

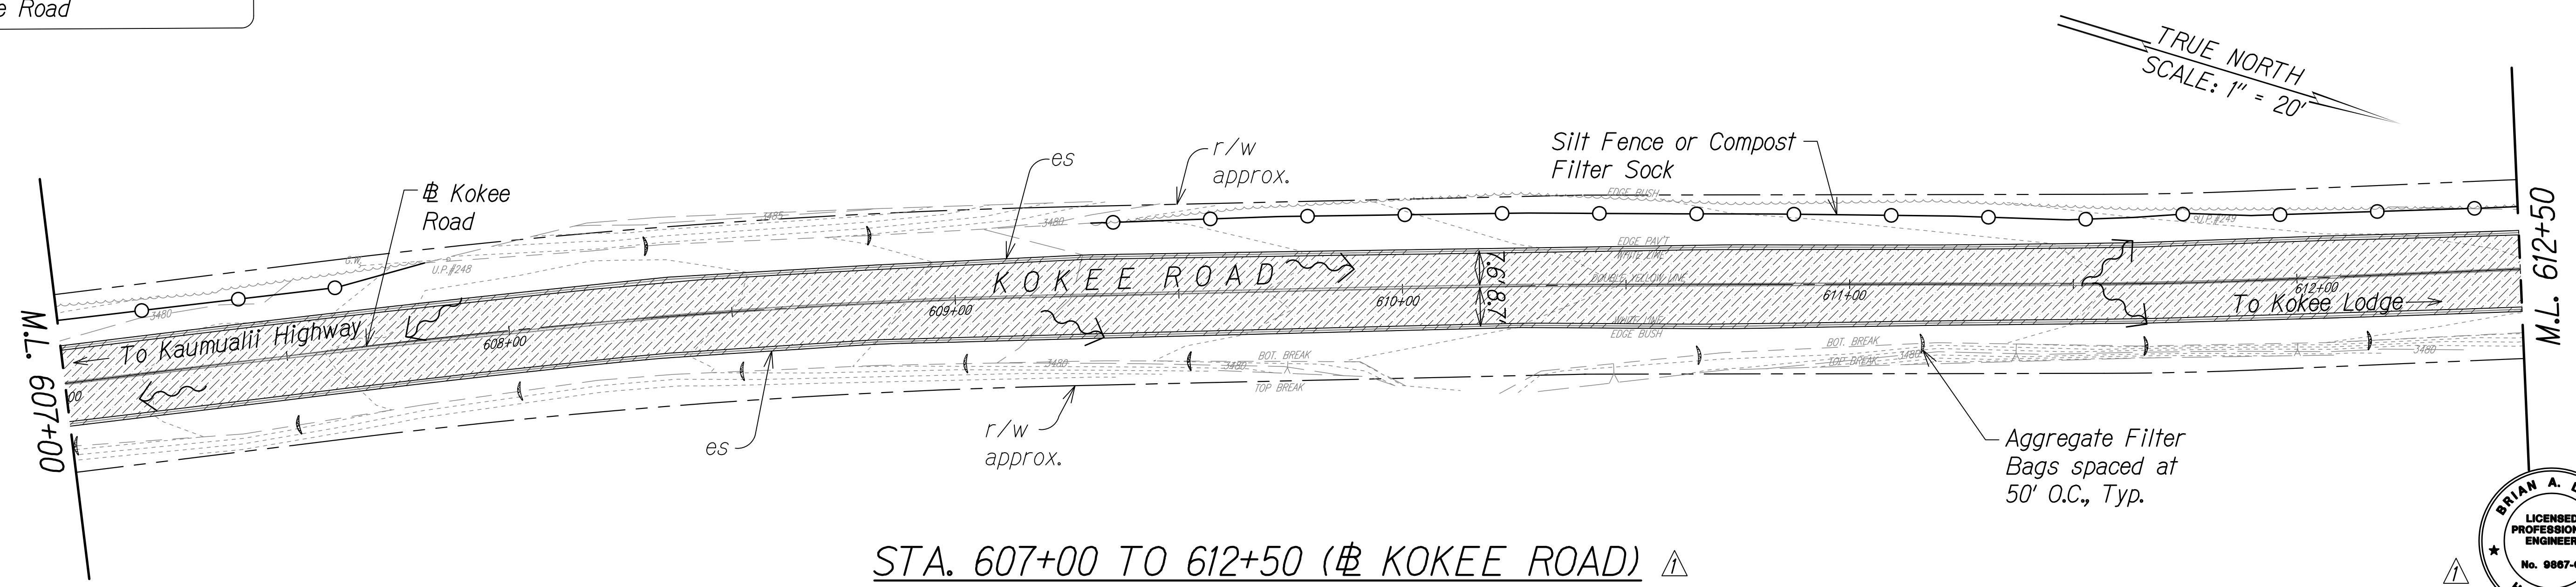


DIST. NO.	STATE	FED. AID PROJ. NO.	FISCAL YEAR	SHEET NO.	TOTAL SHEETS
KAUAI	HAW.	STP-0550(005)	2022	ADD. 13	127

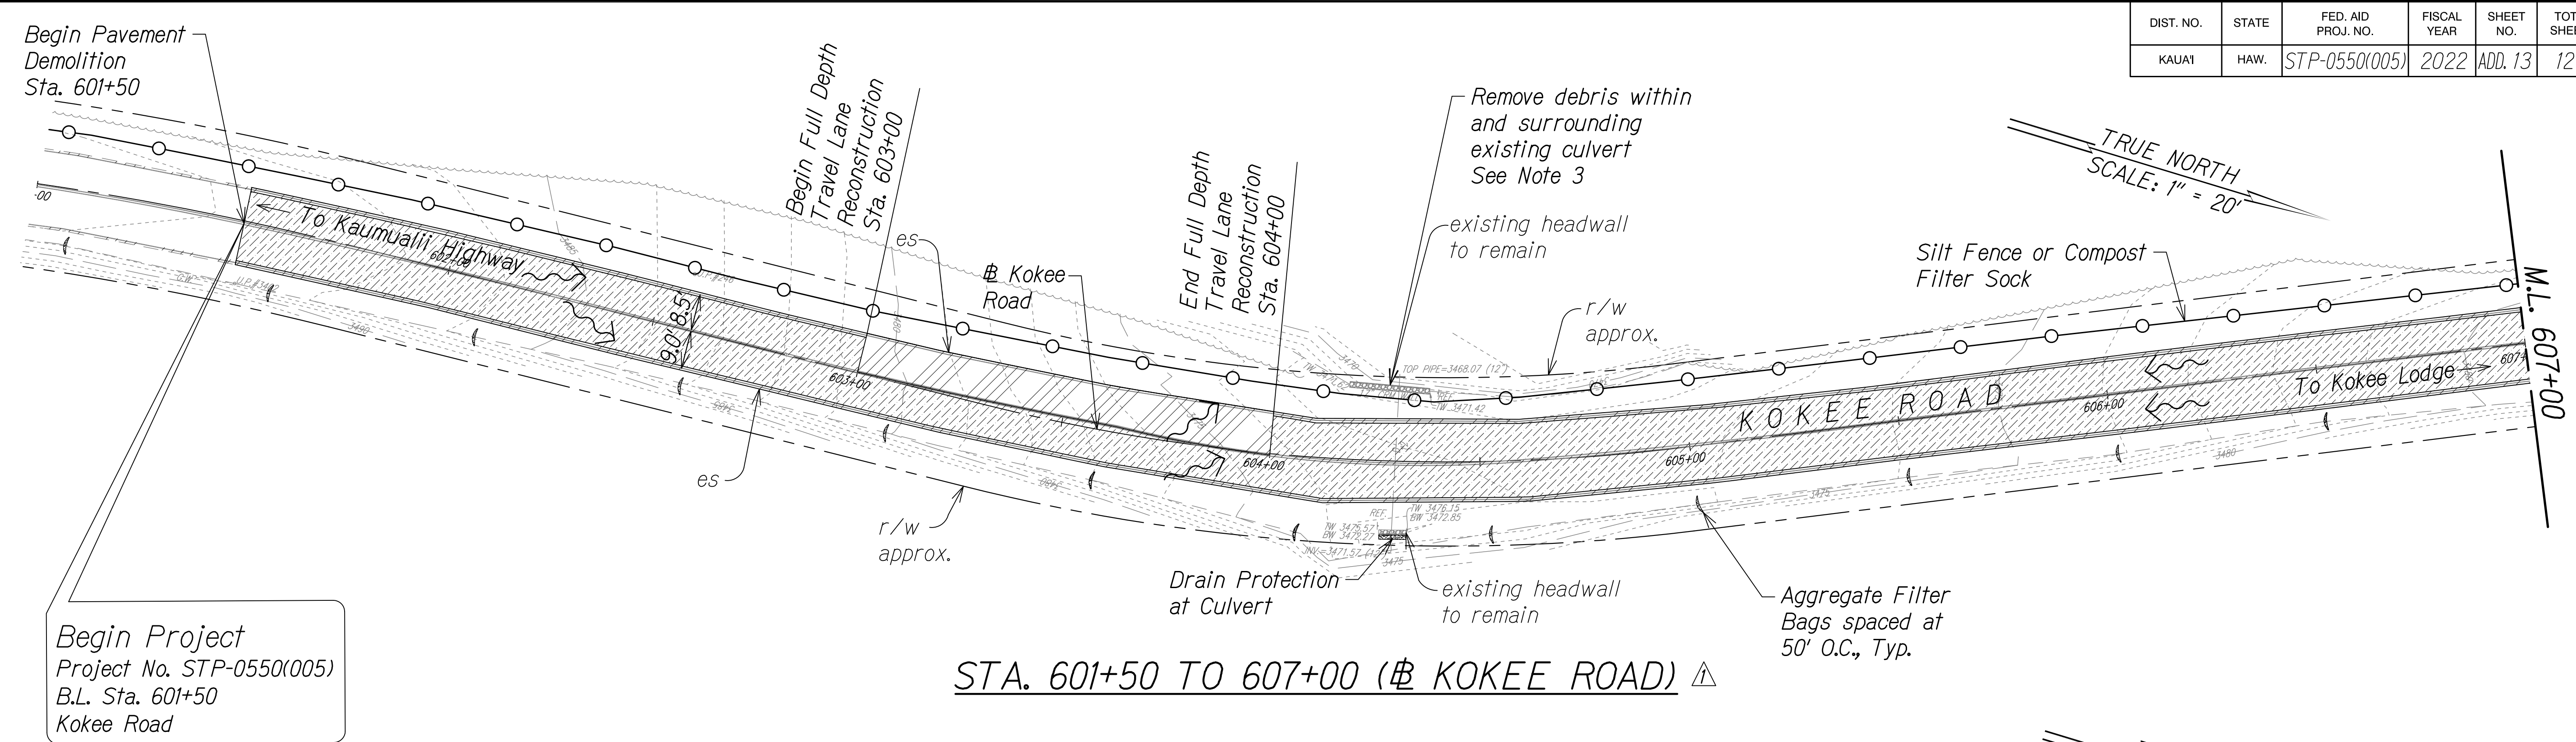


Legend:

- Cold Plane Exist. A.C. 2" Pavement
- Full Depth Pavement Demolition
- Aggregate Filter Bag
- Surface Flow Direction
- Silt Fence or Compost Filter Sock
- Drain Protection at Culvert

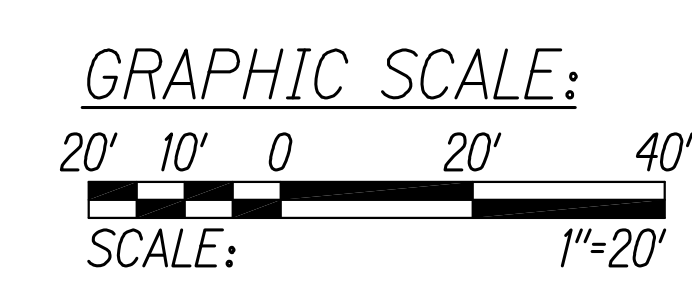

Notes

- Coordinate Guardrail Replacement with Roadway Plan.
- Sediment and Erosion Control BMP measures shown in the Contract Documents are minimum BMPs requirements and do not constitute an acceptable and/or complete Sediment and Erosion Control Plan. The Contractor shall incorporate additional BMPs based upon their means and methods considering site conditions and construction sequence in accordance with the Contract Documents including applicable permit document requirements. Cost shall be included in Pay Item 209.0100, Installation, Maintenance, Monitoring, and Removal of BMP.
- See Historical Preservation Notes.

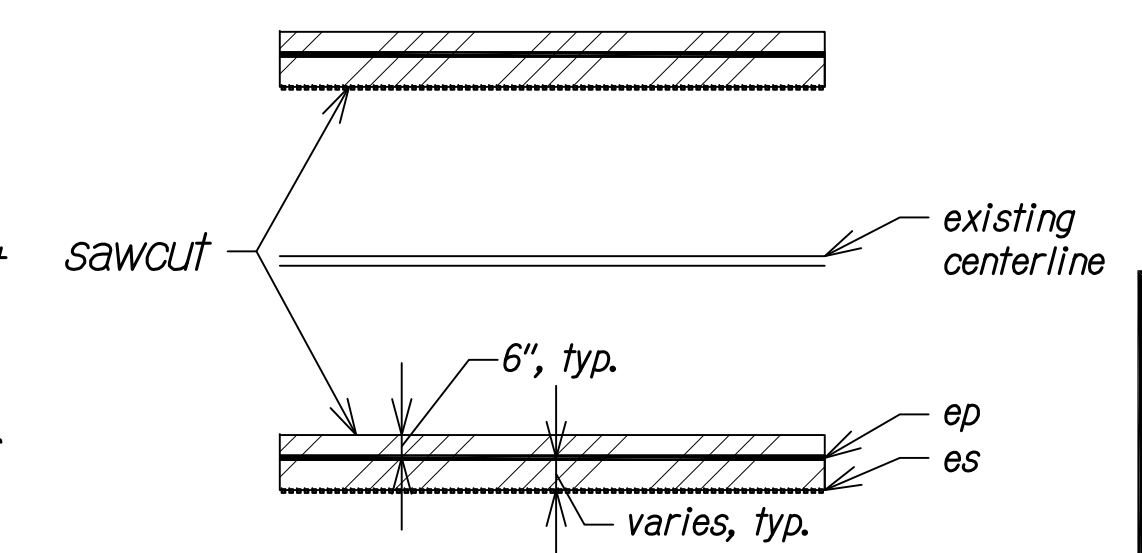

DATE	REVISION
11/07/22	Revised Demolition Extents & Callouts; Revised Engineer's Stamp

STATE OF HAWAII
DEPARTMENT OF TRANSPORTATION
HIGHWAYS DIVISION

DEMOLITION & EROSION CONTROL PLAN

WAIMEA CANYON DRIVE /
KOKEE ROAD IMPROVEMENTS, PHASE 2A
MILE POST 11.5 TO MILE POST 14.0
Federal-Aid Project No. STP-0550(005)
Scale: 1" = 20' Date: August 2022


SHEET No. 1 OF 13 SHEETS



THIS WORK WAS PREPARED BY ME OR UNDER MY SUPERVISION.

WILSON OKAMOTO CORPORATION
APRIL 30, 2024
LIC. EXP. DATE


DIST. NO.	STATE	FED. AID PROJ. NO.	FISCAL YEAR	SHEET NO.	TOTAL SHEETS
KAUAI	HAW.	STP-0550(005)	2022	ADD. 14	127

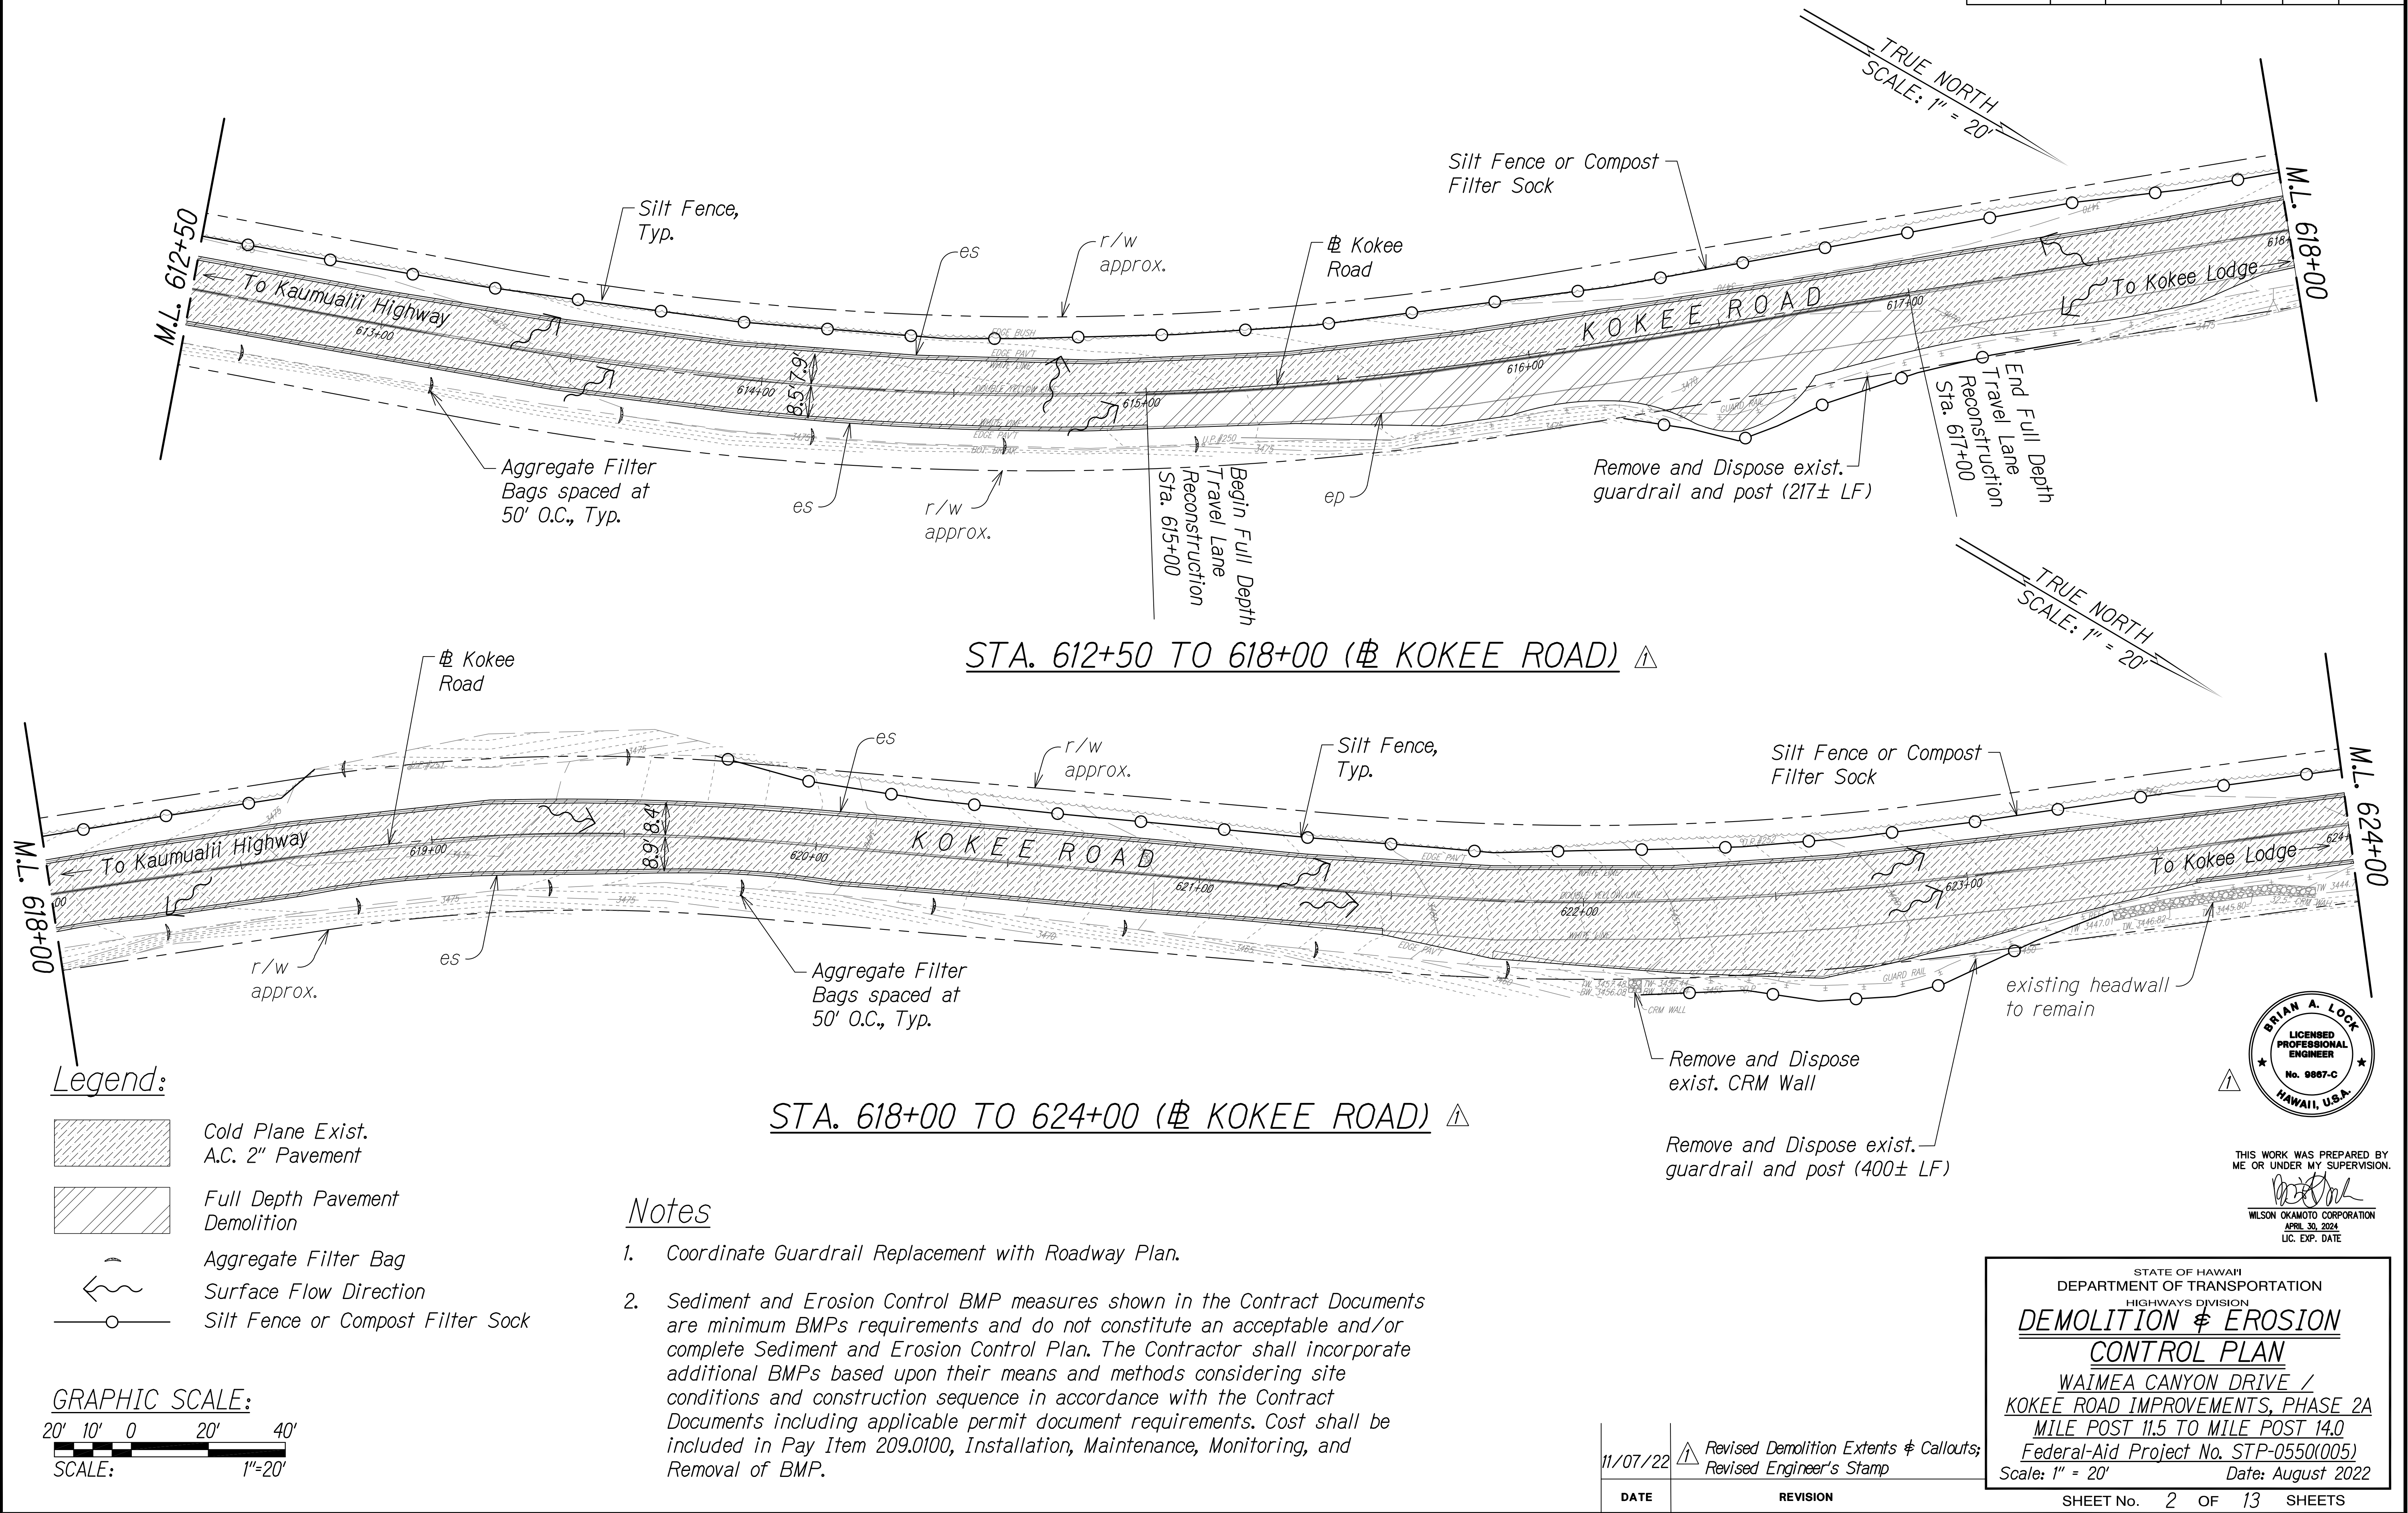

COPY OF ORIGINAL TRACING


ADD 14

DIST. NO.	STATE	FED. AID PROJ. NO.	FISCAL YEAR	SHEET NO.	TOTAL SHEETS
KAUAI	HAW.	STP-0550(005)	2022	ADD. 15	127

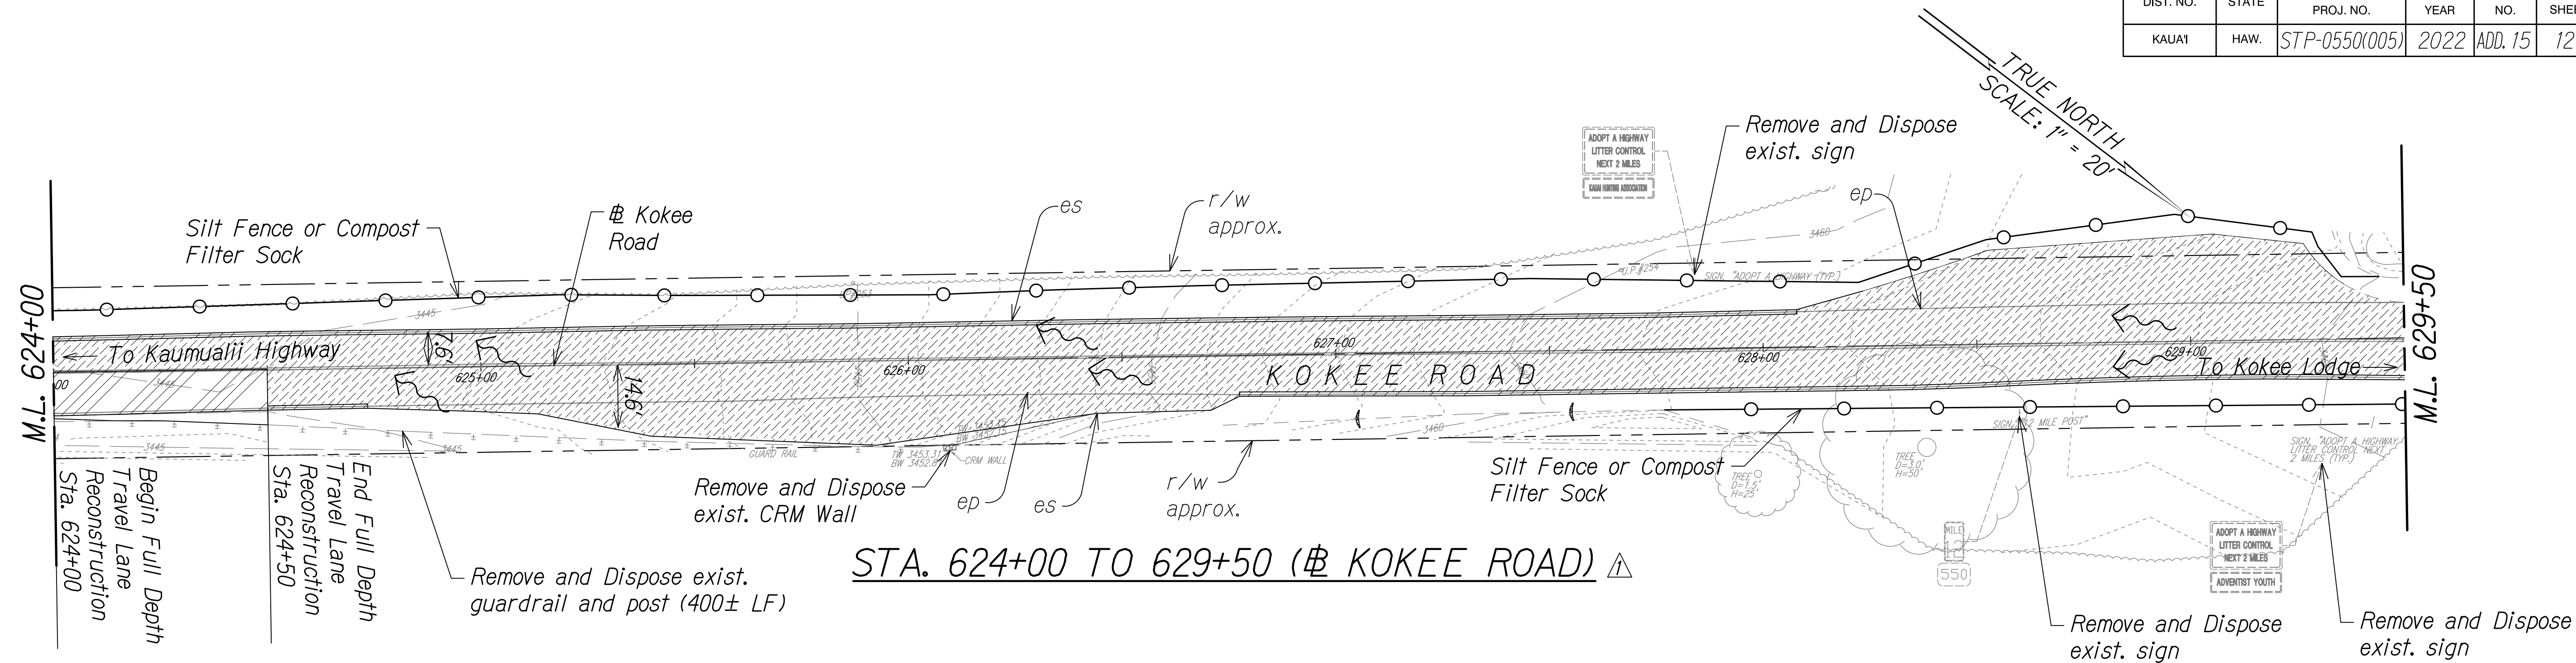

Legend:


- Cold Plane Exist. A.C. 2" Pavement
- Full Depth Pavement Demolition
- Aggregate Filter Bag
- Surface Flow Direction
- Silt Fence or Compost Filter Sock

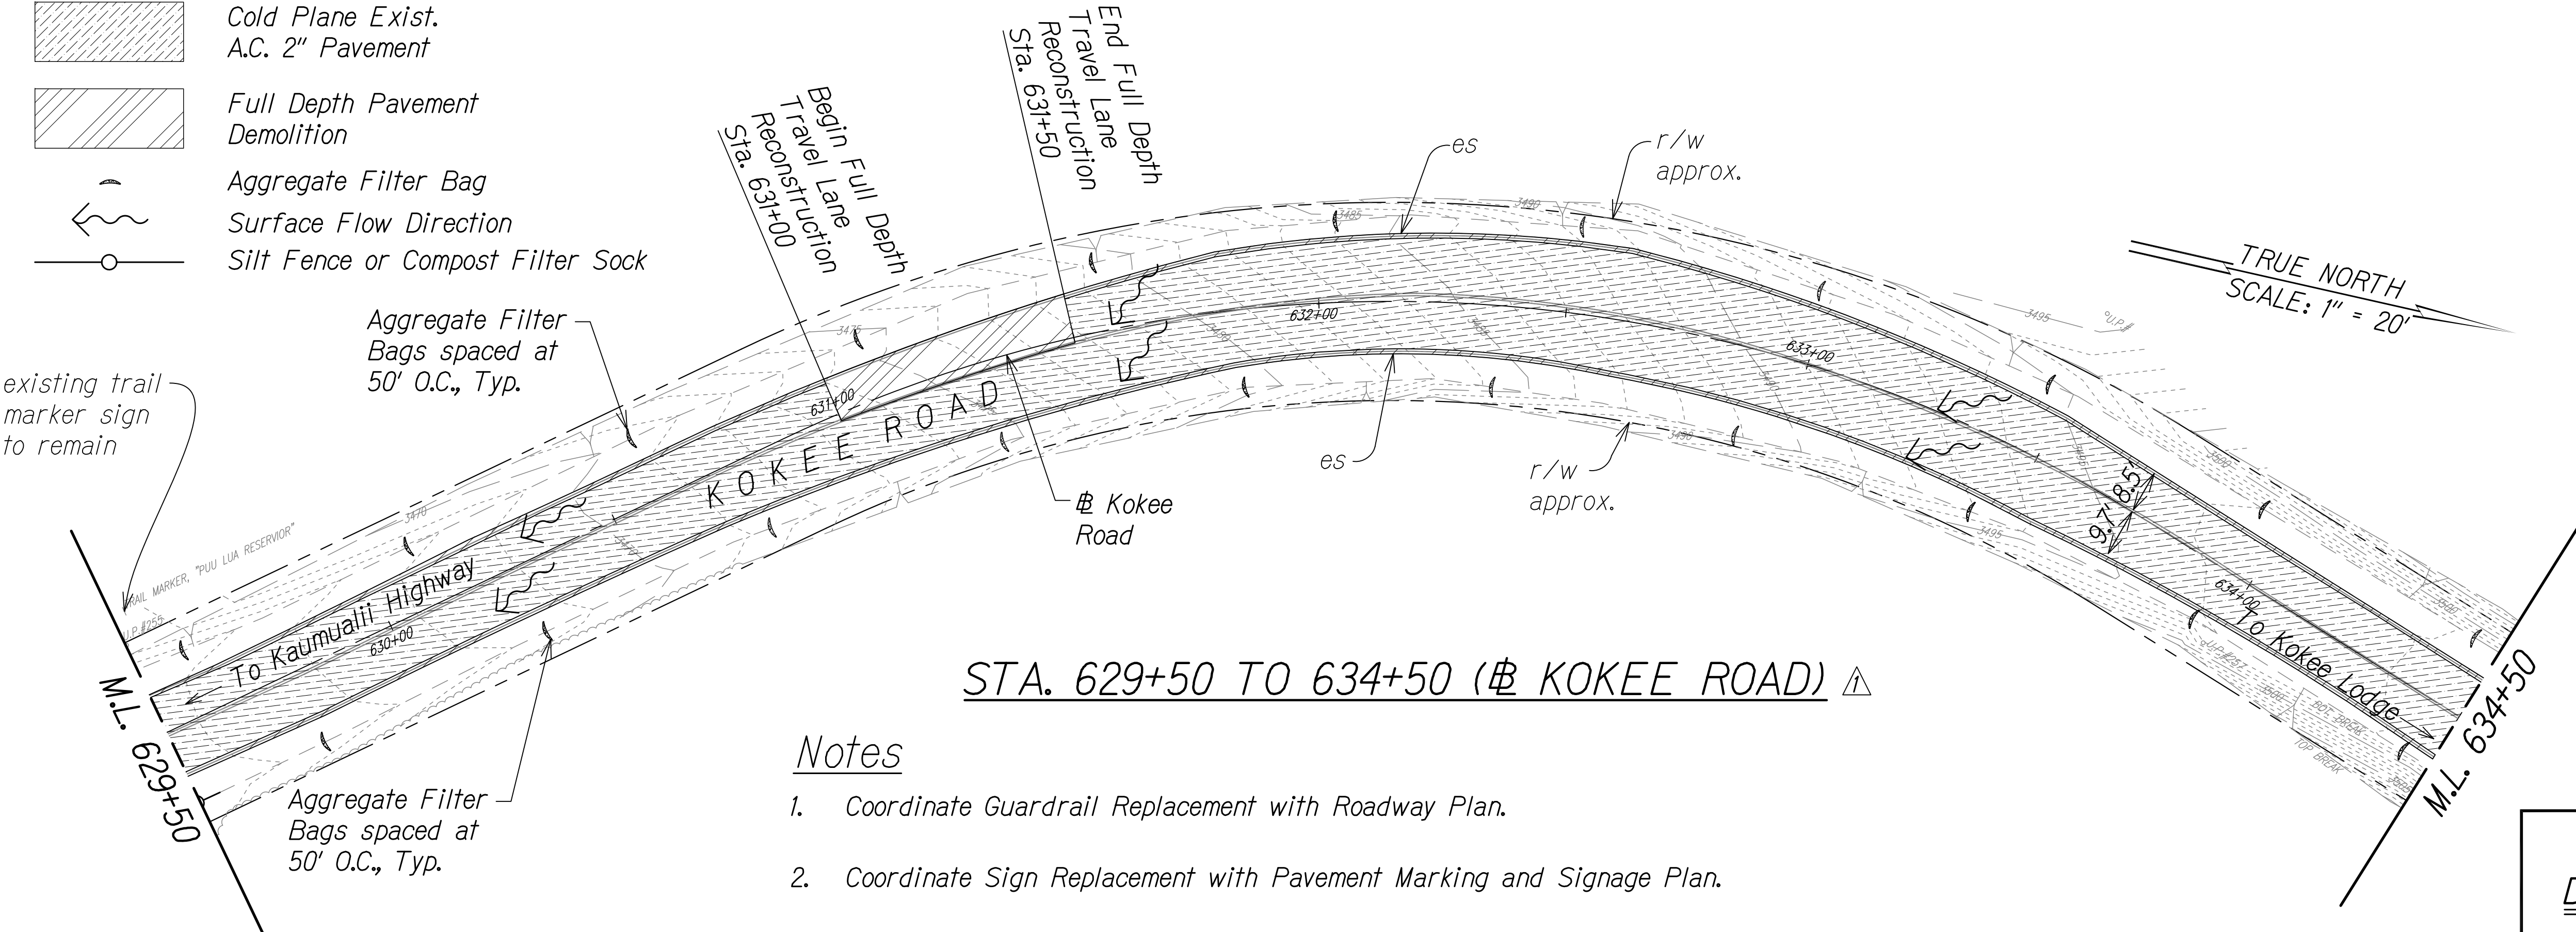


STA. 629+50 TO 634+50 (# KOKEE ROAD) ▲

Notes

- Coordinate Guardrail Replacement with Roadway Plan.
- Coordinate Sign Replacement with Pavement Marking and Signage Plan.
- Sediment and Erosion Control BMP measures shown in the Contract Documents are minimum BMPs requirements and do not constitute an acceptable and/or complete Sediment and Erosion Control Plan. The Contractor shall incorporate additional BMPs based upon their means and methods considering site conditions and construction sequence in accordance with the Contract Documents including applicable permit document requirements. Cost shall be included in Pay Item 209.0100, Installation, Maintenance, Monitoring, and Removal of BMP.

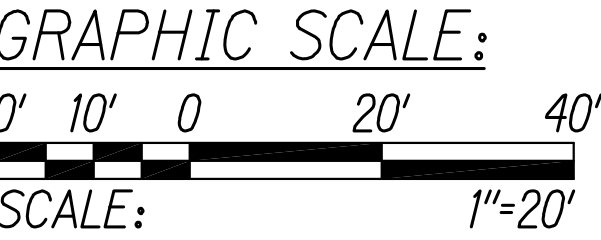

SURVEY PLOTTED BY	DATE
DESIGNED BY	
TRACED BY	
NOTED BY	
QUANTITIES BY	
CHECKED BY	

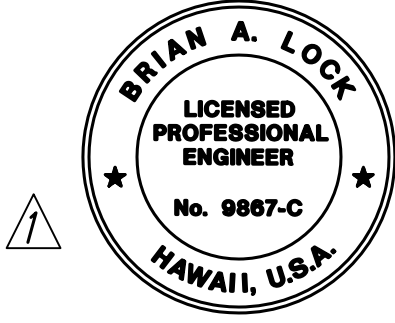

THIS WORK WAS PREPARED BY ME OR UNDER MY SUPERVISION.
WILSON OKAMOTO CORPORATION
APRIL 30, 2024
LIC. EXP. DATE


STATE OF HAWAII
DEPARTMENT OF TRANSPORTATION
HIGHWAYS DIVISION
DEMOLITION & EROSION CONTROL PLAN
WAIMEA CANYON DRIVE /
KOKEE ROAD IMPROVEMENTS, PHASE 2A
MILE POST 11.5 TO MILE POST 14.0
Federal-Aid Project No. STP-0550(005)
Scale: 1" = 20' Date: August 2022

11/07/22 ▲ Revised Demolition Extents & Callouts;
Revised Engineer's Stamp

DATE REVISION

SHEET No. 3 OF 13 SHEETS


DIST. NO.	STATE	FED. AID PROJ. NO.	FISCAL YEAR	SHEET NO.	TOTAL SHEETS
KAUAI	HAW.	STP-0550(005)	2022	ADD. 16	127

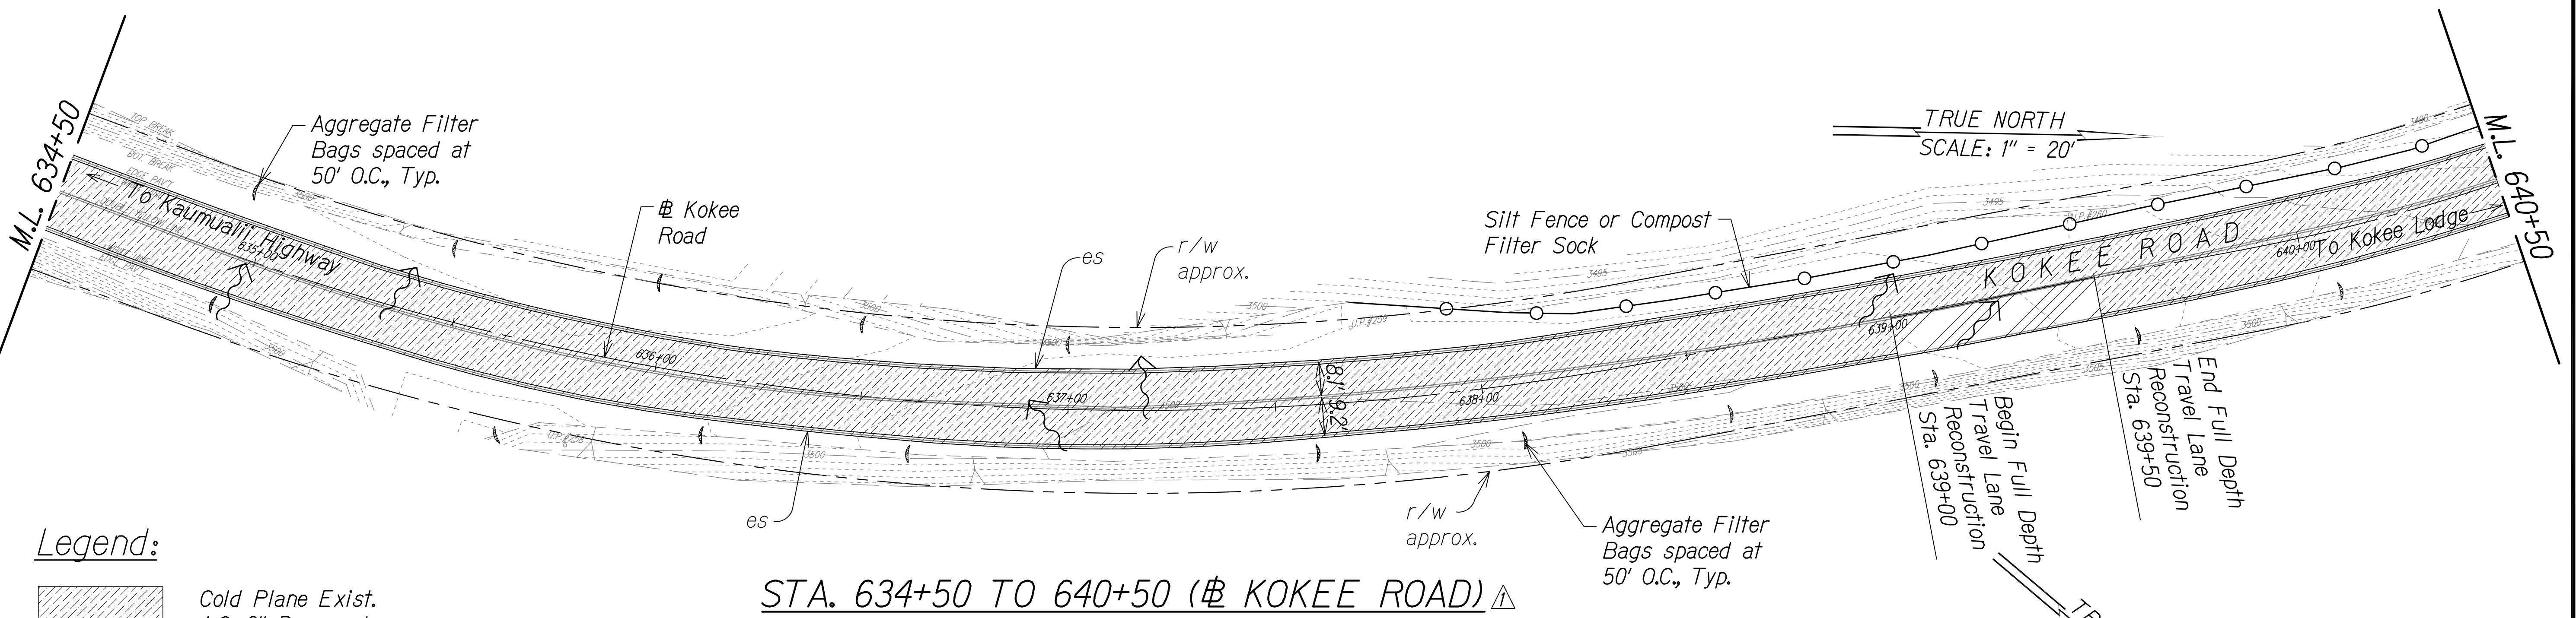

- Legend:**
- Cold Plane Exist. A.C. 2" Pavement
 - Full Depth Pavement Demolition
 - Aggregate Filter Bag
 - Surface Flow Direction
 - Silt Fence or Compost Filter Sock

Notes

Sediment and Erosion Control BMP measures shown in the Contract Documents are minimum BMPs requirements and do not constitute an acceptable and/or complete Sediment and Erosion Control Plan. The Contractor shall incorporate additional BMPs based upon their means and methods considering site conditions and construction sequence in accordance with the Contract Documents including applicable permit document requirements. Cost shall be included in Pay Item 209.0100, Installation, Maintenance, Monitoring, and Removal of BMP.

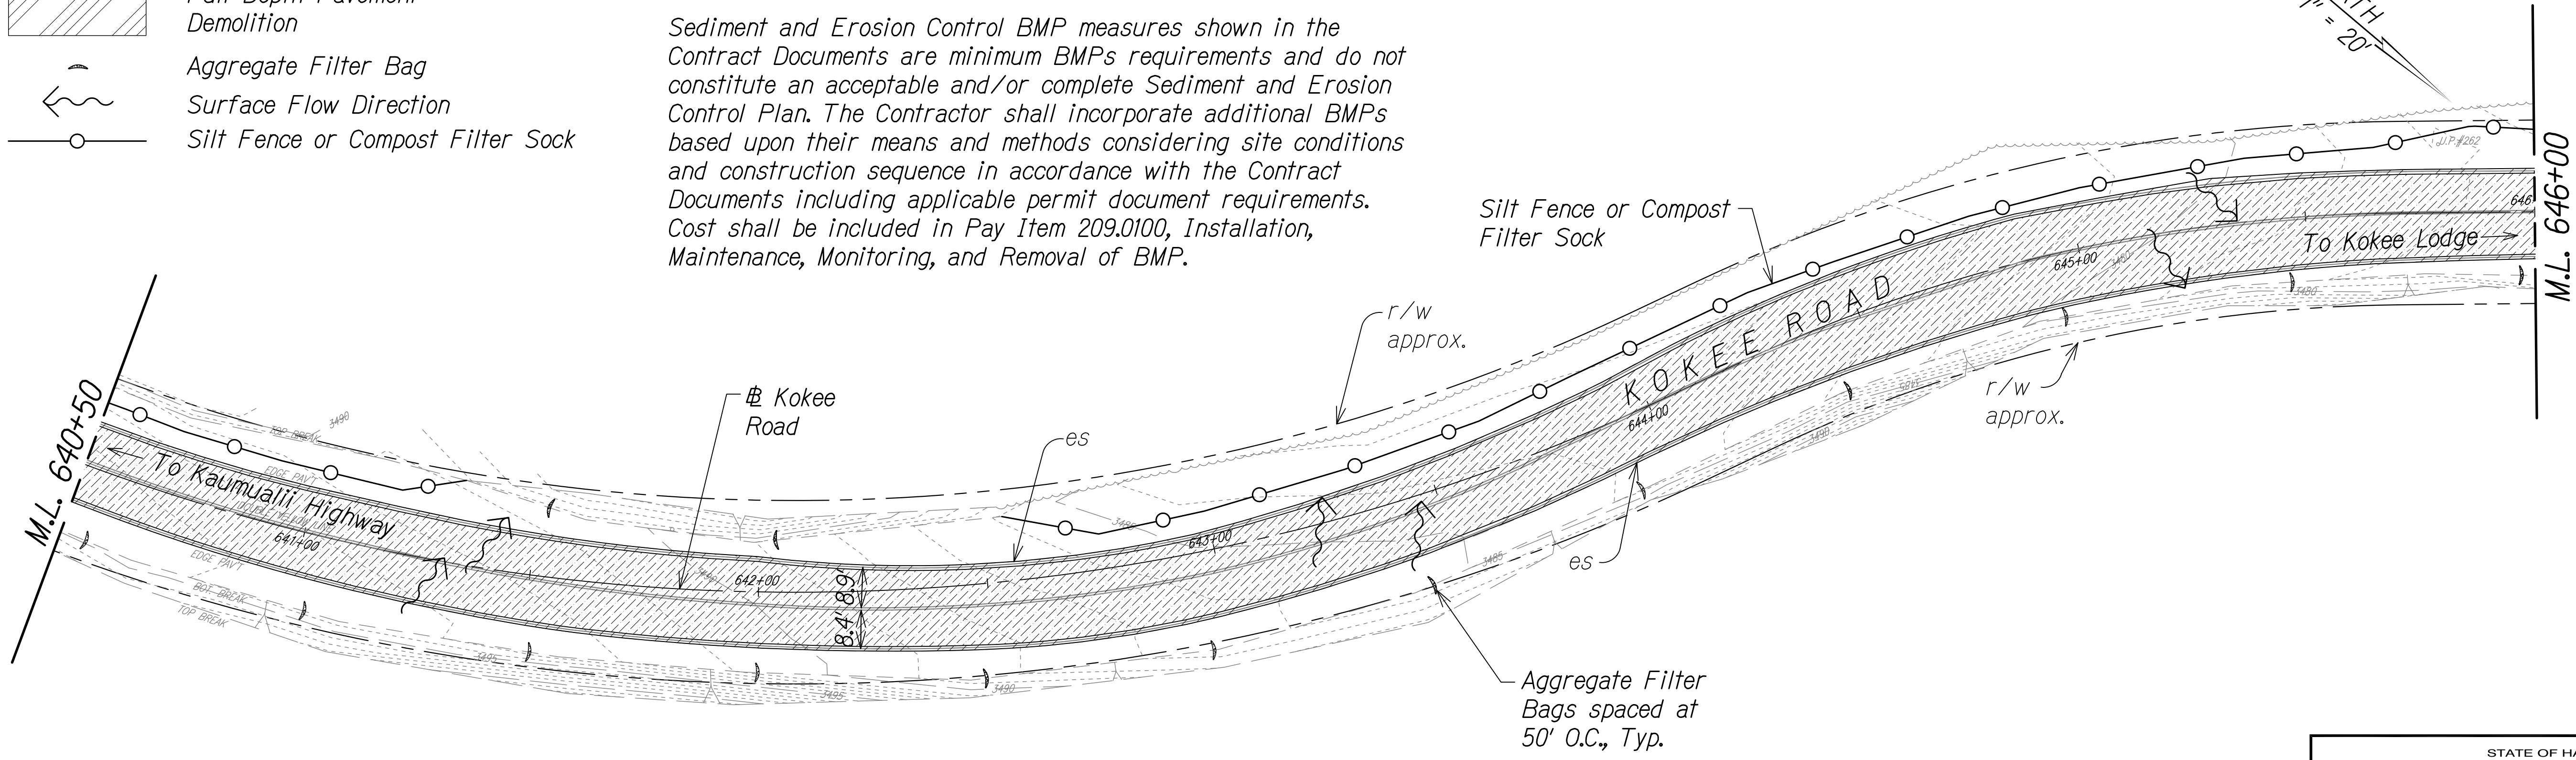

STA. 640+50 TO 646+00 (# KOKEE ROAD) Δ



SURVEY PLOTTED BY	DATE
DESIGNED BY	
TRACED BY	
NOTED BY	
QUANTITIES BY	
CHECKED BY	

THIS WORK WAS PREPARED BY ME OR UNDER MY SUPERVISION.

[Signature]


WILSON OKAMOTO CORPORATION
APRIL 30, 2024
LIC. EXP. DATE

STATE OF HAWAII
DEPARTMENT OF TRANSPORTATION
HIGHWAYS DIVISION
DEMOLITION & EROSION CONTROL PLAN
WAIMEA CANYON DRIVE /
KOKEE ROAD IMPROVEMENTS, PHASE 2A
MILE POST 11.5 TO MILE POST 14.0
Federal-Aid Project No. STP-0550(005)
Scale: 1" = 20' Date: August 2022

DATE: 11/07/22 REVISION: Δ Revised Demolition Extents & Callouts; Revised Engineer's Stamp


SHEET No. 4 OF 13 SHEETS

DIST. NO.	STATE	FED. AID PROJ. NO.	FISCAL YEAR	SHEET NO.	TOTAL SHEETS
KAUAI	HAW.	STP-0550(005)	2022	ADD. 17	127

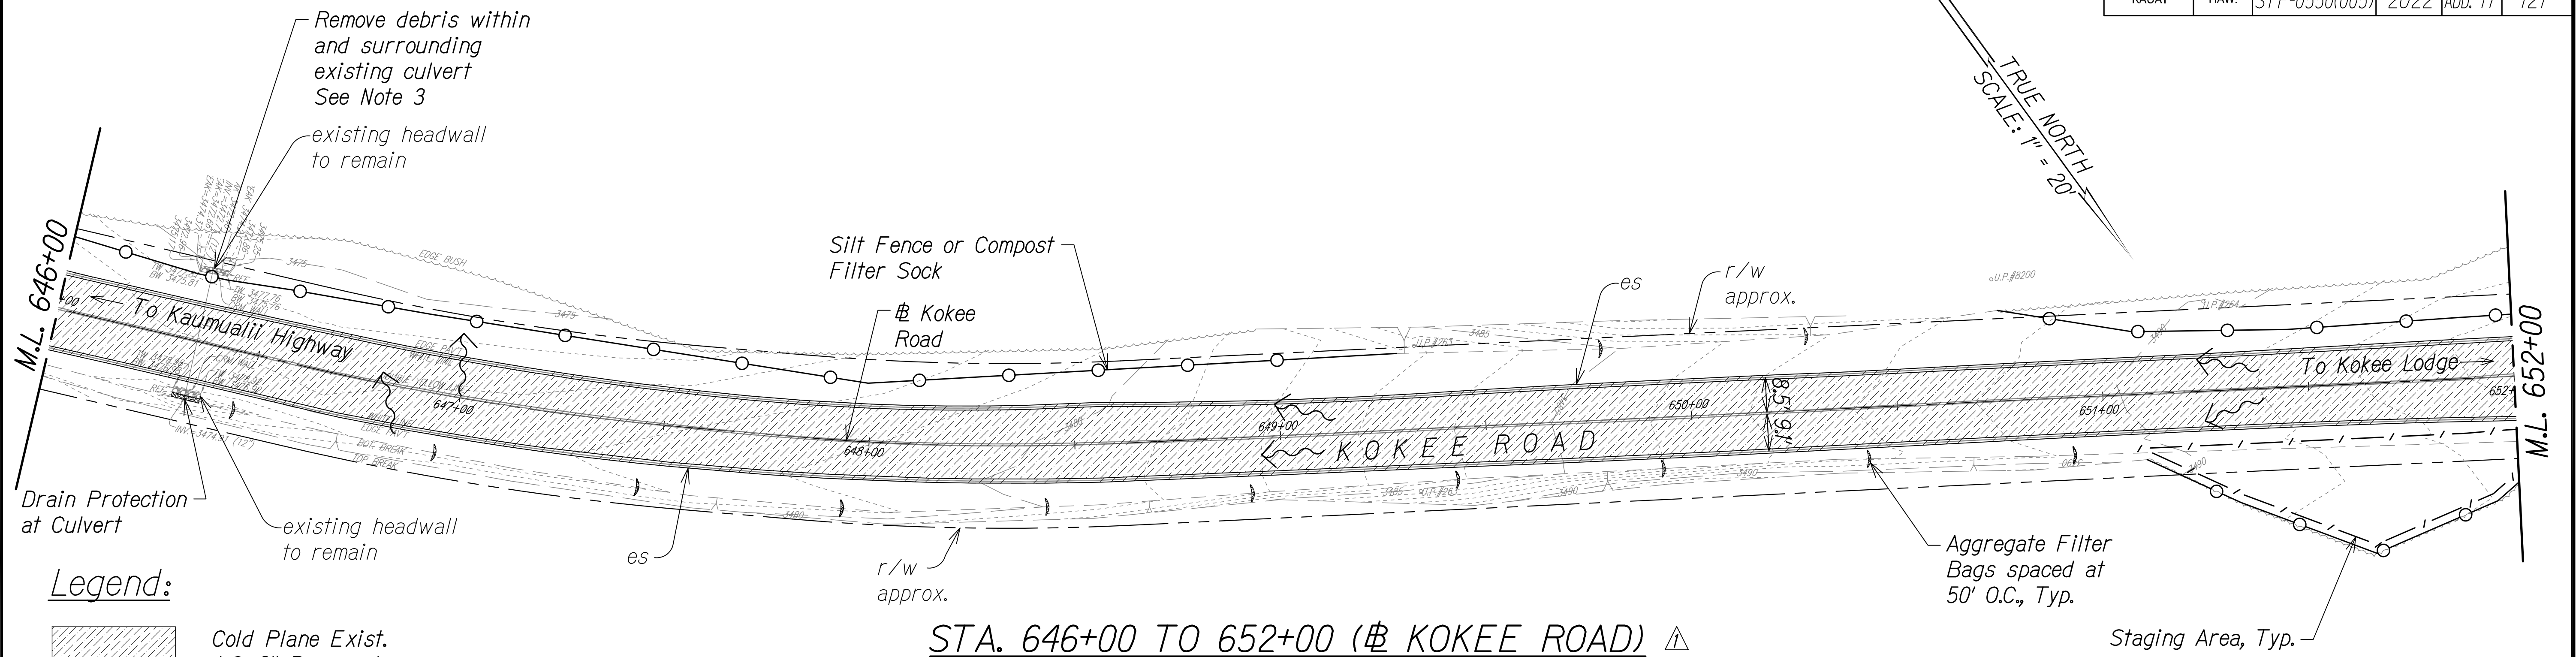

Legend:

-
-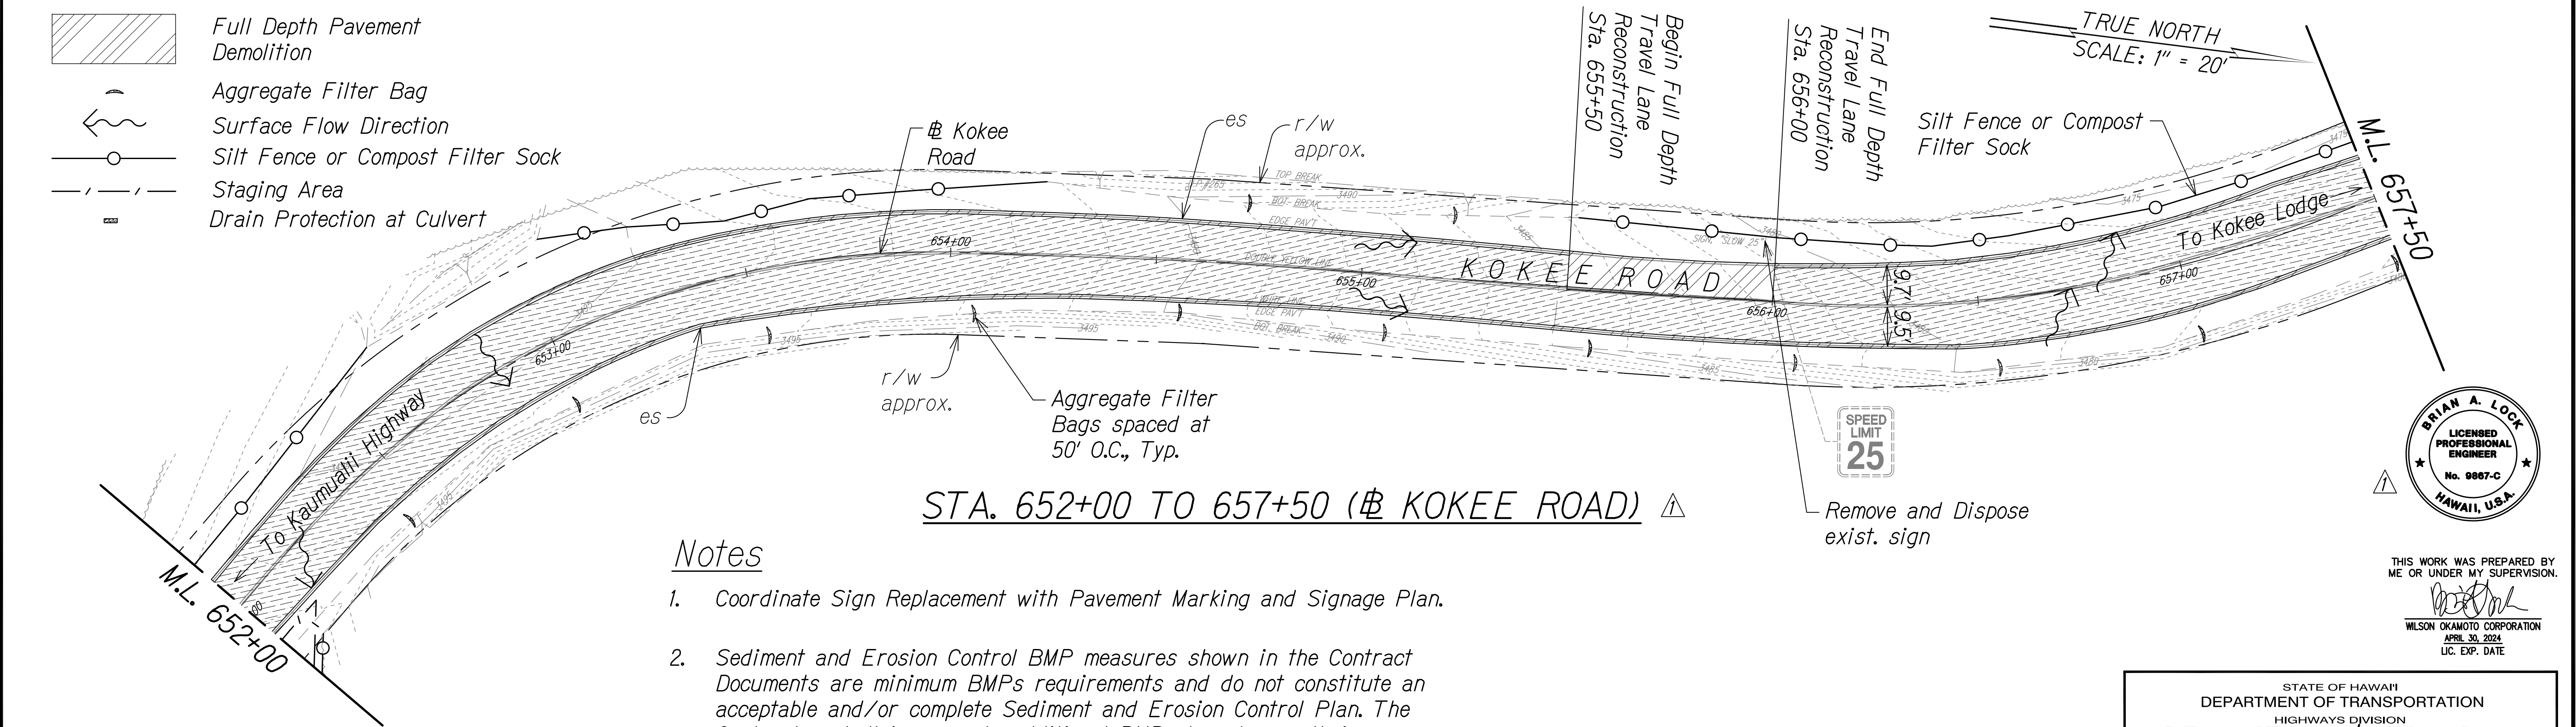
Notes

- Coordinate Sign Replacement with Pavement Marking and Signage Plan.
- Sediment and Erosion Control BMP measures shown in the Contract Documents are minimum BMPs requirements and do not constitute an acceptable and/or complete Sediment and Erosion Control Plan. The Contractor shall incorporate additional BMPs based upon their means and methods considering site conditions and construction sequence in accordance with the Contract Documents including applicable permit document requirements. Cost shall be included in Pay Item 209.0100, Installation, Maintenance, Monitoring, and Removal of BMP.
- See Historical Preservation Notes.



SURVEY PLOTTED BY	DATE
DESIGNED BY	
TRACED BY	
DESIGNED BY	
QUANTITIES BY	
CHECKED BY	
ORIGINAL PLAN	
NOTE BOOK	
No.	

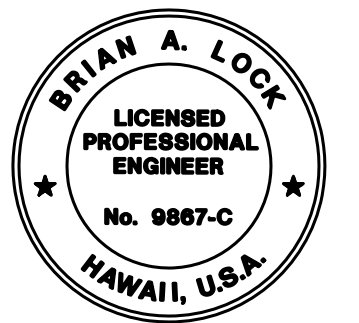

THIS WORK WAS PREPARED BY
ME OR UNDER MY SUPERVISION.
[Signature]
WILSON OKAMOTO CORPORATION
APRIL 30, 2024
LIC. EXP. DATE


STATE OF HAWAII
DEPARTMENT OF TRANSPORTATION
HIGHWAYS DIVISION
**DEMOLITION & EROSION
CONTROL PLAN**
WAIMEA CANYON DRIVE /
Kokee Road Improvements, Phase 2A
MILE POST 11.5 TO MILE POST 14.0
Federal-Aid Project No. STP-0550(005)
Scale: 1" = 20' Date: August 2022
SHEET No. 5 OF 13 SHEETS

DATE	REVISION
11/07/22	Revised Demolition Extents & Callouts; Revised Engineer's Stamp

COPY OF ORIGINAL TRACING


ADD 17

DIST. NO.	STATE	FED. AID PROJ. NO.	FISCAL YEAR	SHEET NO.	TOTAL SHEETS
KAUAI	HAW.	STP-0550(005)	2022	ADD. 18	127

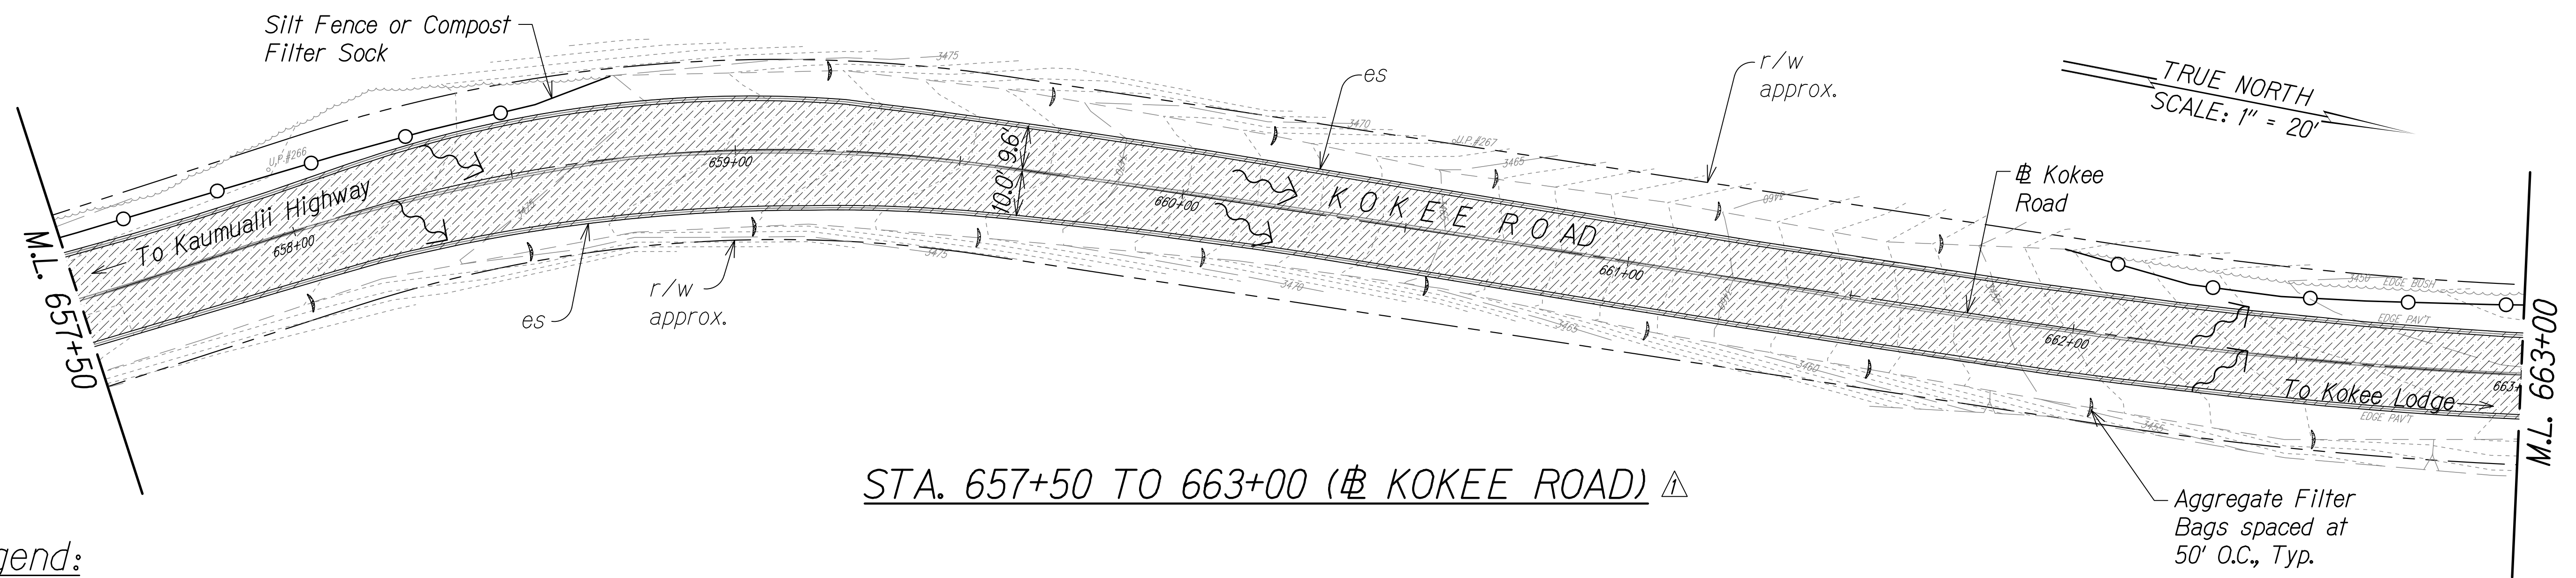

Legend:


- Cold Plane Exist. A.C. 2" Pavement
- Full Depth Pavement Demolition
- Aggregate Filter Bag
- Surface Flow Direction
- Silt Fence or Compost Filter Sock

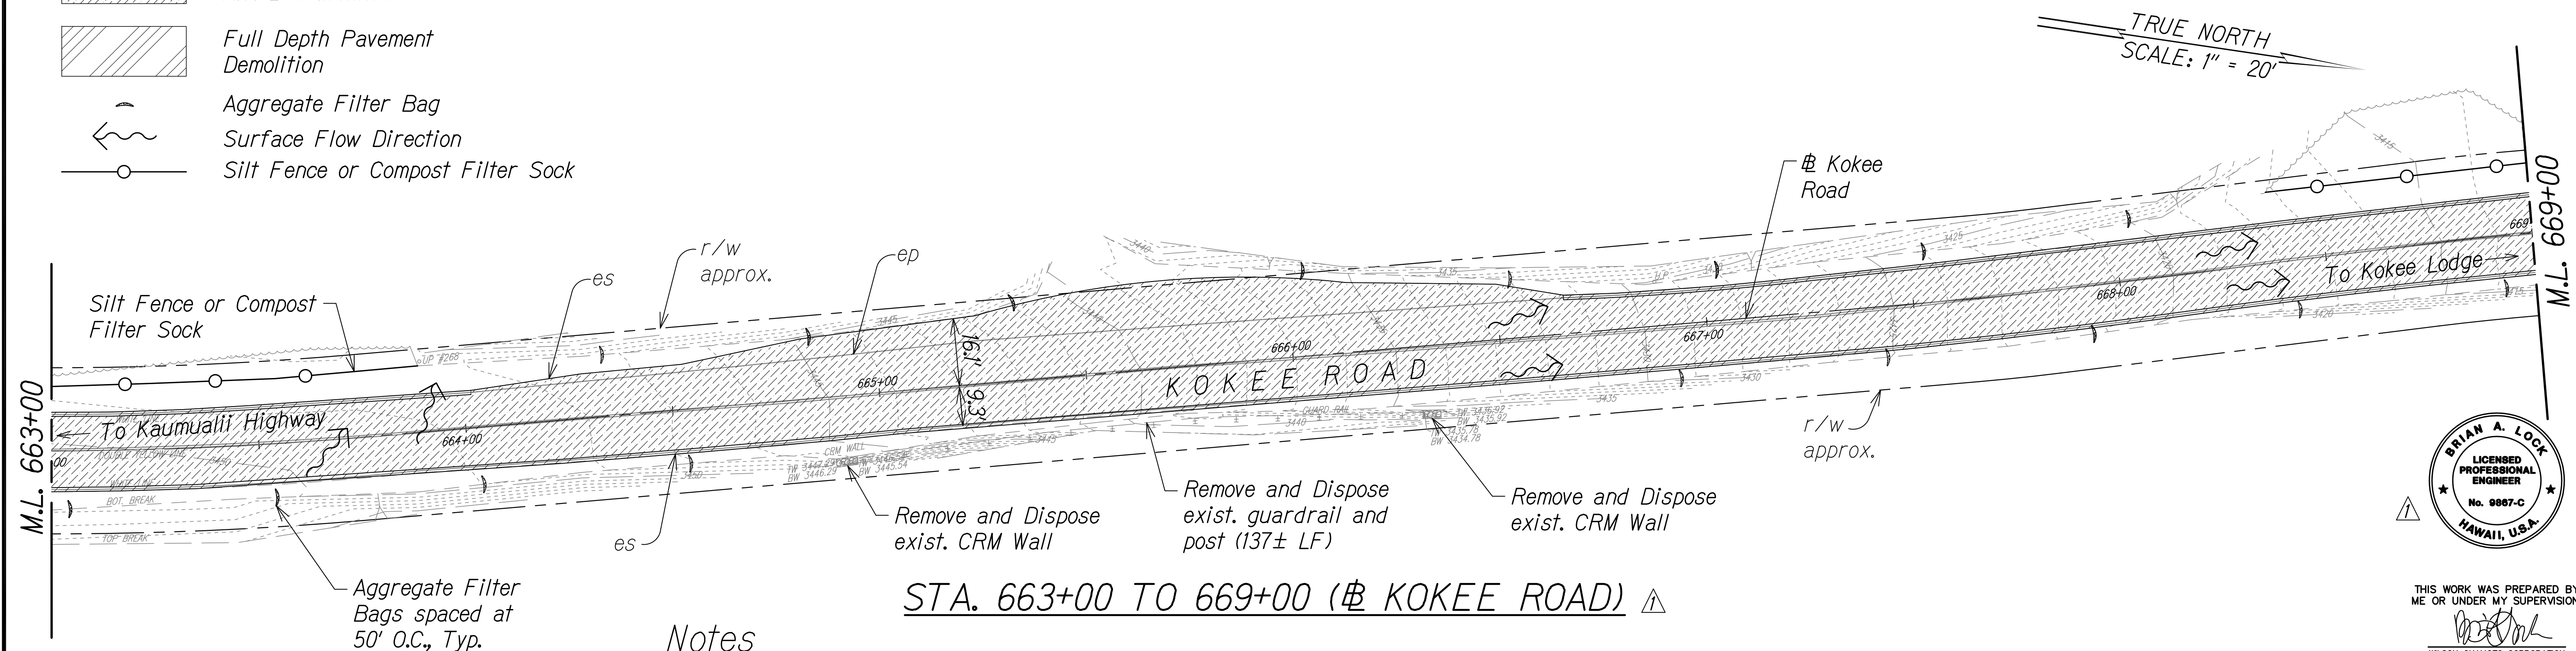

Notes

- Coordinate Guardrail Replacement with Roadway Plan.
- Sediment and Erosion Control BMP measures shown in the Contract Documents are minimum BMPs requirements and do not constitute an acceptable and/or complete Sediment and Erosion Control Plan. The Contractor shall incorporate additional BMPs based upon their means and methods considering site conditions and construction sequence in accordance with the Contract Documents including applicable permit document requirements. Cost shall be included in Pay Item 209.0100, Installation, Maintenance, Monitoring, and Removal of BMP.

GRAPHIC SCALE:
20' 10' 0 20' 40'
SCALE: 1"=20'

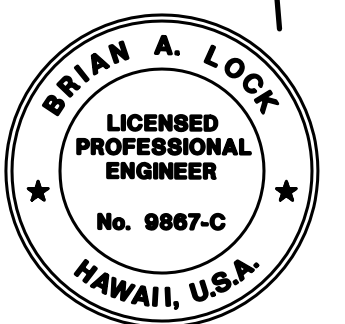

THIS WORK WAS PREPARED BY
ME OR UNDER MY SUPERVISION.
[Signature]
WILSON OKAMOTO CORPORATION
APRIL 30, 2024
LIC. EXP. DATE


STATE OF HAWAII
DEPARTMENT OF TRANSPORTATION
HIGHWAYS DIVISION
**DEMOLITION & EROSION
CONTROL PLAN**
WAIMEA CANYON DRIVE /
Kokee Road Improvements, Phase 2A
MILE POST 11.5 TO MILE POST 14.0
Federal-Aid Project No. STP-0550(005)
Scale: 1" = 20' Date: August 2022
SHEET No. 6 OF 13 SHEETS

DATE	REVISION
11/07/22	Revised Demolition Extents & Callouts; Revised Engineer's Stamp

COPY OF ORIGINAL TRACING


ADD 18

DIST. NO.	STATE	FED. AID PROJ. NO.	FISCAL YEAR	SHEET NO.	TOTAL SHEETS
KAUAI	HAW.	STP-0550(005)	2022	ADD. 19	127

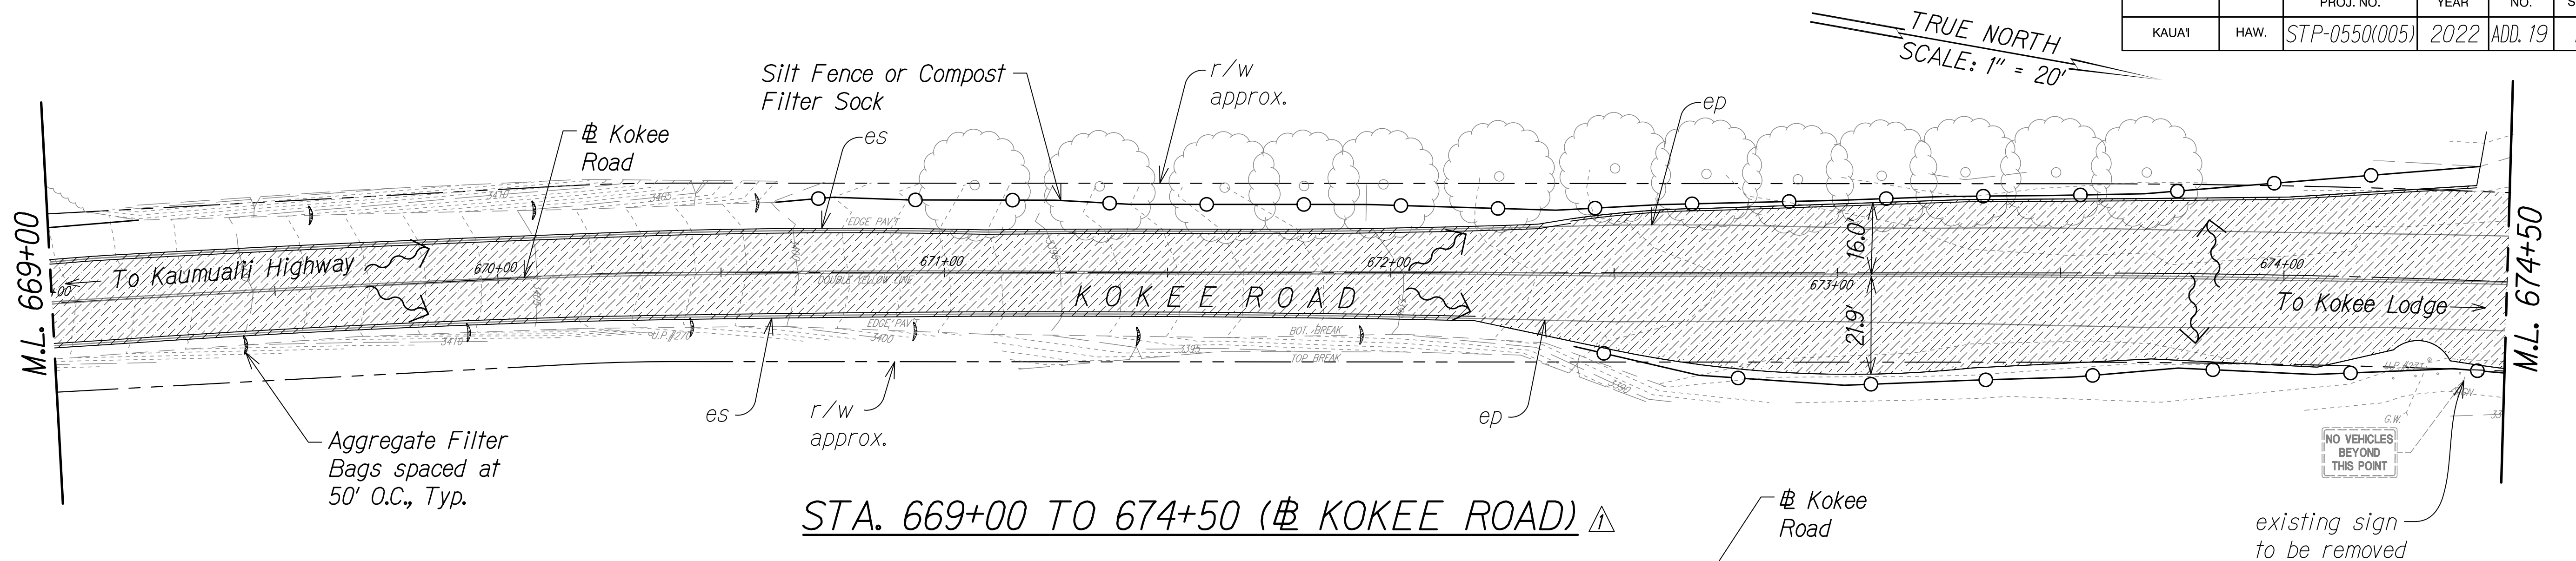

Legend:


- Cold Plane Exist. A.C. 2" Pavement
- Full Depth Pavement Demolition
- Aggregate Filter Bag
- Surface Flow Direction
- Silt Fence or Compost Filter Sock

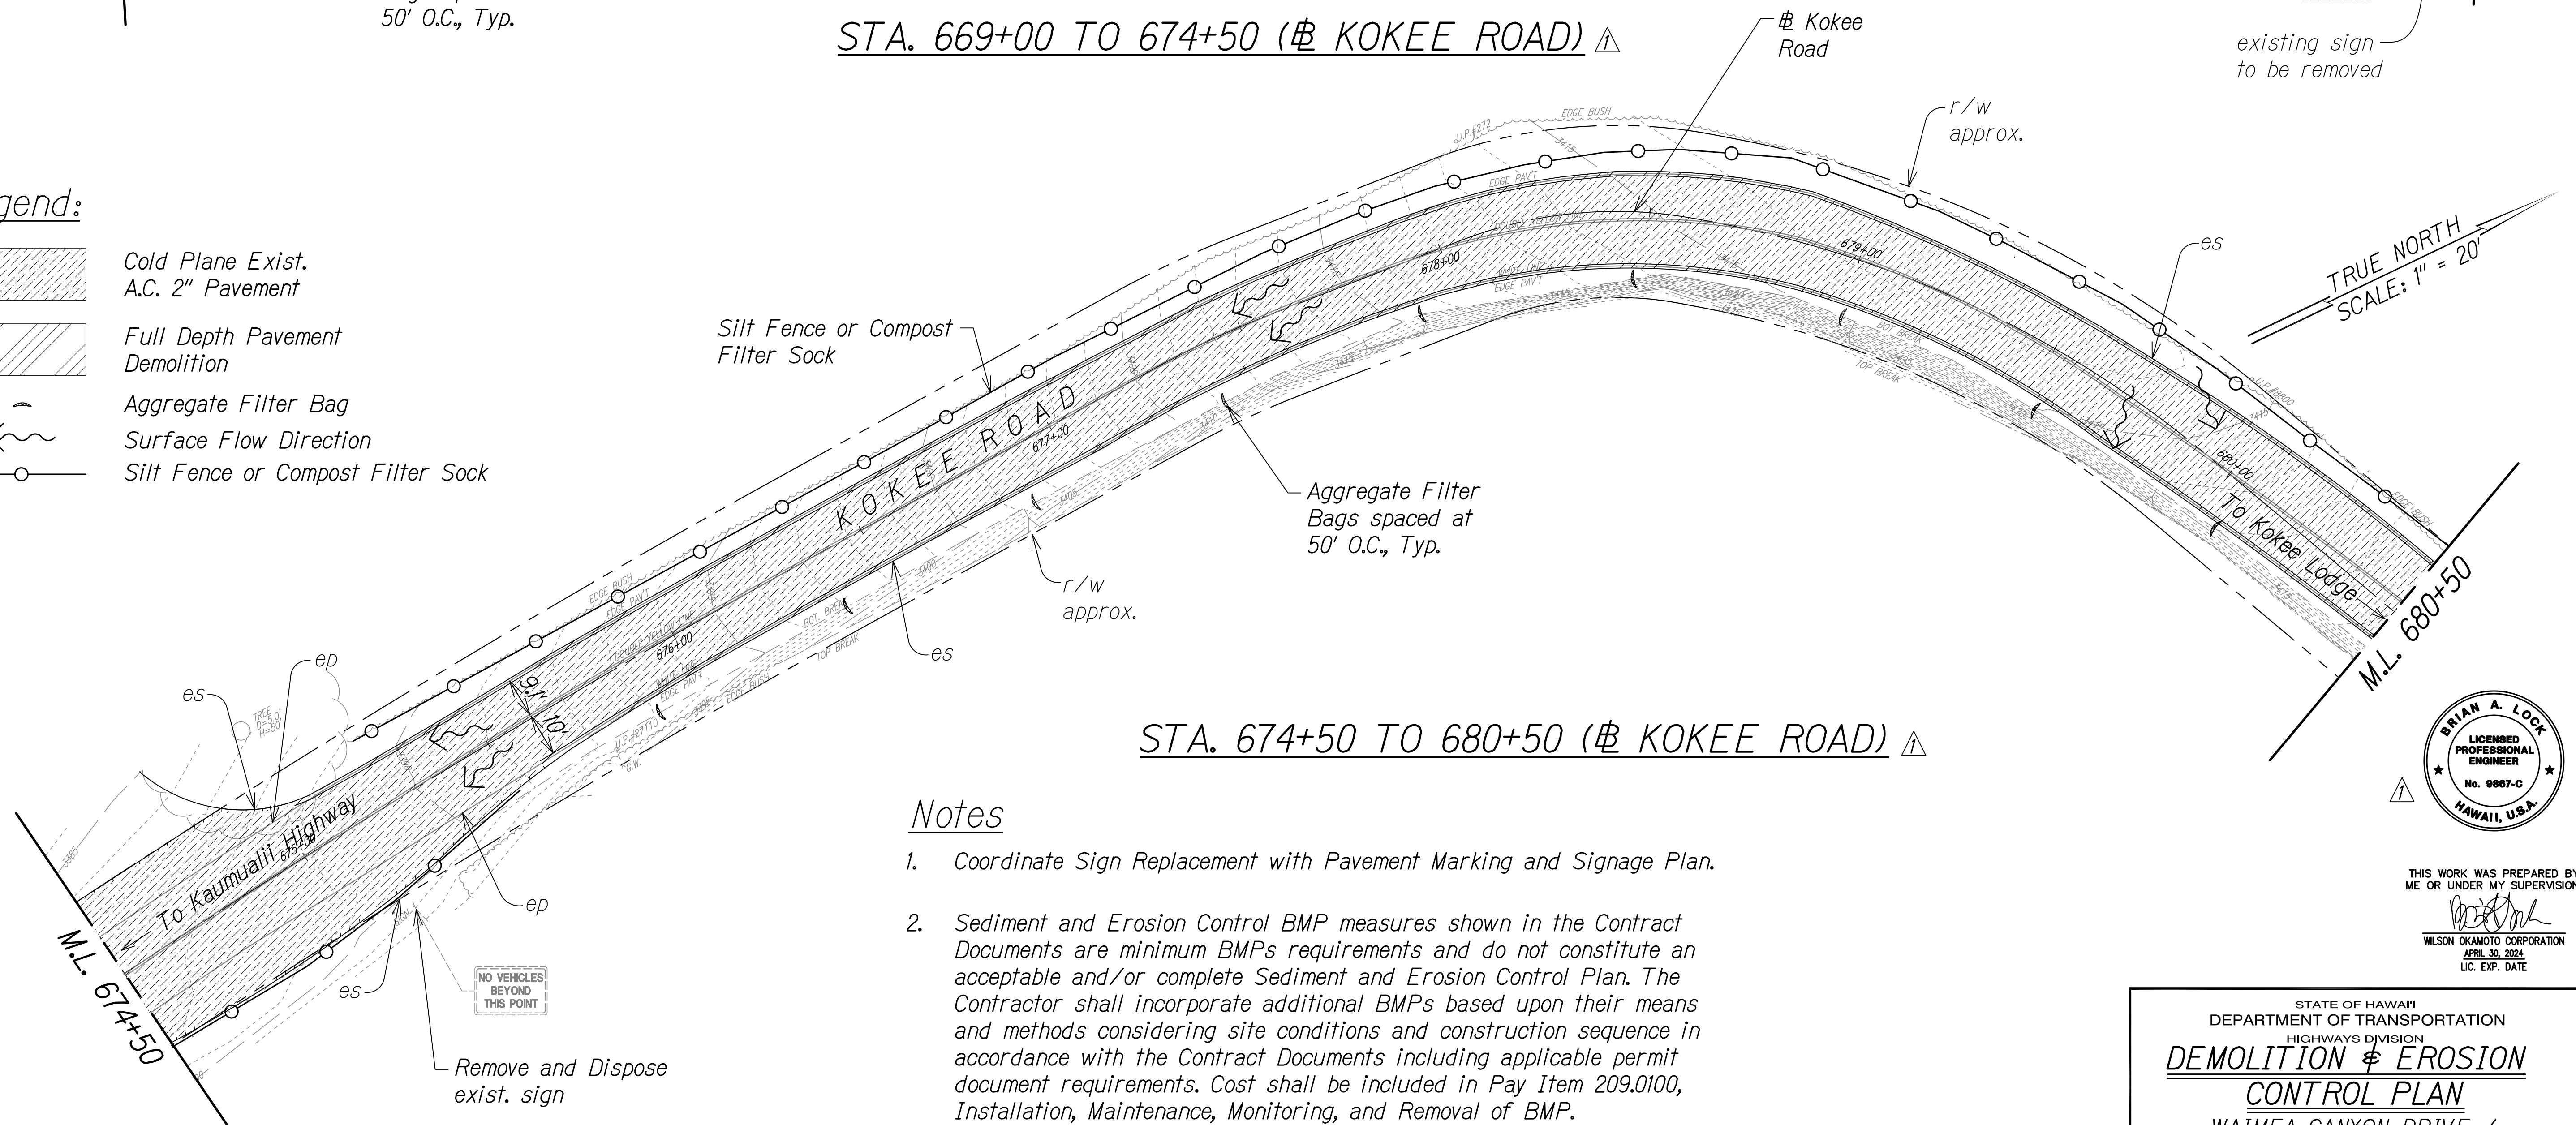

Notes

- Coordinate Sign Replacement with Pavement Marking and Signage Plan.
- Sediment and Erosion Control BMP measures shown in the Contract Documents are minimum BMPs requirements and do not constitute an acceptable and/or complete Sediment and Erosion Control Plan. The Contractor shall incorporate additional BMPs based upon their means and methods considering site conditions and construction sequence in accordance with the Contract Documents including applicable permit document requirements. Cost shall be included in Pay Item 209.0100, Installation, Maintenance, Monitoring, and Removal of BMP.
- Trim trees to ensure traffic signs are visible. Coordinate with Pavement Marking and Signage Plan.

GRAPHIC SCALE:
20' 10' 0 20' 40'
SCALE: 1"=20'

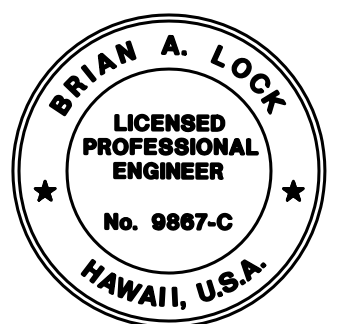

THIS WORK WAS PREPARED BY
ME OR UNDER MY SUPERVISION.
[Signature]
WILSON OKAMOTO CORPORATION
APRIL 30, 2024
LIC. EXP. DATE


STATE OF HAWAII
DEPARTMENT OF TRANSPORTATION
HIGHWAYS DIVISION
**DEMOLITION & EROSION
CONTROL PLAN**
WAIMEA CANYON DRIVE /
Kokee Road Improvements, Phase 2A
MILE POST 11.5 TO MILE POST 14.0
Federal-Aid Project No. STP-0550(005)
Scale: 1" = 20' Date: August 2022
SHEET No. 7 OF 13 SHEETS

11/07/22	Revised Demolition Extents & Callouts; Revised Engineer's Stamp
DATE	REVISION

COPY OF ORIGINAL TRACING

ADD 19

DIST. NO.	STATE	FED. AID PROJ. NO.	FISCAL YEAR	SHEET NO.	TOTAL SHEETS
KAUAI	HAW.	STP-0550(005)	2022	ADD. 20	127


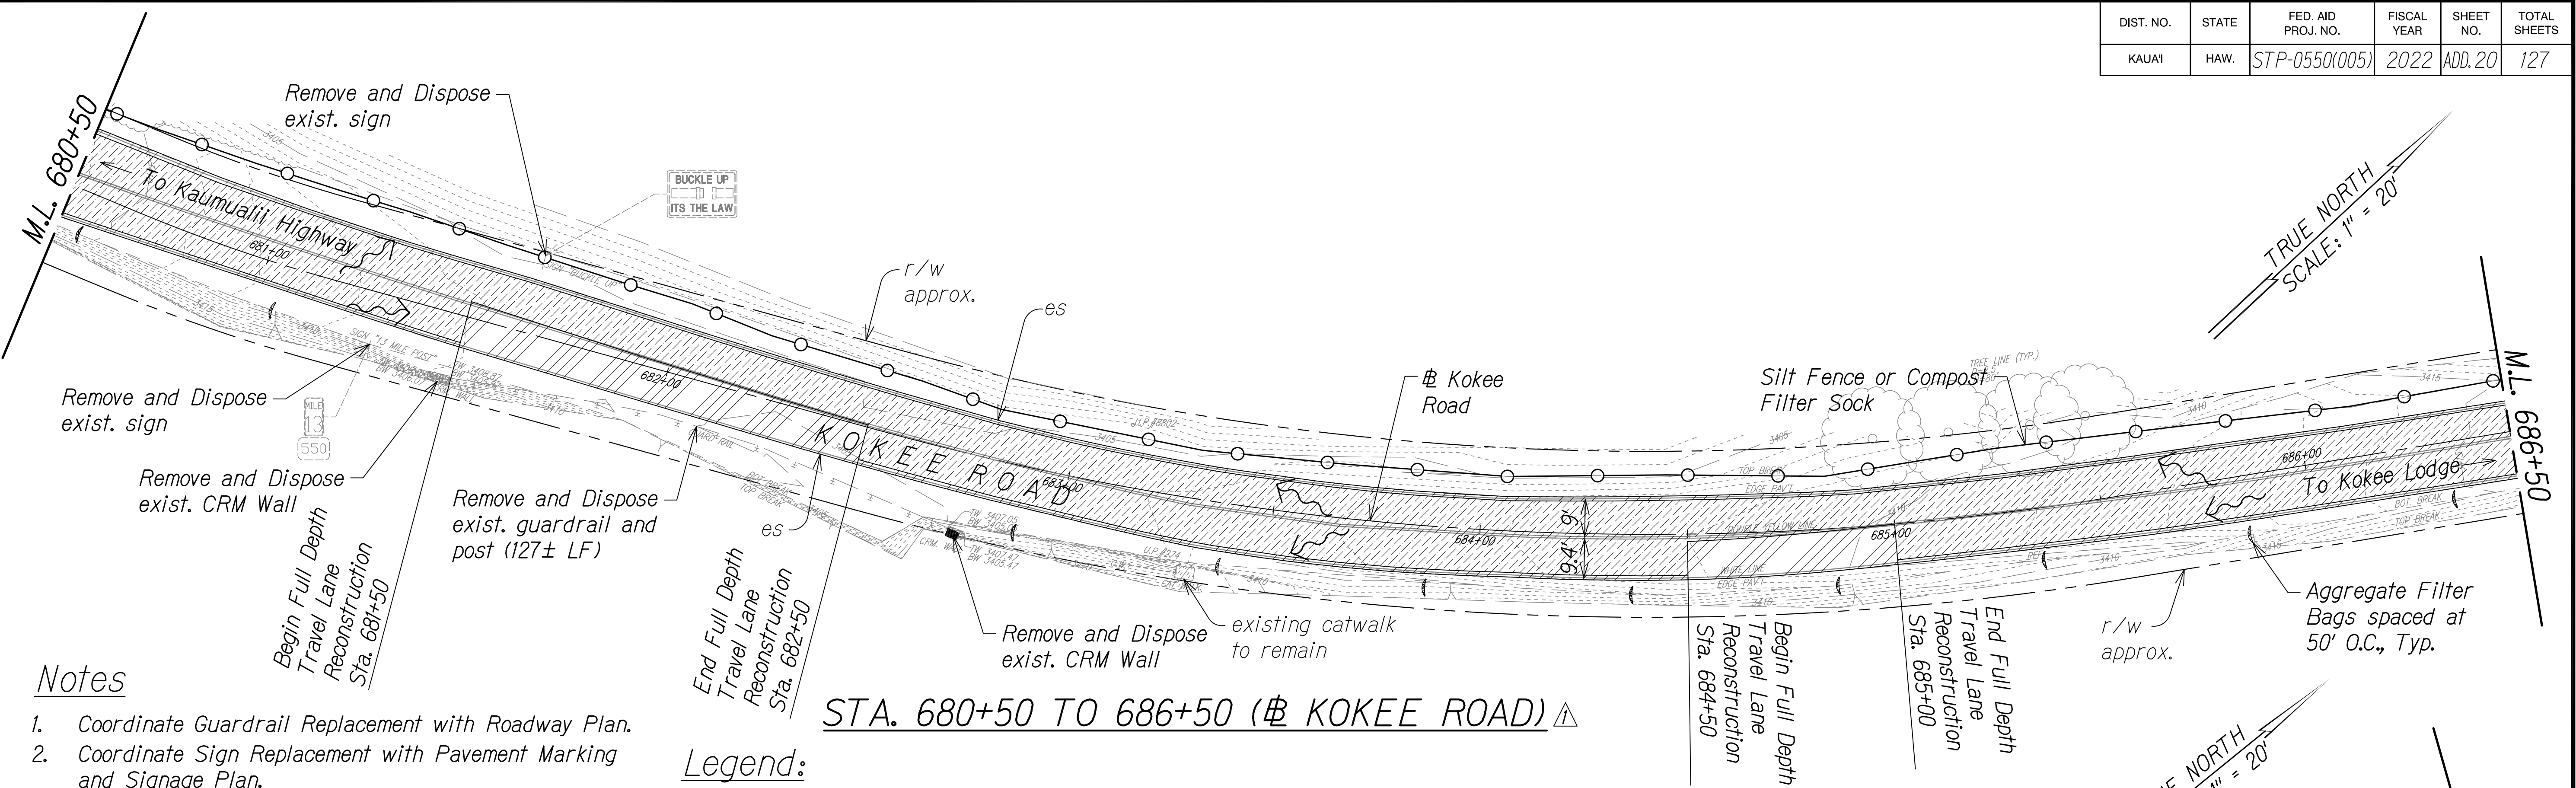


Notes

- Coordinate Guardrail Replacement with Roadway Plan.
- Coordinate Sign Replacement with Pavement Marking and Signage Plan.
- Sediment and Erosion Control BMP measures shown in the Contract Documents are minimum BMPs requirements and do not constitute an acceptable and/or complete Sediment and Erosion Control Plan. The Contractor shall incorporate additional BMPs based upon their means and methods considering site conditions and construction sequence in accordance with the Contract Documents including applicable permit document requirements. Cost shall be included in Pay Item 209.0100, Installation, Maintenance, Monitoring, and Removal of BMP.
- See Historical Preservation Notes.

Legend:


- Cold Plane Exist. A.C. 2" Pavement
- Full Depth Pavement Demolition
- Aggregate Filter Bag
- Surface Flow Direction
- Silt Fence or Compost Filter Sock

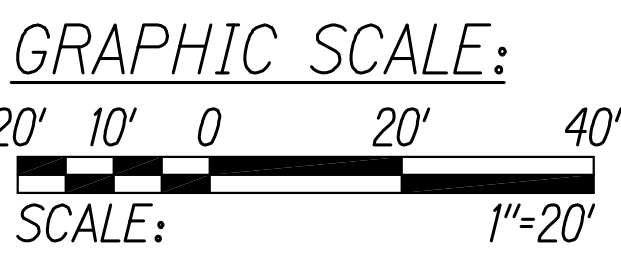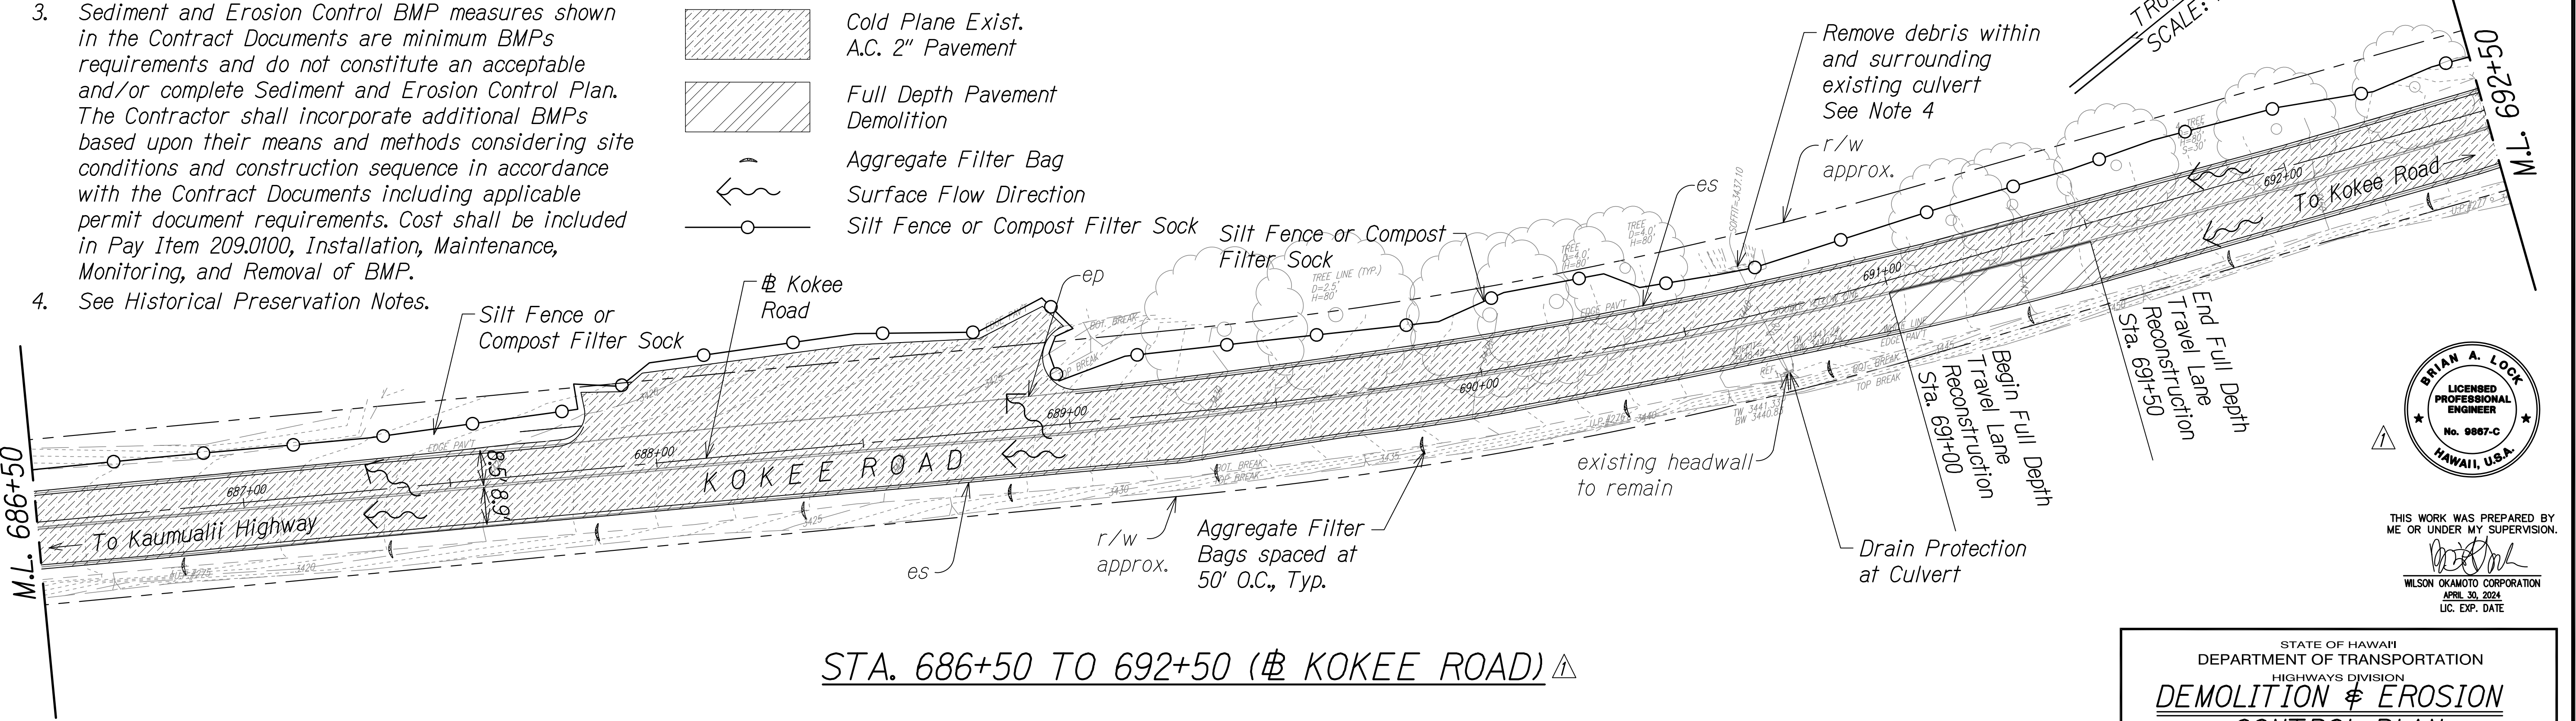

STATE OF HAWAII
DEPARTMENT OF TRANSPORTATION
HIGHWAYS DIVISION
DEMOLITION & EROSION CONTROL PLAN
WAIMEA CANYON DRIVE /
Kokee Road Improvements, Phase 2A
MILE POST 11.5 TO MILE POST 14.0
Federal-Aid Project No. STP-0550(005)
Scale: 1" = 20' Date: August 2022
SHEET No. 8 OF 13 SHEETS

DATE	REVISION
11/07/22	Revised Demolition Extents & Callouts; Revised Engineer's Stamp


DIST. NO.	STATE	FED. AID PROJ. NO.	FISCAL YEAR	SHEET NO.	TOTAL SHEETS
KAUAI	HAW.	STP-0550(005)	2022	ADD. 21	127

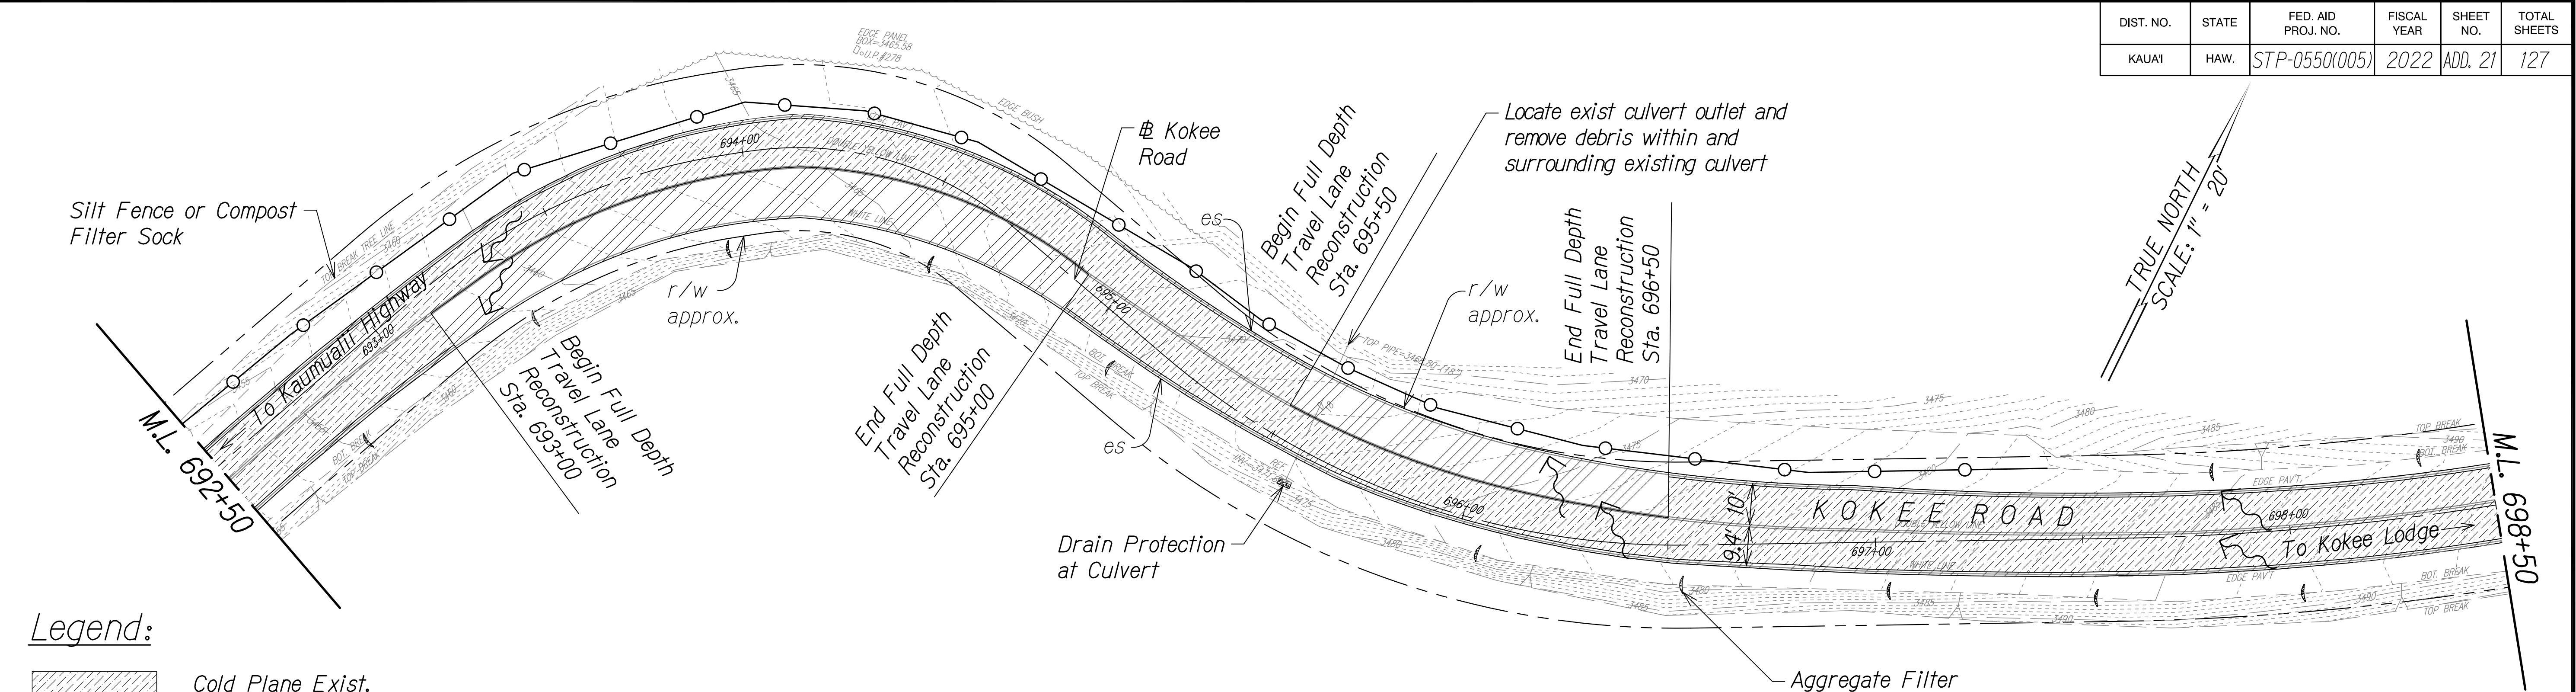

Legend:

- Cold Plane Exist. A.C. 2" Pavement
- Full Depth Pavement Demolition
- Aggregate Filter Bag
- Surface Flow Direction
- Silt Fence or Compost Filter Sock
- Drain Protection at Culvert


STA. 692+50 TO 698+50 (# KOKEE ROAD) ⚠

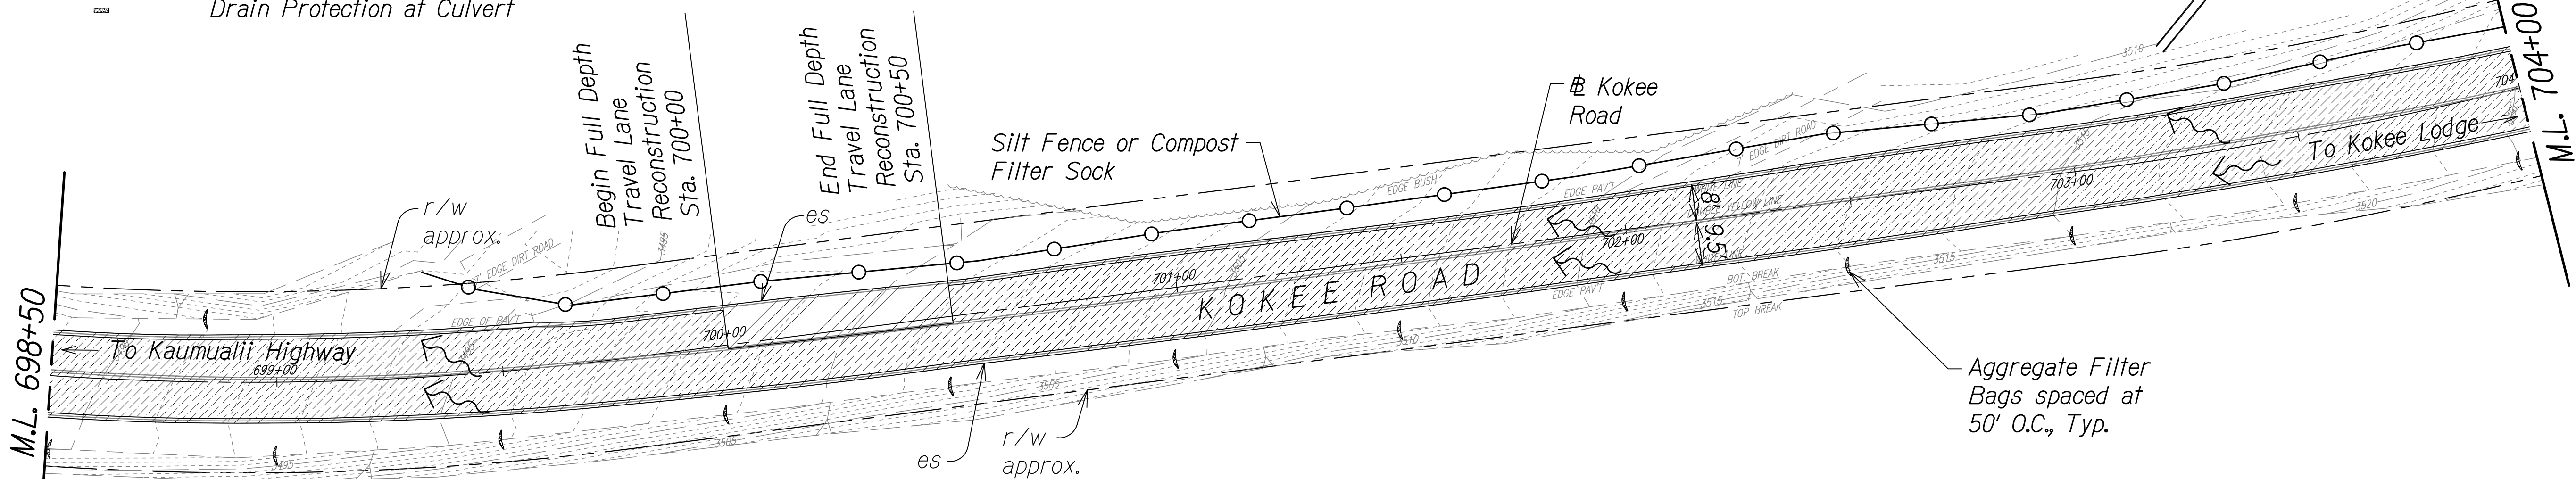


STA. 698+50 TO 704+00 (# KOKEE ROAD) ⚠

Notes

Sediment and Erosion Control BMP measures shown in the Contract Documents are minimum BMPs requirements and do not constitute an acceptable and/or complete Sediment and Erosion Control Plan. The Contractor shall incorporate additional BMPs based upon their means and methods considering site conditions and construction sequence in accordance with the Contract Documents including applicable permit document requirements. Cost shall be included in Pay Item 209.0100, Installation, Maintenance, Monitoring, and Removal of BMP.

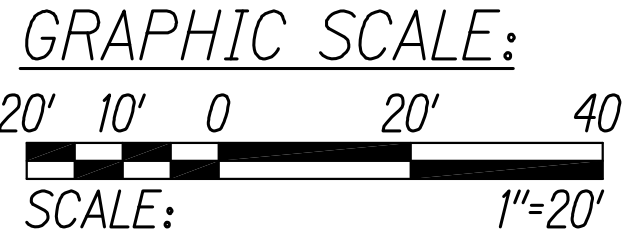

SURVEY PLOTTED BY	DATE
DESIGNED BY	
TRACED BY	
QUANTITIES BY	
CHECKED BY	

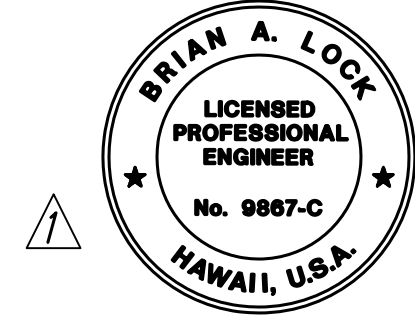

THIS WORK WAS PREPARED BY ME OR UNDER MY SUPERVISION.
WILSON OKAMOTO CORPORATION
APRIL 30, 2024
LIC. EXP. DATE


STATE OF HAWAII
DEPARTMENT OF TRANSPORTATION
HIGHWAYS DIVISION
DEMOLITION & EROSION CONTROL PLAN
WAIMEA CANYON DRIVE /
KOKEE ROAD IMPROVEMENTS, PHASE 2A
MILE POST 11.5 TO MILE POST 14.0
Federal-Aid Project No. STP-0550(005)
Scale: 1" = 20' Date: August 2022
SHEET No. 9 OF 13 SHEETS

DATE	REVISION
11/07/22	Revised Demolition Extents & Callouts; Revised Engineer's Stamp

COPY OF ORIGINAL TRACING

ADD 21

DIST. NO.	STATE	FED. AID PROJ. NO.	FISCAL YEAR	SHEET NO.	TOTAL SHEETS
KAUAI	HAW.	STP-0550(005)	2022	ADD. 22	127

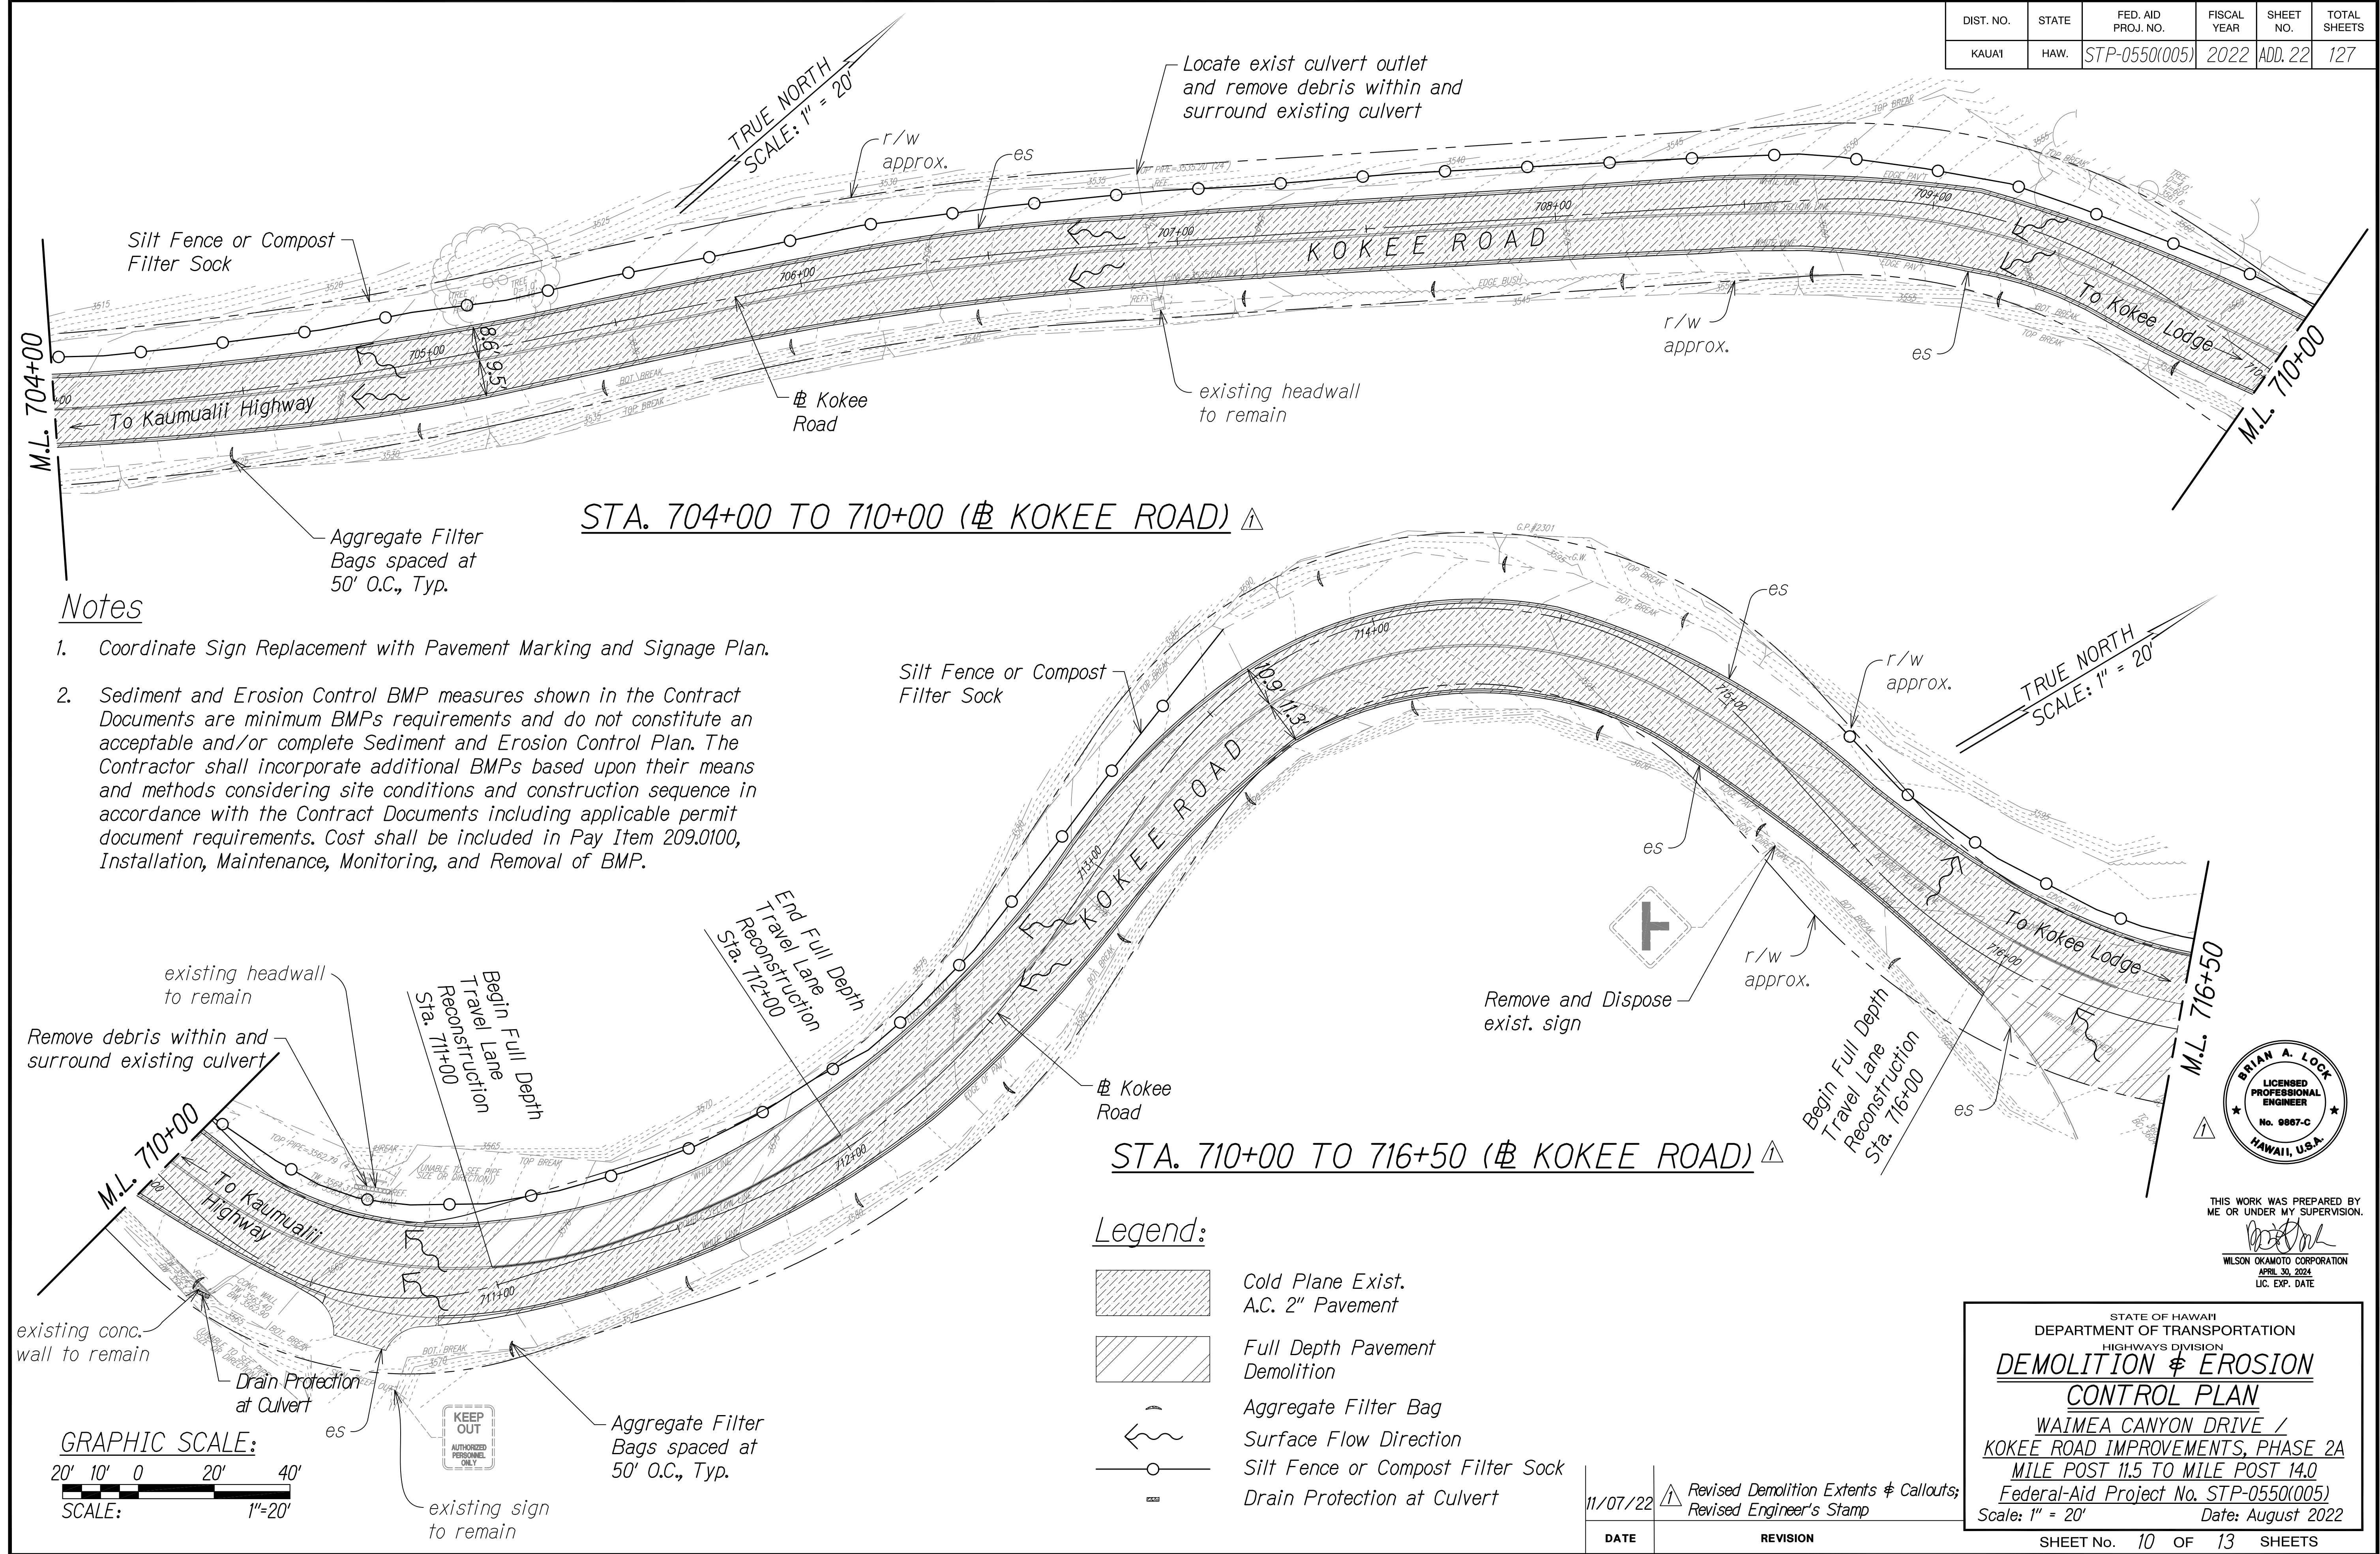

Notes

1. Coordinate Sign Replacement with Pavement Marking and Signage Plan.
2. Sediment and Erosion Control BMP measures shown in the Contract Documents are minimum BMPs requirements and do not constitute an acceptable and/or complete Sediment and Erosion Control Plan. The Contractor shall incorporate additional BMPs based upon their means and methods considering site conditions and construction sequence in accordance with the Contract Documents including applicable permit document requirements. Cost shall be included in Pay Item 209.0100, Installation, Maintenance, Monitoring, and Removal of BMP.


Legend:

- Cold Plane Exist. A.C. 2" Pavement
- Full Depth Pavement Demolition
- Aggregate Filter Bag
- Surface Flow Direction
- Silt Fence or Compost Filter Sock
- Drain Protection at Culvert




GRAPHIC SCALE:
20' 10' 0 20' 40'
SCALE: 1"=20'


STATE OF HAWAII
DEPARTMENT OF TRANSPORTATION
HIGHWAYS DIVISION
DEMOLITION & EROSION CONTROL PLAN
WAIMEA CANYON DRIVE /
Kokee Road Improvements, Phase 2A
MILE POST 11.5 TO MILE POST 14.0
Federal-Aid Project No. STP-0550(005)
Scale: 1" = 20' Date: August 2022
SHEET No. 10 OF 13 SHEETS

DIST. NO.	STATE	FED. AID PROJ. NO.	FISCAL YEAR	SHEET NO.	TOTAL SHEETS
KAUAI	HAW.	STP-0550(005)	2022	ADD. 23	127

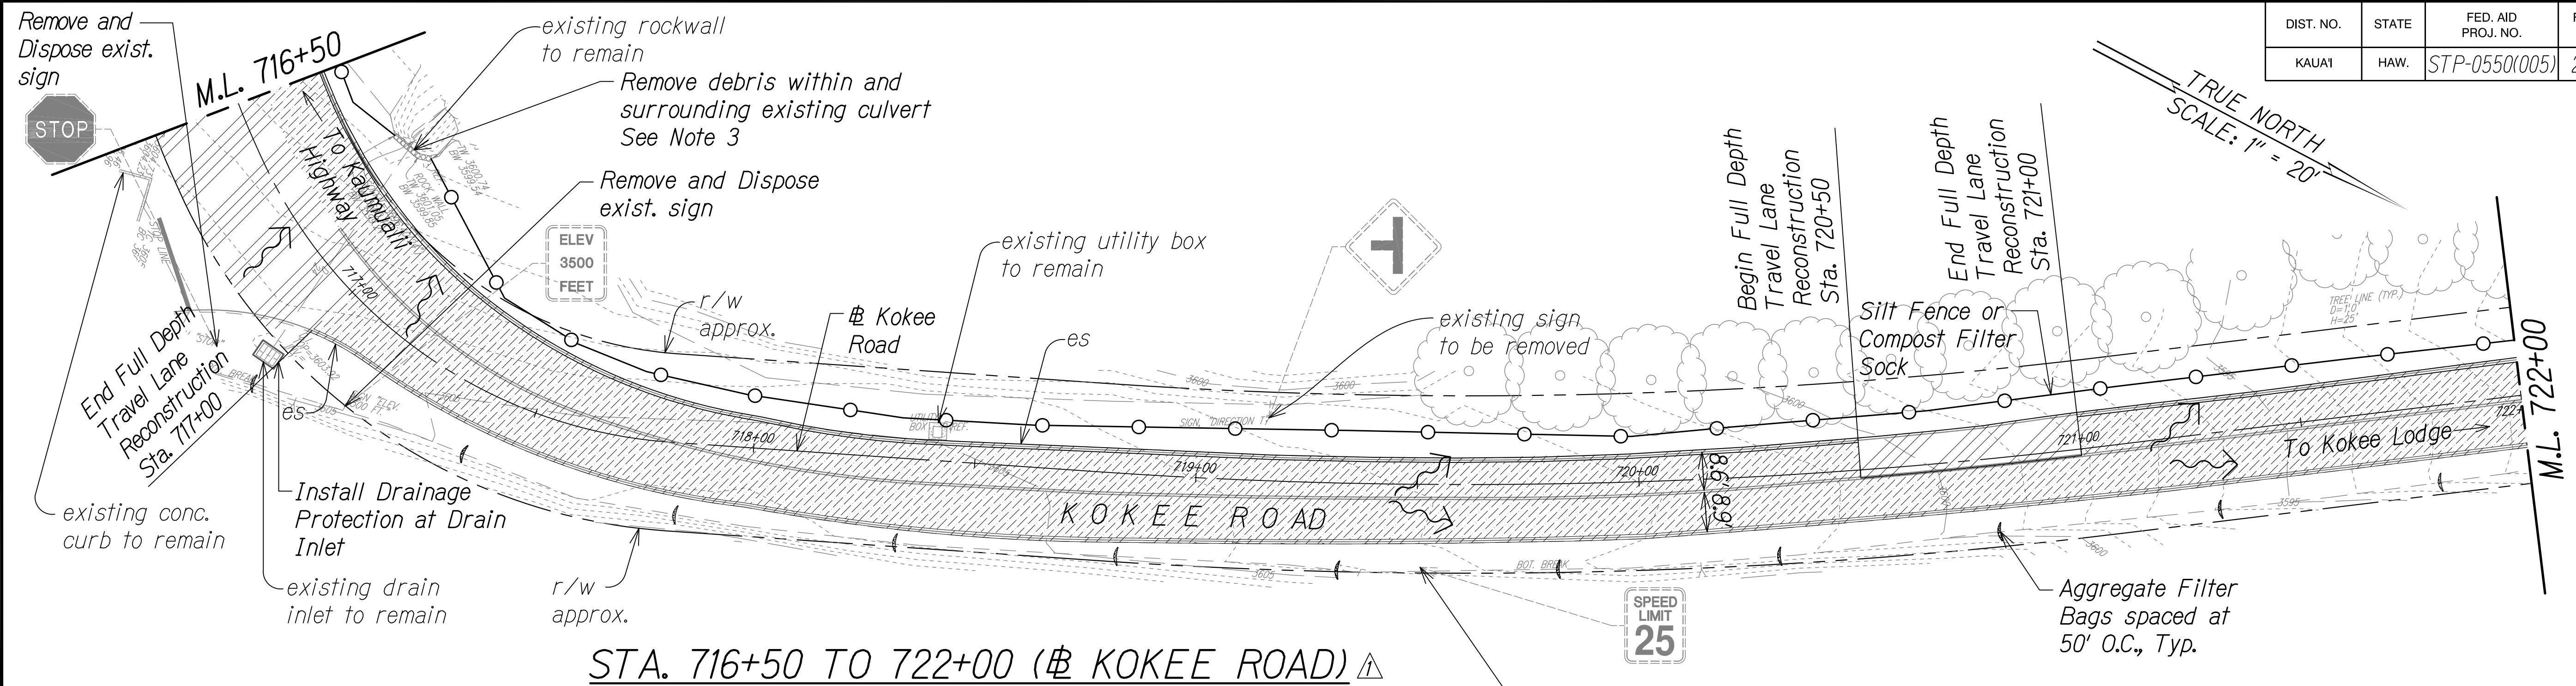

Legend:

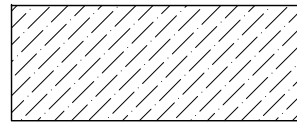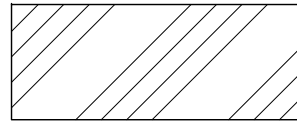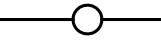-  Cold Plane Exist. A.C. 2" Pavement
-  Full Depth Pavement Demolition
-  Aggregate Filter Bag Surface Flow Direction
-  Silt Fence or Compost Filter Sock

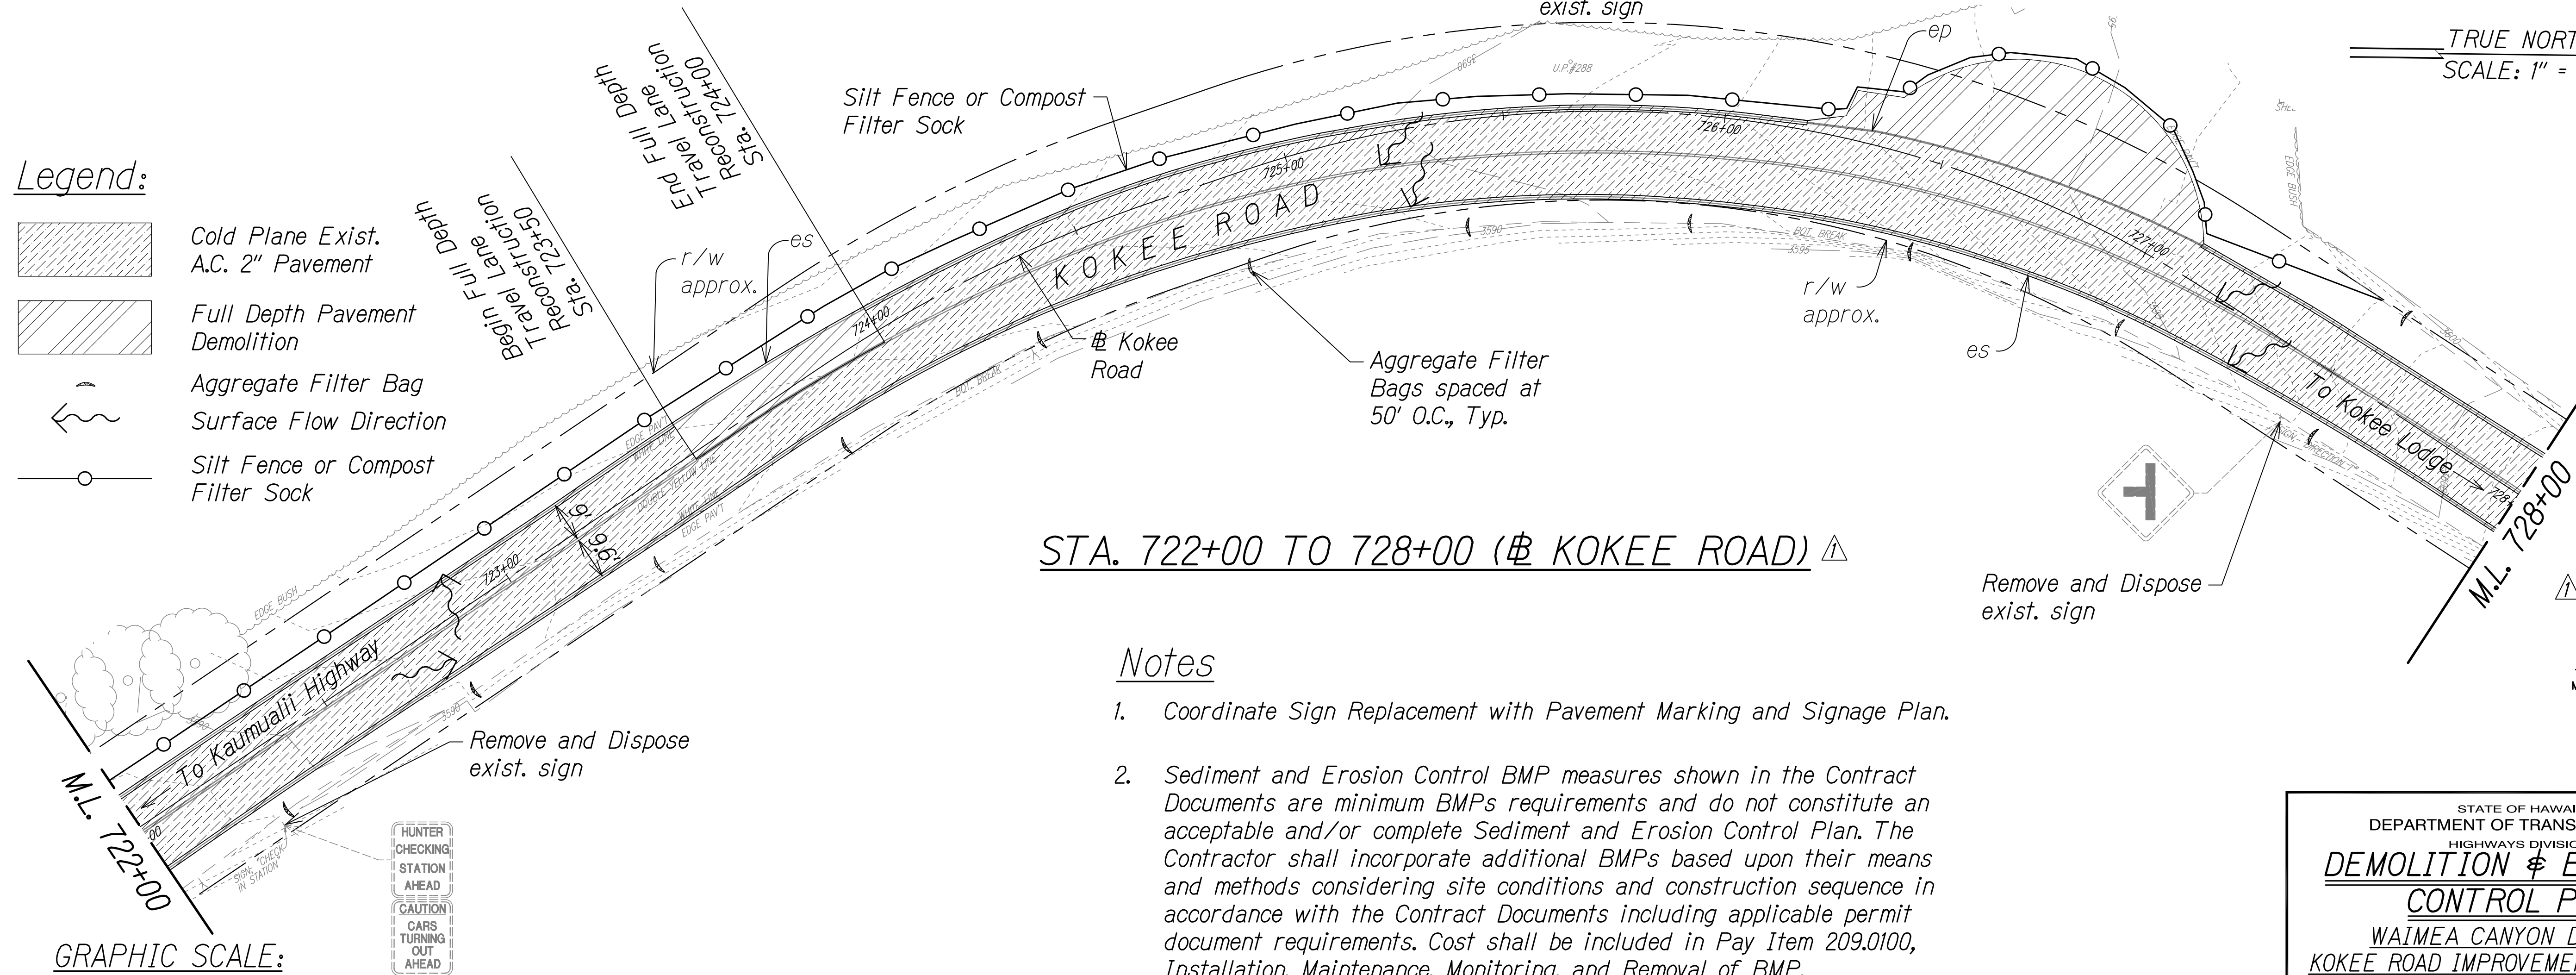


STA. 722+00 TO 728+00 (# KOKEE ROAD) ⚠

Notes

- Coordinate Sign Replacement with Pavement Marking and Signage Plan.
- Sediment and Erosion Control BMP measures shown in the Contract Documents are minimum BMPs requirements and do not constitute an acceptable and/or complete Sediment and Erosion Control Plan. The Contractor shall incorporate additional BMPs based upon their means and methods considering site conditions and construction sequence in accordance with the Contract Documents including applicable permit document requirements. Cost shall be included in Pay Item 209.0100, Installation, Maintenance, Monitoring, and Removal of BMP.
- See Historical Preservation Notes.

SURVEY PLOTTED BY	DATE
DESIGNED BY	
TRACED BY	
NOTED BY	
CHECKED BY	
ORIGINAL PLAN	No.

GRAPHIC SCALE:
20' 10' 0 20' 40'
SCALE: 1"=20'

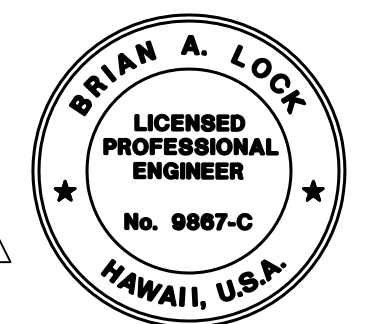

THIS WORK WAS PREPARED BY
ME OR UNDER MY SUPERVISION.
[Signature]
WILSON OKAMOTO CORPORATION
APRIL 30, 2024
LIC. EXP. DATE


STATE OF HAWAII DEPARTMENT OF TRANSPORTATION HIGHWAYS DIVISION DEMOLITION & EROSION CONTROL PLAN WAIMEA CANYON DRIVE / KOKEE ROAD IMPROVEMENTS, PHASE 2A MILE POST 11.5 TO MILE POST 14.0 Federal-Aid Project No. STP-0550(005) Scale: 1" = 20' Date: August 2022
SHEET No. 11 OF 13 SHEETS

11/07/22	Revised Demolition Extents & Callouts; Revised Engineer's Stamp
DATE	REVISION

COPY OF ORIGINAL TRACING

ADD 23


DIST. NO.	STATE	FED. AID PROJ. NO.	FISCAL YEAR	SHEET NO.	TOTAL SHEETS
KAUAI	HAW.	STP-0550(005)	2022	ADD. 24	127

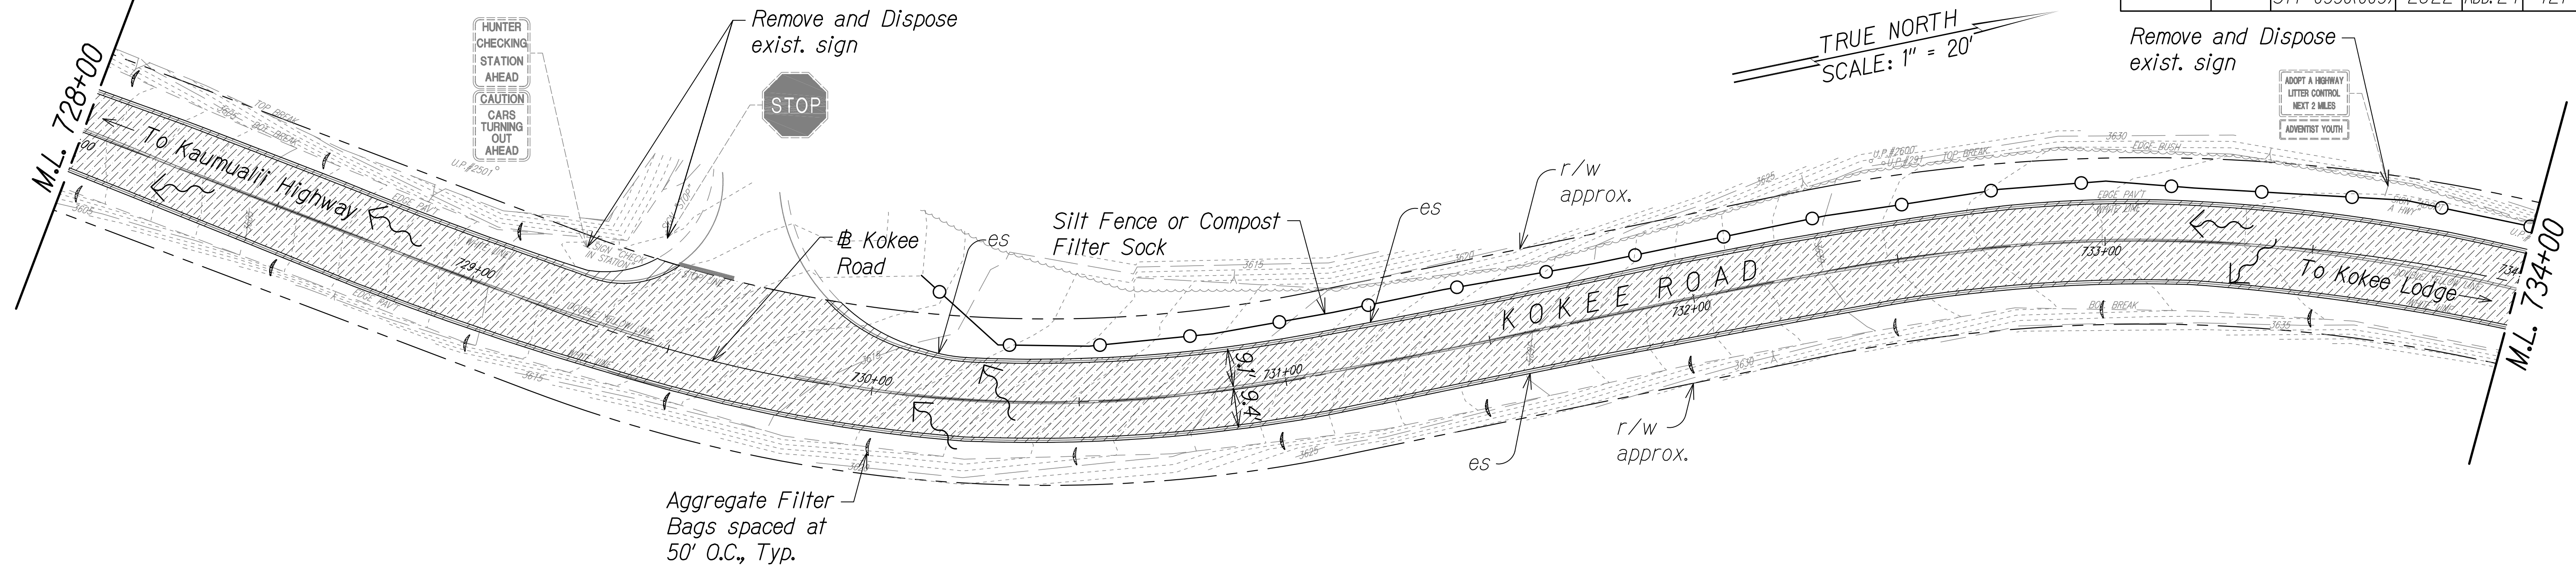

STA. 728+00 TO 734+00 (# KOKEE ROAD) ▲

Legend:


- Cold Plane Exist. A.C. 2" Pavement
- Full Depth Pavement Demolition
- Aggregate Filter Bag
- Surface Flow Direction
- Silt Fence or Compost Filter Sock

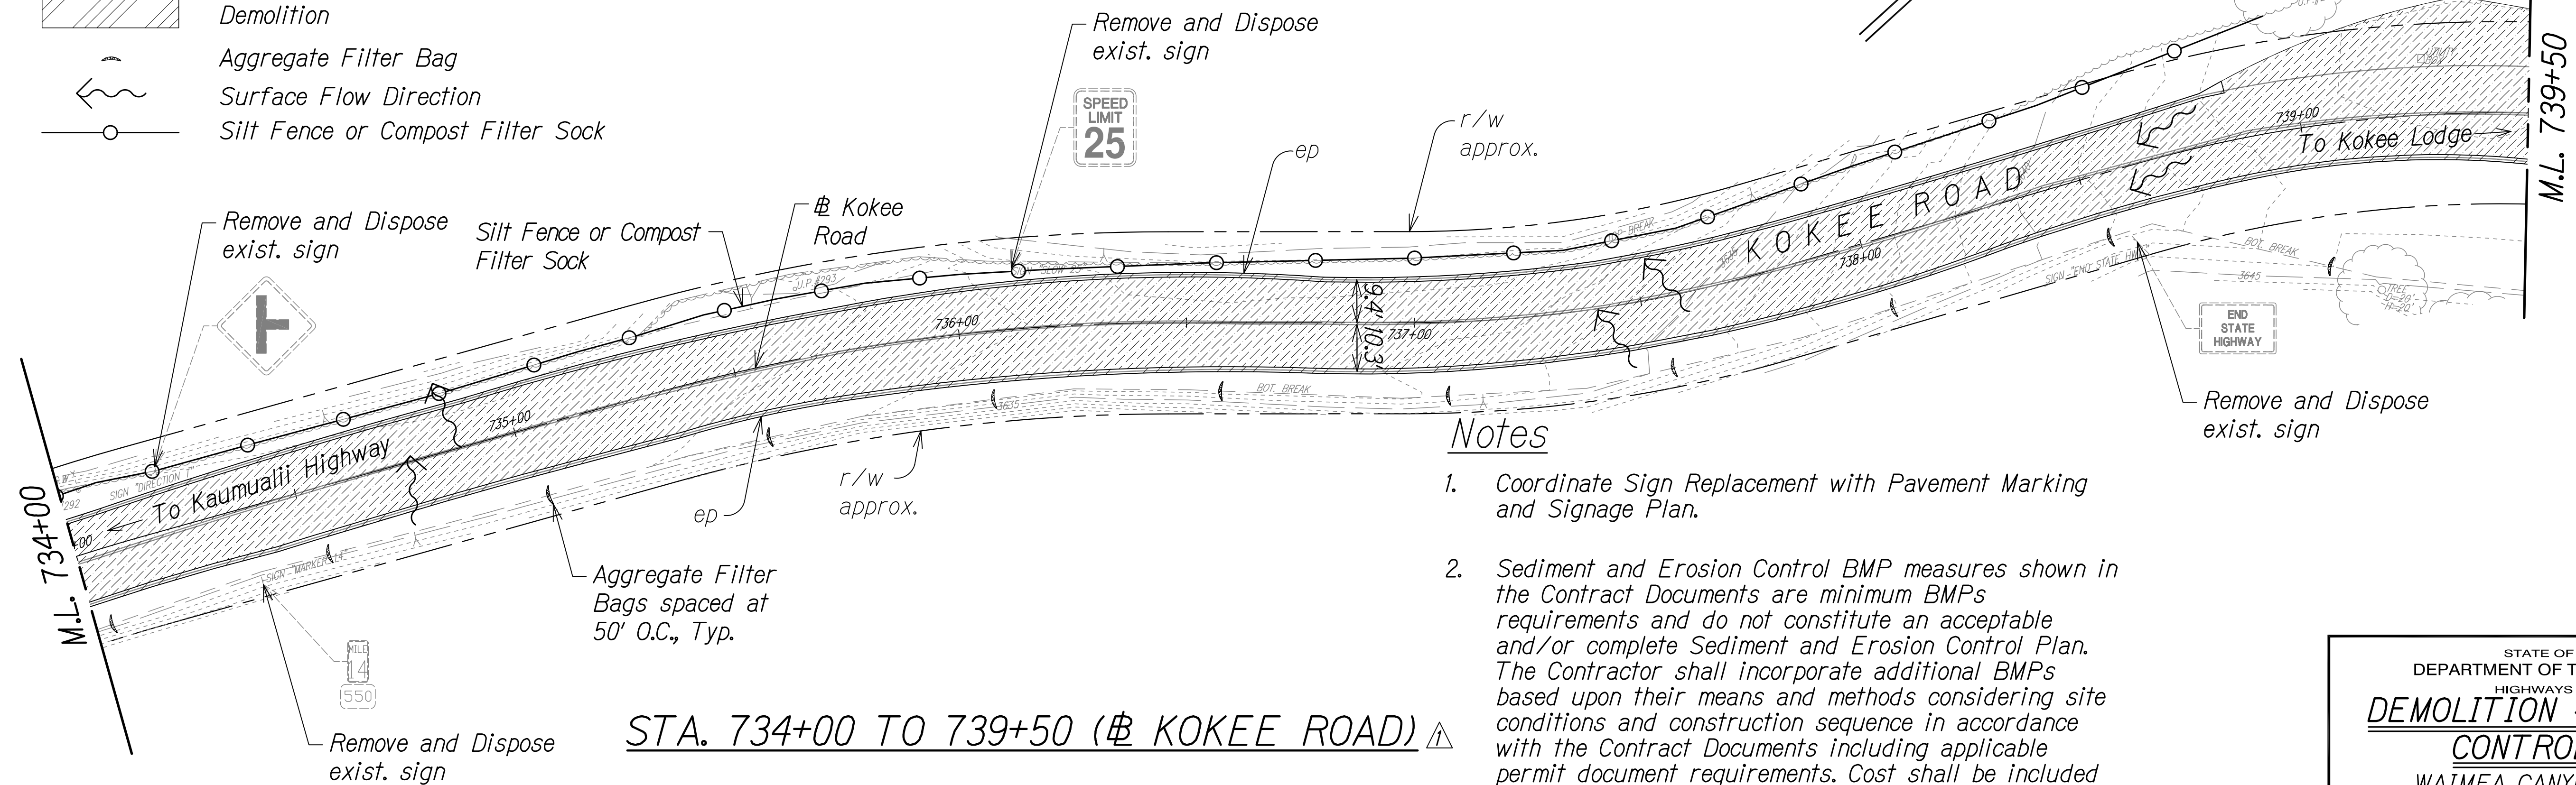

STA. 734+00 TO 739+50 (# KOKEE ROAD) ▲

Notes

- Coordinate Sign Replacement with Pavement Marking and Signage Plan.
- Sediment and Erosion Control BMP measures shown in the Contract Documents are minimum BMPs requirements and do not constitute an acceptable and/or complete Sediment and Erosion Control Plan. The Contractor shall incorporate additional BMPs based upon their means and methods considering site conditions and construction sequence in accordance with the Contract Documents including applicable permit document requirements. Cost shall be included in Pay Item 209.0100, Installation, Maintenance, Monitoring, and Removal of BMP.

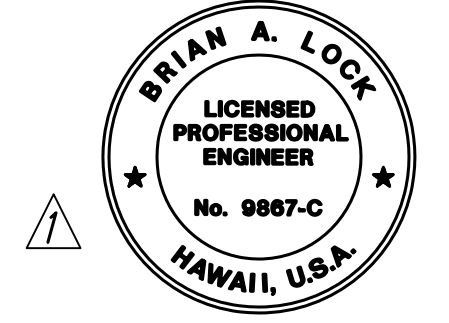


THIS WORK WAS PREPARED BY ME OR UNDER MY SUPERVISION.
WILSON OKAMOTO CORPORATION
APRIL 30, 2024
LIC. EXP. DATE

STATE OF HAWAII
DEPARTMENT OF TRANSPORTATION
HIGHWAYS DIVISION
DEMOLITION & EROSION CONTROL PLAN
WAIMEA CANYON DRIVE /
KOKEE ROAD IMPROVEMENTS, PHASE 2A
MILE POST 11.5 TO MILE POST 14.0
Federal-Aid Project No. STP-0550(005)
Scale: 1" = 20' Date: August 2022
SHEET No. 12 OF 13 SHEETS

DATE	REVISION
11/07/22	▲ Revised Demolition Extents & Callouts; Revised Engineer's Stamp

DIST. NO.	STATE	FED. AID PROJ. NO.	FISCAL YEAR	SHEET NO.	TOTAL SHEETS
KAUAI	HAW.	STP-0550(005)	2022	ADD. 25	127

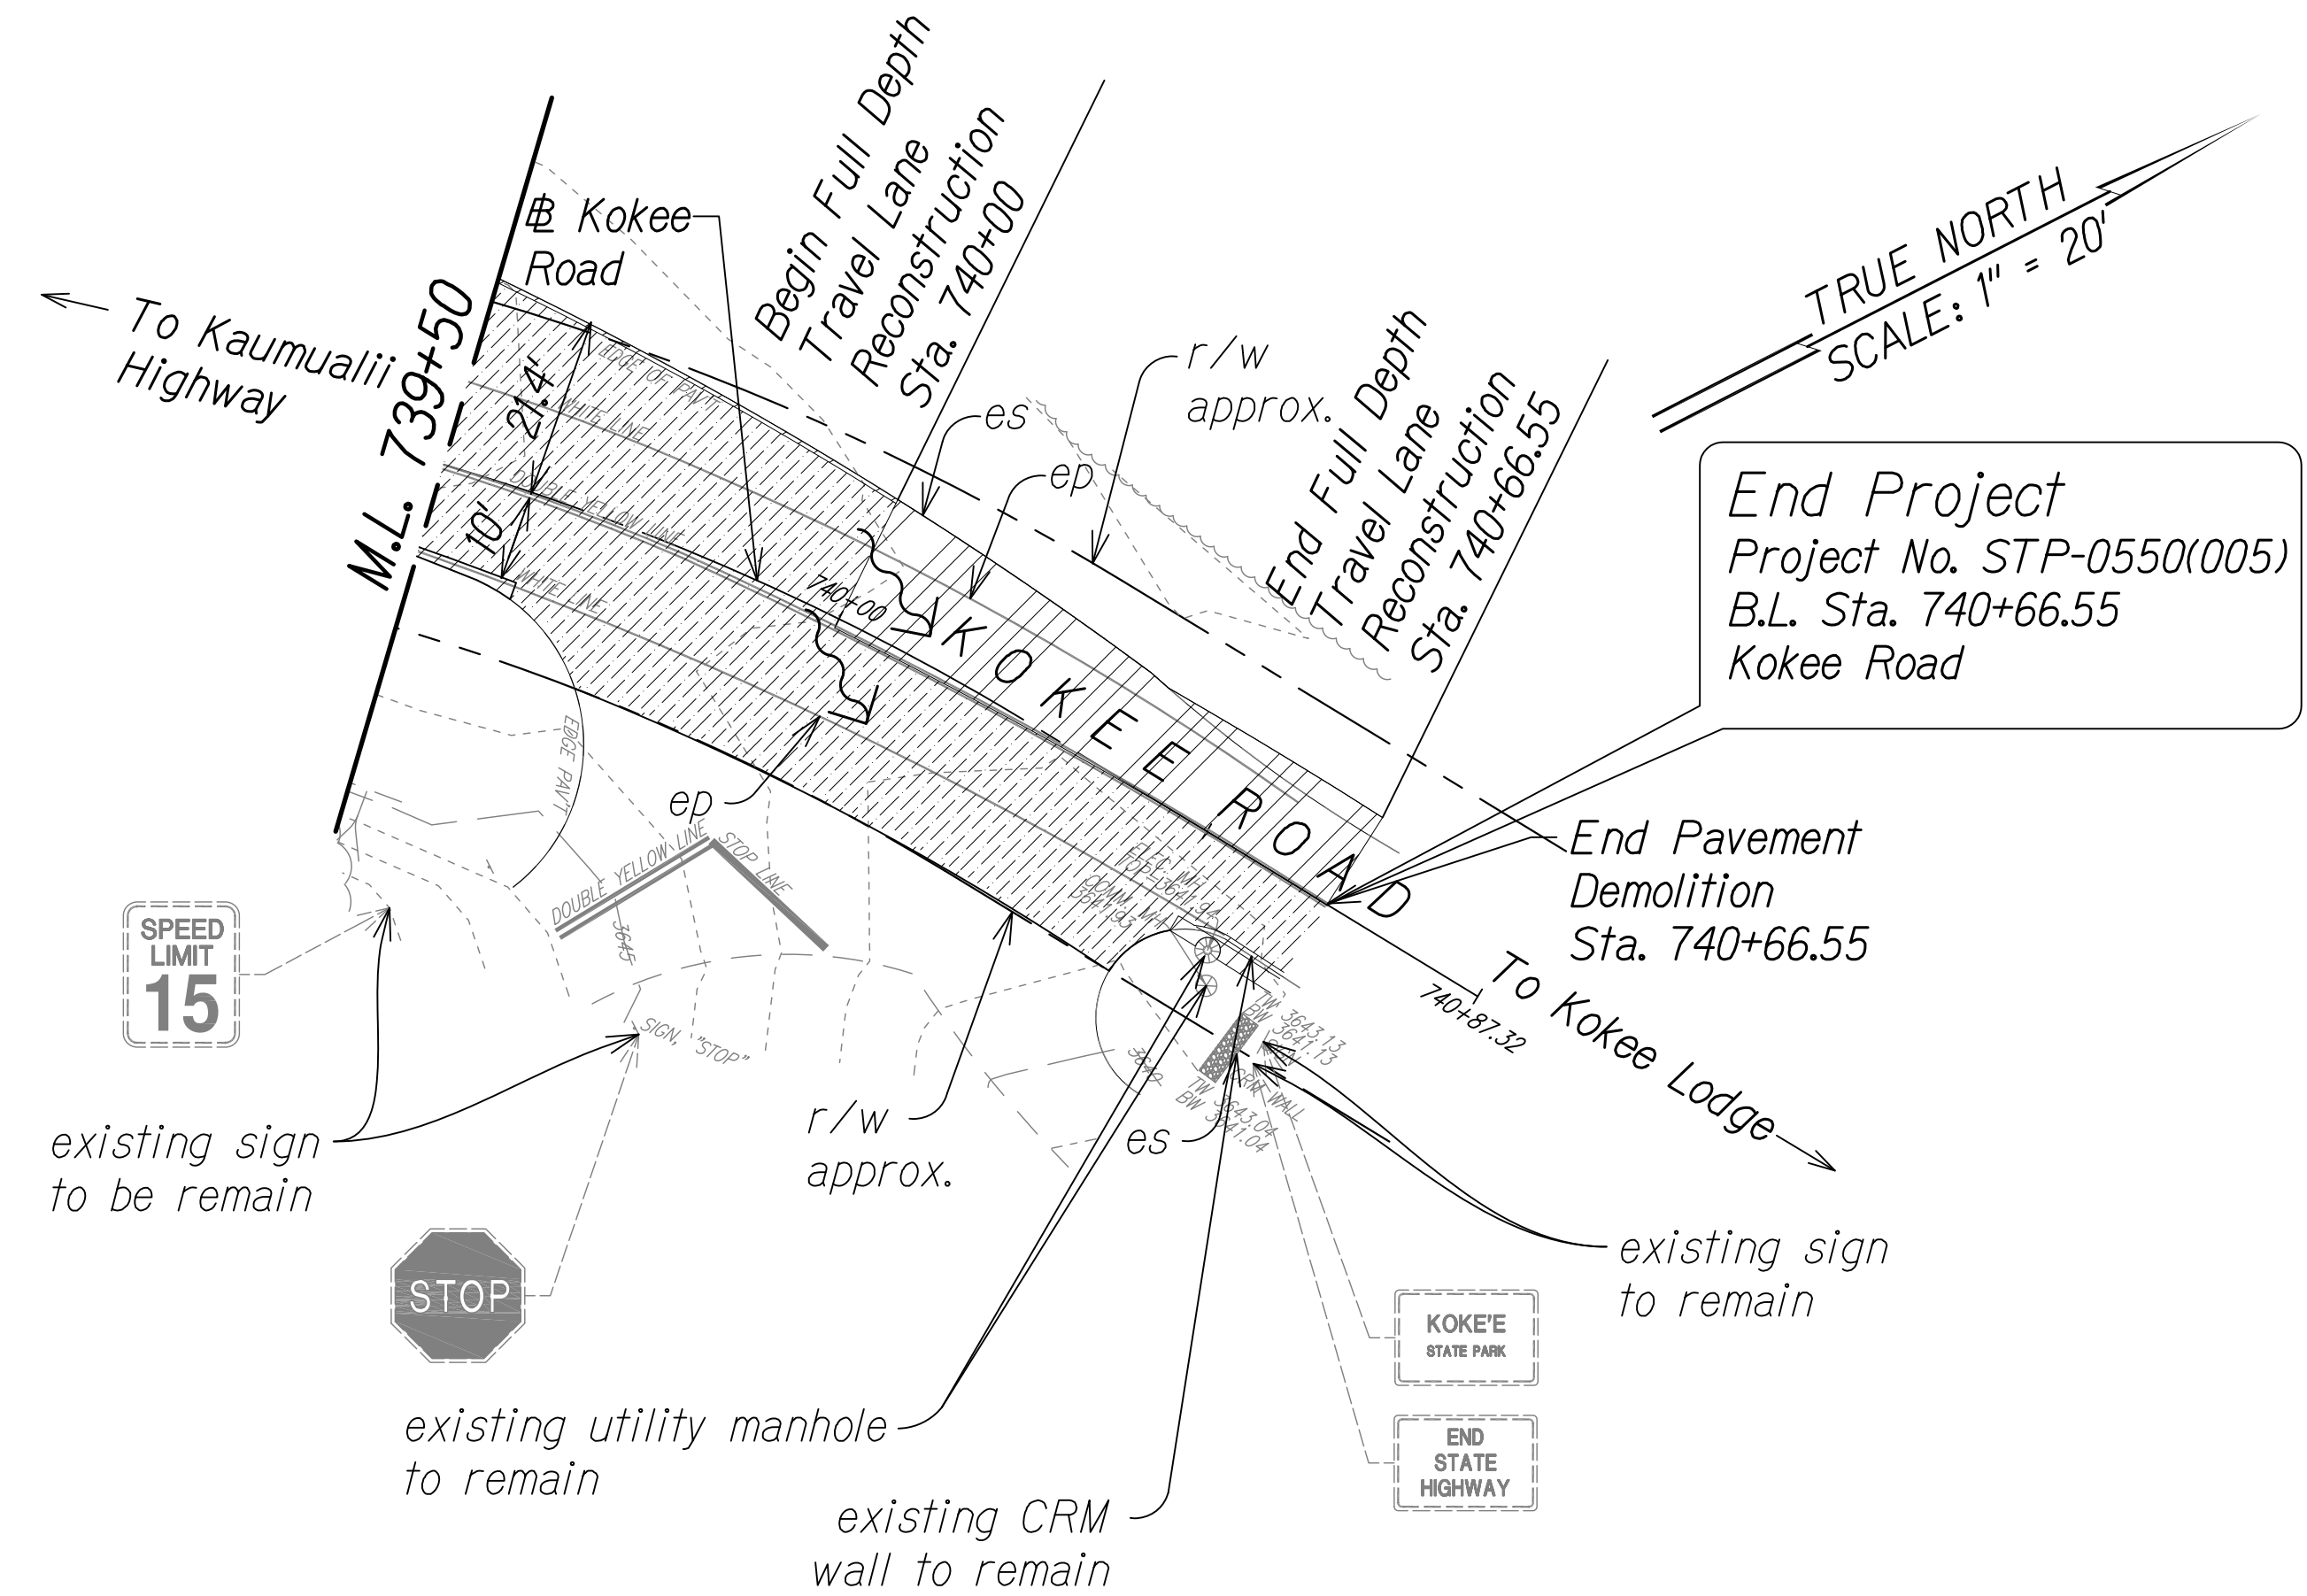

Notes


- Coordinate Sign Replacement with Pavement Marking and Signage Plan.
- Sediment and Erosion Control BMP measures shown in the Contract Documents are minimum BMPs requirements and do not constitute an acceptable and/or complete Sediment and Erosion Control Plan. The Contractor shall incorporate additional BMPs based upon their means and methods considering site conditions and construction sequence in accordance with the Contract Documents including applicable permit document requirements. Cost shall be included in Pay Item 209.0100, Installation, Maintenance, Monitoring, and Removal of BMP.

Legend:

- Cold Plane Exist. A.C. 2" Pavement
- Full Depth Pavement Demolition
- Surface Flow Direction



STA. 739+50 TO 740+66.55 (# KOKEE ROAD) ⚠

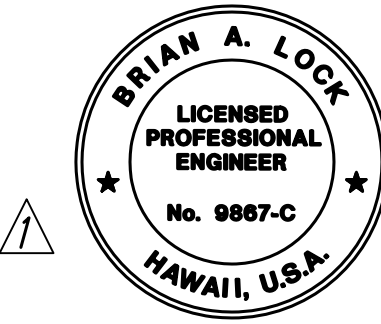

THIS WORK WAS PREPARED BY ME OR UNDER MY SUPERVISION.
WILSON OKAMOTO CORPORATION
APRIL 30, 2024
LIC. EXP. DATE

STATE OF HAWAII
DEPARTMENT OF TRANSPORTATION
HIGHWAYS DIVISION
**DEMOLITION & EROSION
CONTROL PLAN**
WAIMEA CANYON DRIVE /
KOKEE ROAD IMPROVEMENTS, PHASE 2A
MILE POST 11.5 TO MILE POST 14.0
Federal-Aid Project No. STP-0550(005)
Scale: 1" = 20' Date: August 2022

11/07/22 ⚠ Revised Demolition Extents & Callouts;
Revised Engineer's Stamp

DATE REVISION

SHEET No. 13 OF 13 SHEETS