

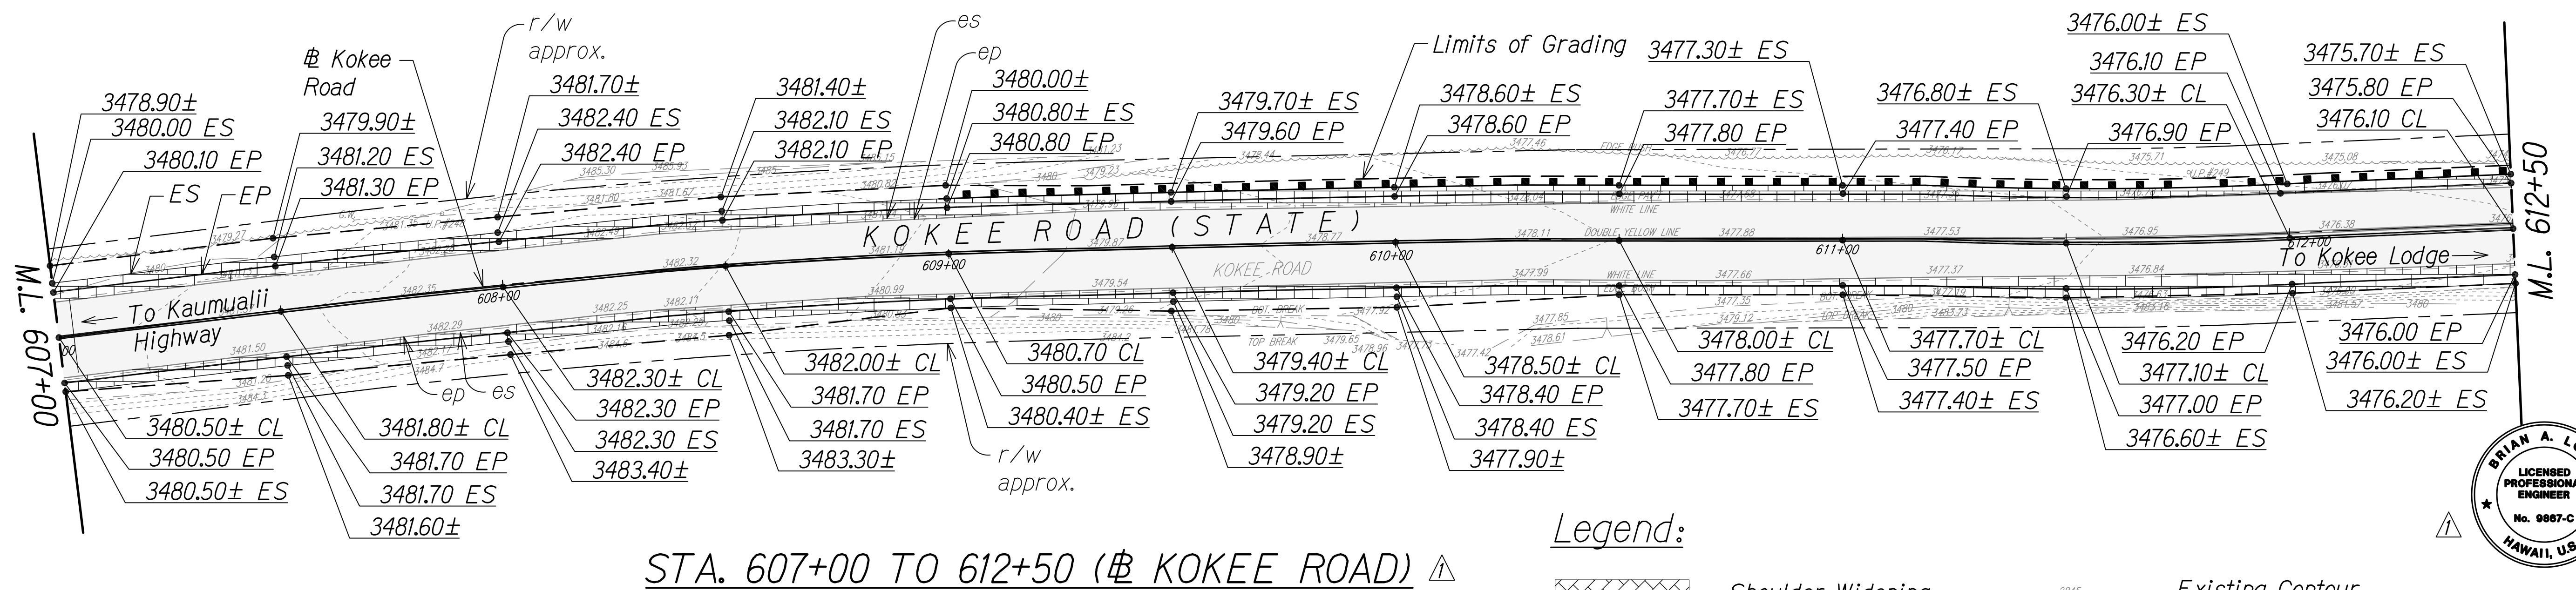


DIST. NO.	STATE	FED. AID PROJ. NO.	FISCAL YEAR	SHEET NO.	TOTAL SHEETS
KAUAI	HAW.	STP-0550(005)	2022	ADD. 39	127

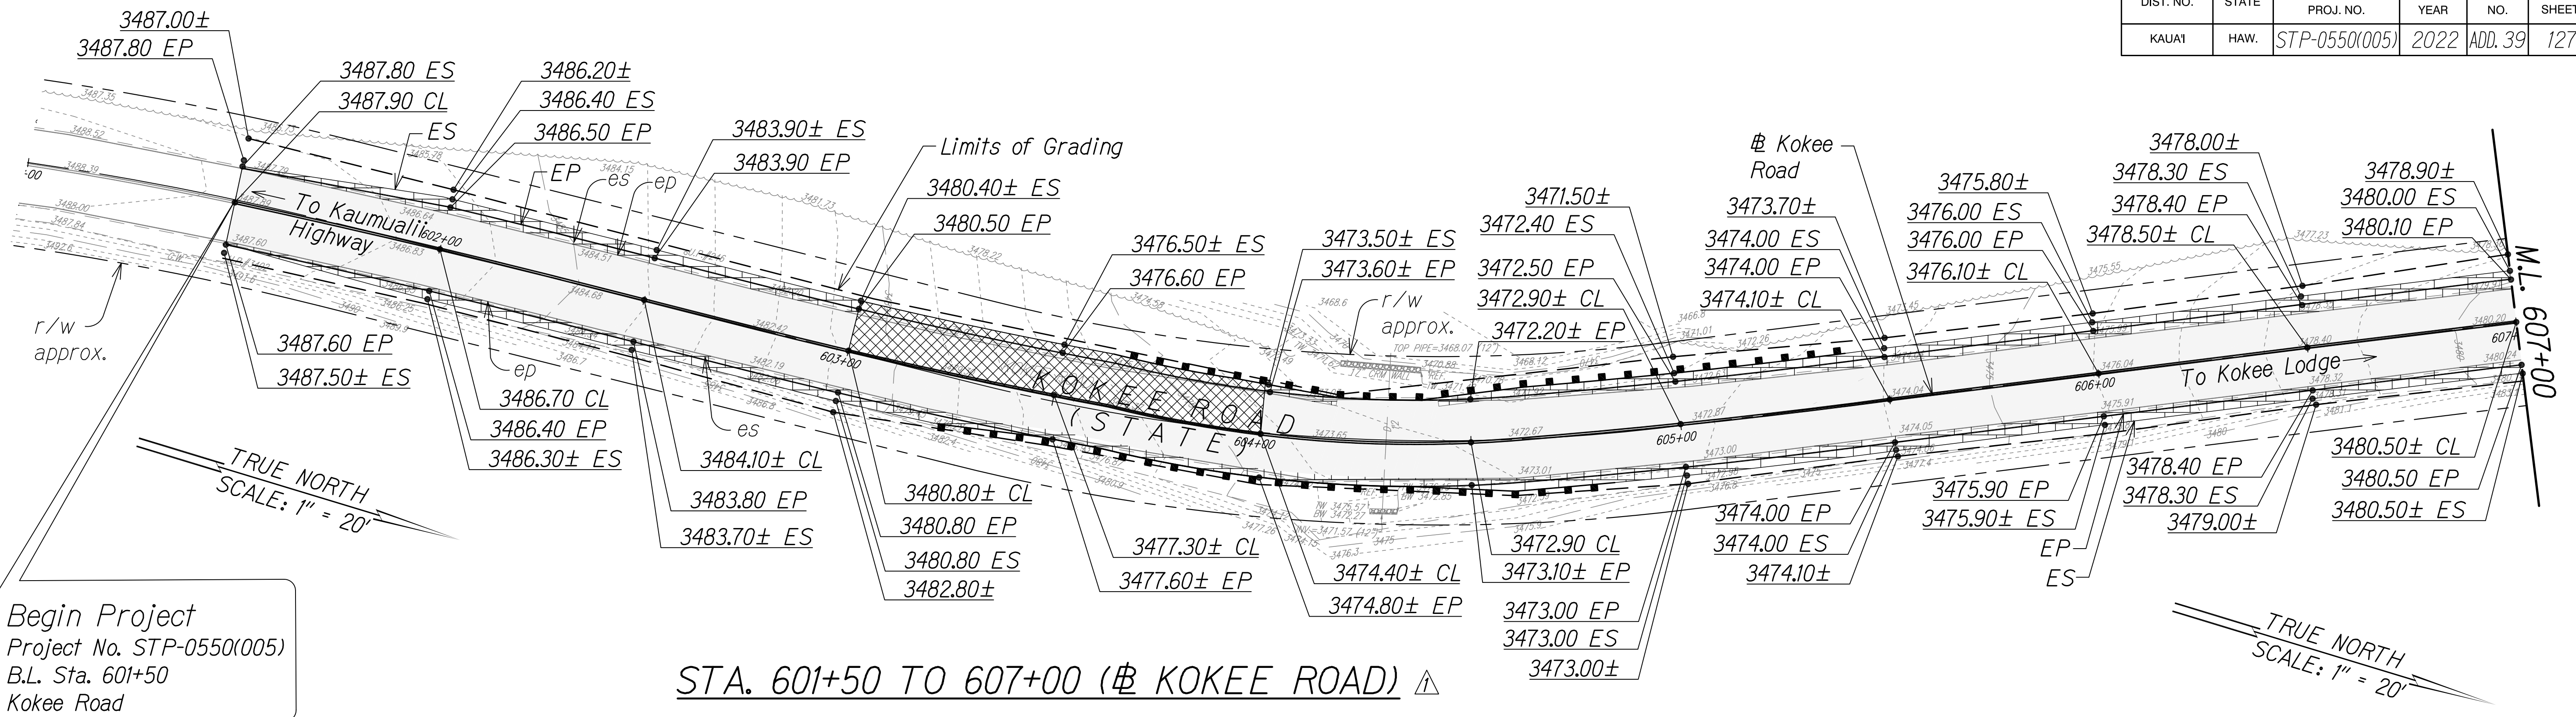


Legend:

- Shoulder Widening Pavement
- Full Depth Pavement Reconstruction
- 2" Asphalt Pavement
- Limits of Grading
- Existing Contour
- Existing Elevation
- Proposed Elevation

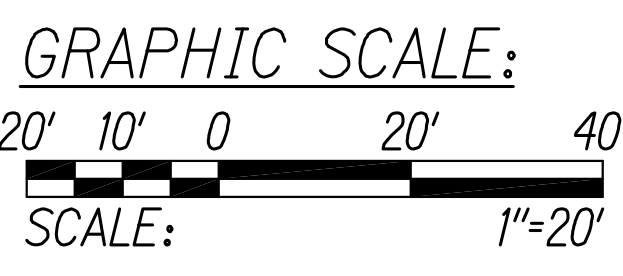

SURVEY PLOTTED BY	DATE
DESIGNED BY	
TRACED BY	
NOTED BY	
CHECKED BY	

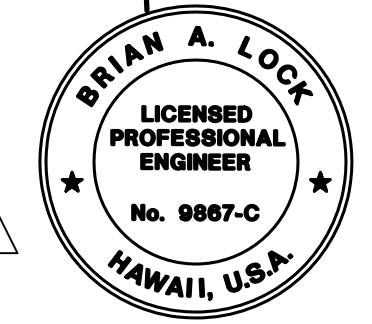

THIS WORK WAS PREPARED BY ME OR UNDER MY SUPERVISION.
WILSON OKAMOTO CORPORATION
APRIL 30, 2024
LIC. EXP. DATE

STATE OF HAWAII
DEPARTMENT OF TRANSPORTATION
HIGHWAYS DIVISION

GRADING PLAN

WAIMEA CANYON DRIVE /
KOKEE ROAD IMPROVEMENTS, PHASE 2A
MILE POST 11.5 TO MILE POST 14.0
Federal-Aid Project No. STP-0550(005)
Scale: 1" = 20' Date: August 2022


SHEET No. 1 OF 13 SHEETS

DATE	REVISION
11/07/22	Revised Grading & Callouts; Revised Engineer's Stamp

COPY OF ORIGINAL TRACING

ADD 39



DIST. NO.	STATE	FED. AID PROJ. NO.	FISCAL YEAR	SHEET NO.	TOTAL SHEETS
KAUAI	HAW.	STP-0550(005)	2022	ADD. 40	127

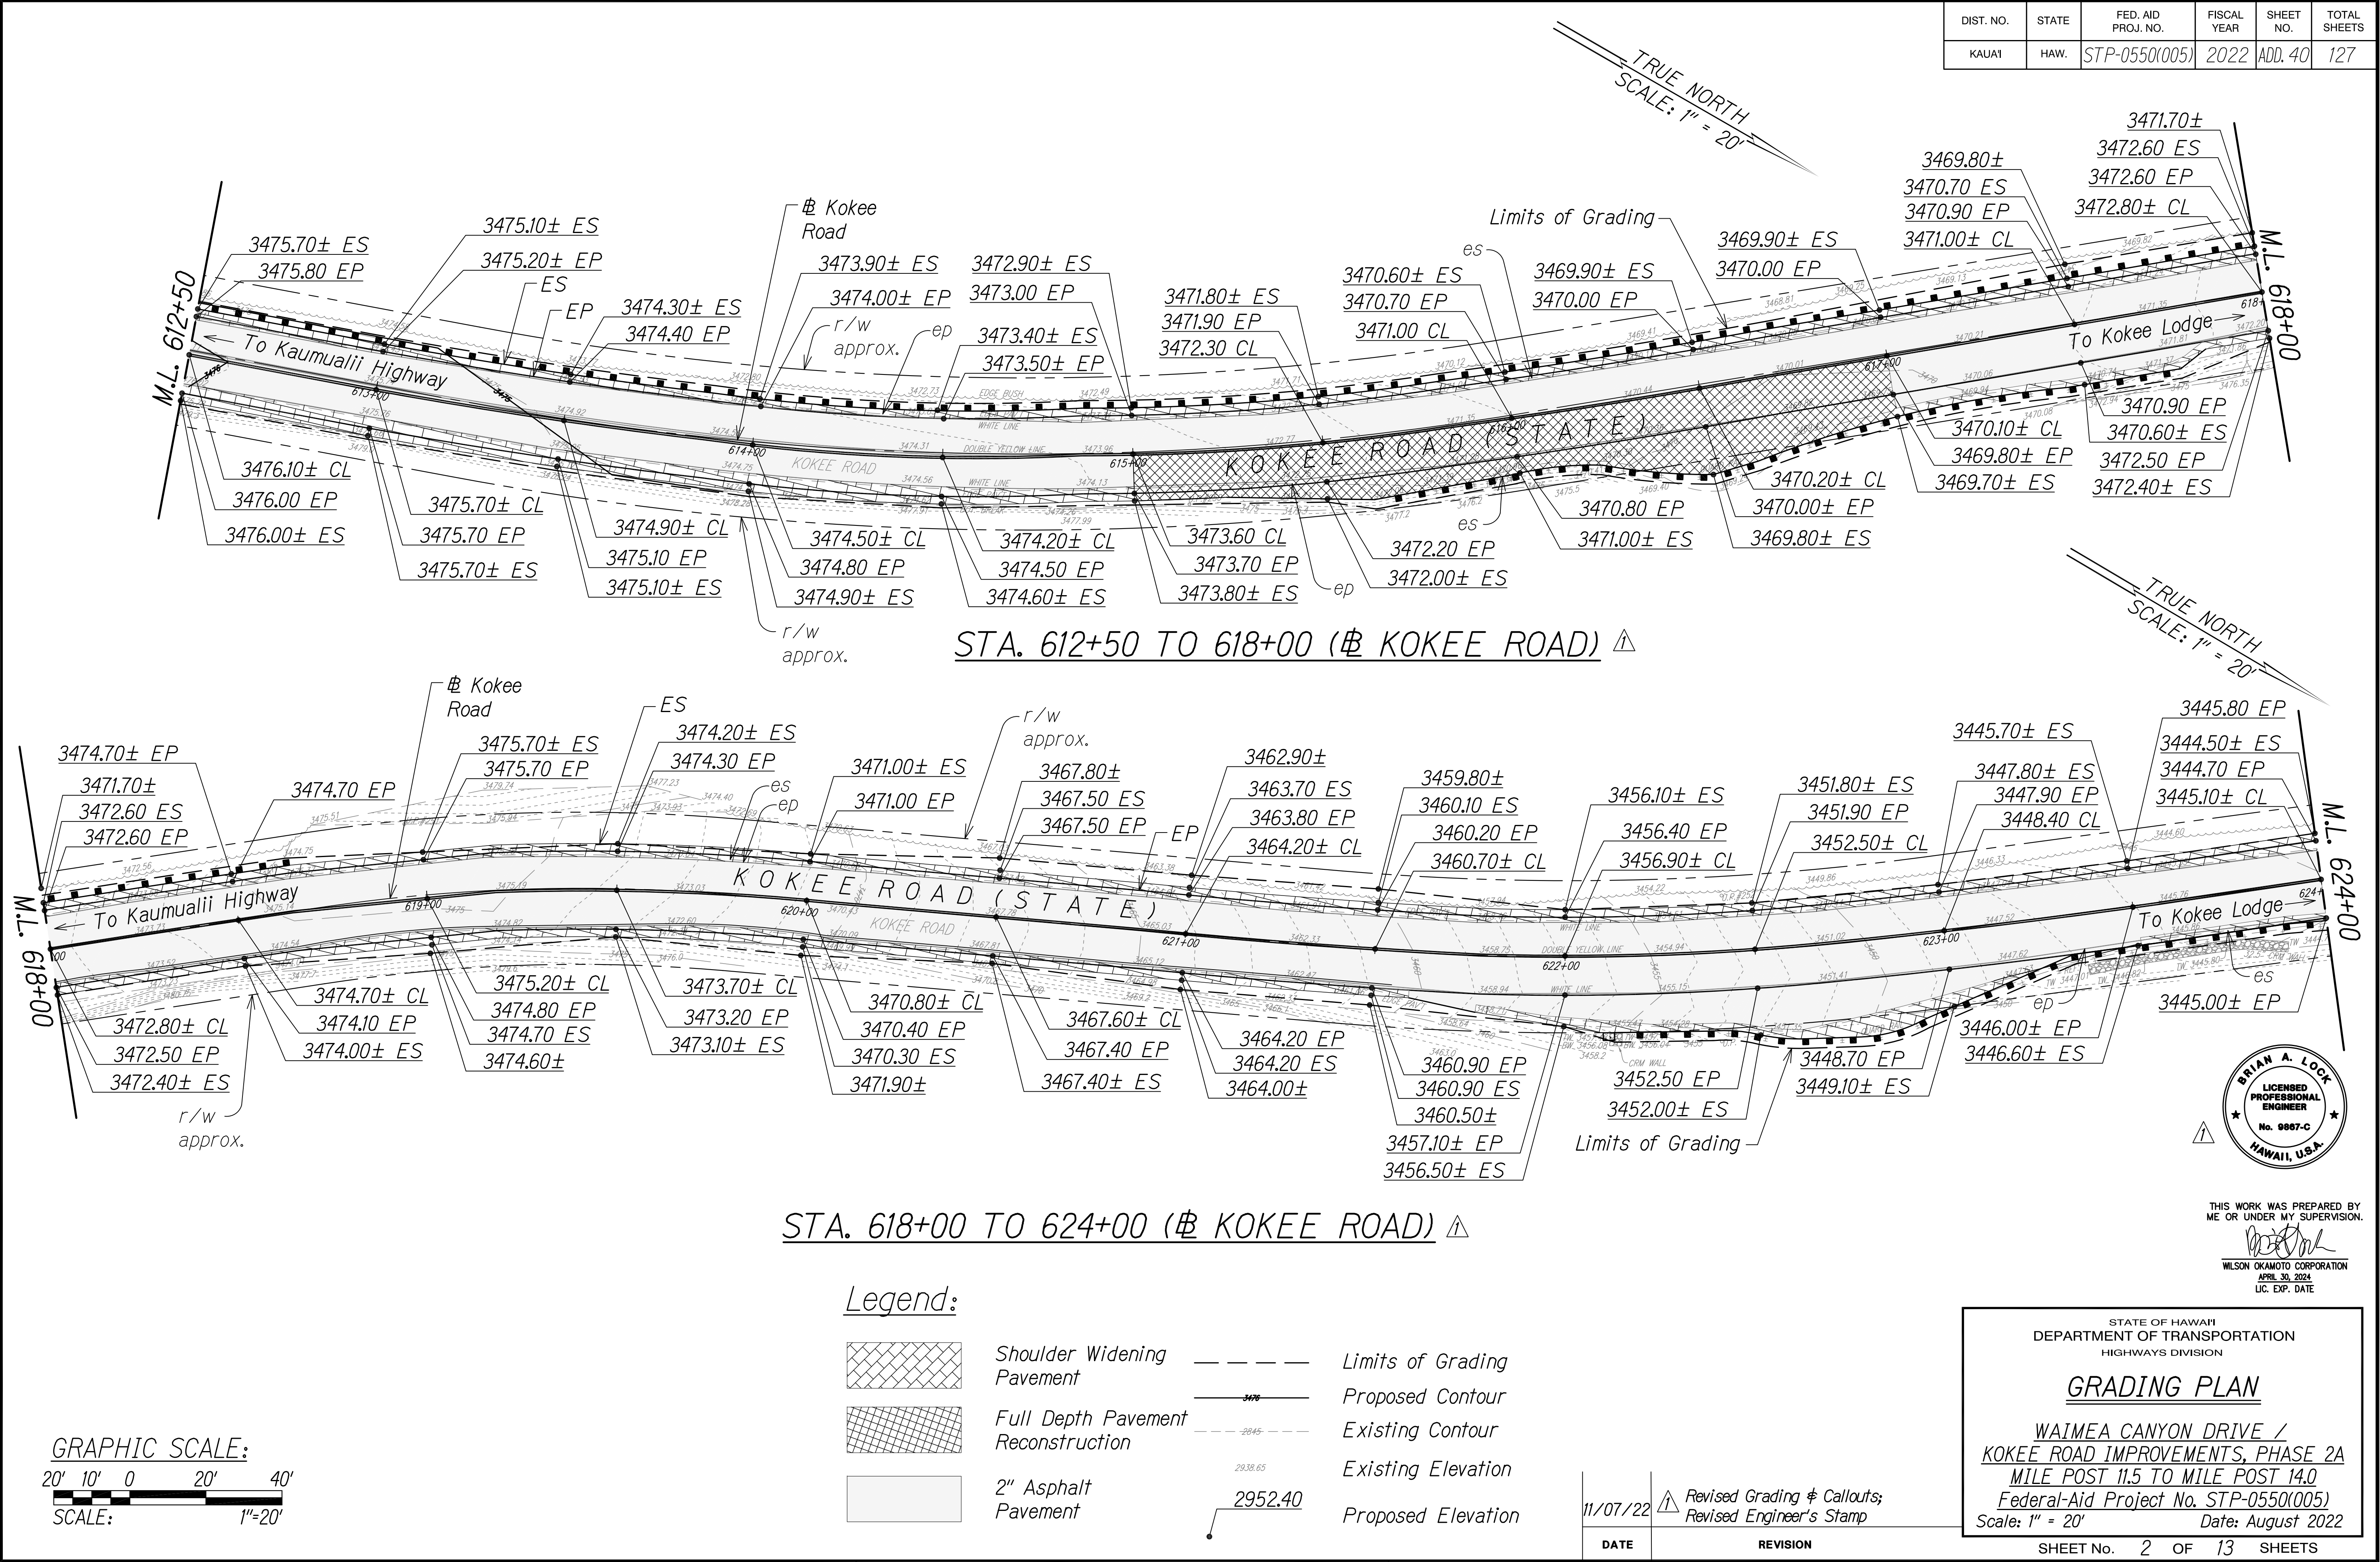

COPY OF ORIGINAL TRACING

ADD 40

DIST. NO.	STATE	FED. AID PROJ. NO.	FISCAL YEAR	SHEET NO.	TOTAL SHEETS
KAUAI	HAW.	STP-0550(005)	2022	ADD. 41	127

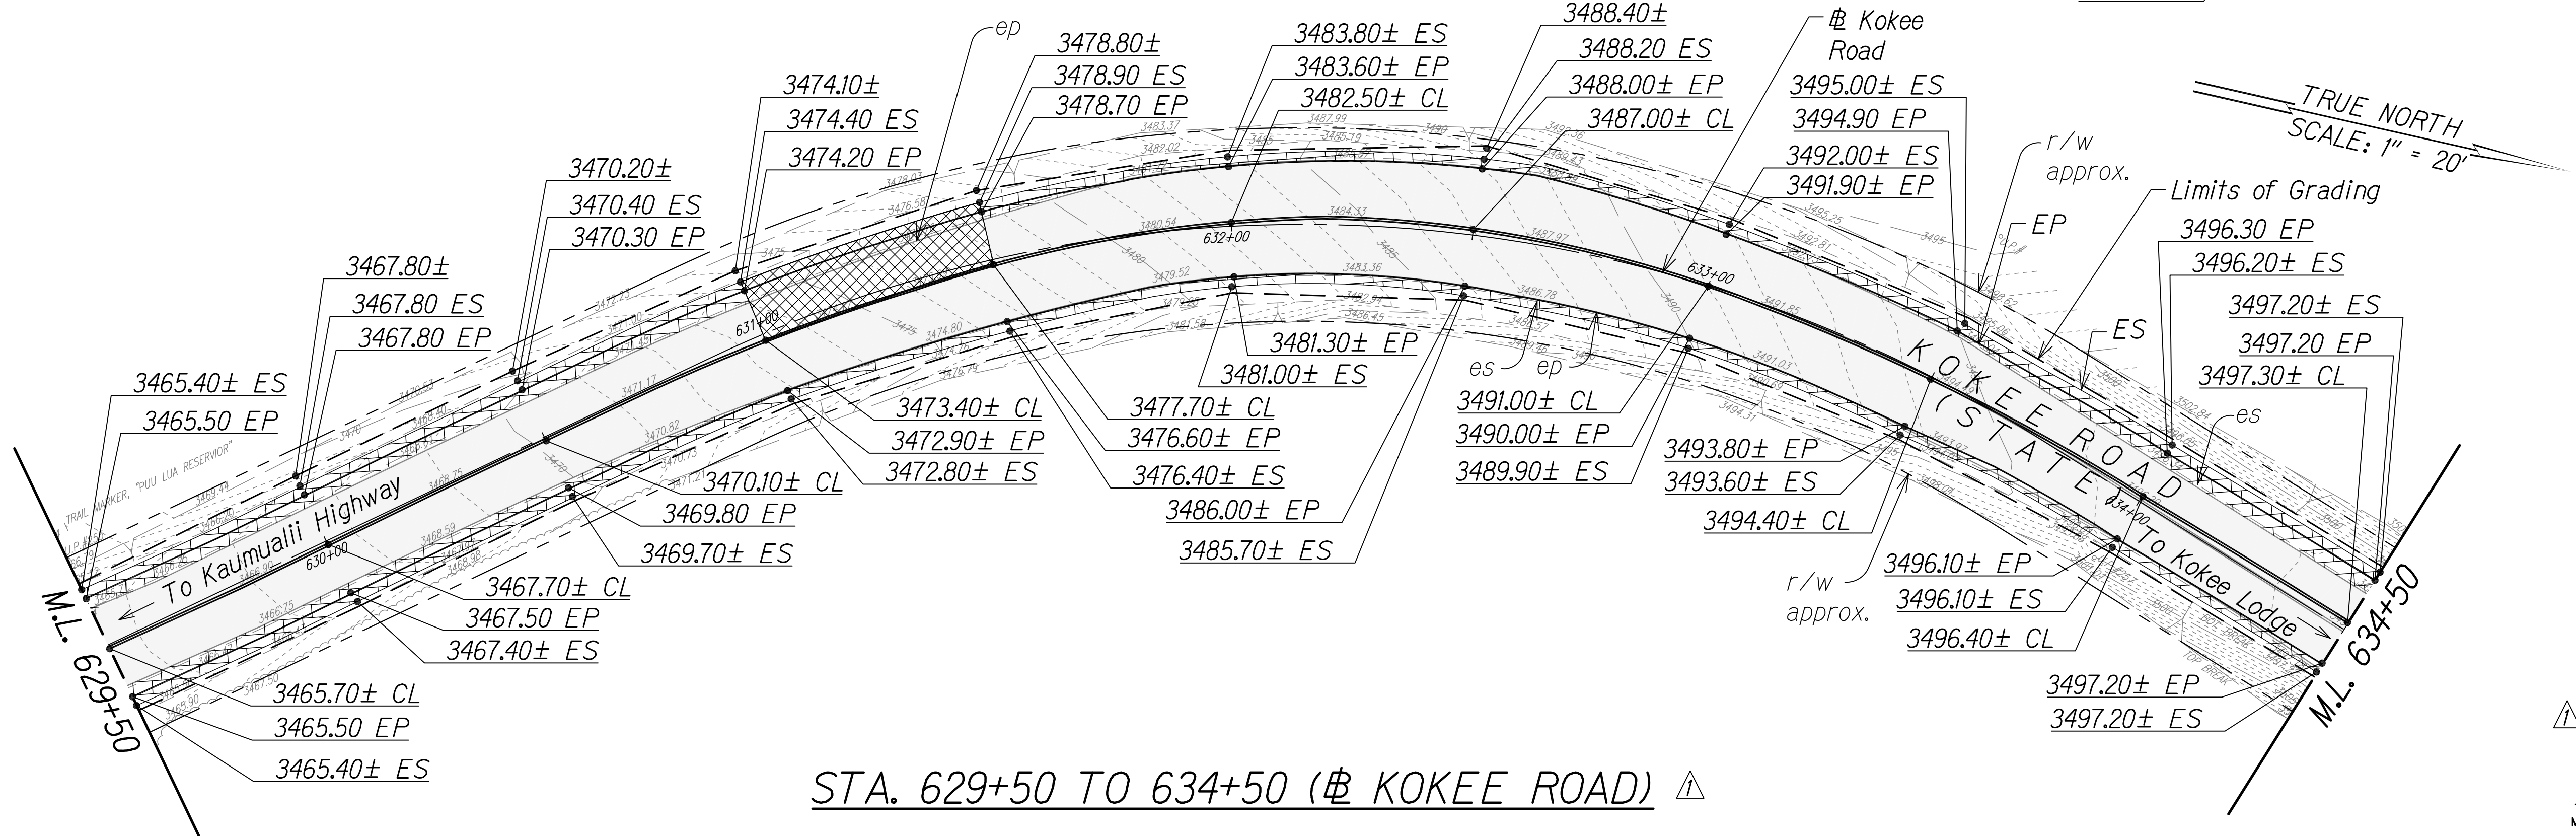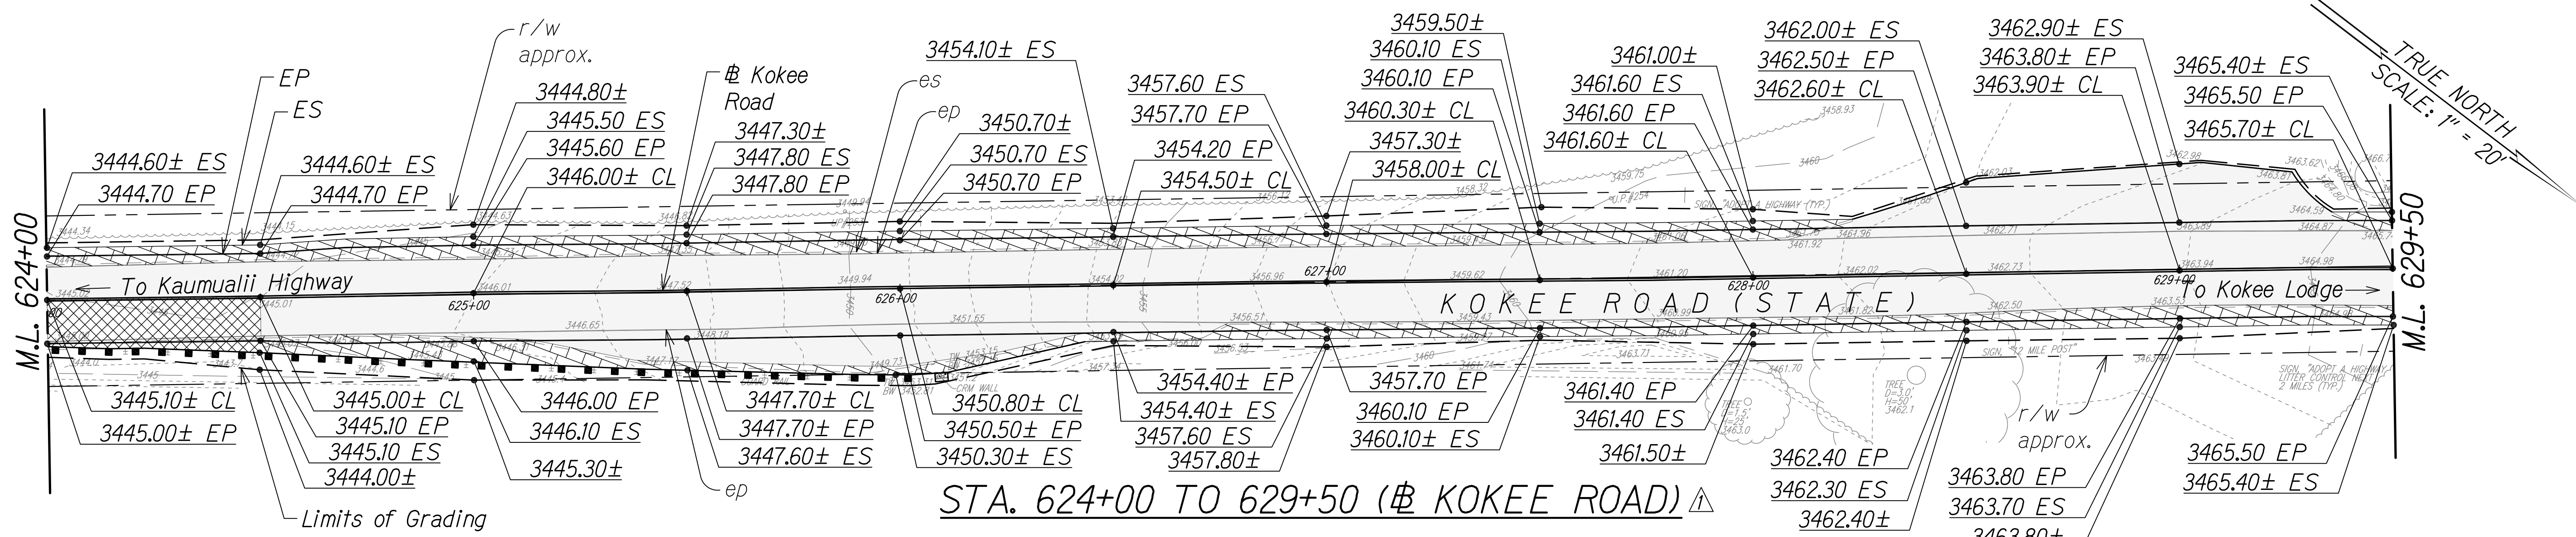


STA. 629+50 TO 634+50 (Kokee Road)

Legend:

- Shoulder Widening Pavement
- Full Depth Pavement Reconstruction
- 2" Asphalt Pavement
- Limits of Grading
- Existing Contour
- Existing Elevation
- Proposed Elevation



SURVEY PLOTTED BY	DATE
DESIGNED BY	
TRACED BY	
NOTE BOOK	
QUANTITIES BY	
CHECKED BY	

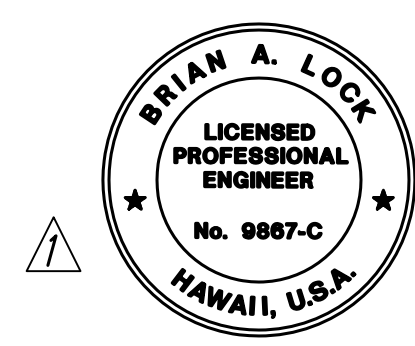

THIS WORK WAS PREPARED BY ME OR UNDER MY SUPERVISION.
WILSON OKAMOTO CORPORATION
APRIL 30, 2024
LIC. EXP. DATE

STATE OF HAWAII
DEPARTMENT OF TRANSPORTATION
HIGHWAYS DIVISION


GRADING PLAN

WAIMEA CANYON DRIVE /
Kokee Road Improvements, Phase 2A
MILE POST 11.5 TO MILE POST 14.0
Federal-Aid Project No. STP-0550(005)
Scale: 1" = 20' Date: August 2022


DATE: 11/07/22 REVISION: Revised Grading & Callouts; Revised Engineer's Stamp

SHEET No. 3 OF 13 SHEETS

DIST. NO.	STATE	FED. AID PROJ. NO.	FISCAL YEAR	SHEET NO.	TOTAL SHEETS
KAUAI	HAW.	STP-0550(005)	2022	ADD. 42	127

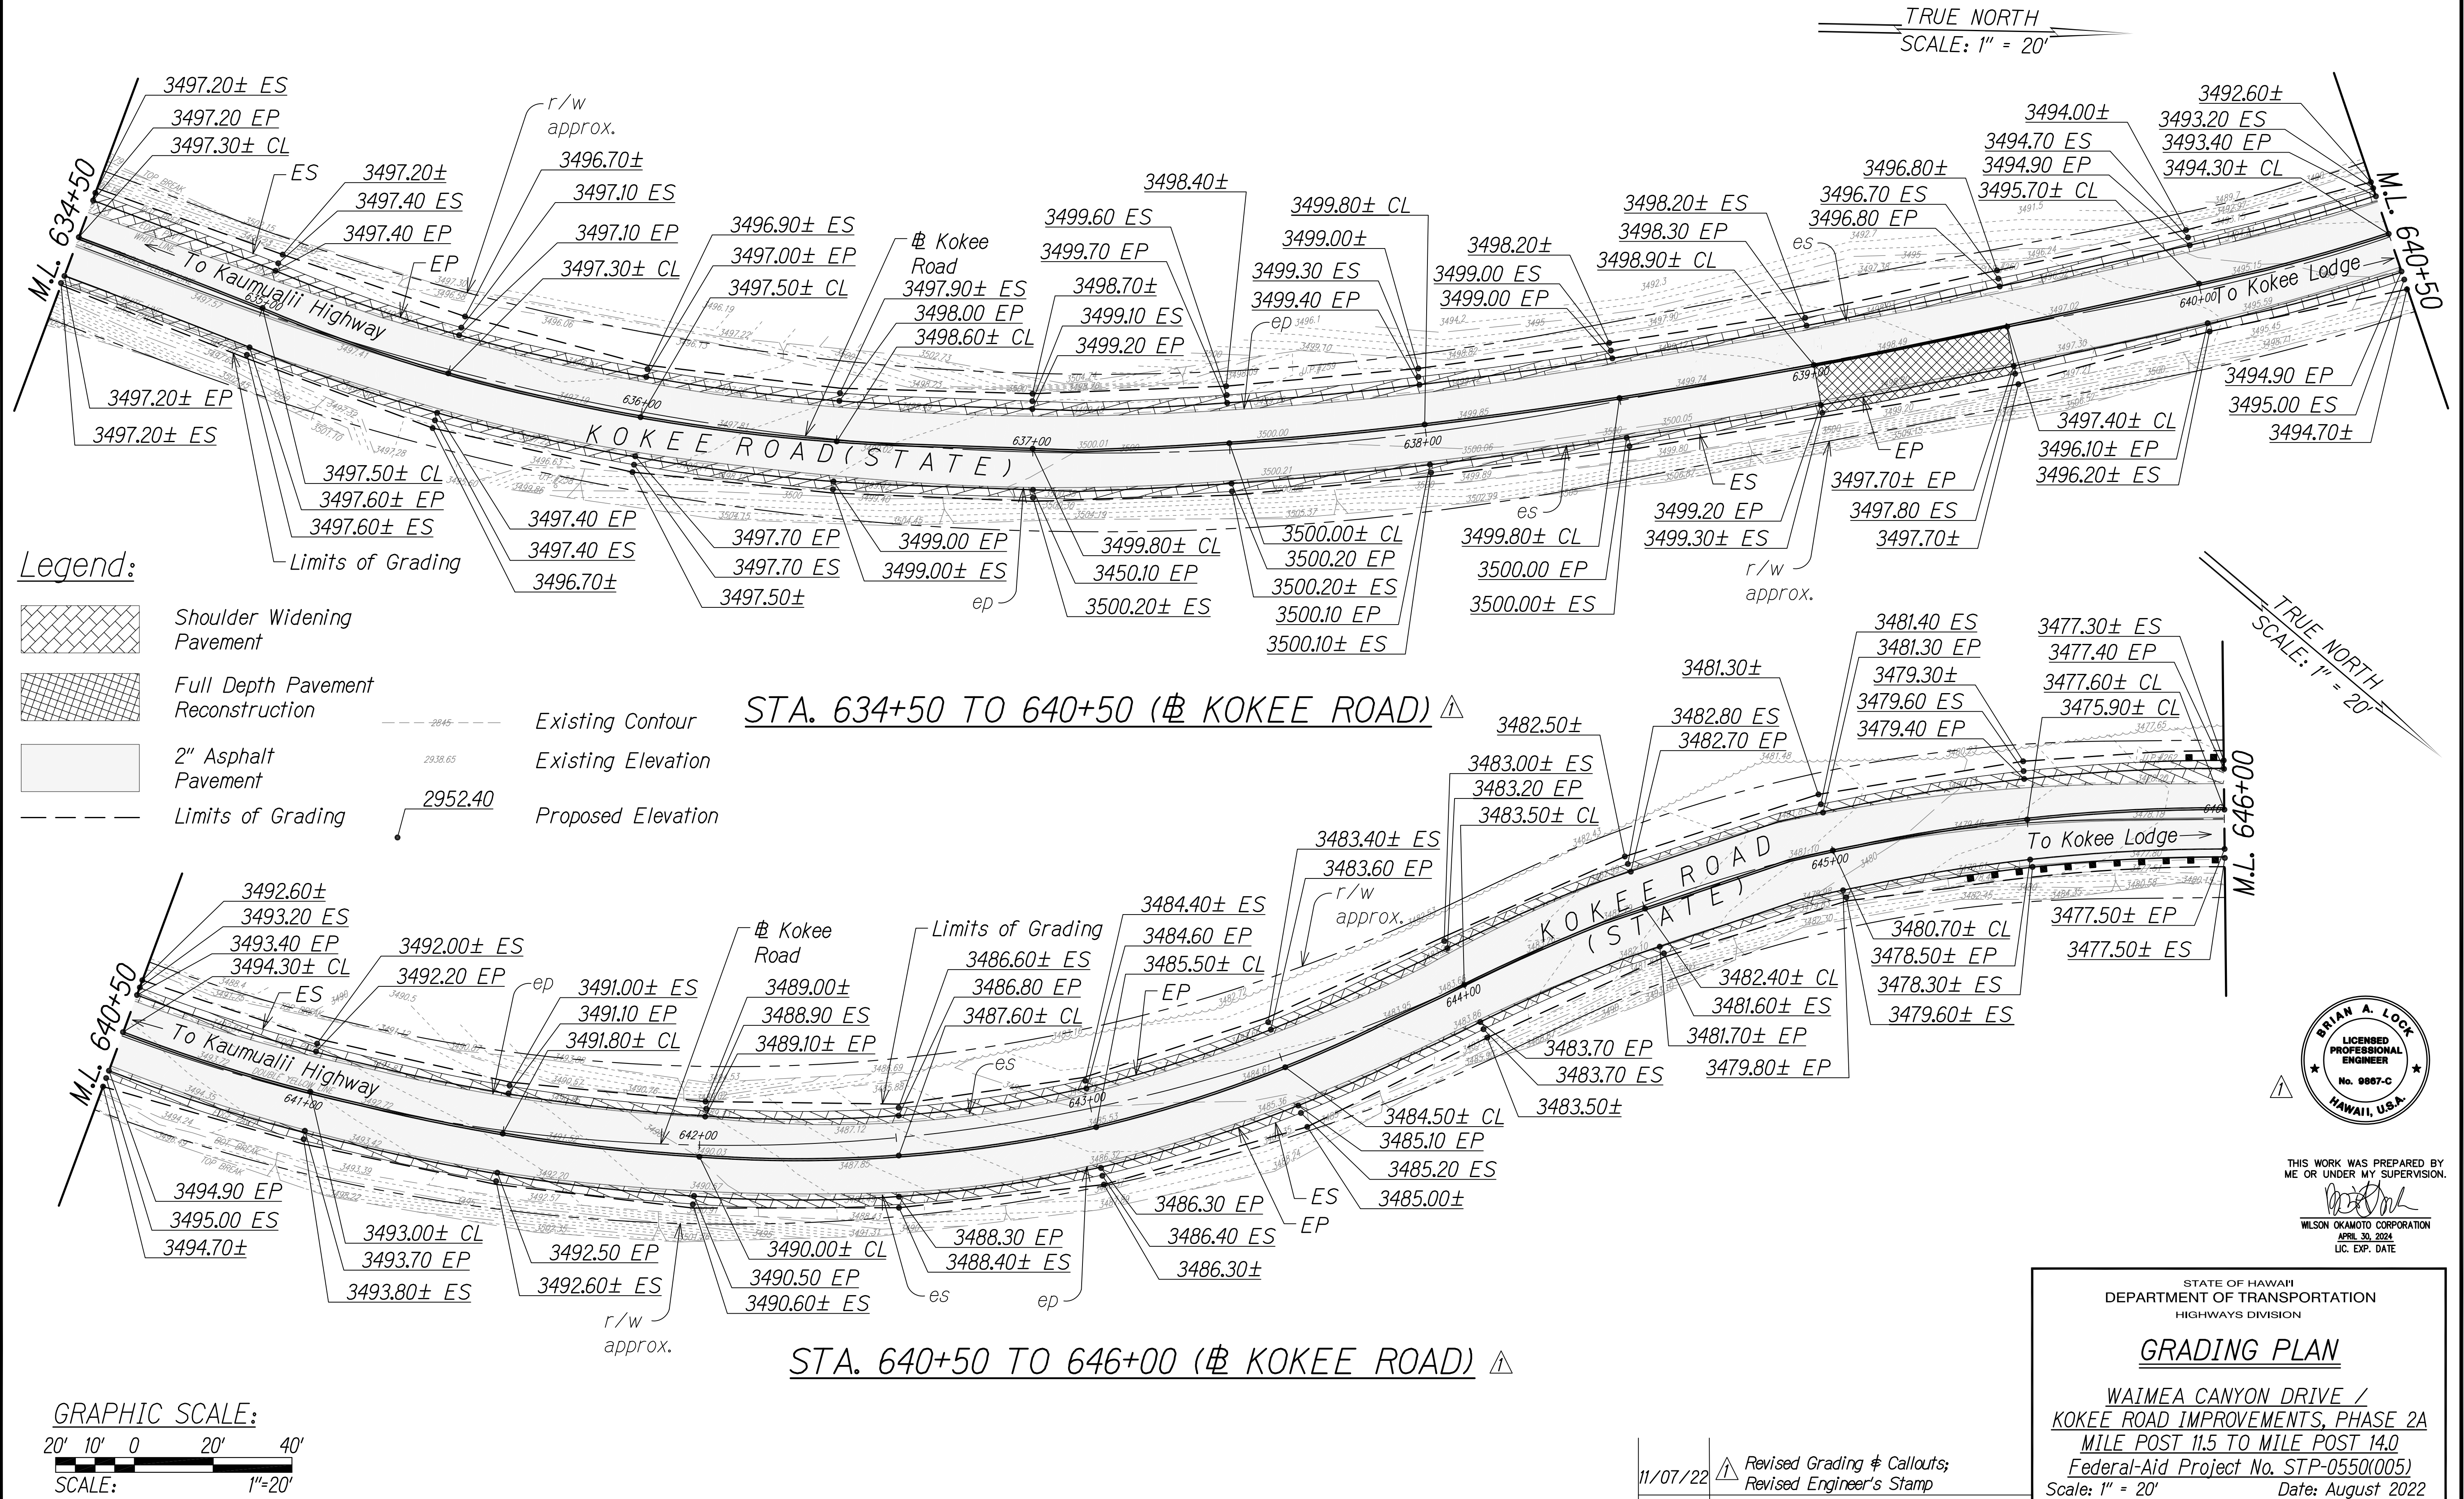

SURVEY PLOTTED BY	DATE
DESIGNED BY	
TRACED BY	
NOTED BY	
QUANTITIES BY	
CHECKED BY	

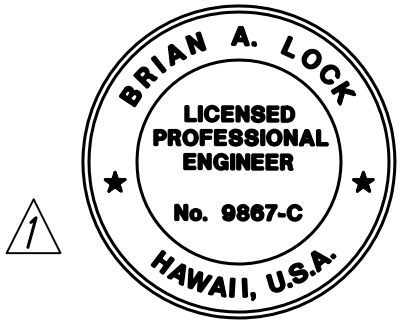

THIS WORK WAS PREPARED BY
ME OR UNDER MY SUPERVISION.
WILSON OKAMOTO CORPORATION
APRIL 30, 2024
LIC. EXP. DATE

STATE OF HAWAII
DEPARTMENT OF TRANSPORTATION
HIGHWAYS DIVISION


GRADING PLAN

WAIMEA CANYON DRIVE /
KOKEE ROAD IMPROVEMENTS, PHASE 2A
MILE POST 11.5 TO MILE POST 14.0
Federal-Aid Project No. STP-0550(005)
Scale: 1" = 20' Date: August 2022


SHEET No. 4 OF 13 SHEETS

DATE	REVISION
11/07/22	Revised Grading & Callouts; Revised Engineer's Stamp

DIST. NO.	STATE	FED. AID PROJ. NO.	FISCAL YEAR	SHEET NO.	TOTAL SHEETS
KAUAI	HAW.	STP-0550(005)	2022	ADD. 43	127

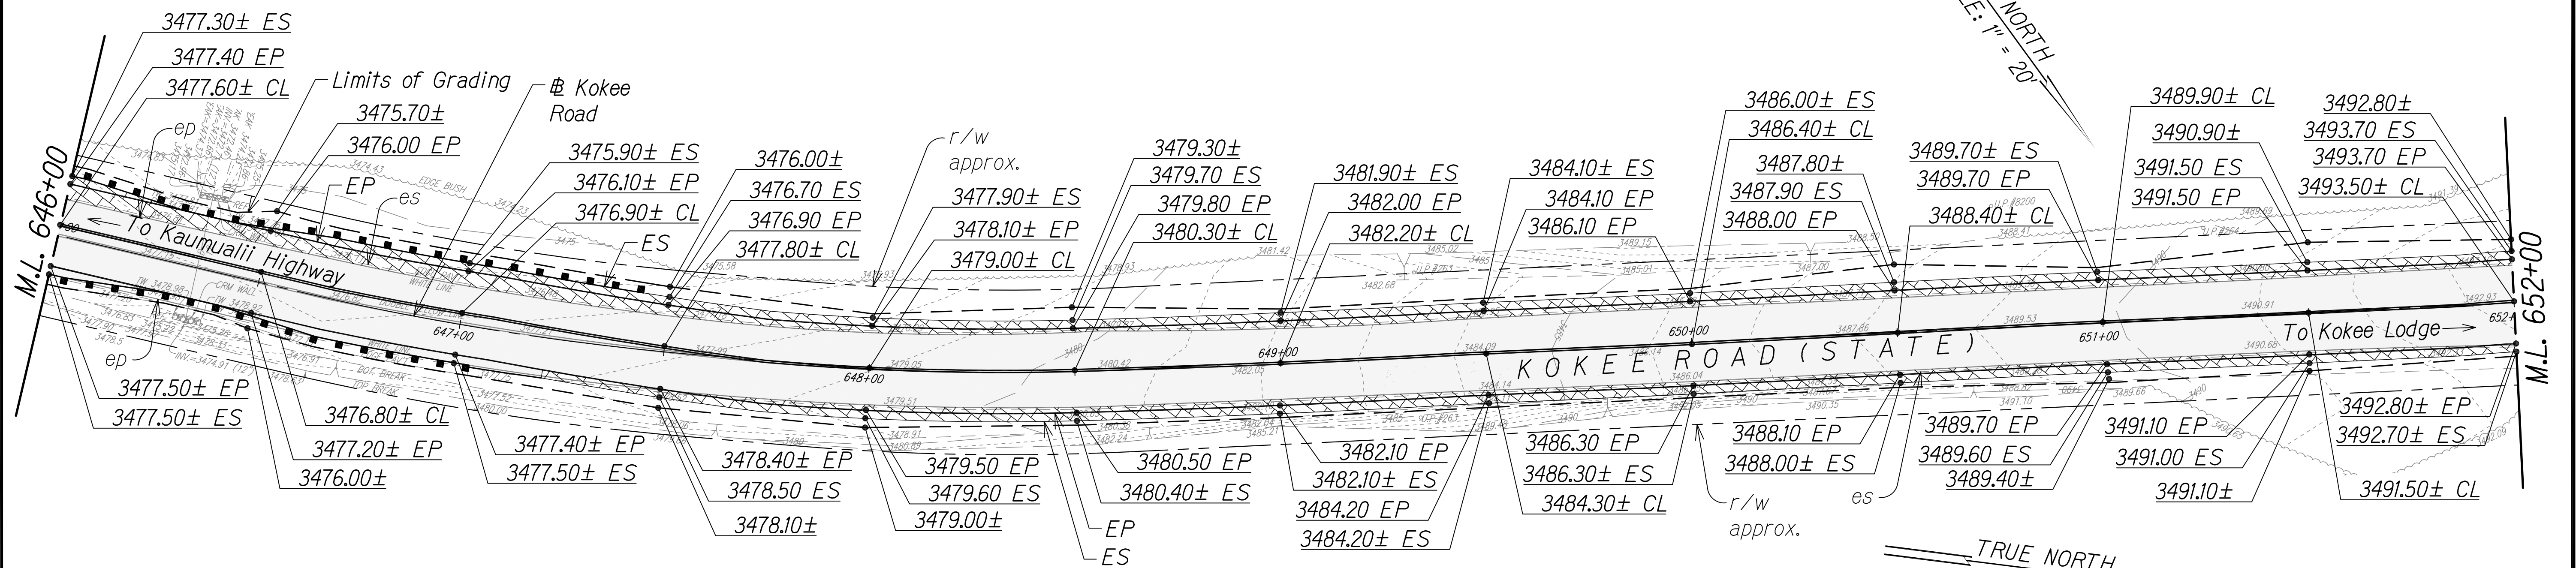

STA. 646+00 TO 652+00 (# KOKEE ROAD) ▲

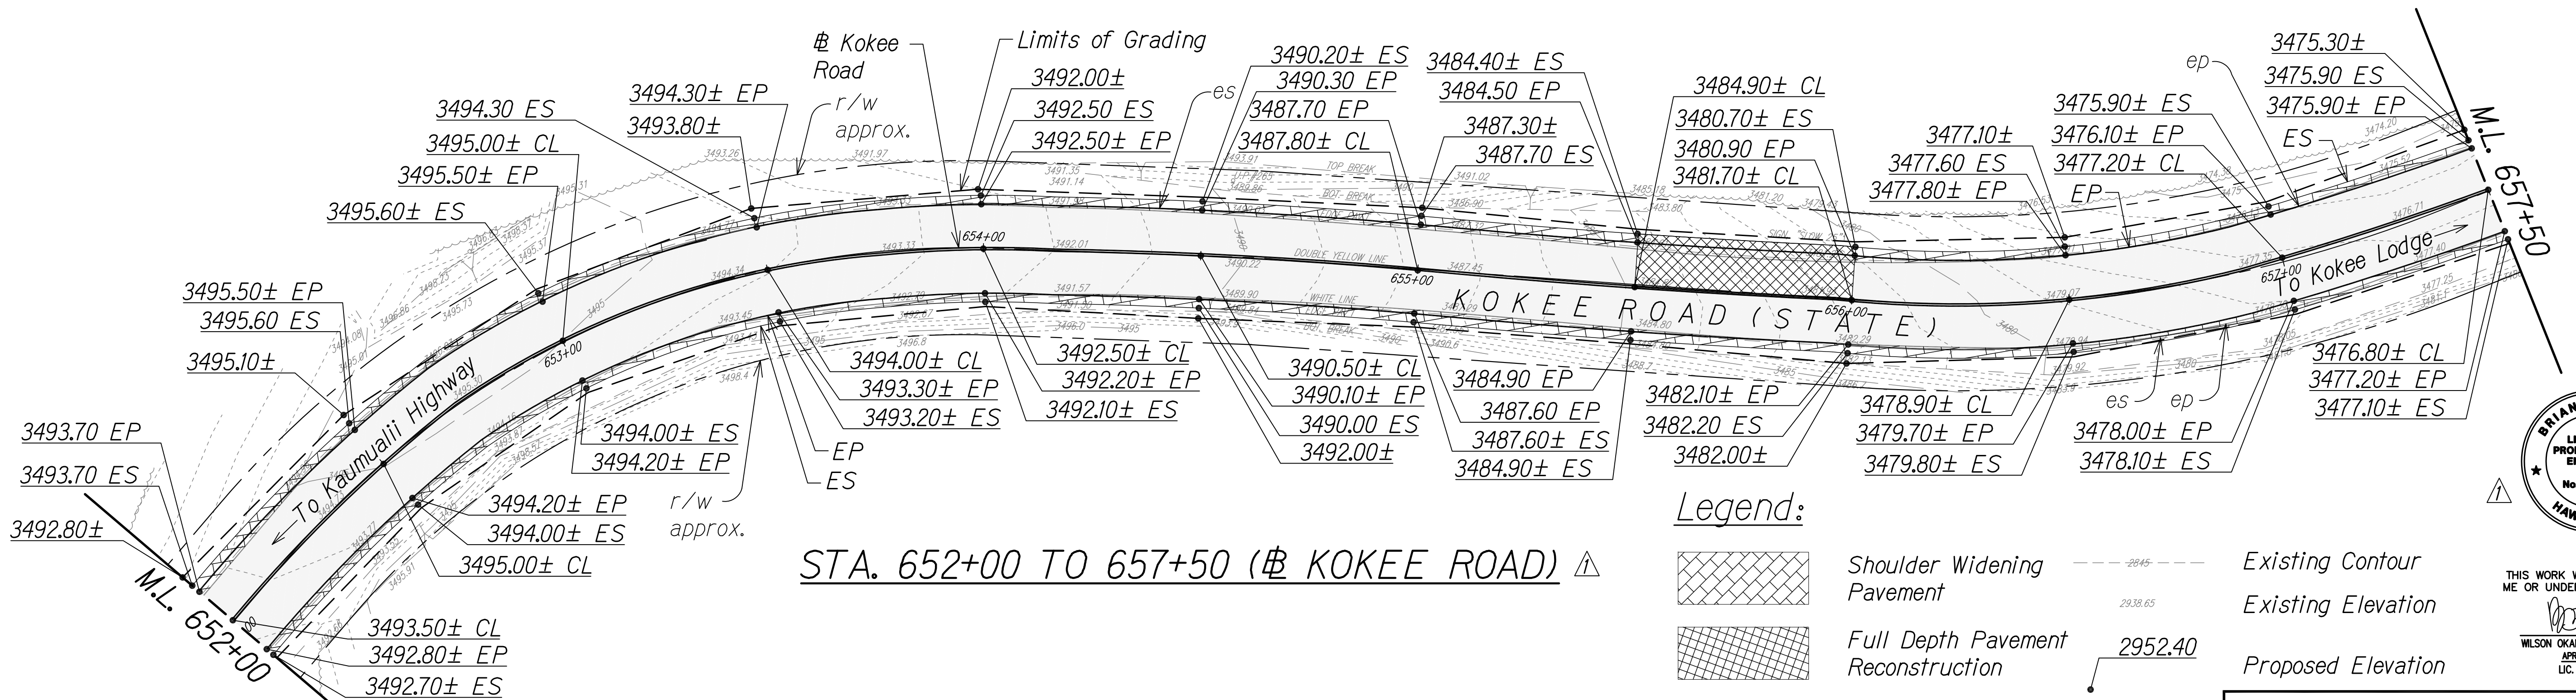

STA. 652+00 TO 657+50 (# KOKEE ROAD) ▲

Legend:

- Shoulder Widening Pavement
- Full Depth Pavement Reconstruction
- 2" Asphalt Pavement
- Limits of Grading
- Existing Contour
- Existing Elevation
- Proposed Elevation

GRAPHIC SCALE:
20' 10' 0 20' 40'
SCALE: 1"=20'

11/07/22	Revised Grading # Callouts; Revised Engineer's Stamp
DATE	REVISION


STATE OF HAWAII
DEPARTMENT OF TRANSPORTATION
HIGHWAYS DIVISION

GRADING PLAN


WAIMEA CANYON DRIVE /
KOKEE ROAD IMPROVEMENTS, PHASE 2A
MILE POST 11.5 TO MILE POST 14.0
Federal-Aid Project No. STP-0550(005)
Scale: 1" = 20' Date: August 2022

SHEET No. 5 OF 13 SHEETS

DIST. NO.	STATE	FED. AID PROJ. NO.	FISCAL YEAR	SHEET NO.	TOTAL SHEETS
KAUAI	HAW.	STP-0550(005)	2022	ADD. 44	127

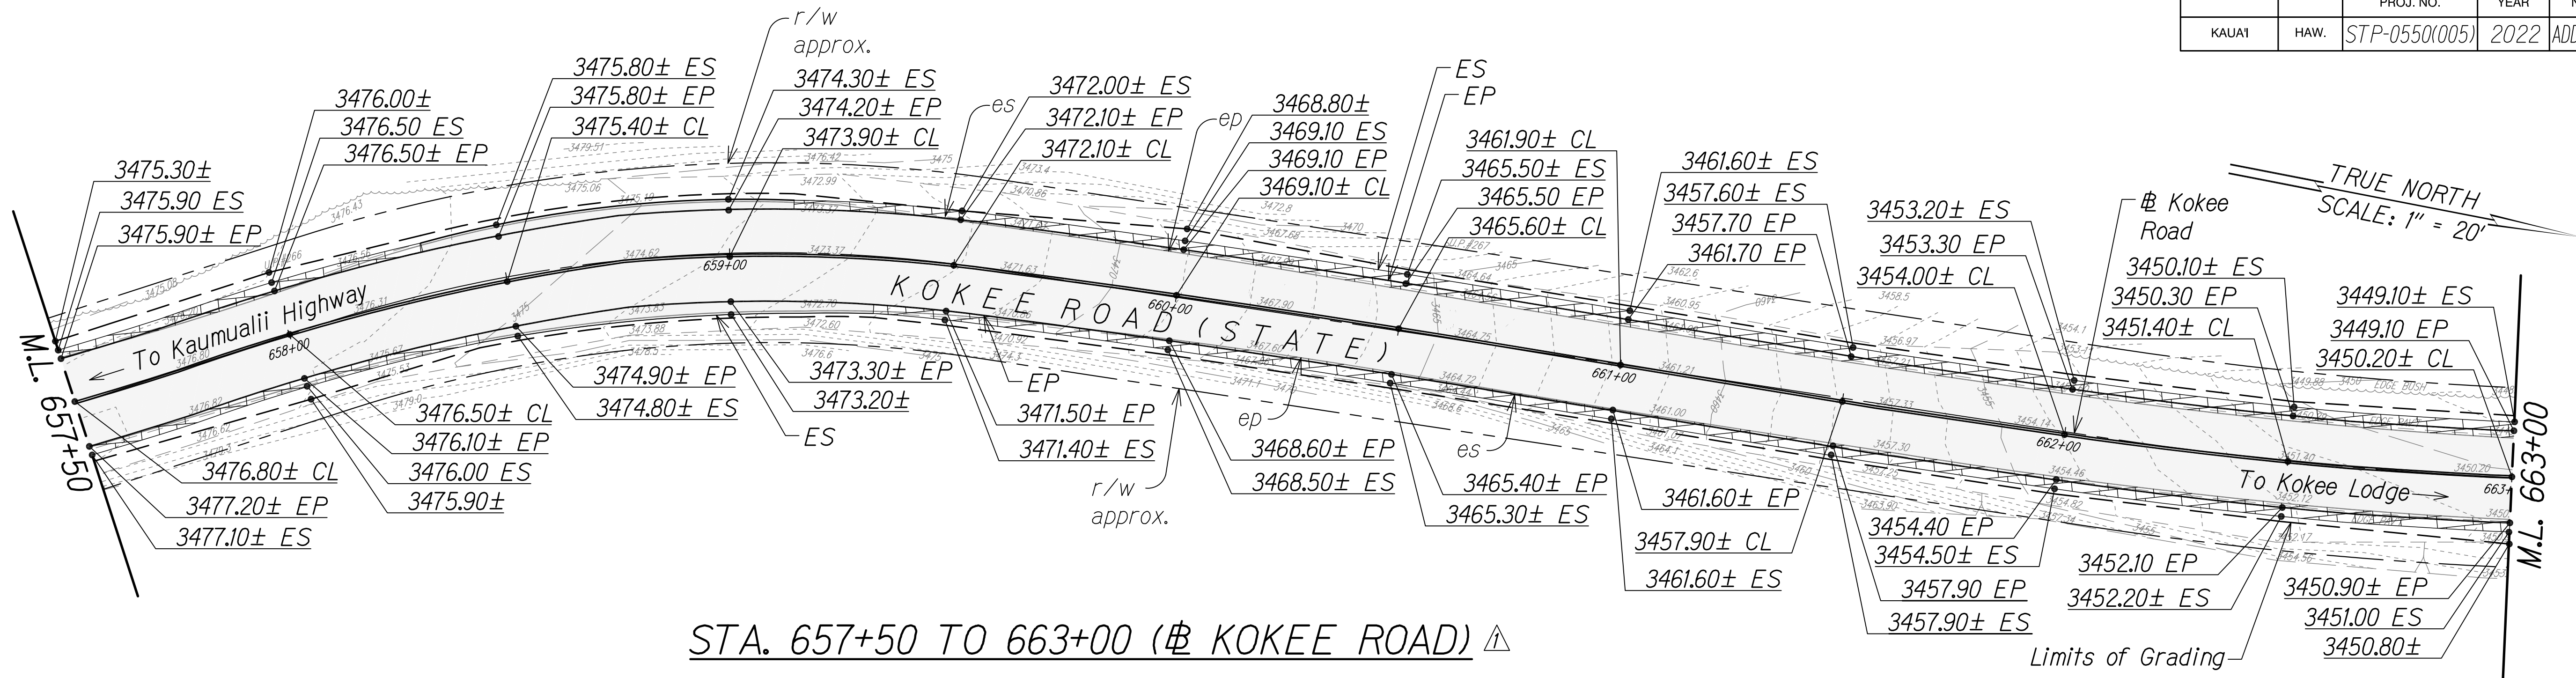

STA. 657+50 TO 663+00 (# KOKEE ROAD) ▲

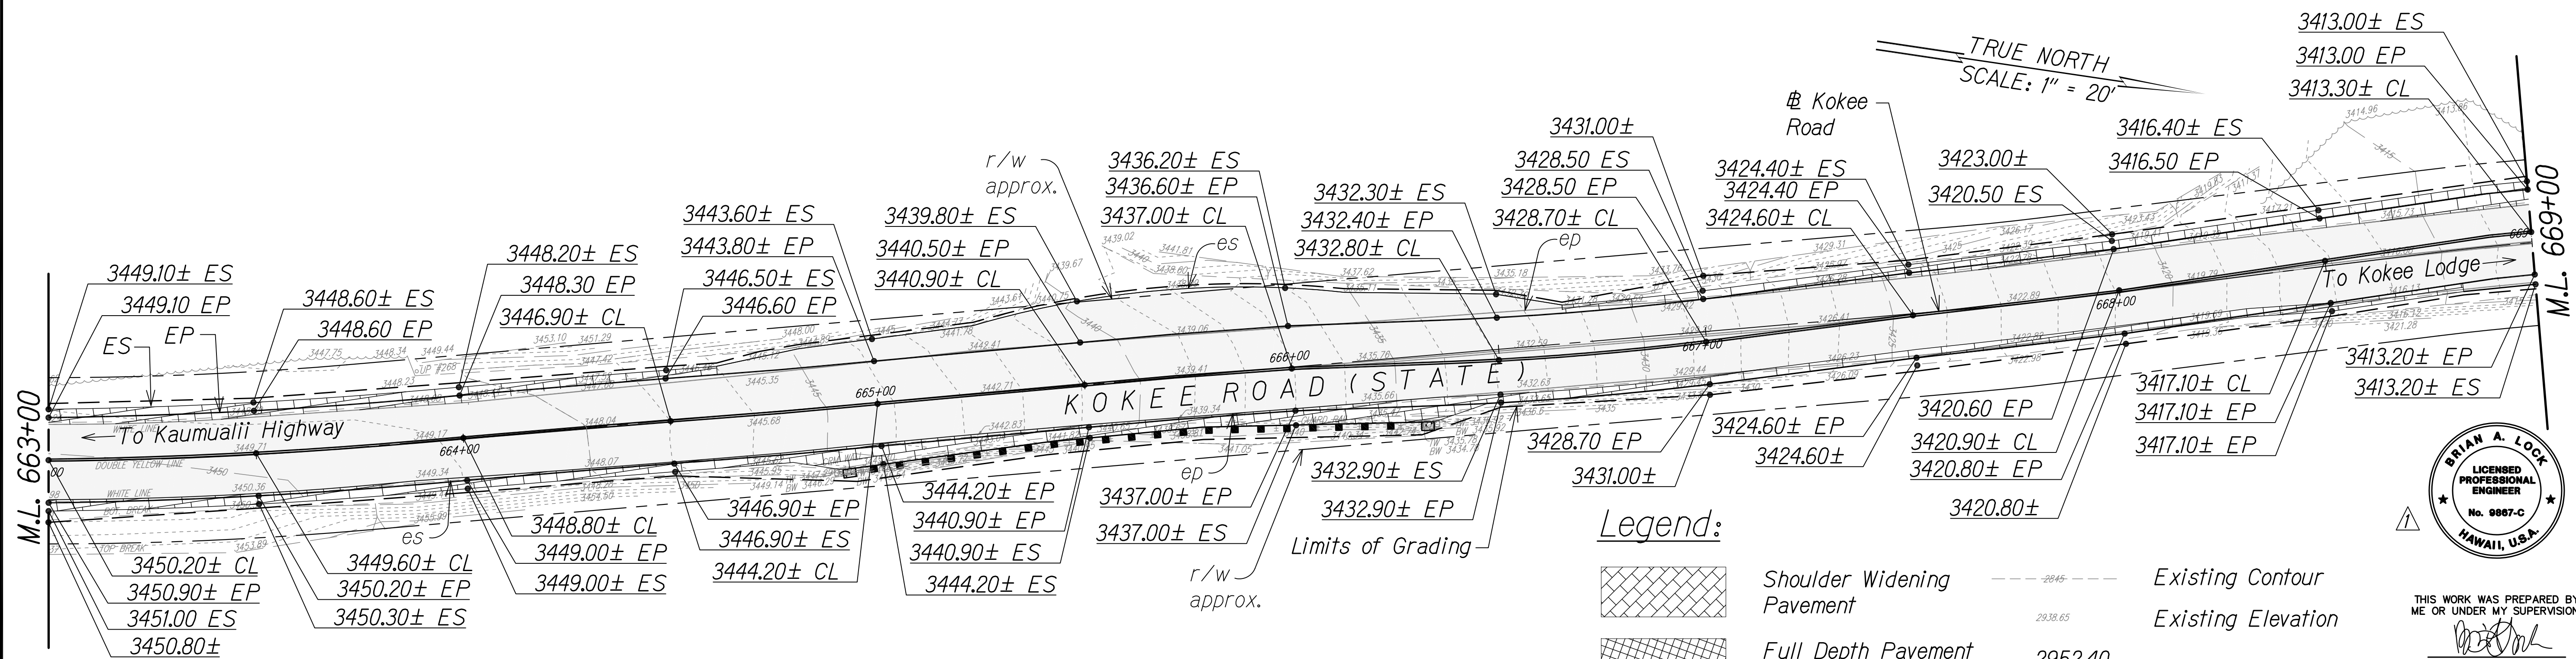

Legend:

- Shoulder Widening Pavement
- Full Depth Pavement Reconstruction
- 2" Asphalt Pavement
- Limits of Grading
- Existing Contour
- Existing Elevation
- Proposed Elevation

GRAPHIC SCALE:
20' 10' 0 20' 40'
SCALE: 1"=20'

STA. 663+00 TO 669+00 (# KOKEE ROAD) ▲

11/07/22 Revised Grading & Callouts;
Revised Engineer's Stamp

STATE OF HAWAII
DEPARTMENT OF TRANSPORTATION
HIGHWAYS DIVISION

GRADING PLAN


WAIMEA CANYON DRIVE /
KOKEE ROAD IMPROVEMENTS, PHASE 2A
MILE POST 11.5 TO MILE POST 14.0
Federal-Aid Project No. STP-0550(005)
Scale: 1" = 20' Date: August 2022

SHEET No. 6 OF 13 SHEETS


COPY OF ORIGINAL TRACING

ADD 44

DIST. NO.	STATE	FED. AID PROJ. NO.	FISCAL YEAR	SHEET NO.	TOTAL SHEETS
KAUAI	HAW.	STP-0550(005)	2022	ADD. 45	127

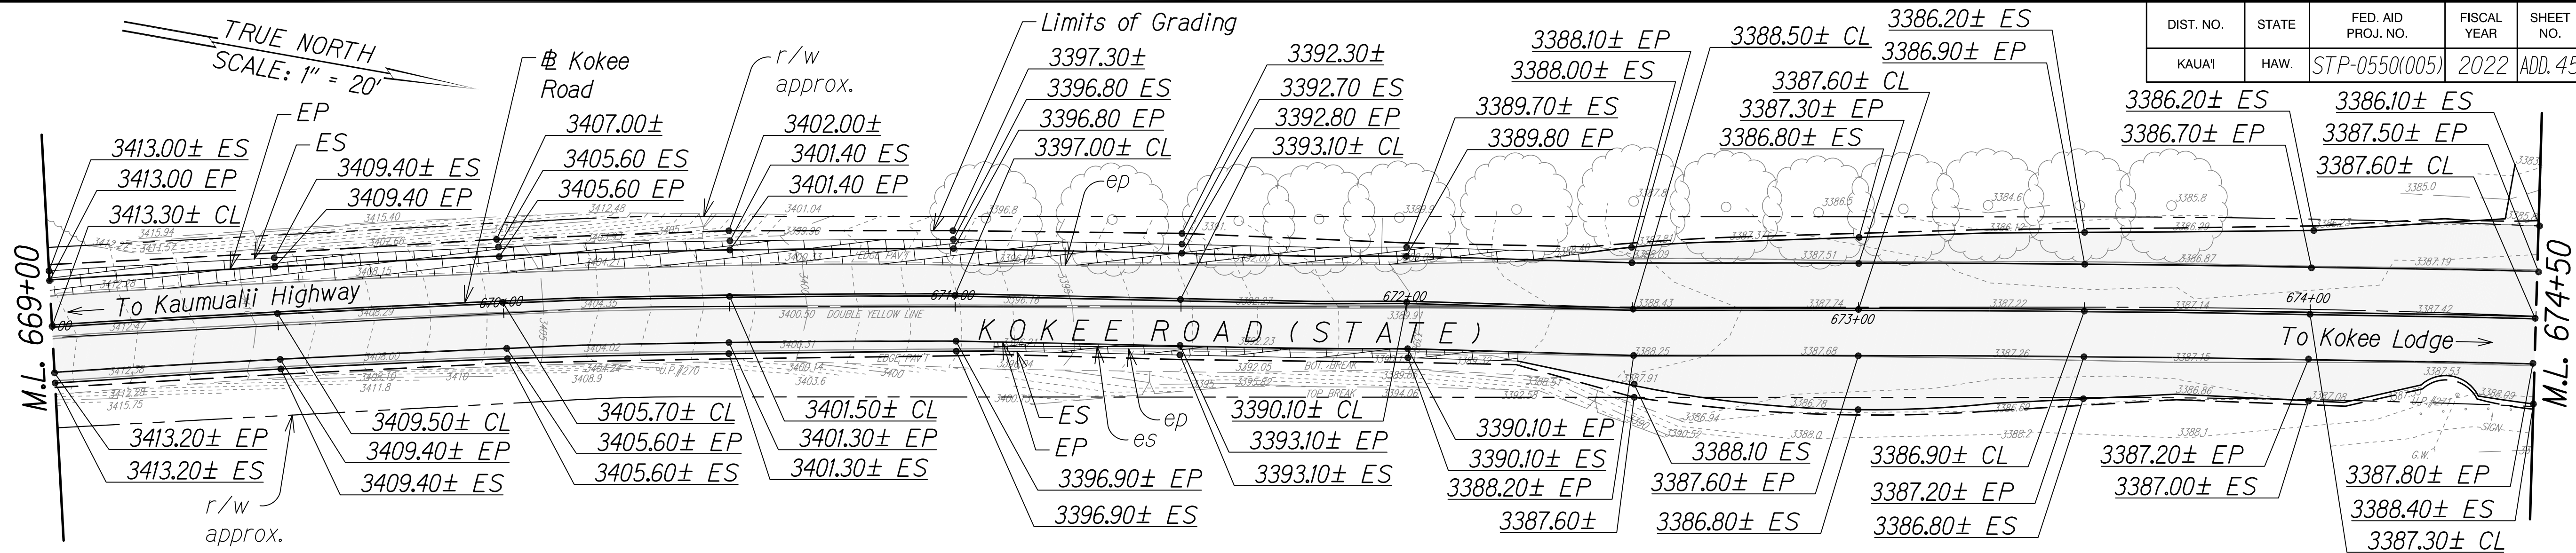


STA. 669+00 TO 674+50 (# KOKEE ROAD) ▲

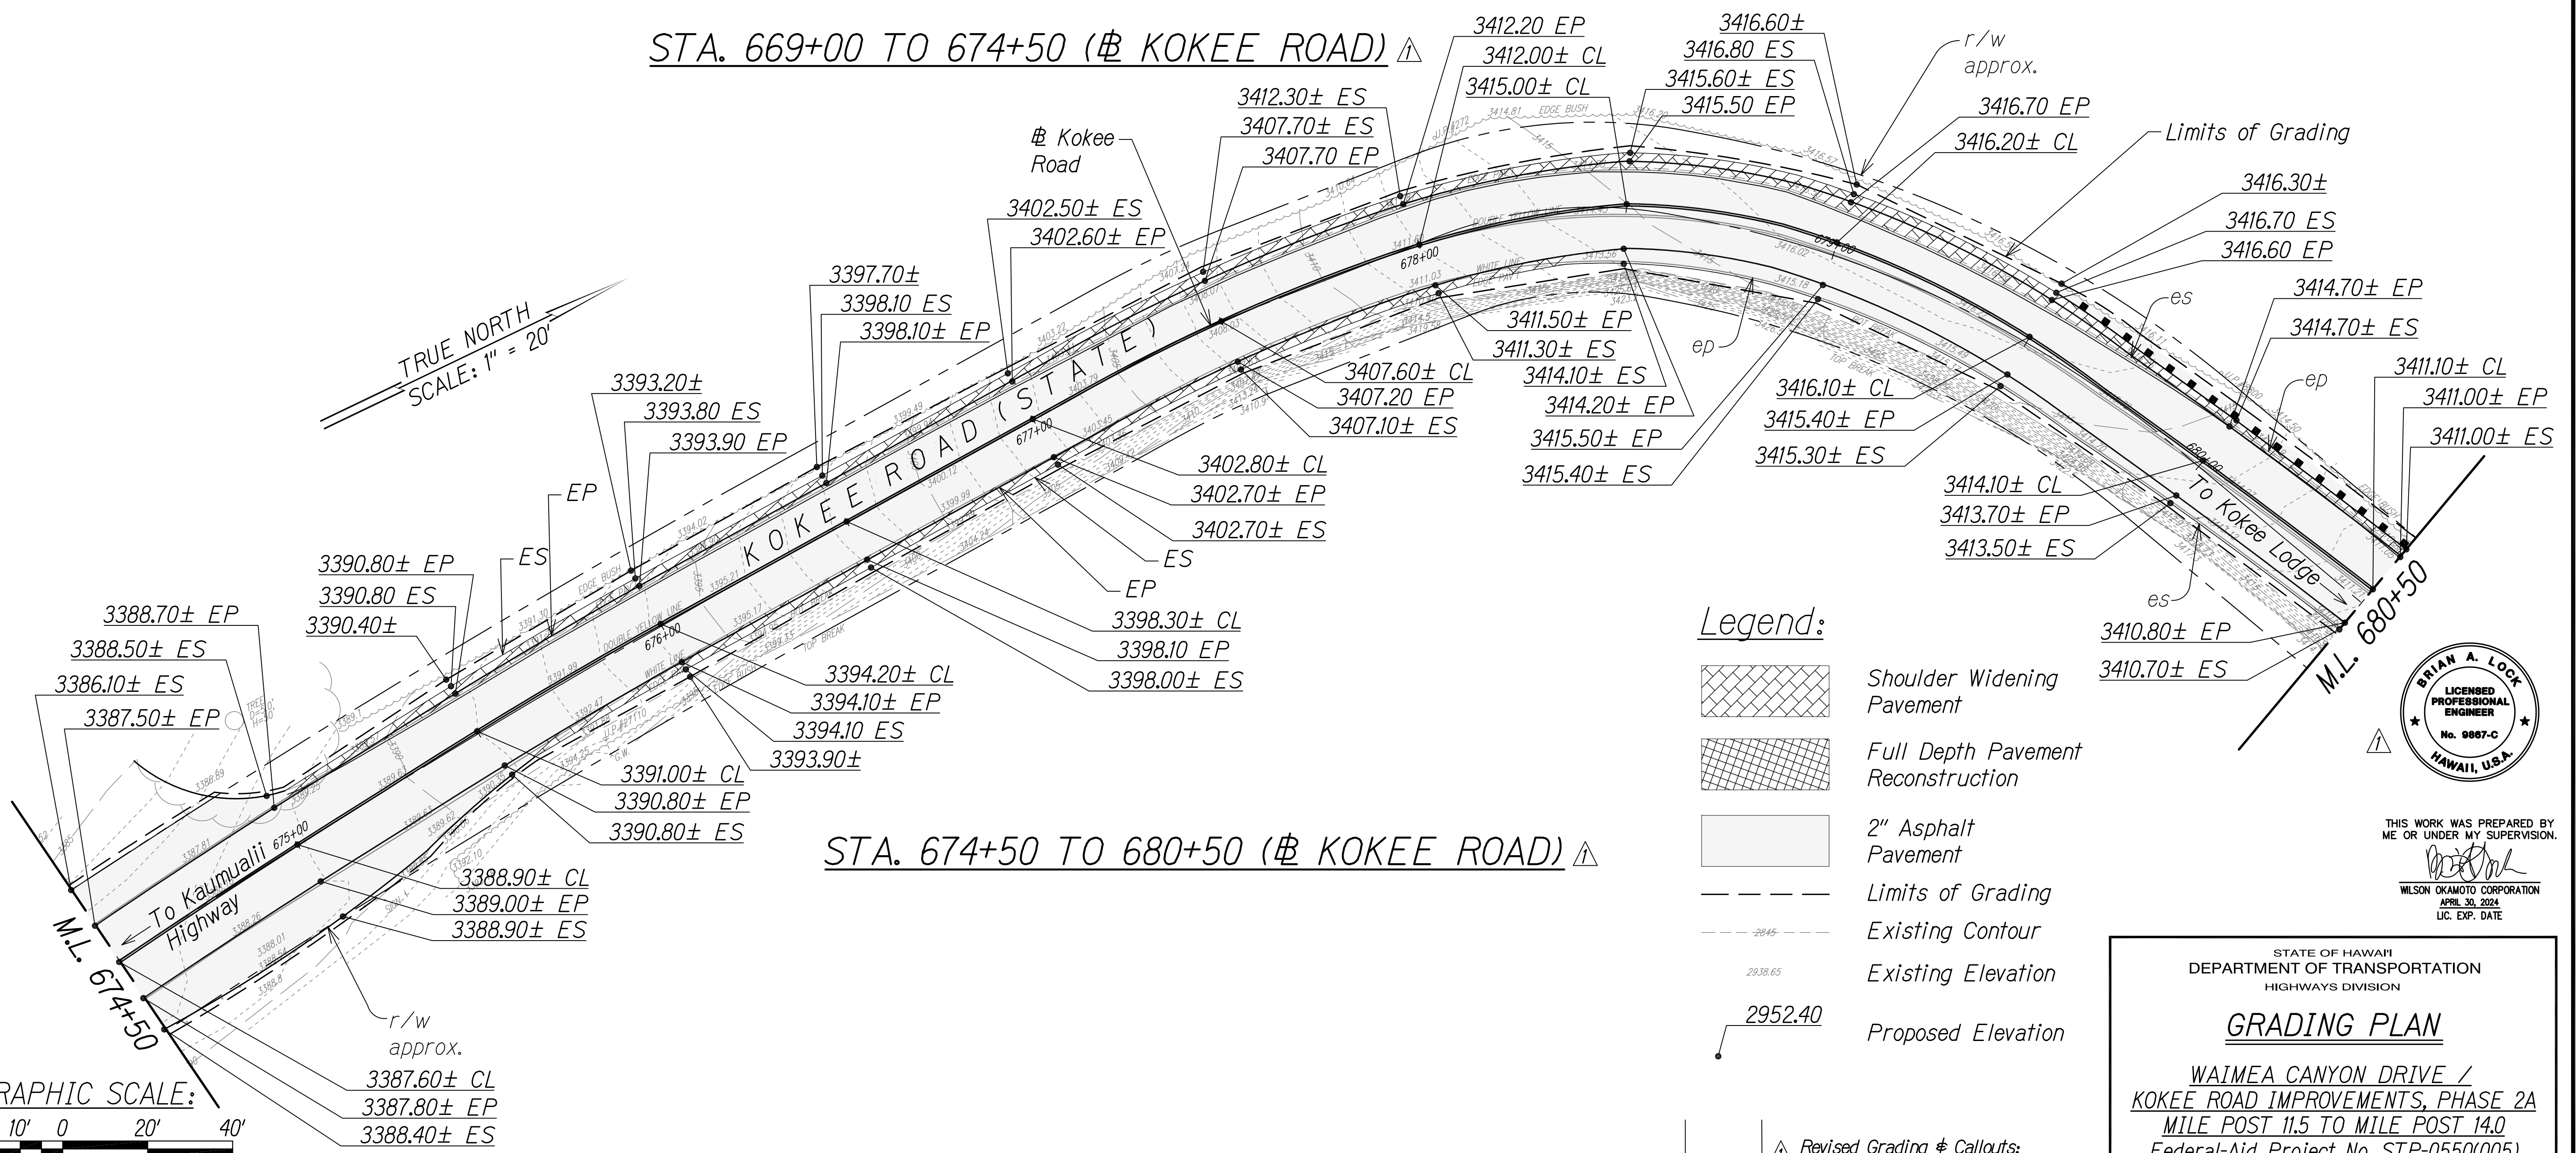

STA. 674+50 TO 680+50 (# KOKEE ROAD) ▲

Legend:

- Shoulder Widening Pavement
- Full Depth Pavement Reconstruction
- 2" Asphalt Pavement
- Limits of Grading
- Existing Contour
- Existing Elevation
- Proposed Elevation

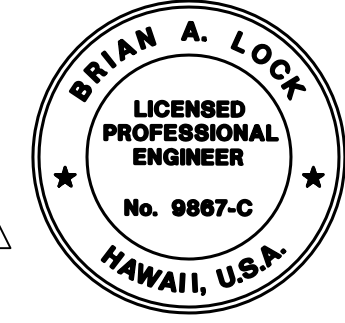

THIS WORK WAS PREPARED BY ME OR UNDER MY SUPERVISION.
WILSON OKAMOTO CORPORATION
APRIL 30, 2024
LIC. EXP. DATE

STATE OF HAWAII
DEPARTMENT OF TRANSPORTATION
HIGHWAYS DIVISION

GRADING PLAN

WAIMEA CANYON DRIVE /
KOKEE ROAD IMPROVEMENTS, PHASE 2A
MILE POST 11.5 TO MILE POST 14.0
Federal-Aid Project No. STP-0550(005)
Scale: 1" = 20' Date: August 2022


SHEET No. 7 OF 13 SHEETS

DATE	REVISION
11/07/22	Revised Grading & Callouts; Revised Engineer's Stamp

COPY OF ORIGINAL TRACING

ADD 45


DIST. NO.	STATE	FED. AID PROJ. NO.	FISCAL YEAR	SHEET NO.	TOTAL SHEETS
KAUAI	HAW.	STP-0550(005)	2022	ADD. 46	127

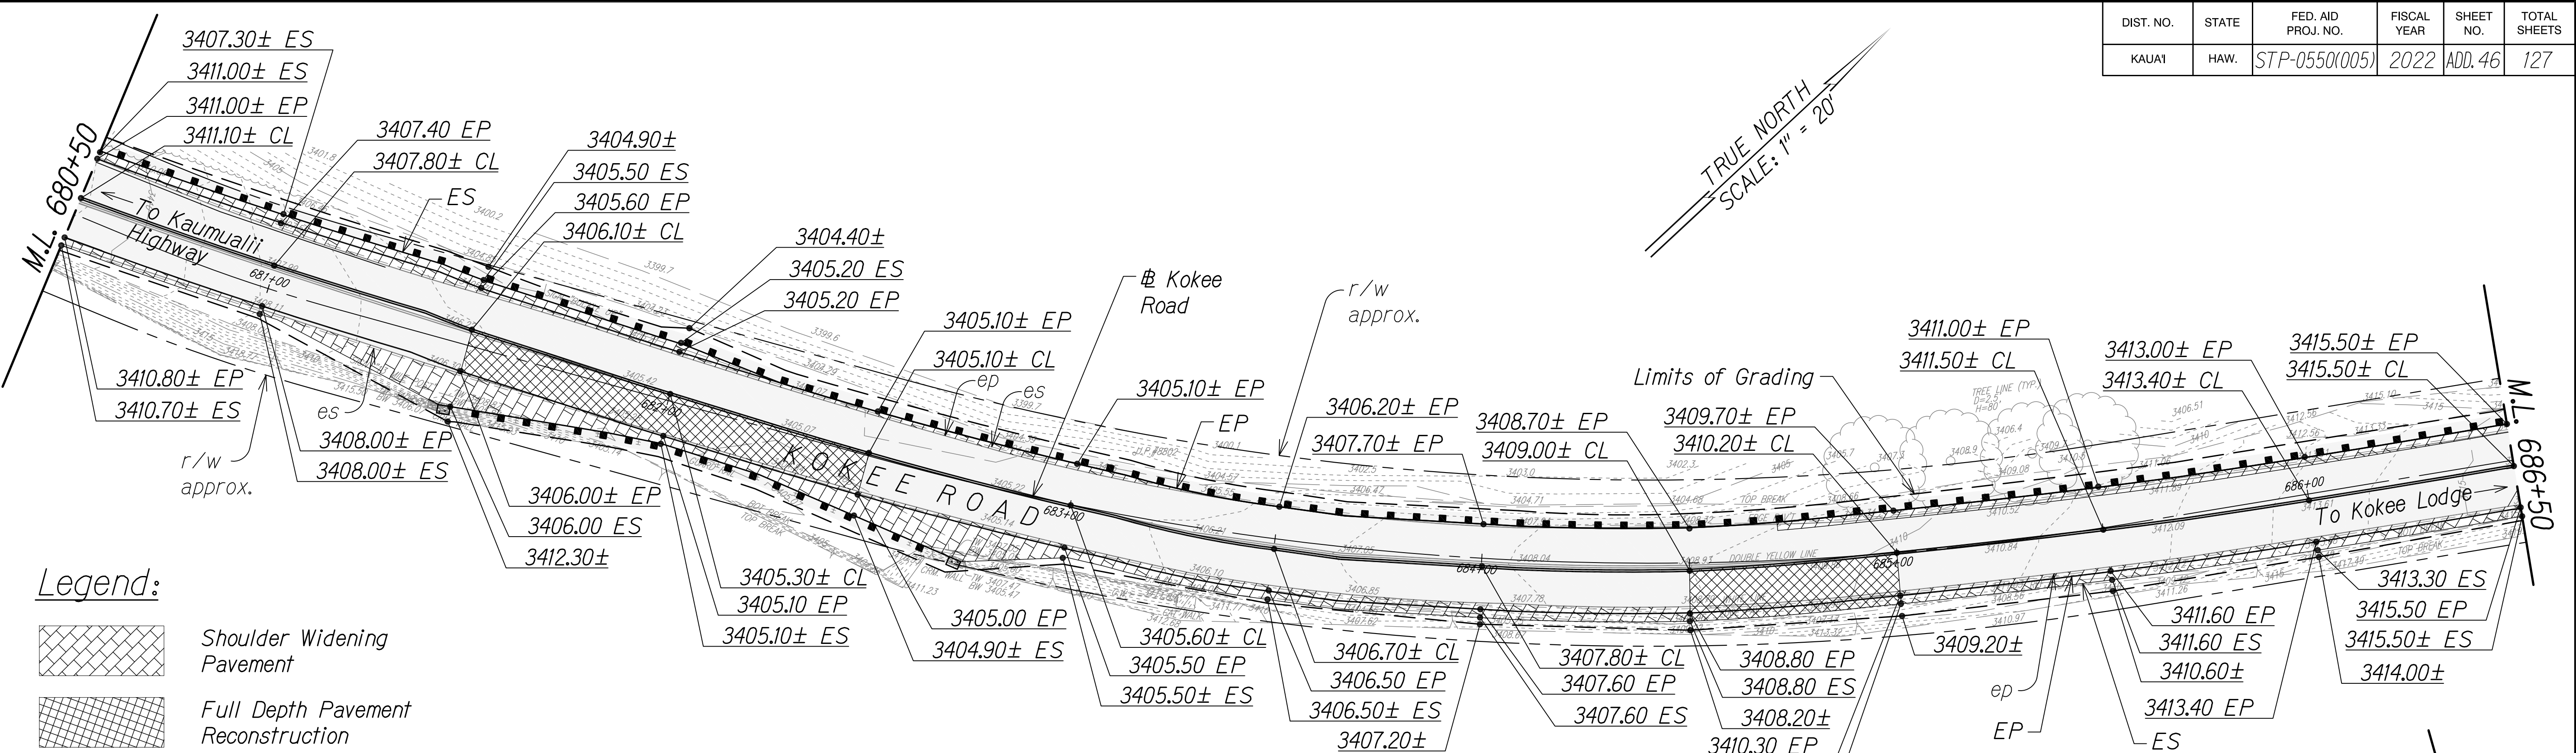


Legend:

- Shoulder Widening Pavement
- Full Depth Pavement Reconstruction
- 2" Asphalt Pavement
- Limits of Grading
- Existing Contour
- Existing Elevation
- Proposed Elevation


STA. 680+50 TO 686+50 (# KOKEE ROAD) ▲

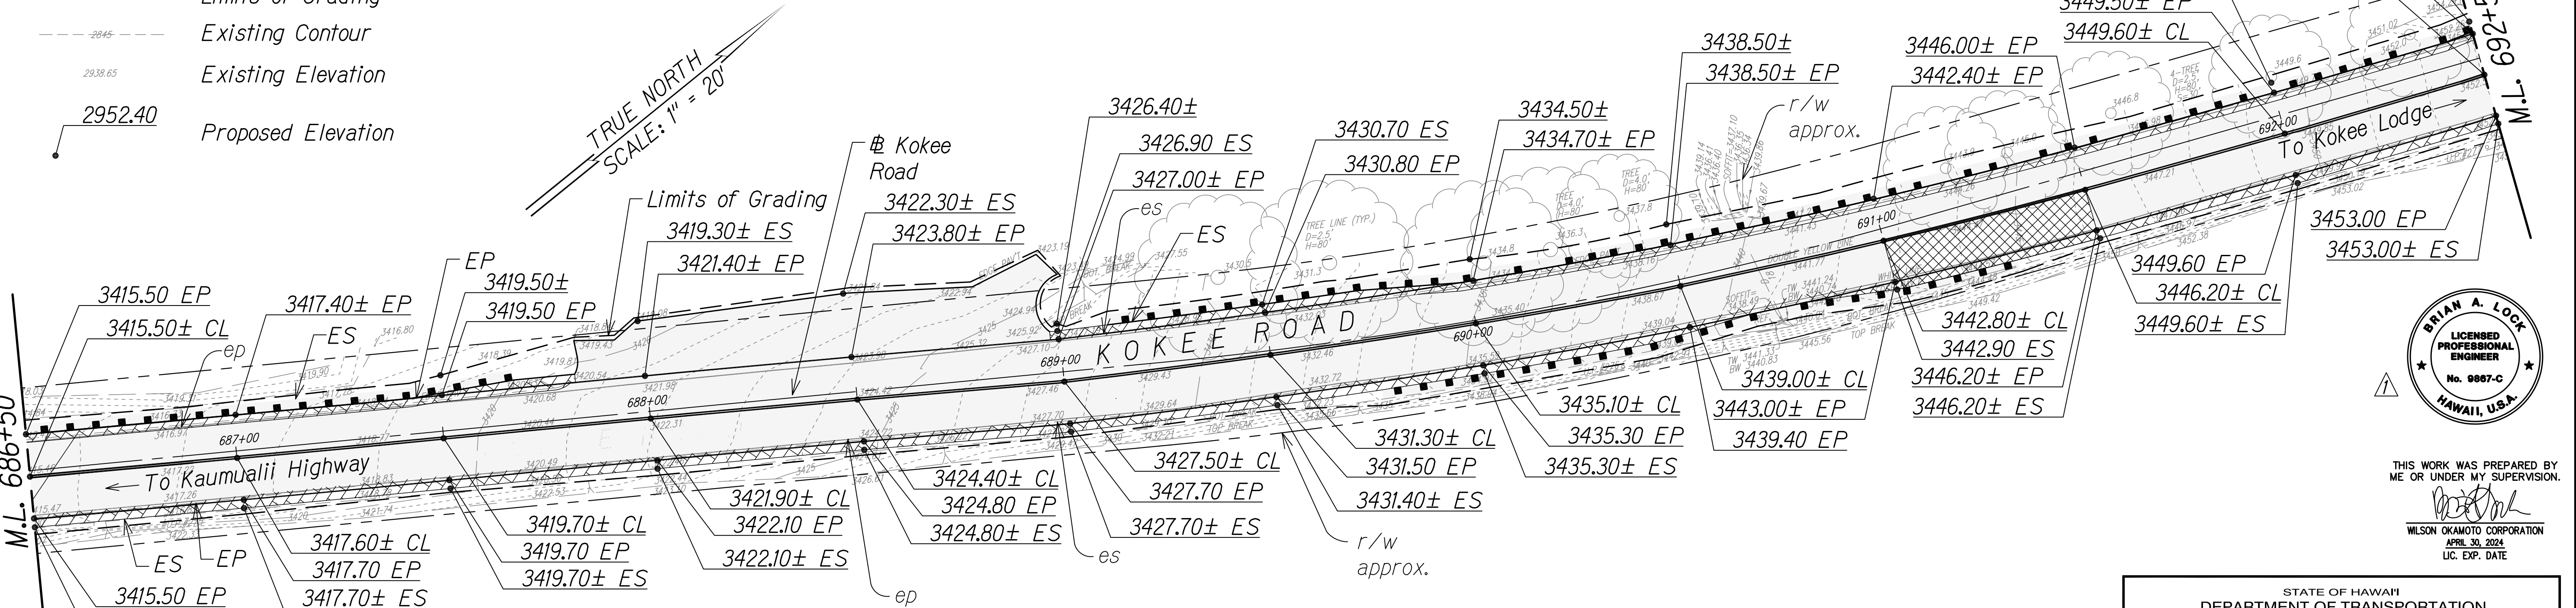

STA. 686+50 TO 692+50 (# KOKEE ROAD) ▲

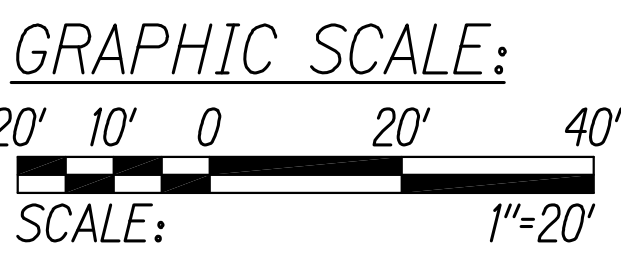

SURVEY PLOTTED BY	DATE
DESIGNED BY	
TRACED BY	
QUANTITIES BY	
CHECKED BY	
ORIGINAL PLAN	No.

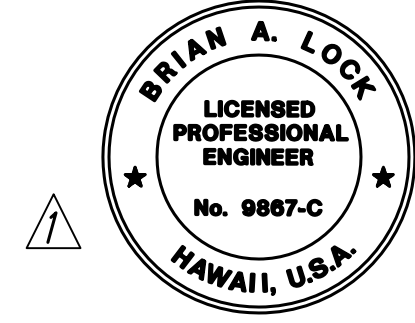

THIS WORK WAS PREPARED BY ME OR UNDER MY SUPERVISION.

[Signature]

WILSON OKAMOTO CORPORATION
APR. 30, 2024
LIC. EXP. DATE

STATE OF HAWAII
DEPARTMENT OF TRANSPORTATION
HIGHWAYS DIVISION


GRADING PLAN

WAIMEA CANYON DRIVE /
KOKEE ROAD IMPROVEMENTS, PHASE 2A
MILE POST 11.5 TO MILE POST 14.0
Federal-Aid Project No. STP-0550(005)
Scale: 1" = 20' Date: August 2022

SHEET No. 8 OF 13 SHEETS

DATE	REVISION
11/07/22	▲ Revised Grading & Callouts; Revised Engineer's Stamp


DIST. NO.	STATE	FED. AID PROJ. NO.	FISCAL YEAR	SHEET NO.	TOTAL SHEETS
KAUAI	HAW.	STP-0550(005)	2022	ADD. 47	127

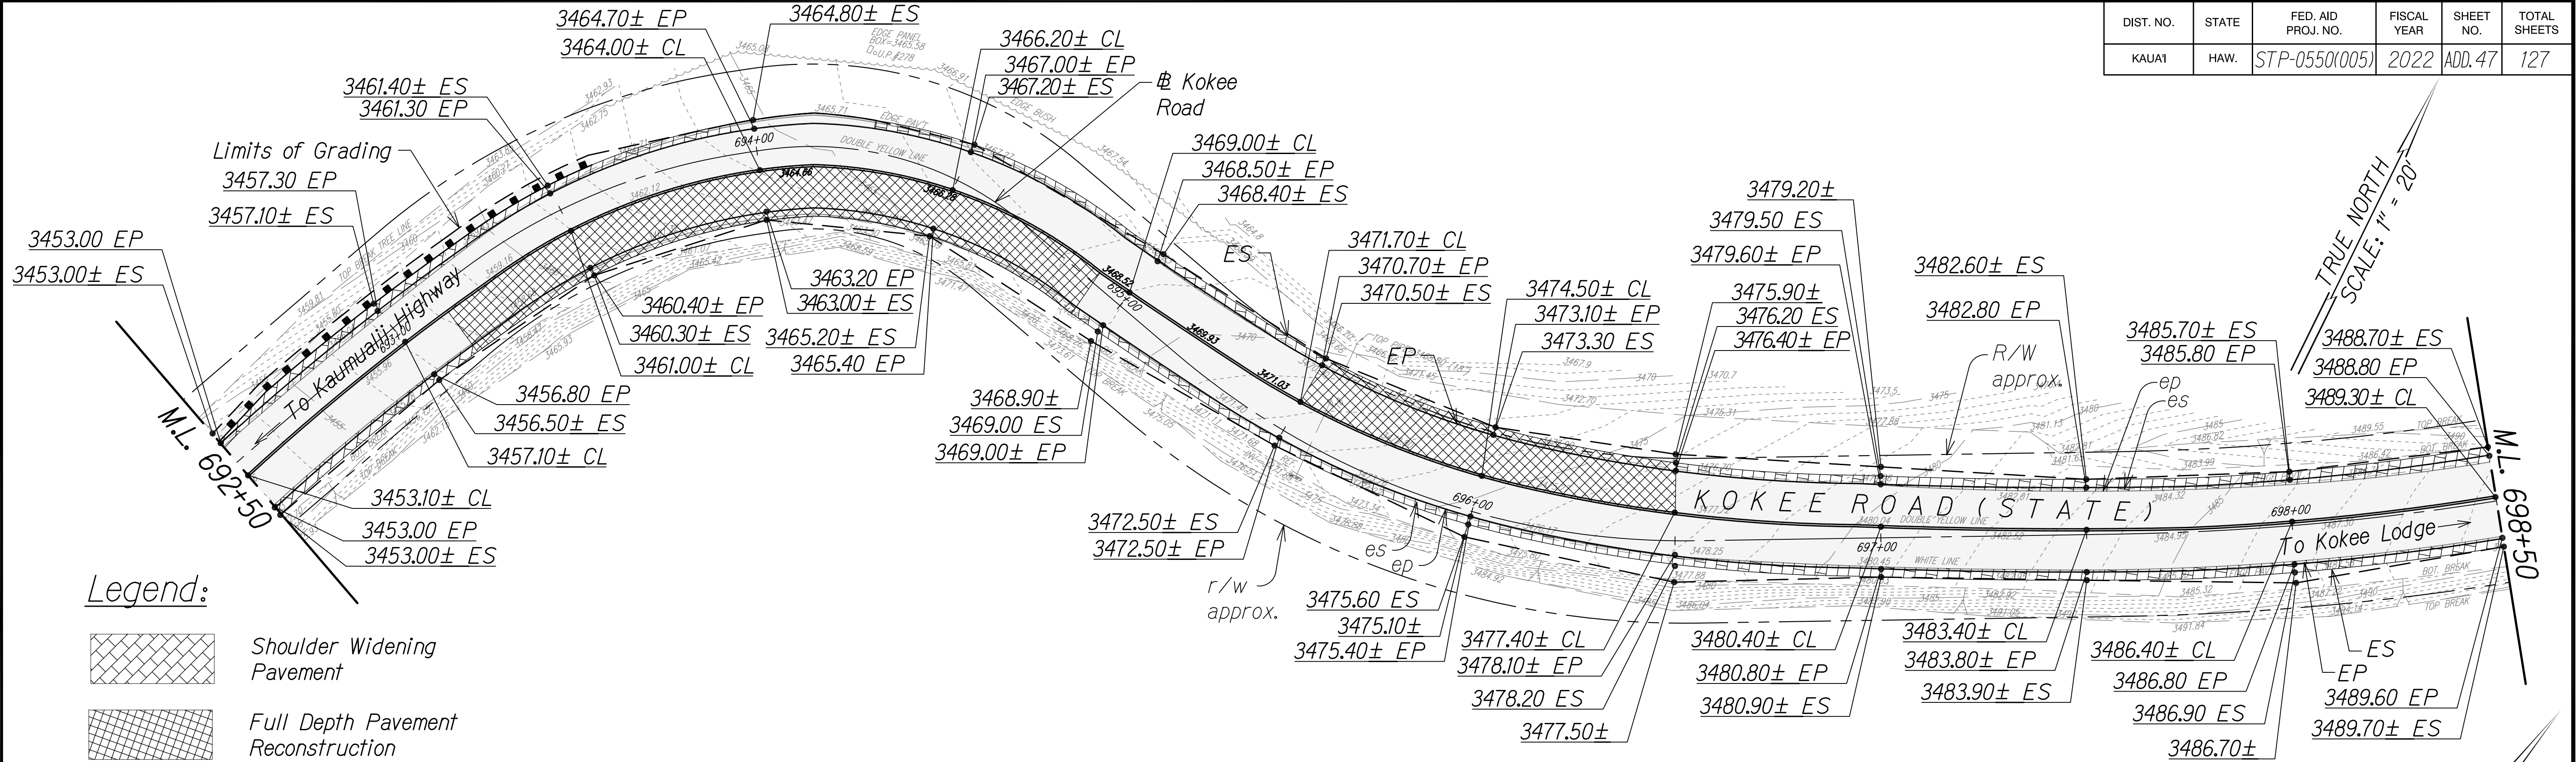

Legend:

- Shoulder Widening Pavement
- Full Depth Pavement Reconstruction
- 2" Asphalt Pavement
- Limits of Grading
- Proposed Contour
- Existing Contour
- Existing Elevation
- Proposed Elevation


STA. 692+50 TO 698+50 (# KOKEE ROAD) Δ

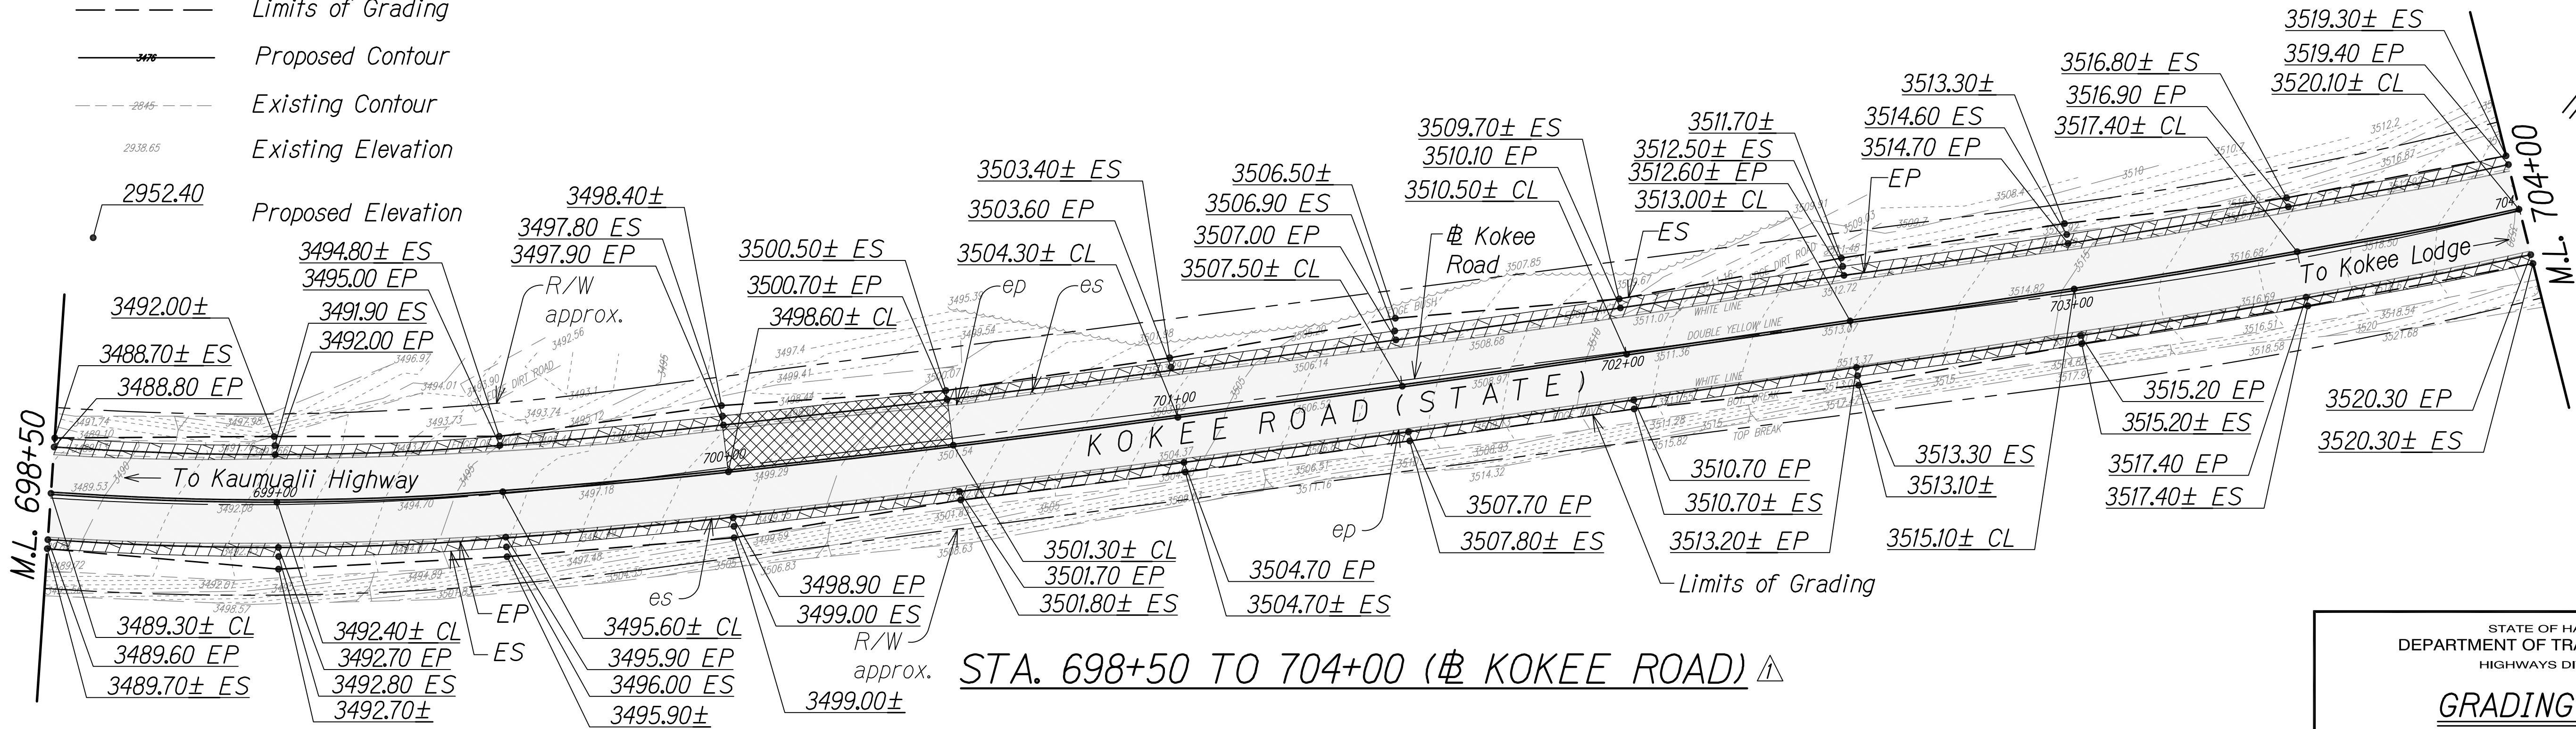

STA. 698+50 TO 704+00 (# KOKEE ROAD) Δ



SURVEY PLOTTED BY	DATE
DESIGNED BY	
NOTED BY	
QUANTITIES BY	
CHECKED BY	

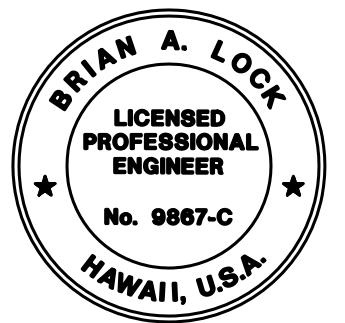

THIS WORK WAS PREPARED BY
ME OR UNDER MY SUPERVISION.
[Signature]
WILSON OKAMOTO CORPORATION
APRIL 30, 2024
LIC. EXP. DATE

STATE OF HAWAII
DEPARTMENT OF TRANSPORTATION
HIGHWAYS DIVISION

GRADING PLAN

WAIMEA CANYON DRIVE /
KOKEE ROAD IMPROVEMENTS, PHASE 2A
MILE POST 11.5 TO MILE POST 14.0
Federal-Aid Project No. STP-0550(005)
Scale: 1" = 20' Date: August 2022


11/07/22	Δ Revised Grading # Callouts; Revised Engineer's Stamp
DATE	REVISION

SHEET No. 9 OF 13 SHEETS

COPY OF ORIGINAL TRACING

ADD 47


DIST. NO.	STATE	FED. AID PROJ. NO.	FISCAL YEAR	SHEET NO.	TOTAL SHEETS
KAUAI	HAW.	STP-0550(005)	2022	ADD. 48	127

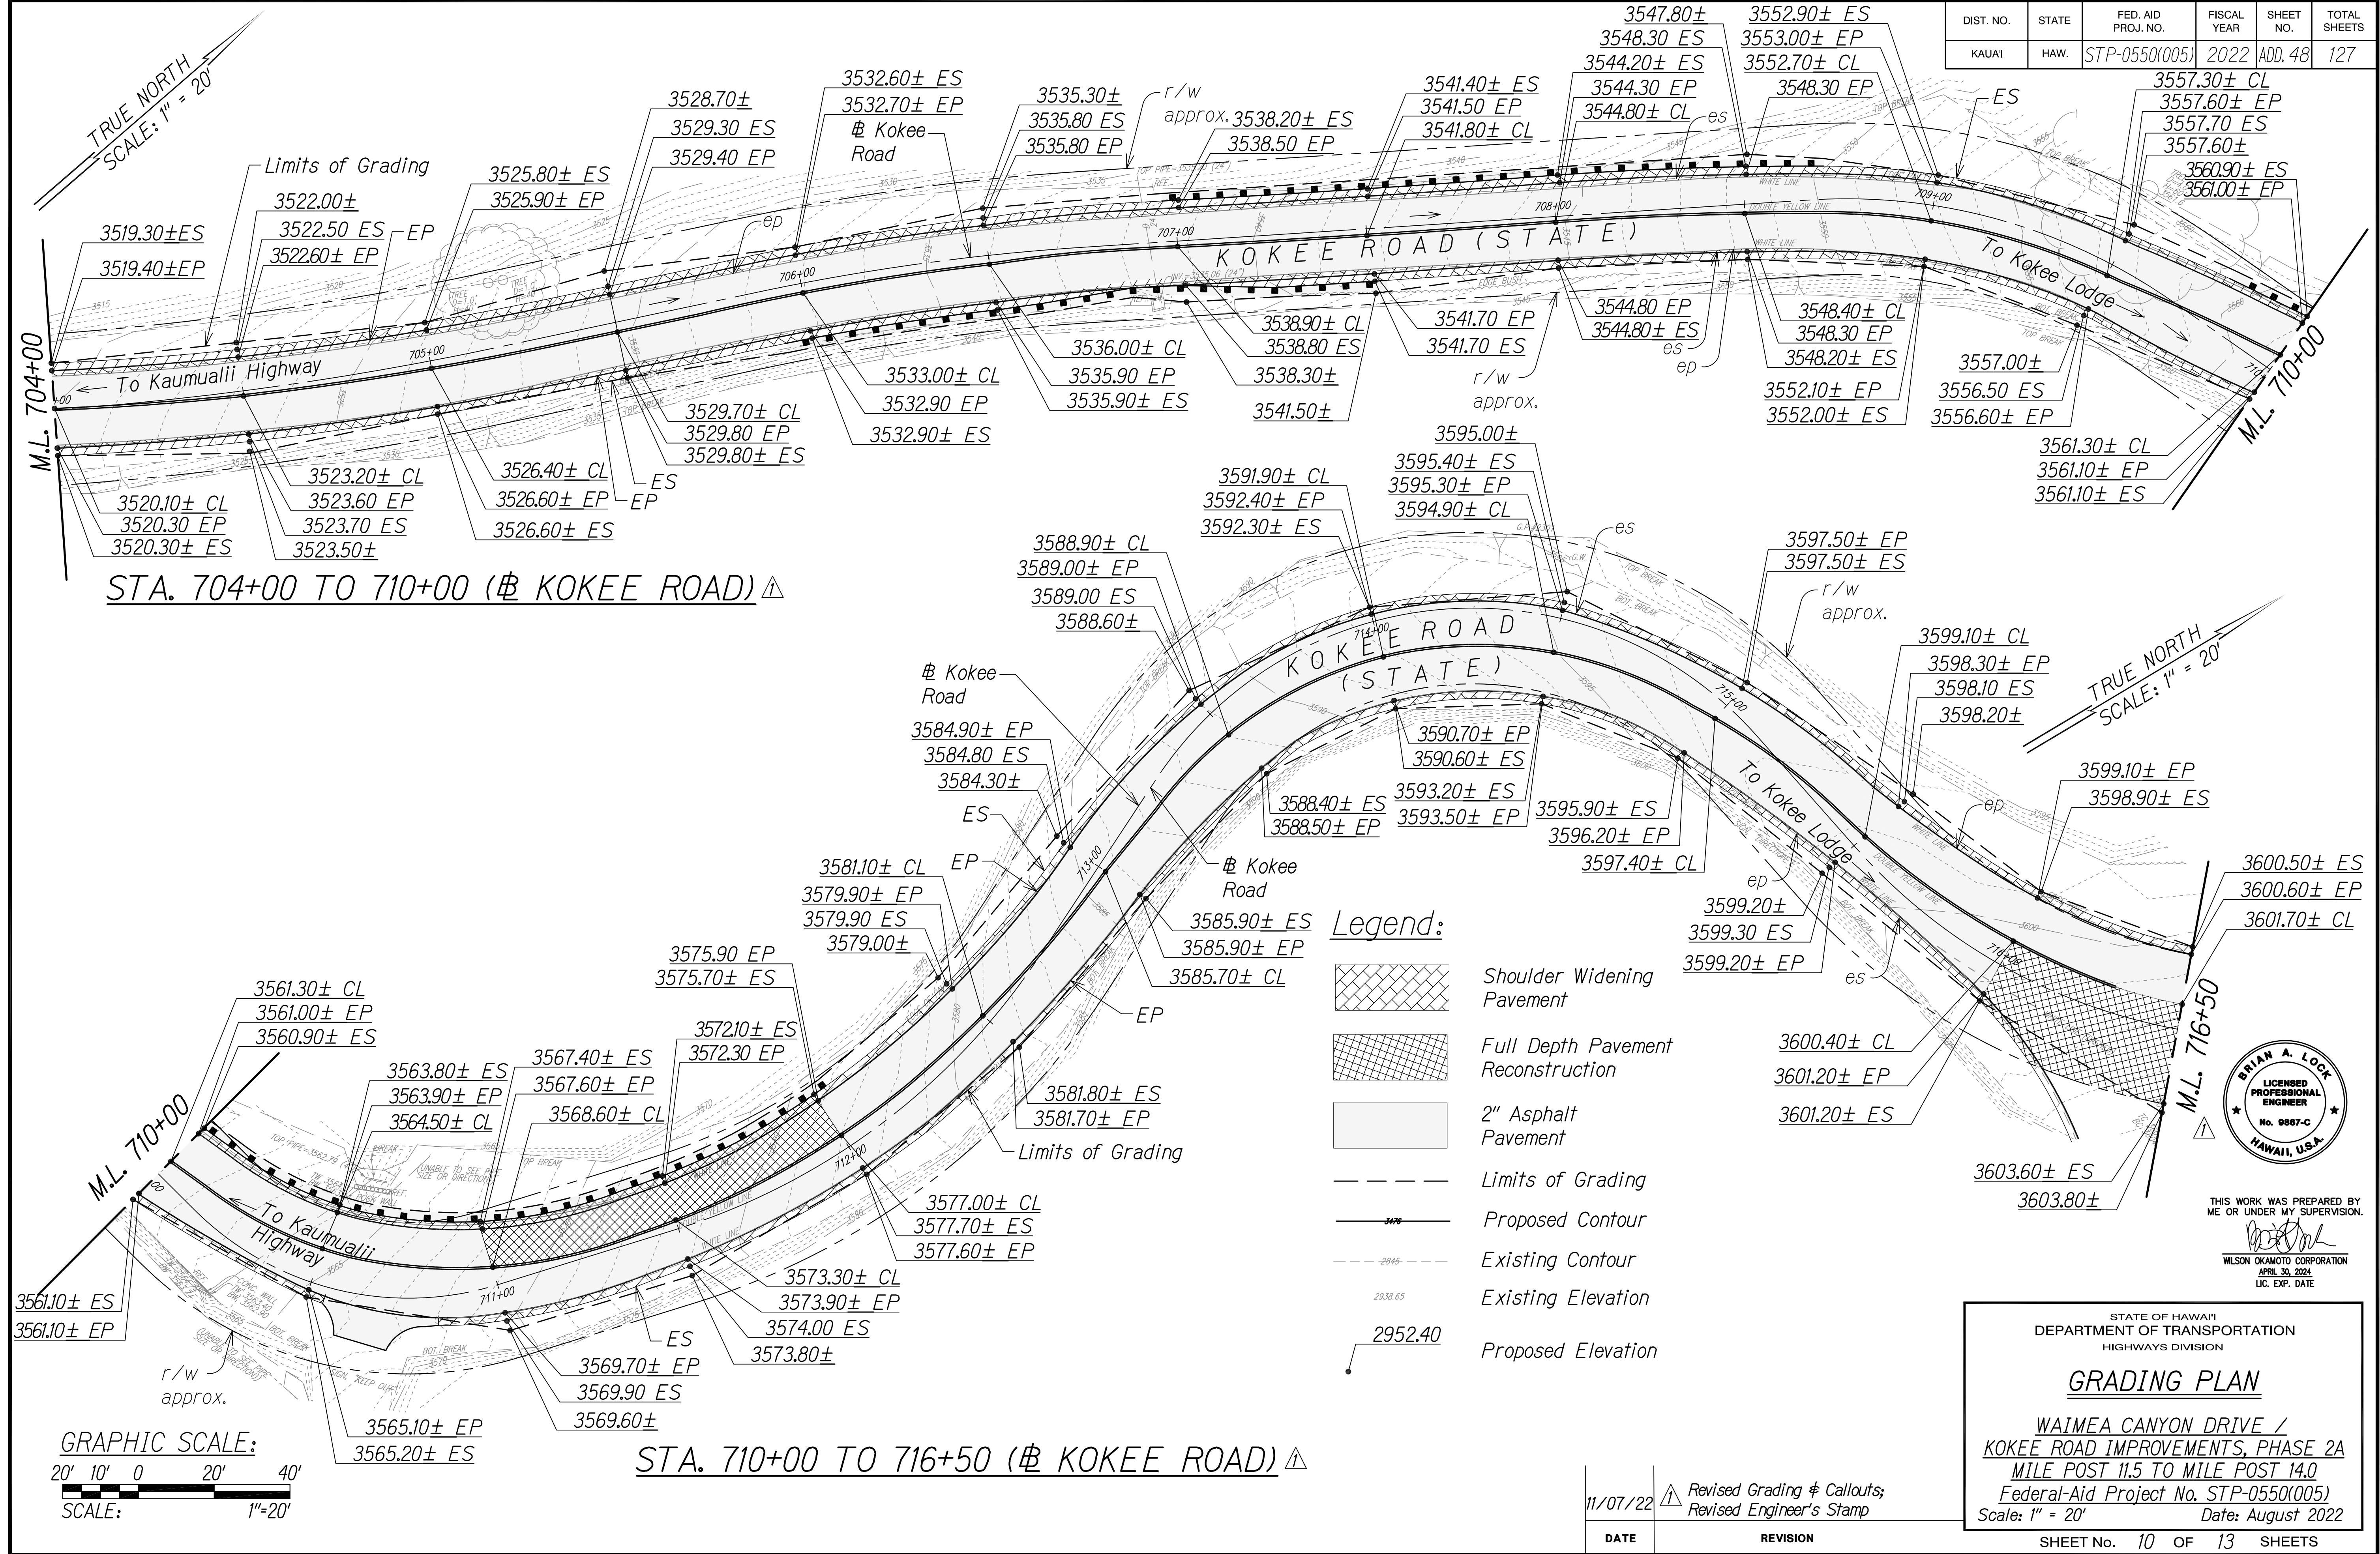

COPY OF ORIGINAL TRACING

ADD 48


DIST. NO.	STATE	FED. AID PROJ. NO.	FISCAL YEAR	SHEET NO.	TOTAL SHEETS
KAUAI	HAW.	STP-0550(005)	2022	ADD. 49	127

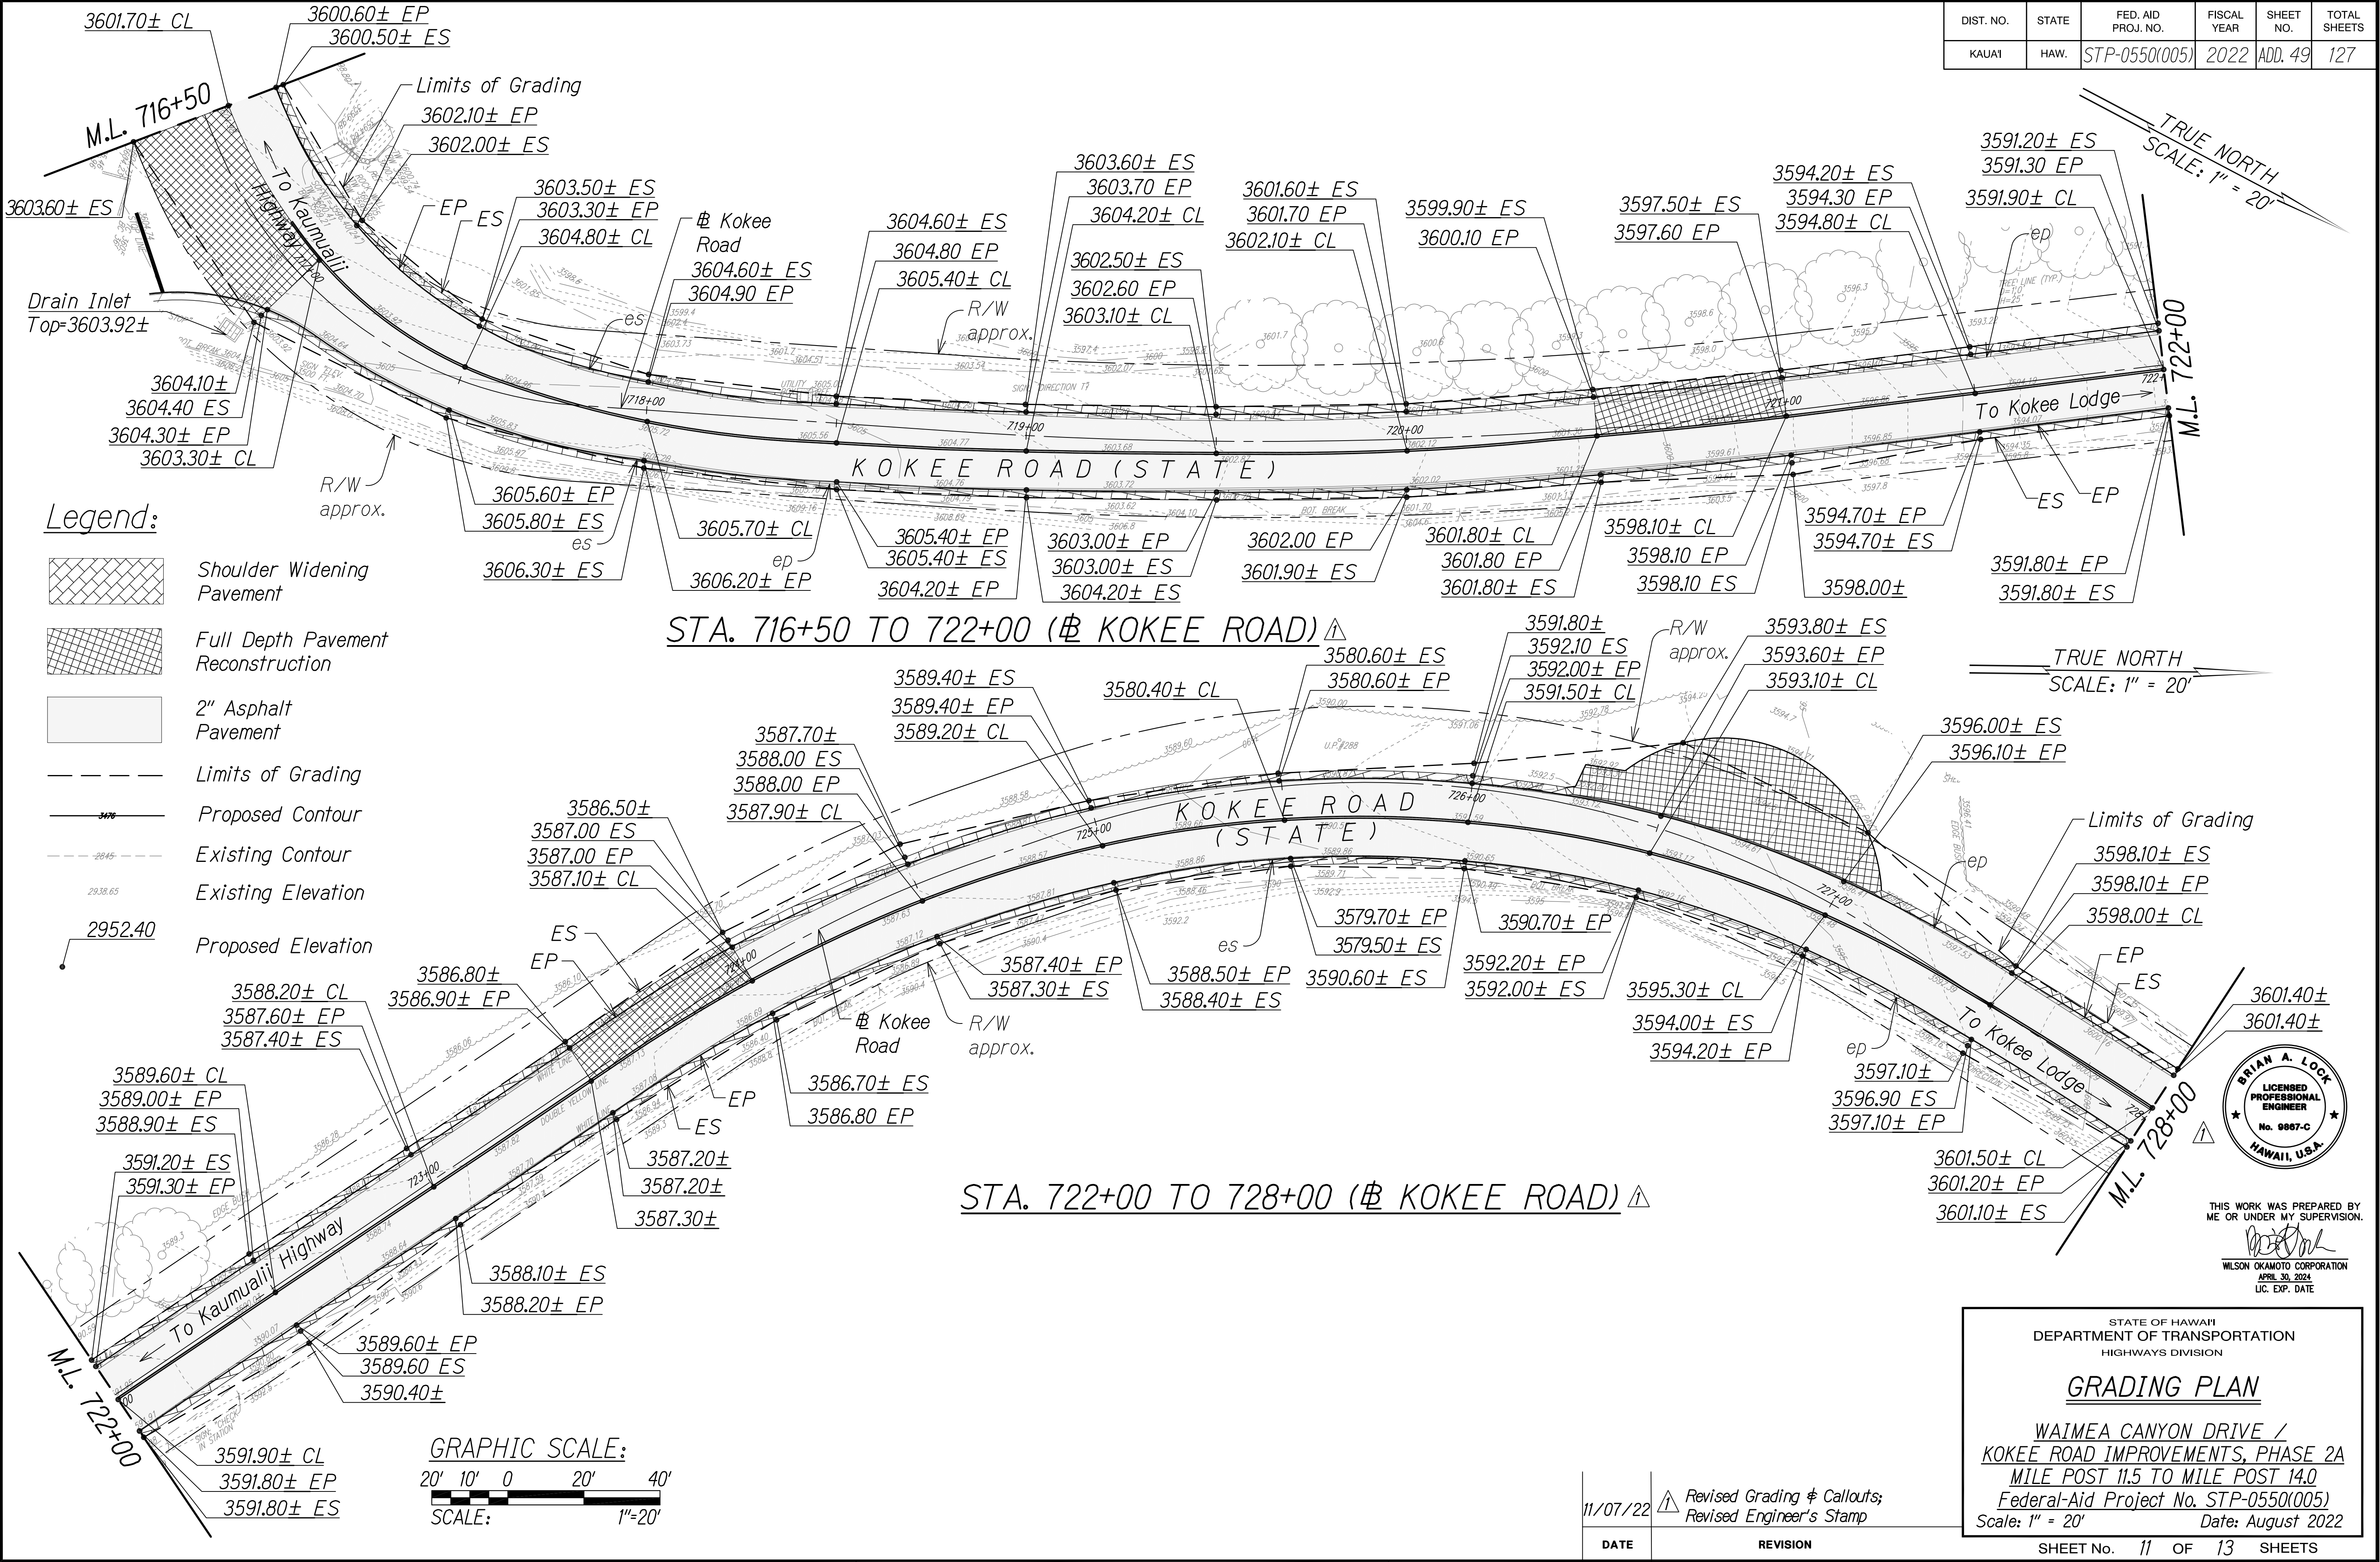


COPY OF ORIGINAL TRACING

ADD 49

DIST. NO.	STATE	FED. AID PROJ. NO.	FISCAL YEAR	SHEET NO.	TOTAL SHEETS
KAUAI	HAW.	STP-0550(005)	2022	ADD. 50	127

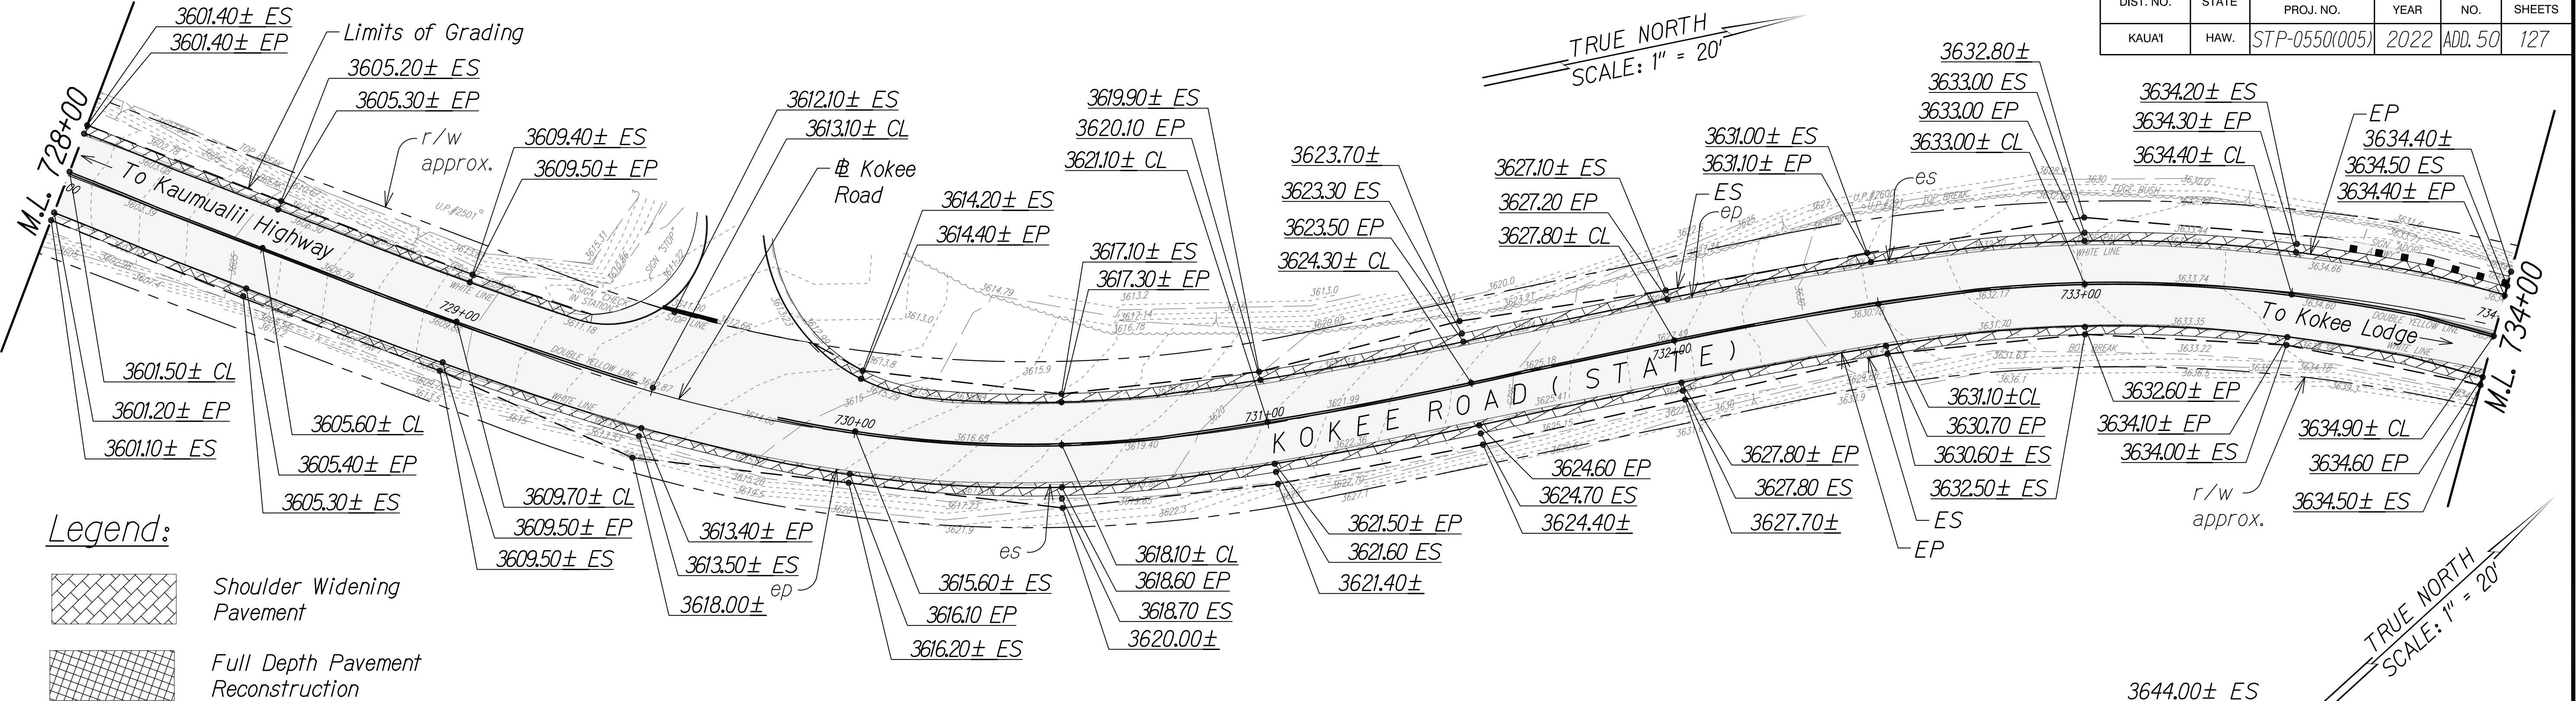


STA. 728+00 TO 734+00 (# KOKEE ROAD) ▲

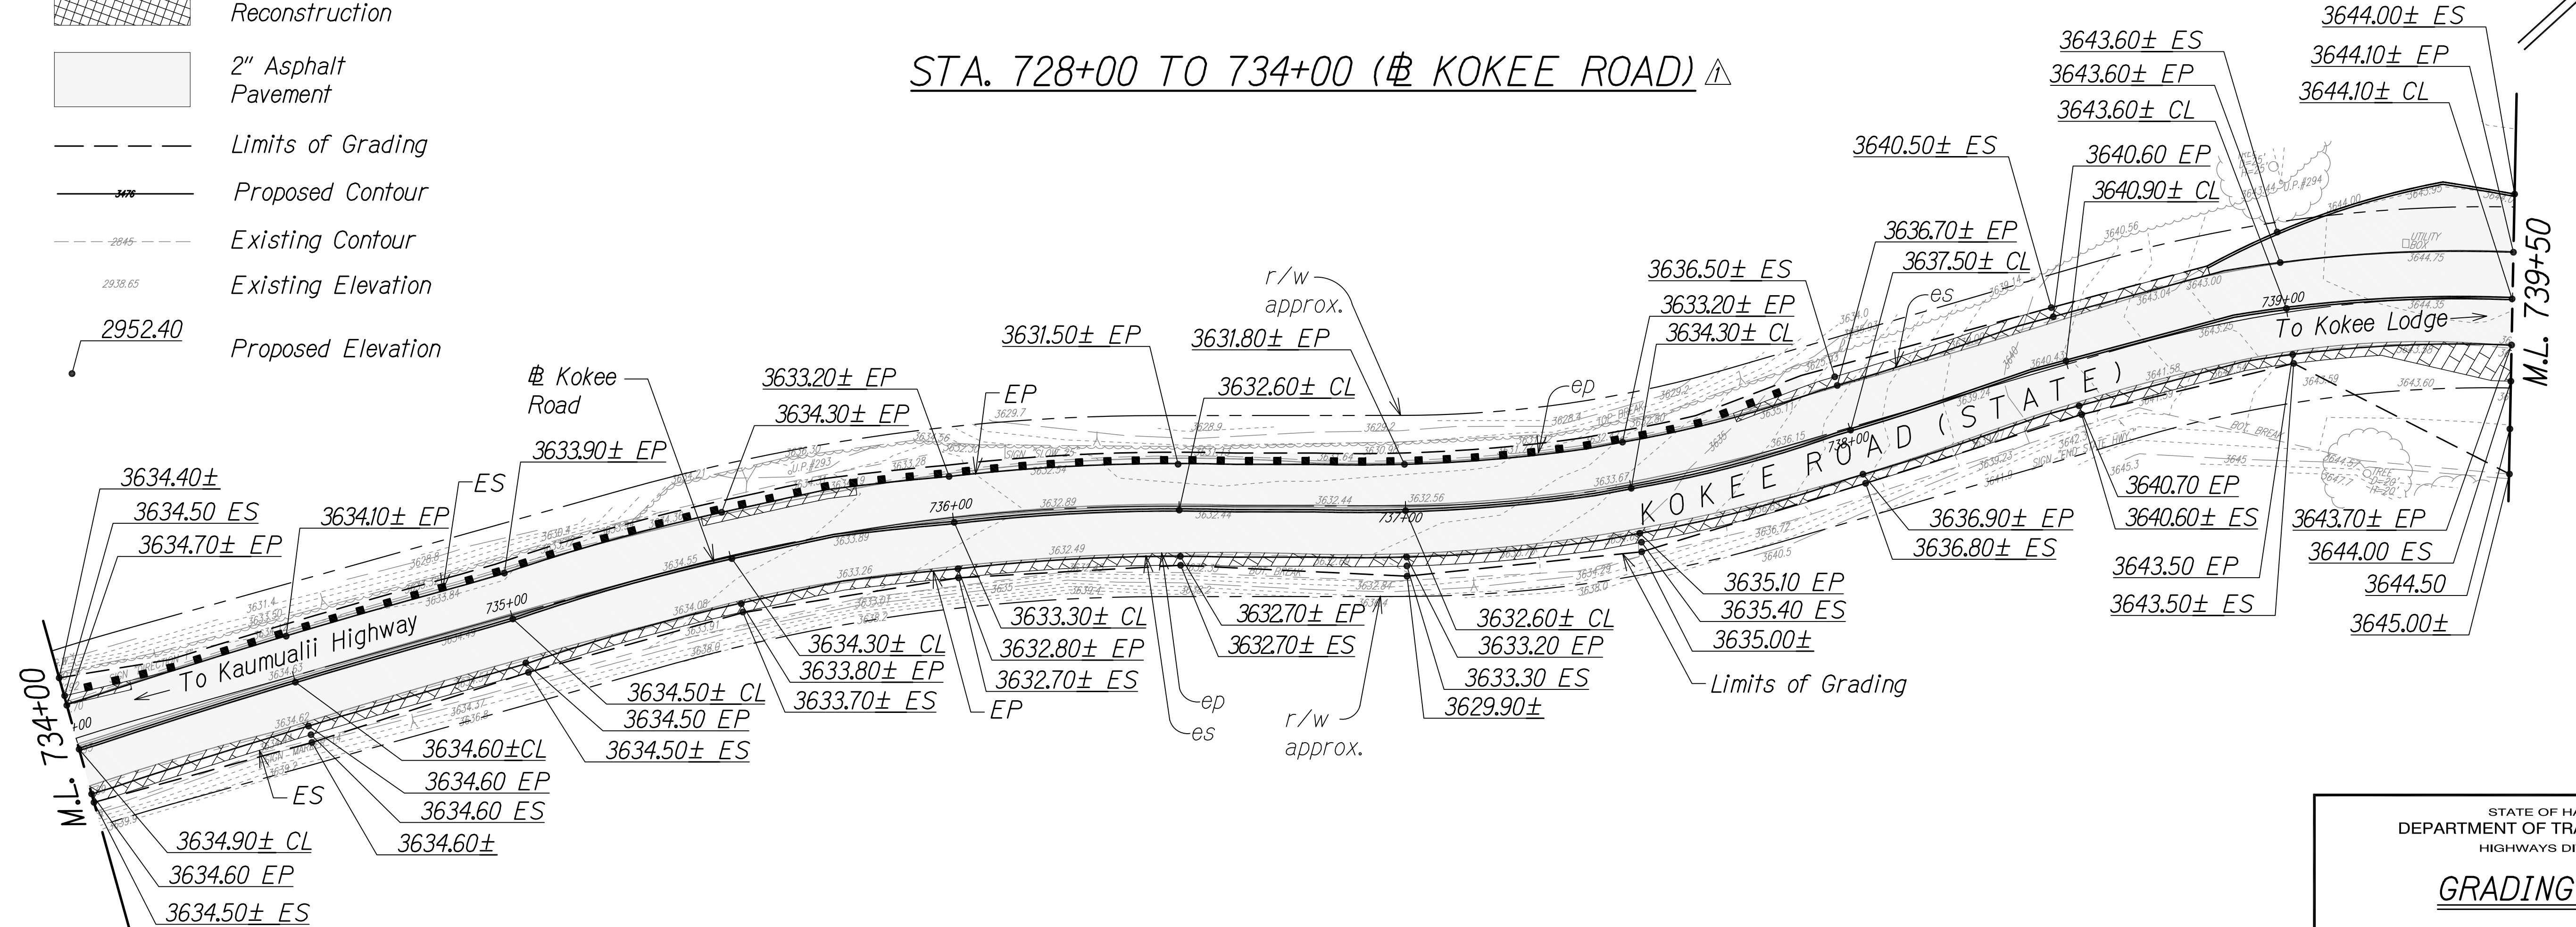

STA. 734+00 TO 739+50 (# KOKEE ROAD) ▲

SURVEY PLOTTED BY	DATE
DESIGNED BY	
TRACED BY	
QUANTITIES BY	
CHECKED BY	

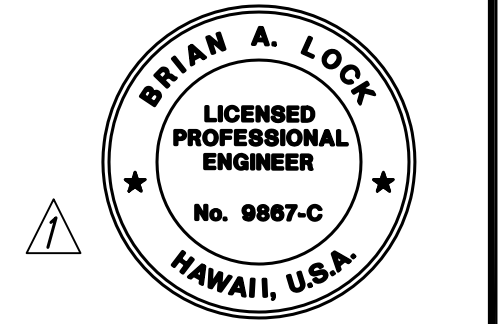

THIS WORK WAS PREPARED BY ME OR UNDER MY SUPERVISION.
WILSON OKAMOTO CORPORATION
APRIL 30, 2024
LIC. EXP. DATE

STATE OF HAWAII
DEPARTMENT OF TRANSPORTATION
HIGHWAYS DIVISION

GRADING PLAN


WAIMEA CANYON DRIVE /
KOKEE ROAD IMPROVEMENTS, PHASE 2A
MILE POST 11.5 TO MILE POST 14.0
Federal-Aid Project No. STP-0550(005)
Scale: 1" = 20' Date: August 2022


SHEET No. 12 OF 13 SHEETS

11/07/22	Revised Grading & Callouts; Revised Engineer's Stamp
DATE	REVISION


DIST. NO.	STATE	FED. AID PROJ. NO.	FISCAL YEAR	SHEET NO.	TOTAL SHEETS
KAUAI	HAW.	STP-0550(005)	2022	ADD. 51	127


Legend:

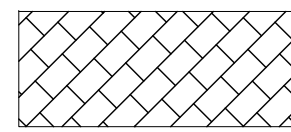- 

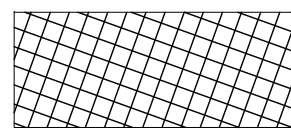Shoulder Widening Pavement
- 

Full Depth Pavement Reconstruction
- 

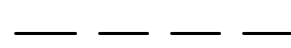2" Asphalt Pavement
- 

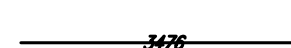
Limits of Grading
- 

Proposed Contour
- 

Existing Contour
- 

Existing Elevation
- 


Proposed Elevation

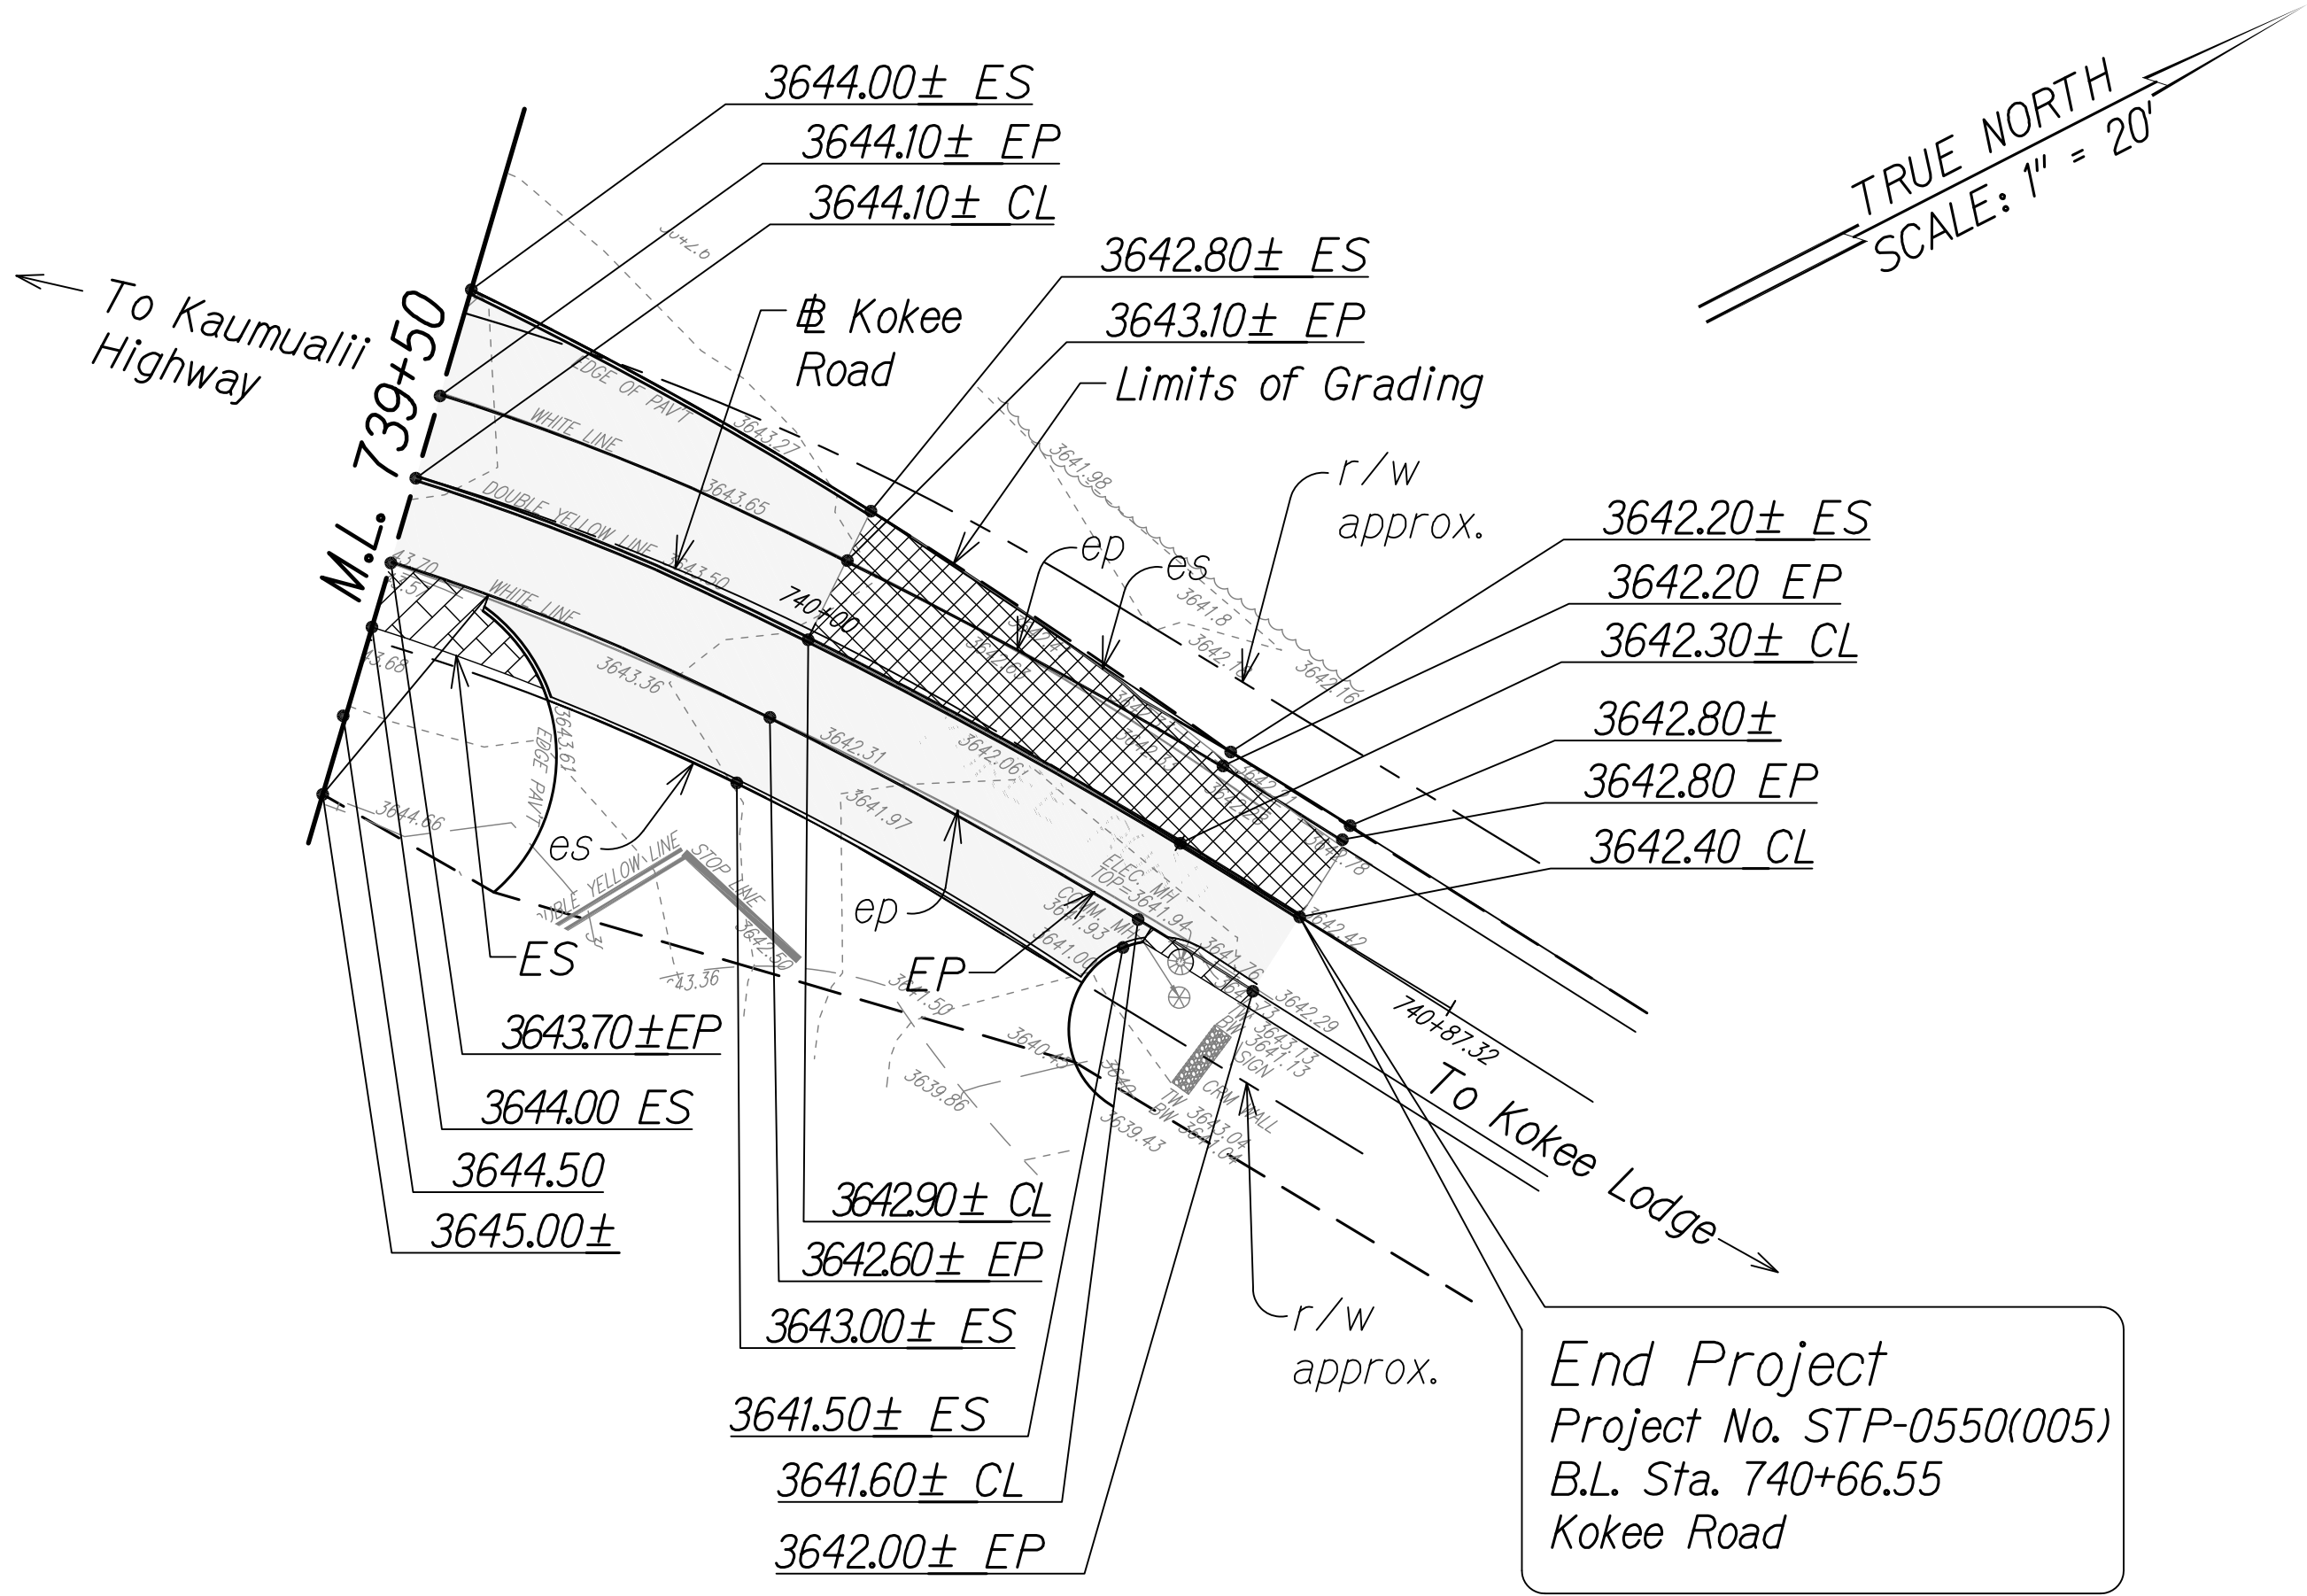


STA. 739+50 TO 740+66.55 (Kokee Road)

Notes

1. Unpaved Shoulders shall be Graded to Promote Positive Drainage.

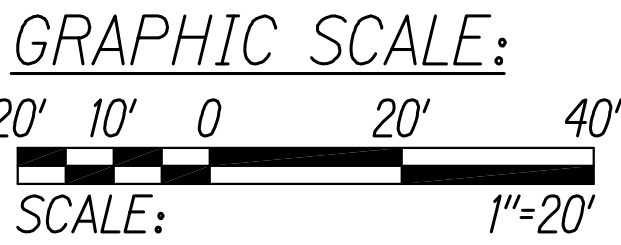

SURVEY PLOTTED BY	DATE
DESIGNED BY	
TRACED BY	
NOTED BY	
QUANTITIES BY	
CHECKED BY	

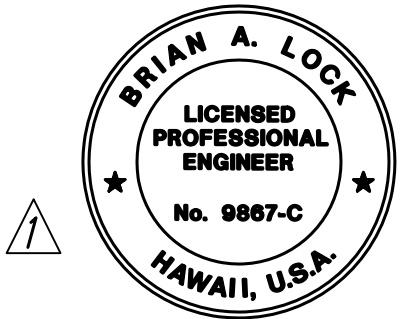

THIS WORK WAS PREPARED BY ME OR UNDER MY SUPERVISION.

[Signature]

WILSON OKAMOTO CORPORATION
APRIL 30, 2024
LIC. EXP. DATE

STATE OF HAWAII
DEPARTMENT OF TRANSPORTATION
HIGHWAYS DIVISION

GRADING PLAN

WAIMEA CANYON DRIVE /
Kokee Road Improvements, Phase 2A
MILE POST 11.5 TO MILE POST 14.0
Federal-Aid Project No. STP-0550(005)
Scale: 1" = 20' Date: August 2022

SHEET No. 13 OF 13 SHEETS

11/07/22	Revised Grading & Callouts; Revised Engineer's Stamp
DATE	REVISION