


DIST. NO.	STATE	FED. AID PROJ. NO.	FISCAL YEAR	SHEET NO.	TOTAL SHEETS
KAUAI	HAW.	STP-0550(005)	2022	ADD. 4	127

LEGEND

	Existing Electrical Line
	Existing Joint Pole
	Existing Power Pole
	Existing Electric Manhole
	Existing Telephone Line
	Existing Telephone Pole
	Existing Telephone Manhole
	Existing Monument
	Existing 24" Drain Line
	Existing Storm Drain Manhole
	Existing Grated Drop Inlet
	Existing Catch Basin
	Existing Traffic Sign
	Existing Highway Lighting Standard
	Existing Highway Lighting Pullbox
	New Guardrail
	Existing Metal Guardrail
	Existing Right-of-Way
	New Right-of-Way
	New Traffic Sign
	New Pavement Grade
	existing pavement grade

ABBREVIATIONS


A.C., a.c.	Asphalt Concrete
#	Baseline
BB	Bottom of Bank
EP	New Edge of Pavement
ES	New Edge of Shoulder
ep	existing edge of pavement
es	existing edge of shoulder
P.C.	Point of Curvature
P.O.C.C.	Point of Compound Curvature
P.C.C.	Portland Cement Concrete
P.I.	Point of Intersection
P.O.C.	Point on Curvature
P.T.	Point of Tangency
R	Radius
R/W	Right-of-Way
R.P.M.	Raised Pavement Marker
TB	Top of Bank

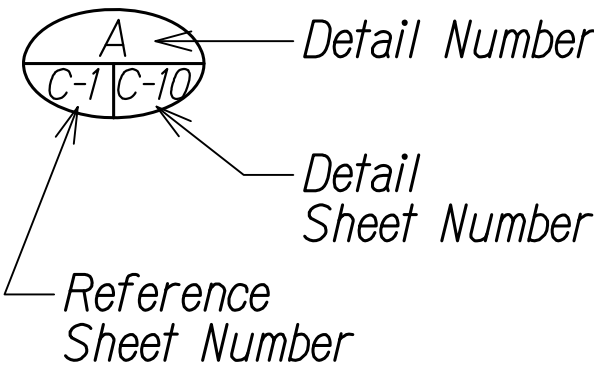

LEGEND

A.C.	ASPHALT CONCRETE	INV.	INVERT
A/C	AIR CONDITIONING	JTS	JOINT TRUNKING SYSTEM
APPROX.	APPROXIMATE	L.P.	LAMP POLE
ARV	AIR RELEASE VALVE	M.B.	MAIL BOX
BC	BOTTOM CURB	MH	MANHOLE
BFP	BACK FLOW PREVENTER	O/H	OVERHEAD
BOT.	BOTTOM	PAV'T.	PAVEMENT
BW	BOTTOM WALL	P.M.	PARKING METER
CATV	CABLE TELEVISION	P.P.	POWER POLE
C.B.	CATCH BASIN	PSL	PEDESTRIAN SIGNAL LIGHT
C.L.	CHAIN LINK	REF.	REFLECTOR
CMU	CONCRETE MASONRY UNIT	S	SEWER OR SPREAD
C.O.	CLEAN OUT	SC	SIGNAL CORPS
COL.	COLUMN	SCMH	SIGNAL CORPS MANHOLE
COMM.	COMMUNICATION	SDMH	STORM DRAIN MANHOLE
CONC.	CONCRETE	S.L.	STREET LIGHT
CRM	CONCRETE RUBBLE MASONRY	SLB	STREET LIGHT BOX
D	DIAMETER OR DRAIN	SMH	SEWER MANHOLE
D.I.	DRAIN INLET	SPR.	SPRINKLER
D.S.	DOWN SPOUT	ST. NAME	STREET NAME
DSP	DRY STAND PIPE	STA.	STATION
DWY.	DRIVEWAY	TC	TOP CURB
E/ELEC.	ELECTRIC	TDC	TOP DROP CURB
ELEV./EL.	ELEVATION	T/TEL.	TELEPHONE
F.A.	FIRE ALARM	TP	TOP PIPE
F.H.	FIRE HYDRANT	TRC	TOP ROLLED CURB
FL	FLOW LINE	TS	TOP STEM
FM	FORCE MAIN	TSL	TRAFFIC SIGNAL LIGHT
G	GAS	TSLB	TRAFFIC SIGNAL LIGHT BOX
G.I.	GRADED INLET	TV	TOP VALVE
GMH	GAS MANHOLE	TW	TOP WALL
GND.	GROUND	U.P.	UTILITY POLE
G.P.	GUARD POST/GUY POLE/GATE POST	U.P./S.L.	UTILITY POLE W/STREET LIGHT
GV	GAS VALVE	W	WATER
G.W.	GUY WIRE	WM	WATER METER
H	HEIGHT	WMH	WATER MANHOLE
H.B.	HOSE BIB	WV	WATER VALVE BOX
ICV	IRRIGATION CONTROL VALVE	X-WALK	CROSS WALK

ORIGINAL PLAN	SURVEY PLOTTED BY	DATE
	DESIGNED BY	
	NOTED BY	
	CHECKED BY	
NOTE BOOK	QUANTITIES BY	
	NO.	

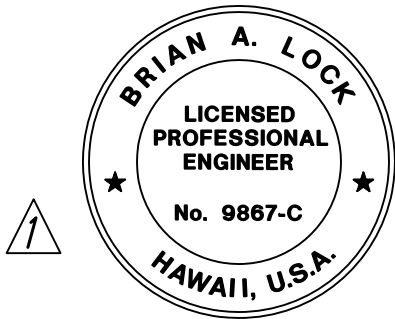

THIS WORK WAS PREPARED BY ME OR UNDER MY SUPERVISION.
WILSON OKAMOTO CORPORATION
APRIL 30, 2024
LIC. EXP. DATE

STATE OF HAWAII
DEPARTMENT OF TRANSPORTATION
HIGHWAYS DIVISION

LEGEND AND ABBREVIATIONS

WAIMEA CANYON DRIVE /
KOEKE ROAD IMPROVEMENTS, PHASE 2A
MILE POST 11.5 TO MILE POST 14.0
Federal-Aid Project No. STP-0550(005)
Scale: None Date: August 2022

11/07/22	Revised Engineer's Stamp
DATE	REVISION

SHEET No. 1 OF 1 SHEETS