
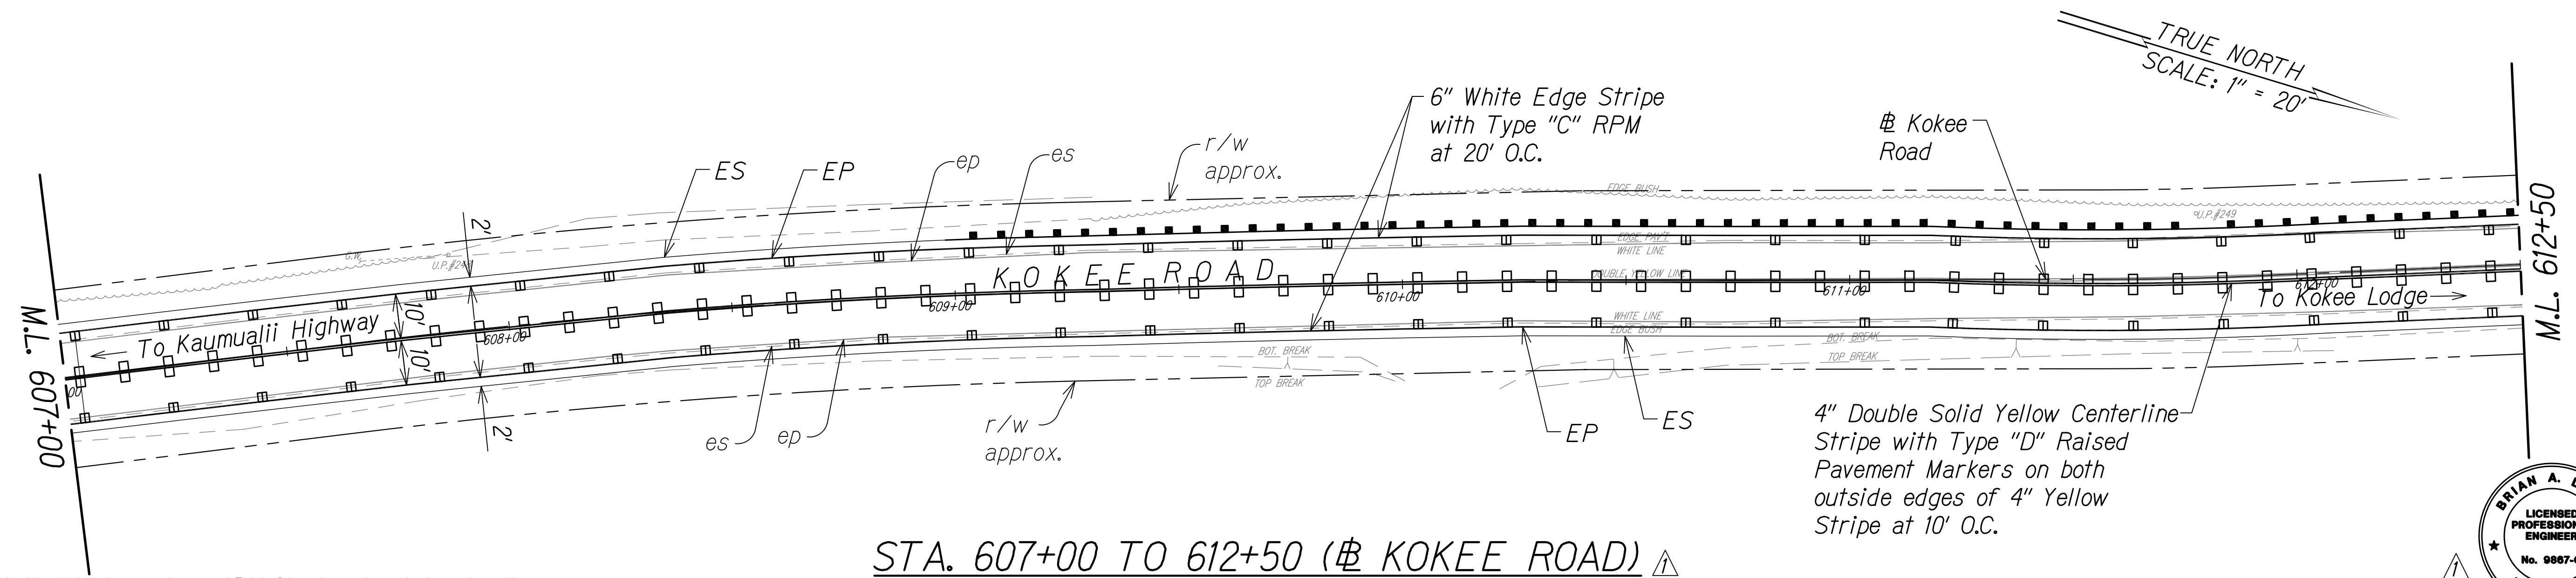


DIST. NO.	STATE	FED. AID PROJ. NO.	FISCAL YEAR	SHEET NO.	TOTAL SHEETS
KAUA'I	HAW.	STP-0550(005)	2022	ADD. 56	127

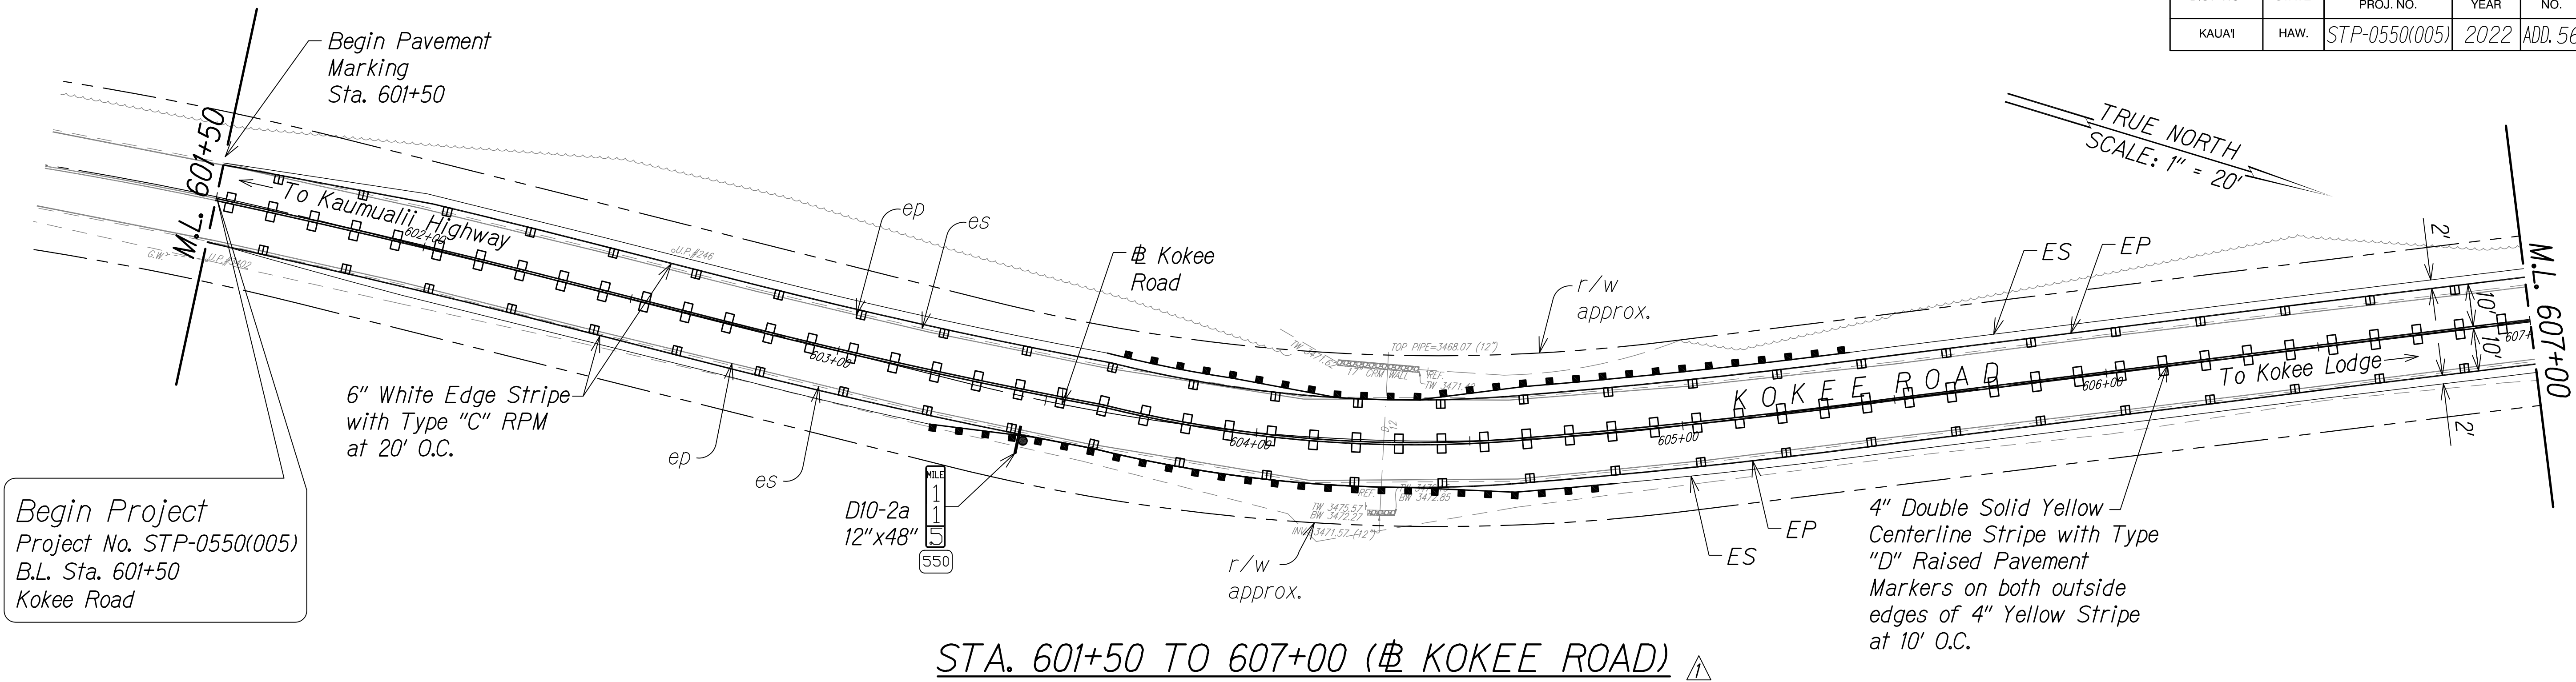


Notes

1. Install object markers (RM-3) at culvert headwall crossings.
2. Install object markers (OM2-2H) on all utility poles within ROW.
3. OM-5 to be installed on all regulatory and warning signs. Install OM-2V on other types of signs.
4. Install White Reflector Markers (RM-3) behind guardrails at spacing identified on Table 3F-1 in MUTCD or 200' on tangents (from end to end).

GRAPHIC SCALE:
20' 10' 0 20' 40'
SCALE: 1"=20'

SURVEY PLOTTED BY	DATE
DESIGNED BY	
TRACED BY	
NOTE BOOK	
QUANTITIES BY	
CHECKED BY	

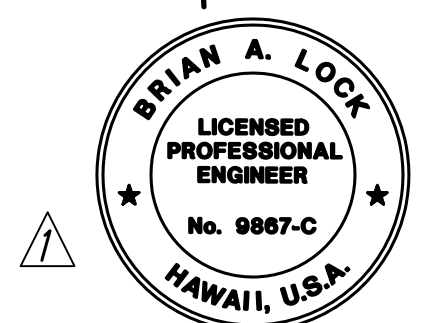


THIS WORK WAS PREPARED BY
ME OR UNDER MY SUPERVISION.
WILSON OKAMOTO CORPORATION
APRIL 30, 2024
LIC. EXP. DATE

STATE OF HAWAII DEPARTMENT OF TRANSPORTATION HIGHWAYS DIVISION PAVEMENT MARKING & SIGNING PLAN WAIMEA CANYON DRIVE / KOKEE ROAD IMPROVEMENTS, PHASE 2A MILE POST 11.5 TO MILE POST 14.0 Federal-Aid Project No. STP-0550(005) Scale: 1" = 20' Date: August 2022
Revised Presentation of RPM; Revised Engineer's Stamp DATE: 11/07/22
SHEET No. 1 OF 13 SHEETS


COPY OF ORIGINAL TRACING

ADD 56

DIST. NO.	STATE	FED. AID PROJ. NO.	FISCAL YEAR	SHEET NO.	TOTAL SHEETS
KAUAI	HAW.	STP-0550(005)	2022	ADD. 58	127

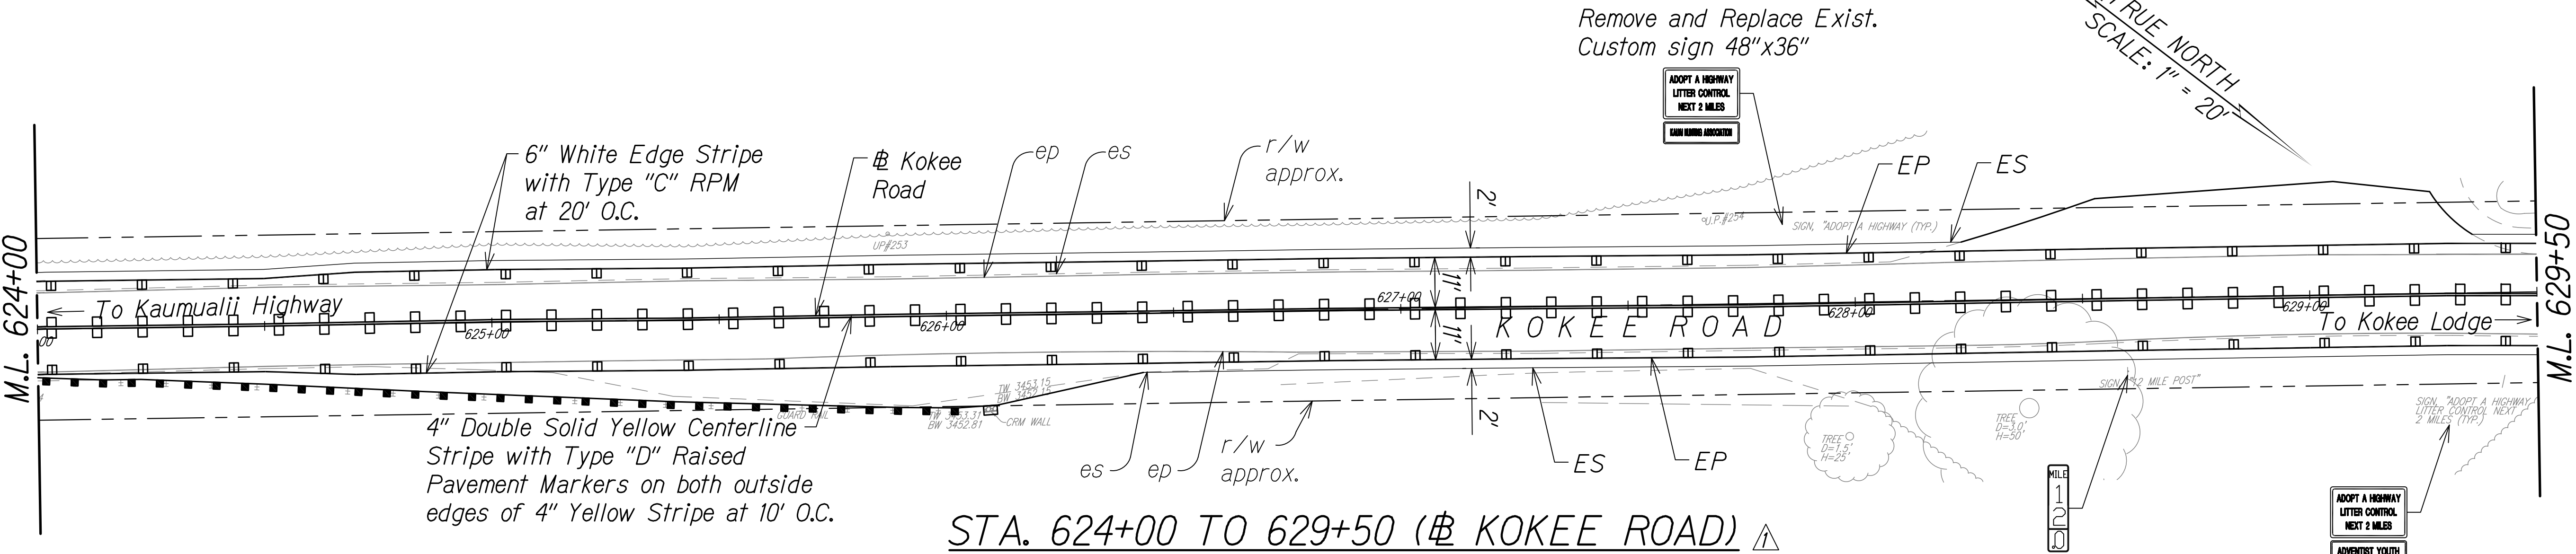


STA. 624+00 TO 629+50 (Kokee Road)

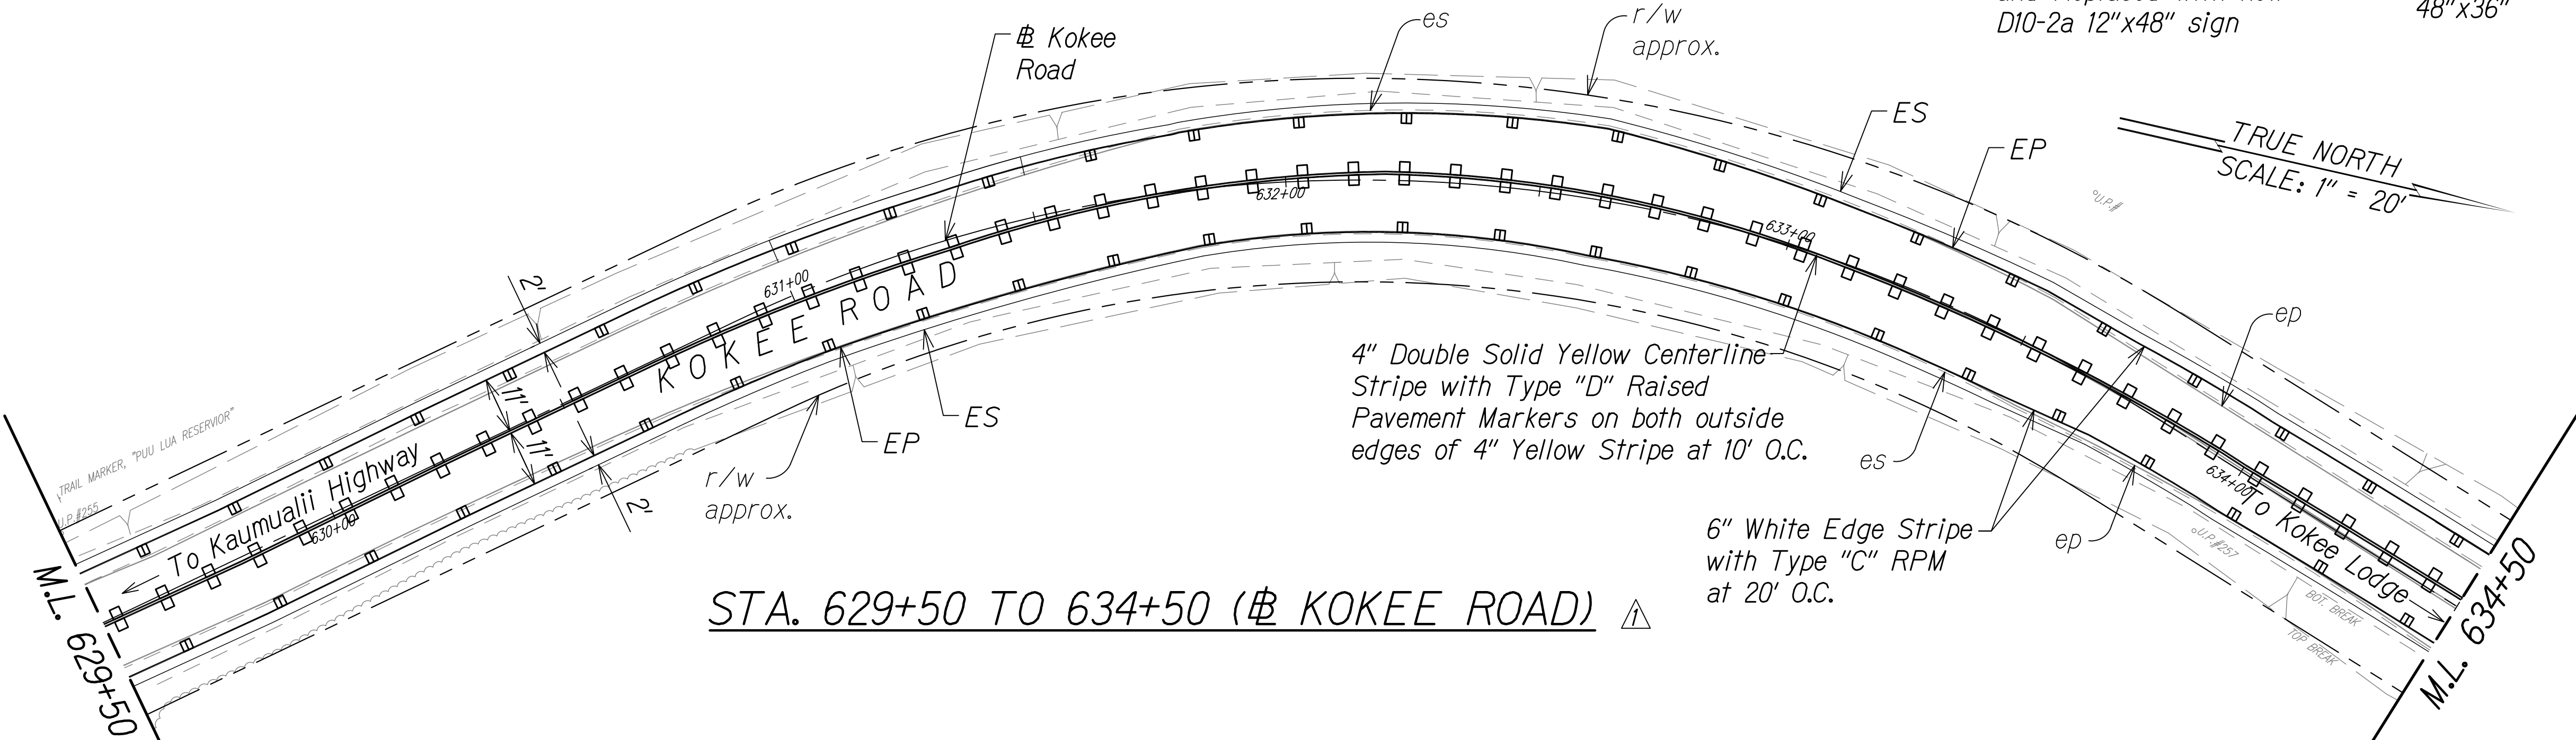


STA. 629+50 TO 634+50 (Kokee Road)

Notes

1. Install object markers (RM-3) at culvert headwall crossings.
2. Install object markers (OM2-2H) on all utility poles within ROW.
3. OM-5 to be installed on all regulatory and warning signs. Install OM-2V on other types of signs.
4. Install White Reflector Markers (RM-3) behind guardrails at spacing identified on Table 3F-1 in MUTCD or 200' on tangents (from end to end).

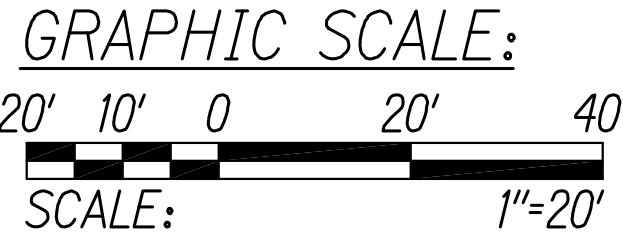

SURVEY PLOTTED BY	DATE
DESIGNED BY	
TRACED BY	
NOTE BOOK	
QUANTITIES BY	
CHECKED BY	

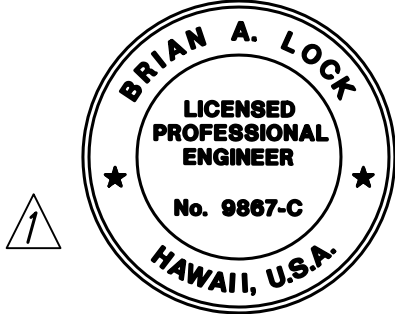


THIS WORK WAS PREPARED BY ME OR UNDER MY SUPERVISION.
WILSON OKAMOTO CORPORATION
APRIL 30, 2024
LIC. EXP. DATE

STATE OF HAWAII
DEPARTMENT OF TRANSPORTATION
HIGHWAYS DIVISION
PAVEMENT MARKING & SIGNING PLAN
WAIMEA CANYON DRIVE /
Kokee Road Improvements, Phase 2A
MILE POST 11.5 TO MILE POST 14.0
Federal-Aid Project No. STP-0550(005)
Scale: 1" = 20' Date: August 2022


DATE	REVISION
11/07/22	Revised Presentation of RPM; Revised Engineer's Stamp

SHEET No. 3 OF 13 SHEETS

DIST. NO.	STATE	FED. AID PROJ. NO.	FISCAL YEAR	SHEET NO.	TOTAL SHEETS
KAUAI	HAW.	STP-0550(005)	2022	ADD. 59	127

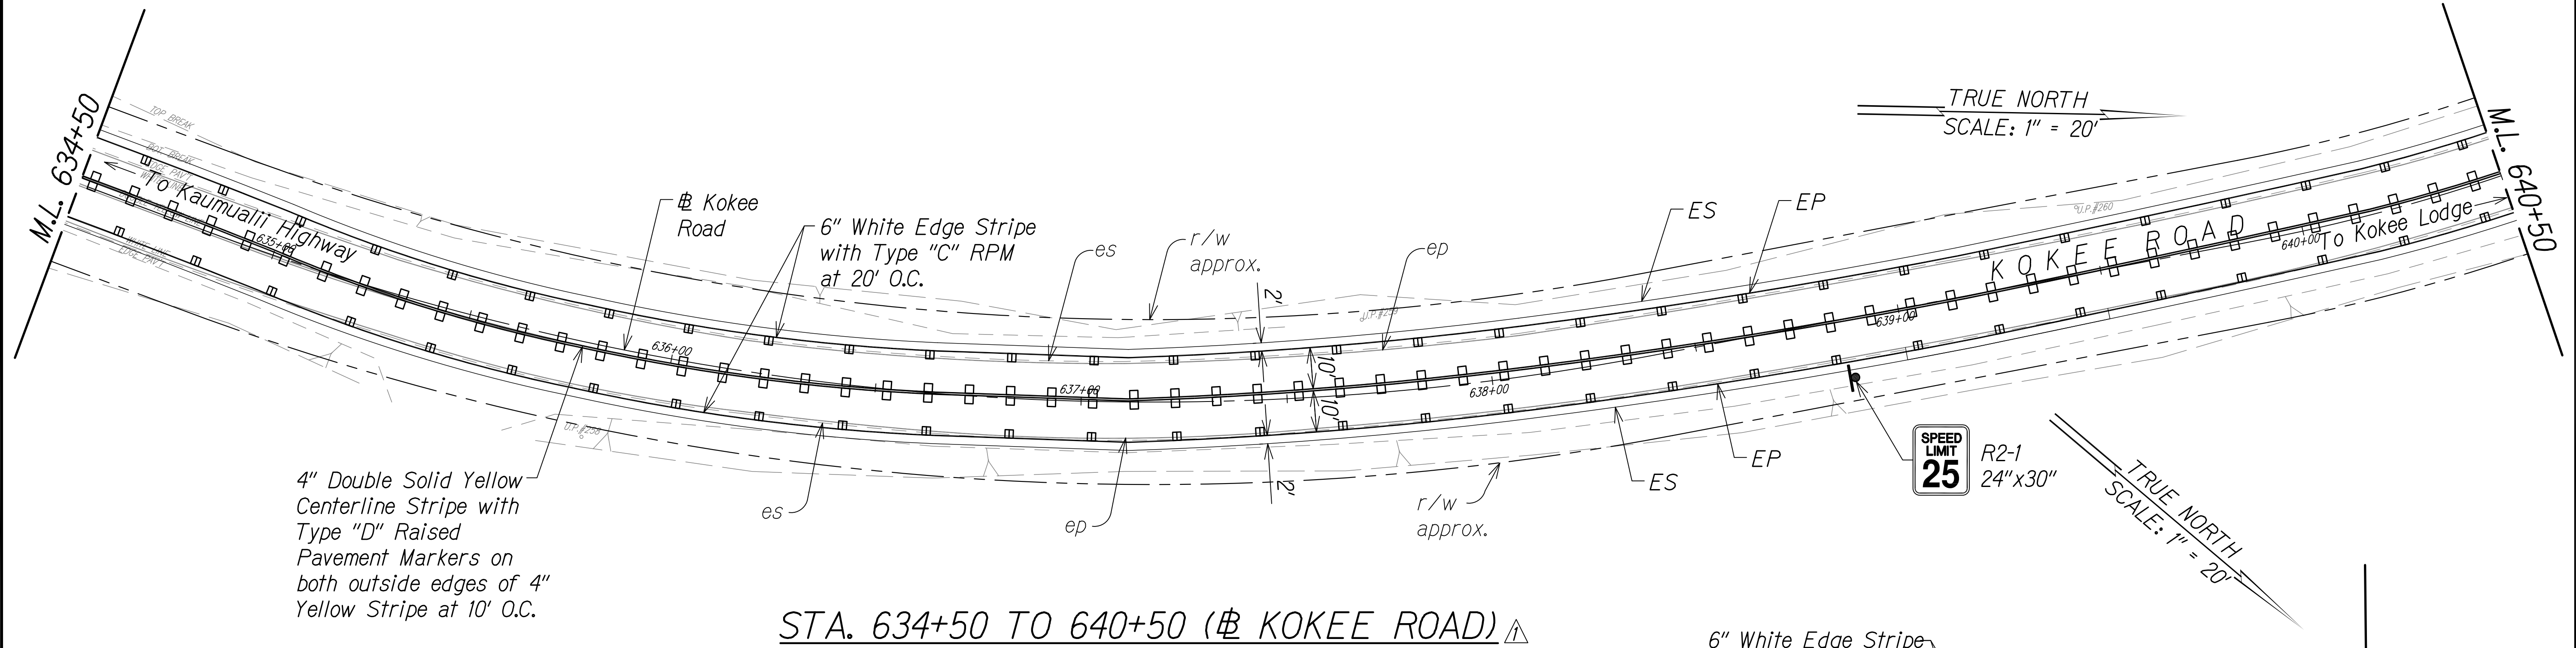

STA. 634+50 TO 640+50 (# KOKEE ROAD) ▲

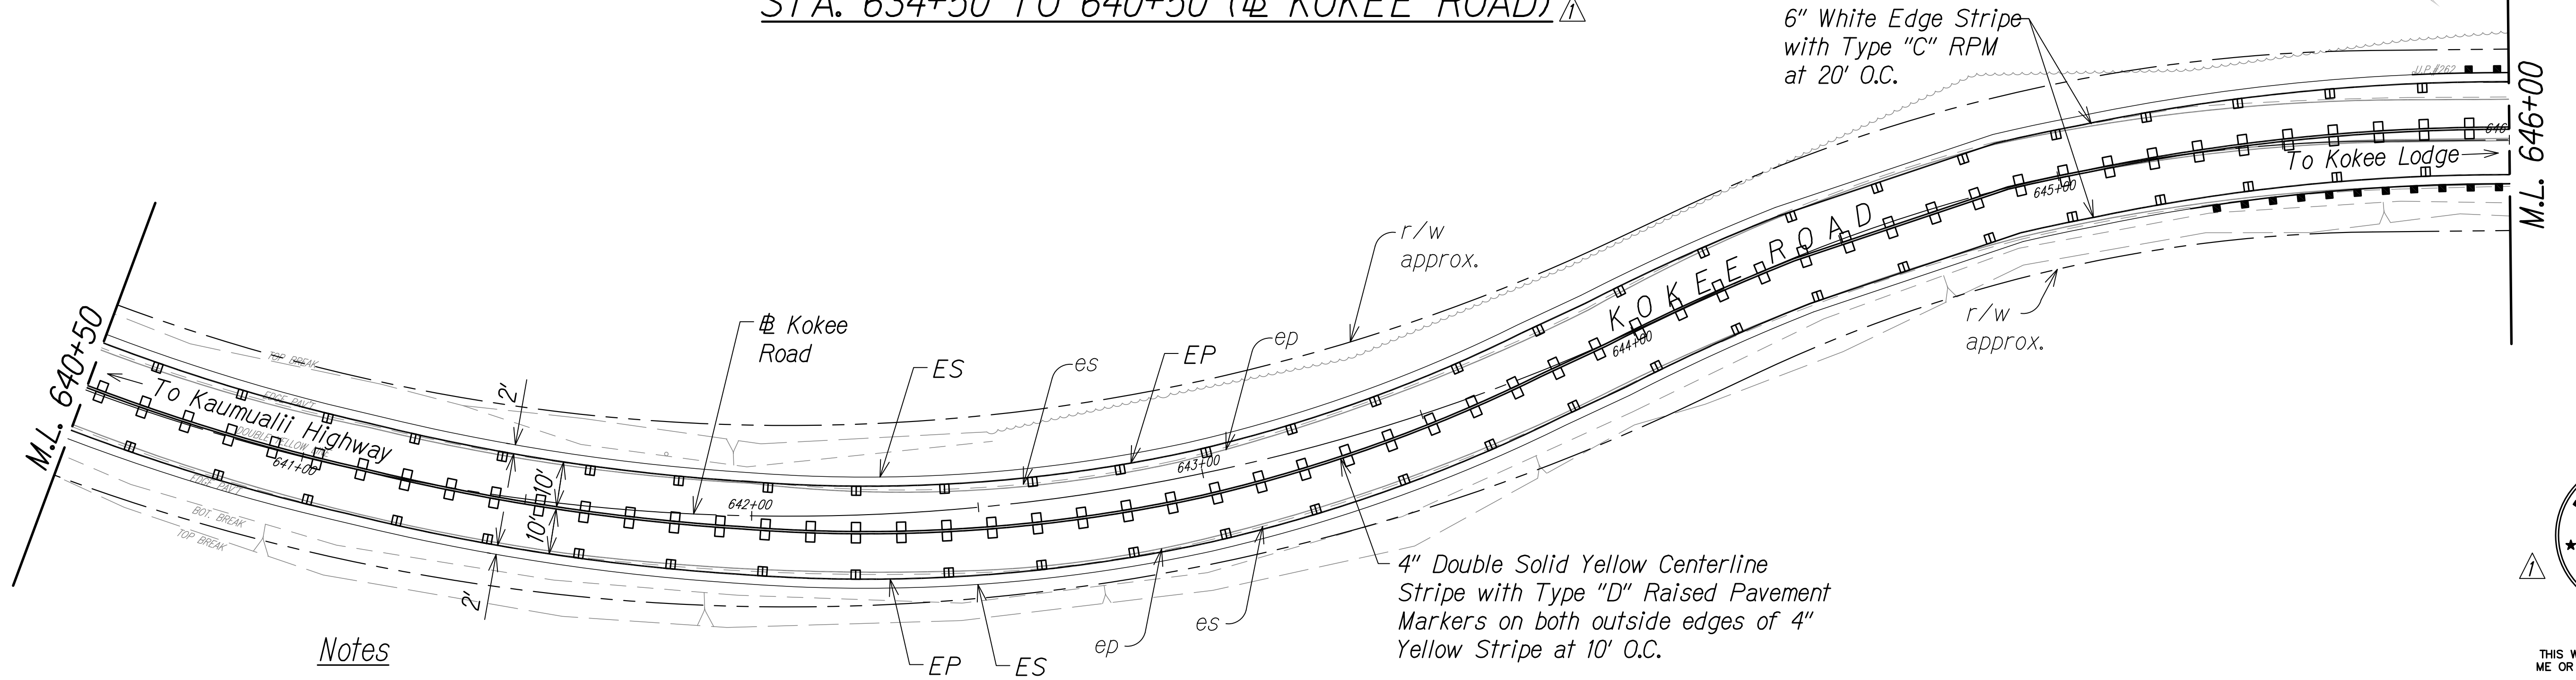


STA. 640+50 TO 646+00 (# KOKEE ROAD) ▲

- Notes
1. Install object markers (RM-3) at culvert headwall crossings.
 2. Install object markers (OM2-2H) on all utility poles within ROW.
 3. OM-5 to be installed on all regulatory and warning signs. Install OM-2V on other types of signs.
 4. Install White Reflector Markers (RM-3) behind guardrails at spacing identified on Table 3F-1 in MUTCD or 200' on tangents (from end to end).



SURVEY PLOTTED BY	DATE
DESIGNED BY	
TRACED BY	
NOTED BY	
QUANTITIES BY	
CHECKED BY	

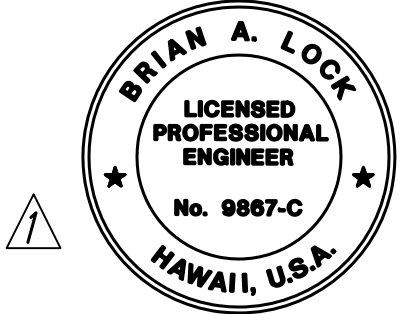

THIS WORK WAS PREPARED BY
ME OR UNDER MY SUPERVISION.
[Signature]
WILSON OKAMOTO CORPORATION
APRIL 30, 2024
LIC. EXP. DATE



STATE OF HAWAII
DEPARTMENT OF TRANSPORTATION
HIGHWAYS DIVISION
**PAVEMENT MARKING &
SIGNING PLAN**
WAIMEA CANYON DRIVE /
KOKEE ROAD IMPROVEMENTS, PHASE 2A
MILE POST 11.5 TO MILE POST 14.0
Federal-Aid Project No. STP-0550(005)
Scale: 1" = 20' Date: August 2022

Revised Presentation of RPM;
Revised Engineer's Stamp
11/07/22

DATE REVISION

SHEET No. 4 OF 13 SHEETS

DIST. NO.	STATE	FED. AID PROJ. NO.	FISCAL YEAR	SHEET NO.	TOTAL SHEETS
KAUAI	HAW.	STP-0550(005)	2022	ADD. 60	127

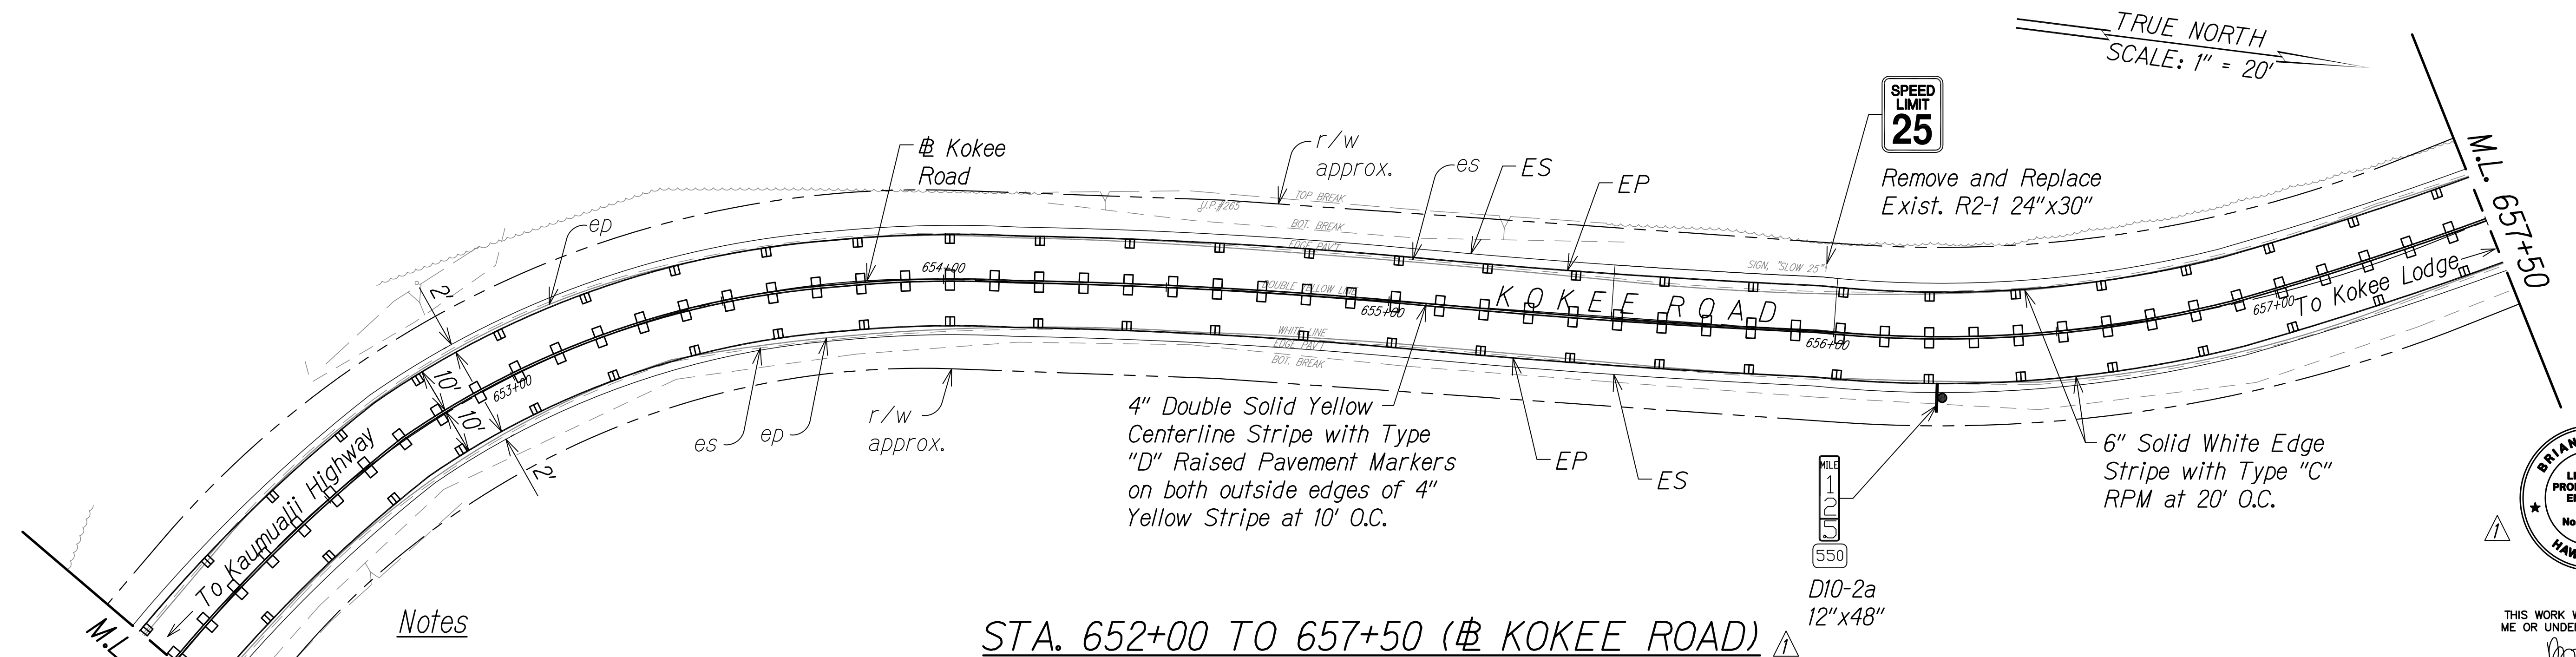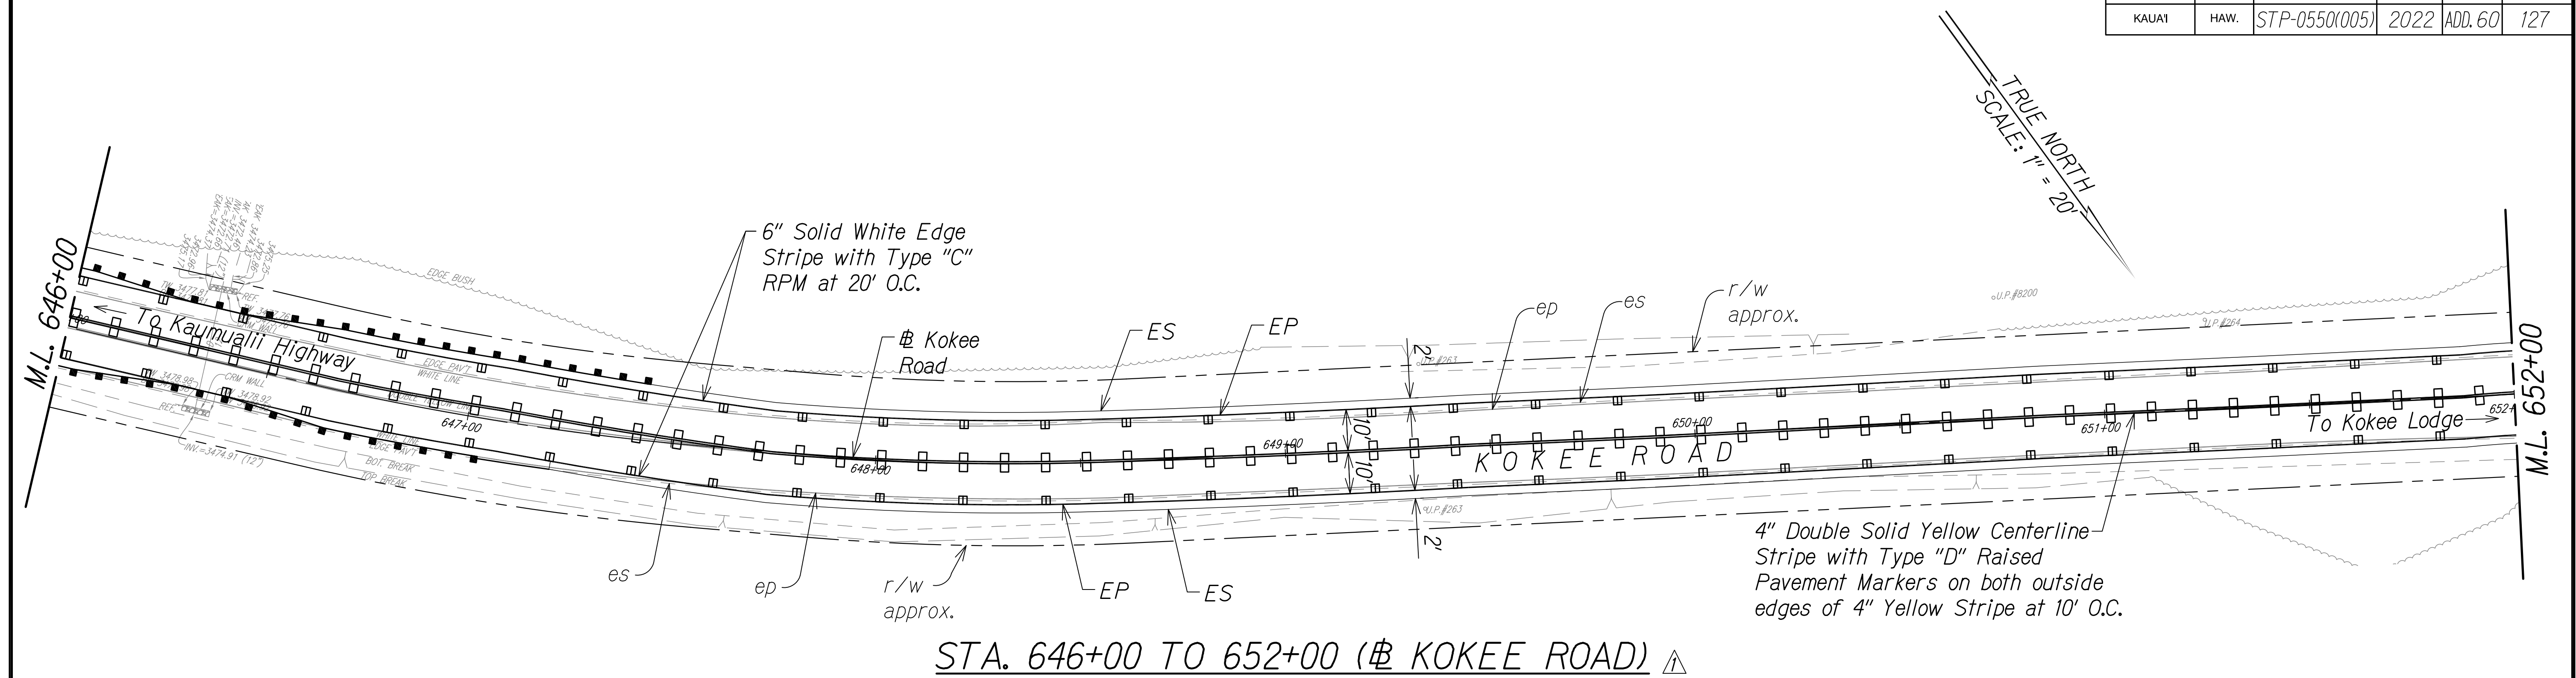


Notes

1. Install object markers (RM-3) at culvert headwall crossings.
2. Install object markers (OM2-2H) on all utility poles within ROW.
3. OM-5 to be installed on all regulatory and warning signs. Install OM-2V on other types of signs.
4. Install White Reflector Markers (RM-3) behind guardrails at spacing identified on Table 3F-1 in MUTCD or 200' on tangents (from end to end).

GRAPHIC SCALE:
20' 10' 0 20' 40'
SCALE: 1"=20'

SURVEY PLOTTED BY	DATE
DESIGNED BY	
TRACED BY	
NOTE BOOK	
QUANTITIES BY	
CHECKED BY	

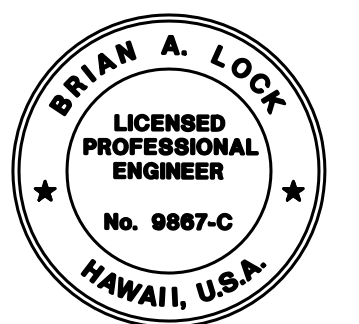

THIS WORK WAS PREPARED BY
ME OR UNDER MY SUPERVISION.
Brian A. Lock
WILSON OKAMOTO CORPORATION
APRIL 30, 2024
LIC. EXP. DATE


STATE OF HAWAII DEPARTMENT OF TRANSPORTATION HIGHWAYS DIVISION
PAVEMENT MARKING & CONTROL PLAN
WAIMEA CANYON DRIVE / KOKEE ROAD IMPROVEMENTS, PHASE 2A MILE POST 11.5 TO MILE POST 14.0 Federal-Aid Project No. STP-0550(005) Scale: 1" = 20' Date: August 2022
SHEET No. 5 OF 13 SHEETS

DATE	REVISION
11/07/22	Revised Presentation of RPM; Revised Engineer's Stamp


COPY OF ORIGINAL TRACING

ADD 60

DIST. NO.	STATE	FED. AID PROJ. NO.	FISCAL YEAR	SHEET NO.	TOTAL SHEETS
KAUAI	HAW.	STP-0550(005)	2022	ADD. 61	127

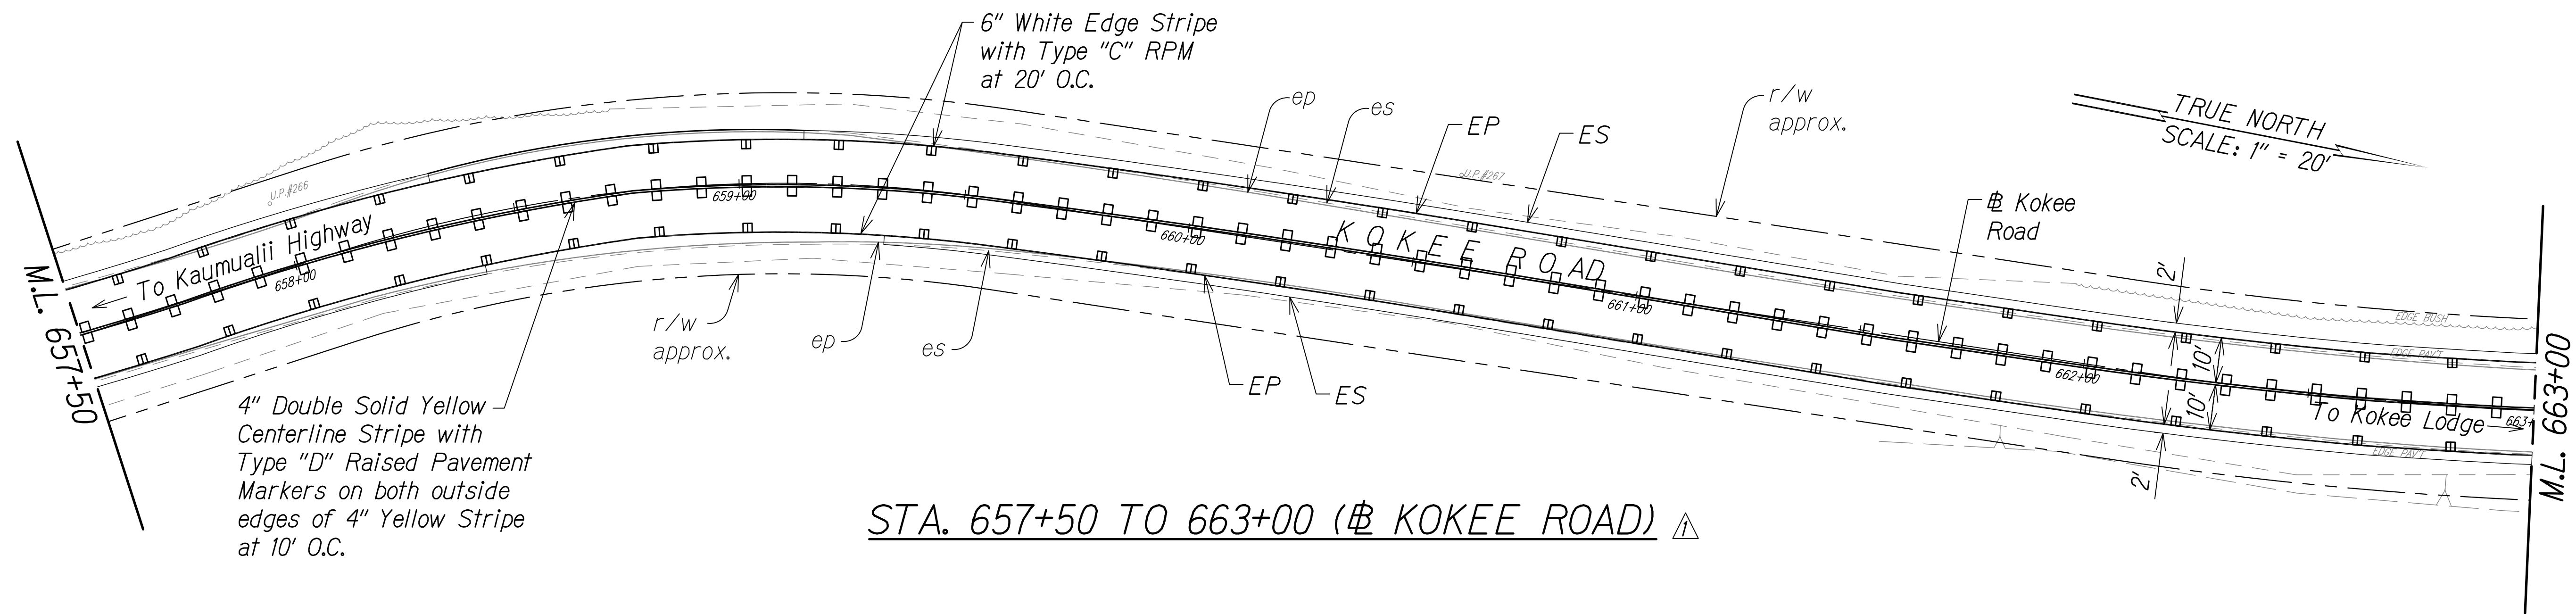

STA. 657+50 TO 663+00 (# KOKEE ROAD) ⚠

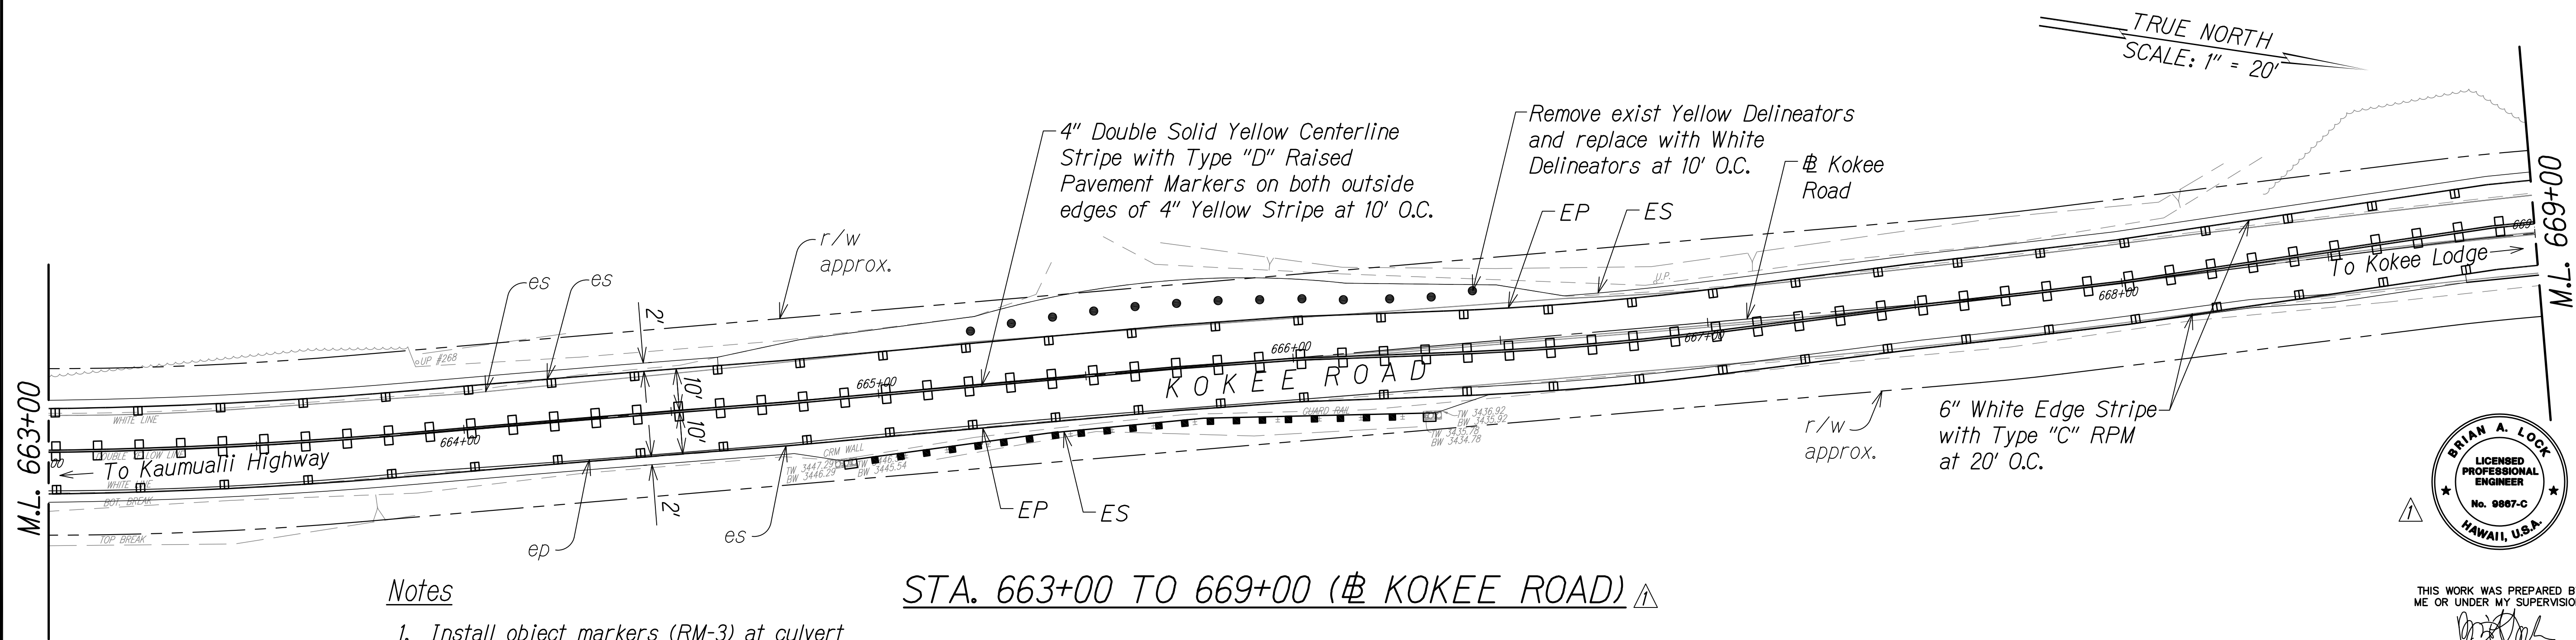


STA. 663+00 TO 669+00 (# KOKEE ROAD) ⚠

Notes

1. Install object markers (RM-3) at culvert headwall crossings.
2. Install object markers (OM2-2H) on all utility poles within ROW.
3. OM-5 to be installed on all regulatory and warning signs. Install OM-2V on other types of signs.
4. Install White Reflector Markers (RM-3) behind guardrails at spacing identified on Table 3F-1 in MUTCD or 200' on tangents (from end to end).



SURVEY PLOTTED BY	DATE
DESIGNED BY	
TRACED BY	
NOTE BOOK	
QUANTITIES BY	
CHECKED BY	

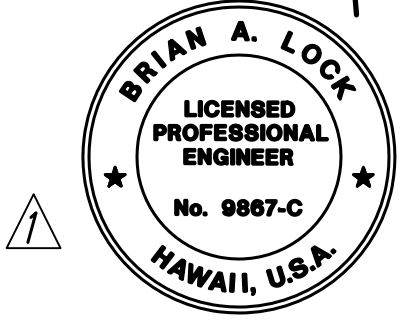


THIS WORK WAS PREPARED BY ME OR UNDER MY SUPERVISION.
WILSON OKAMOTO CORPORATION
APRIL 30, 2024
LIC. EXP. DATE

STATE OF HAWAII
DEPARTMENT OF TRANSPORTATION
HIGHWAYS DIVISION
PAVEMENT MARKING & SIGNING PLAN
WAIMEA CANYON DRIVE /
KOKEE ROAD IMPROVEMENTS, PHASE 2A
MILE POST 11.5 TO MILE POST 14.0
Federal-Aid Project No. STP-0550(005)
Scale: 1" = 20' Date: August 2022

DATE: 11/07/22 REVISION: Revised Presentation of RPM; Revised Engineer's Stamp

SHEET No. 6 OF 13 SHEETS



DIST. NO.	STATE	FED. AID PROJ. NO.	FISCAL YEAR	SHEET NO.	TOTAL SHEETS
KAUAI	HAW.	STP-0550(005)	2022	ADD. 63	127

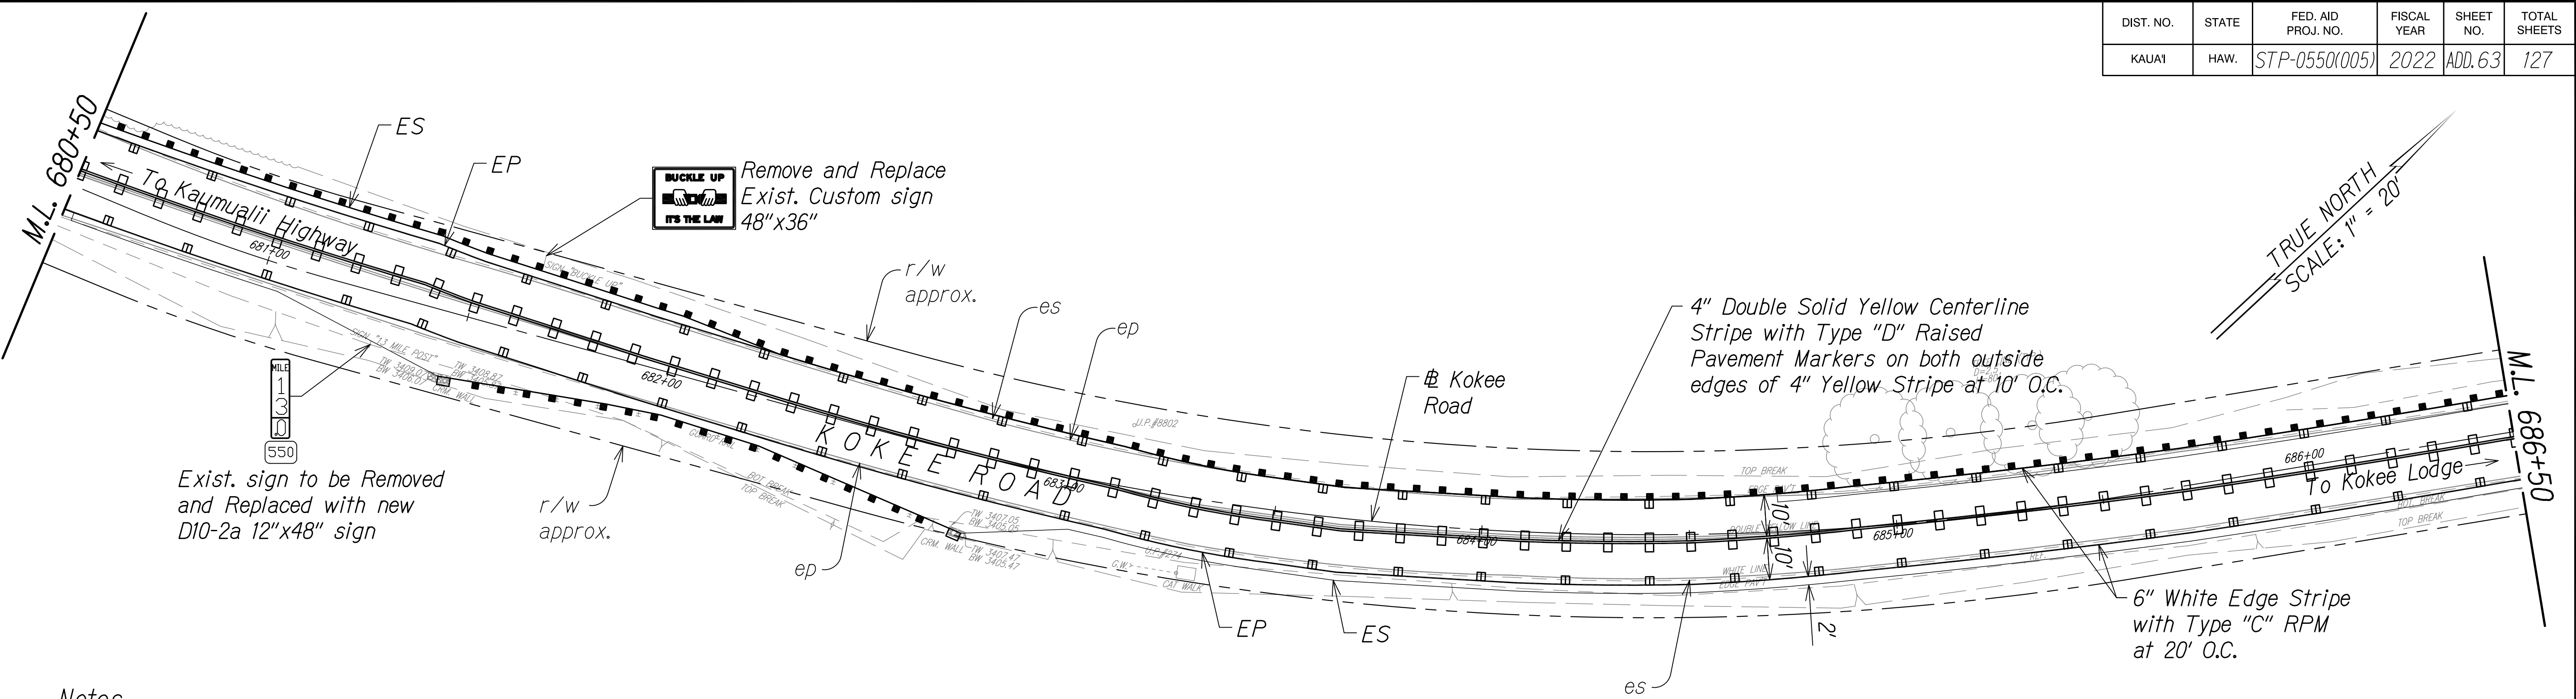

Notes

1. Install object markers (RM-3) at culvert headwall crossings.
2. Install object markers (OM2-2H) on all utility poles within ROW.
3. OM-5 to be installed on all regulatory and warning signs. Install OM-2V on other types of signs.
4. Install White Reflector Markers (RM-3) behind guardrails at spacing identified on Table 3F-1 in MUTCD or 200' on tangents (from end to end).

STA. 680+50 TO 686+50 (# KOKEE ROAD) ▲

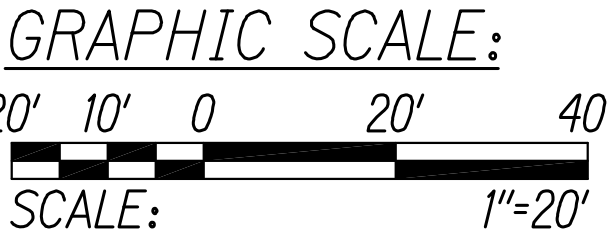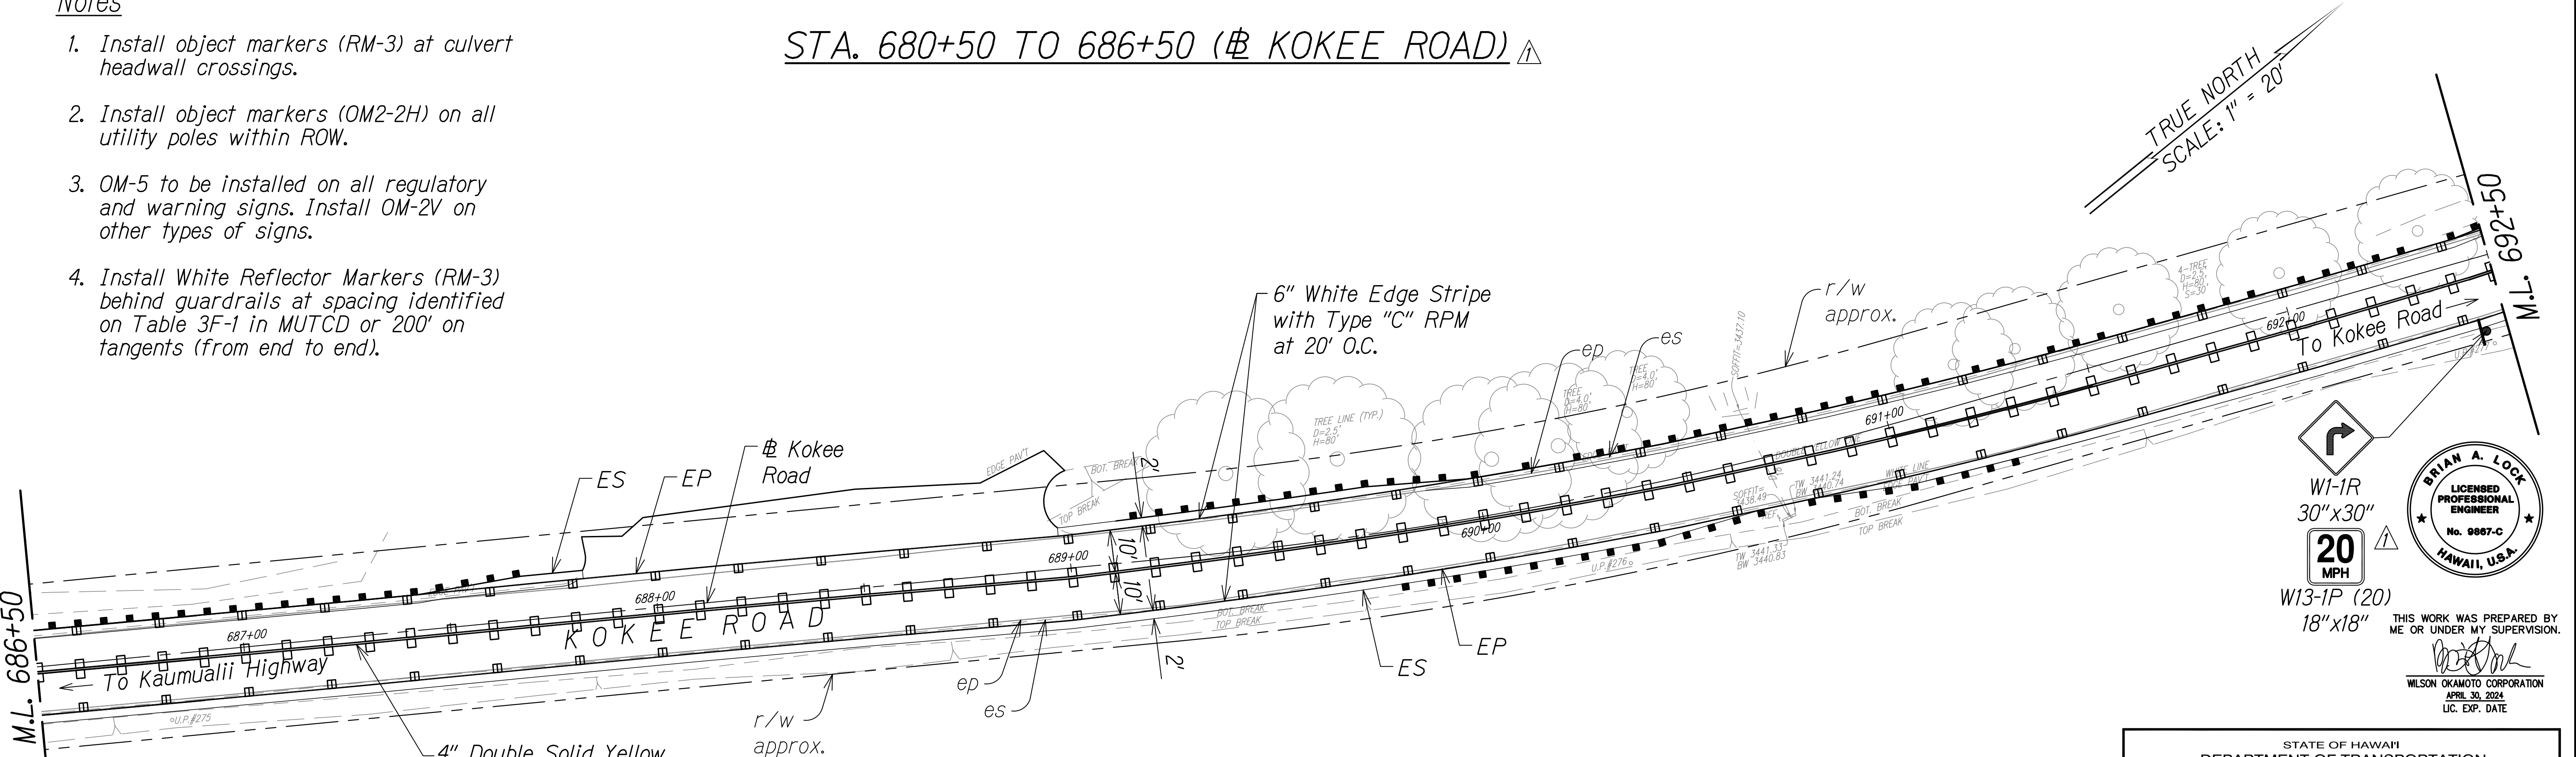

4" Double Solid Yellow Centerline Stripe with Type "D" Raised Pavement Markers on both outside edges of 4" Yellow Stripe at 10' O.C.

STA. 686+50 TO 692+50 (# KOKEE ROAD) ▲

STATE OF HAWAII
DEPARTMENT OF TRANSPORTATION
HIGHWAYS DIVISION
PAVEMENT MARKING & SIGNING PLAN
WAIMEA CANYON DRIVE /
KOKEE ROAD IMPROVEMENTS, PHASE 2A
MILE POST 11.5 TO MILE POST 14.0
Federal-Aid Project No. STP-0550(005)
Scale: 1" = 20' Date: August 2022


SHEET No. 8 OF 13 SHEETS

DATE	REVISION
11/07/22	Revised Presentation of RPM; Revised Engineer's Stamp

COPY OF ORIGINAL TRACING

ADD 63


DIST. NO.	STATE	FED. AID PROJ. NO.	FISCAL YEAR	SHEET NO.	TOTAL SHEETS
KAUAI	HAW.	STP-0550(005)	2022	ADD. 64	127

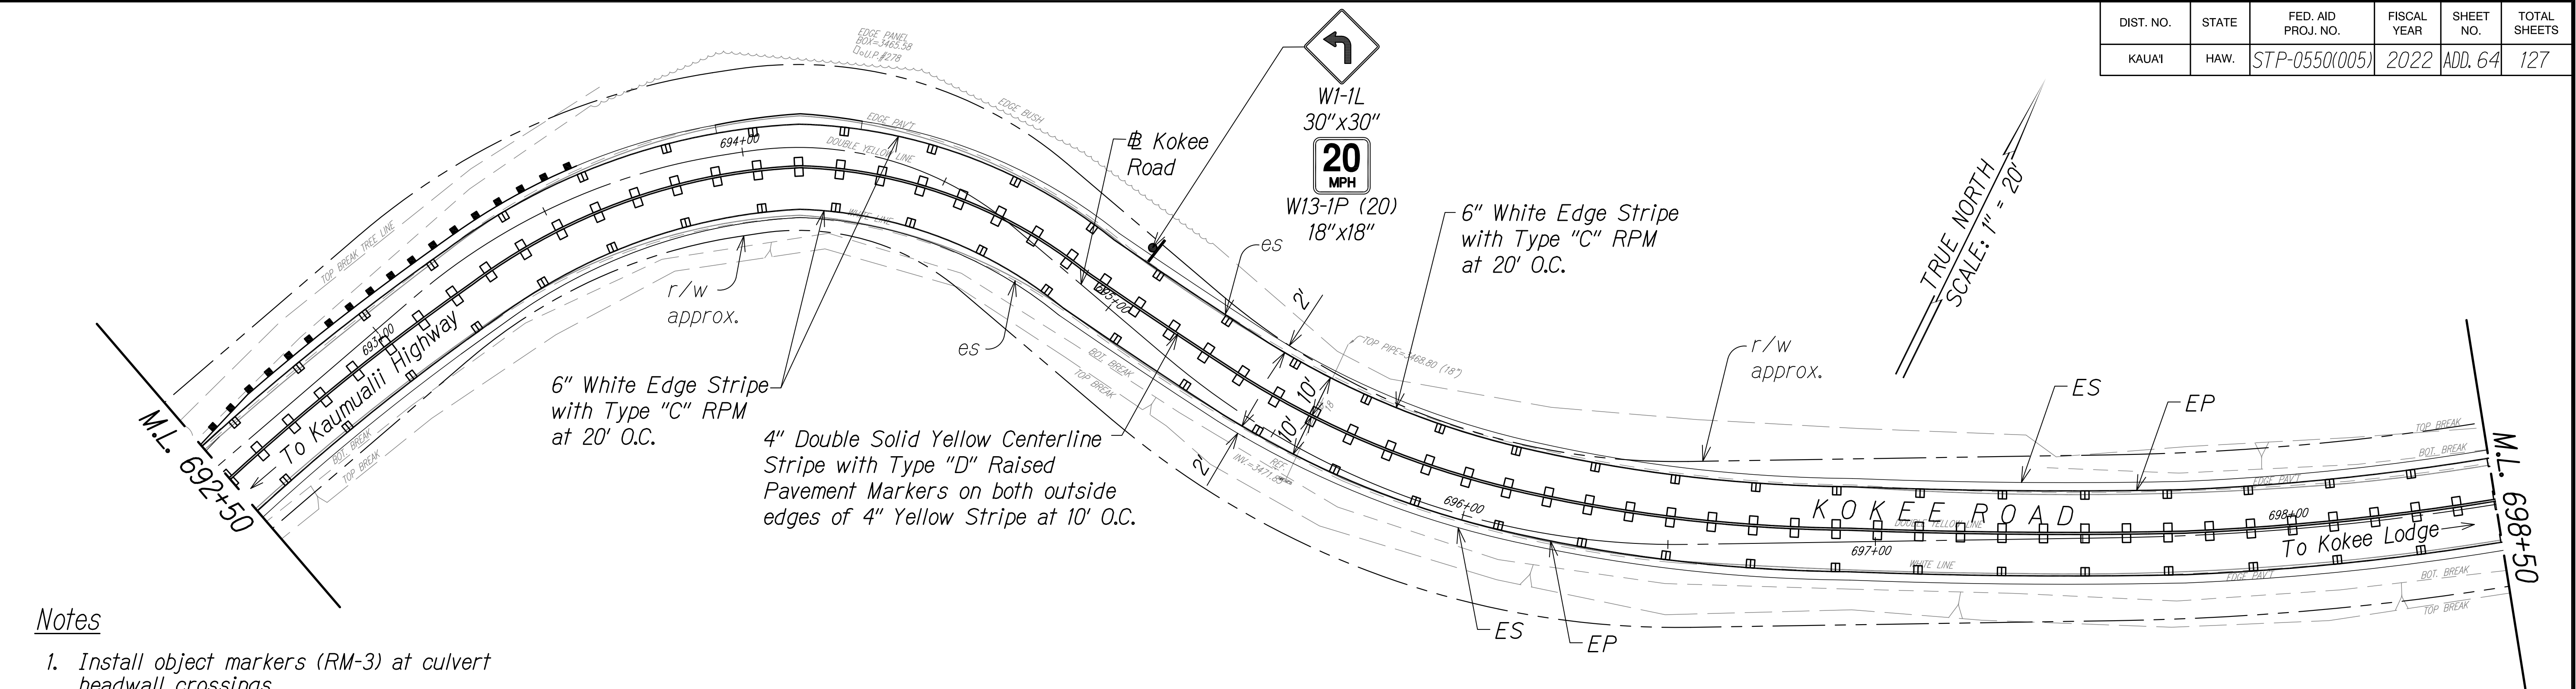

Notes



1. Install object markers (RM-3) at culvert headwall crossings.
2. Install object markers (OM2-2H) on all utility poles within ROW.
3. OM-5 to be installed on all regulatory and warning signs. Install OM-2V on other types of signs.
4. Install White Reflector Markers (RM-3) behind guardrails at spacing identified on Table 3F-1 in MUTCD or 200' on tangents (from end to end).

STA. 692+50 TO 698+50 (# KOKEE ROAD) ▲

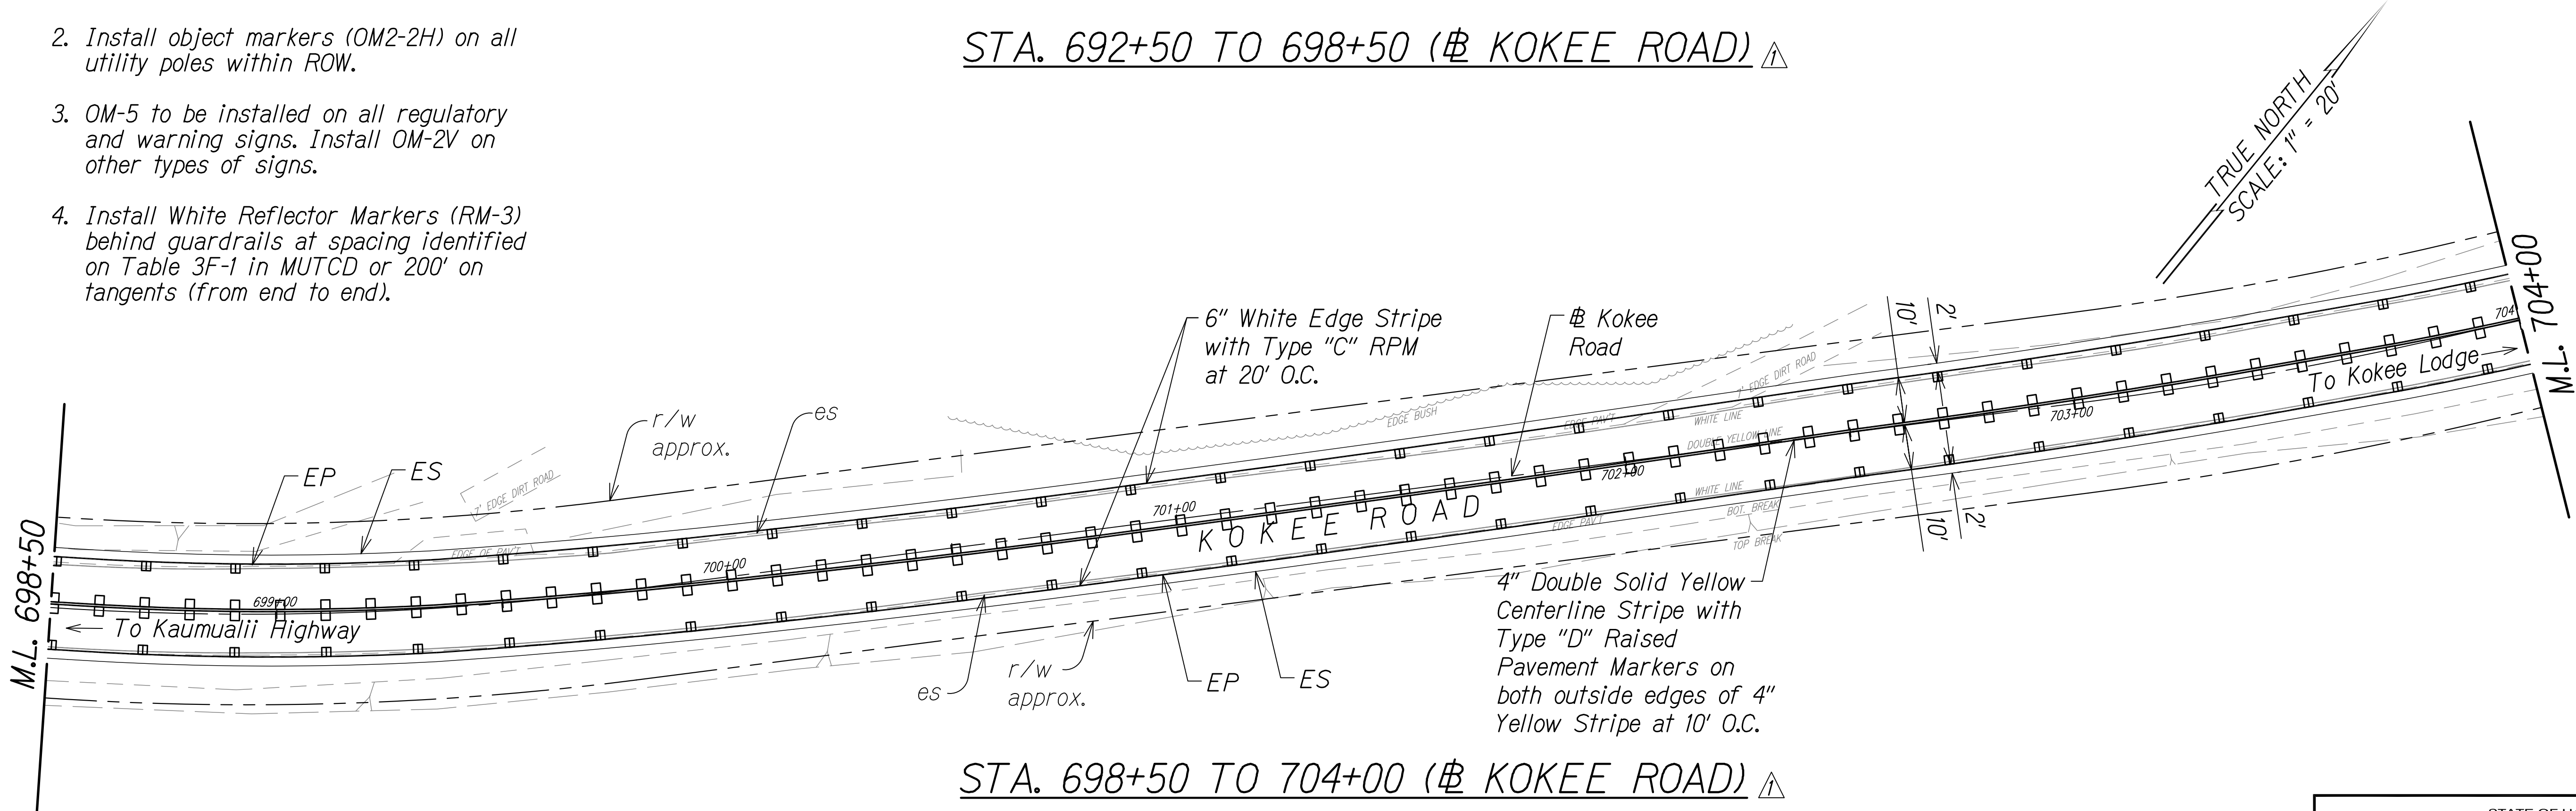

STA. 698+50 TO 704+00 (# KOKEE ROAD) ▲

SURVEY PLOTTED BY	DATE
DESIGNED BY	
TRACED BY	
NOTED BY	
QUANTITIES BY	
CHECKED BY	

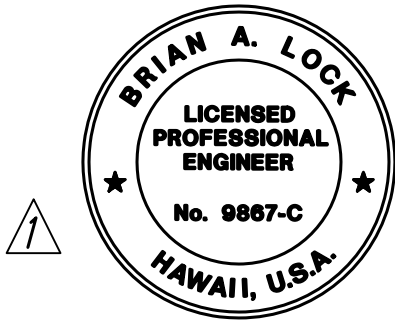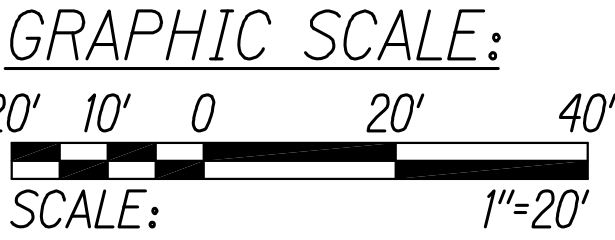


THIS WORK WAS PREPARED BY
ME OR UNDER MY SUPERVISION.
[Signature]
WILSON OKAMOTO CORPORATION
APRIL 30, 2024
LIC. EXP. DATE

STATE OF HAWAII
DEPARTMENT OF TRANSPORTATION
HIGHWAYS DIVISION
**PAVEMENT MARKING &
SIGNING PLAN**
WAIMEA CANYON DRIVE /
KOKEE ROAD IMPROVEMENTS, PHASE 2A
MILE POST 11.5 TO MILE POST 14.0
Federal-Aid Project No. STP-0550(005)
Scale: 1" = 20' Date: August 2022

DATE	REVISION
11/07/22	Revised Presentation of RPM; Revised Engineer's Stamp

SHEET No. 9 OF 13 SHEETS

DIST. NO.	STATE	FED. AID PROJ. NO.	FISCAL YEAR	SHEET NO.	TOTAL SHEETS
KAUAI	HAW.	STP-0550(005)	2022	ADD.65	127

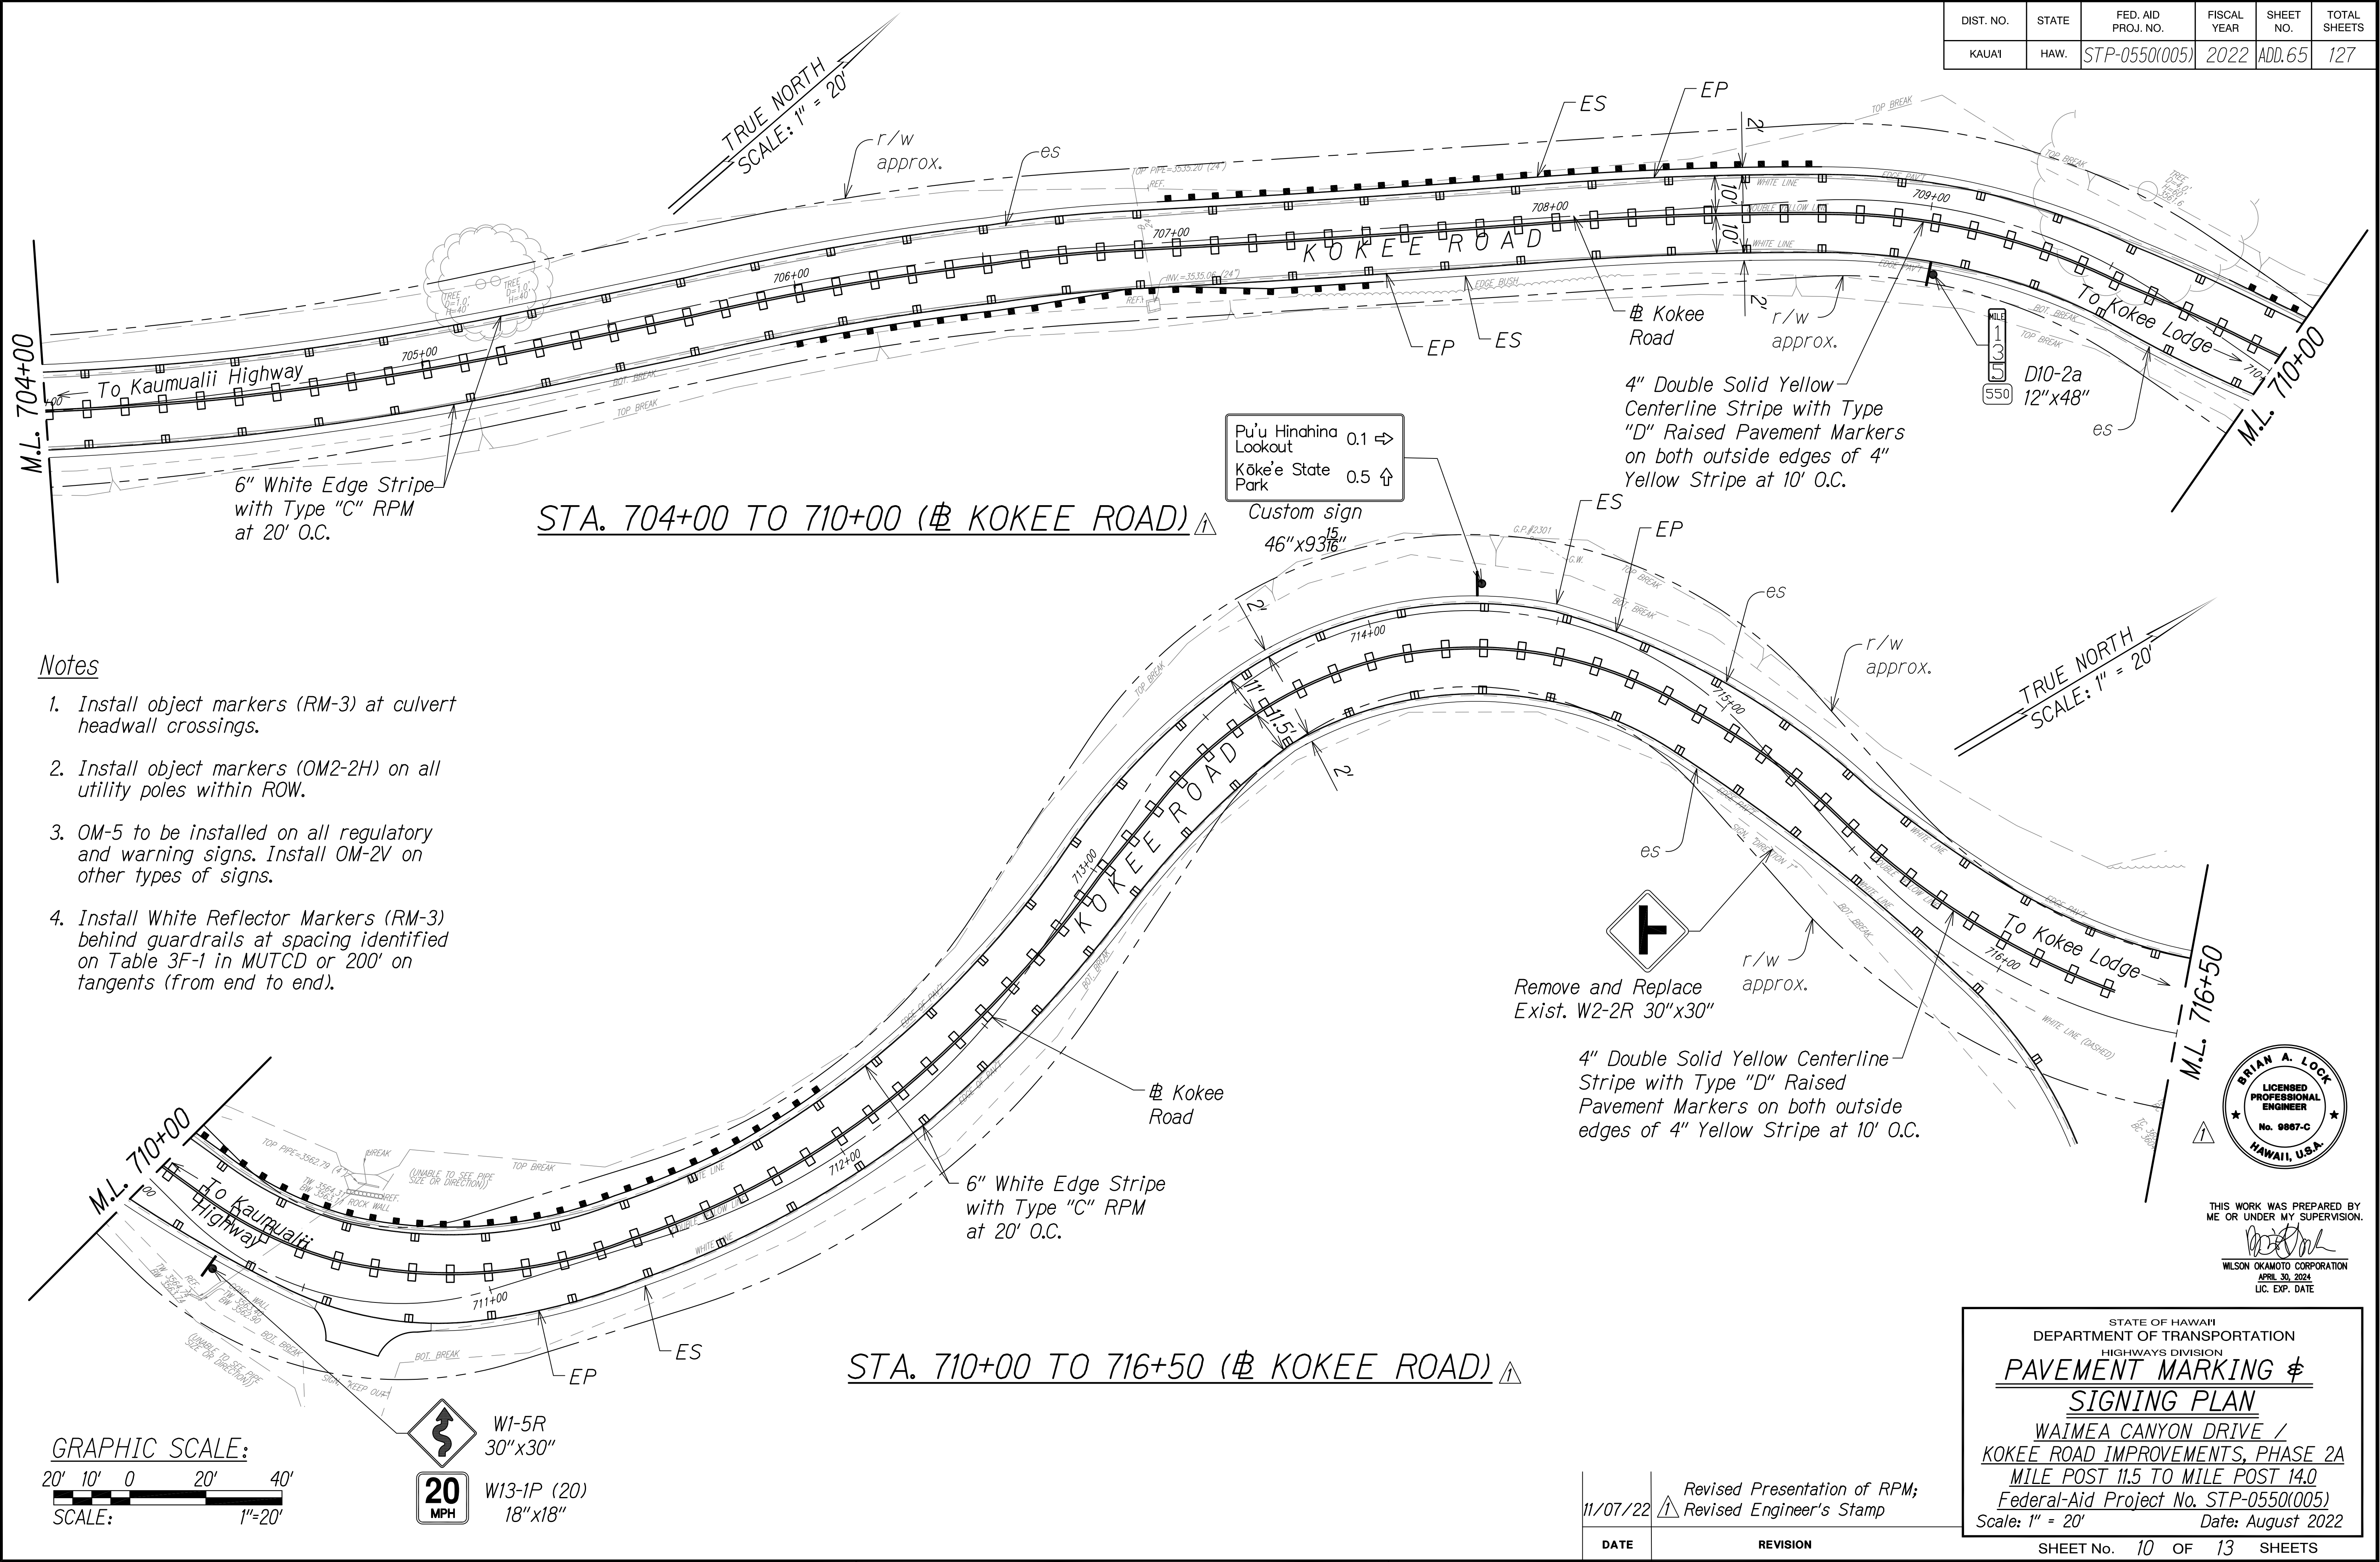

Notes

1. Install object markers (RM-3) at culvert headwall crossings.
2. Install object markers (OM2-2H) on all utility poles within ROW.
3. OM-5 to be installed on all regulatory and warning signs. Install OM-2V on other types of signs.
4. Install White Reflector Markers (RM-3) behind guardrails at spacing identified on Table 3F-1 in MUTCD or 200' on tangents (from end to end).


SURVEY PLOTTED BY	DATE
DESIGNED BY	
TRACED BY	
NOTED BY	
QUANTITIES BY	
CHECKED BY	

GRAPHIC SCALE:
20' 10' 0 20' 40'
SCALE: 1"=20'

W1-5R 30"x30"
W13-1P (20) 18"x18"
20 MPH


COPY OF ORIGINAL TRACING

STATE OF HAWAII
DEPARTMENT OF TRANSPORTATION
HIGHWAYS DIVISION
PAVEMENT MARKING & SIGNING PLAN
WAIMEA CANYON DRIVE /
Kokee Road Improvements, Phase 2A
MILE POST 11.5 TO MILE POST 14.0
Federal-Aid Project No. STP-0550(005)
Scale: 1" = 20' Date: August 2022
SHEET No. 10 OF 13 SHEETS

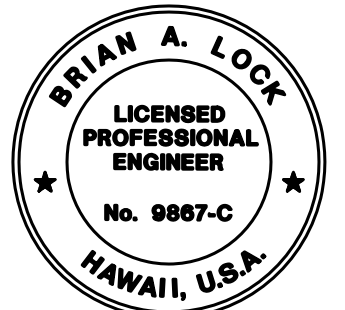

THIS WORK WAS PREPARED BY
ME OR UNDER MY SUPERVISION.
WILSON OKAMOTO CORPORATION
APRIL 30, 2024
LIC. EXP. DATE


DIST. NO.	STATE	FED. AID PROJ. NO.	FISCAL YEAR	SHEET NO.	TOTAL SHEETS
KAUAI	HAW.	STP-0550(005)	2022	ADD. 66	127

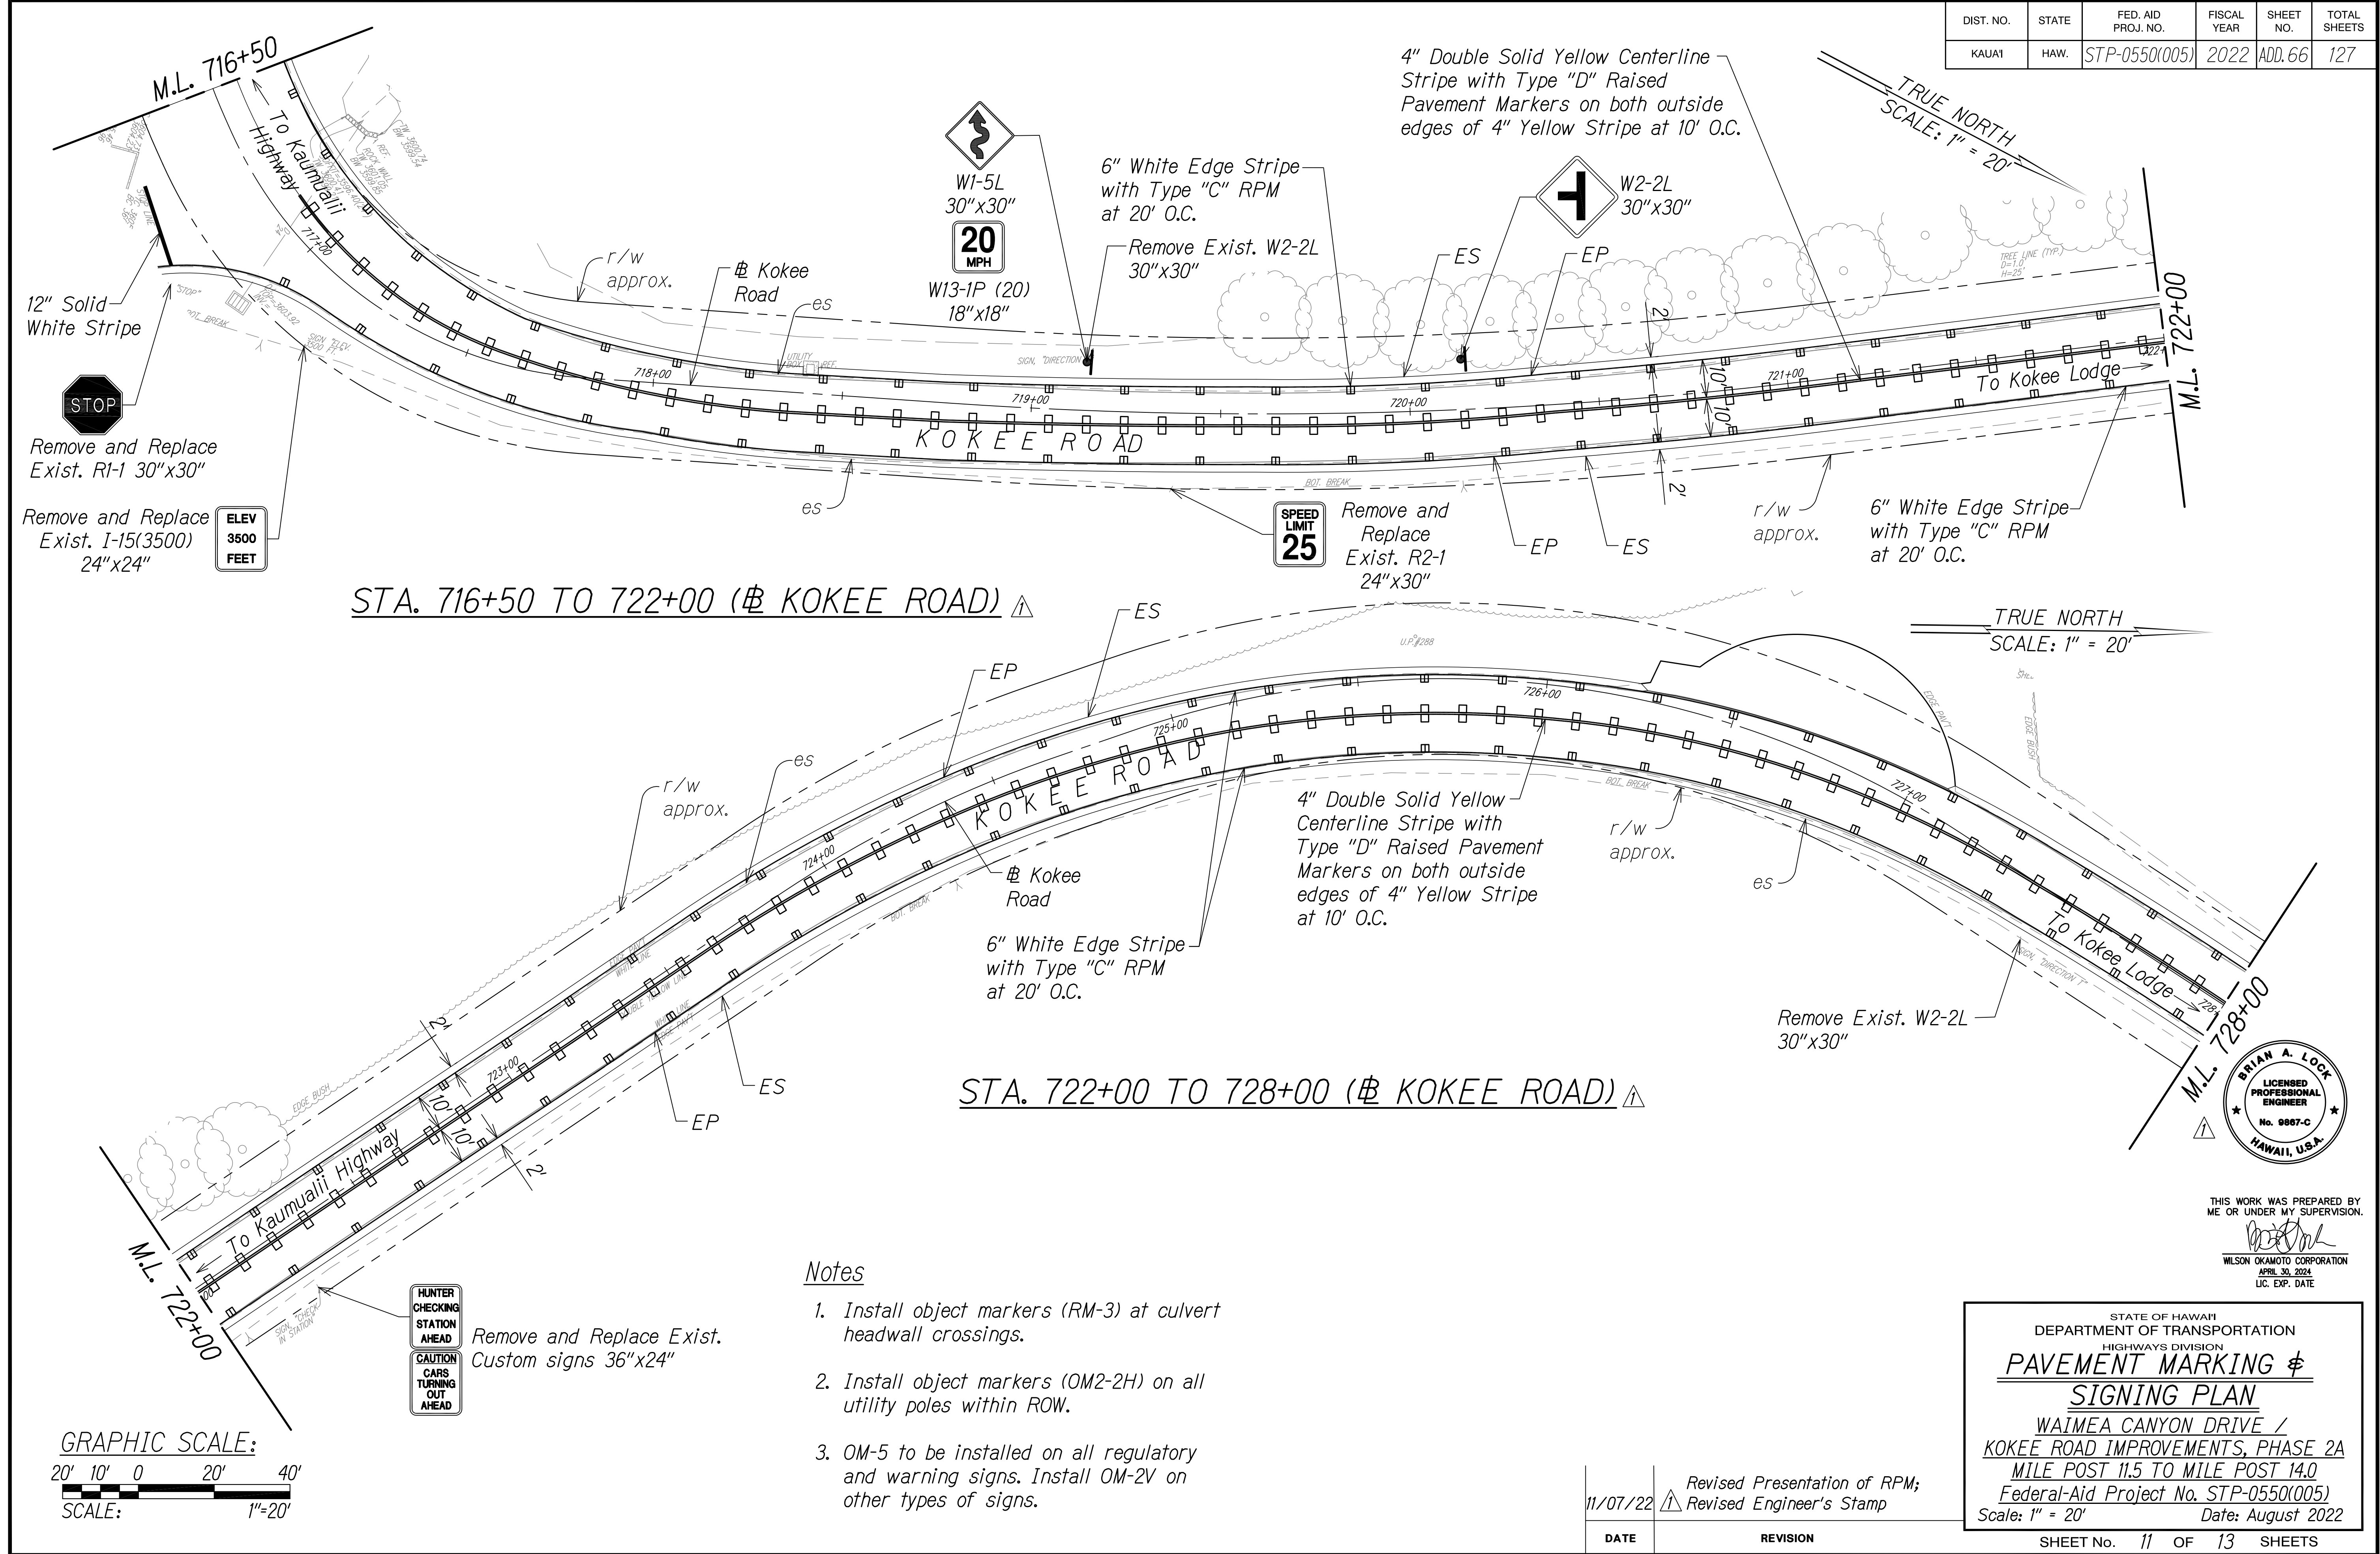

COPY OF ORIGINAL TRACING

ADD 66


DIST. NO.	STATE	FED. AID PROJ. NO.	FISCAL YEAR	SHEET NO.	TOTAL SHEETS
KAUAI	HAW.	STP-0550(005)	2022	ADD. 67	127

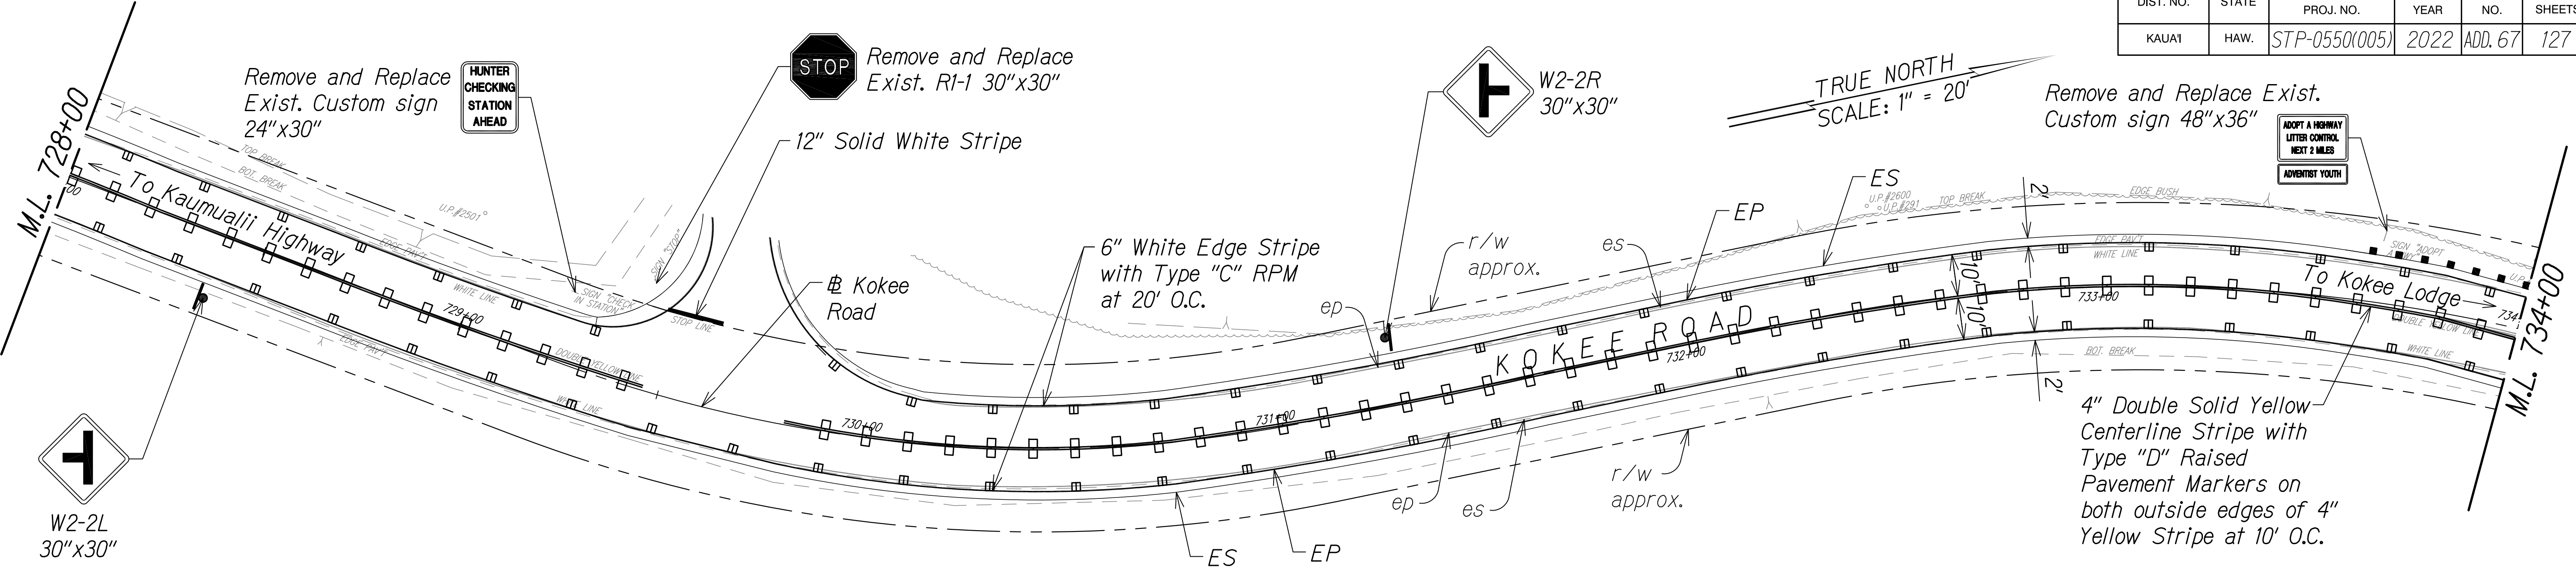


Notes

1. Install object markers (RM-3) at culvert headwall crossings.
2. Install object markers (OM2-2H) on all utility poles within ROW.
3. OM-5 to be installed on all regulatory and warning signs. Install OM-2V on other types of signs.
4. Install White Reflector Markers (RM-3) behind guardrails at spacing identified on Table 3F-1 in MUTCD or 200' on tangents (from end to end).


STA. 728+00 TO 734+00 (# KOKEE ROAD) ▲

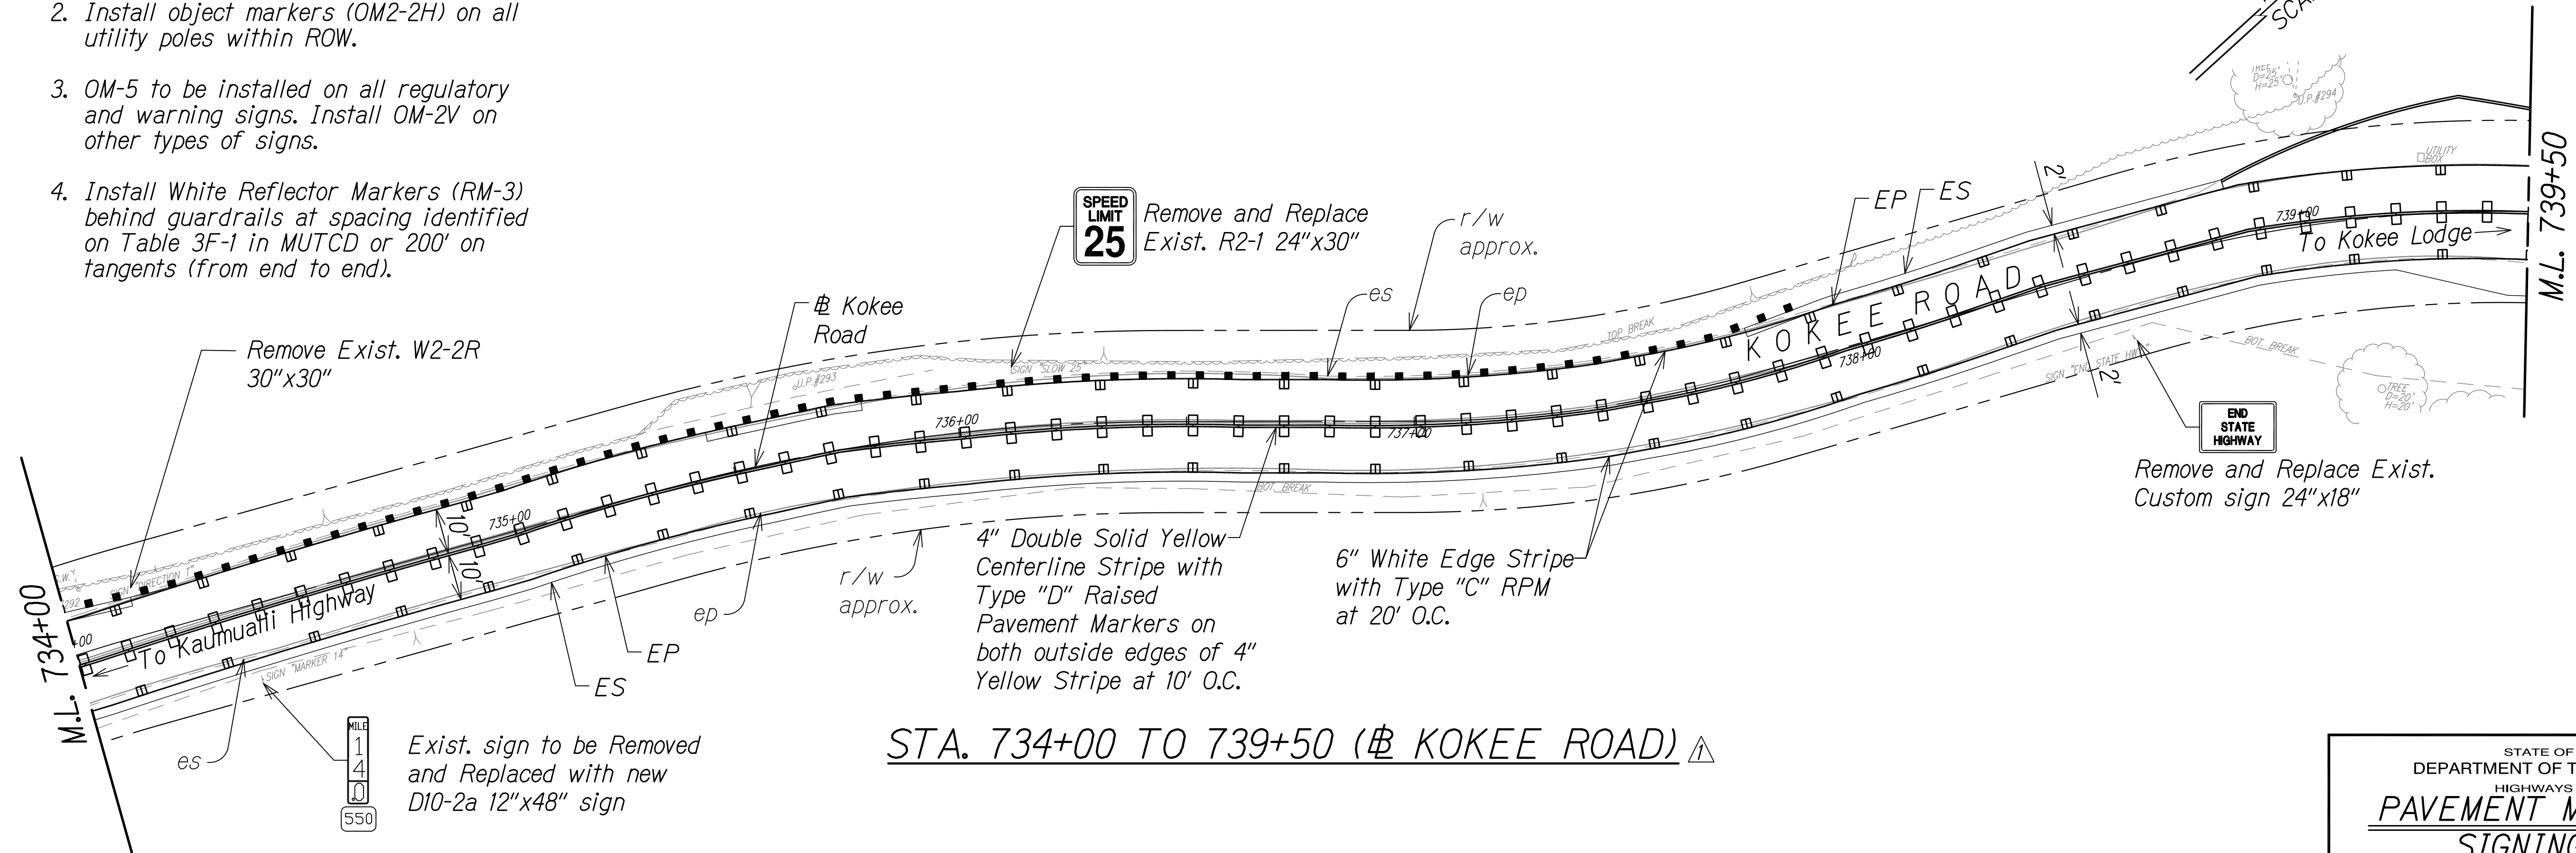

STA. 734+00 TO 739+50 (# KOKEE ROAD) ▲

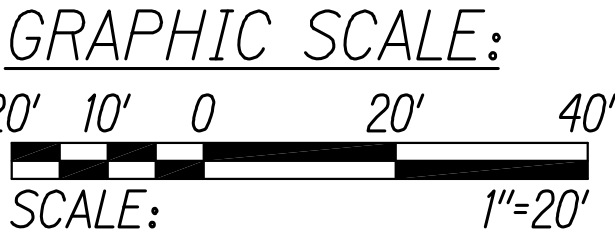

SURVEY PLOTTED BY	DATE
DESIGNED BY	
TRACED BY	
NOTED BY	
QUANTITIES BY	
CHECKED BY	

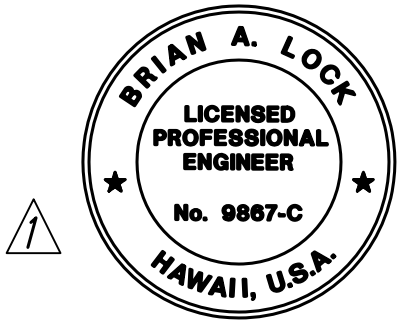

THIS WORK WAS PREPARED BY
ME OR UNDER MY SUPERVISION.
WILSON OKAMOTO CORPORATION
APRIL 30, 2024
LIC. EXP. DATE

STATE OF HAWAII
DEPARTMENT OF TRANSPORTATION
HIGHWAYS DIVISION
**PAVEMENT MARKING &
SIGNING PLAN**
WAIMEA CANYON DRIVE /
KOKEE ROAD IMPROVEMENTS, PHASE 2A
MILE POST 11.5 TO MILE POST 14.0
Federal-Aid Project No. STP-0550(005)
Scale: 1" = 20' Date: August 2022

11/07/22 Revised Presentation of RPM;
Revised Engineer's Stamp


DATE REVISION

SHEET No. 12 OF 13 SHEETS

COPY OF ORIGINAL TRACING

ADD 67


DIST. NO.	STATE	FED. AID PROJ. NO.	FISCAL YEAR	SHEET NO.	TOTAL SHEETS
KAUAI	HAW.	STP-0550(005)	2022	ADD. 68	127

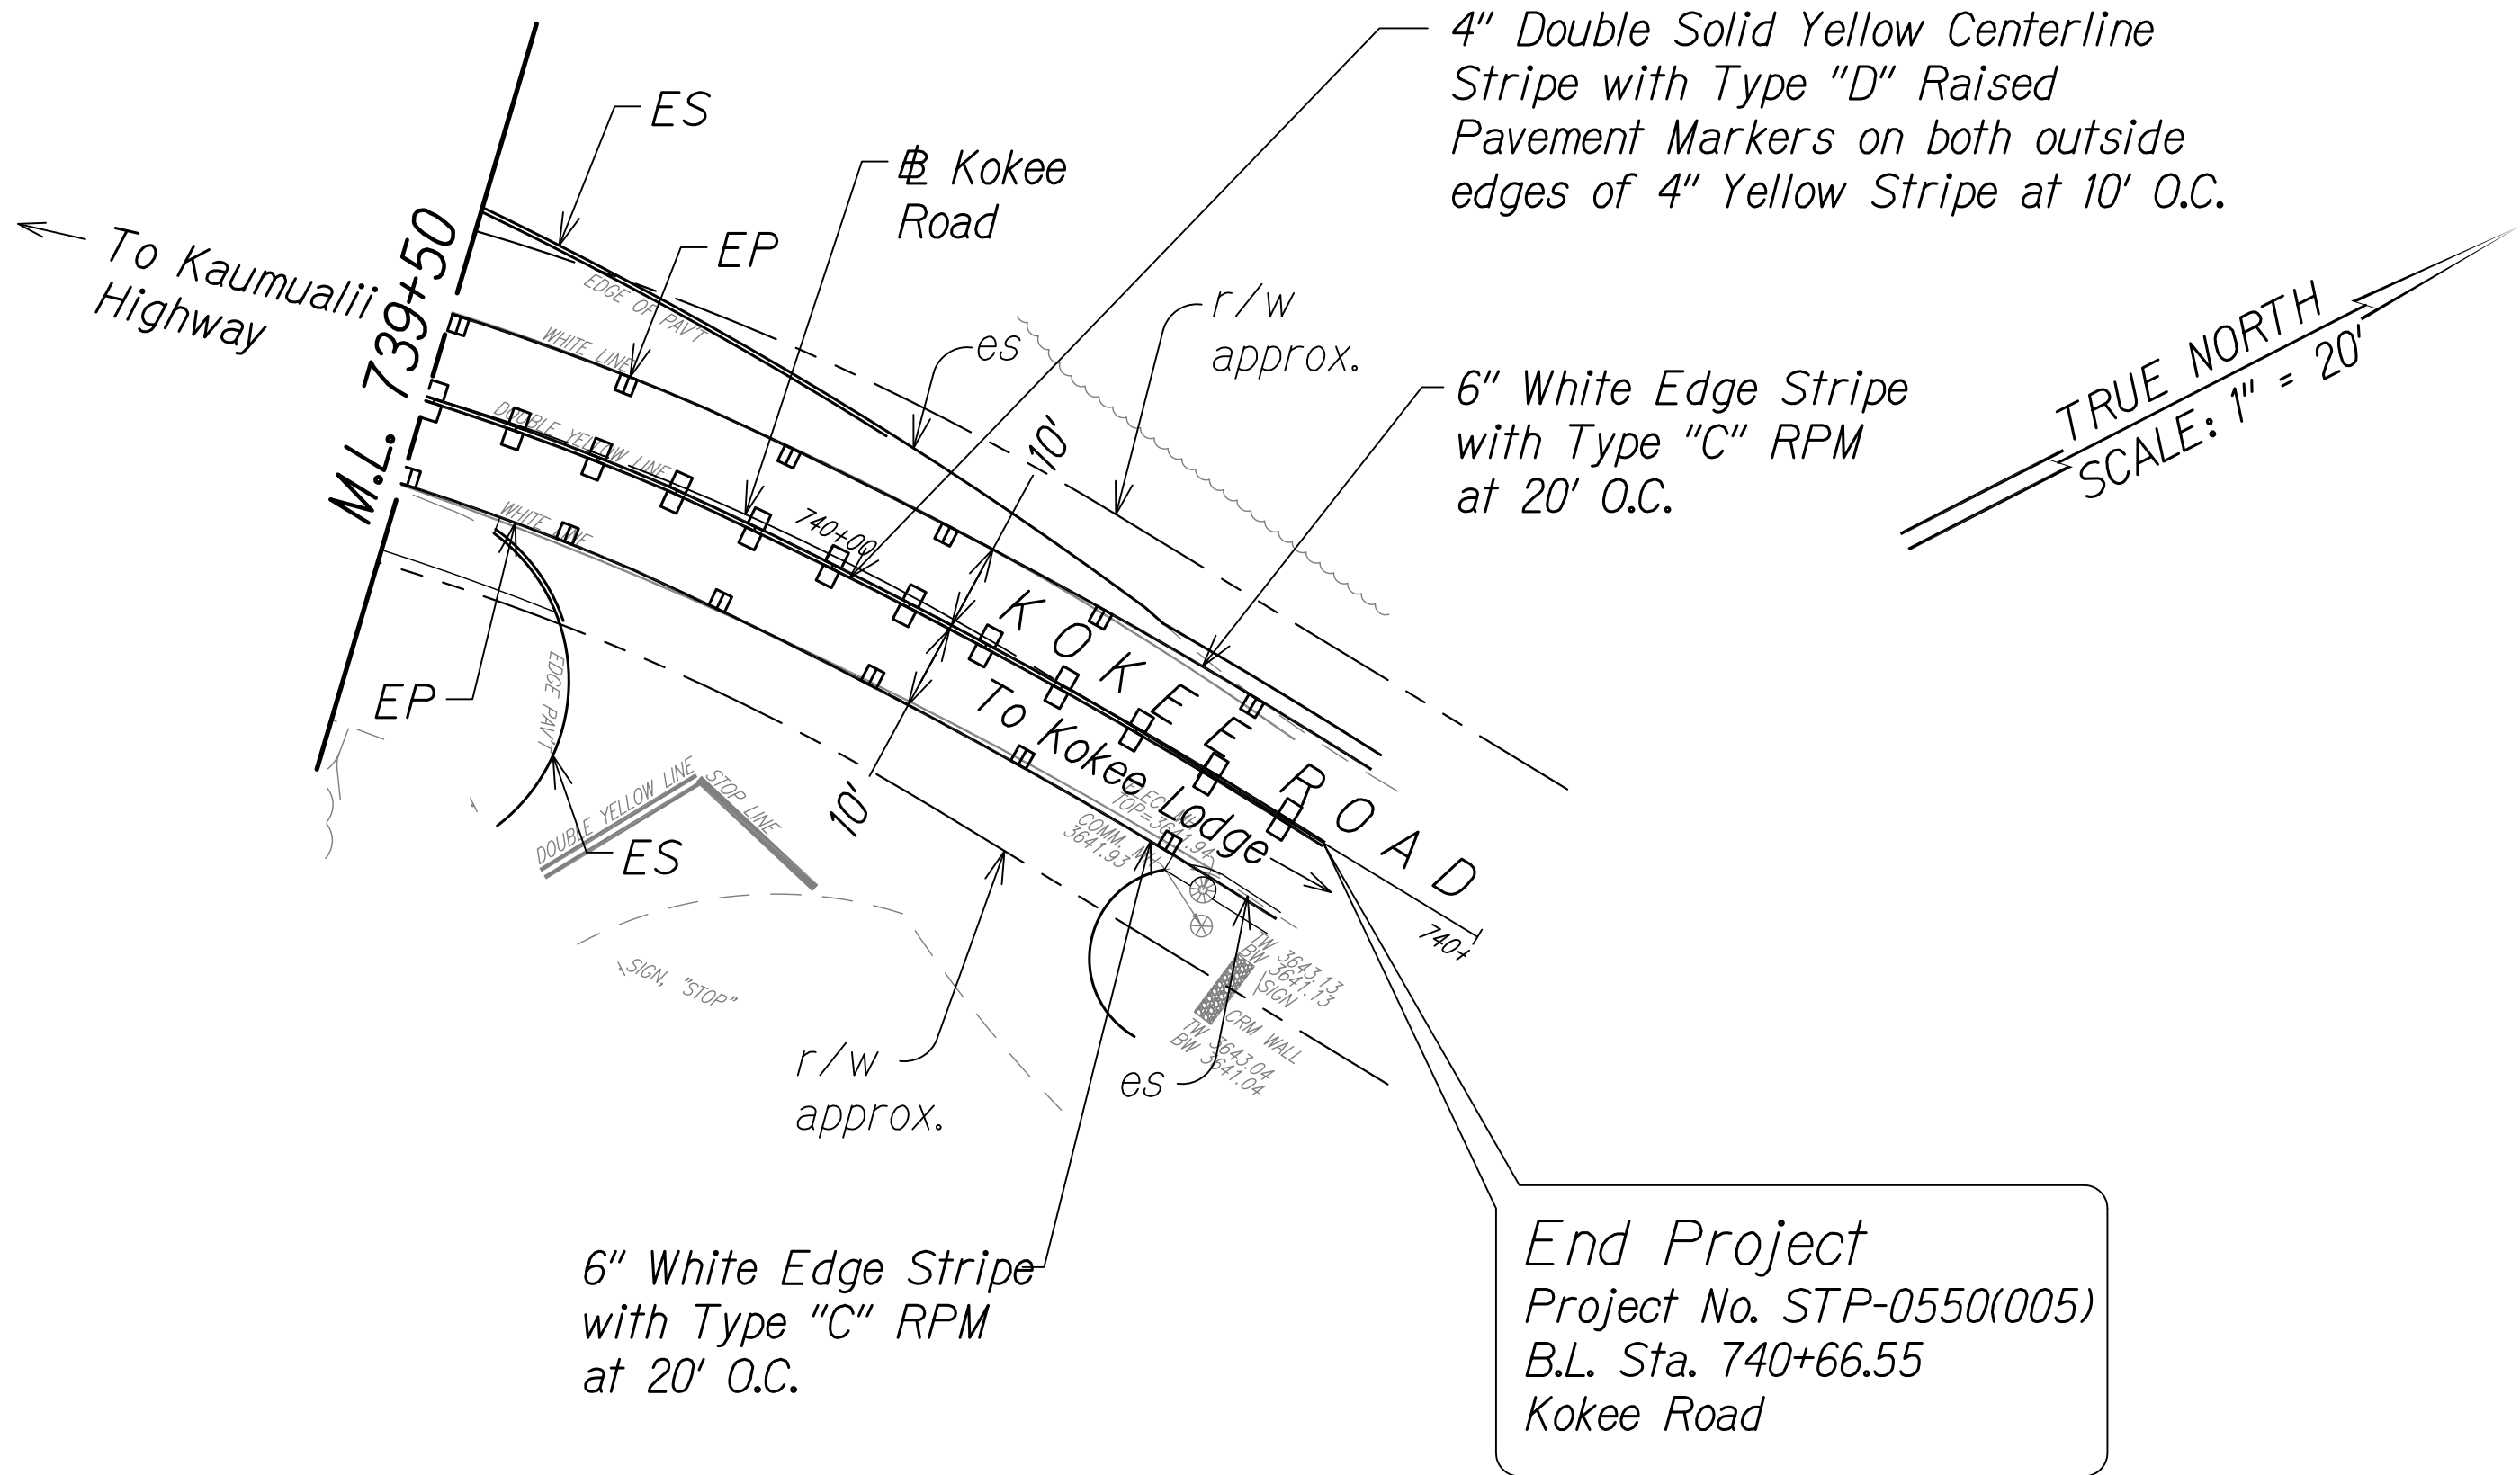


STA. 739+50 TO 740+87.32 (Kokee Road) A

Notes

1. Install object markers (RM-3) at culvert headwall crossings.
2. Install object markers (OM2-2H) on all utility poles within ROW.
3. OM-5 to be installed on all regulatory and warning signs. Install OM-2V on other types of signs.

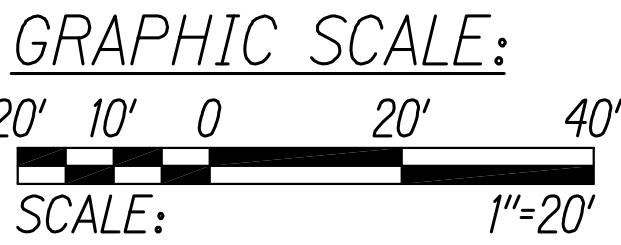

SURVEY PLOTTED BY	DATE
DESIGNED BY	
TRACED BY	
DESIGNED BY	
QUANTITIES BY	
CHECKED BY	
ORIGINAL PLAN	No.

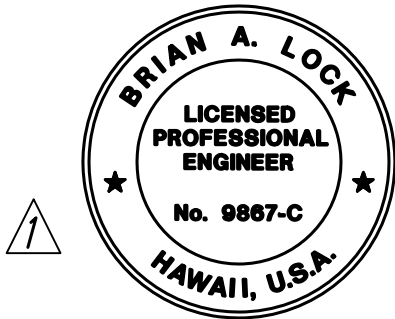

THIS WORK WAS PREPARED BY
ME OR UNDER MY SUPERVISION.
[Signature]
WILSON OKAMOTO CORPORATION
APRIL 30, 2024
LIC. EXP. DATE

STATE OF HAWAII
DEPARTMENT OF TRANSPORTATION
HIGHWAYS DIVISION
**PAVEMENT MARKING &
SIGNING PLAN**
WAIMEA CANYON DRIVE /
Kokee Road IMPROVEMENTS, PHASE 2A
MILE POST 11.5 TO MILE POST 14.0
Federal-Aid Project No. STP-0550(005)
Scale: 1" = 20' Date: August 2022

11/07/22	Revised Presentation of RPM; Revised Engineer's Stamp
DATE	REVISION

SHEET No. 13 OF 13 SHEETS

COPY OF ORIGINAL TRACING

ADD 68