
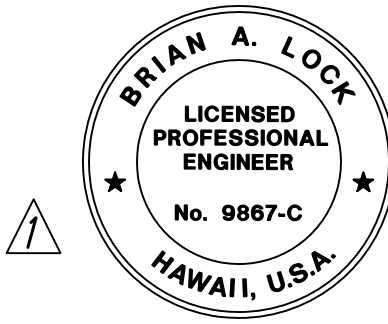
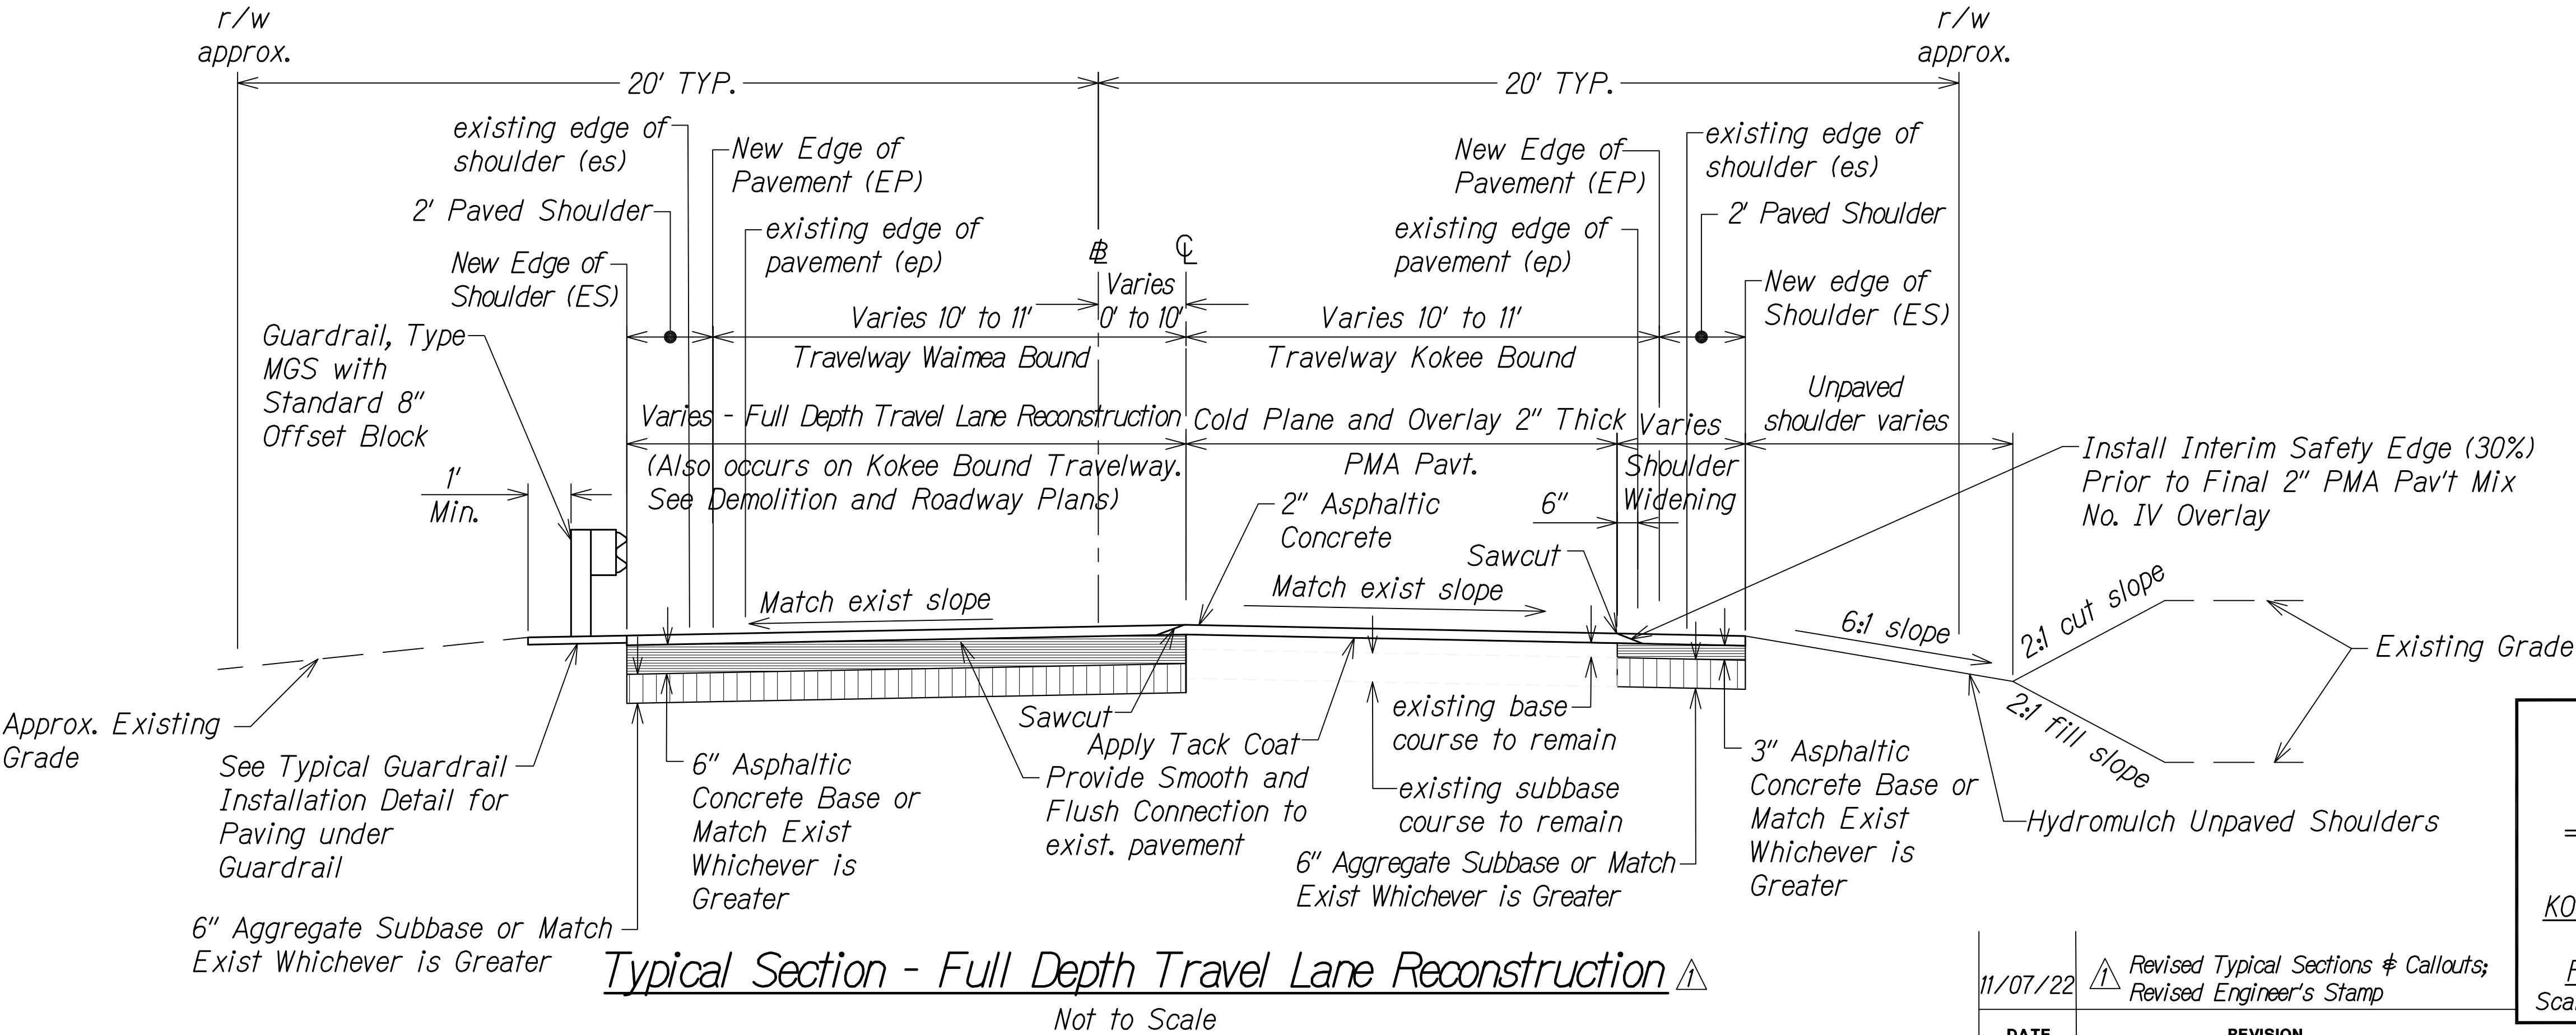


DIST. NO.	STATE	FED. AID PROJ. NO.	FISCAL YEAR	SHEET NO.	TOTAL SHEETS
KAUAI	HAW.	STP-0550(005)	2022	ADD. 12	127

Notes:

1. Recompact Subgrade to 95% Relative Compaction Before Placing New Pavement Structure.
2. See Demolition and Erosion Control Plans, and Roadway Plans for Additional Paving Location and Instruction.
3. If Softer Soils are Encountered, Add a Biaxial or Triaxial Geogrid (BCR of 0.5 to 0.6) on Top of Geotextile.

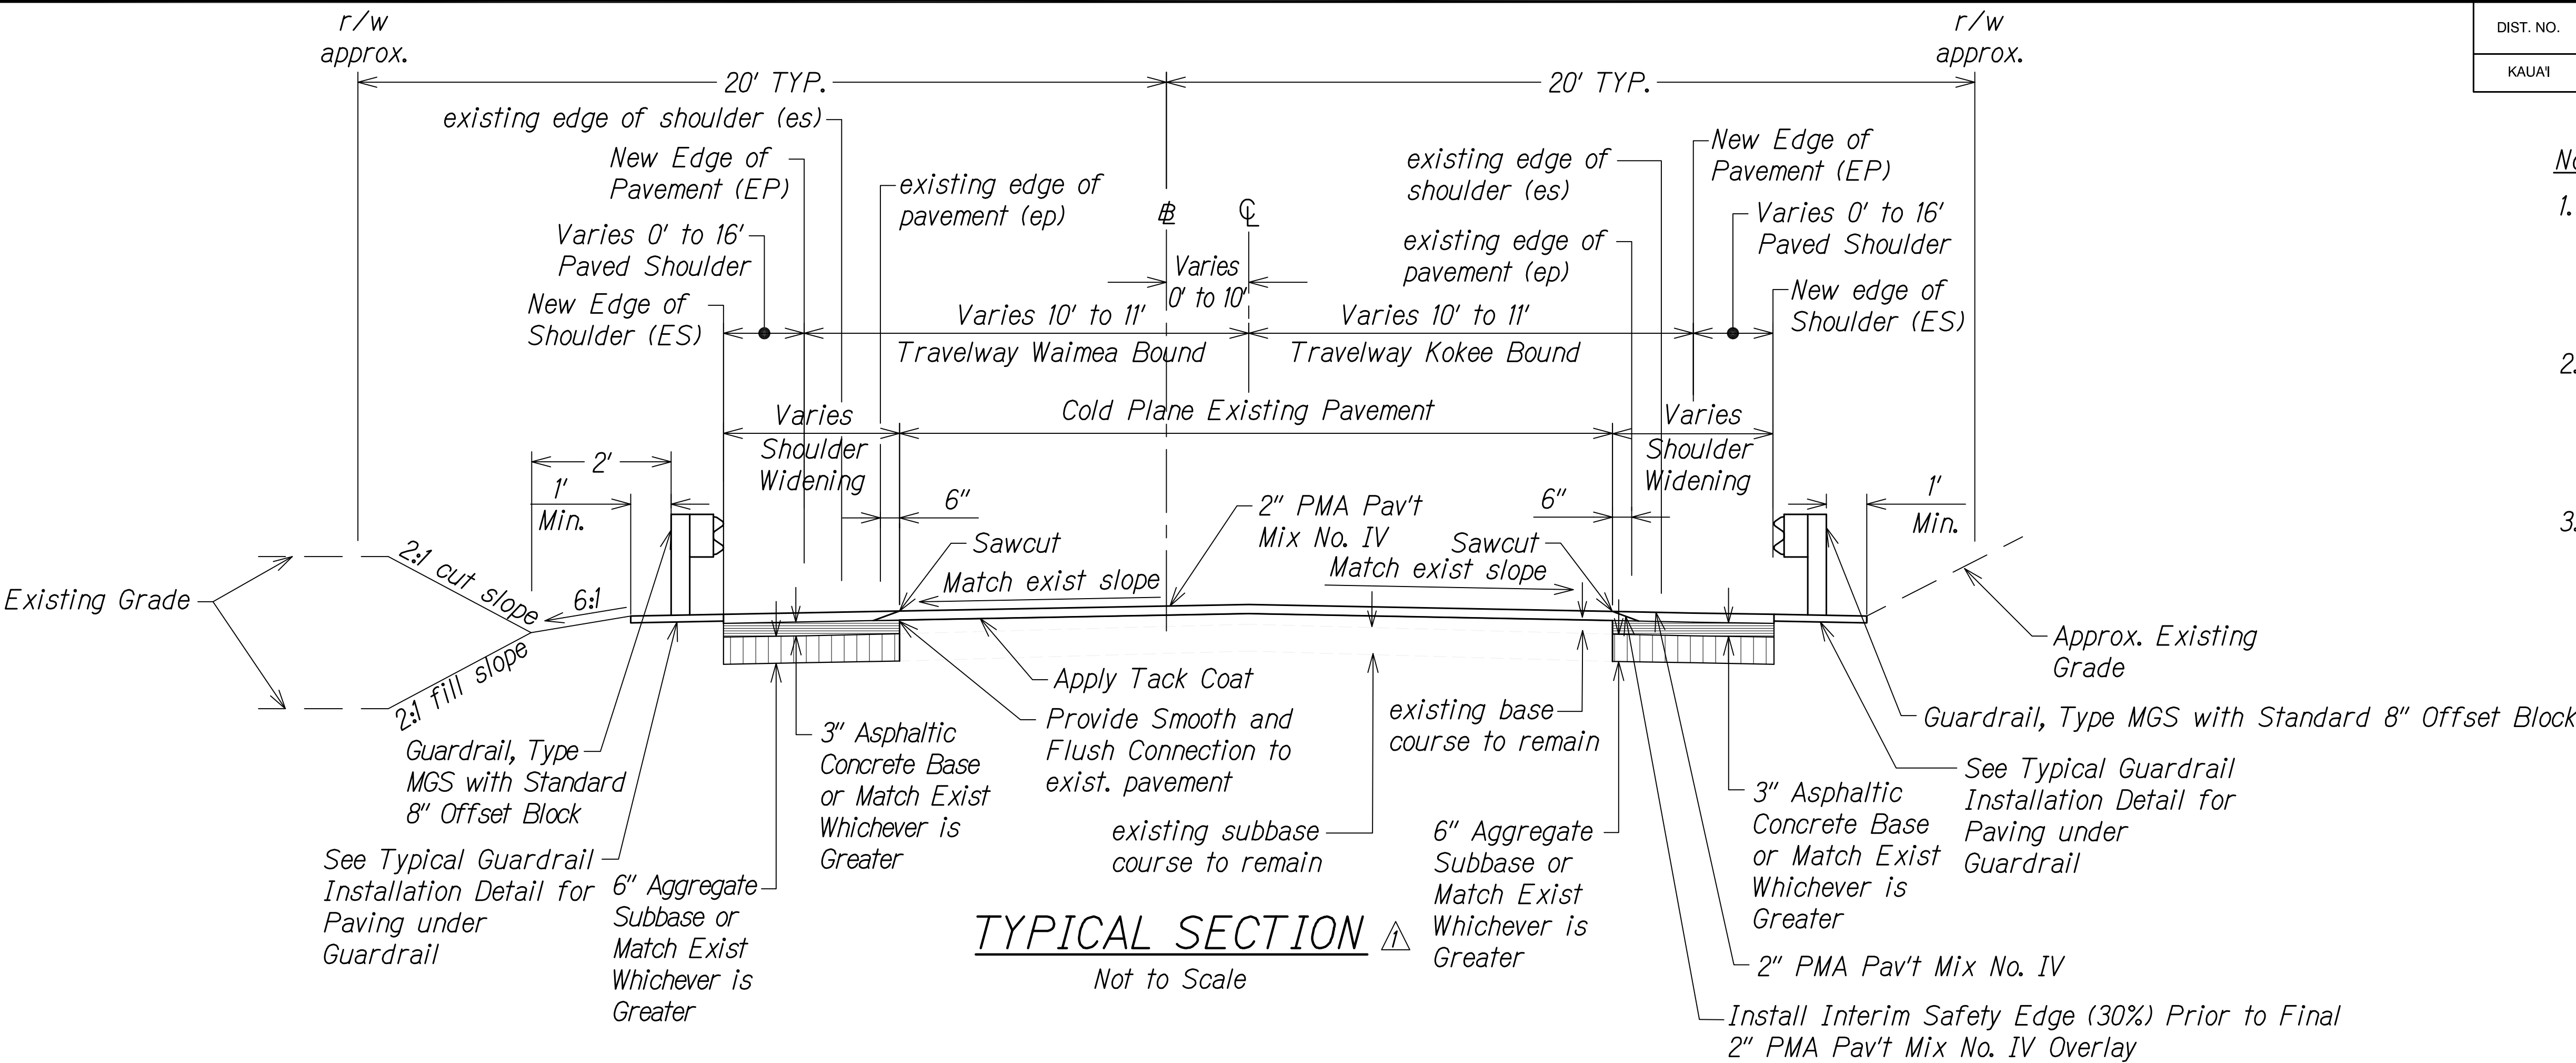

THIS WORK WAS PREPARED BY ME OR UNDER MY SUPERVISION.  
WILSON OKAMOTO CORPORATION  
APRIL 30, 2024  
LIC. EXP. DATE

STATE OF HAWAII  
DEPARTMENT OF TRANSPORTATION  
HIGHWAYS DIVISION

**TYPICAL ROAD SECTION**

WAIMEA CANYON DRIVE /  
KOKEE ROAD IMPROVEMENTS, PHASE 2A  
MILE POST 11.5 TO MILE POST 14.0  
Federal-Aid Project No. STP-0550(005)  
Scale: Date: August 2022

11/07/22 ⚠ Revised Typical Sections & Callouts;  
Revised Engineer's Stamp

DATE REVISION

SHEET No. 1 OF 1 SHEETS

COPY OF ORIGINAL TRACING

ADD 12