
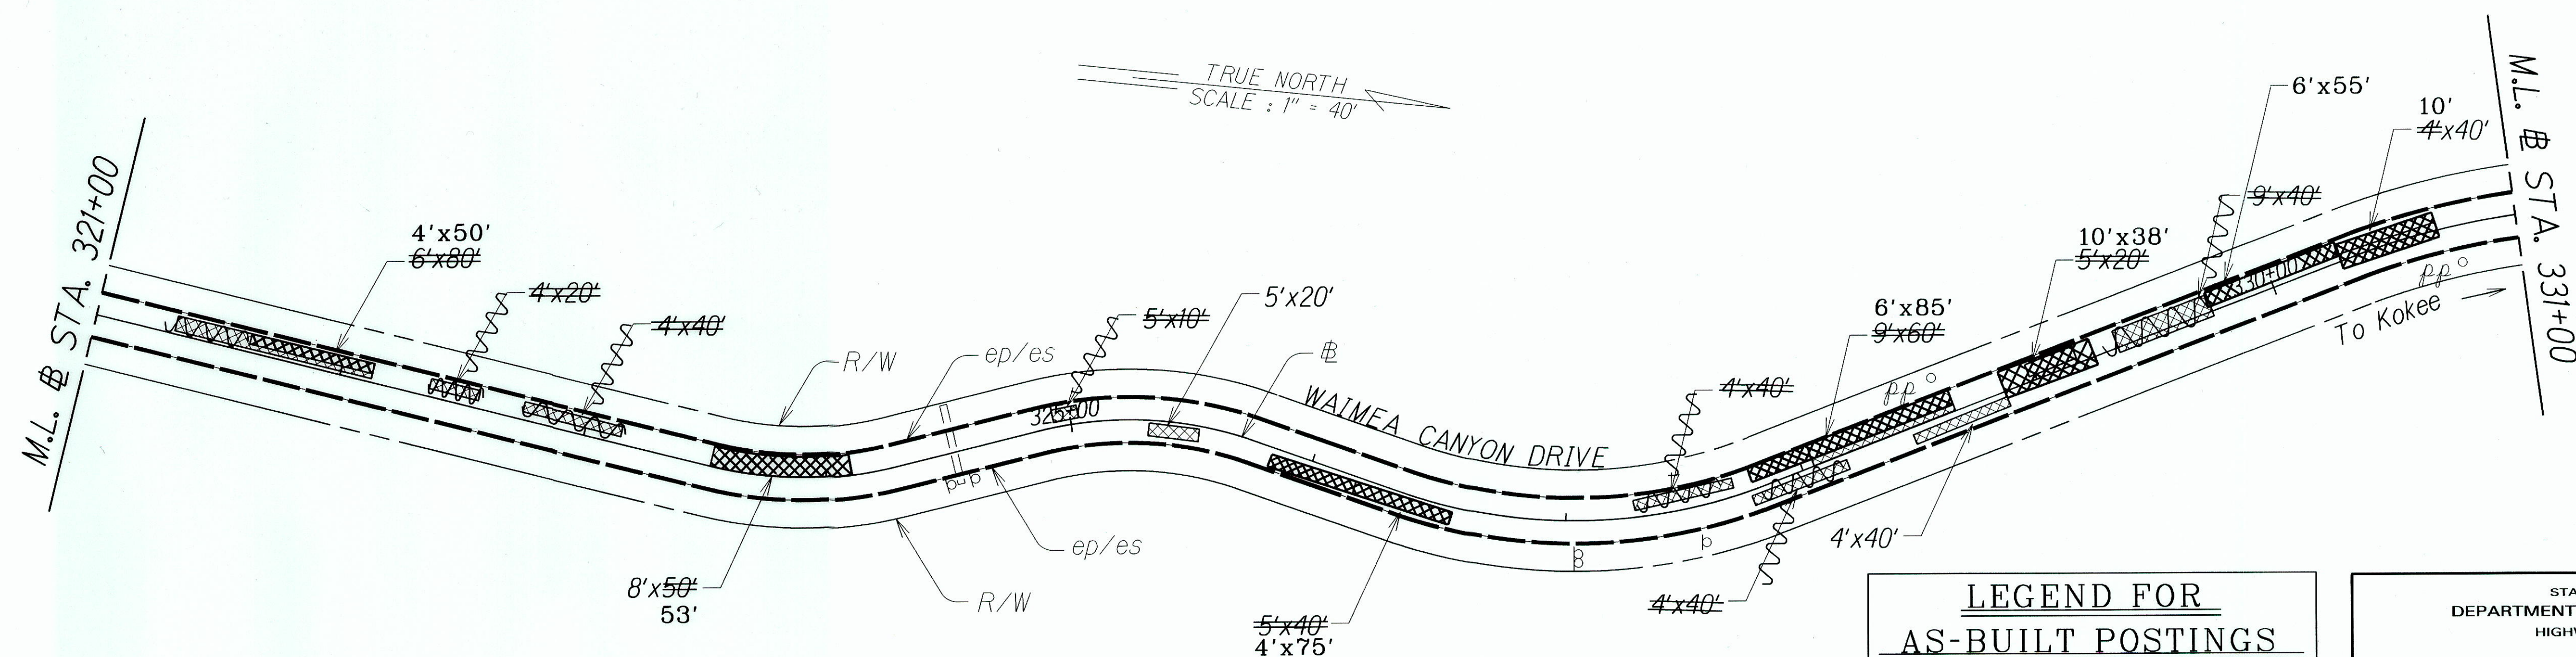


FED. ROAD DIST. NO.	STATE	FED-AID PROJ. NO.	FISCAL YEAR	SHEET NO.	TOTAL SHEETS
HAWAII	HAW.	STP-0550(004)	2013	8	24

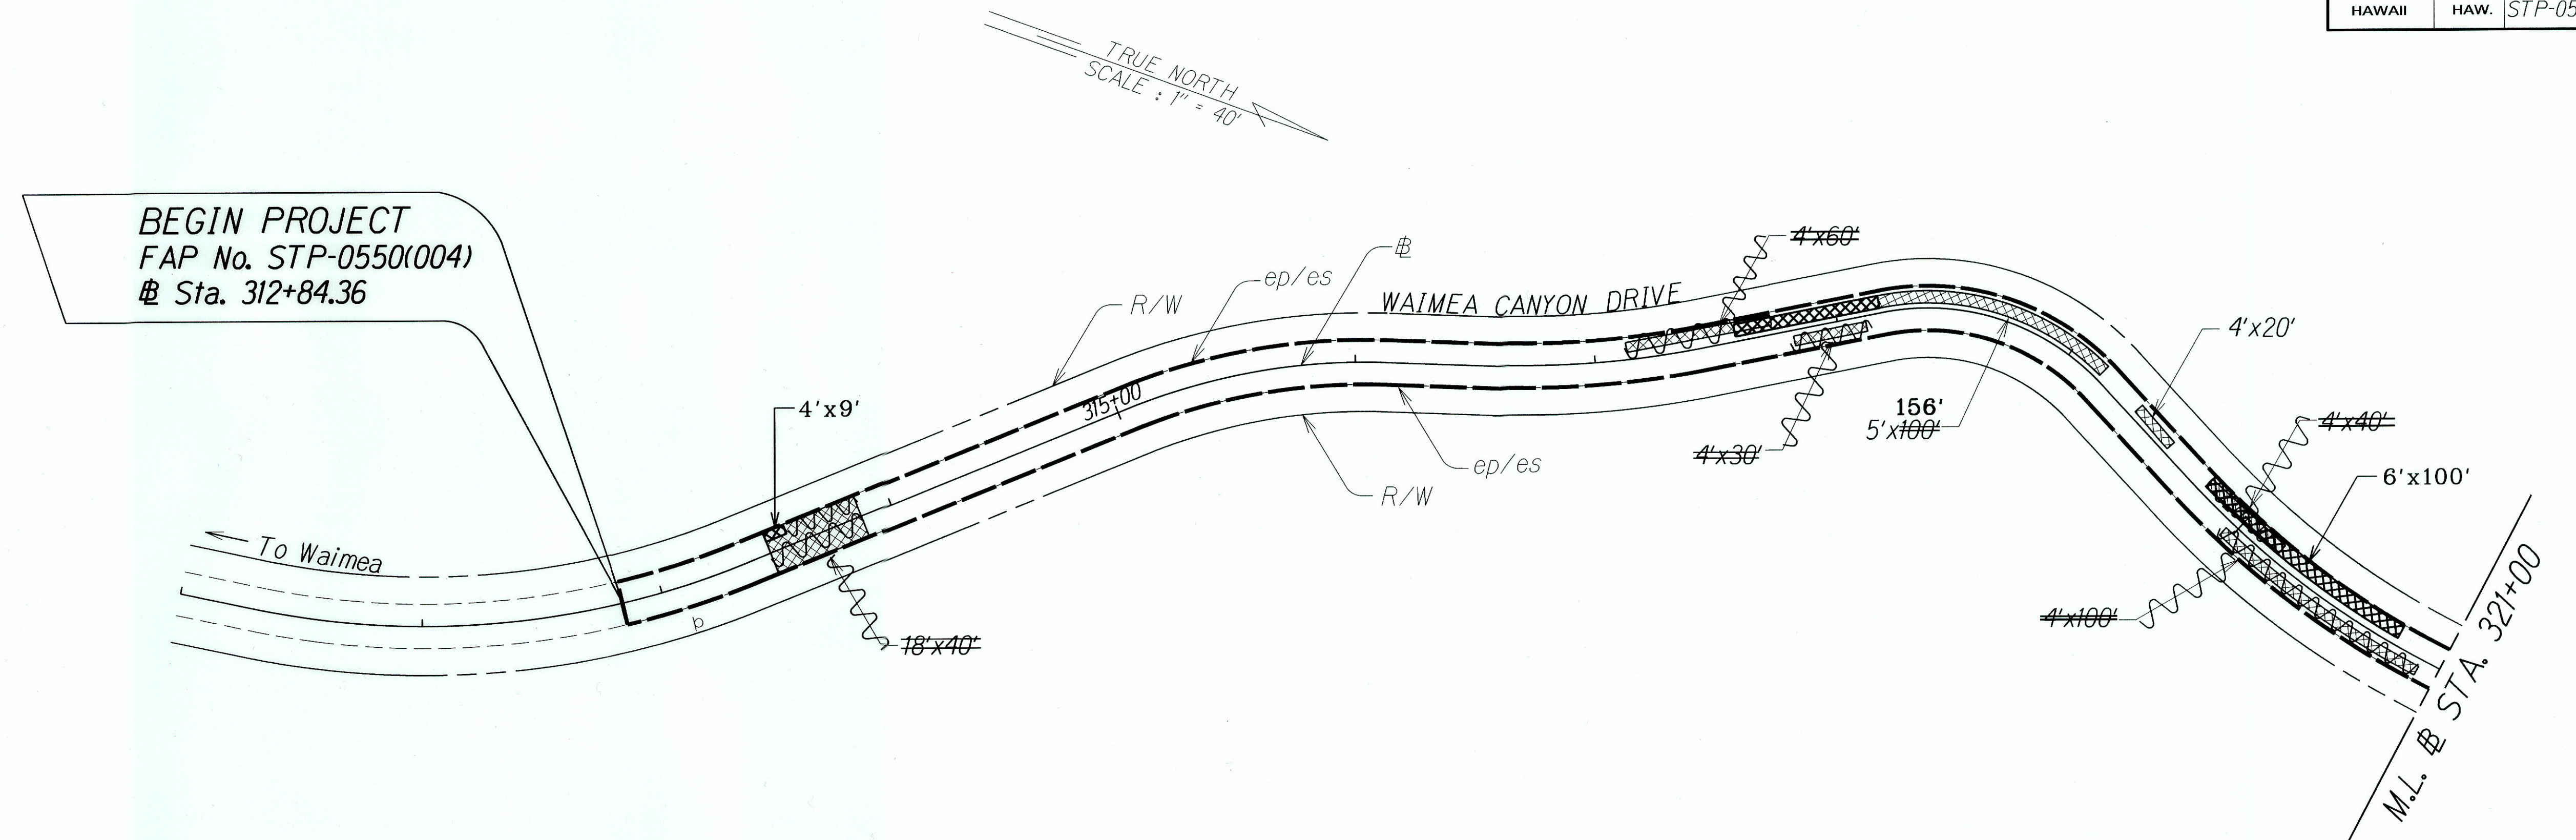

ORIGINAL PLAN	SURVEY PLOTTED BY	DATE
NOTE BOOK	DESIGNED BY	
QUANTITIES BY	CHECKED BY	
N.		


LEGEND FOR AS-BUILT POSTINGS	
	Squiggly line for as-built deletion
	Double line for as-built deletion
Roadway	Text for as-built posting

STATE OF HAWAII
DEPARTMENT OF TRANSPORTATION
HIGHWAYS DIVISION

ROADWAY PLAN
WAIMEA CANYON DRIVE/KOKEE ROAD RESURFACING
Mile Post 6.0 to Mile Post 8.5
Fed-Aid Proj. No. STP-0550(004)
Scale: 1" = 40' Date: Dec, 2012
SHEET No. 1 OF 7 SHEETS

"AS-BUILT"

FED. ROAD DIST. NO.	STATE	FED-AID PROJ. NO.	FISCAL YEAR	SHEET NO.	TOTAL SHEETS
HAWAII	HAW.	STP-0550(004)	2013	9	24

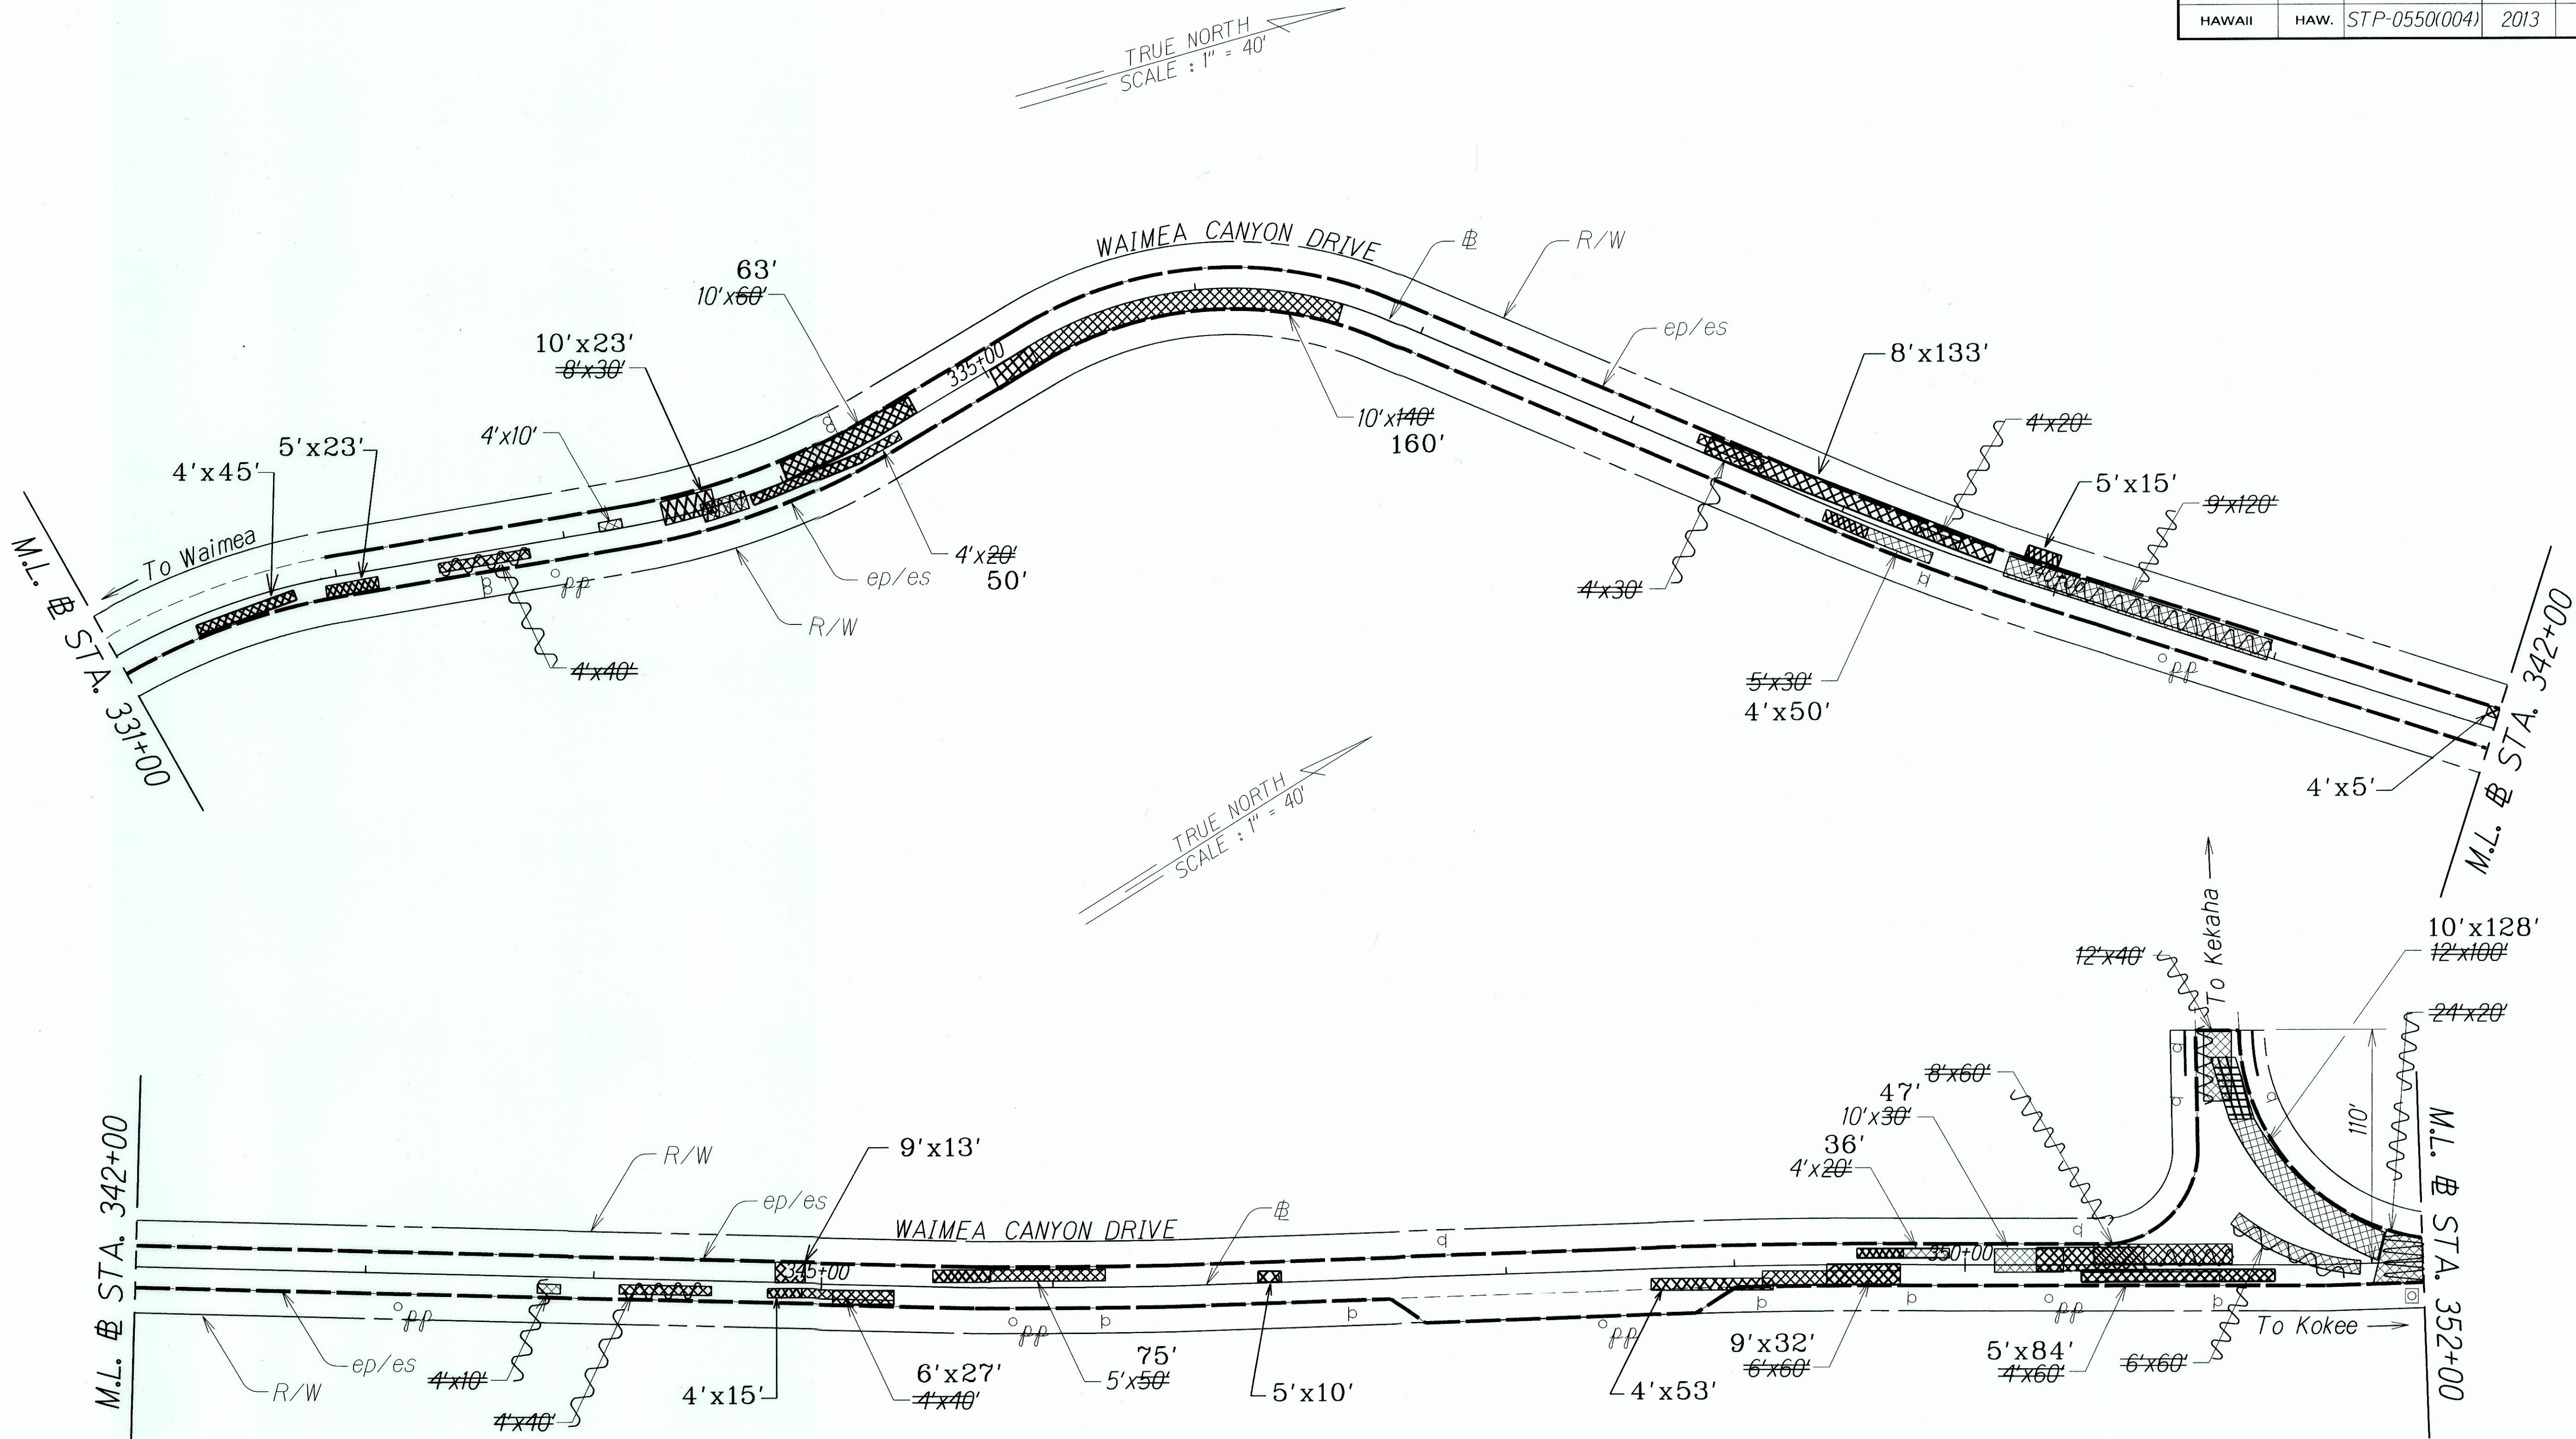

ORIGINAL PLAN	SURVEY PLOTTED BY	DATE
NOTE BOOK	DRAWN BY	
DESIGNED BY	CHECKED BY	
QUANTITIES BY		
CHECKED BY		

LEGEND FOR AS-BUILT POSTINGS	
	Squiggly line for as-built deletion
	Double line for as-built deletion
Roadway	Text for as-built posting

STATE OF HAWAII
DEPARTMENT OF TRANSPORTATION
HIGHWAYS DIVISION

ROADWAY PLAN

WAIMEA CANYON DRIVE/KOKEE ROAD RESURFACING

Mile Post 6.0 to Mile Post 8.5



Fed-Aid Proj. No. STP-0550(004)

Scale: 1" = 40' Date: Dec. 2012

SHEET No. 2 OF 7 SHEETS

"AS-BUILT"

FED. ROAD DIST. NO.	STATE	FED-AID PROJ. NO.	FISCAL YEAR	SHEET NO.	TOTAL SHEETS
HAWAII	HAW.	STP-0550(004)	2013	10	24

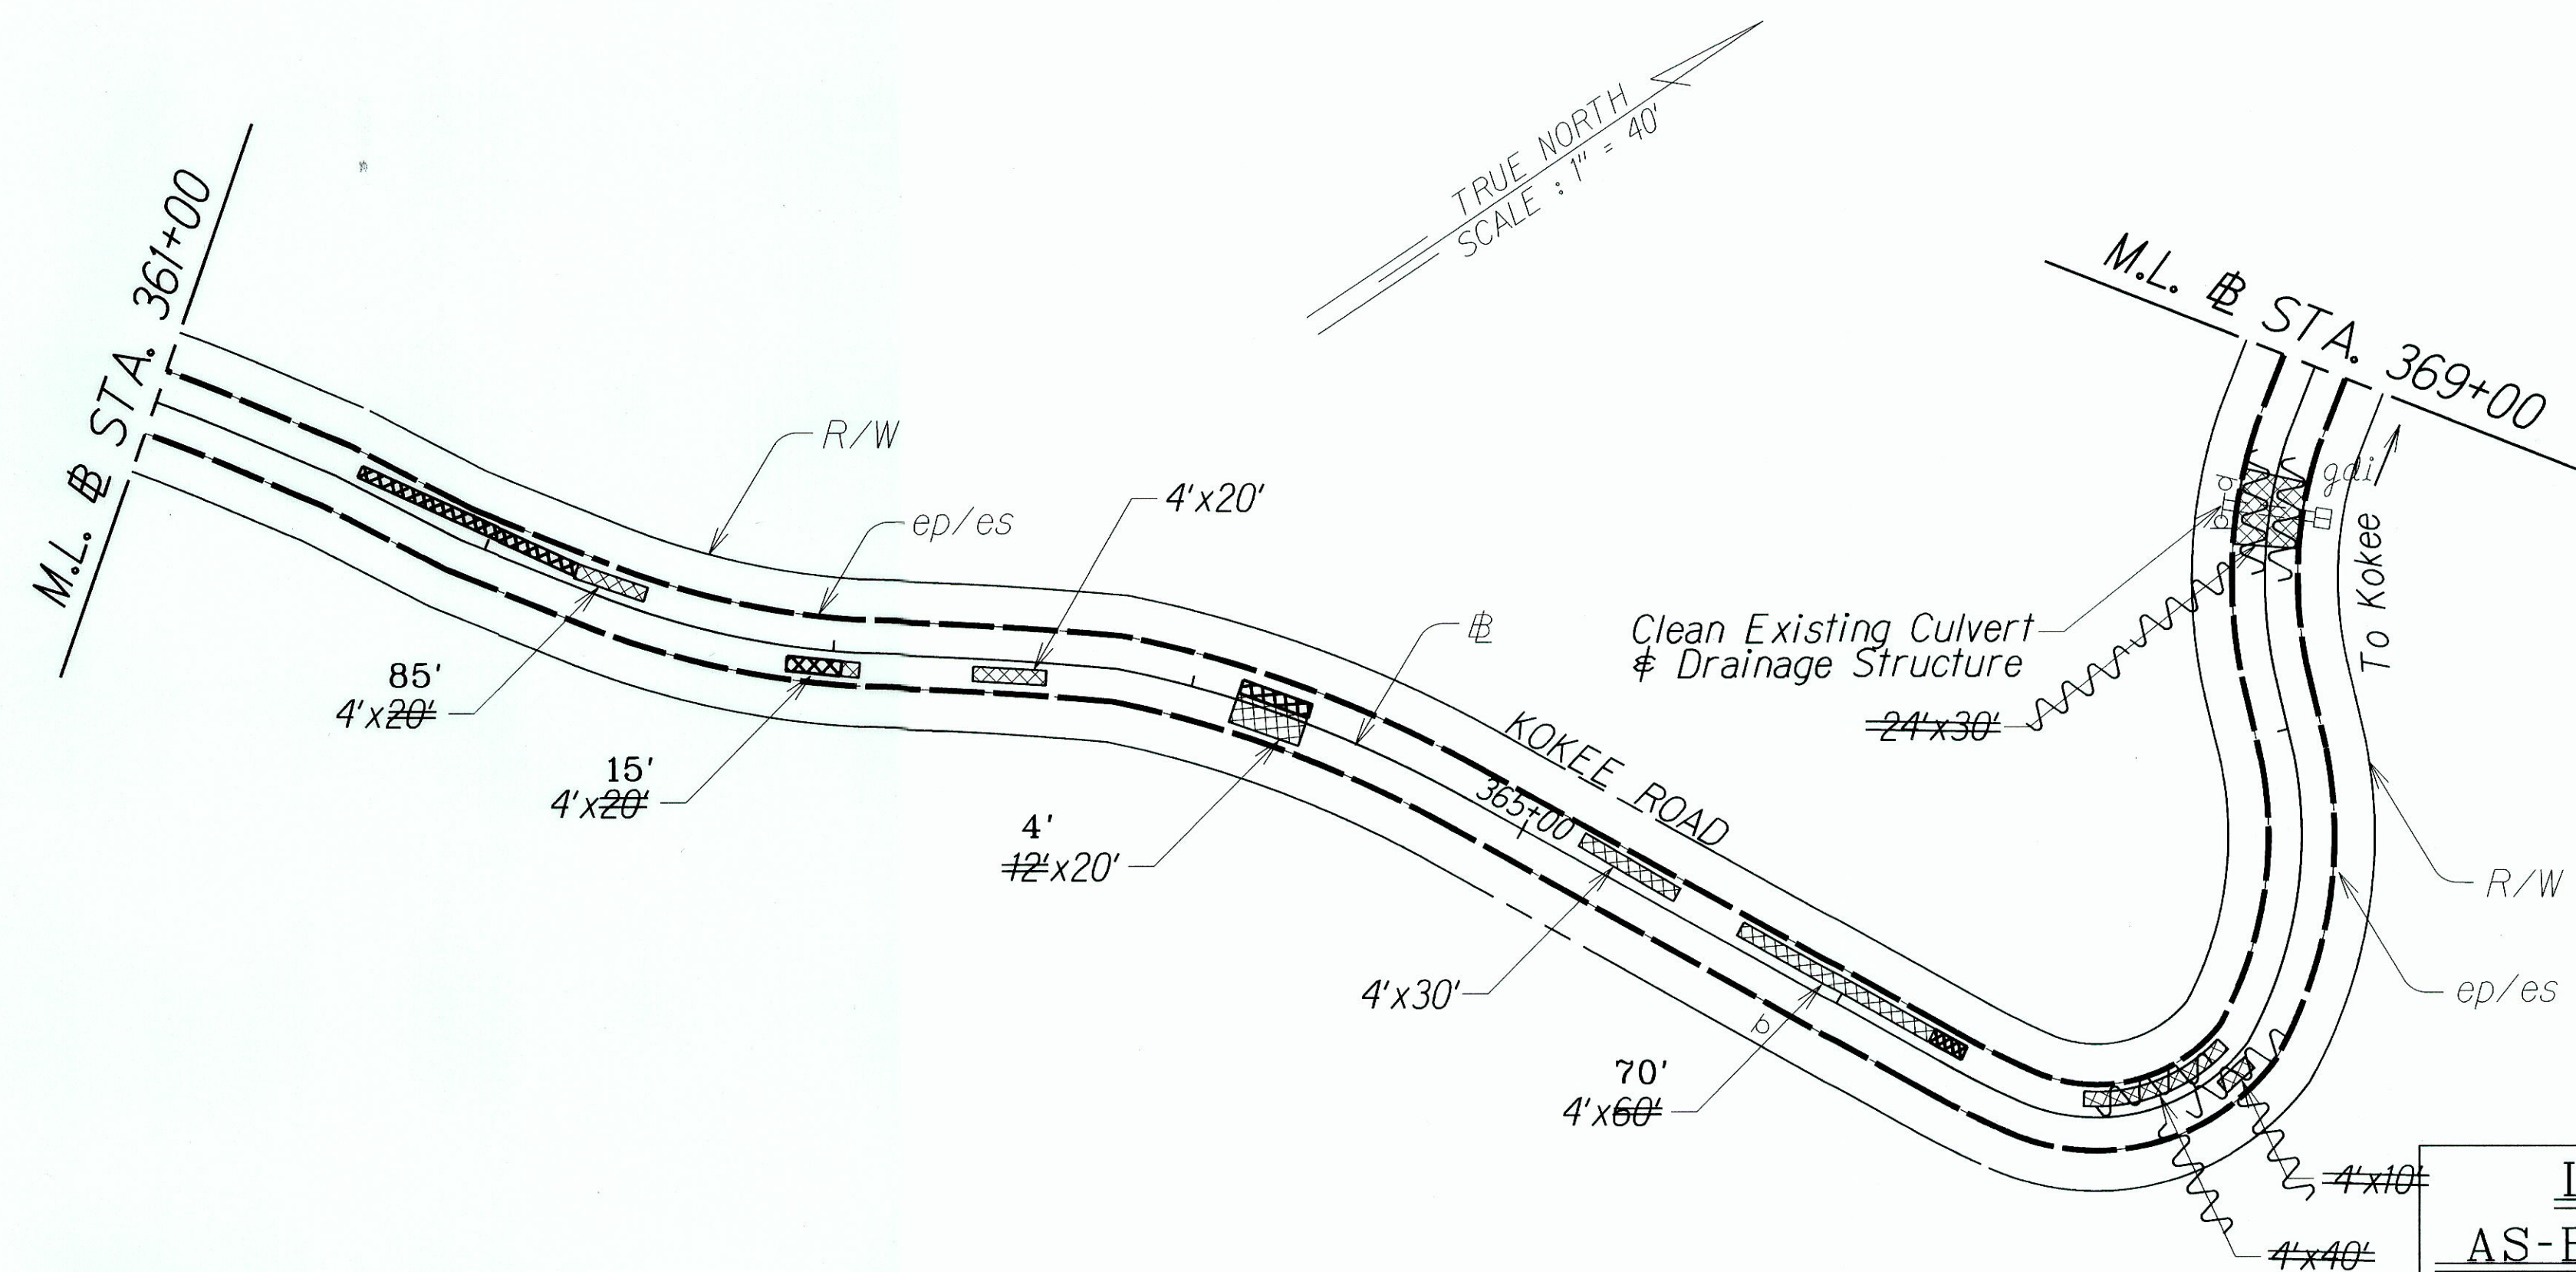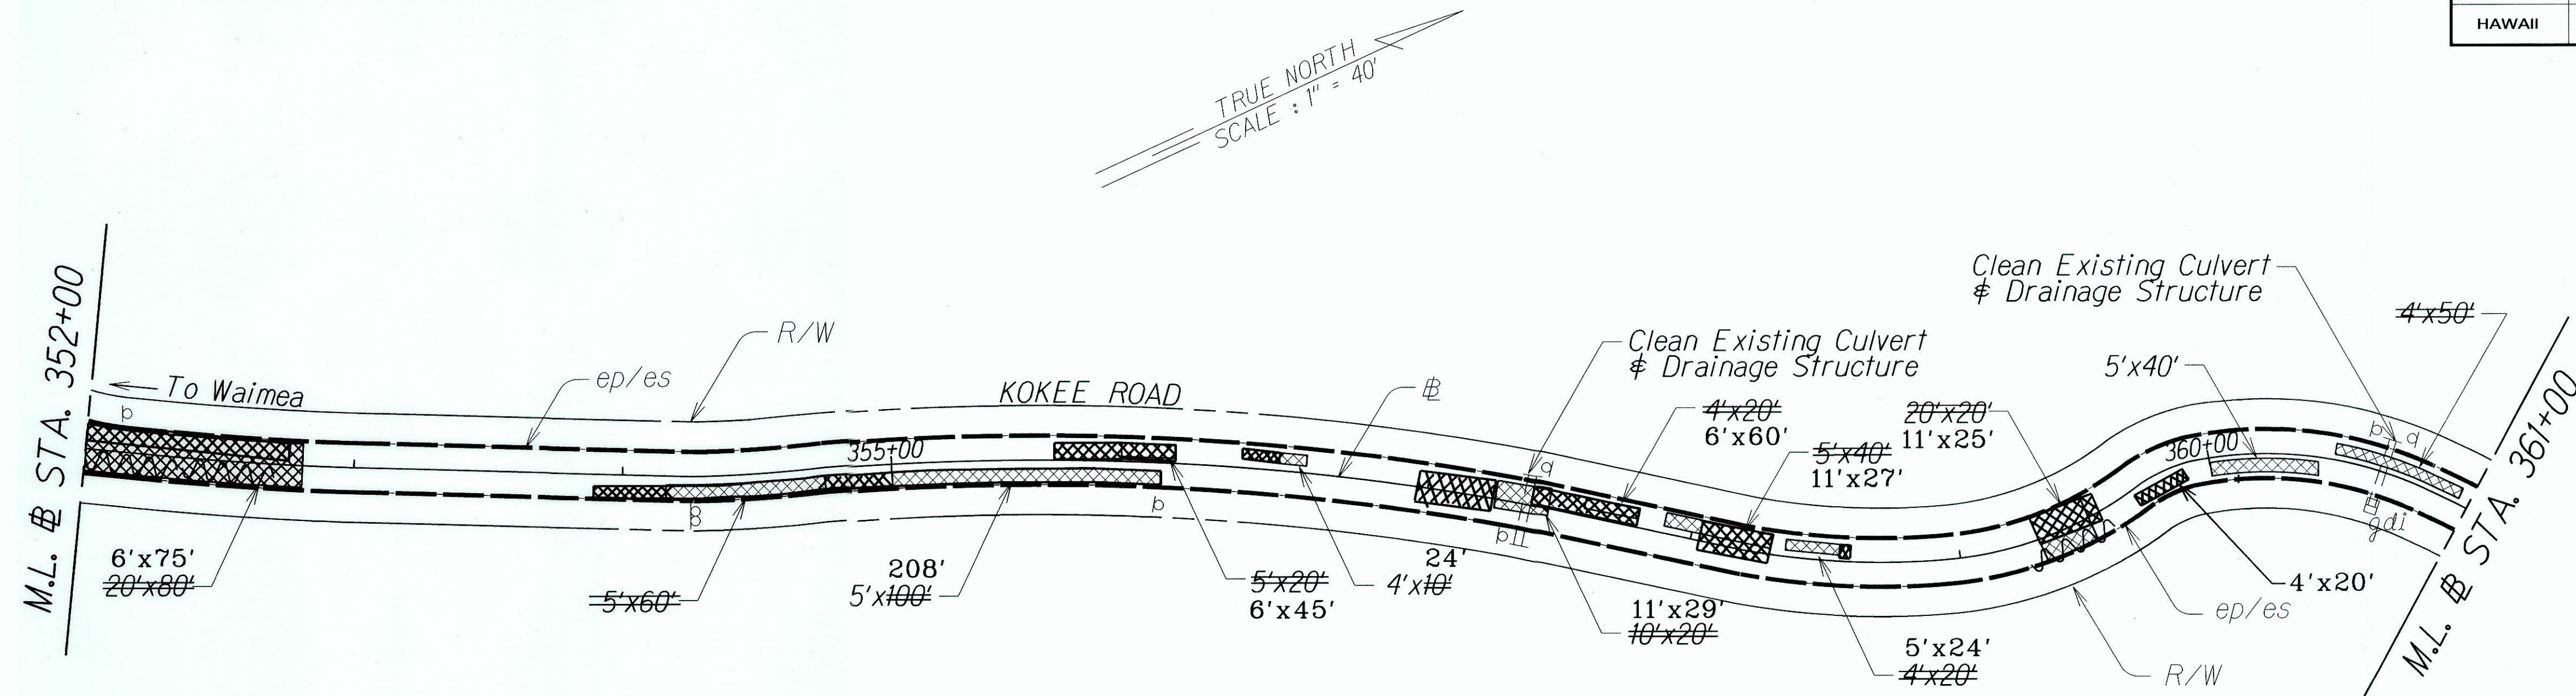

LEGEND FOR AS-BUILT POSTINGS	
	Squiggly line for as-built deletion
	Double line for as-built deletion
Roadway	Text for as-built posting

STATE OF HAWAII
DEPARTMENT OF TRANSPORTATION
HIGHWAYS DIVISION

ROADWAY PLAN

WAIMEA CANYON DRIVE/KOKEE ROAD RESURFACING

Mile Post 6.0 to Mile Post 8.5

Fed-Aid Proj. No. STP-0550(004)


Scale: 1" = 40' Date: Dec. 2012

SHEET No. 3 OF 7 SHEETS

"AS-BUILT"

ORIGINAL PLAN	SURVEY PLOTTED BY	DATE
NOTE BOOK	DESIGNED BY	
	QUANTITIES BY	
	CHECKED BY	

FED. ROAD DIST. NO.	STATE	FED-AID PROJ. NO.	FISCAL YEAR	SHEET NO.	TOTAL SHEETS
HAWAII	HAW.	STP-0550(004)	2013	11	24

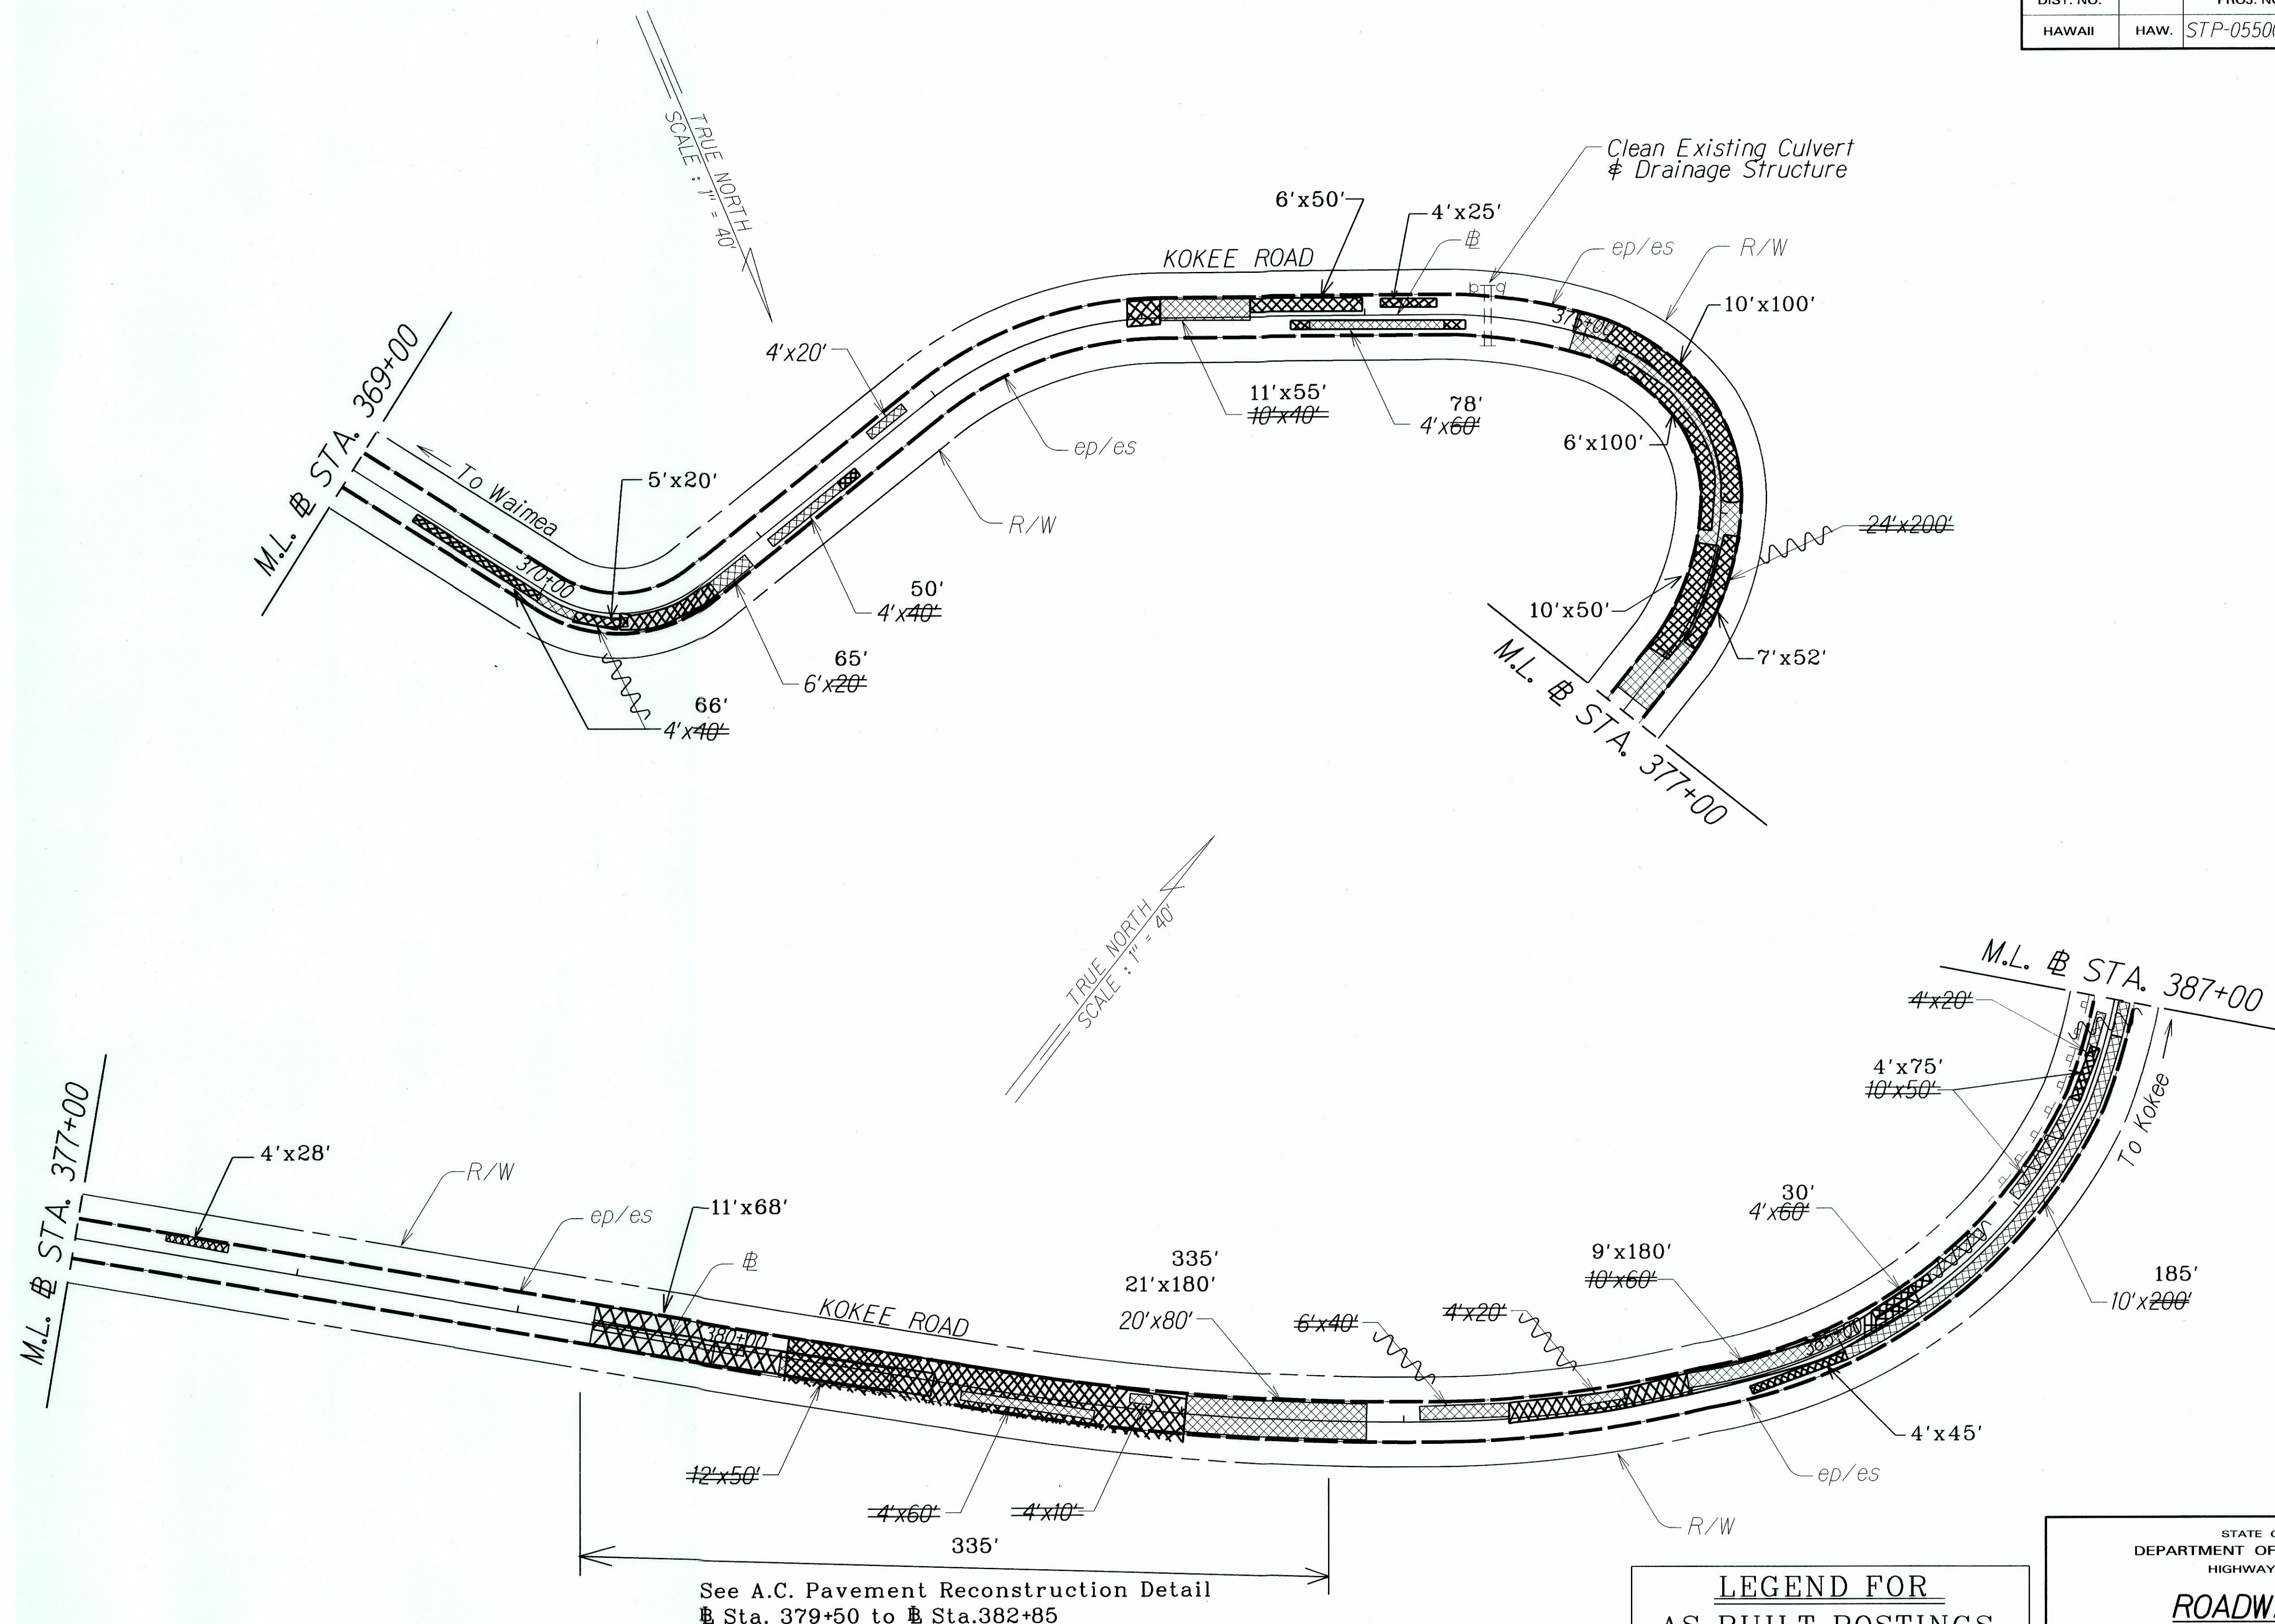

See A.C. Pavement Reconstruction Detail
 Sta. 379+50 to Sta. 382+85

LEGEND FOR AS-BUILT POSTINGS	
	Squiggly line for as-built deletion
	Double line for as-built deletion
Roadway	Text for as-built posting

STATE OF HAWAII
 DEPARTMENT OF TRANSPORTATION
 HIGHWAYS DIVISION

ROADWAY PLAN



WAIMEA CANYON DRIVE/KOKEE ROAD RESURFACING
 Mile Post 6.0 to Mile Post 8.5
 Fed-Aid Proj. No. STP-0550(004)

Scale: 1" = 40' Date: Dec. 2012

SHEET No. 4 OF 7 SHEETS

"AS-BUILT"

FED. ROAD DIST. NO.	STATE	FED-AID PROJ. NO.	FISCAL YEAR	SHEET NO.	TOTAL SHEETS
HAWAII	HAW.	STP-0550(004)	2013	12	24

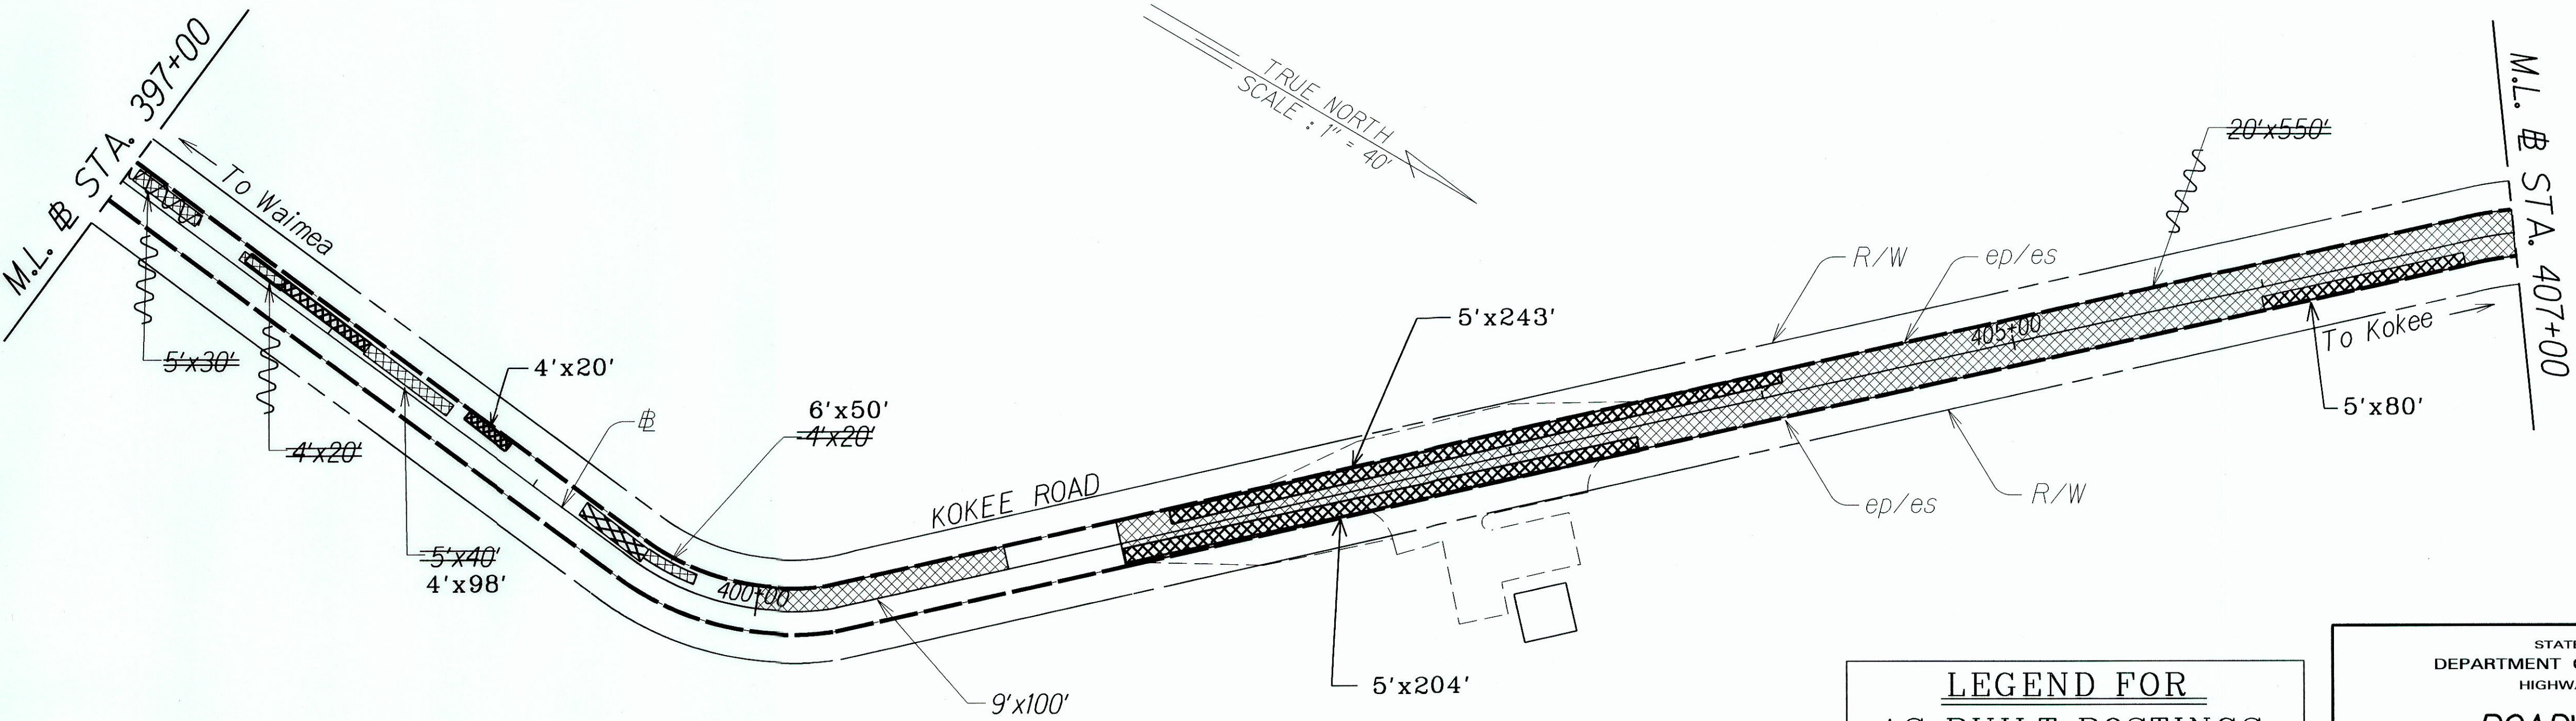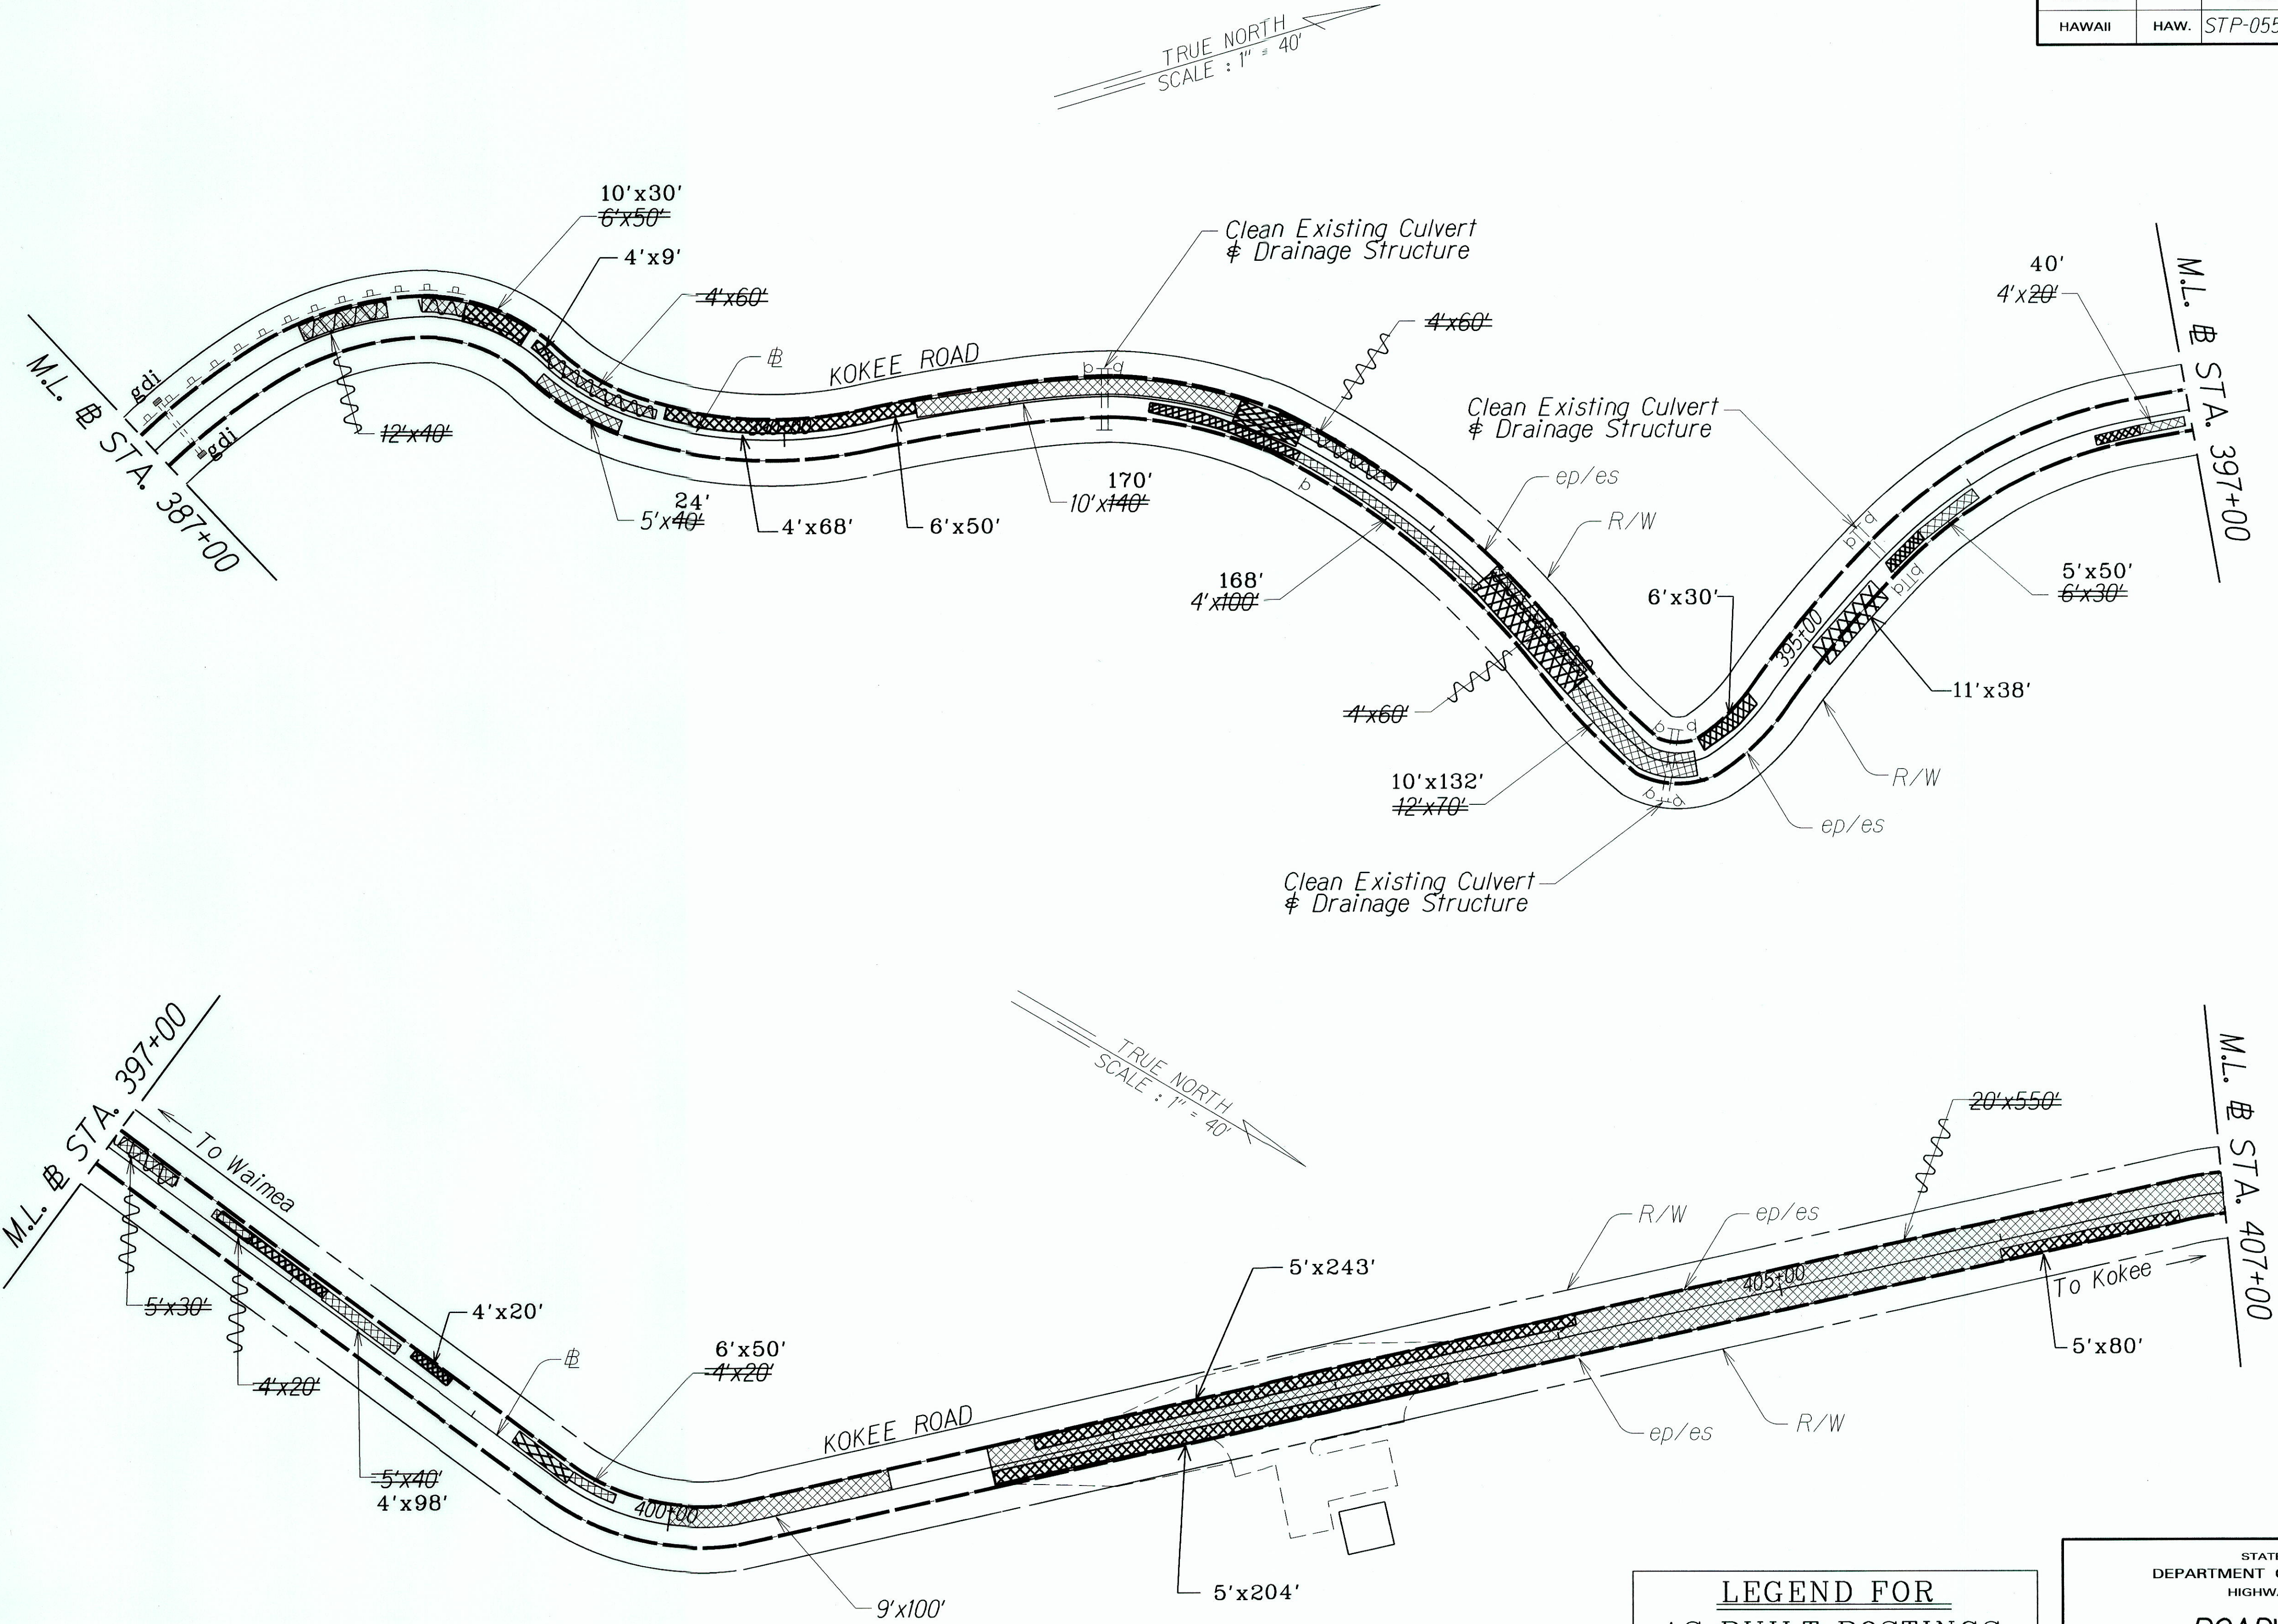

LEGEND FOR AS-BUILT POSTINGS	
	Squiggly line for as-built deletion
	Double line for as-built deletion
Roadway	Text for as-built posting

STATE OF HAWAII DEPARTMENT OF TRANSPORTATION HIGHWAYS DIVISION
ROADWAY PLAN
WAIMEA CANYON DRIVE/KOKEE ROAD RESURFACING
Mile Post 6.0 to Mile Post 8.5
Fed-Aid Proj. No. STP-0550(004)
Scale: 1" = 40'
Date: Dec. 2012


SHEET No. 5 OF 7 SHEETS

"AS-BUILT"

12

ORIGINAL PLAN	SURVEY PLOTTED BY	DATE
NOTE BOOK	DRAWN BY	
DESIGNED BY		
QUANTITIES BY		
CHECKED BY		

FED. ROAD DIST. NO.	STATE	FED-AID PROJ. NO.	FISCAL YEAR	SHEET NO.	TOTAL SHEETS
HAWAII	HAW.	STP-0550(004)	2013	13	24

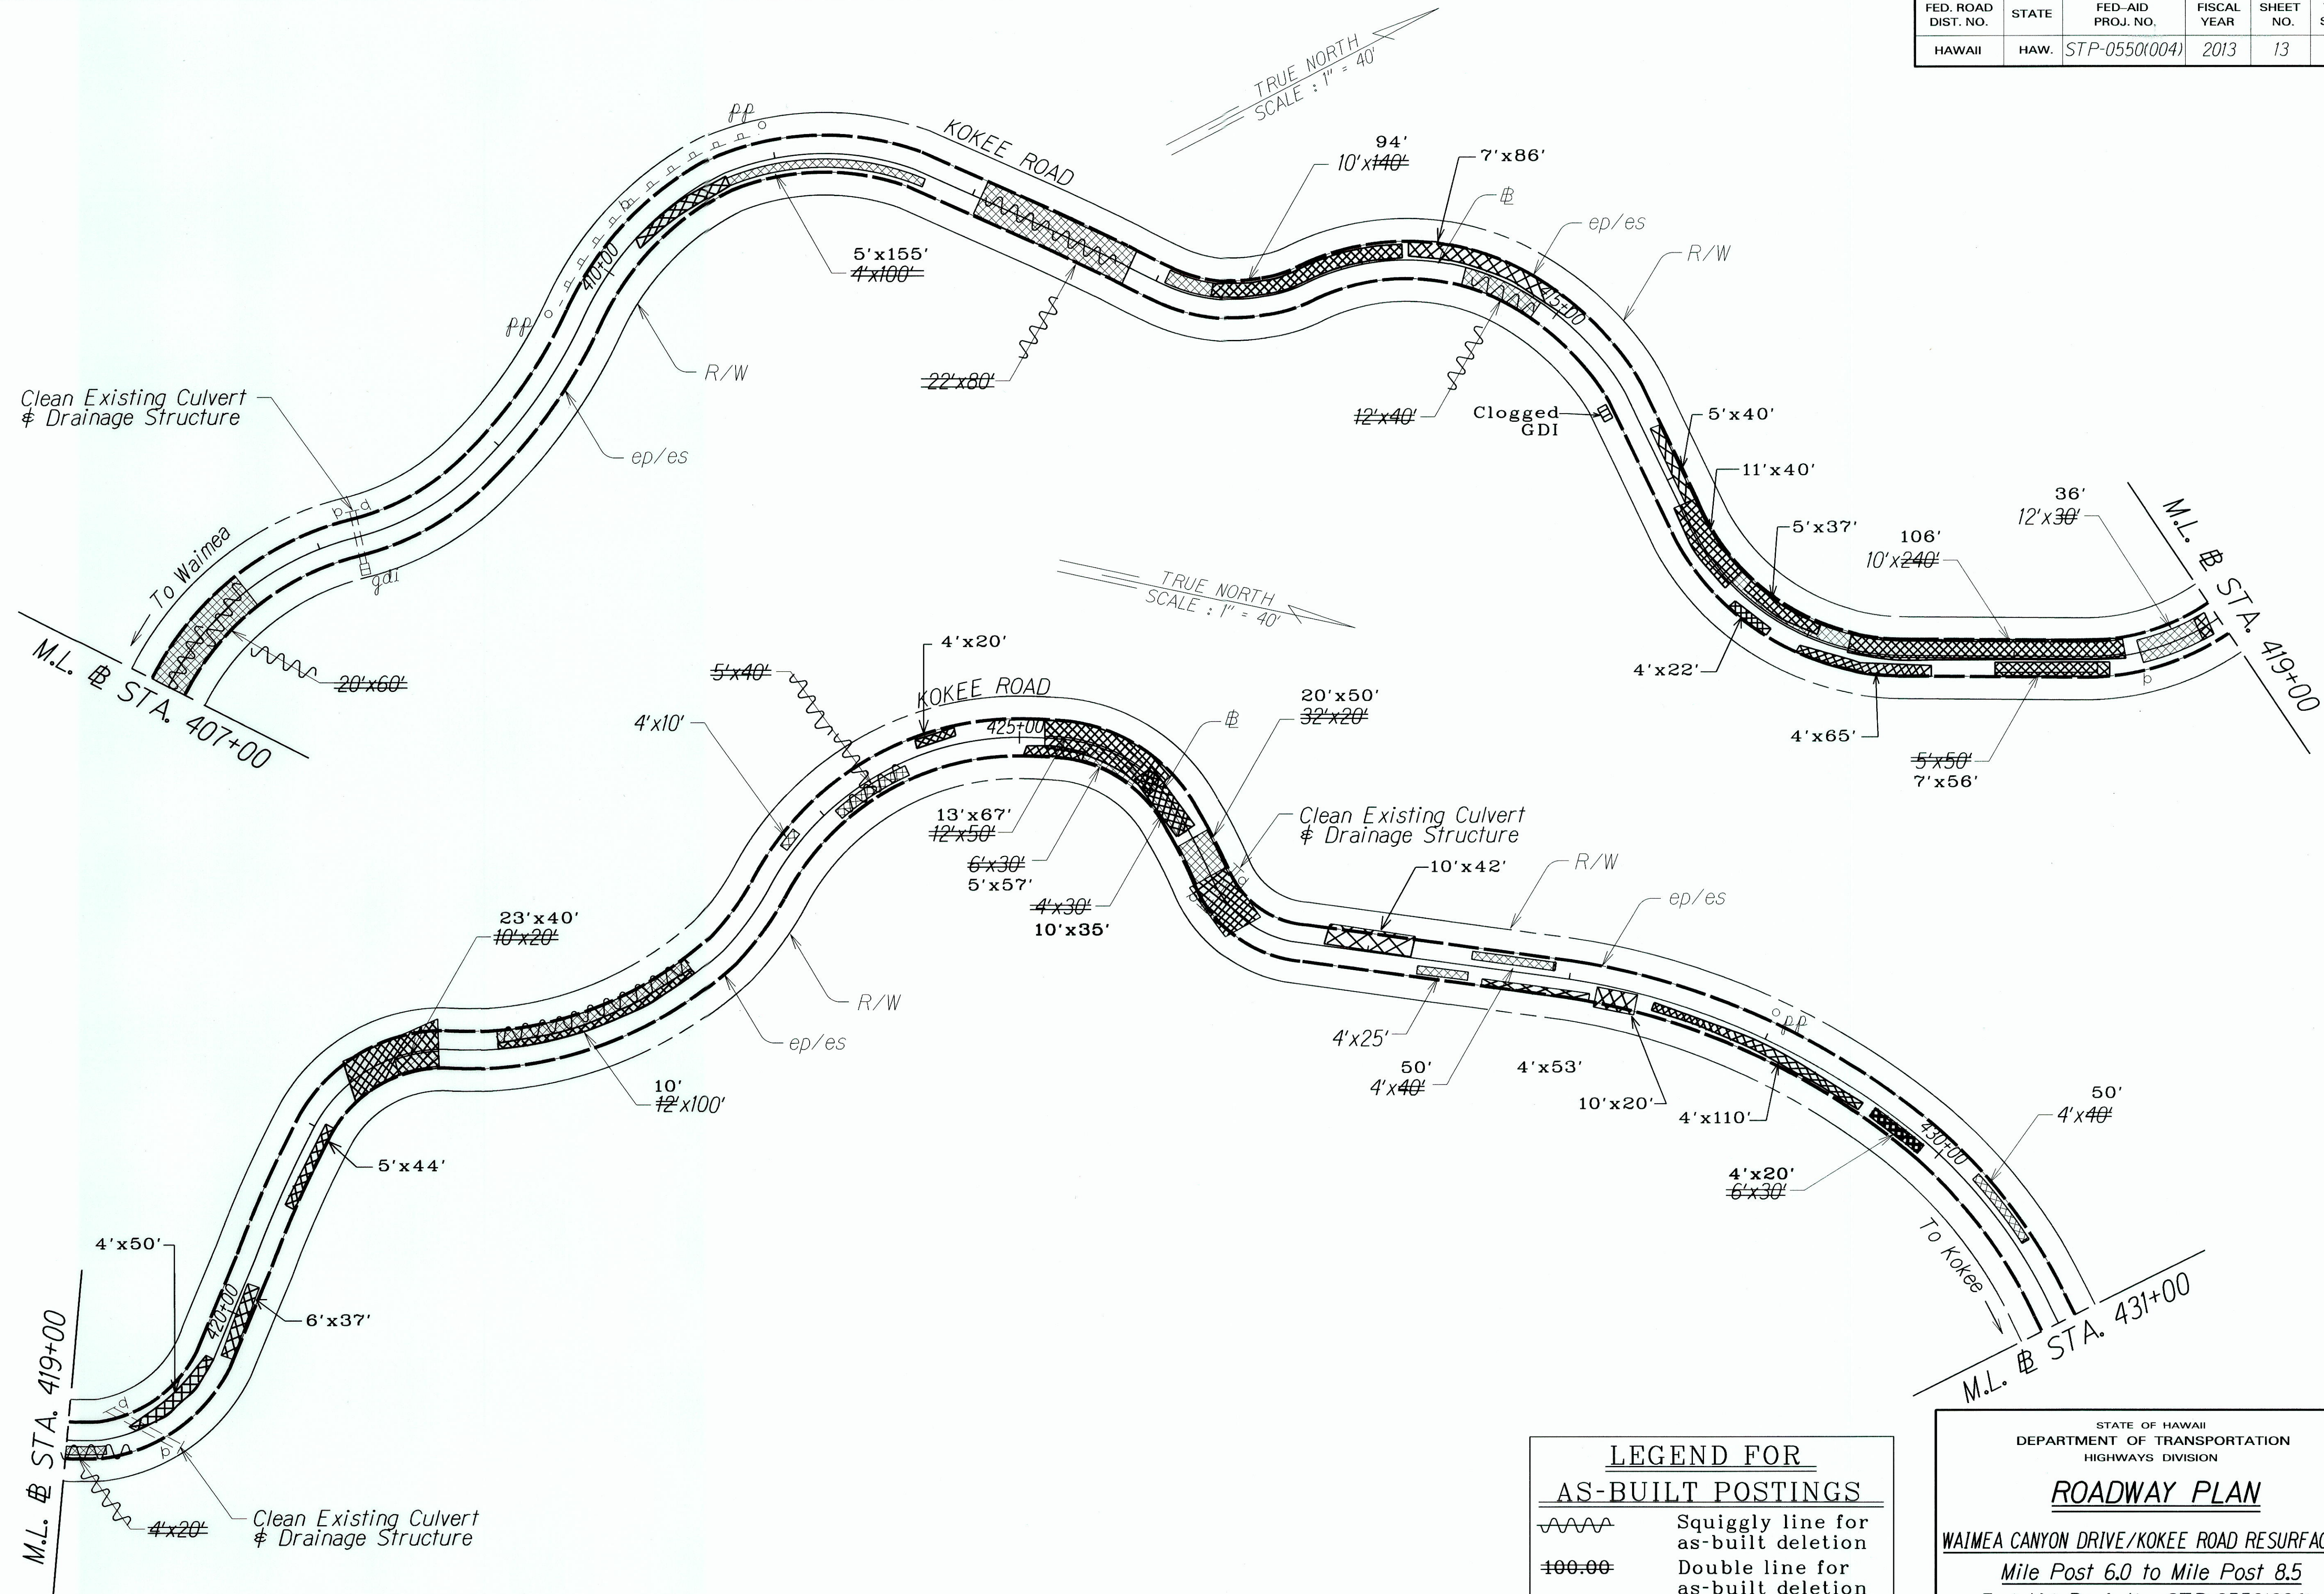

ORIGINAL PLAN	SURVEY PLOTTED BY	DATE
NOTED BOOK	DRAWN BY	
DESIGNED BY	CHECKED BY	
NO.		

LEGEND FOR AS-BUILT POSTINGS	
	Squiggly line for as-built deletion
	Double line for as-built deletion
Roadway	Text for as-built posting

STATE OF HAWAII
DEPARTMENT OF TRANSPORTATION
HIGHWAYS DIVISION

ROADWAY PLAN


WAIMEA CANYON DRIVE/KOKEE ROAD RESURFACING
Mile Post 6.0 to Mile Post 8.5
Fed-Aid Proj. No. STP-0550(004)

Scale: 1" = 40' Date: Dec. 2012

SHEET No. 6 OF 7 SHEETS

"AS-BUILT"

FED. ROAD DIST. NO.	STATE	FED-AID PROJ. NO.	FISCAL YEAR	SHEET NO.	TOTAL SHEETS
HAWAII	HAW.	STP-0550(004)	2013	14	24

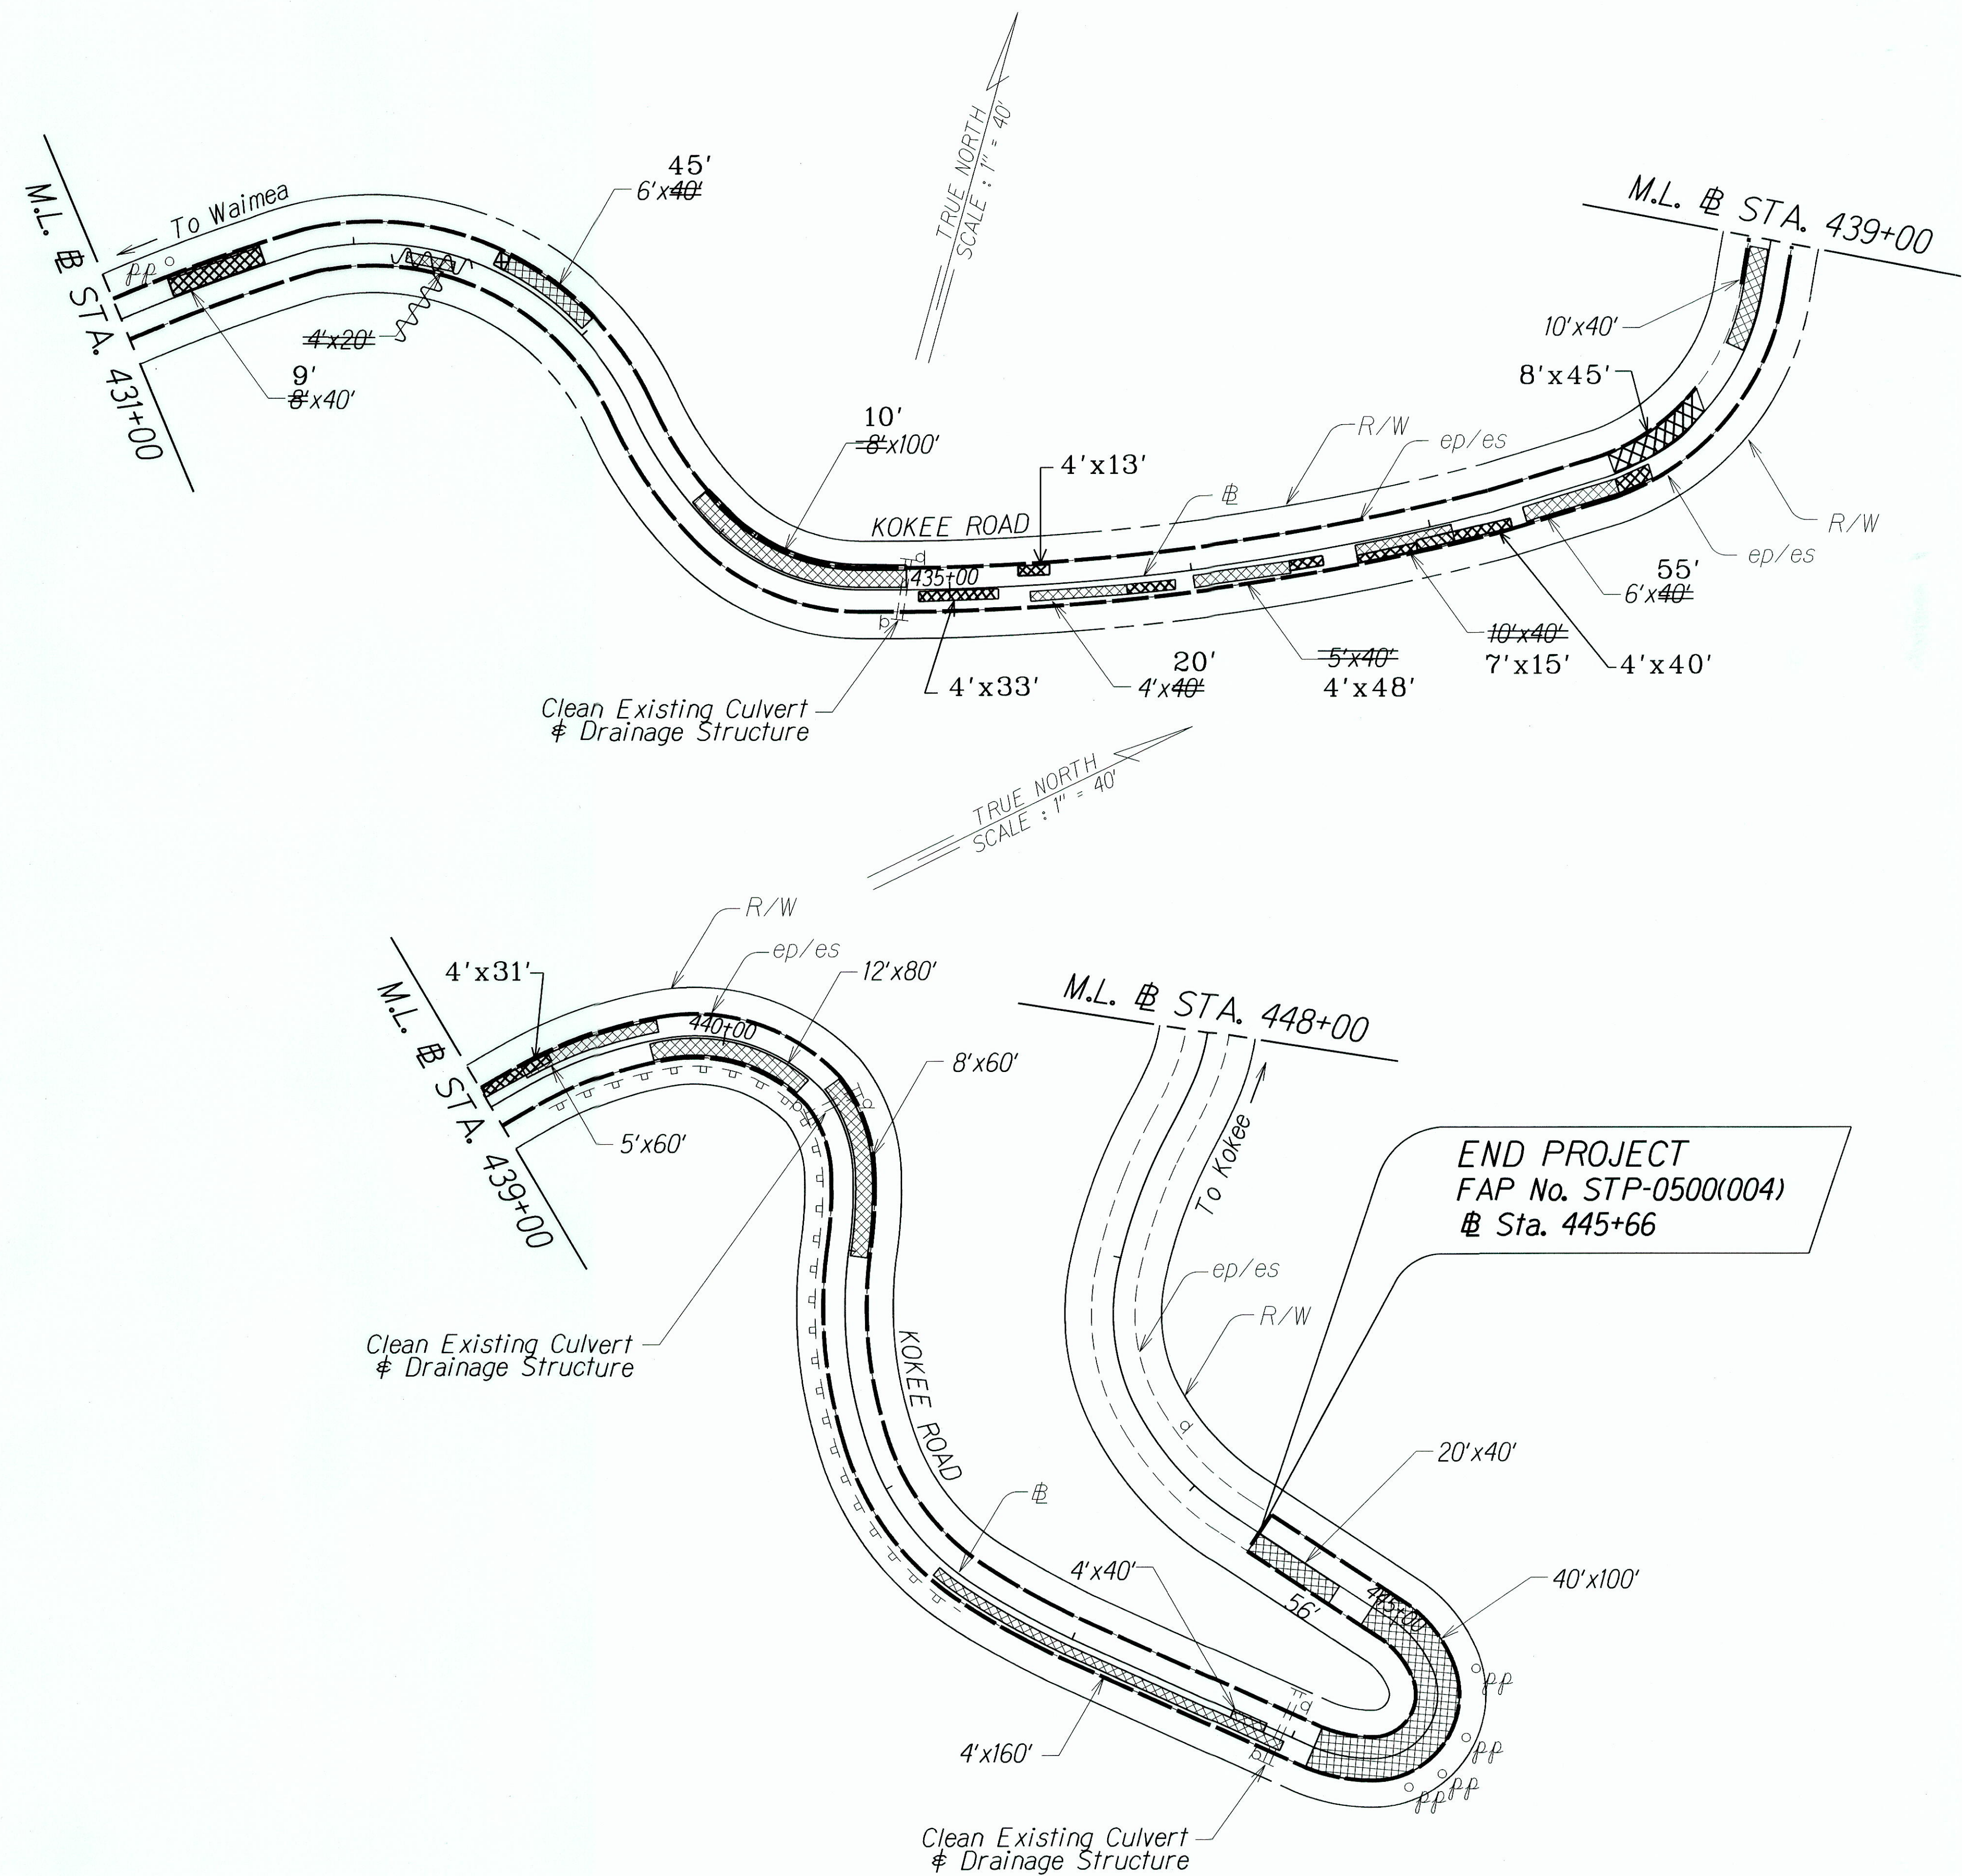

ORIGINAL PLAN	DATE
DESIGNED BY	
CHECKED BY	
NOTED BY	
DATE	

"AS-BUILT"