

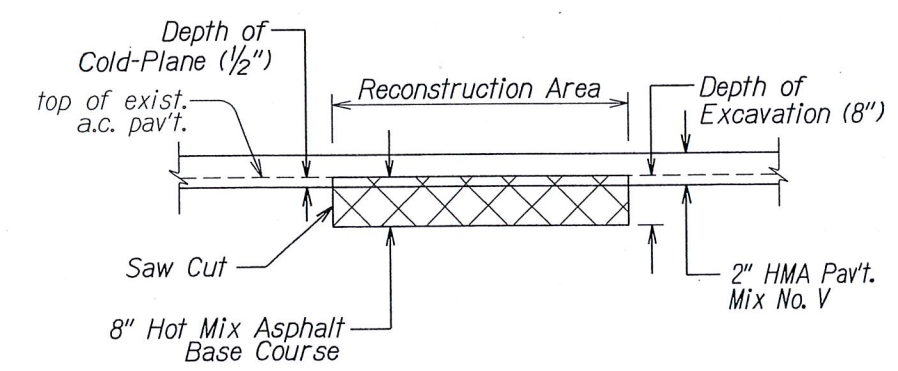
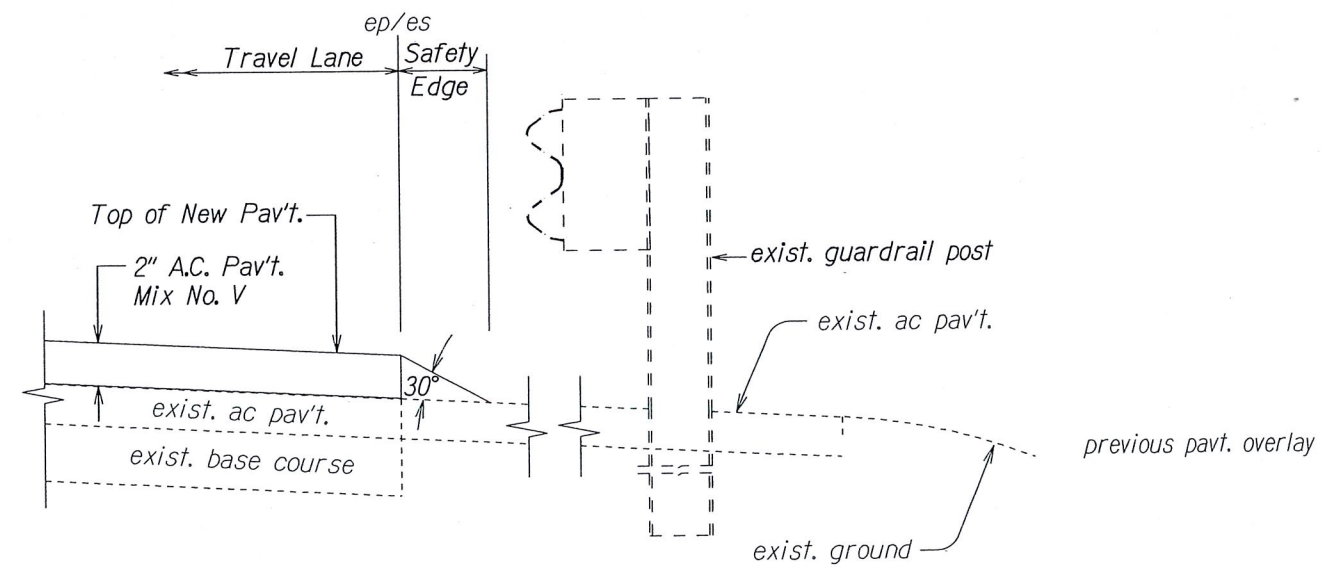
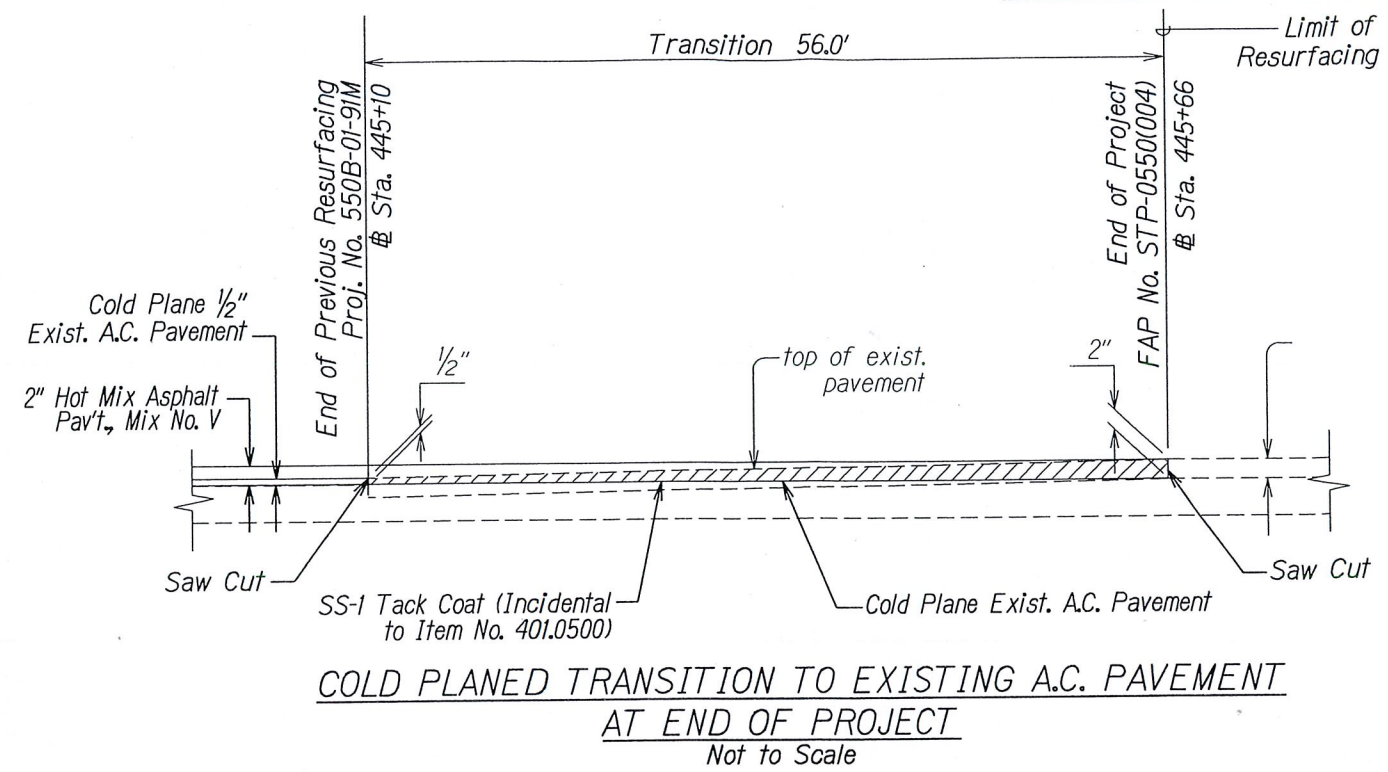



FED. ROAD DIST. NO.	STATE	FED-AID PROJ. NO.	FISCAL YEAR	SHEET NO.	TOTAL SHEETS
HAWAII	HAW.	STP-0550(004)	2013	ADD.7	24

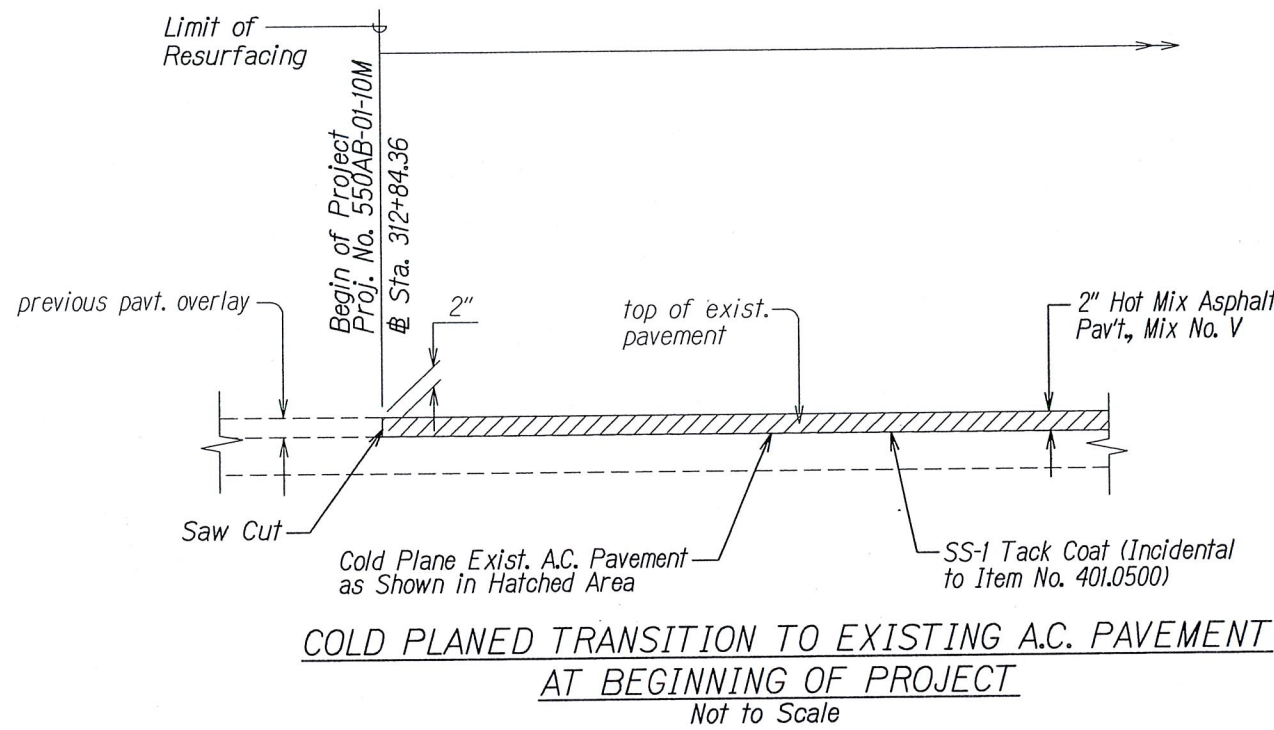

Note: Reconstruct weakened pavement areas prior to cold planing.

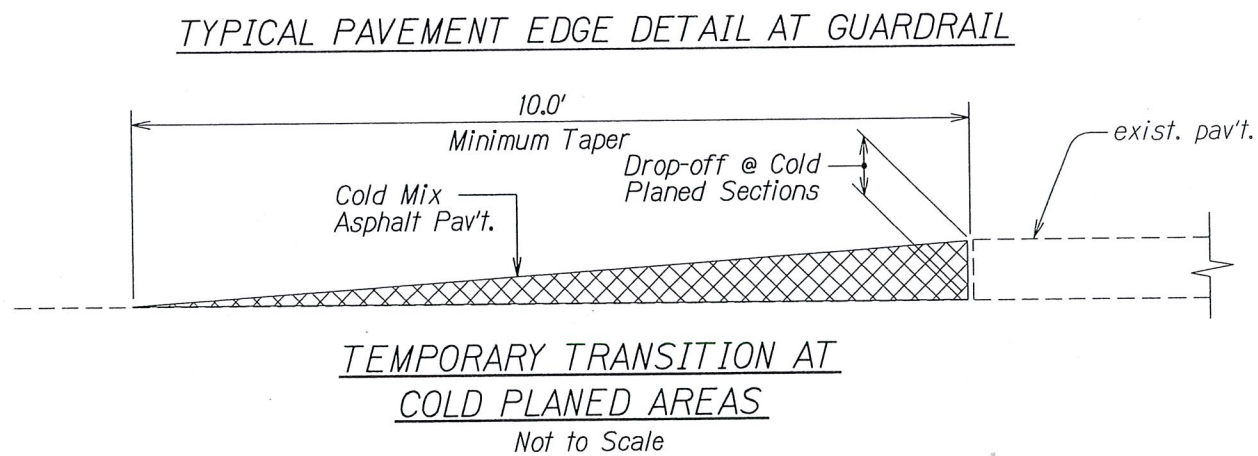

Note: Contractor shall construct temporary pavement taper to prevent sharp pavement drop-offs at all cold planed sections. Prior to final Asphalt Pavement placement, temporary pavement taper shall be removed.

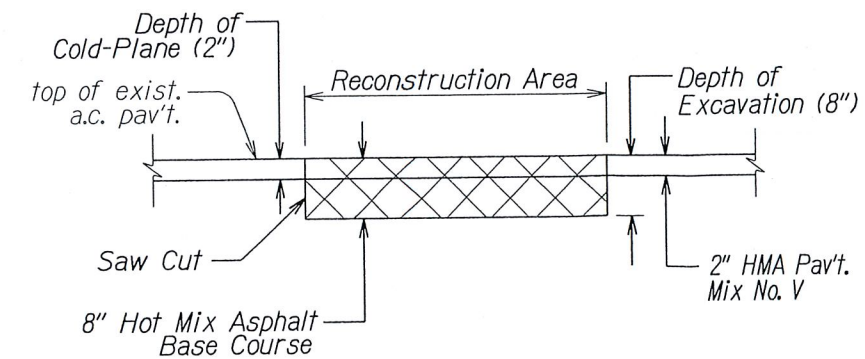

Note: Reconstruct weakened pavement areas prior to cold planing.

4/30/13	△ -A.C. Pavement Reconstruction Detail
DATE	REVISION
STATE OF HAWAII DEPARTMENT OF TRANSPORTATION HIGHWAYS DIVISION	
TYPICAL SECTIONS	
WAIMEA CANYON DRIVE/KOKEE ROAD RESURFACING	
Mile Post 6.0 to Mile Post 8.5	
Fed-Aid Proj. No. STP-0550(004)	
Not to Scale	Date: April 2013
SHEET No. 2 OF 2 SHEETS	