


DIST. NO.	STATE	FED. AID PROJ. NO.	FISCAL YEAR	SHEET NO.	TOTAL SHEETS
KAUAI	HAW.	STP-0550(006)	2024	ADD.204	325


SURVEY PLOTTED BY	DATE
DESIGNED BY	
TRACED BY	
QUANTITIES BY	
CHECKED BY	

ORIGINAL PLAN	NOTE BOOK
No.	

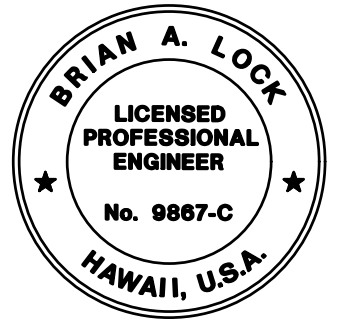


THIS WORK WAS PREPARED BY ME OR UNDER MY SUPERVISION.
[Signature]
WILSON OKAMOTO CORPORATION
APRIL 30, 2026
LIC. EXP. DATE

STATE OF HAWAII
DEPARTMENT OF TRANSPORTATION
HIGHWAYS DIVISION
ROADWAY CROSS SECTIONS
WAIMEA CANYON DRIVE /
KOEKE ROAD IMPROVEMENTS, PHASE 2B
MILE POST 4.6 TO MILE POST 11.5
Federal-Aid Project No. STP-0550(006)
Scale: 1" = 10' Date: July 2024

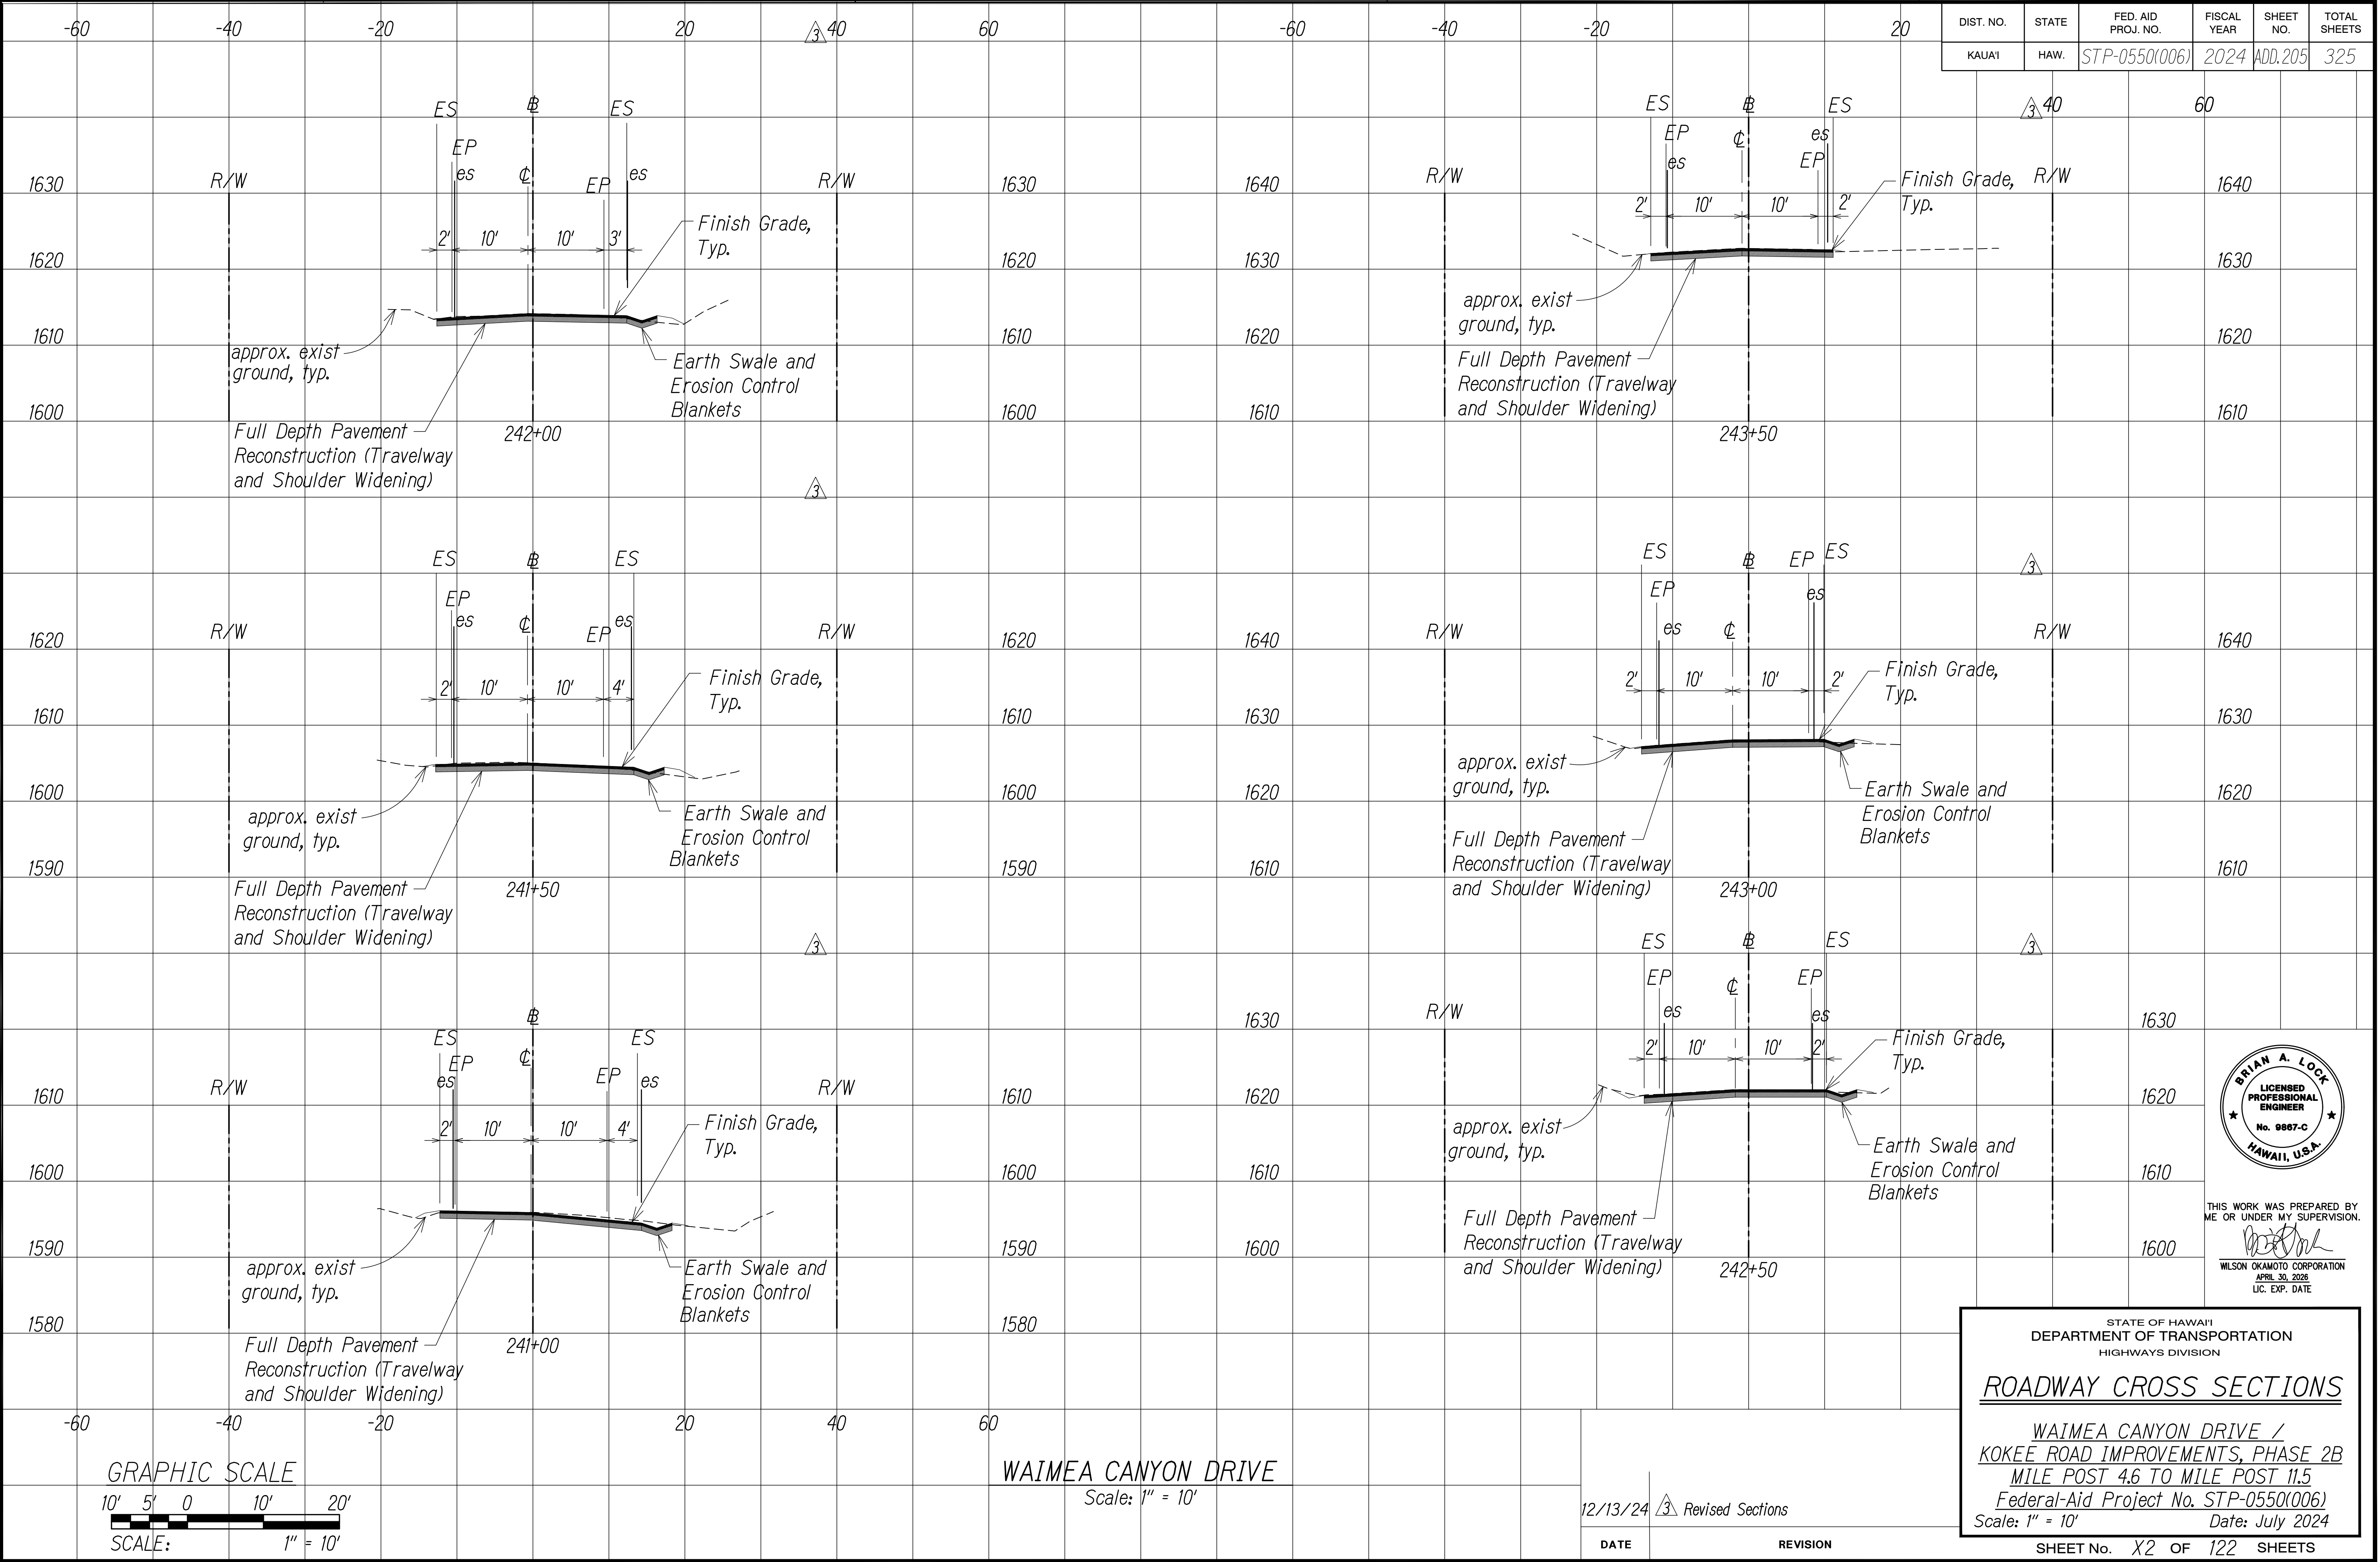

SURVEY PLOTTED BY	DATE
DESIGNED BY	
TRACED BY	
NOTED BY	
CHECKED BY	

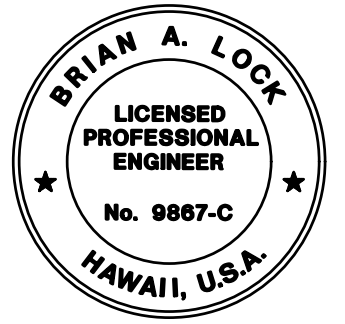

THIS WORK WAS PREPARED BY
ME OR UNDER MY SUPERVISION.
[Signature]
WILSON OKAMOTO CORPORATION
APRIL 30, 2026
LIC. EXP. DATE


STATE OF HAWAII
DEPARTMENT OF TRANSPORTATION
HIGHWAYS DIVISION
ROADWAY CROSS SECTIONS
WAIMEA CANYON DRIVE /
KOEKEE ROAD IMPROVEMENTS, PHASE 2B
MILE POST 4.6 TO MILE POST 11.5
Federal-Aid Project No. STP-0550(006)
Scale: 1" = 10' Date: July 2024

12/13/24 3 Revised Sections


DATE REVISION

SHEET No. X2 OF 122 SHEETS

DIST. NO.	STATE	FED. AID PROJ. NO.	FISCAL YEAR	SHEET NO.	TOTAL SHEETS
KAUA'I	HAW.	STP-0550(006)	2024	ADD.206	325

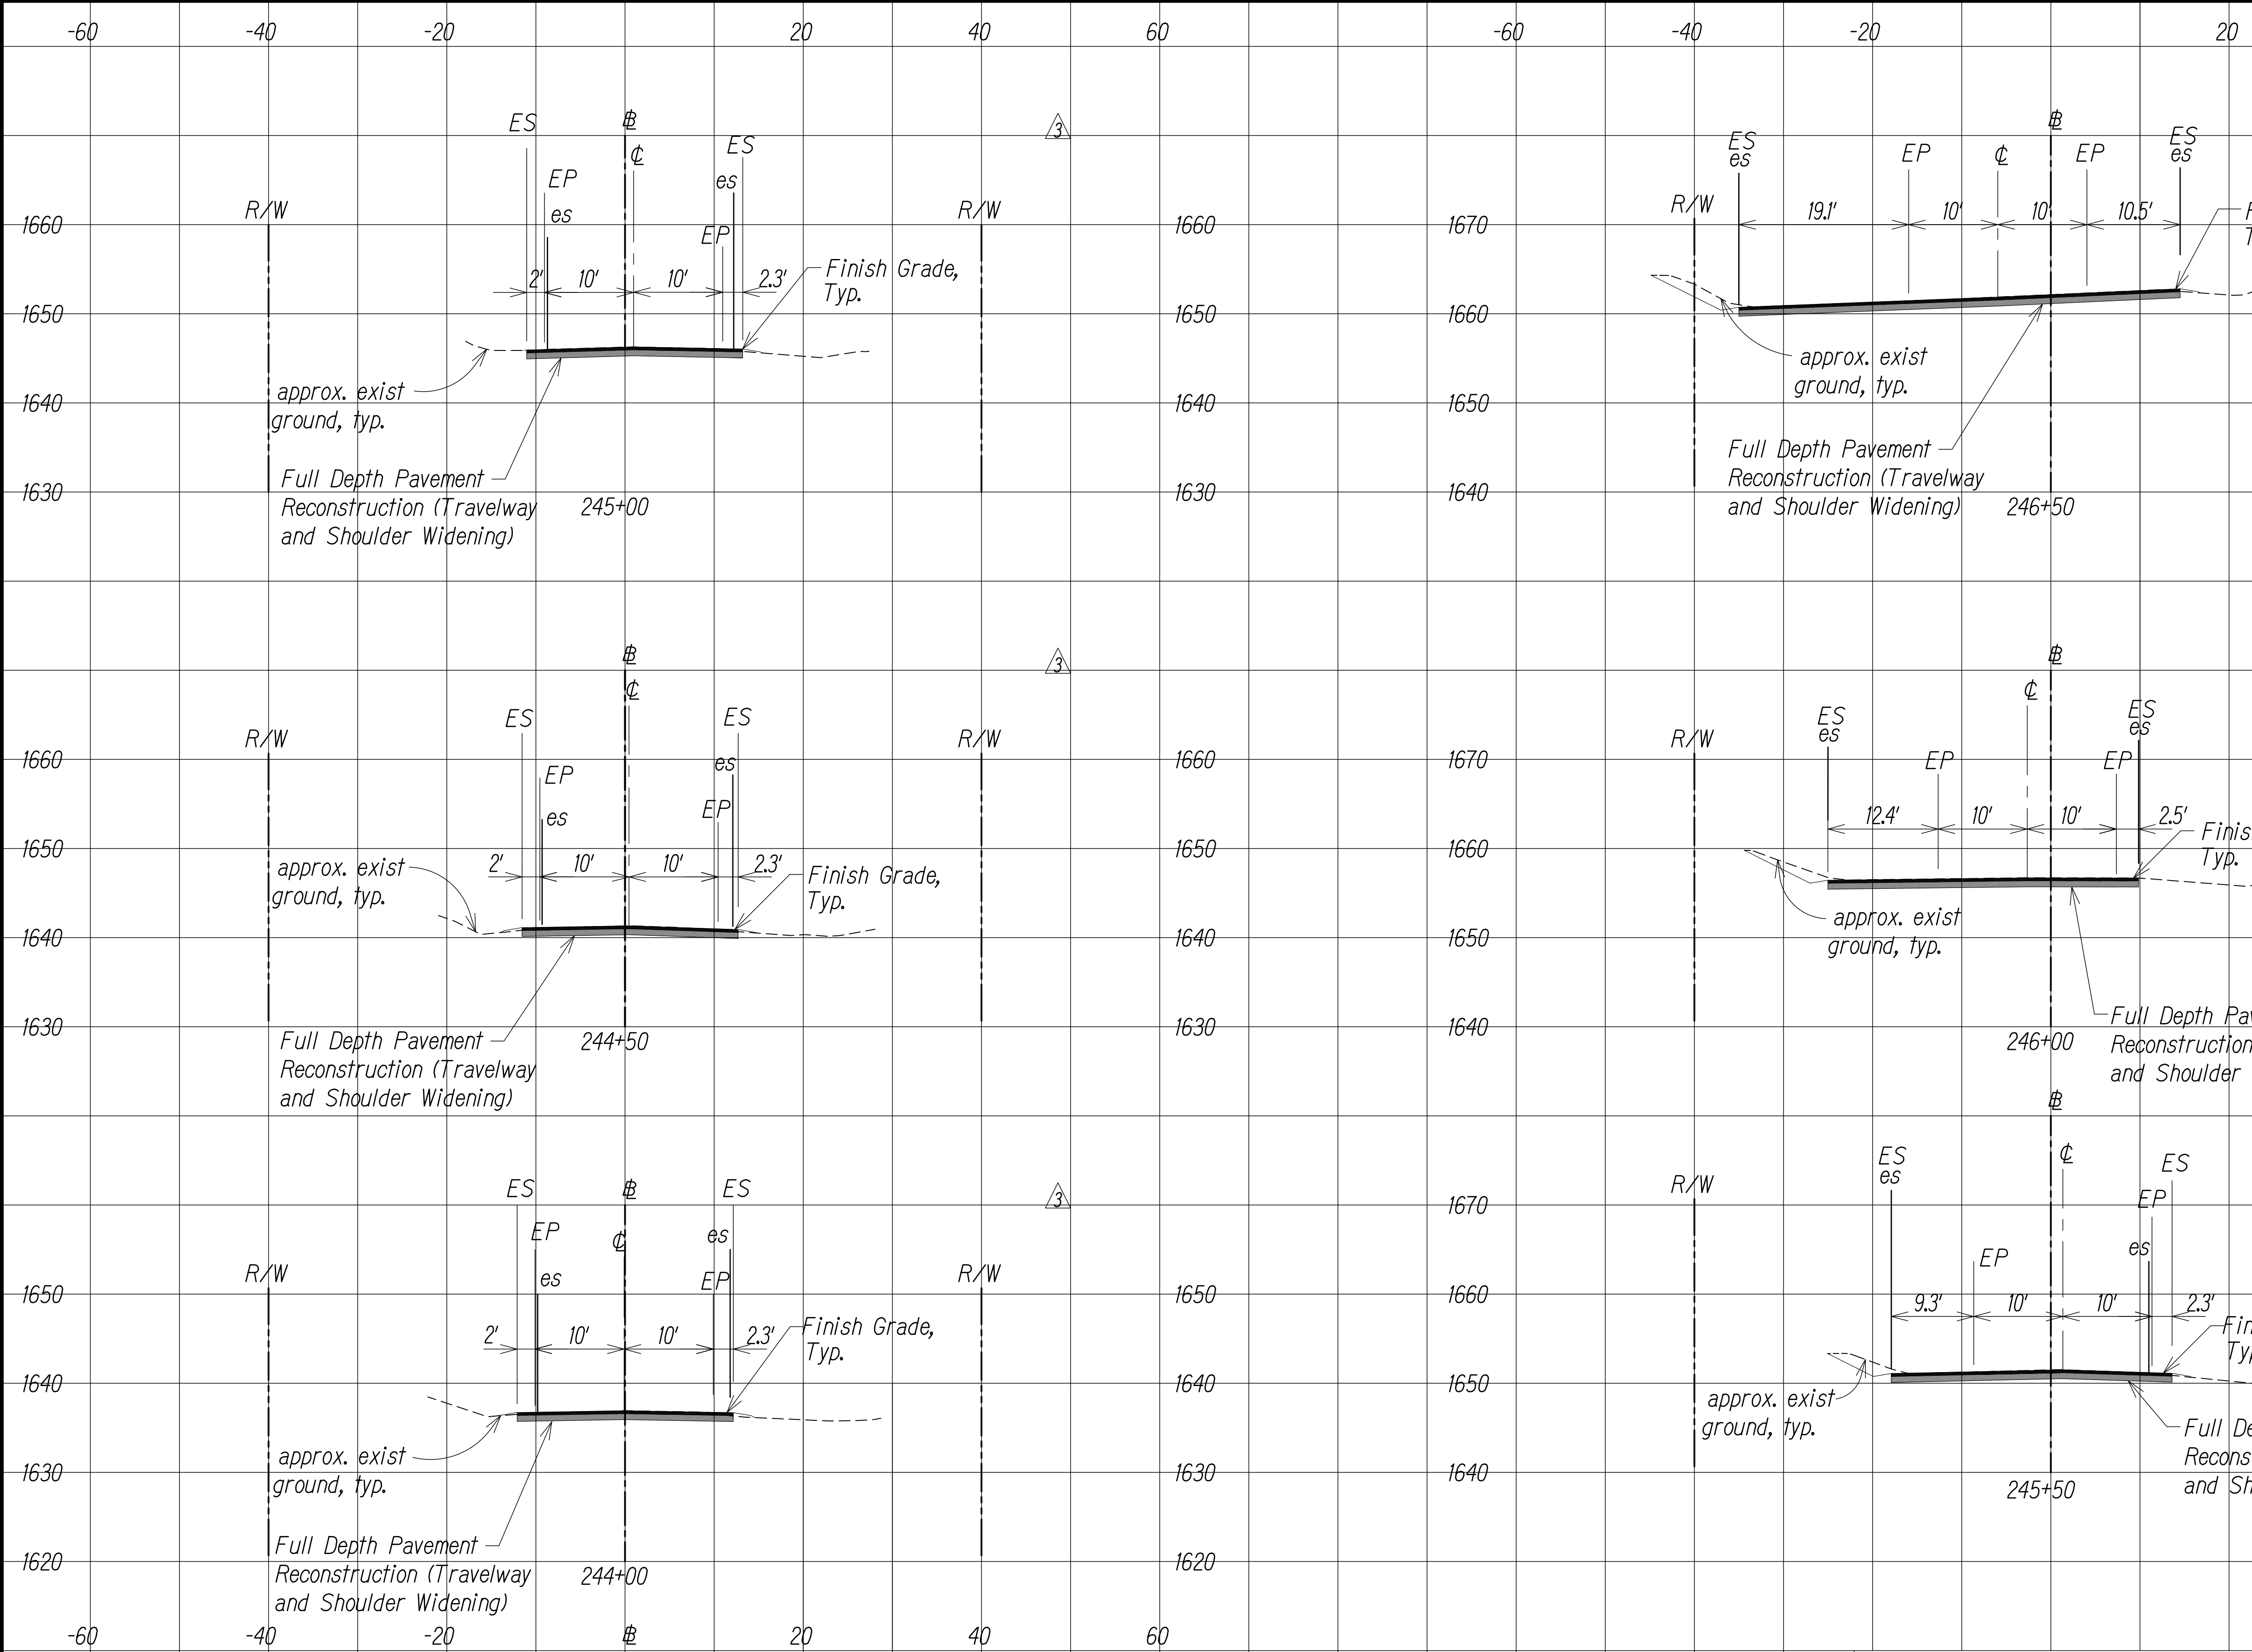


SURVEY PLOTTED BY	DATE
DESIGNED BY	
TRACED BY	
QUANTITIES BY	
CHECKED BY	
NOTE BOOK	
No.	

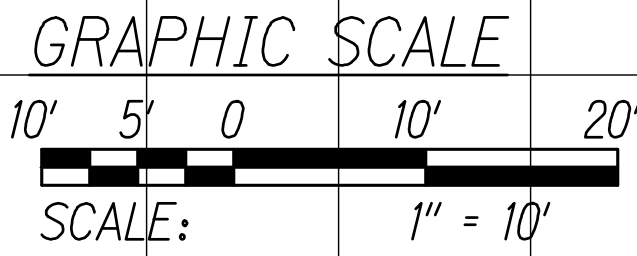

WAIMEA CANYON DRIVE
Scale: 1" = 10'

12/13/24 3 Revised Sections


DATE REVISION

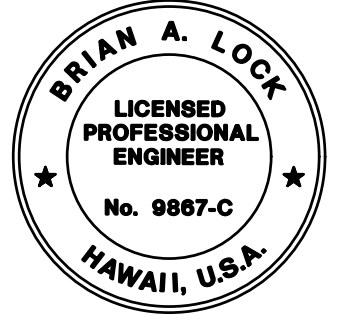

THIS WORK WAS PREPARED BY
ME OR UNDER MY SUPERVISION.
[Signature]
WILSON OKAMOTO CORPORATION
APRIL 30, 2026
LIC. EXP. DATE


STATE OF HAWAII
DEPARTMENT OF TRANSPORTATION
HIGHWAYS DIVISION
ROADWAY CROSS SECTIONS
WAIMEA CANYON DRIVE /
KOEKE ROAD IMPROVEMENTS, PHASE 2B
MILE POST 4.6 TO MILE POST 11.5
Federal-Aid Project No. STP-0550(006)
Scale: 1" = 10' Date: July 2024

SHEET No. X3 OF 122 SHEETS

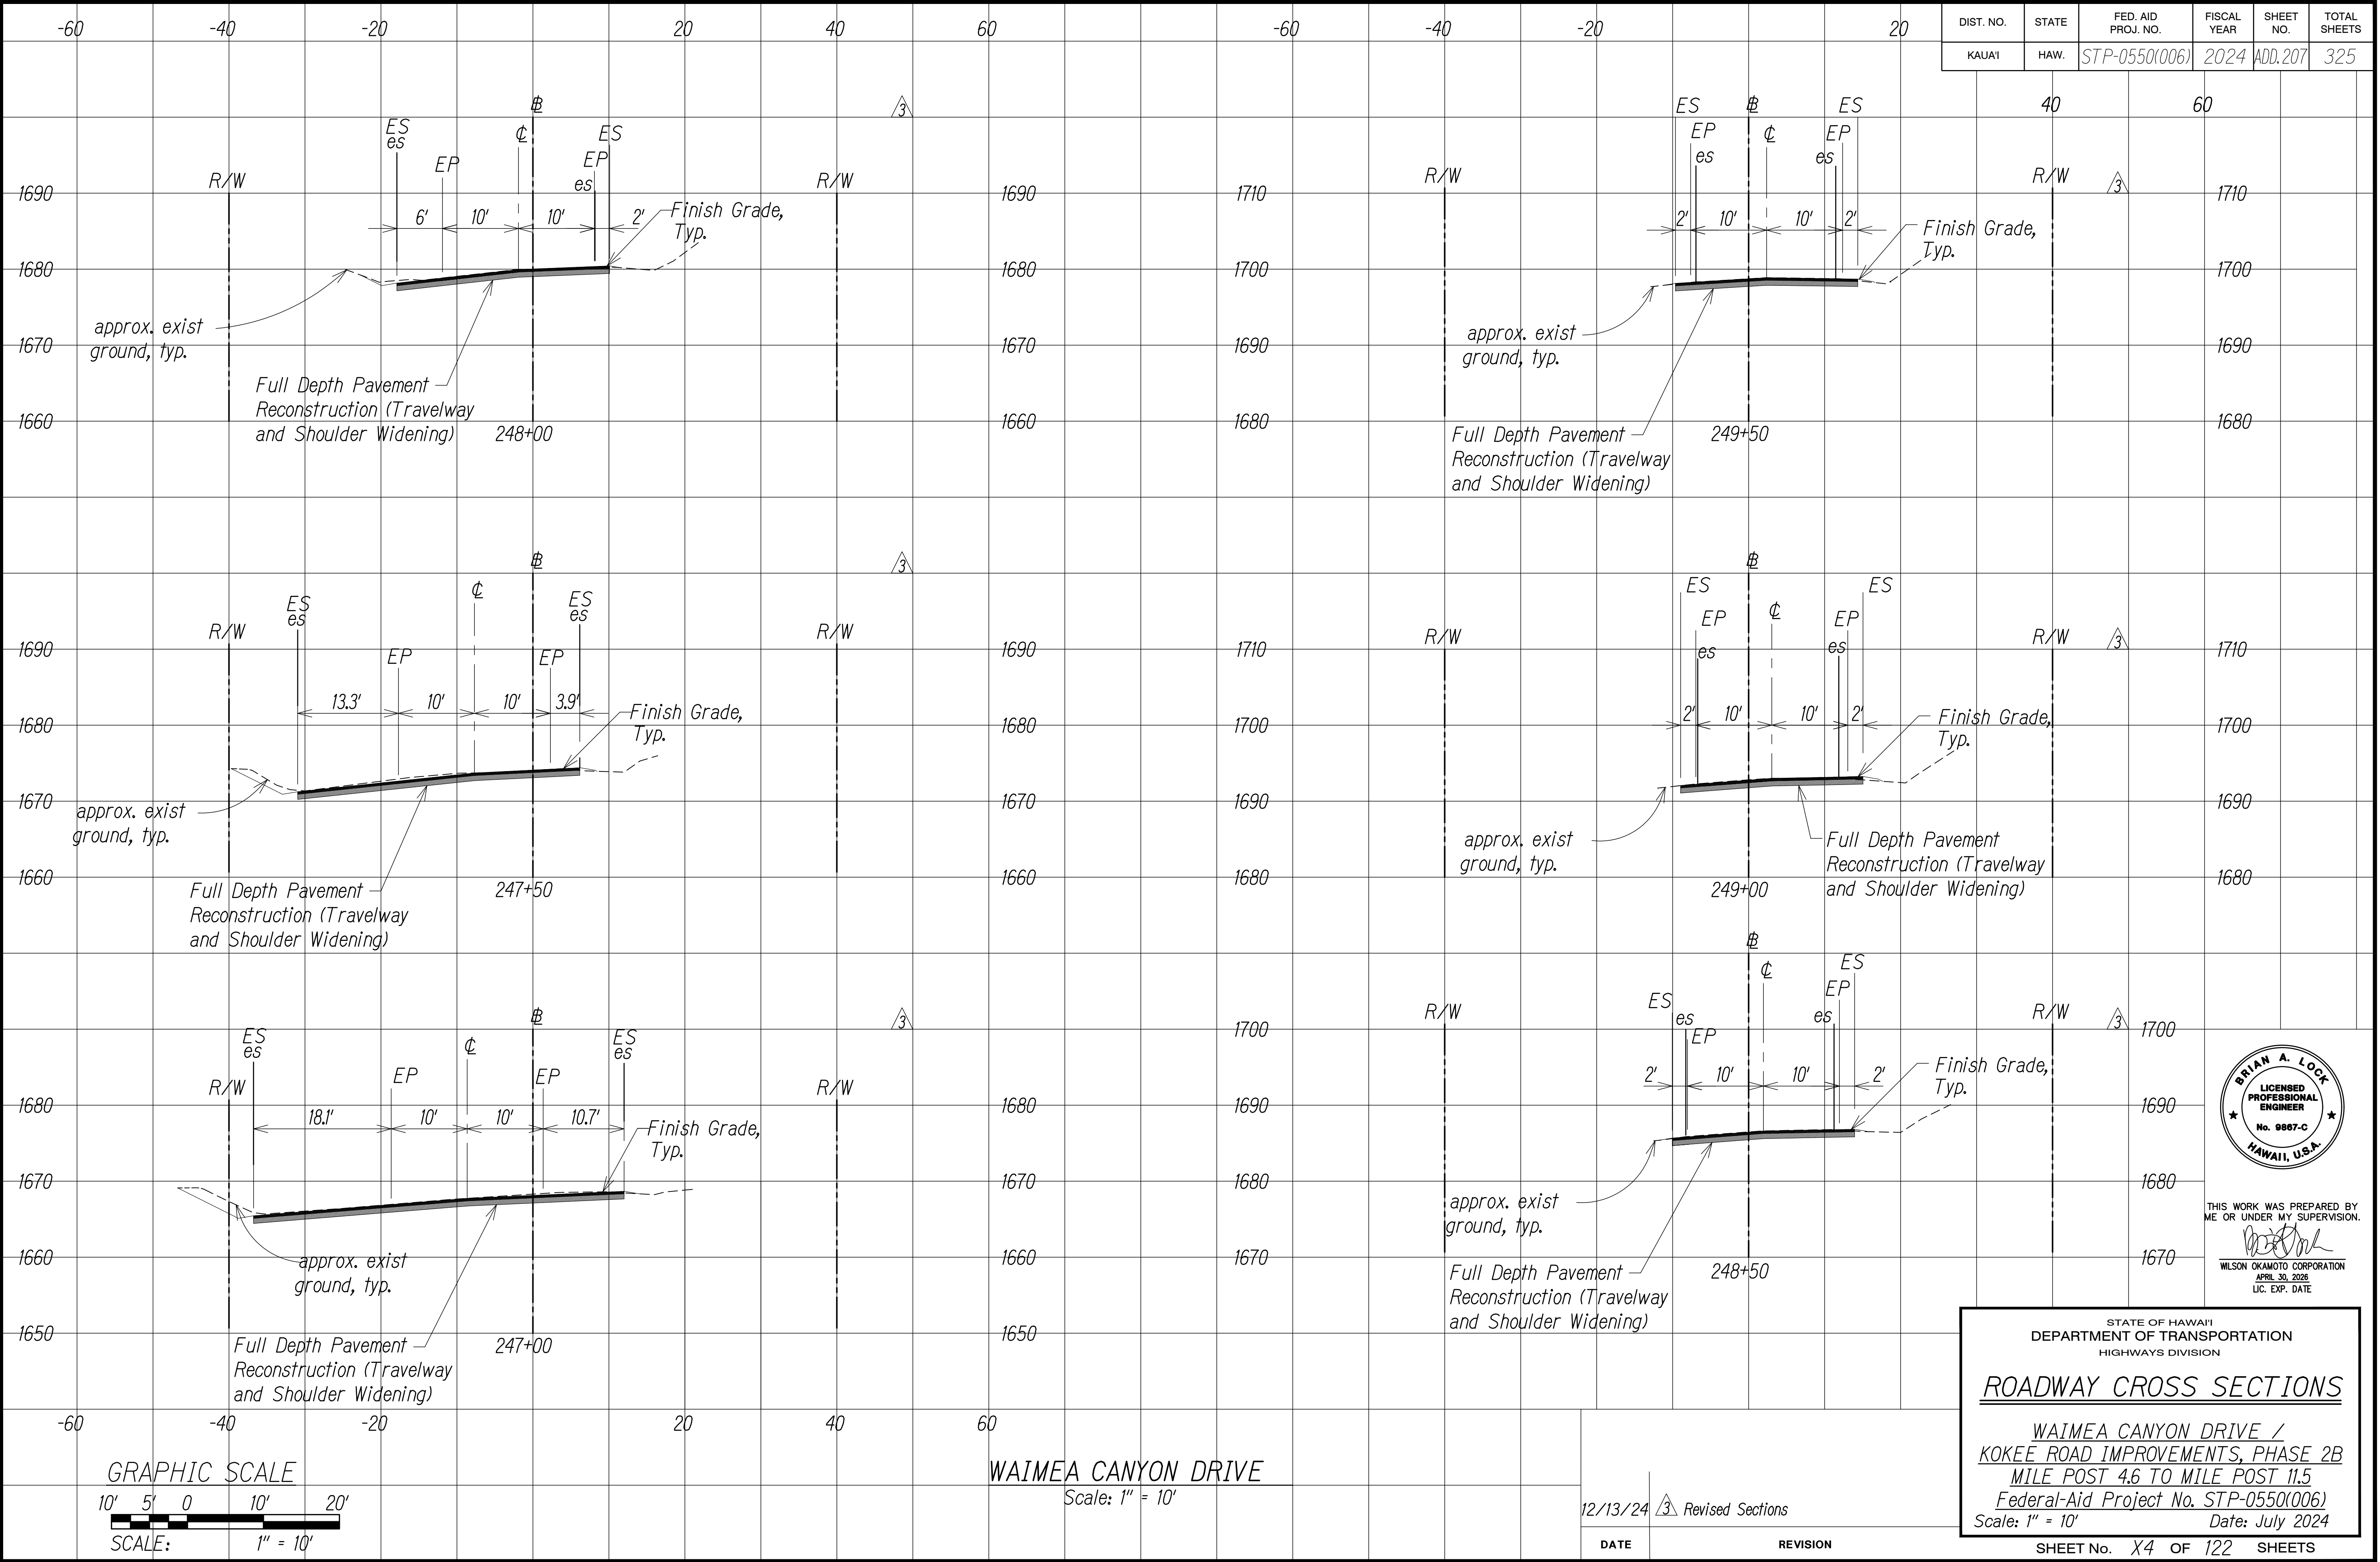


SURVEY PLOTTED BY	DATE
DESIGNED BY	
TRACED BY	
DESIGNED BY	
QUANTITIES BY	
CHECKED BY	

ORIGINAL PLAN	No.
NOTE BOOK	
CHECKED BY	

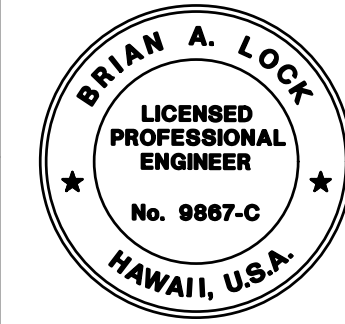


THIS WORK WAS PREPARED BY
ME OR UNDER MY SUPERVISION.
[Signature]
WILSON OKAMOTO CORPORATION
APRIL 30, 2026
LIC. EXP. DATE

STATE OF HAWAII
DEPARTMENT OF TRANSPORTATION
HIGHWAYS DIVISION
ROADWAY CROSS SECTIONS
WAIMEA CANYON DRIVE /
KOEKOE ROAD IMPROVEMENTS, PHASE 2B
MILE POST 4.6 TO MILE POST 11.5
Federal-Aid Project No. STP-0550(006)
Scale: 1" = 10' Date: July 2024

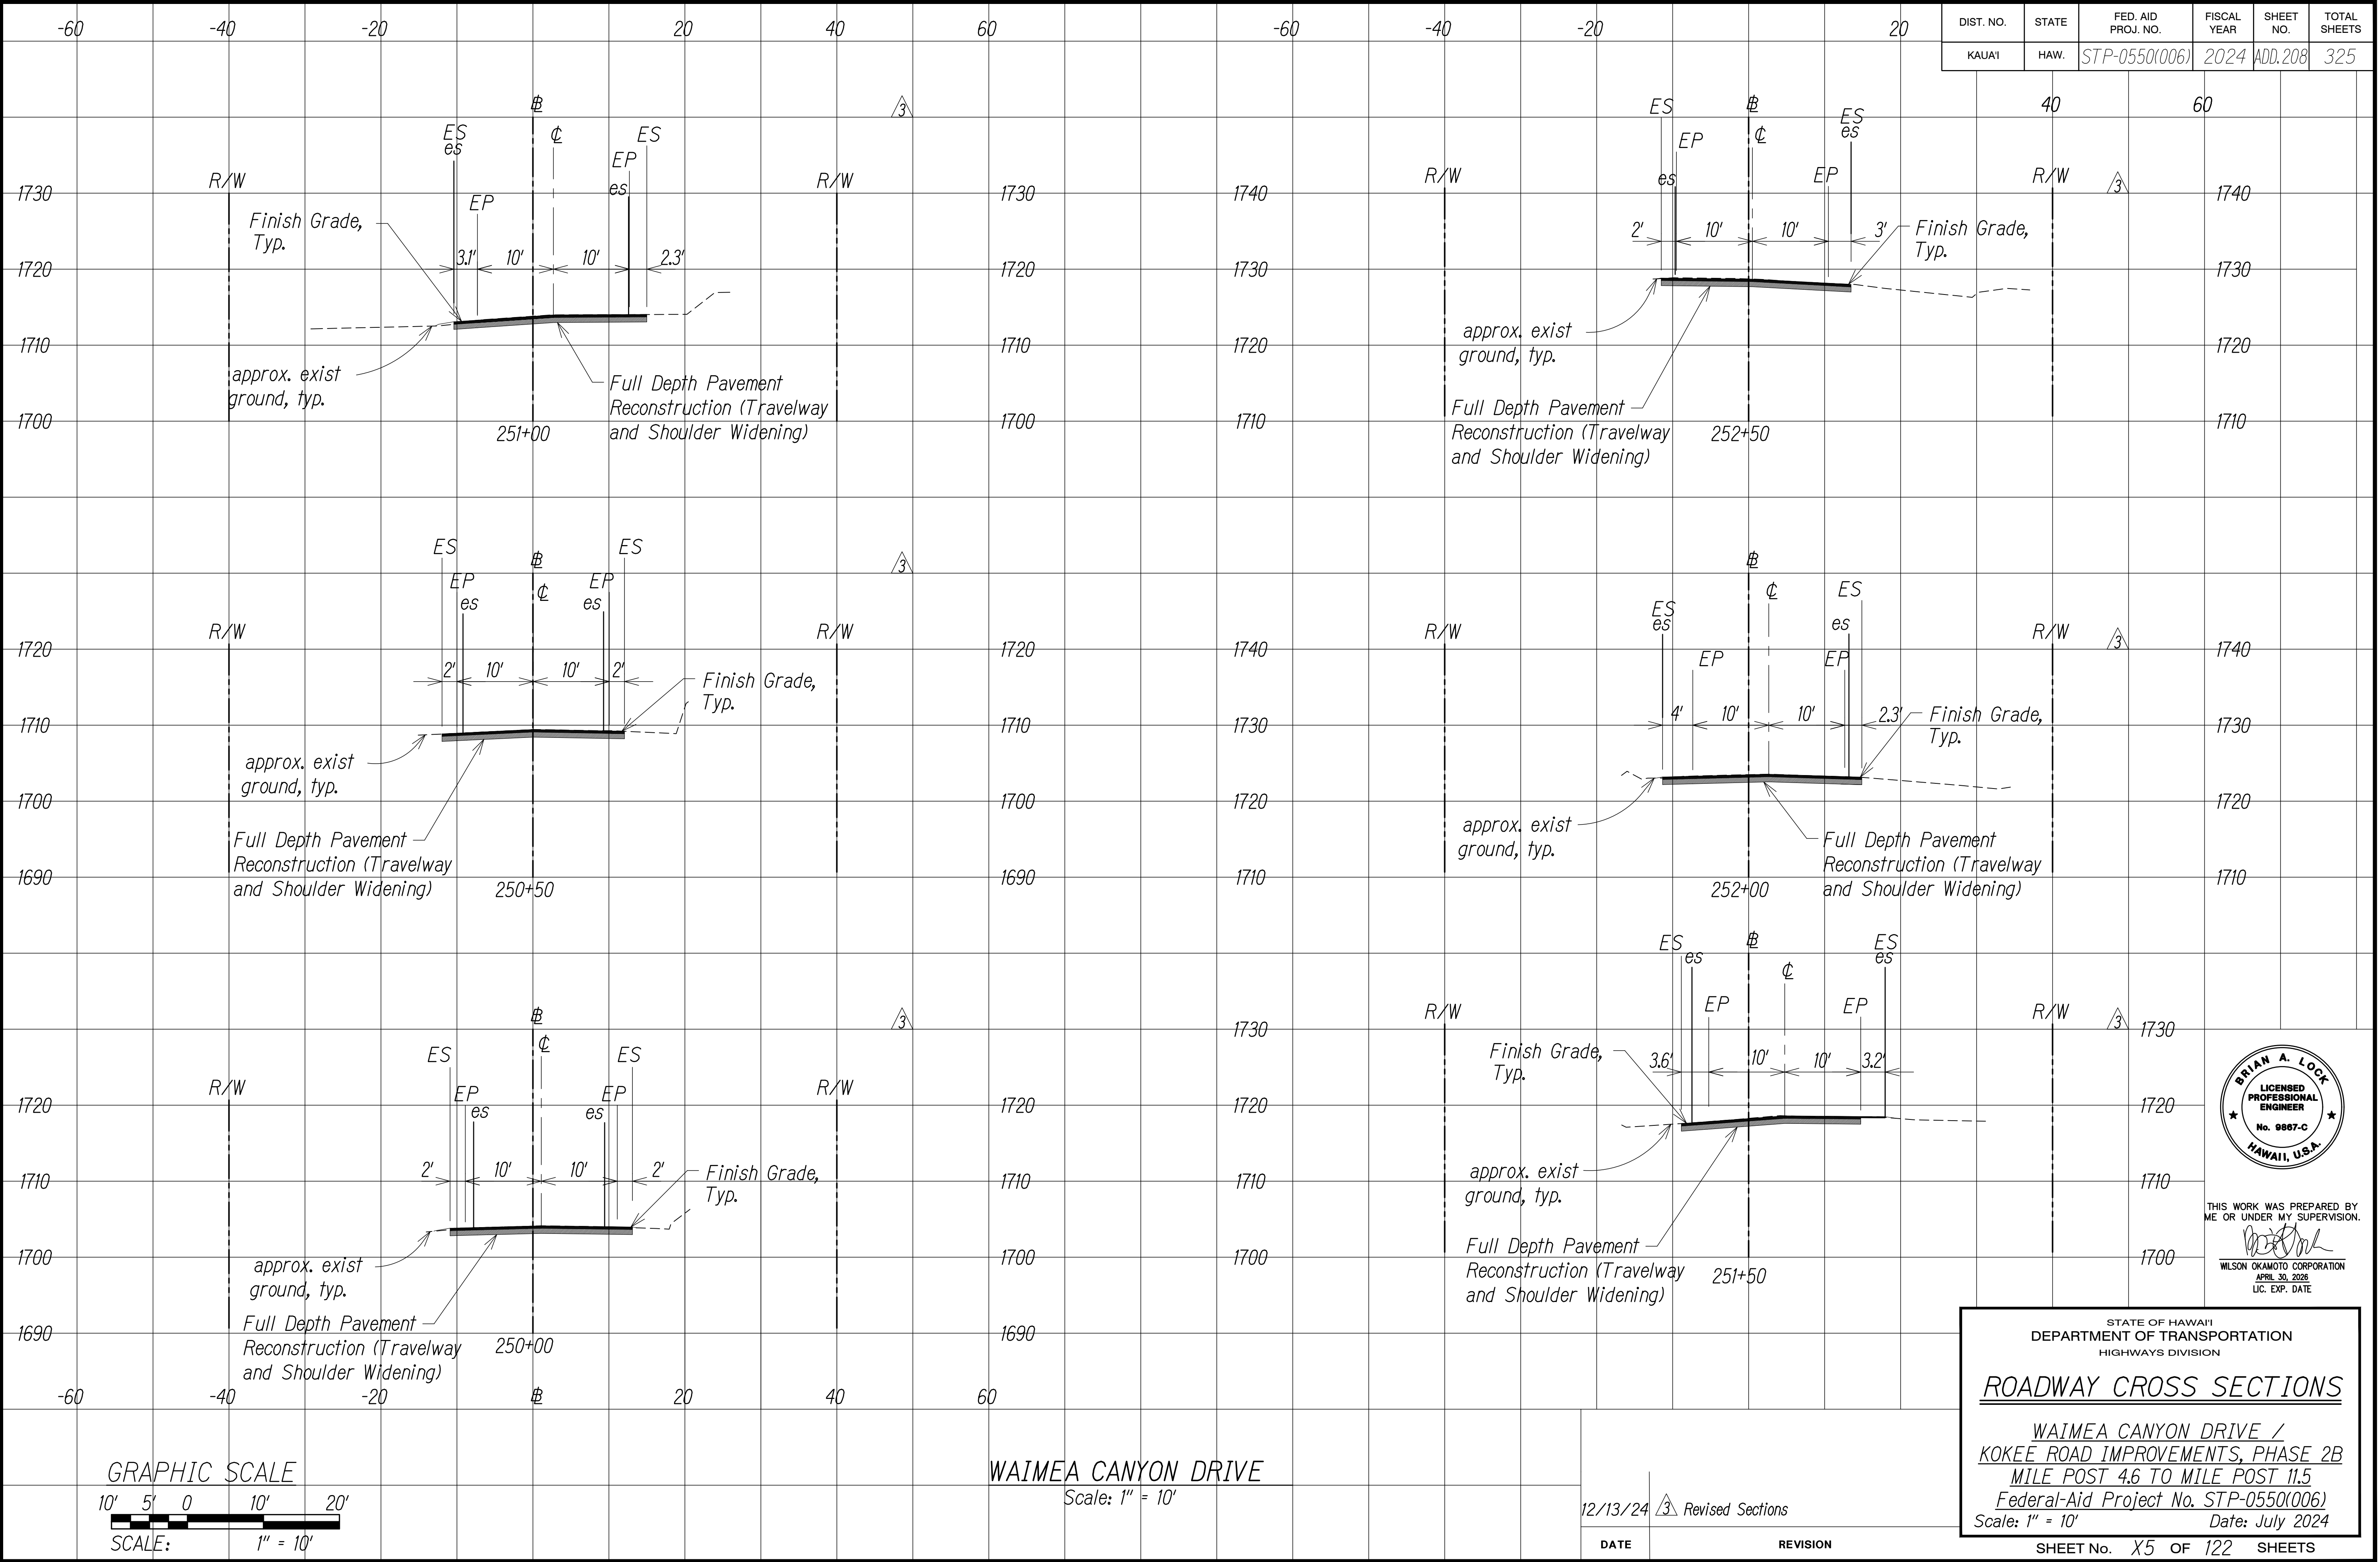

SURVEY PLOTTED BY	DATE
DESIGNED BY	
TRACED BY	
QUANTITIES BY	
CHECKED BY	
ORIGINAL PLAN	
NOTE BOOK	
No.	

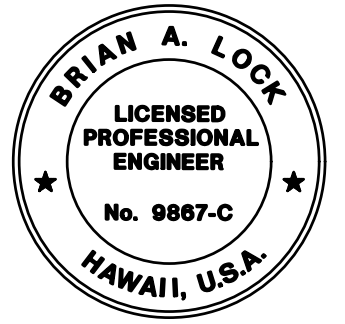


THIS WORK WAS PREPARED BY
ME OR UNDER MY SUPERVISION.
[Signature]
WILSON OKAMOTO CORPORATION
APRIL 30, 2026
LIC. EXP. DATE

STATE OF HAWAII
DEPARTMENT OF TRANSPORTATION
HIGHWAYS DIVISION
ROADWAY CROSS SECTIONS
WAIMEA CANYON DRIVE /
KOKEE ROAD IMPROVEMENTS, PHASE 2B
MILE POST 4.6 TO MILE POST 11.5
Federal-Aid Project No. STP-0550(006)
Scale: 1" = 10' Date: July 2024

12/13/24 3 Revised Sections


DATE REVISION

SHEET No. X5 OF 122 SHEETS

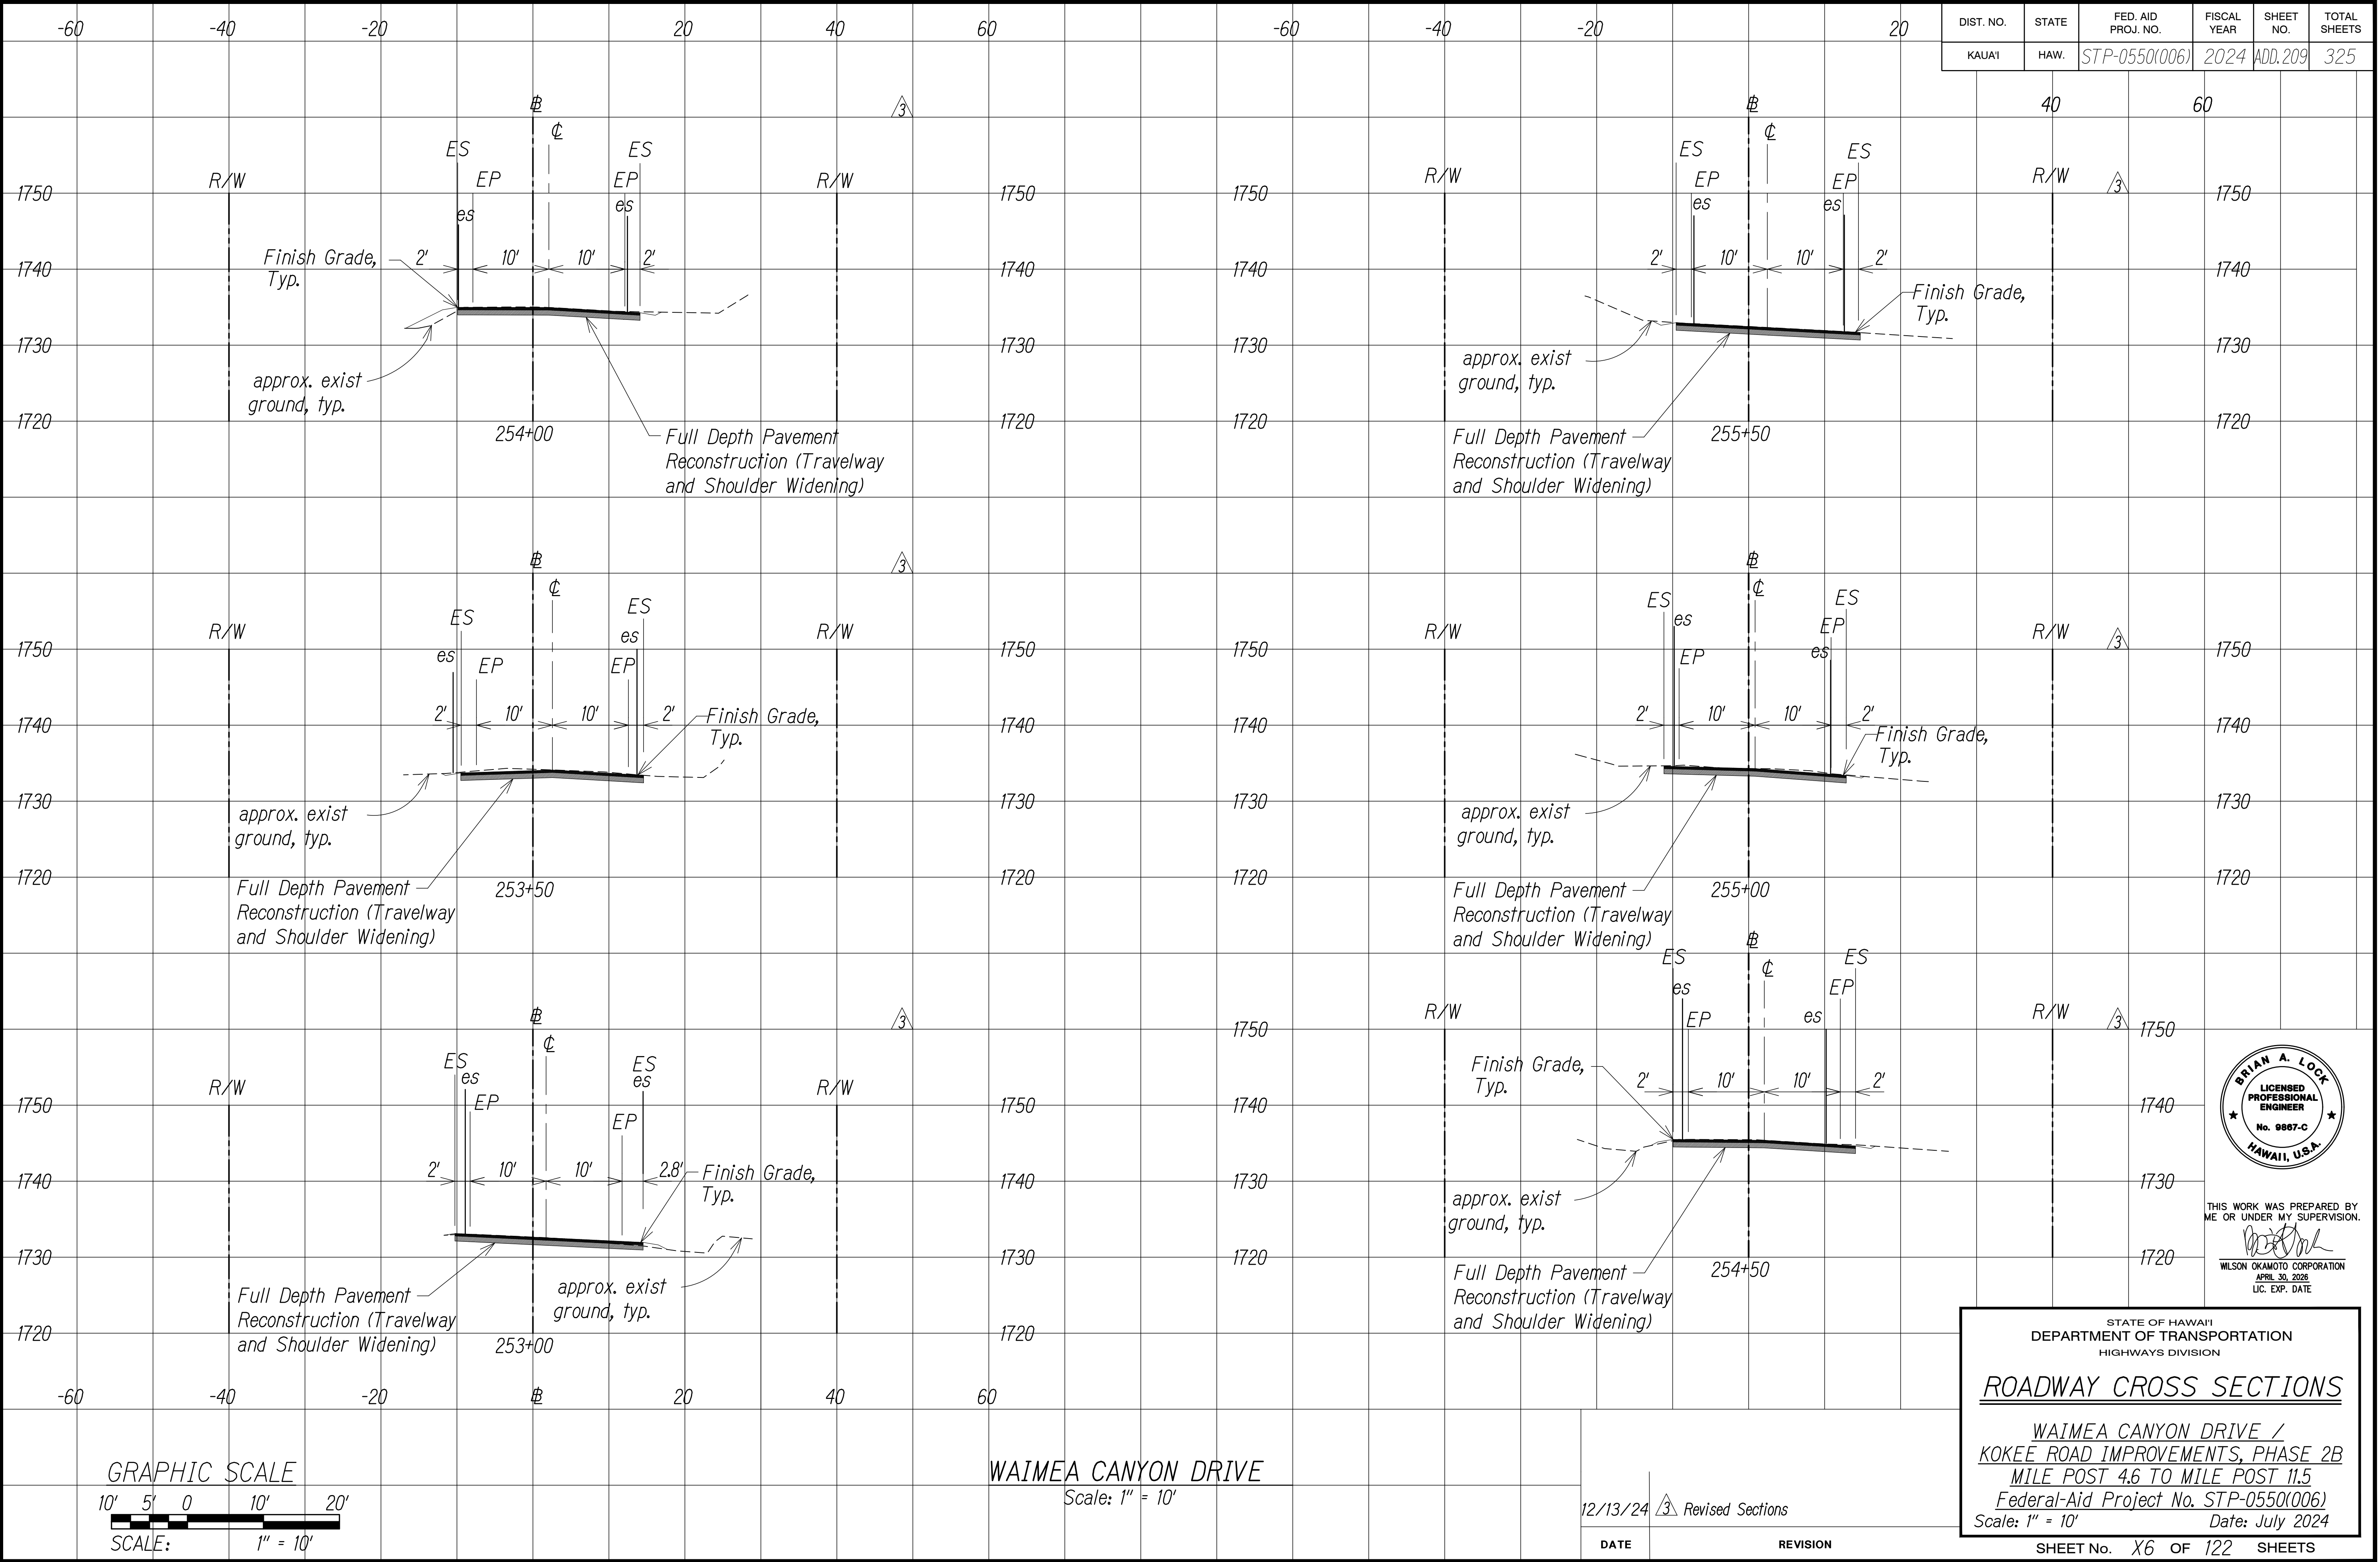

DIST. NO.	STATE	FED. AID PROJ. NO.	FISCAL YEAR	SHEET NO.	TOTAL SHEETS
KAUAI	HAW.	STP-0550(006)	2024	ADD.209	325

SURVEY PLOTTED BY	DATE
DESIGNED BY	
TRACED BY	
QUANTITIES BY	
CHECKED BY	
ORIGINAL PLAN	
NOTE BOOK	
No.	

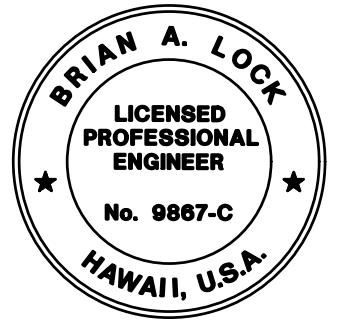


THIS WORK WAS PREPARED BY
ME OR UNDER MY SUPERVISION.
[Signature]
WILSON OKAMOTO CORPORATION
APRIL 30, 2026
LIC. EXP. DATE

STATE OF HAWAII
DEPARTMENT OF TRANSPORTATION
HIGHWAYS DIVISION
ROADWAY CROSS SECTIONS
WAIMEA CANYON DRIVE /
KOKEE ROAD IMPROVEMENTS, PHASE 2B
MILE POST 4.6 TO MILE POST 11.5
Federal-Aid Project No. STP-0550(006)
Scale: 1" = 10' Date: July 2024

12/13/24 3 Revised Sections


DATE REVISION

SHEET No. X6 OF 122 SHEETS

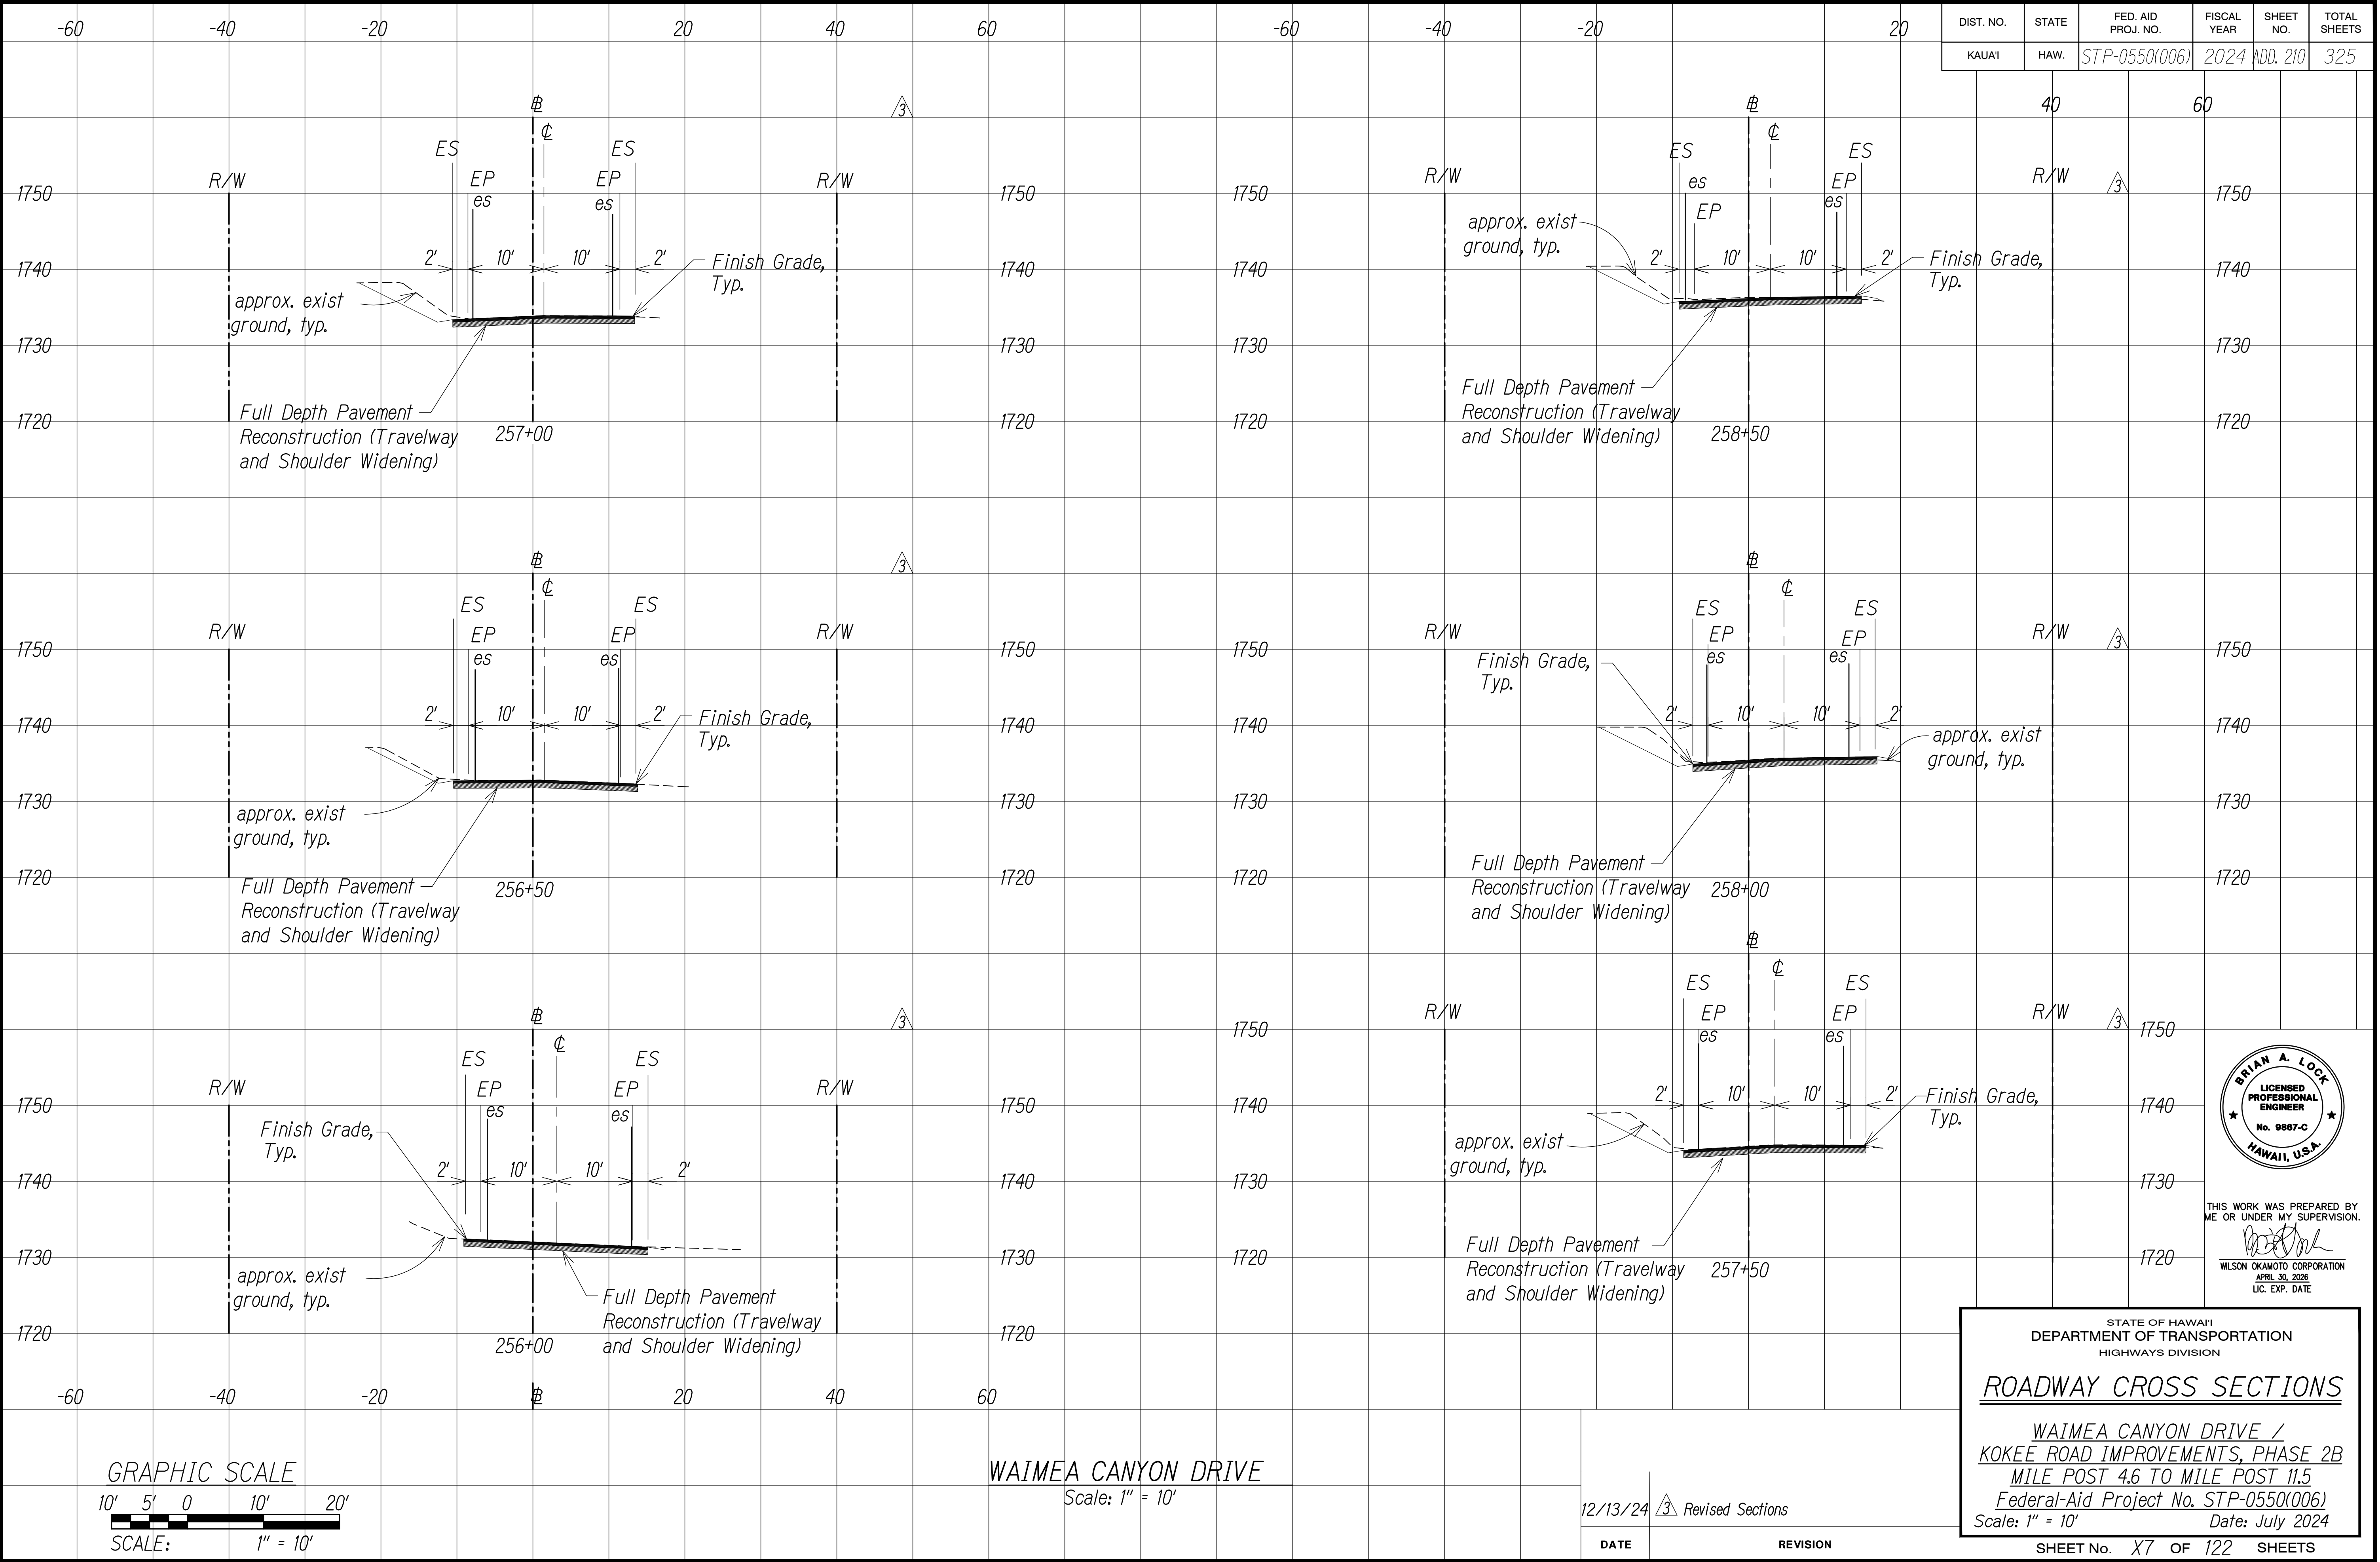

DIST. NO.	STATE	FED. AID PROJ. NO.	FISCAL YEAR	SHEET NO.	TOTAL SHEETS
KAUAI	HAW.	STP-0550(006)	2024	ADD. 210	325


SURVEY PLOTTED BY	DATE
DESIGNED BY	
TRACED BY	
QUANTITIES BY	
CHECKED BY	
ORIGINAL PLAN	
NOTE BOOK	
No.	

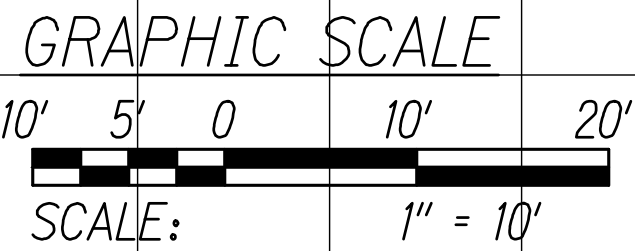

WAIMEA CANYON DRIVE
Scale: 1" = 10'

12/13/24 3 Revised Sections

DATE	REVISION
------	----------

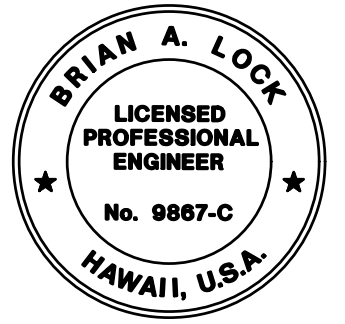


THIS WORK WAS PREPARED BY
ME OR UNDER MY SUPERVISION.
[Signature]
WILSON OKAMOTO CORPORATION
APRIL 30, 2026
LIC. EXP. DATE

STATE OF HAWAII
DEPARTMENT OF TRANSPORTATION
HIGHWAYS DIVISION


ROADWAY CROSS SECTIONS

WAIMEA CANYON DRIVE /
KOEKOE ROAD IMPROVEMENTS, PHASE 2B
MILE POST 4.6 TO MILE POST 11.5
Federal-Aid Project No. STP-0550(006)
Scale: 1" = 10' Date: July 2024

SHEET No. X7 OF 122 SHEETS

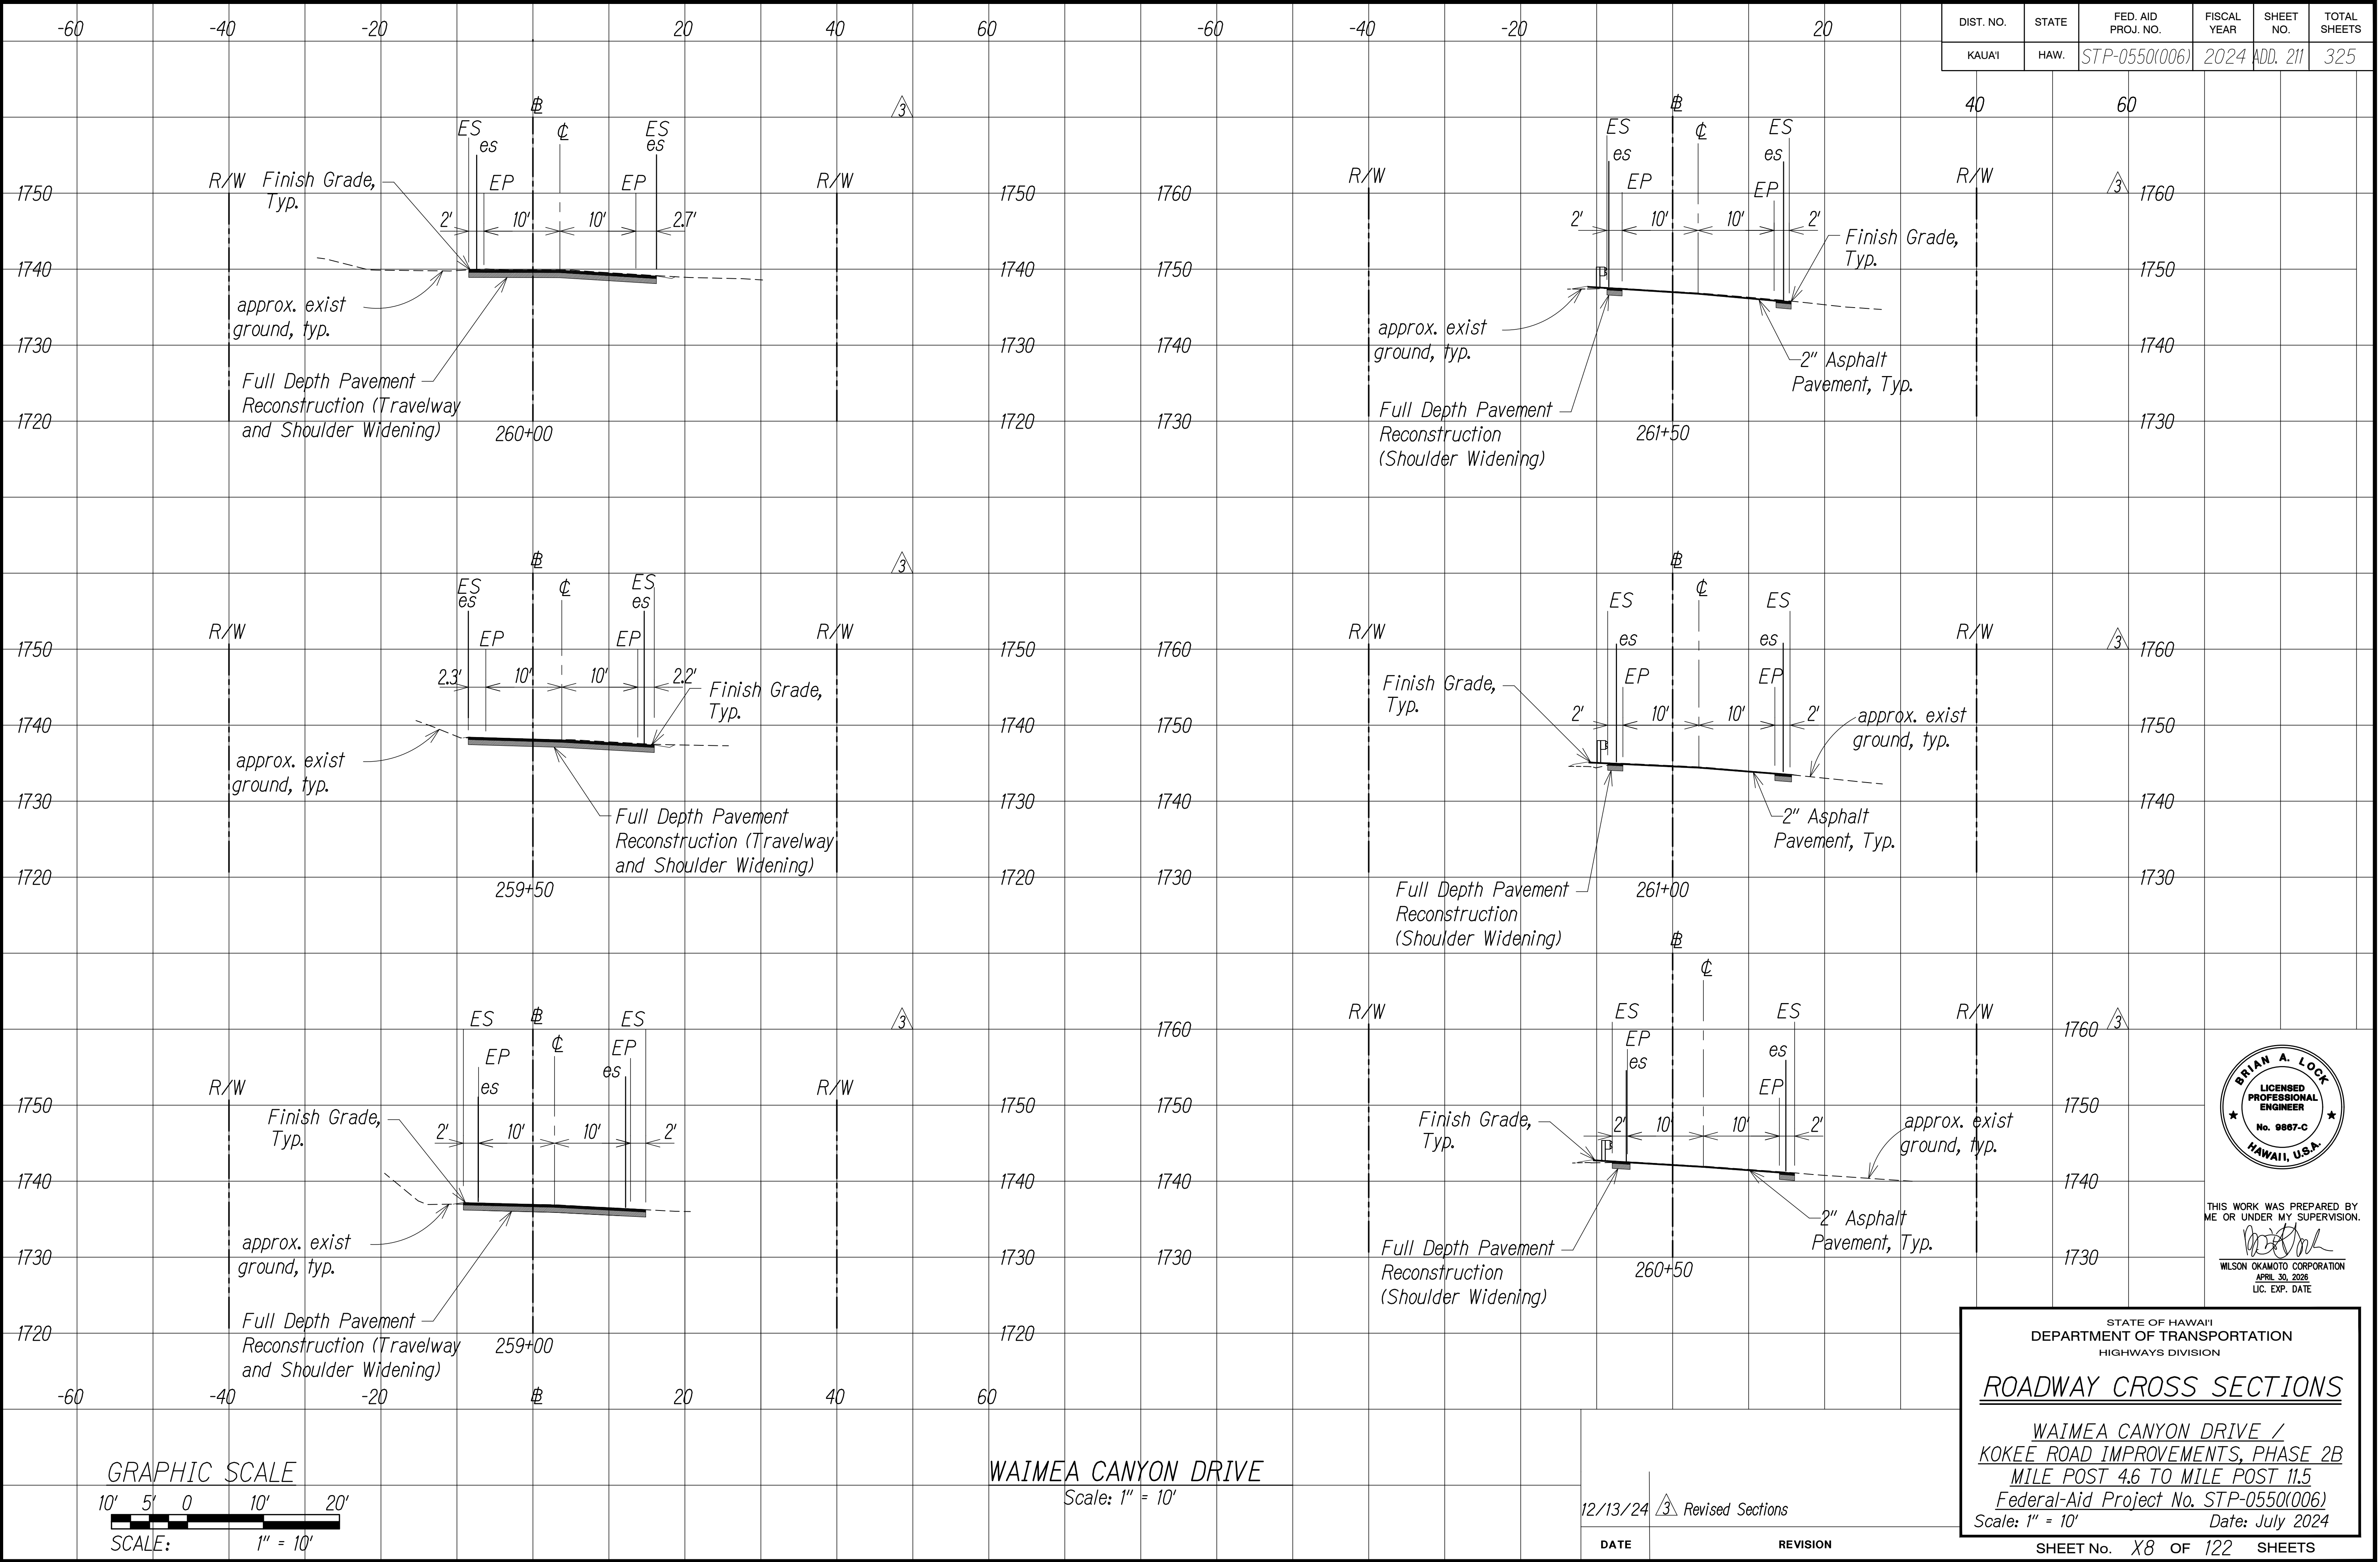

DIST. NO.	STATE	FED. AID PROJ. NO.	FISCAL YEAR	SHEET NO.	TOTAL SHEETS
KAUAI	HAW.	STP-0550(006)	2024	ADD. 211	325

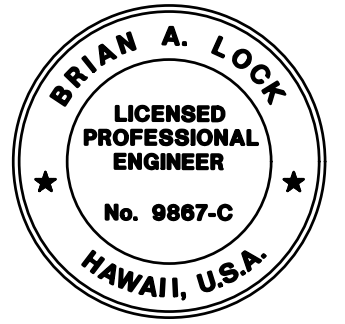

THIS WORK WAS PREPARED BY ME OR UNDER MY SUPERVISION.

[Signature]

WILSON OKAMOTO CORPORATION
APRIL 30, 2026
LIC. EXP. DATE


STATE OF HAWAII
DEPARTMENT OF TRANSPORTATION
HIGHWAYS DIVISION

ROADWAY CROSS SECTIONS

WAIMEA CANYON DRIVE /
KOEKE ROAD IMPROVEMENTS, PHASE 2B
MILE POST 4.6 TO MILE POST 11.5
Federal-Aid Project No. STP-0550(006)
Scale: 1" = 10' Date: July 2024


SURVEY PLOTTED BY	DATE
DESIGNED BY	
TRACED BY	
QUANTITIES BY	
CHECKED BY	
ORIGINAL PLAN	
NOTE BOOK	
No.	

DIST. NO.	STATE	FED. AID PROJ. NO.	FISCAL YEAR	SHEET NO.	TOTAL SHEETS
20	KAUAI	HAW. STP-0550(006)	2024	ADD. 212	325

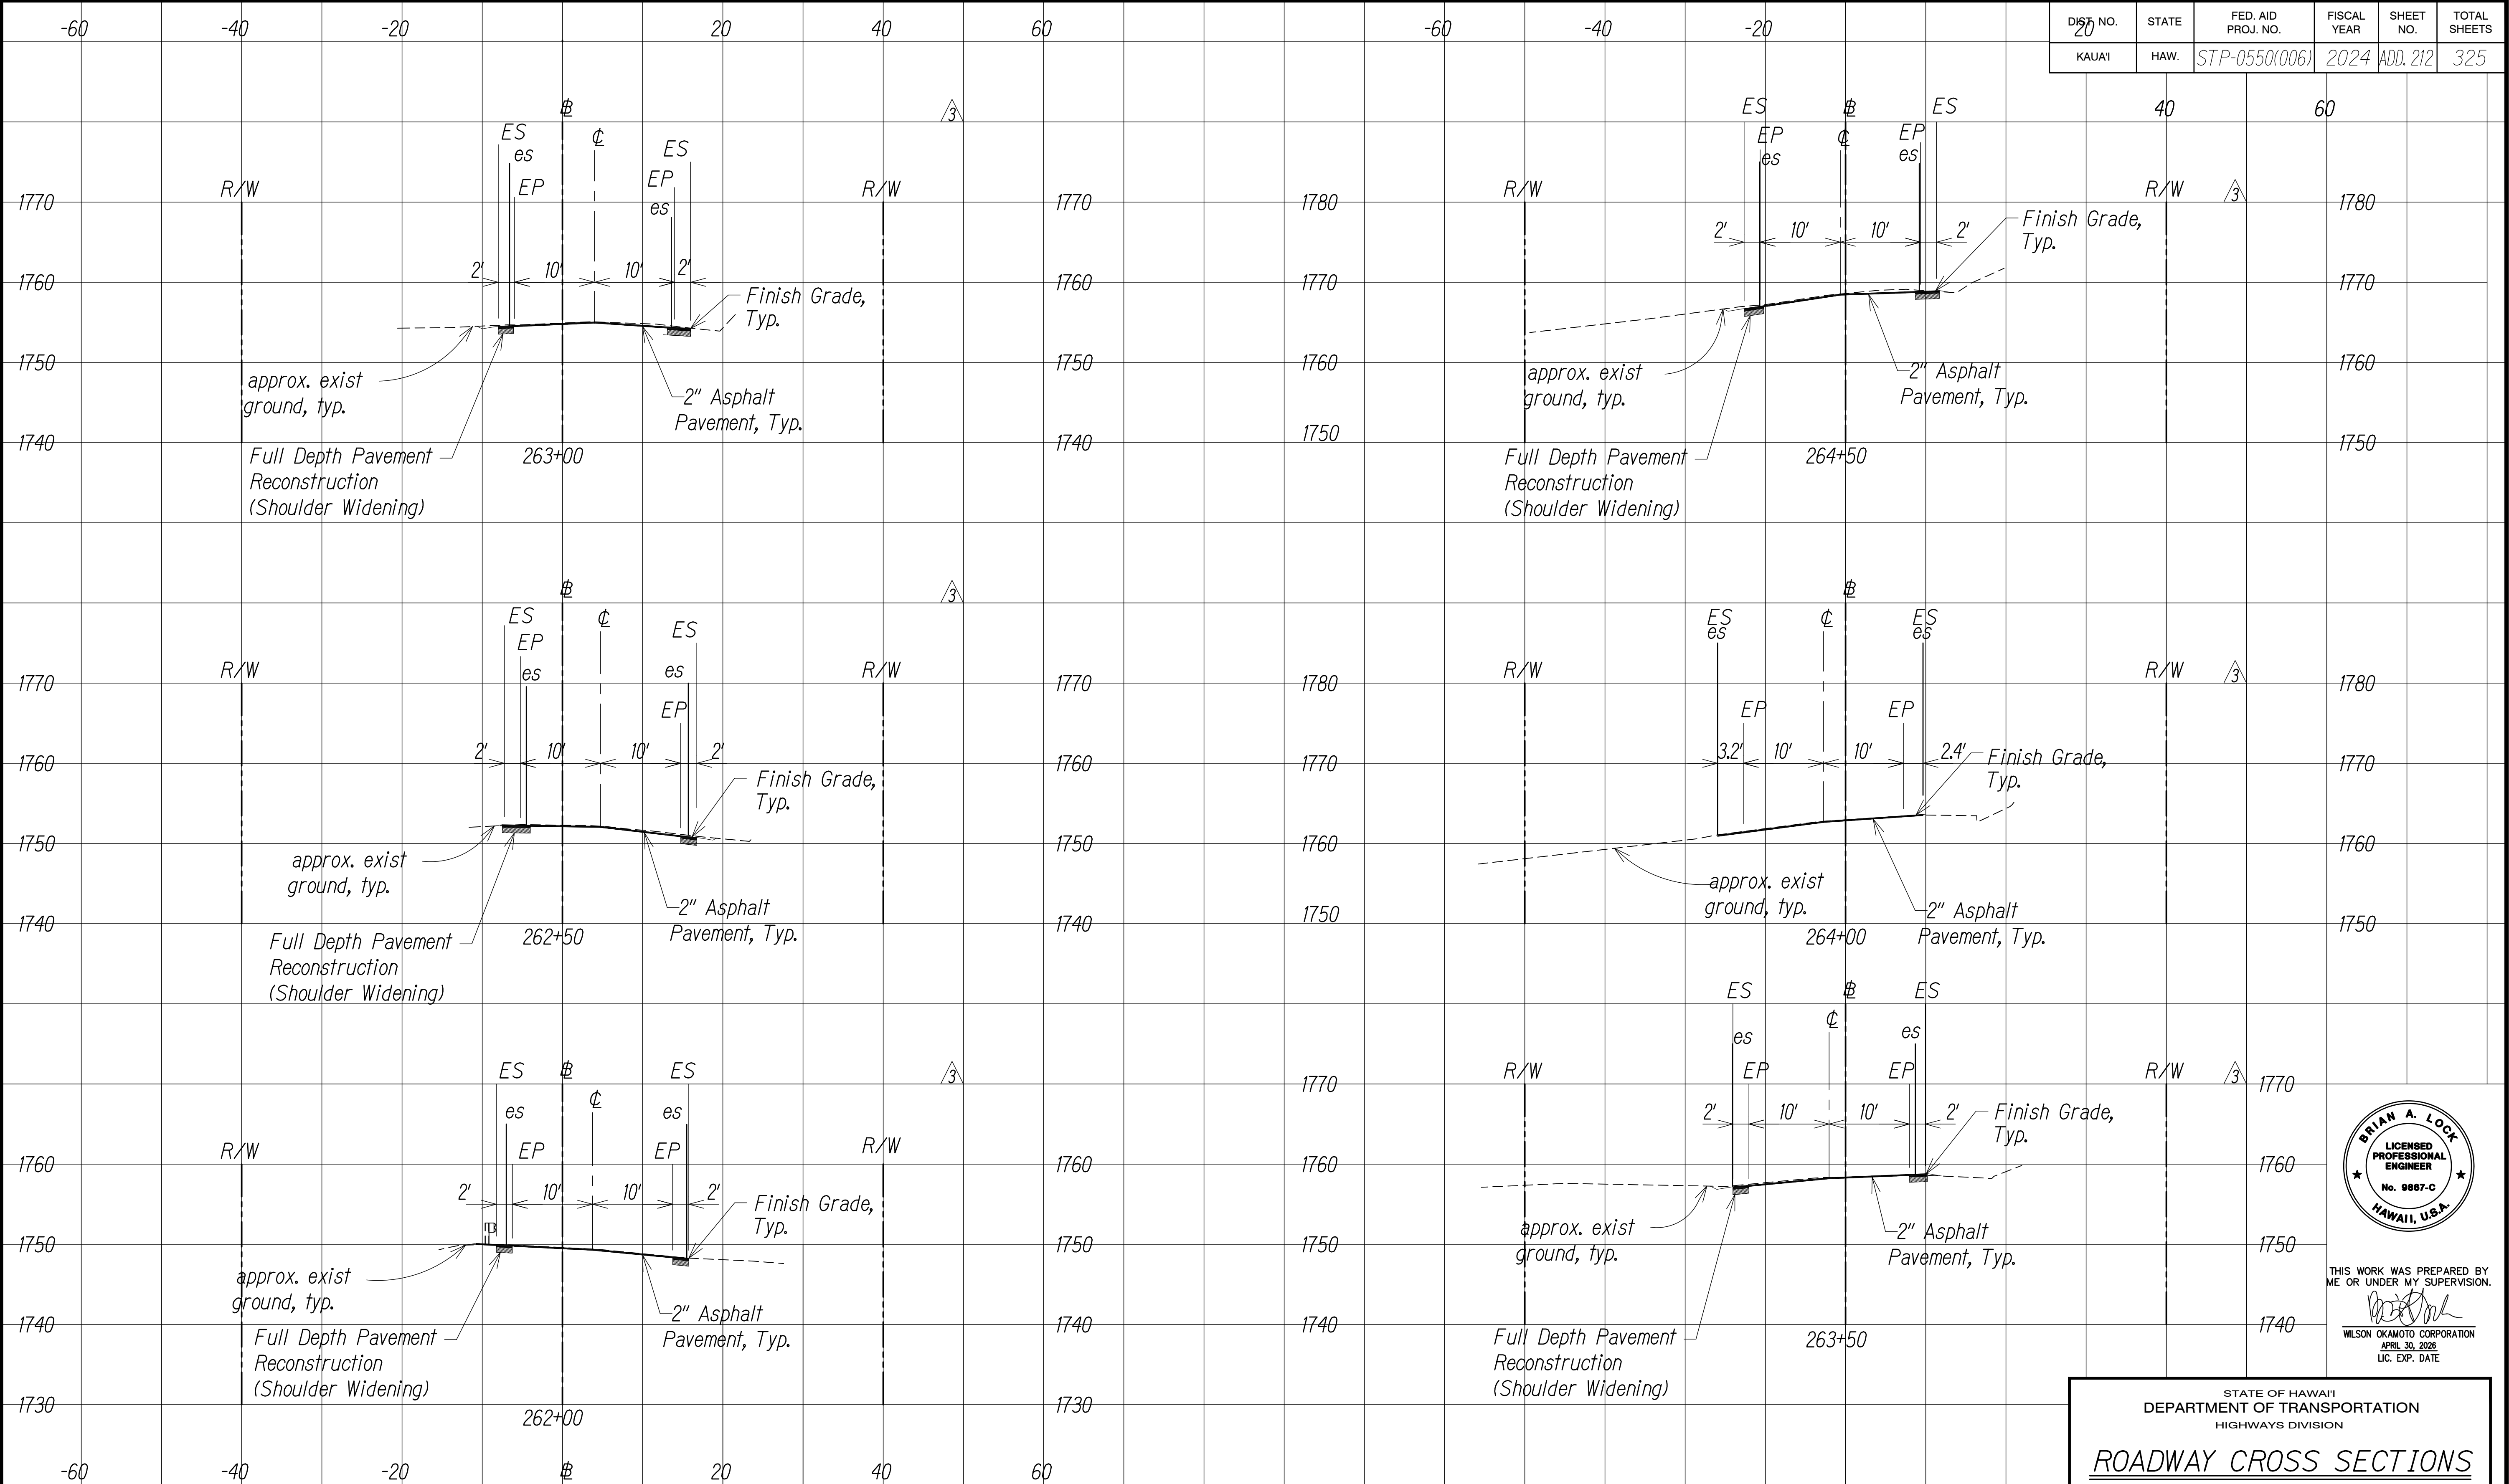

SURVEY PLOTTED BY	DATE
DESIGNED BY	
TRACED BY	
QUANTITIES BY	
CHECKED BY	

ORIGINAL PLAN	NOTE BOOK
No.	

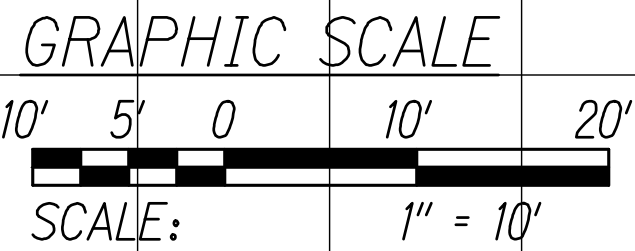


WAIMEA CANYON DRIVE

Scale: 1" = 10'

12/13/24 3 Revised Sections

DATE REVISION

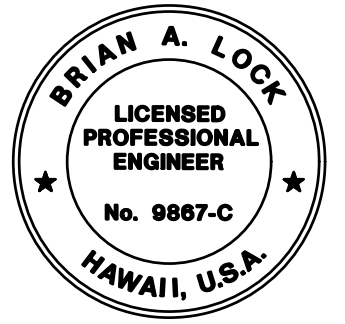

THIS WORK WAS PREPARED BY
ME OR UNDER MY SUPERVISION.

[Signature]

WILSON OKAMOTO CORPORATION
APRIL 30, 2026
LIC. EXP. DATE


STATE OF HAWAII
DEPARTMENT OF TRANSPORTATION
HIGHWAYS DIVISION

ROADWAY CROSS SECTIONS


WAIMEA CANYON DRIVE /
KOEKE ROAD IMPROVEMENTS, PHASE 2B
MILE POST 4.6 TO MILE POST 11.5
Federal-Aid Project No. STP-0550(006)
Scale: 1" = 10' Date: July 2024

SHEET No. X9 OF 122 SHEETS

ADD212

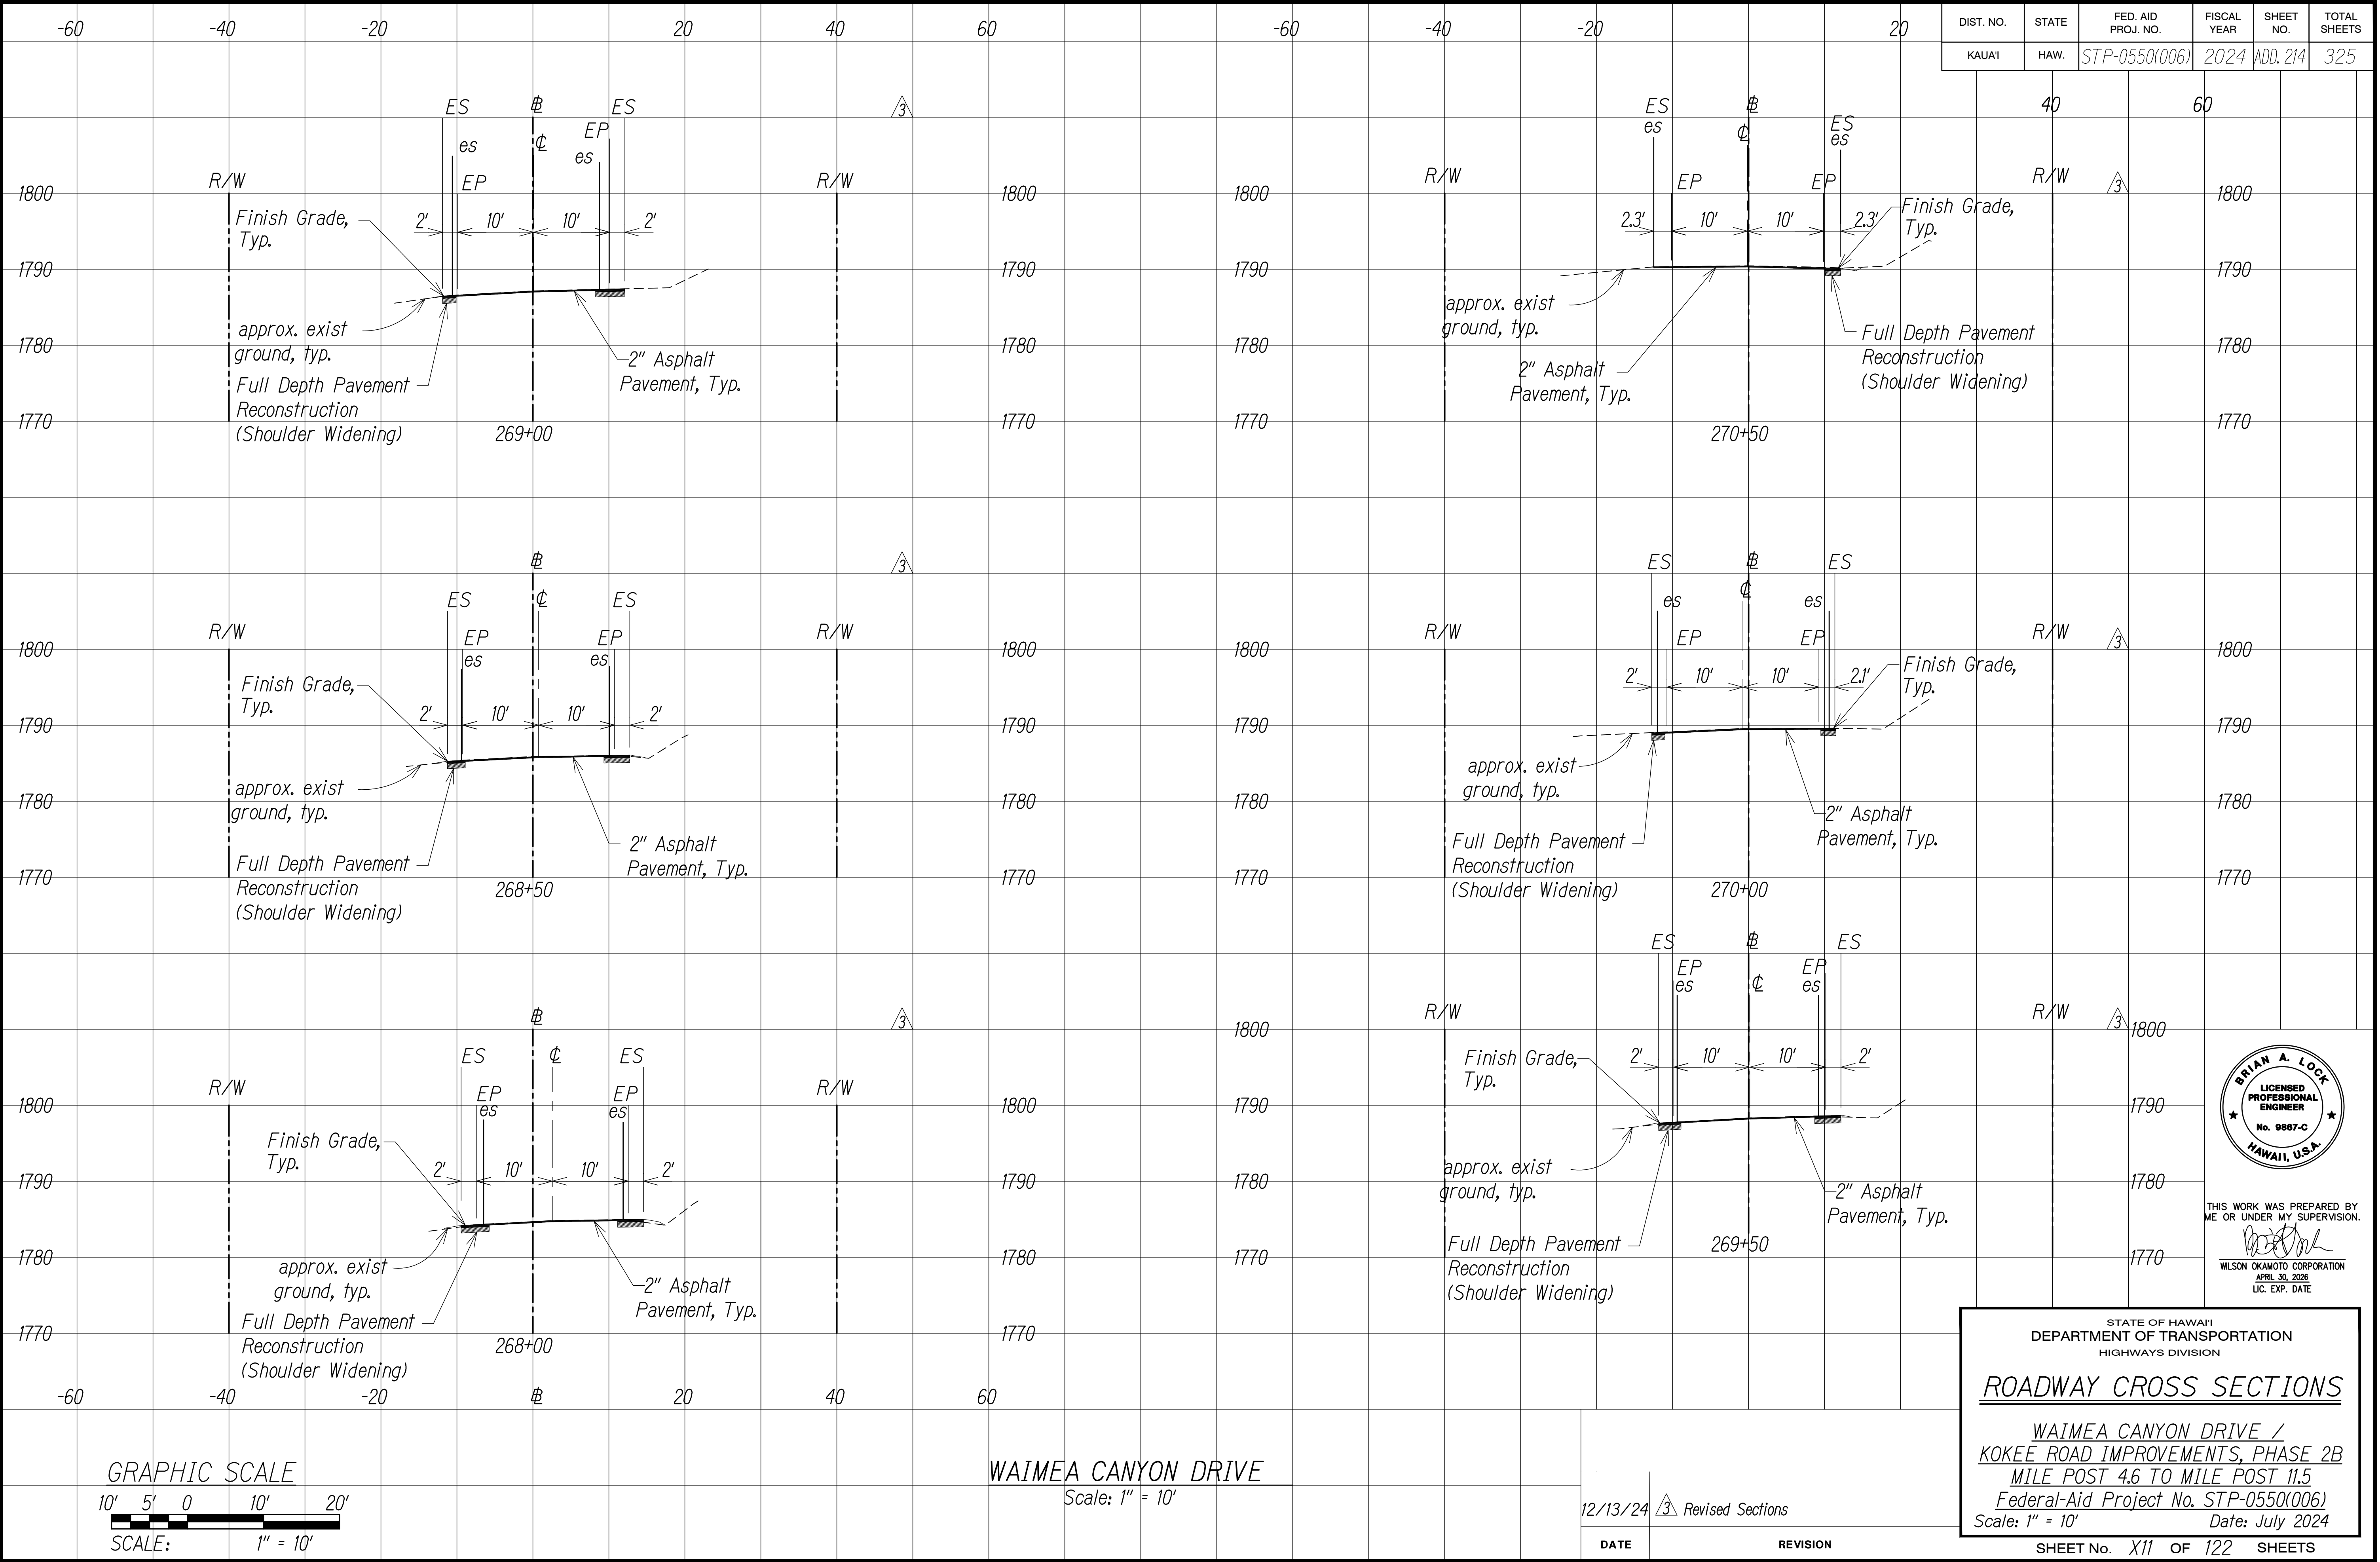


ORIGINAL PLAN	SURVEY PLOTTED BY	DATE
	DESIGNED BY	
	TRACED BY	
	QUANTITIES BY	
NOTE BOOK	CHECKED BY	
	No.	

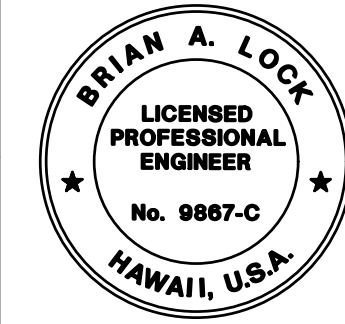


THIS WORK WAS PREPARED BY
ME OR UNDER MY SUPERVISION.
[Signature]
WILSON OKAMOTO CORPORATION
APRIL 30, 2026
LIC. EXP. DATE

STATE OF HAWAII
DEPARTMENT OF TRANSPORTATION
HIGHWAYS DIVISION
ROADWAY CROSS SECTIONS
WAIMEA CANYON DRIVE /
KOEKE ROAD IMPROVEMENTS, PHASE 2B
MILE POST 4.6 TO MILE POST 11.5
Federal-Aid Project No. STP-0550(006)
Scale: 1" = 10' Date: July 2024

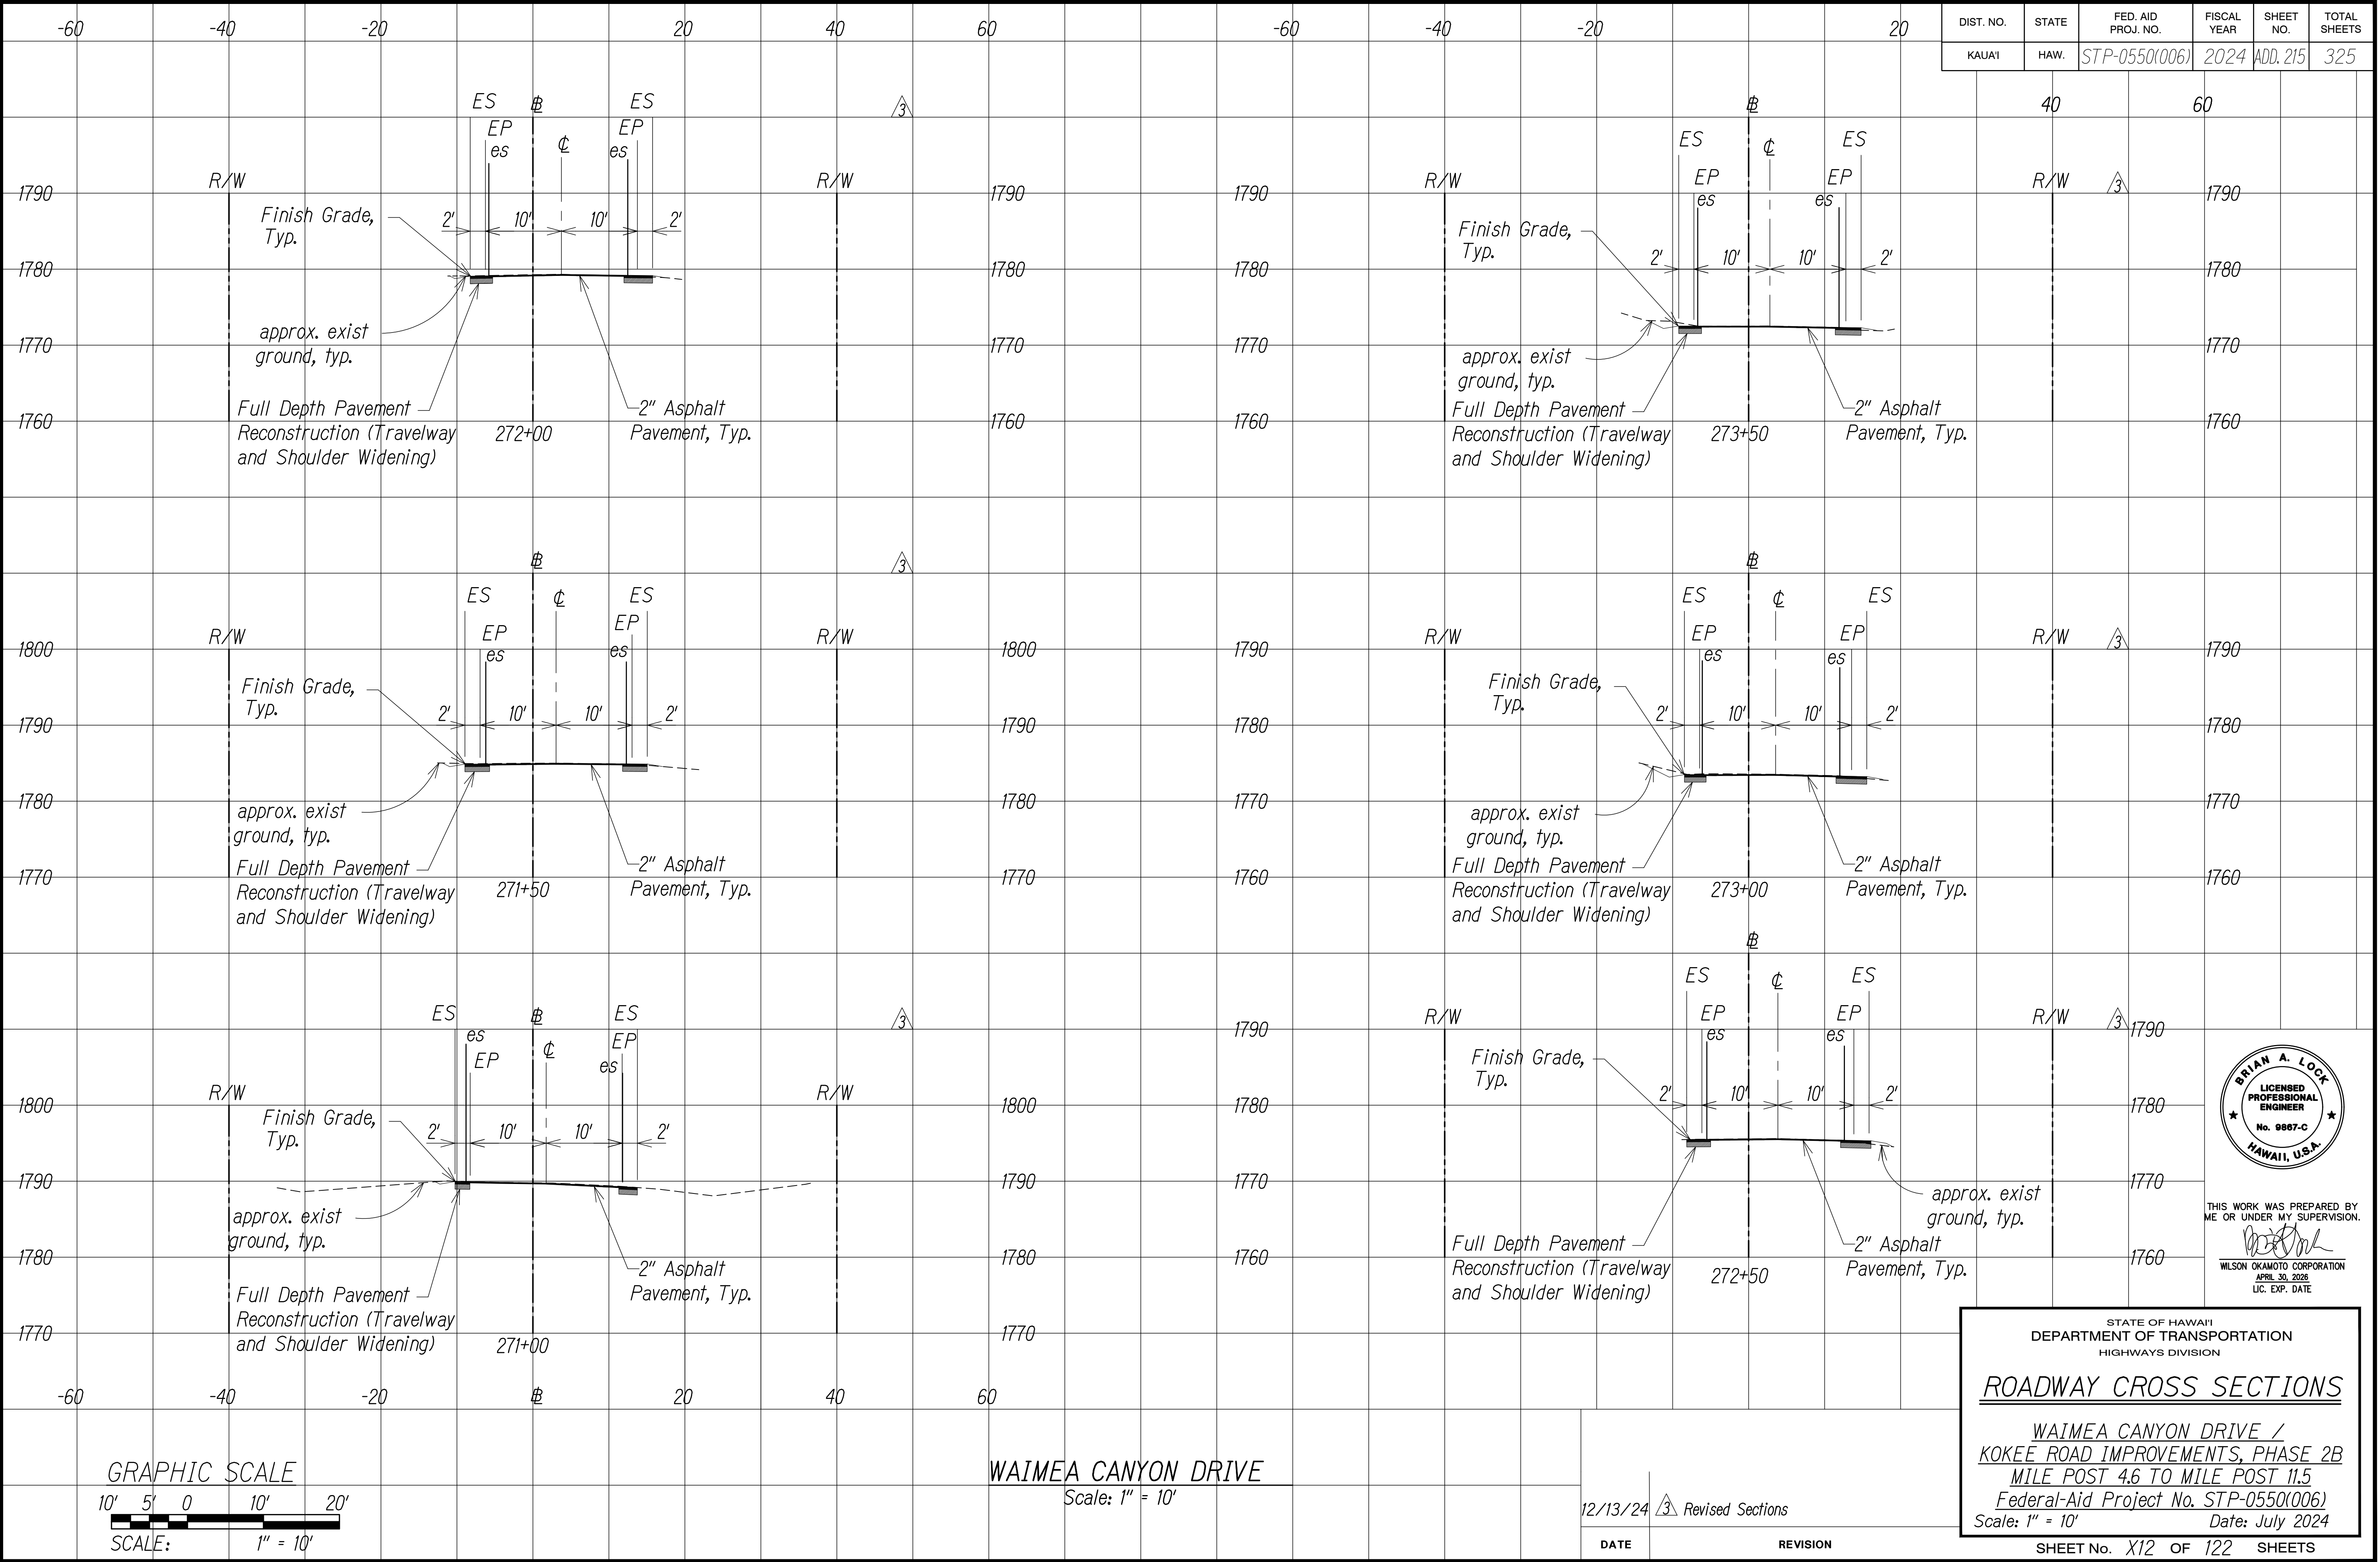

DIST. NO.	STATE	FED. AID PROJ. NO.	FISCAL YEAR	SHEET NO.	TOTAL SHEETS
KAUAI	HAW.	STP-0550(006)	2024	ADD. 215	325


SURVEY PLOTTED BY	DATE
DESIGNED BY	
TRACED BY	
QUANTITIES BY	
CHECKED BY	
NOTE BOOK	
No.	

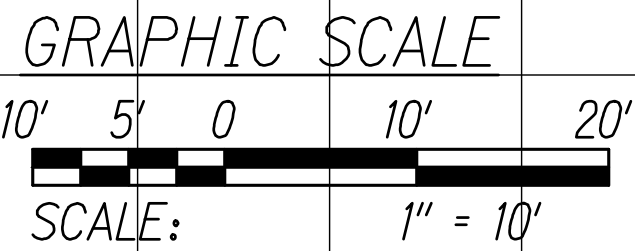

WAIMEA CANYON DRIVE
Scale: 1" = 10'

12/13/24 3 Revised Sections


DATE	REVISION
------	----------

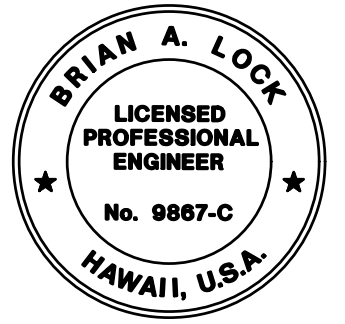


THIS WORK WAS PREPARED BY ME OR UNDER MY SUPERVISION.
WILSON OKAMOTO CORPORATION
APRIL 30, 2026
LIC. EXP. DATE

STATE OF HAWAII
DEPARTMENT OF TRANSPORTATION
HIGHWAYS DIVISION
ROADWAY CROSS SECTIONS
WAIMEA CANYON DRIVE /
KOEKE ROAD IMPROVEMENTS, PHASE 2B
MILE POST 4.6 TO MILE POST 11.5
Federal-Aid Project No. STP-0550(006)
Scale: 1" = 10' Date: July 2024

SHEET No. X12 OF 122 SHEETS

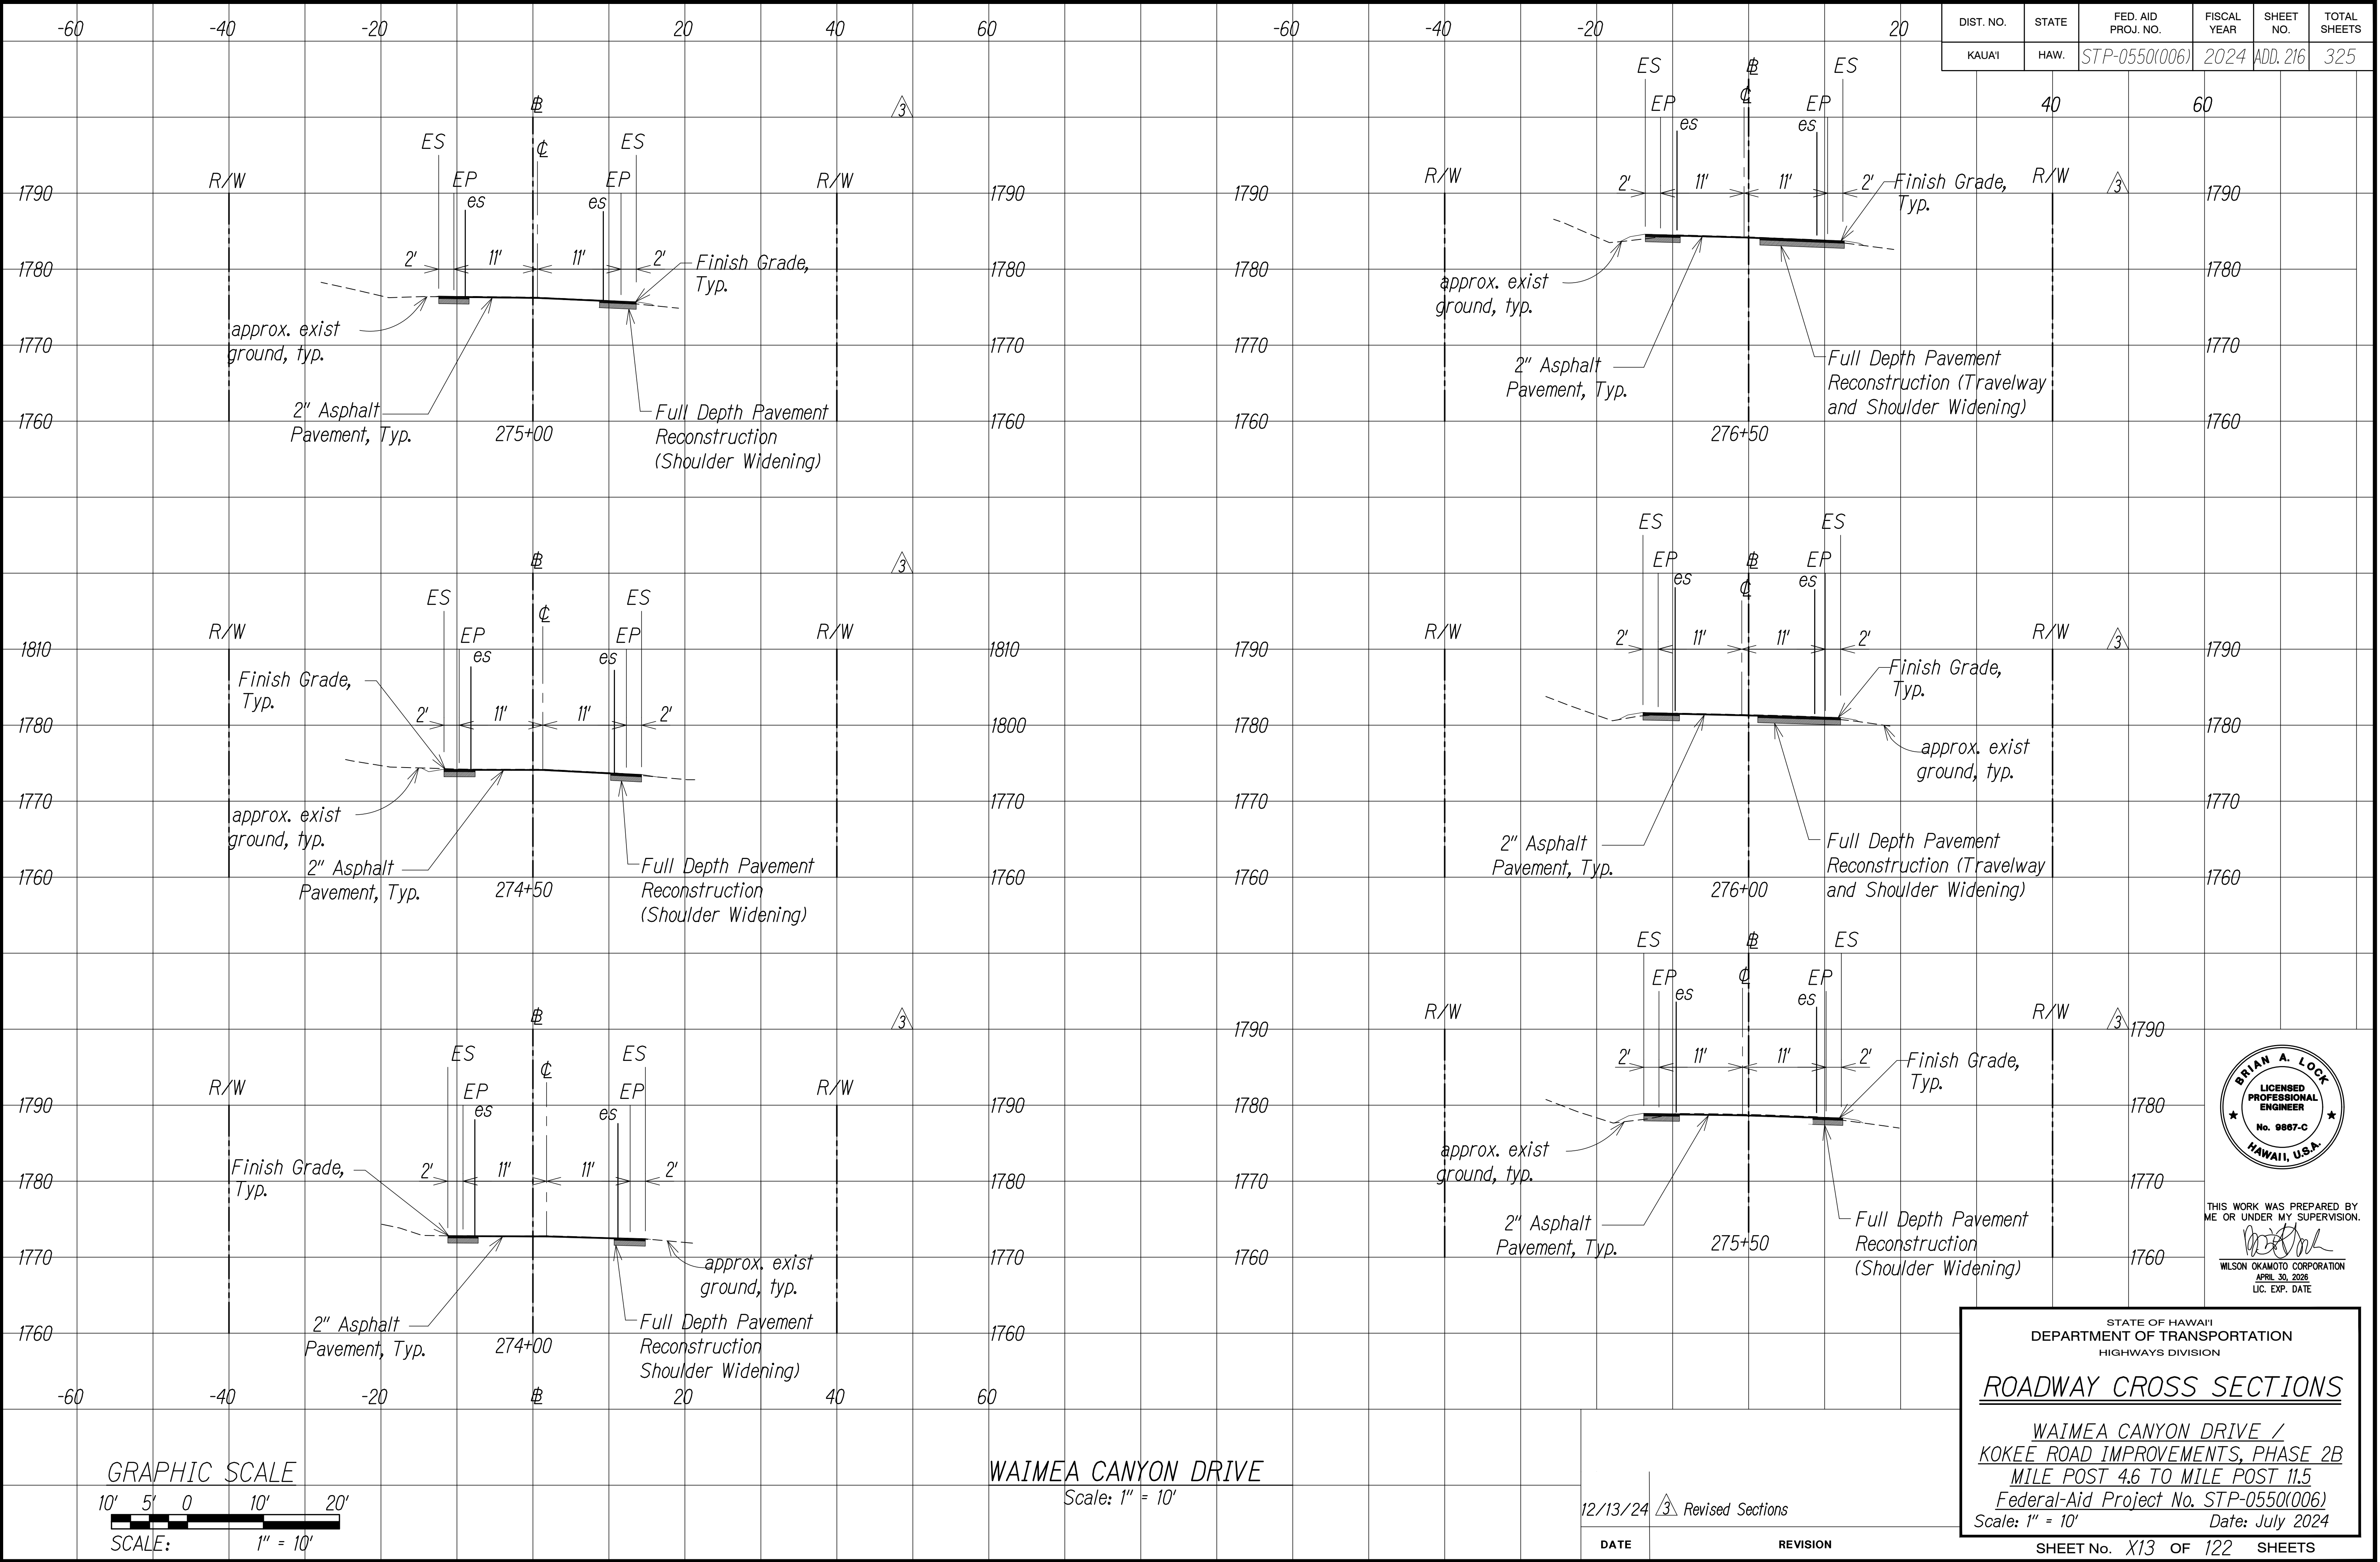

SURVEY PLOTTED BY	DATE
DESIGNED BY	
TRACED BY	
DESIGNED BY	
QUANTITIES BY	
CHECKED BY	
ORIGINAL PLAN	
NOTE BOOK	
No.	

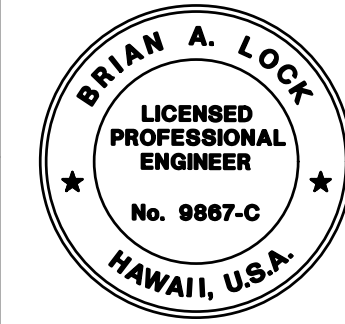

THIS WORK WAS PREPARED BY
ME OR UNDER MY SUPERVISION.
[Signature]
WILSON OKAMOTO CORPORATION
APRIL 30, 2026
LIC. EXP. DATE


STATE OF HAWAII
DEPARTMENT OF TRANSPORTATION
HIGHWAYS DIVISION
ROADWAY CROSS SECTIONS
WAIMEA CANYON DRIVE /
KOKEE ROAD IMPROVEMENTS, PHASE 2B
MILE POST 4.6 TO MILE POST 11.5
Federal-Aid Project No. STP-0550(006)
Scale: 1" = 10' Date: July 2024

12/13/24 3 Revised Sections


DATE REVISION

SHEET No. X13 OF 122 SHEETS

DIST. NO.	STATE	FED. AID PROJ. NO.	FISCAL YEAR	SHEET NO.	TOTAL SHEETS
KAUAI	HAW.	STP-0550(006)	2024	ADD. 218	325

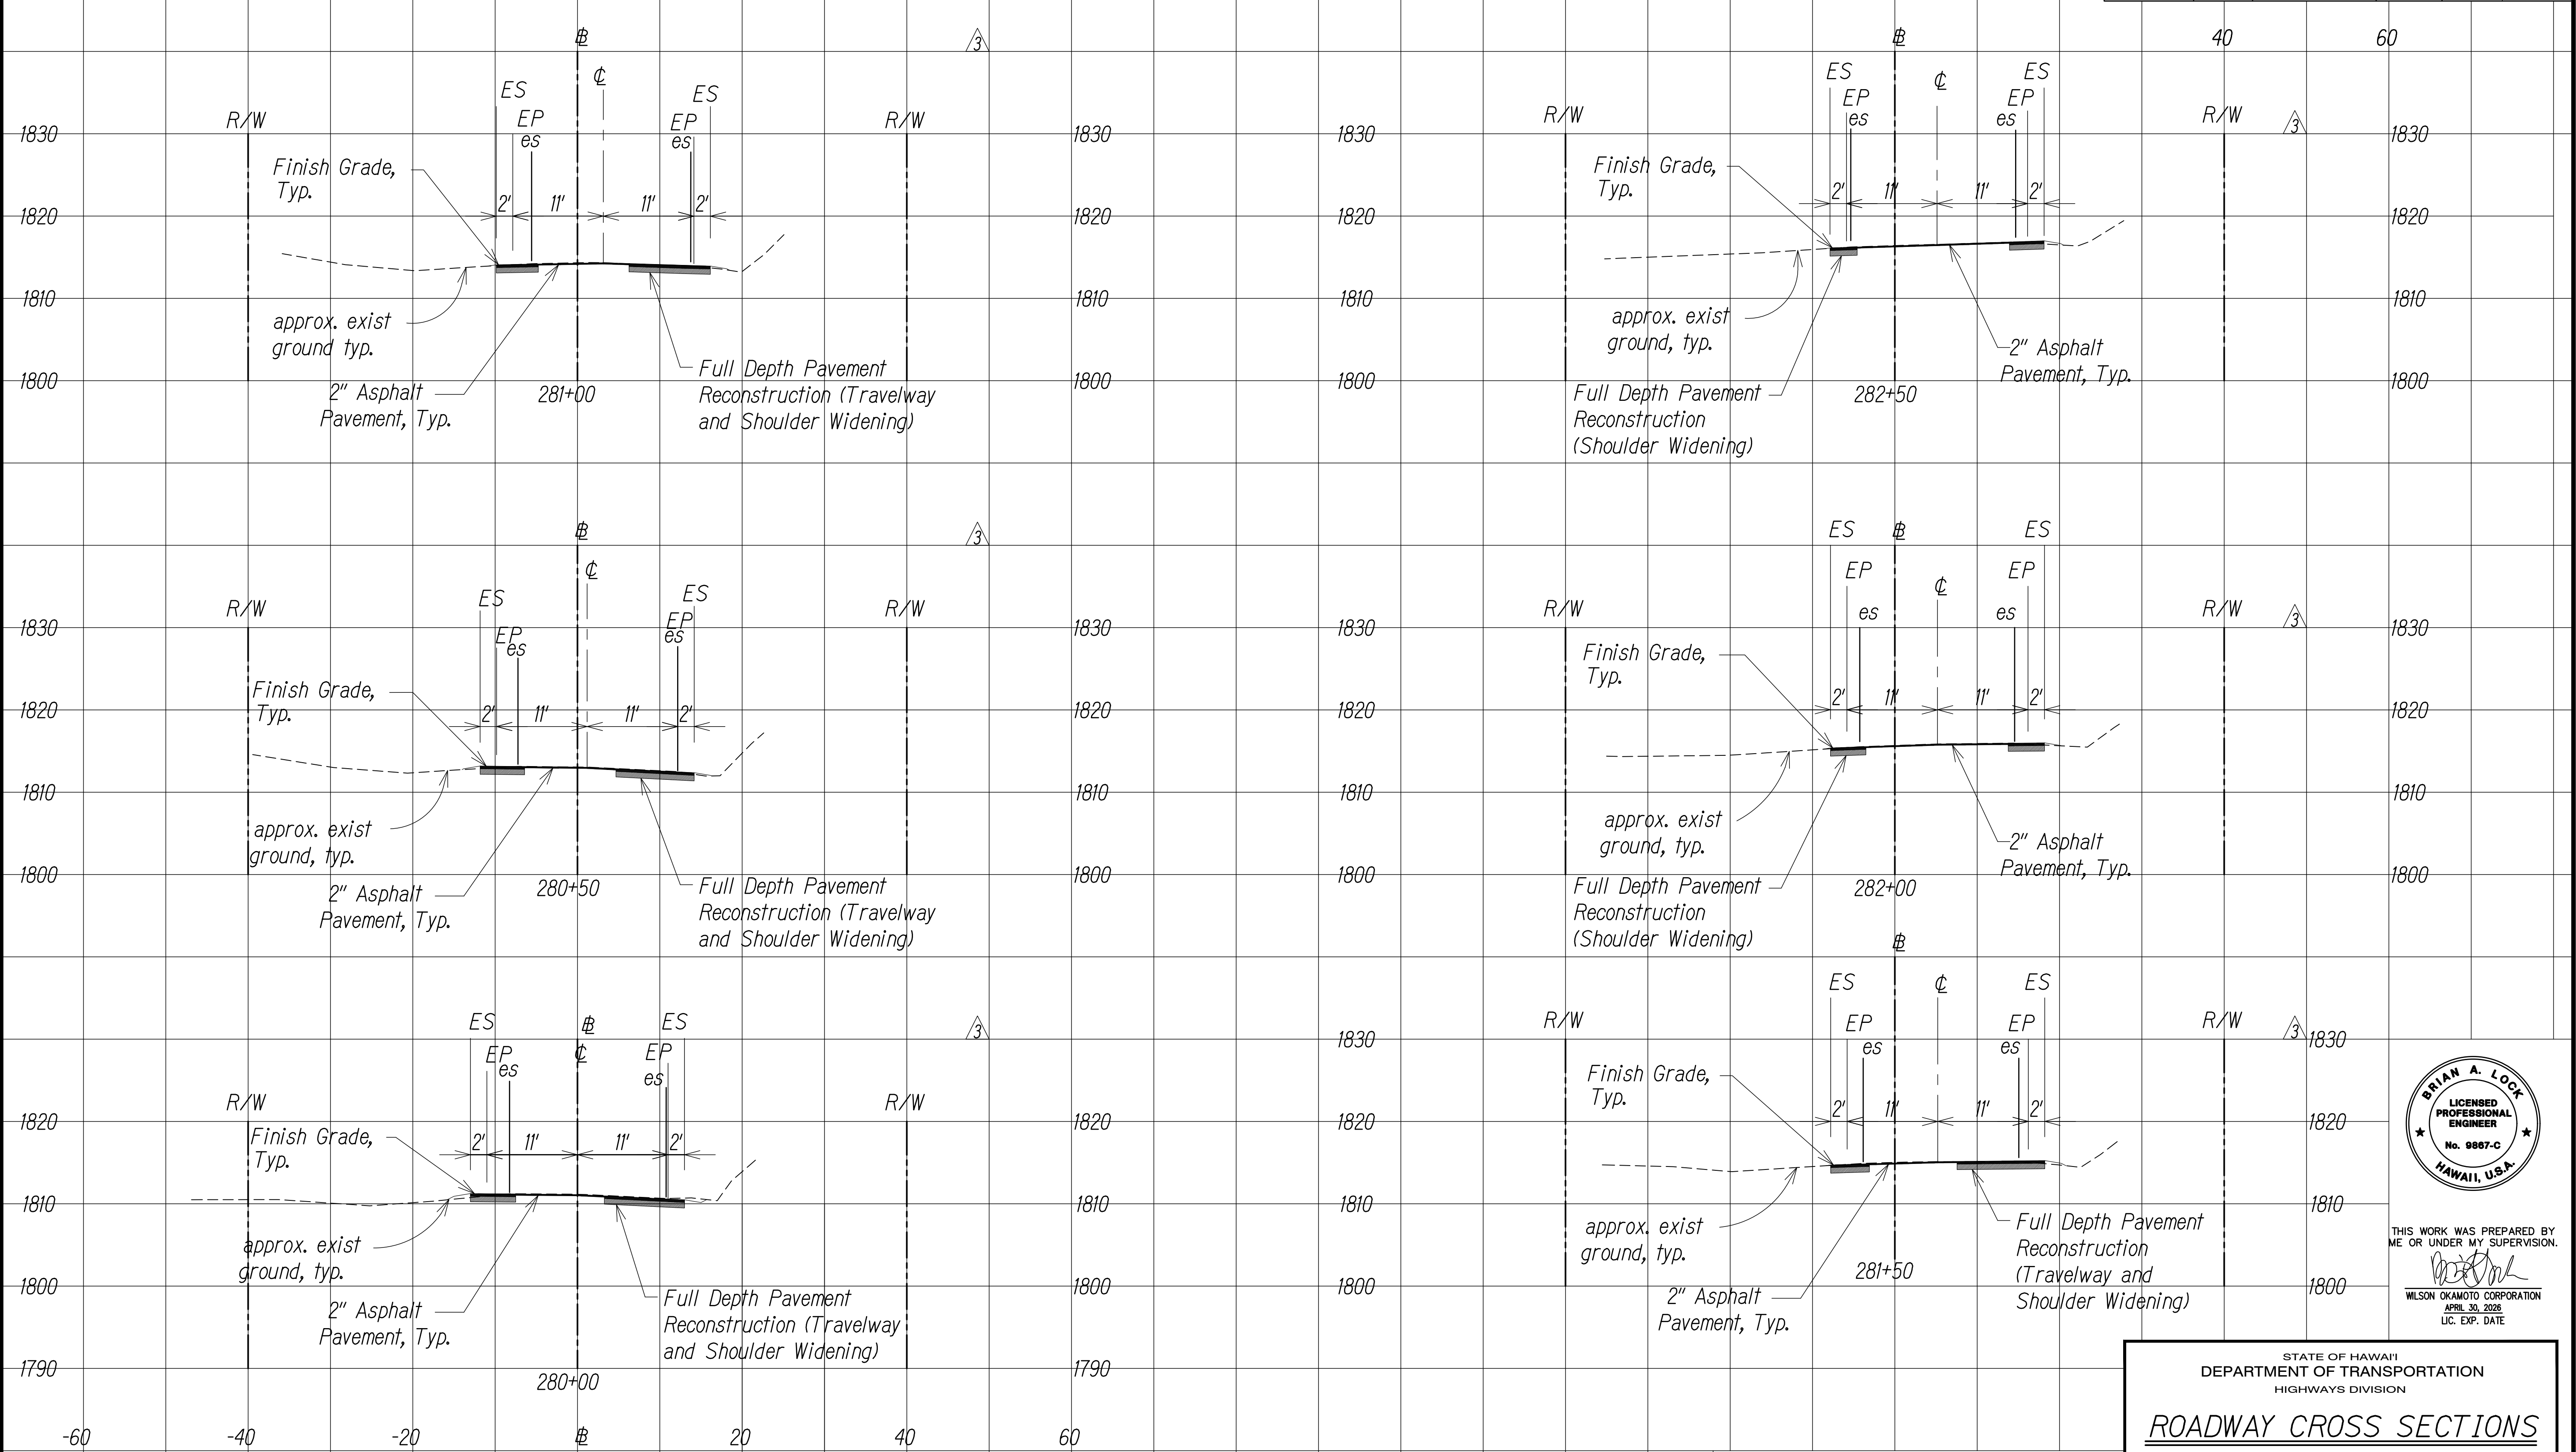


SURVEY PLOTTED BY	DATE
DESIGNED BY	
TRACED BY	
NOTED BY	
CHECKED BY	

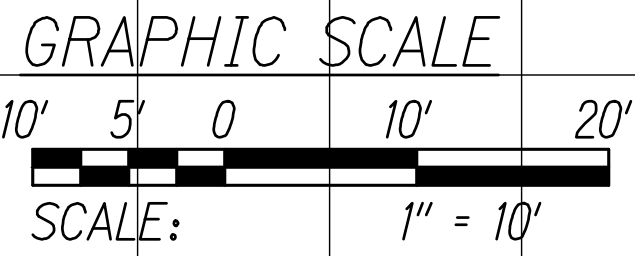

WAIMEA CANYON DRIVE
Scale: 1" = 10'


12/13/24 3 Revised Sections

DATE REVISION

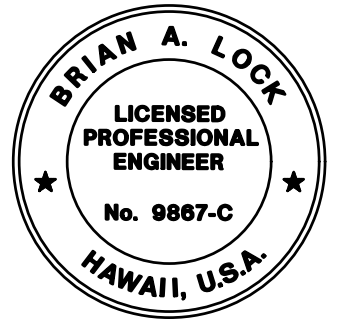

THIS WORK WAS PREPARED BY
ME OR UNDER MY SUPERVISION.
[Signature]
WILSON OKAMOTO CORPORATION
APRIL 30, 2026
LIC. EXP. DATE


STATE OF HAWAII
DEPARTMENT OF TRANSPORTATION
HIGHWAYS DIVISION
ROADWAY CROSS SECTIONS
WAIMEA CANYON DRIVE /
KOEKE ROAD IMPROVEMENTS, PHASE 2B
MILE POST 4.6 TO MILE POST 11.5
Federal-Aid Project No. STP-0550(006)
Scale: 1" = 10' Date: July 2024
SHEET No. X15 OF 122 SHEETS

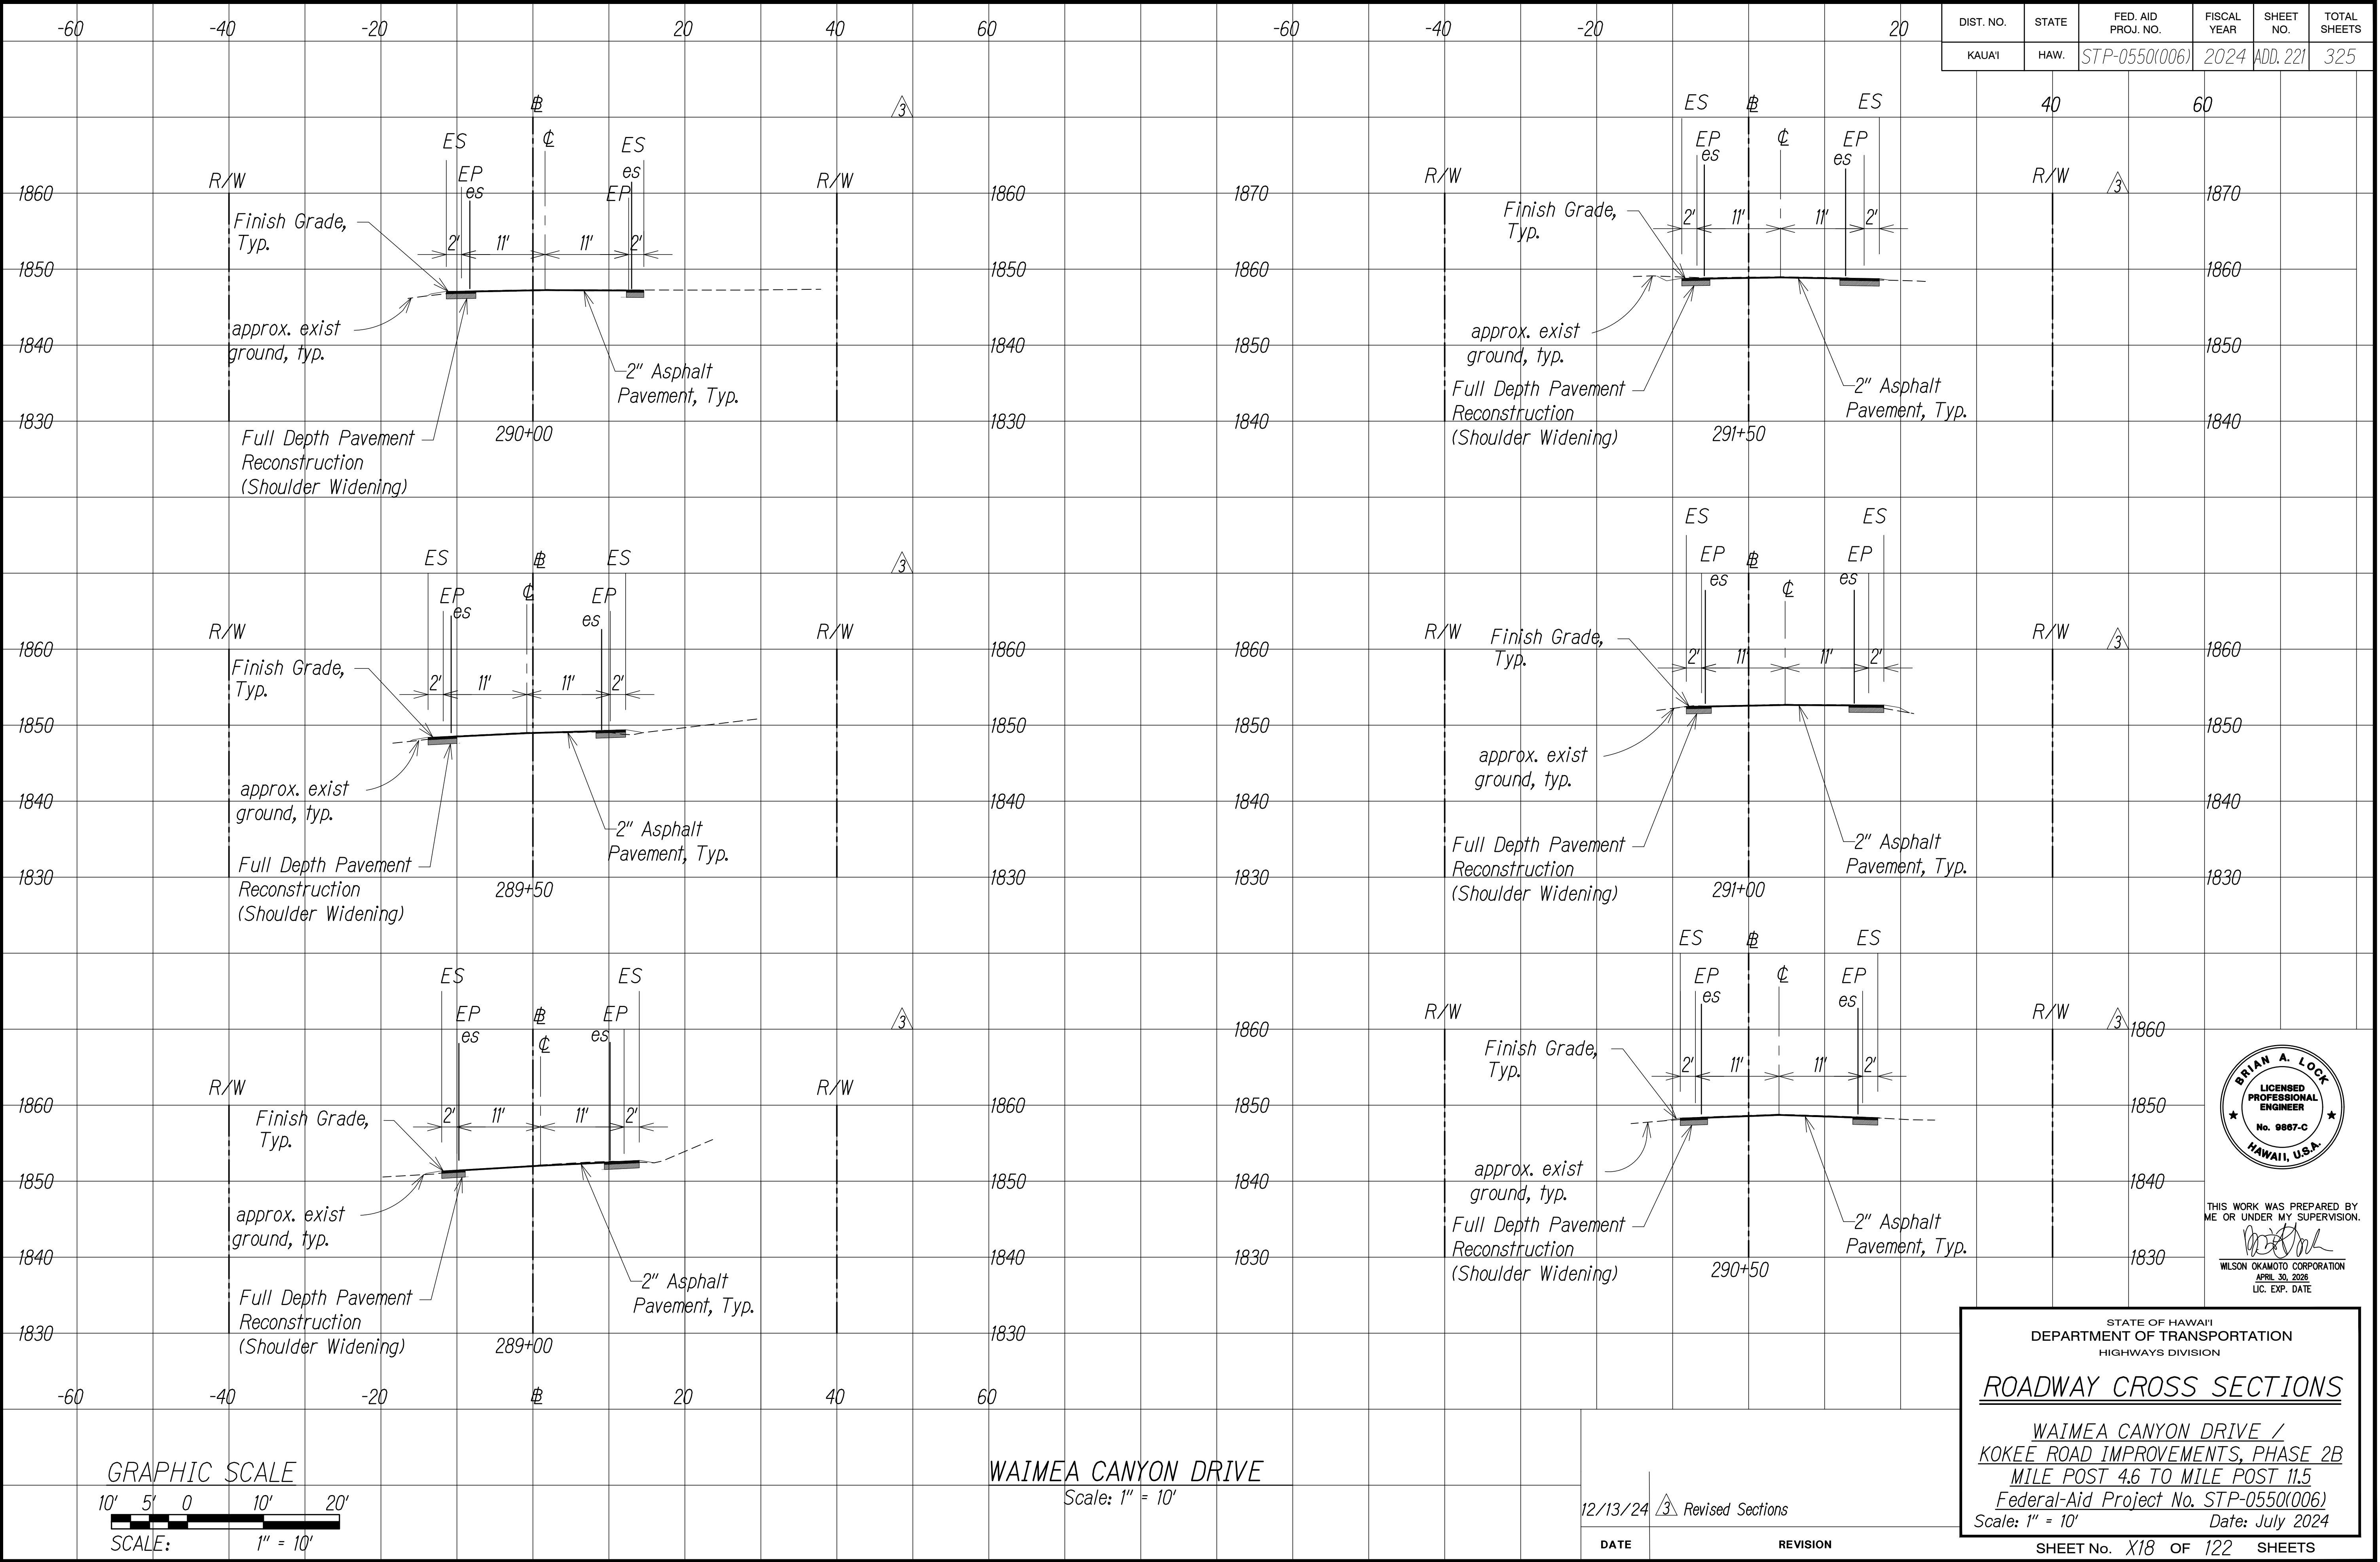

DIST. NO.	STATE	FED. AID PROJ. NO.	FISCAL YEAR	SHEET NO.	TOTAL SHEETS
KAUAI	HAW.	STP-0550(006)	2024	ADD. 221	325

SURVEY PLOTTED BY	DATE
DESIGNED BY	
TRACED BY	
QUANTITIES BY	
CHECKED BY	

ORIGINAL PLAN	No.
NOTE BOOK	

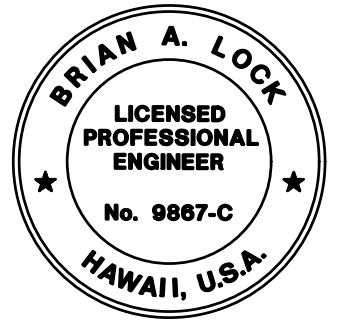

THIS WORK WAS PREPARED BY
ME OR UNDER MY SUPERVISION.
[Signature]
WILSON OKAMOTO CORPORATION
APRIL 30, 2026
LIC. EXP. DATE


STATE OF HAWAII
DEPARTMENT OF TRANSPORTATION
HIGHWAYS DIVISION
ROADWAY CROSS SECTIONS
WAIMEA CANYON DRIVE /
KOKEE ROAD IMPROVEMENTS, PHASE 2B
MILE POST 4.6 TO MILE POST 11.5
Federal-Aid Project No. STP-0550(006)
Scale: 1" = 10' Date: July 2024

12/13/24 3 Revised Sections

DATE REVISION


SHEET No. X18 OF 122 SHEETS

DIST. NO.	STATE	FED. AID PROJ. NO.	FISCAL YEAR	SHEET NO.	TOTAL SHEETS
KAUAI	HAW.	STP-0550(006)	2024	ADD.222	325

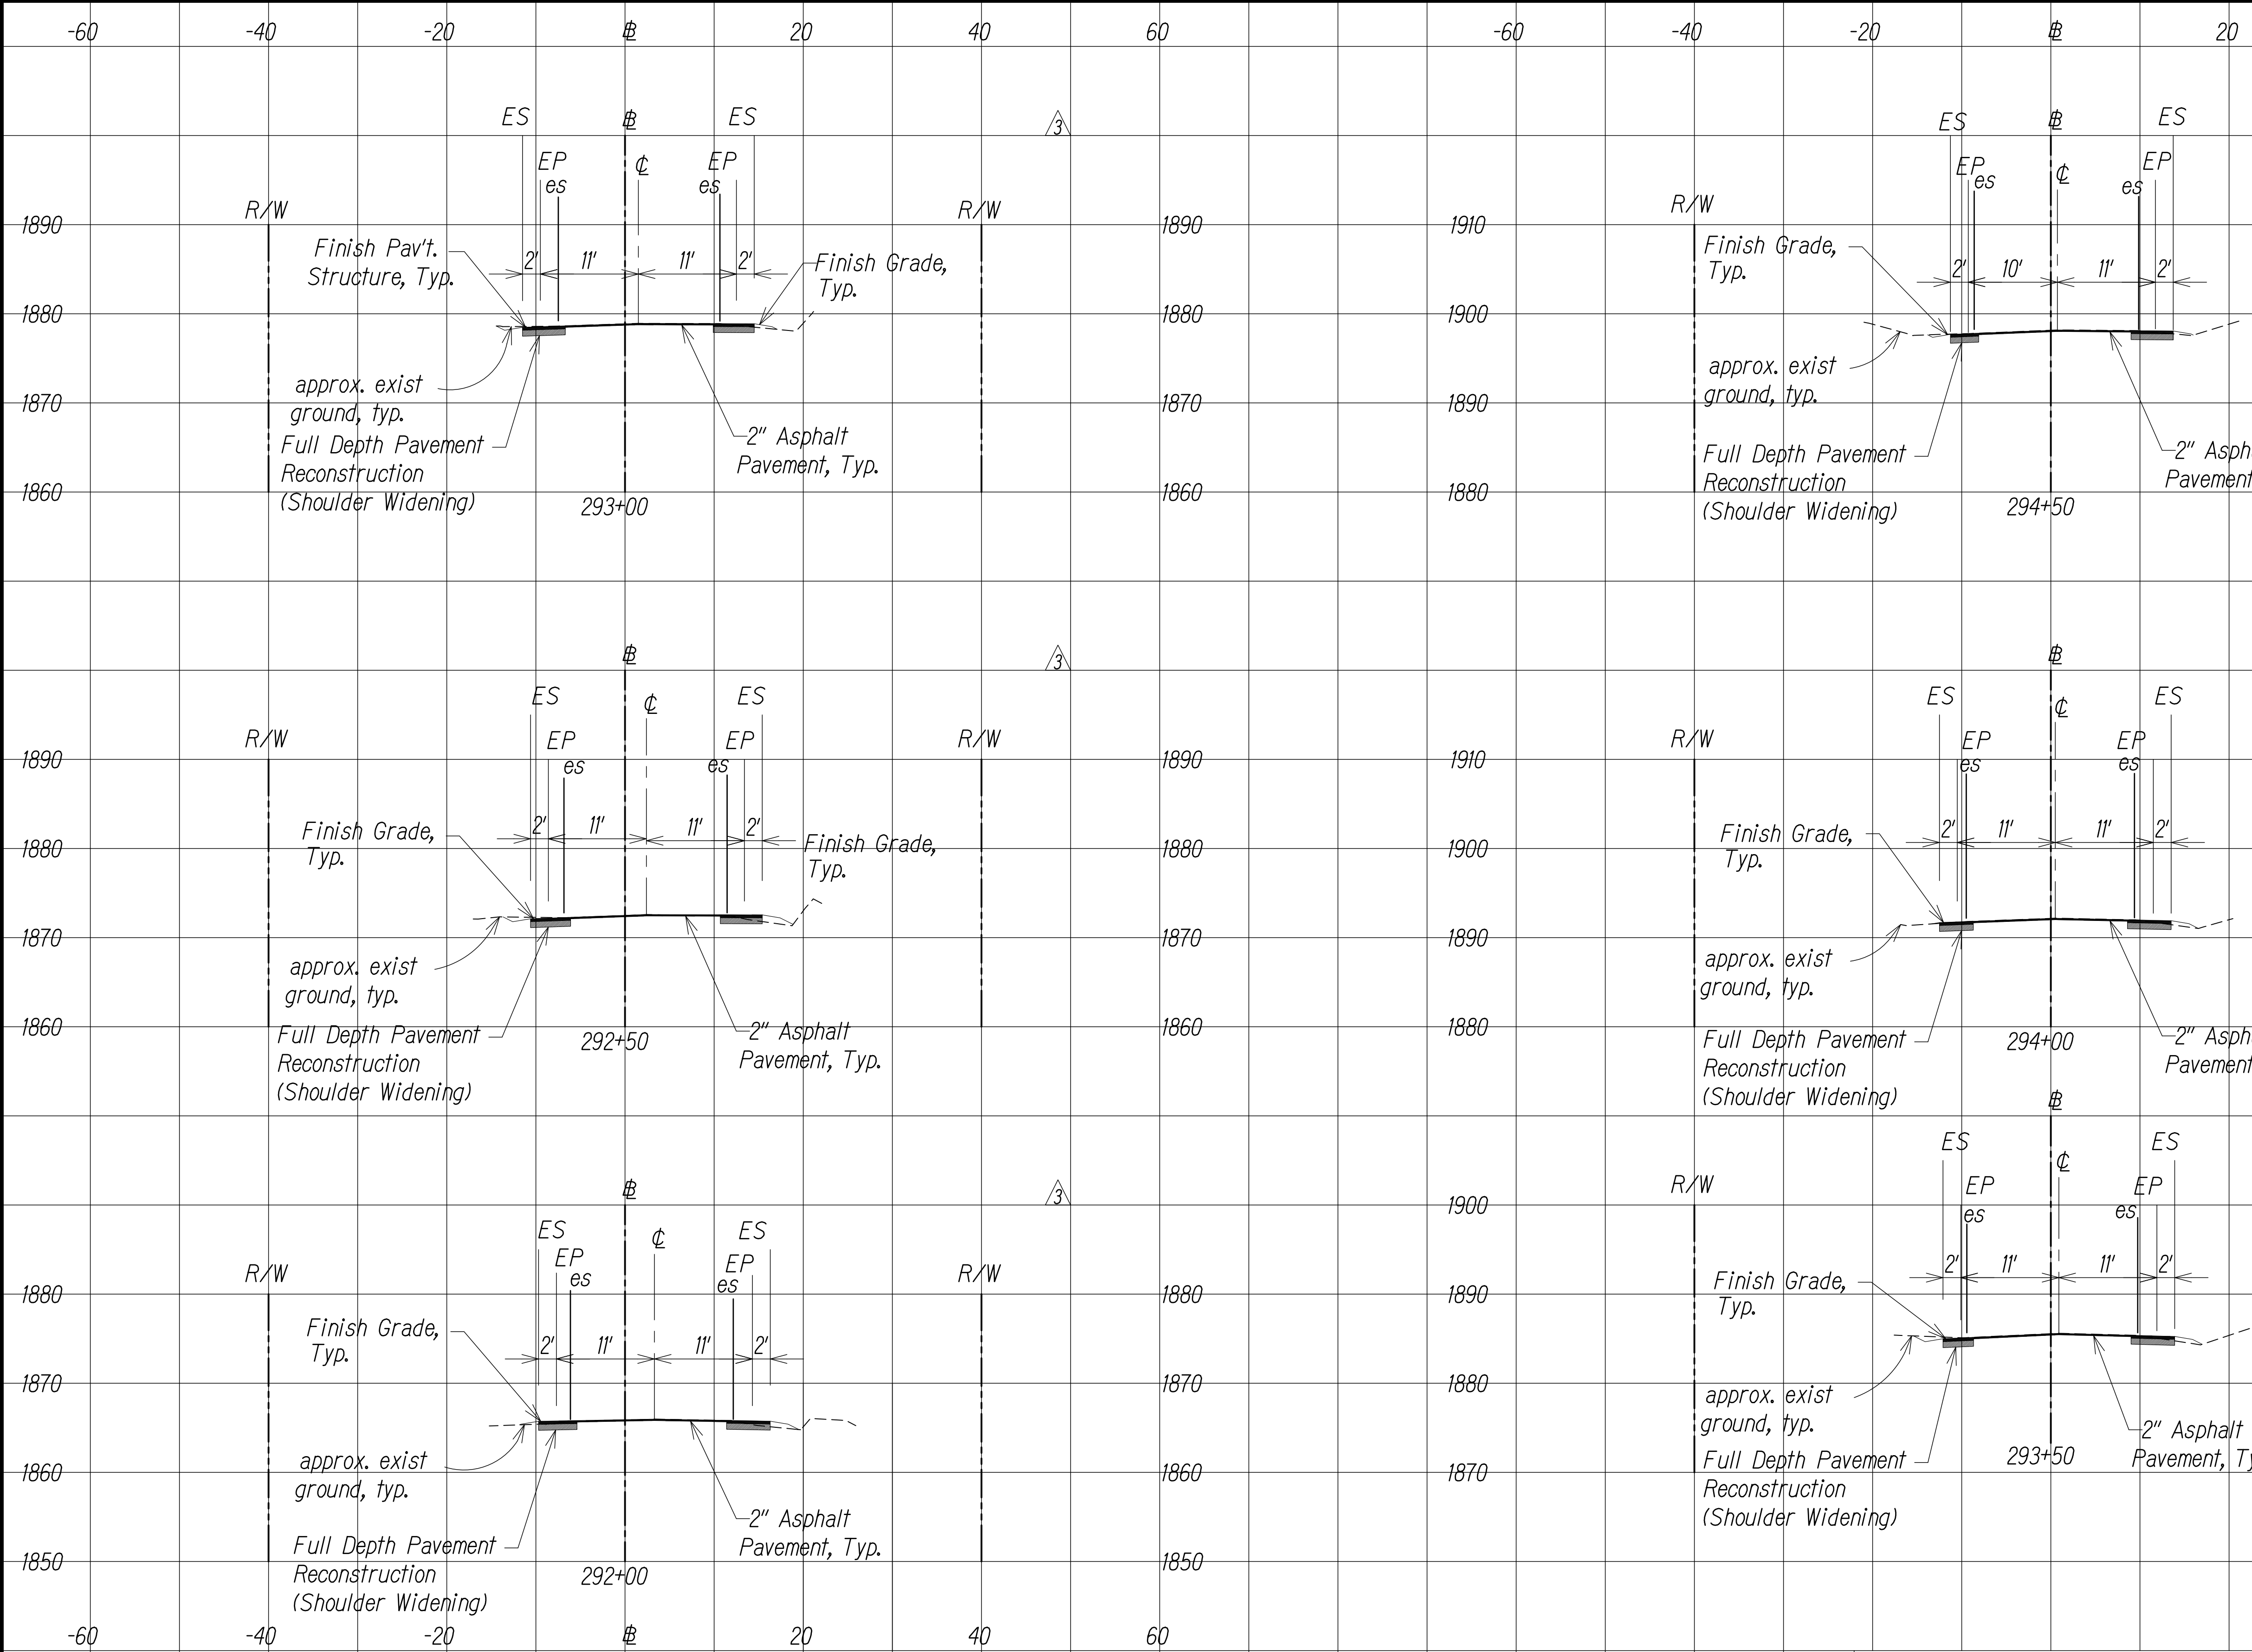

SURVEY PLOTTED BY	DATE
DESIGNED BY	
TRACED BY	
QUANTITIES BY	
CHECKED BY	


ORIGINAL PLAN	NOTE BOOK
No.	

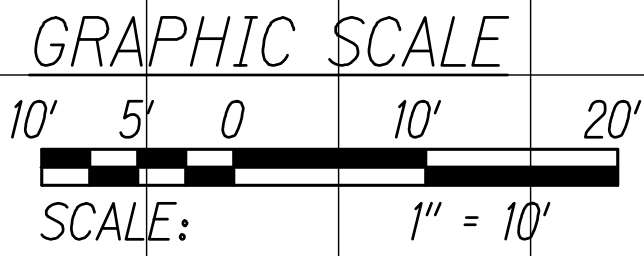

WAIMEA CANYON DRIVE
Scale: 1" = 10'

12/13/24 3 Revised Sections


DATE REVISION

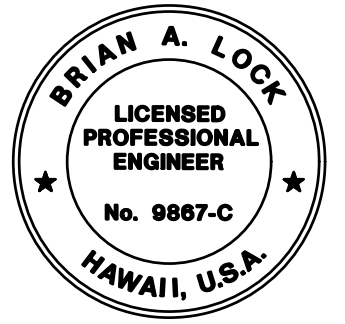

THIS WORK WAS PREPARED BY
ME OR UNDER MY SUPERVISION.
[Signature]
WILSON OKAMOTO CORPORATION
APRIL 30, 2026
LIC. EXP. DATE


STATE OF HAWAII
DEPARTMENT OF TRANSPORTATION
HIGHWAYS DIVISION
ROADWAY CROSS SECTIONS
WAIMEA CANYON DRIVE /
KOEKE ROAD IMPROVEMENTS, PHASE 2B
MILE POST 4.6 TO MILE POST 11.5
Federal-Aid Project No. STP-0550(006)
Scale: 1" = 10' Date: July 2024
SHEET No. X19 OF 122 SHEETS

DIST. NO.	STATE	FED. AID PROJ. NO.	FISCAL YEAR	SHEET NO.	TOTAL SHEETS
KAUAI	HAW.	STP-0550(006)	2024	ADD.223	325

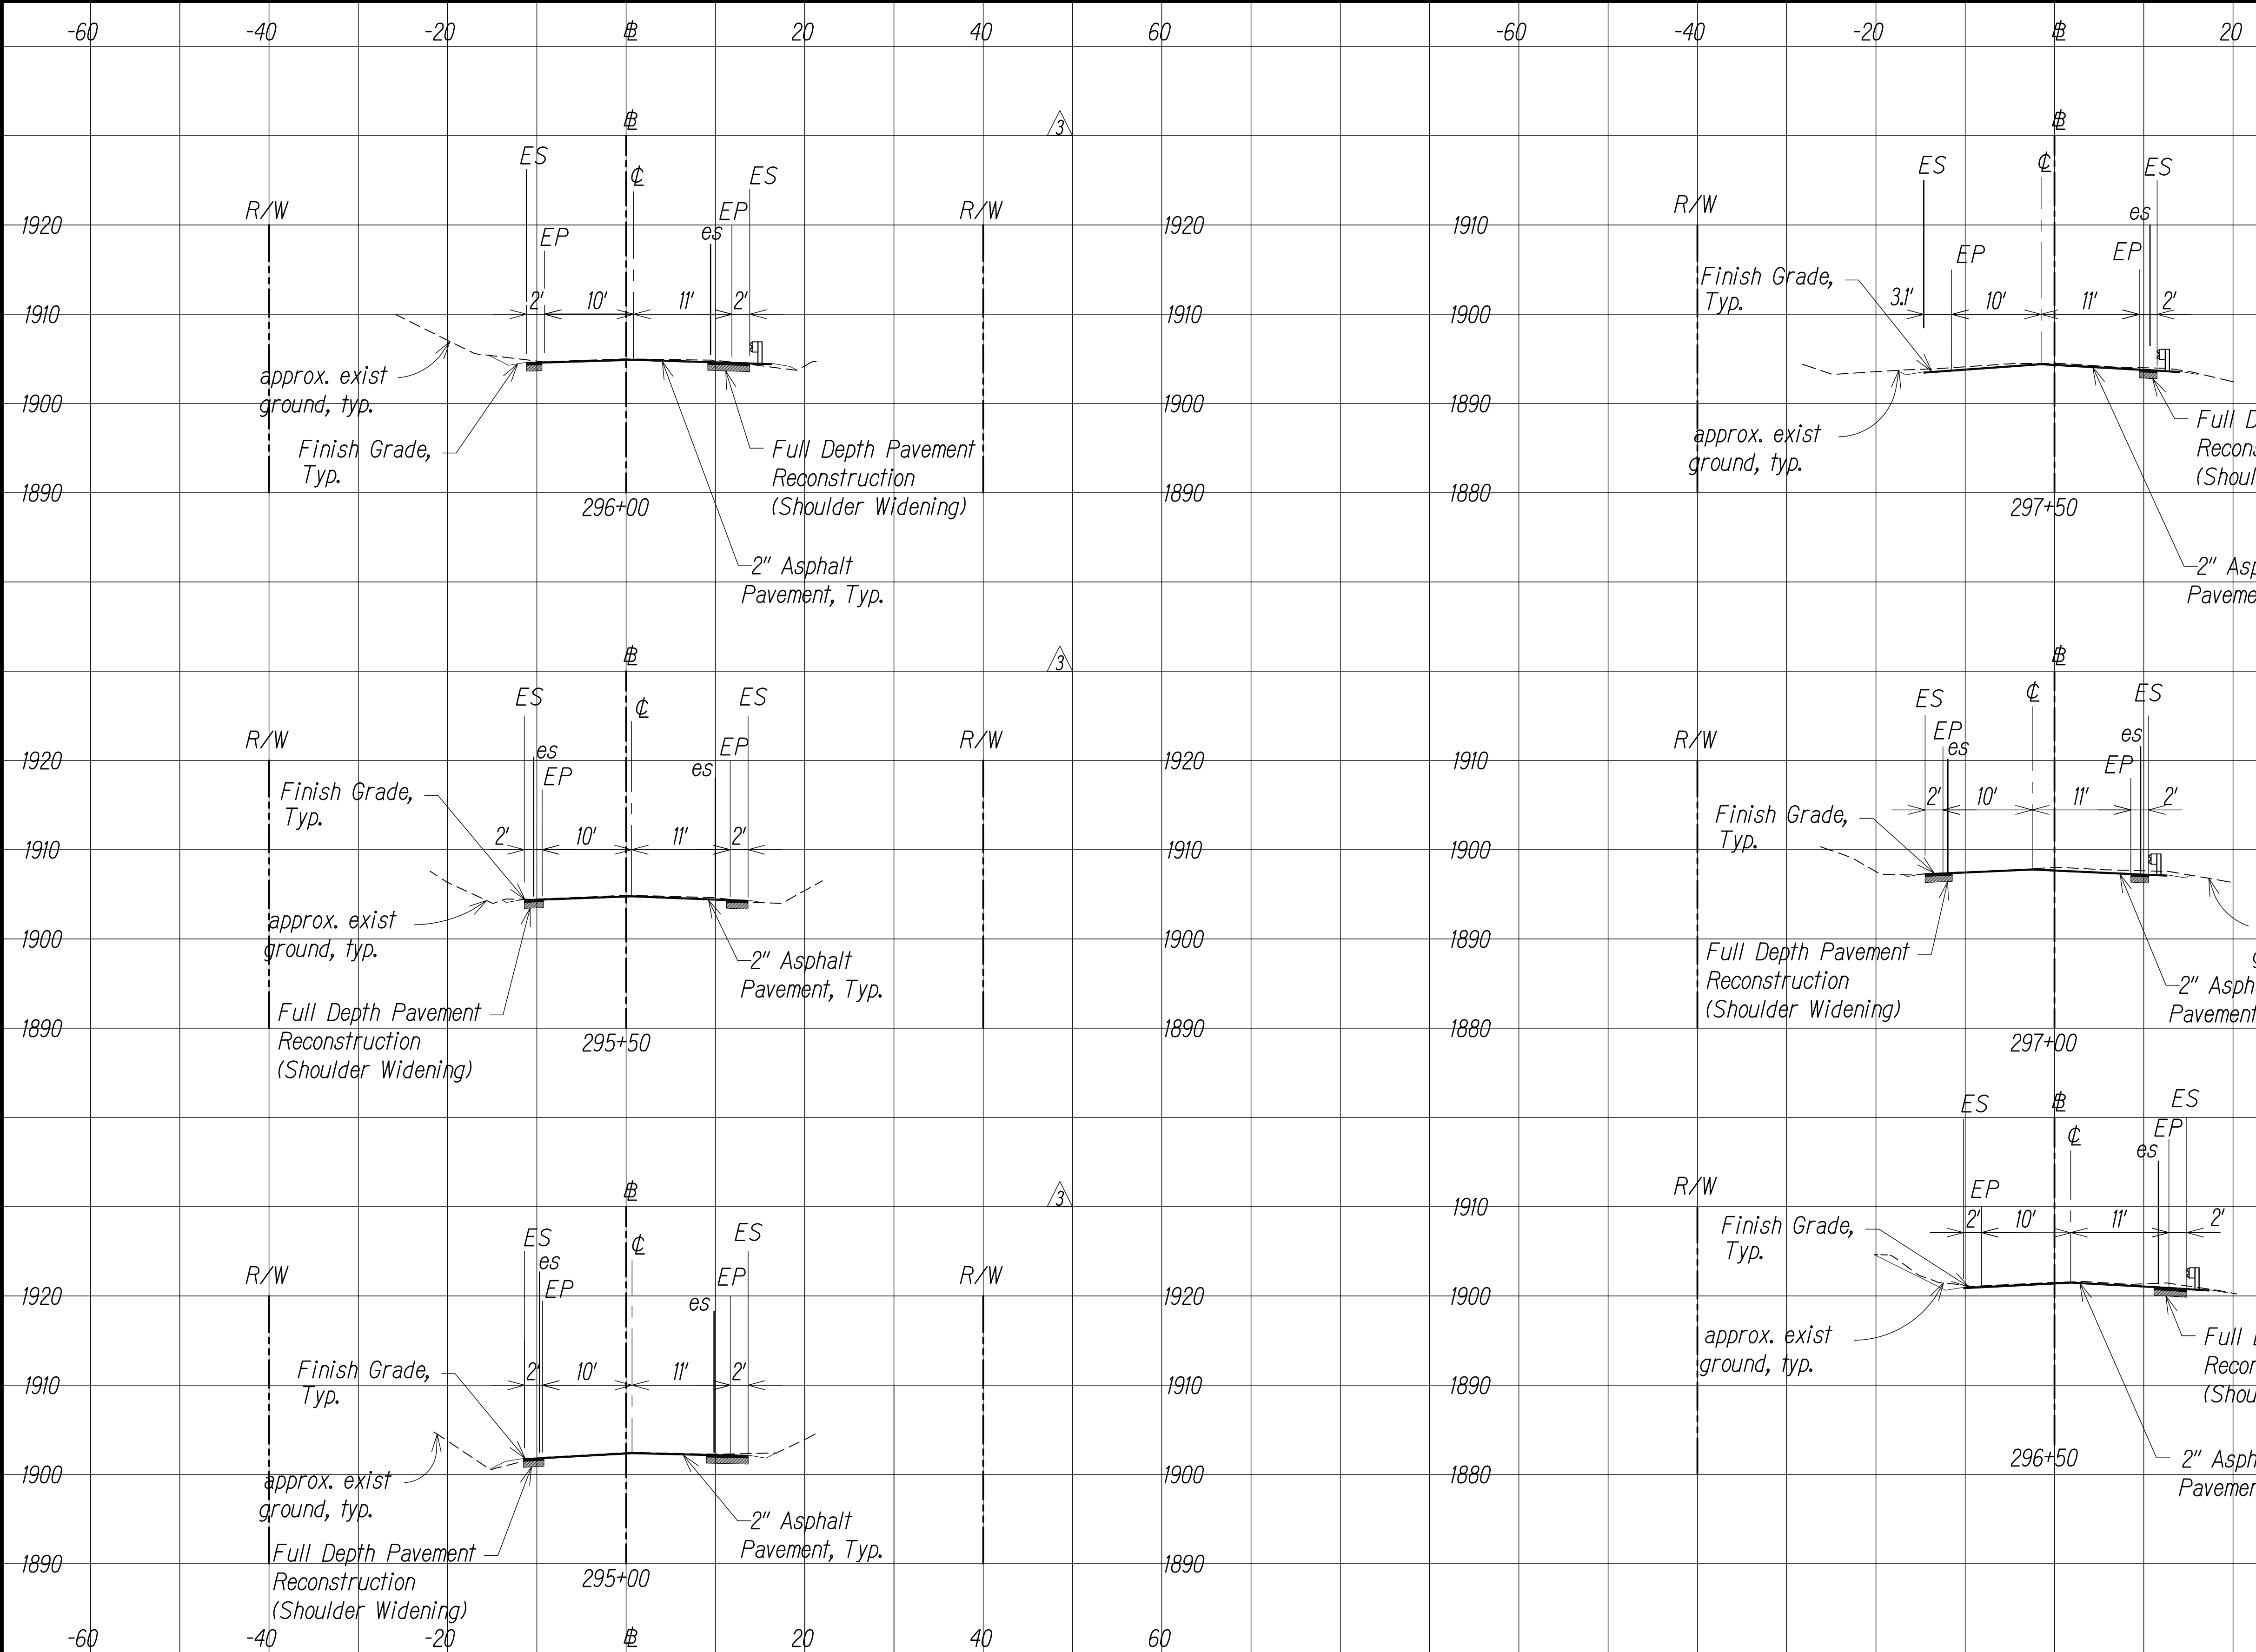

SURVEY PLOTTED BY	DATE
DESIGNED BY	
TRACED BY	
QUANTITIES BY	
CHECKED BY	


ORIGINAL PLAN	No.
NOTE BOOK	

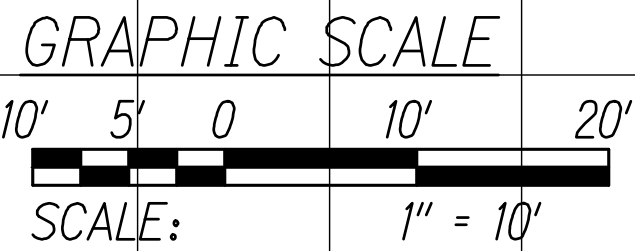

WAIMEA CANYON DRIVE
Scale: 1" = 10'

12/13/24 3 Revised Sections





DATE REVISION

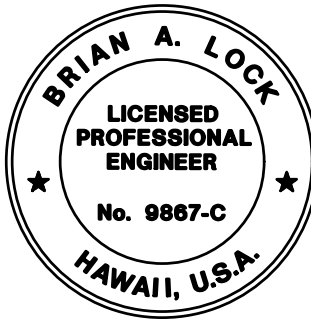

THIS WORK WAS PREPARED BY
ME OR UNDER MY SUPERVISION.
[Signature]
WILSON OKAMOTO CORPORATION
APRIL 30, 2026
LIC. EXP. DATE





STATE OF HAWAII
DEPARTMENT OF TRANSPORTATION
HIGHWAYS DIVISION
ROADWAY CROSS SECTIONS
WAIMEA CANYON DRIVE /
KOEKOE ROAD IMPROVEMENTS, PHASE 2B
MILE POST 4.6 TO MILE POST 11.5
Federal-Aid Project No. STP-0550(006)
Scale: 1" = 10' Date: July 2024
SHEET No. X20 OF 122 SHEETS

DIST. NO.	STATE	FED. AID PROJ. NO.	FISCAL YEAR	SHEET NO.	TOTAL SHEETS
KAUA'I	HAW.	STP-0550(006)	2024	ADD.225	325

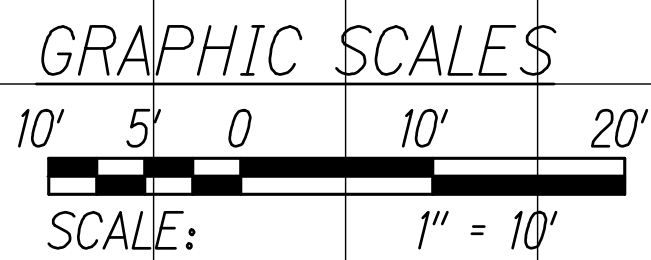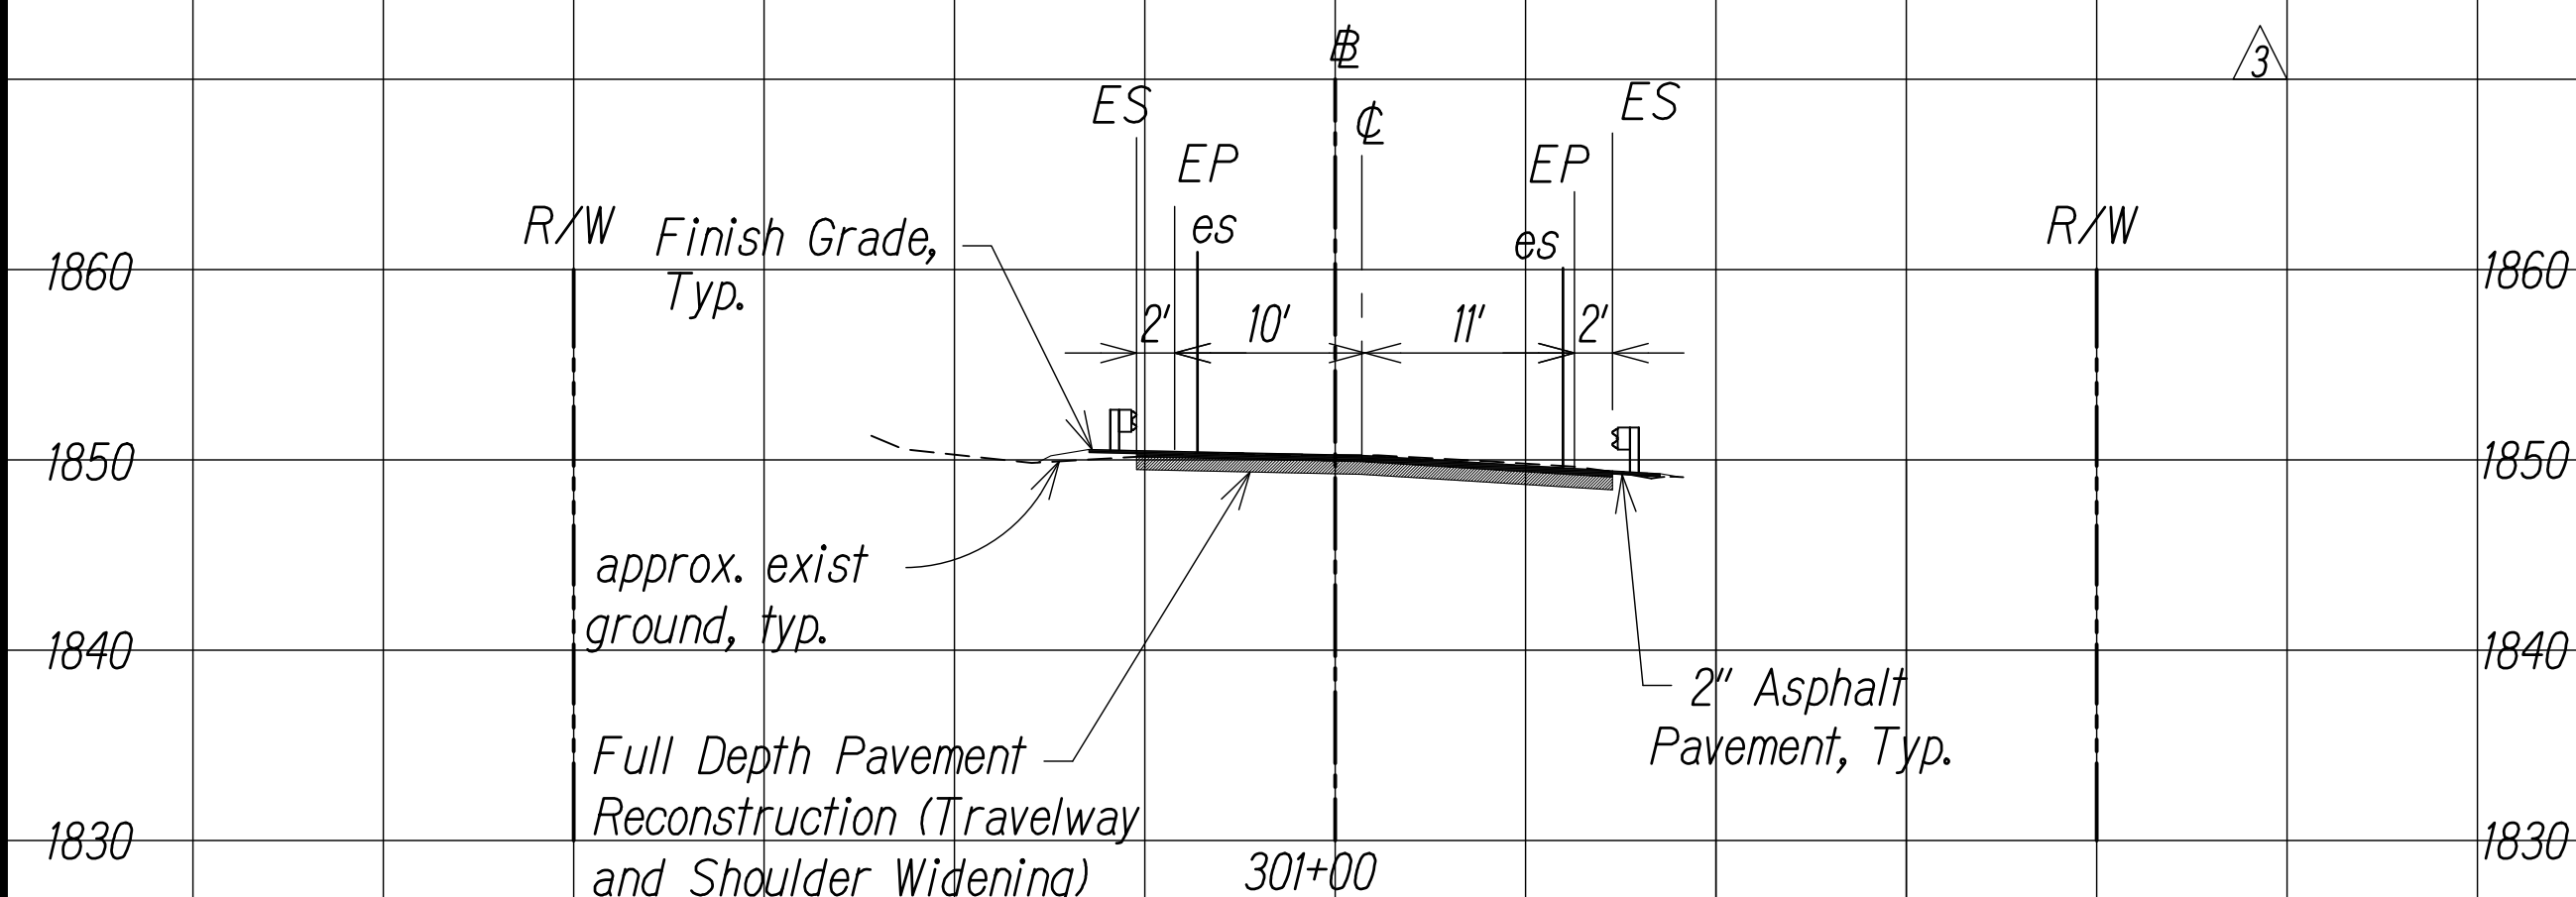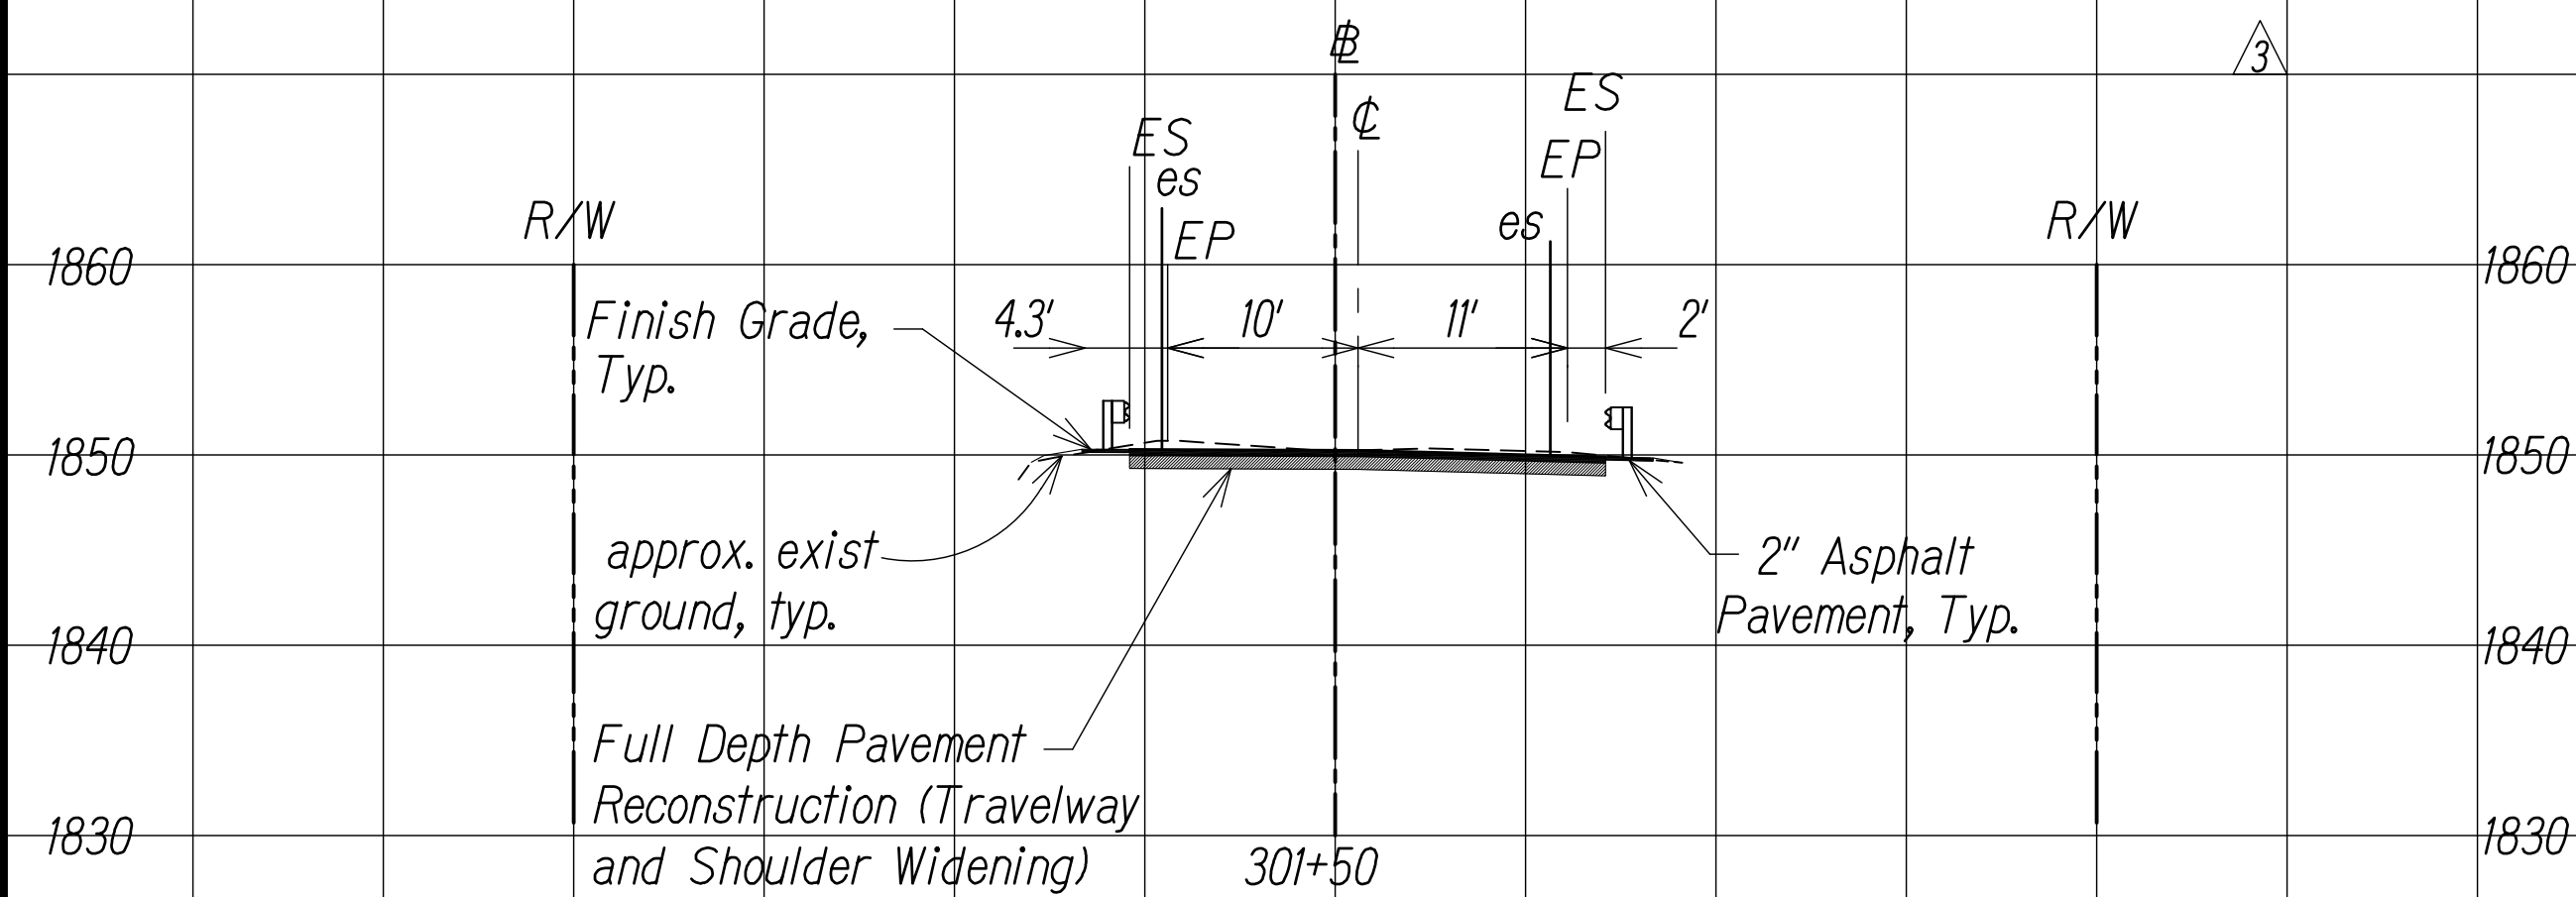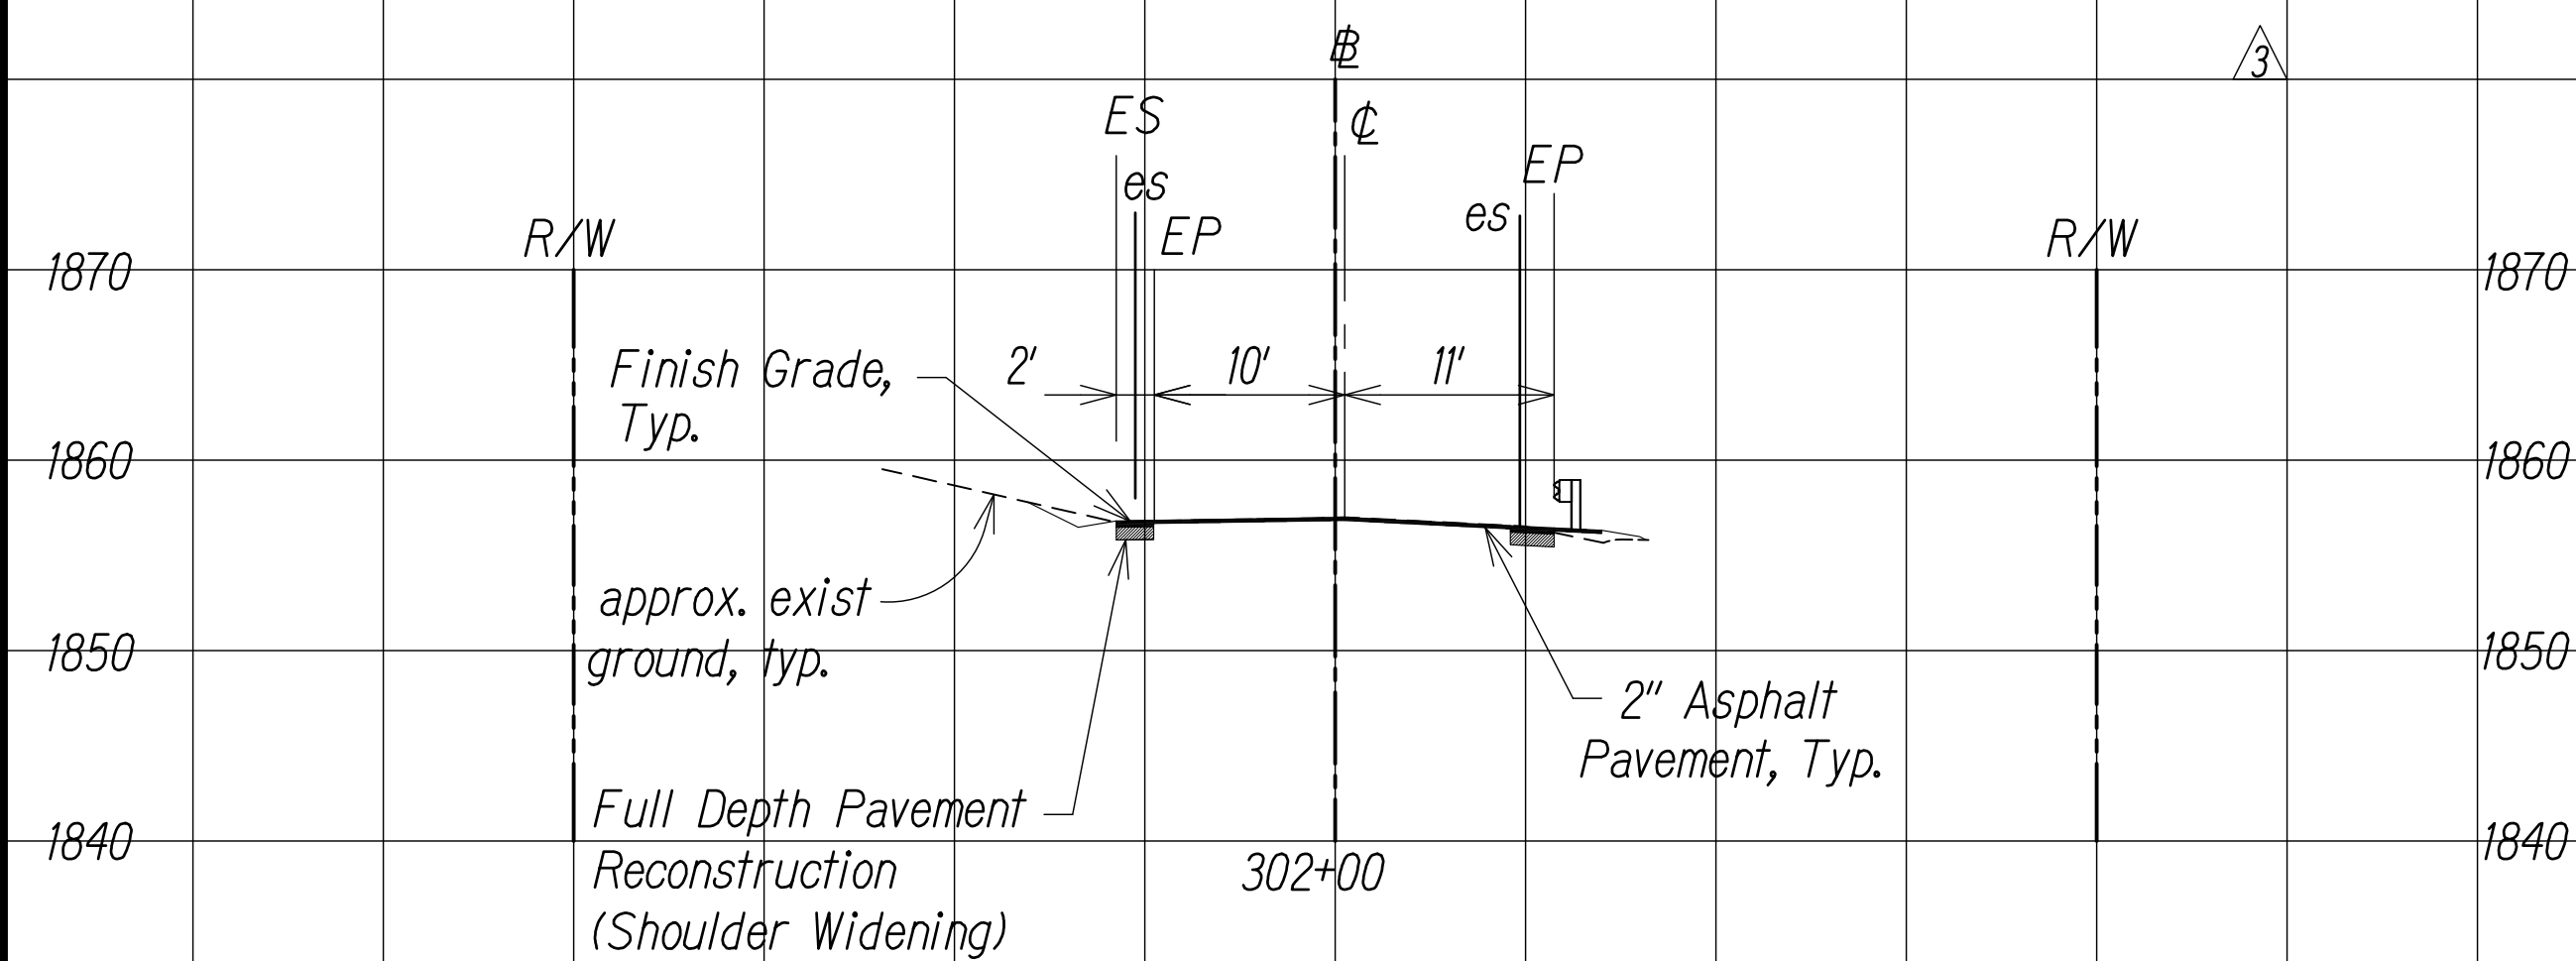

WAIMEA CANYON DRIVE

Scale: 1" = 10'

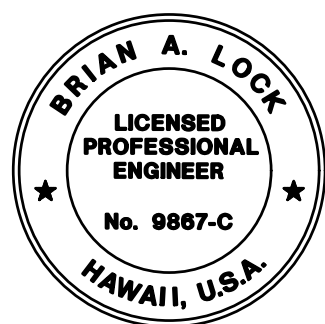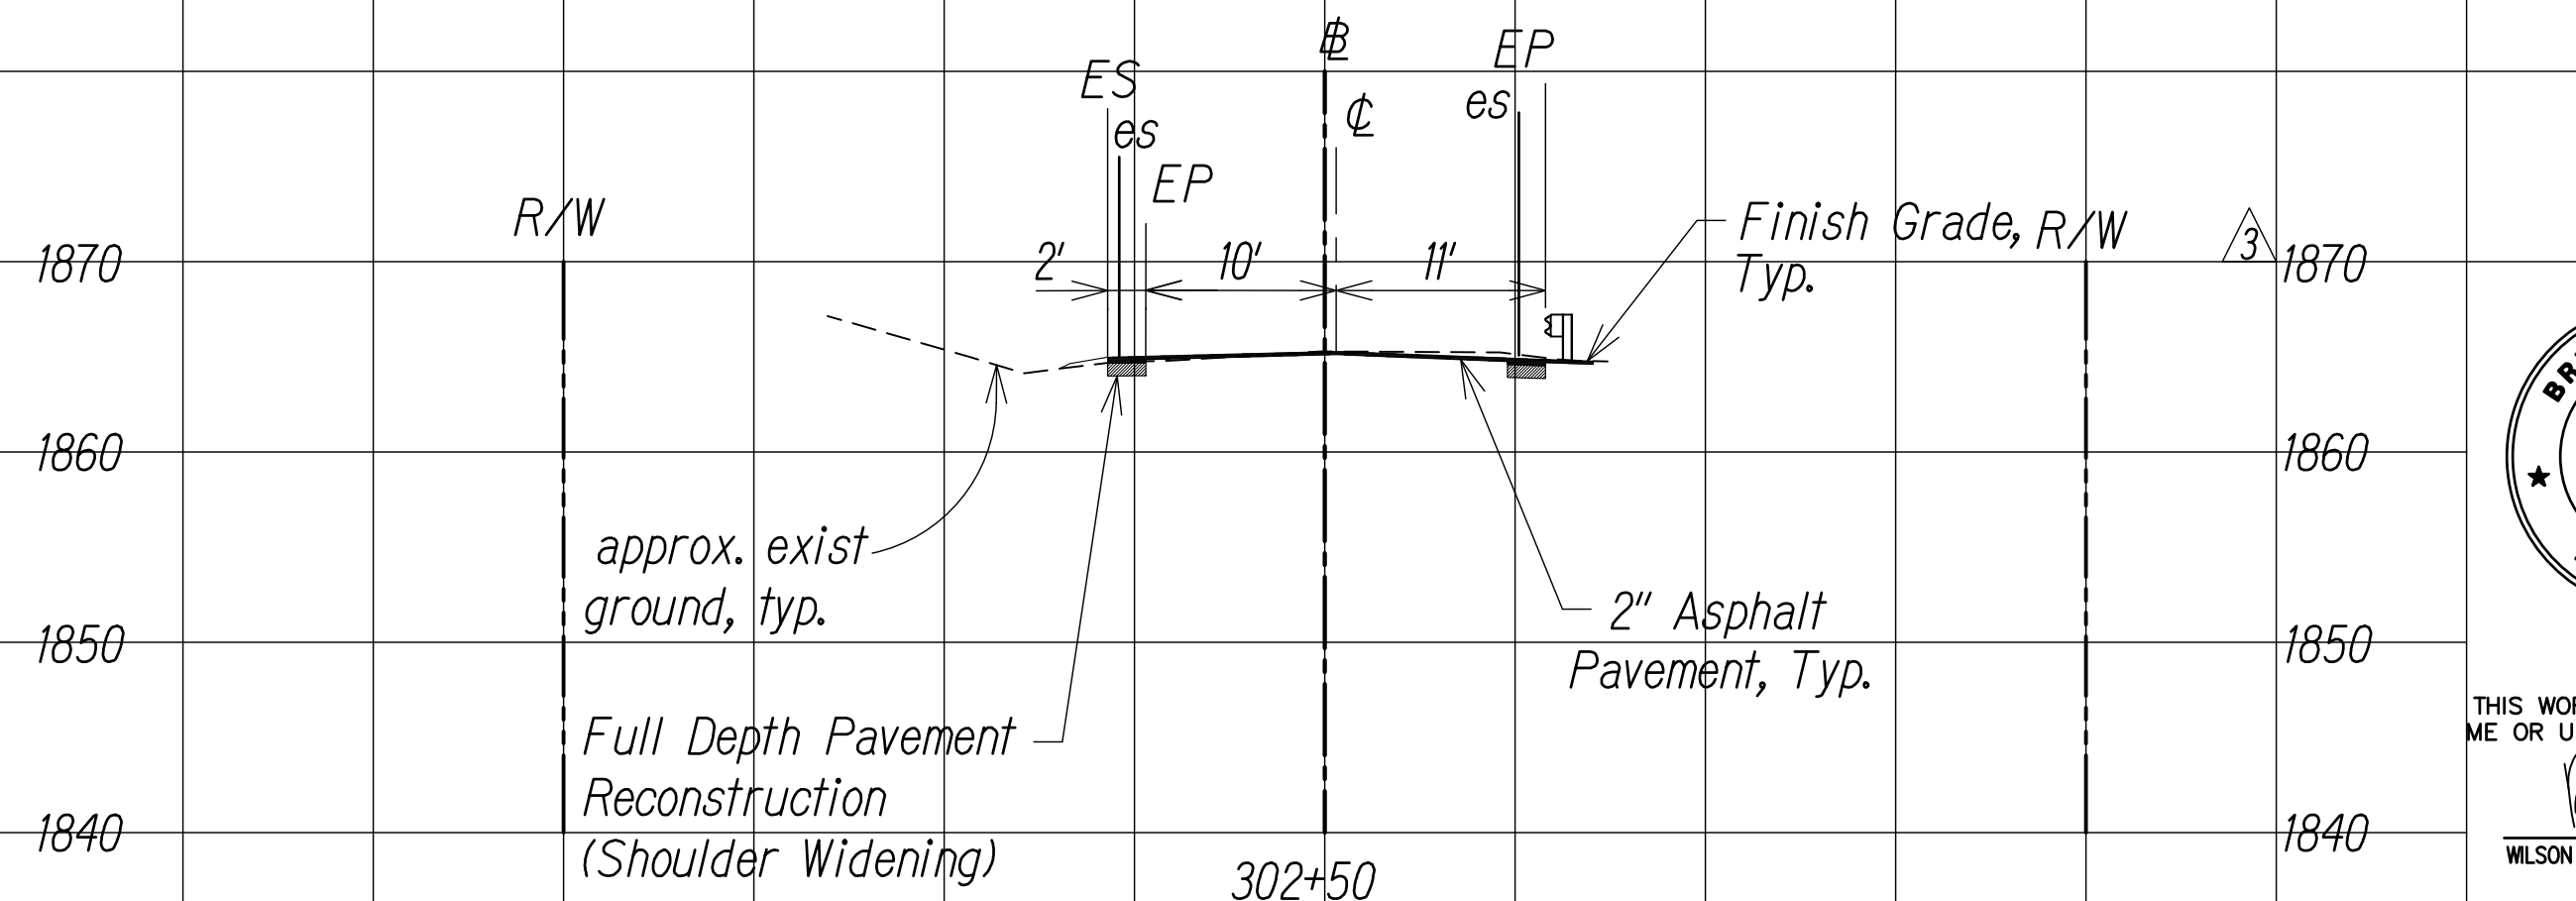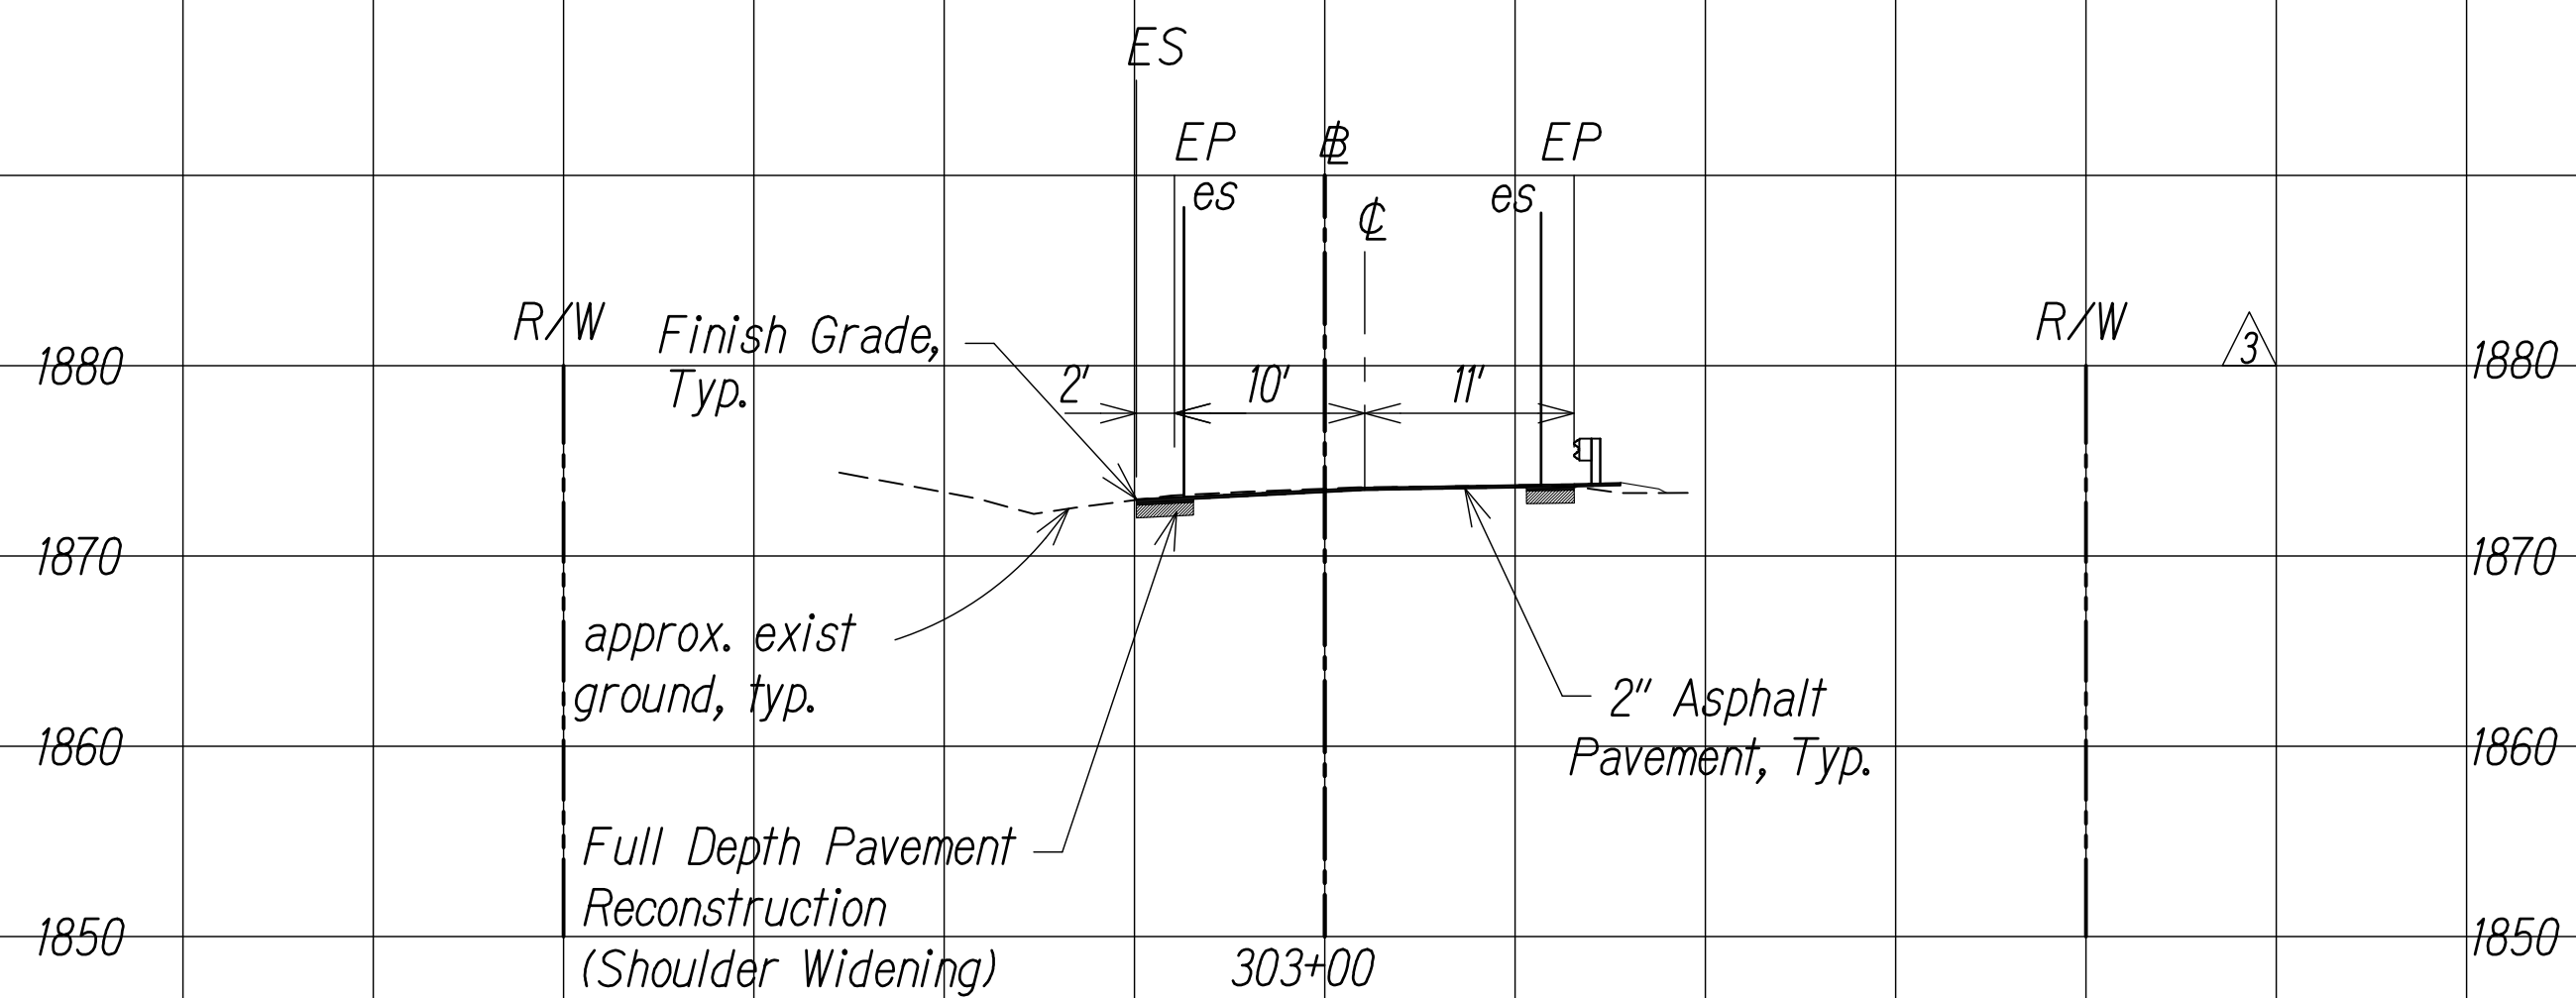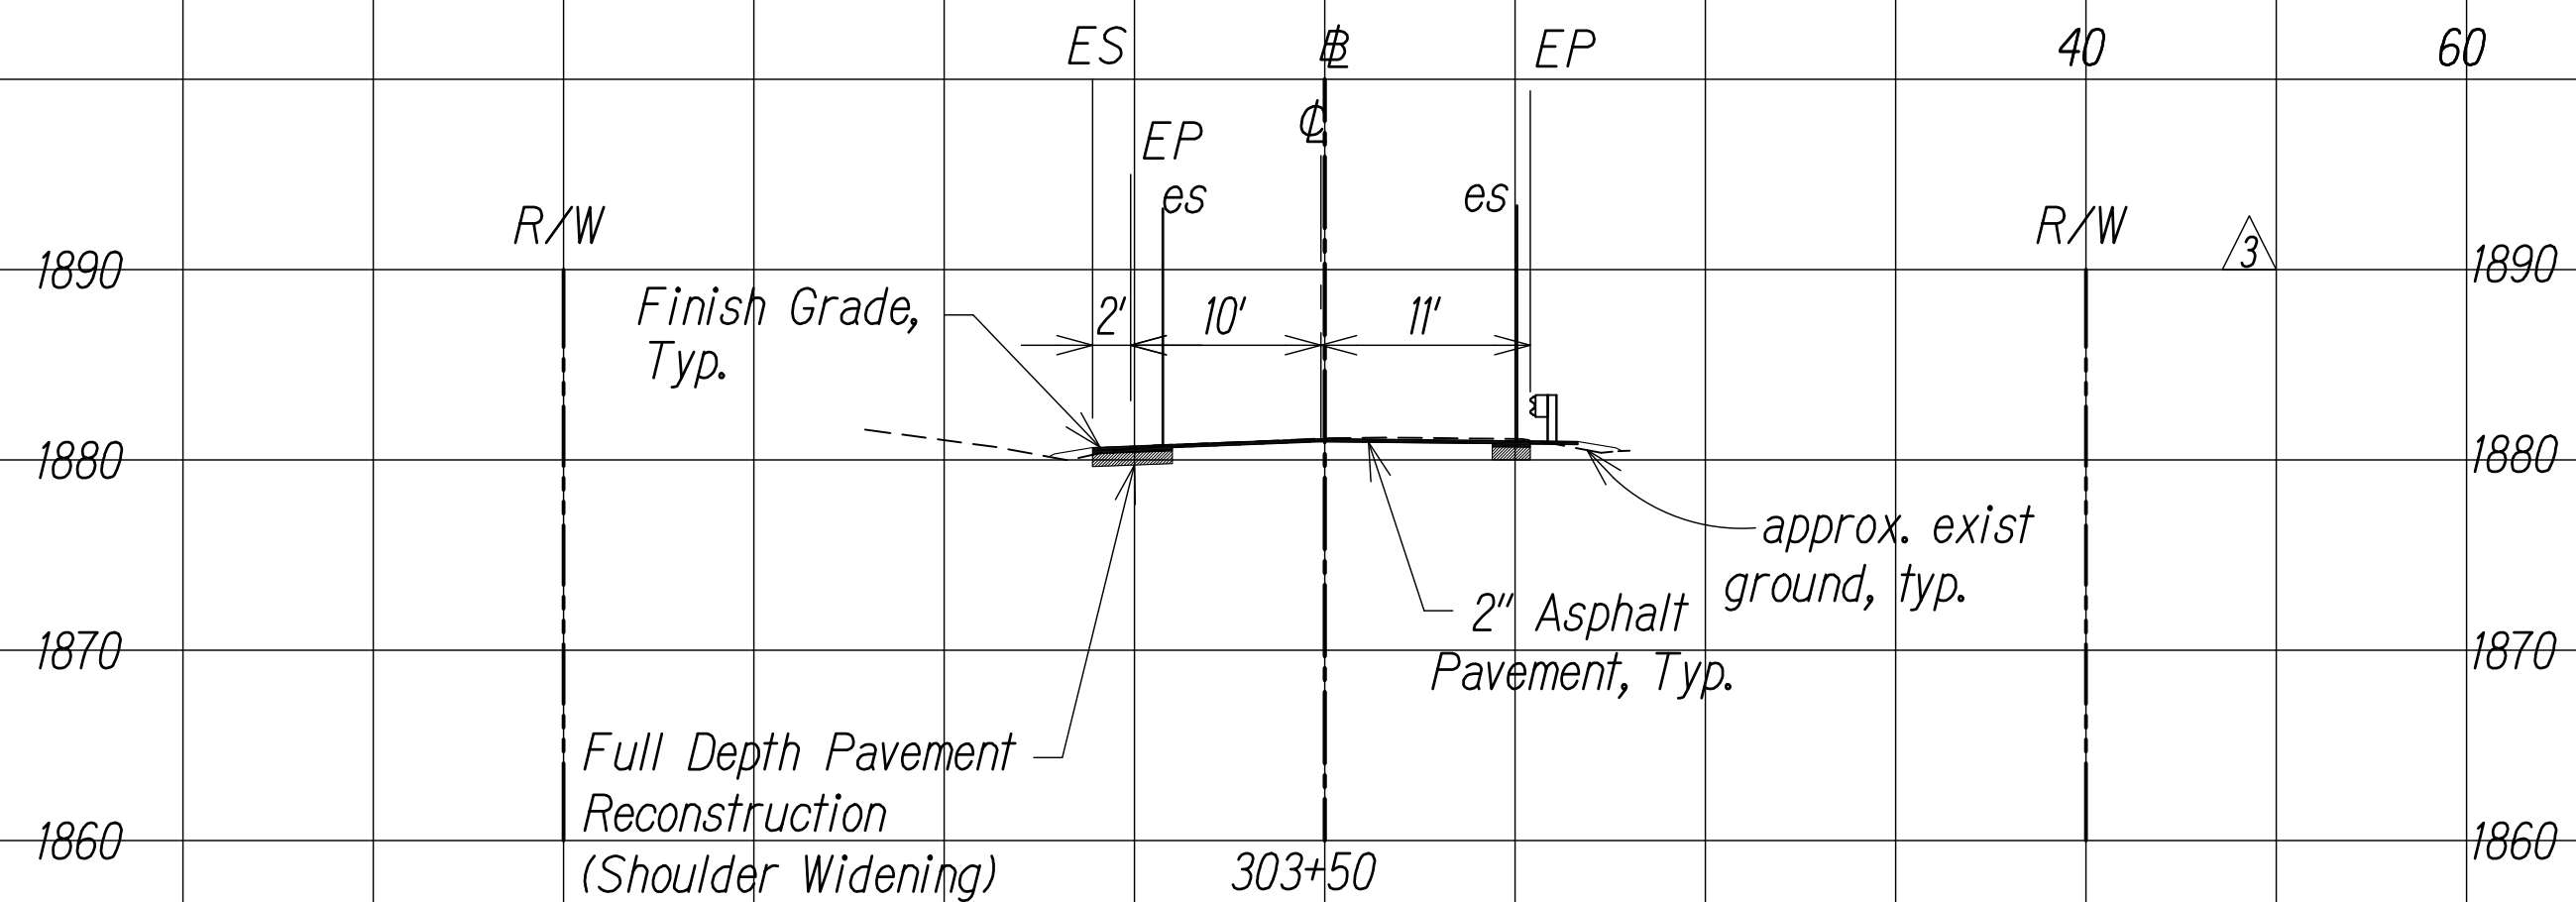

THIS WORK WAS PREPARED BY
ME OR UNDER MY SUPERVISION.

[Signature]

WILSON OKAMOTO CORPORATION
APRIL 30, 2026
LIC. EXP. DATE

STATE OF HAWAII
DEPARTMENT OF TRANSPORTATION
HIGHWAYS DIVISION

ROADWAY CROSS SECTIONS

WAIMEA CANYON DRIVE /
KOEKOE ROAD IMPROVEMENTS, PHASE 2B
MILE POST 4.6 TO MILE POST 11.5
Federal-Aid Project No. STP-0550(006)
Scale: 1" = 10' Date: July 2024

12/13/24 3 Revised Sections

DATE REVISION


SHEET No. X22 OF 122 SHEETS

ADD225


SURVEY PLOTTED BY	DATE
DESIGNED BY	
TRACED BY	
NOTED BY	
QUANTITIES BY	
CHECKED BY	

ORIGINAL PLAN	No.
NOTE BOOK	

DIST. NO.	STATE	FED. AID PROJ. NO.	FISCAL YEAR	SHEET NO.	TOTAL SHEETS
KAUA1	HAW.	STP-0550(006)	2024	ADD.226	325

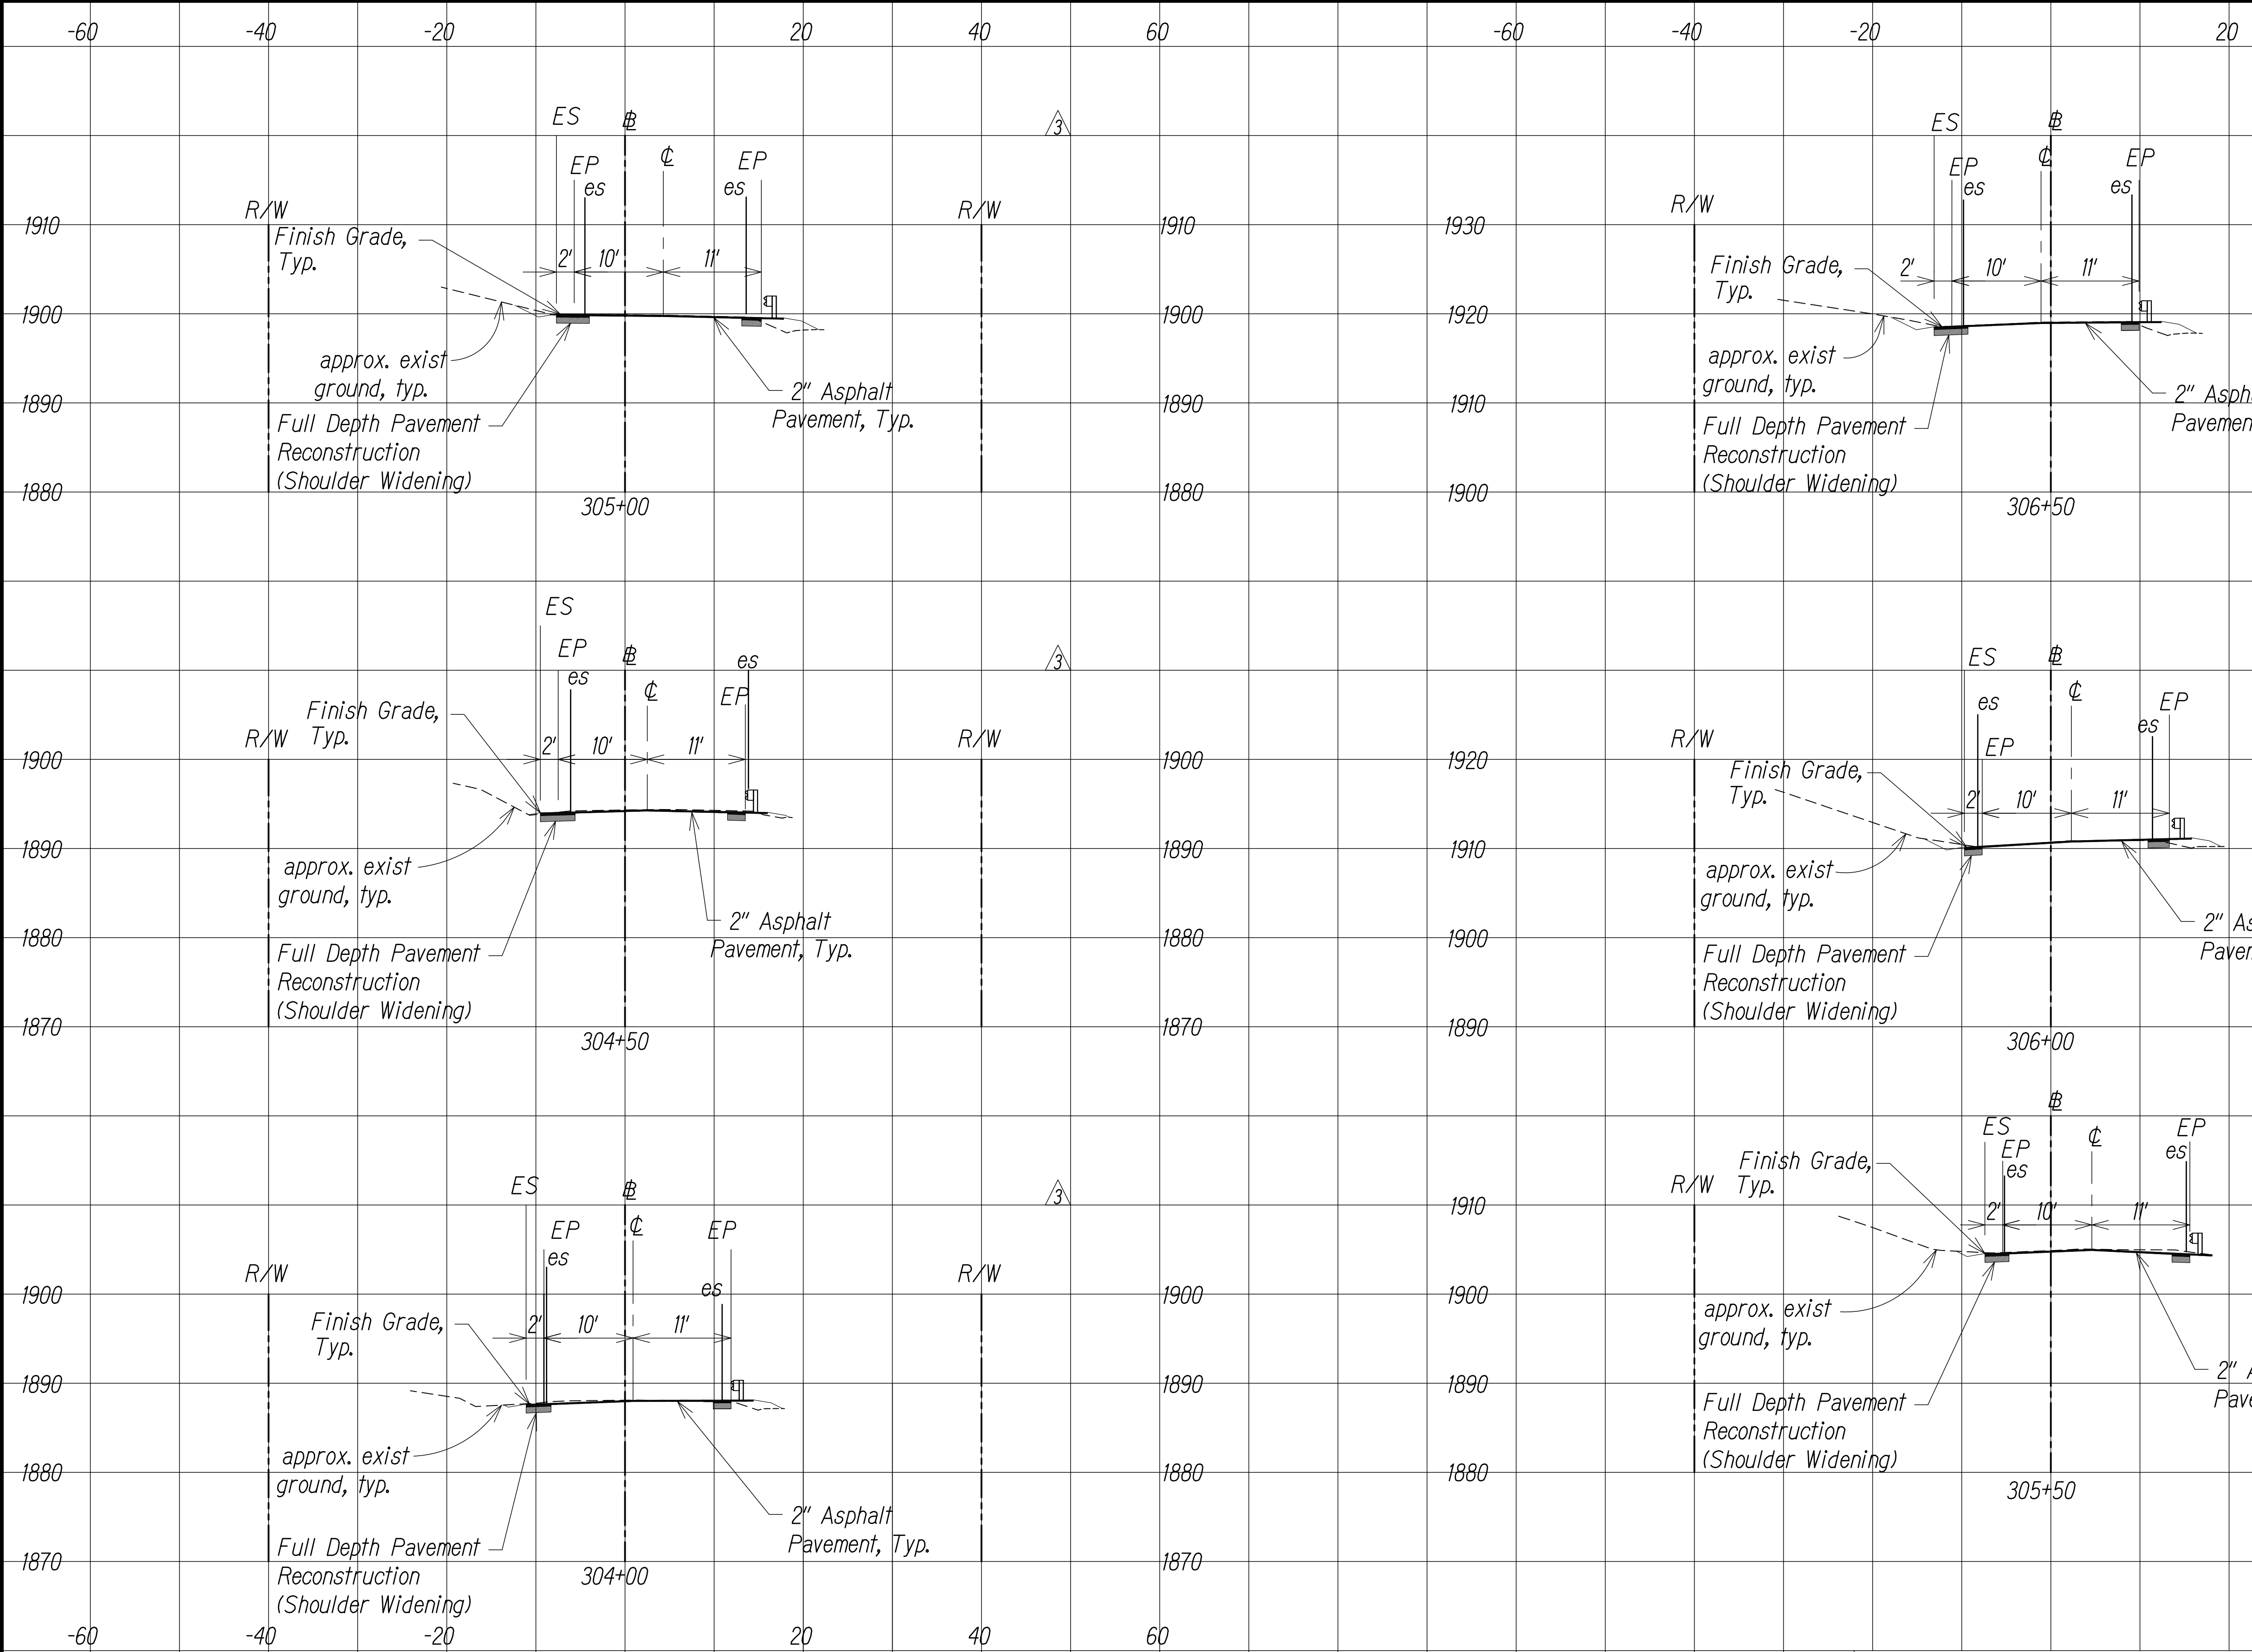


SURVEY PLOTTED BY	DATE
DESIGNED BY	
TRACED BY	
QUANTITIES BY	
CHECKED BY	
NOTE BOOK	
No.	

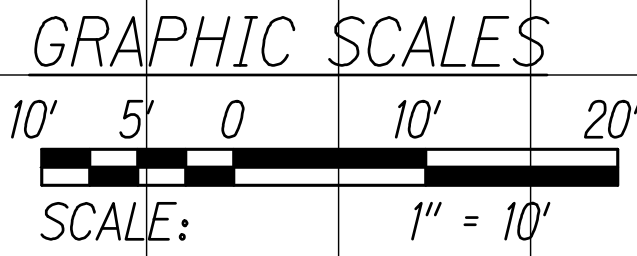

WAIMEA CANYON DRIVE
Scale: 1" = 10'

12/13/24 3 Revised Sections


DATE	REVISION
------	----------

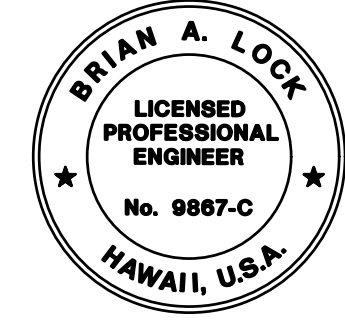

THIS WORK WAS PREPARED BY
ME OR UNDER MY SUPERVISION.
[Signature]
WILSON OKAMOTO CORPORATION
APRIL 30, 2026
LIC. EXP. DATE


STATE OF HAWAII
DEPARTMENT OF TRANSPORTATION
HIGHWAYS DIVISION
ROADWAY CROSS SECTIONS
WAIMEA CANYON DRIVE /
KOEKE ROAD IMPROVEMENTS, PHASE 2B
MILE POST 4.6 TO MILE POST 11.5
Federal-Aid Project No. STP-0550(006)
Scale: 1" = 10' Date: July 2024

SHEET No. X23 OF 122 SHEETS

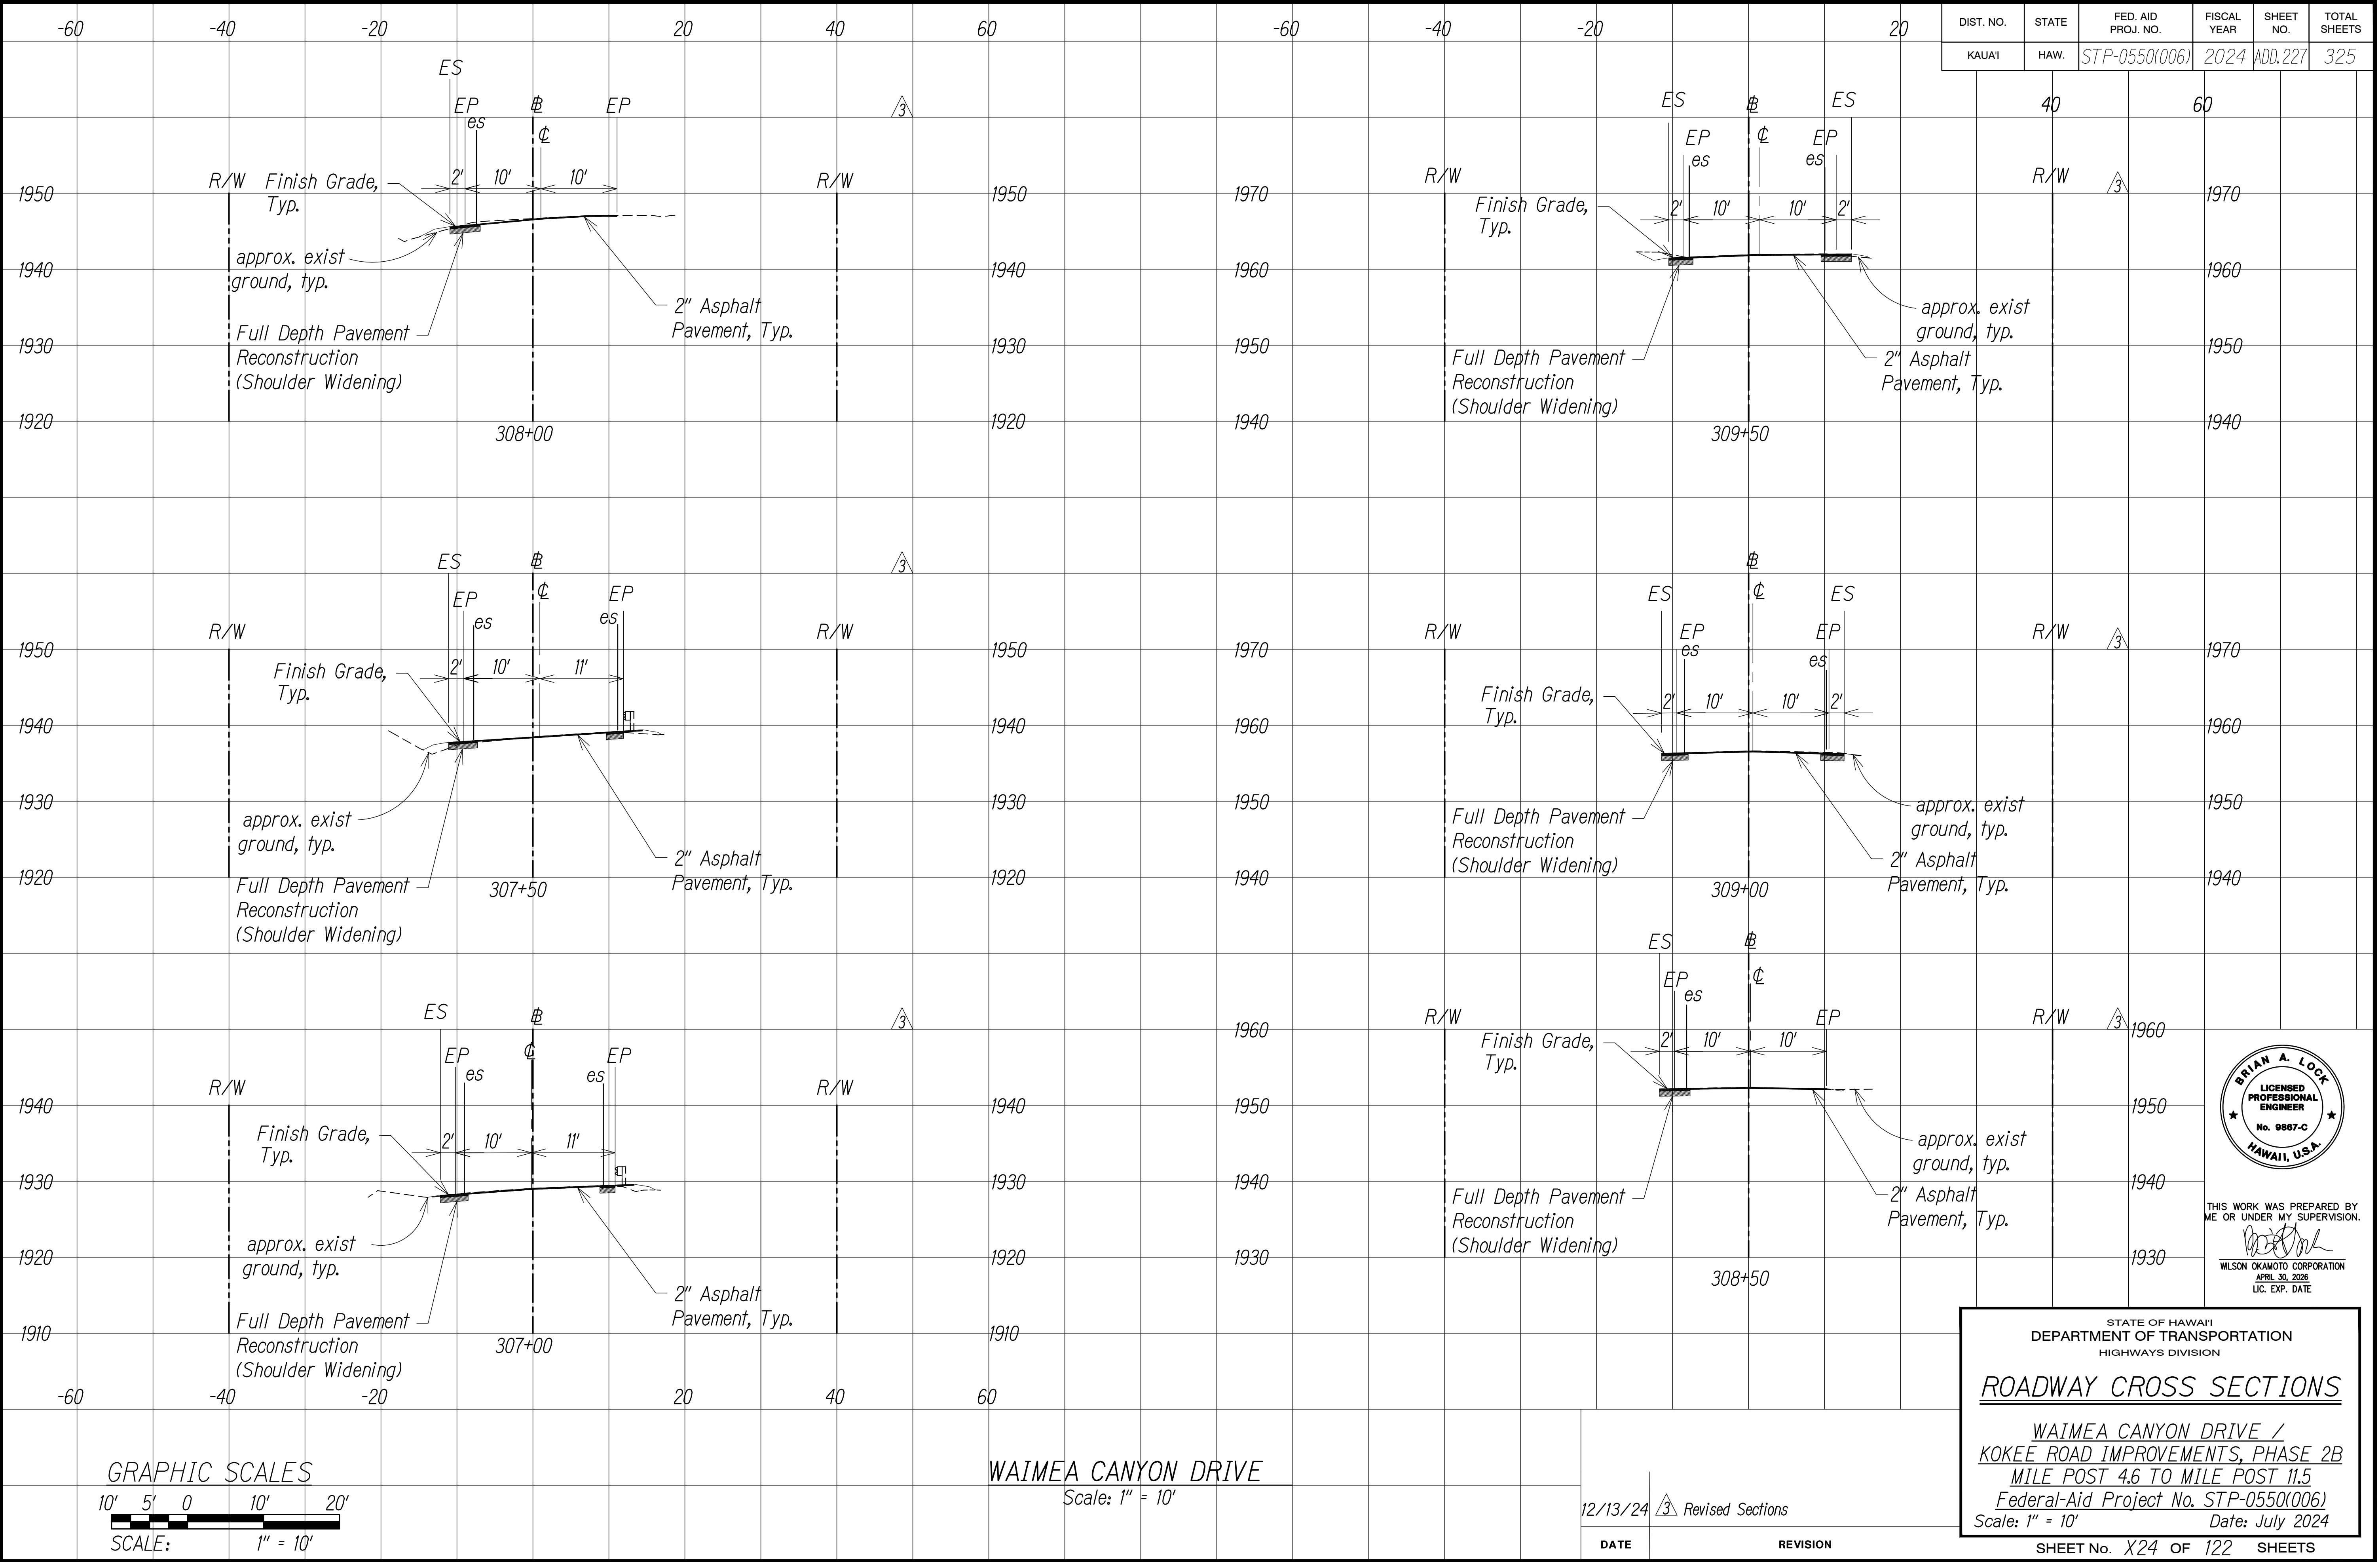

DIST. NO.	STATE	FED. AID PROJ. NO.	FISCAL YEAR	SHEET NO.	TOTAL SHEETS
KAUA'I	HAW.	STP-0550(006)	2024	ADD.227	325

SURVEY PLOTTED BY	DATE
DESIGNED BY	
TRACED BY	
QUANTITIES BY	
CHECKED BY	
ORIGINAL PLAN	
NOTE BOOK	
No.	

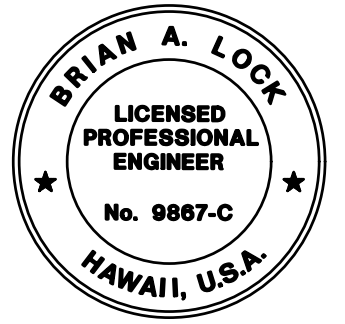

THIS WORK WAS PREPARED BY
ME OR UNDER MY SUPERVISION.
[Signature]
WILSON OKAMOTO CORPORATION
APRIL 30, 2026
LIC. EXP. DATE



STATE OF HAWAII
DEPARTMENT OF TRANSPORTATION
HIGHWAYS DIVISION
ROADWAY CROSS SECTIONS
WAIMEA CANYON DRIVE /
KOKEE ROAD IMPROVEMENTS, PHASE 2B
MILE POST 4.6 TO MILE POST 11.5
Federal-Aid Project No. STP-0550(006)
Scale: 1" = 10' Date: July 2024

12/13/24 3 Revised Sections

DATE	REVISION
------	----------


SHEET No. X24 OF 122 SHEETS

DIST. NO.	STATE	FED. AID PROJ. NO.	FISCAL YEAR	SHEET NO.	TOTAL SHEETS
KAUA'I	HAW.	STP-0550(006)	2024	ADD.228	325

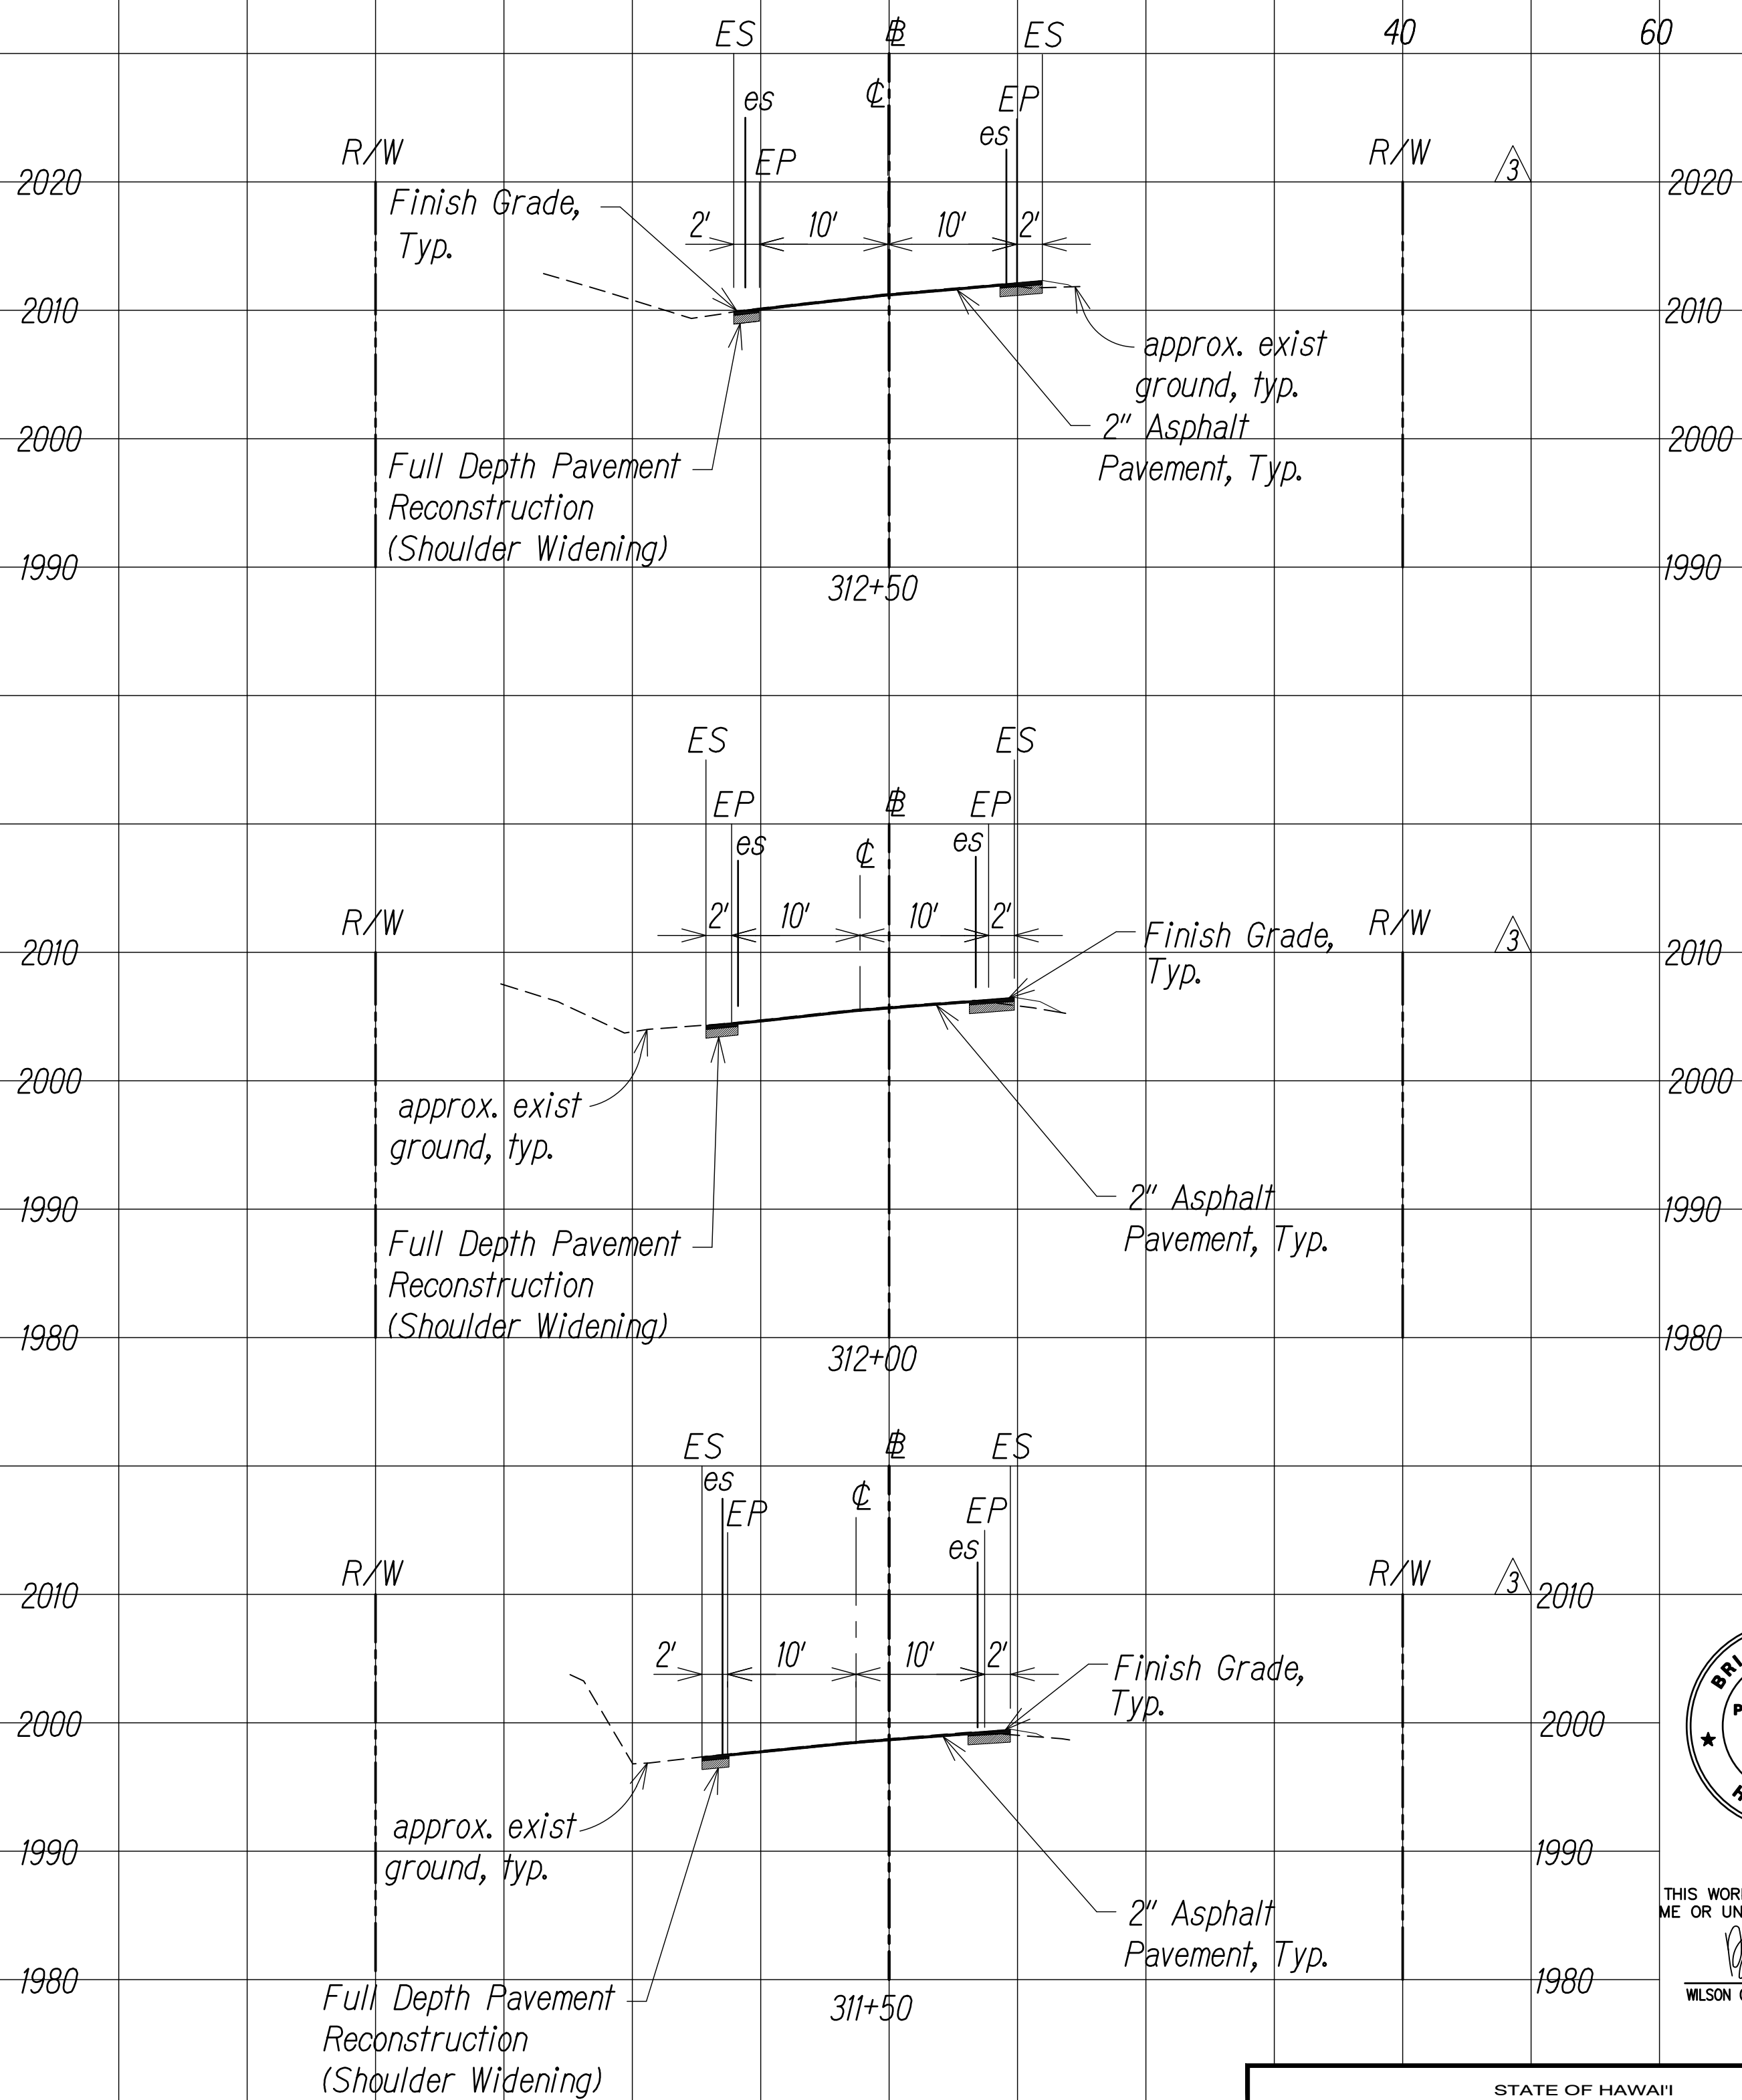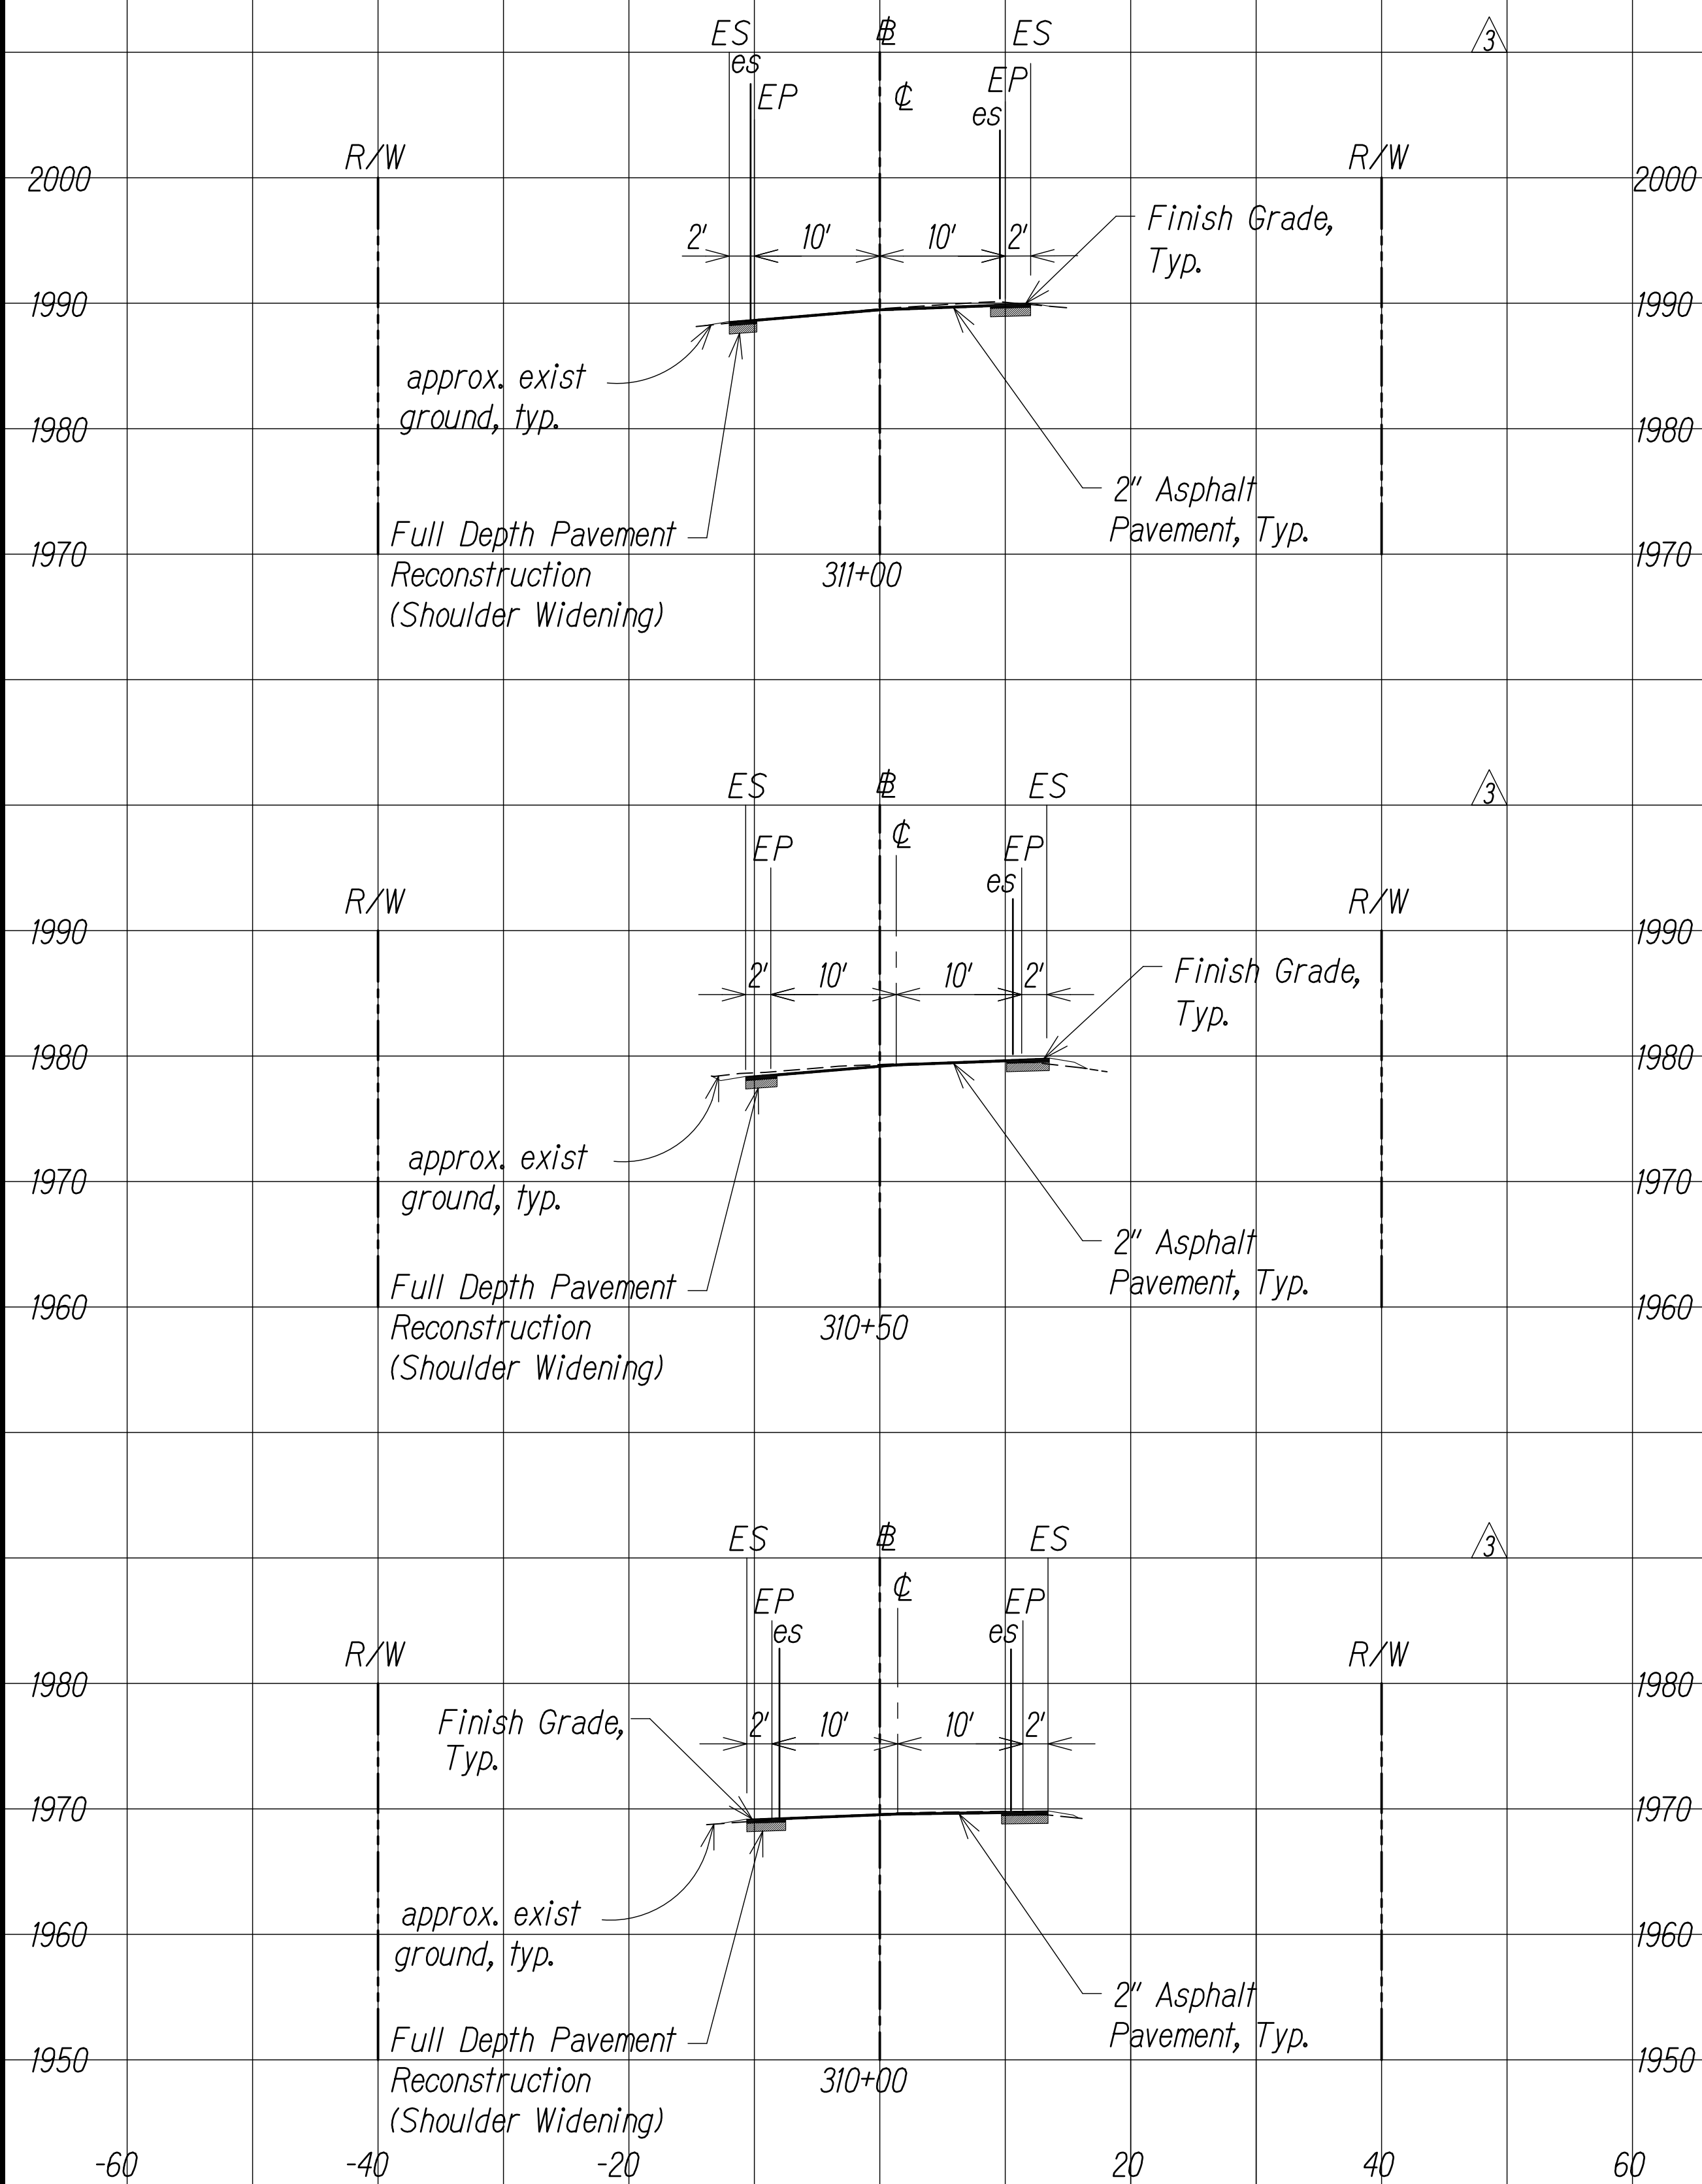


SURVEY PLOTTED BY	DATE
DESIGNED BY	
TRACED BY	
QUANTITIES BY	
CHECKED BY	

ORIGINAL PLAN	No.
NOTE BOOK	

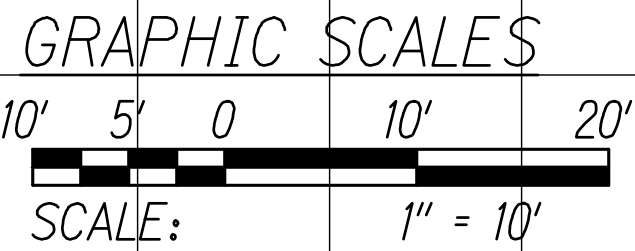

WAIMEA CANYON DRIVE
Scale: 1" = 10'

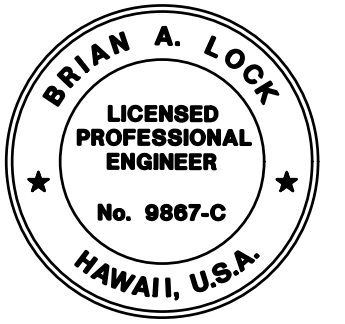


THIS WORK WAS PREPARED BY
ME OR UNDER MY SUPERVISION.
[Signature]
WILSON OKAMOTO CORPORATION
APRIL 30, 2026
LIC. EXP. DATE

STATE OF HAWAII
DEPARTMENT OF TRANSPORTATION
HIGHWAYS DIVISION
ROADWAY CROSS SECTIONS
WAIMEA CANYON DRIVE /
KOEKE ROAD IMPROVEMENTS, PHASE 2B
MILE POST 4.6 TO MILE POST 11.5
Federal-Aid Project No. STP-0550(006)
Scale: 1" = 10' Date: July 2024


12/13/24 3 Revised Sections

DATE REVISION

SHEET No. X25 OF 122 SHEETS

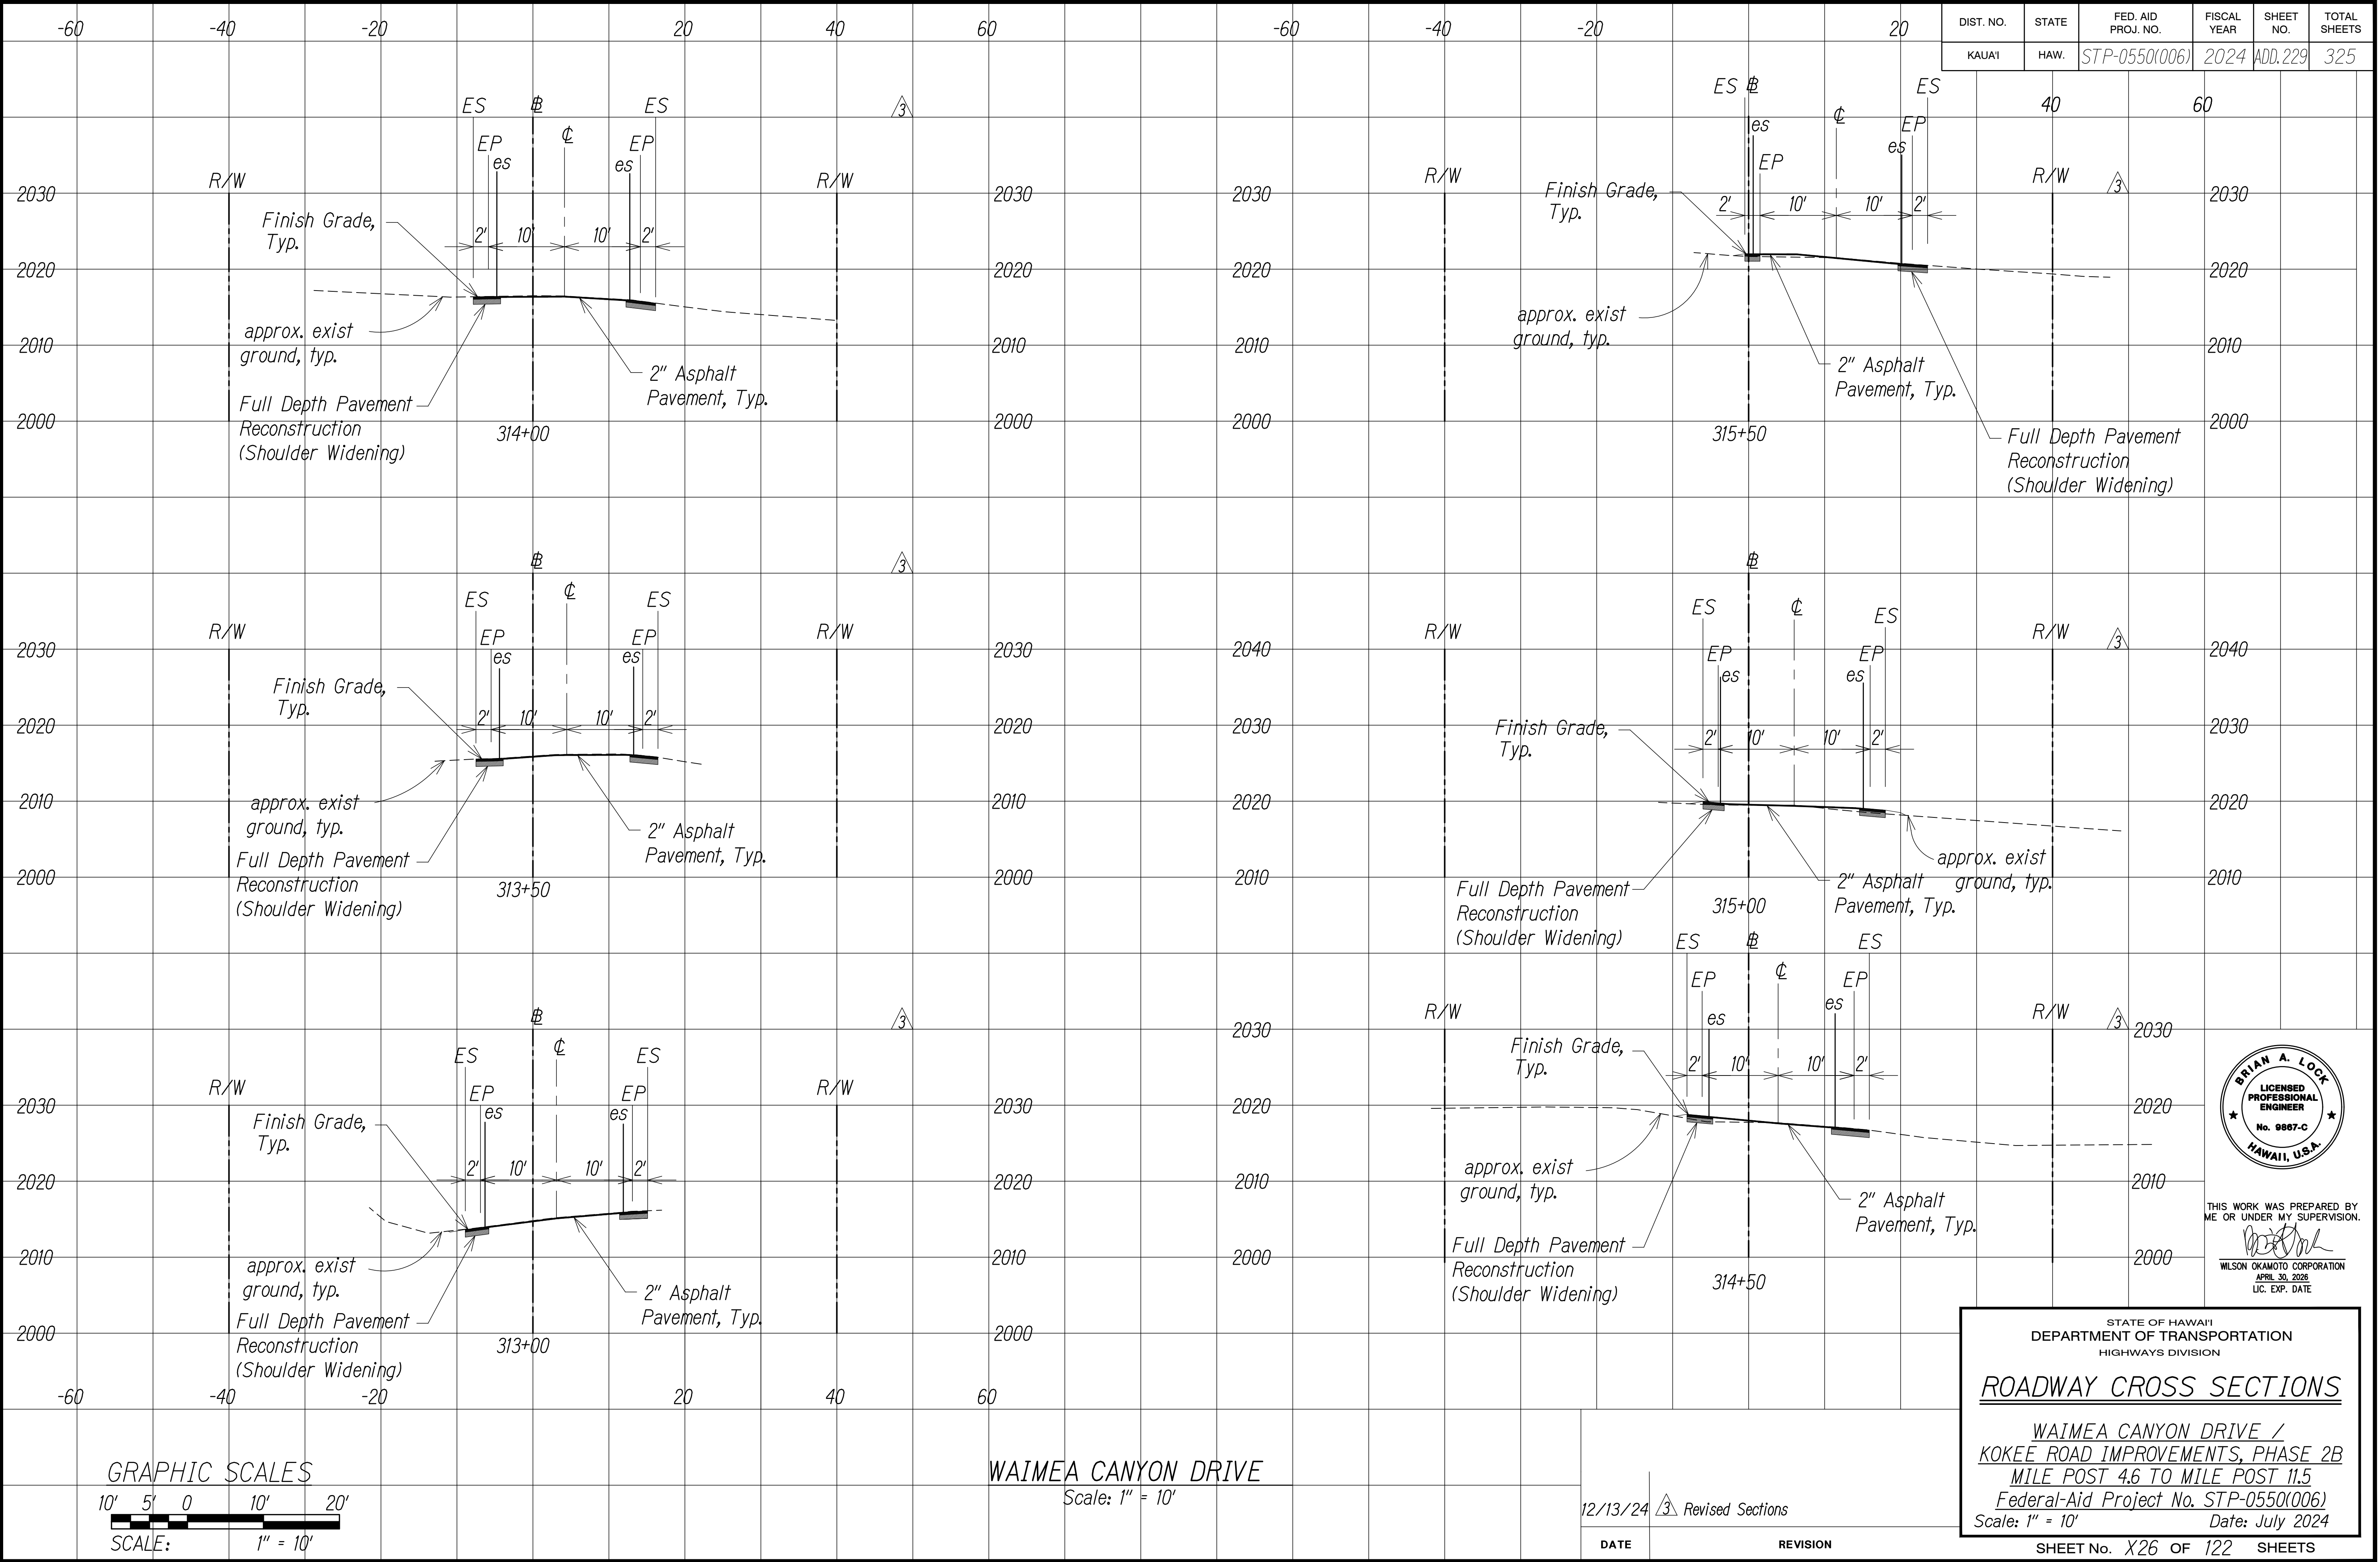

ORIGINAL PLAN	SURVEY PLOTTED BY	DATE
NOTE BOOK	DESIGNED BY	
No.	QUANTITIES BY	
	CHECKED BY	

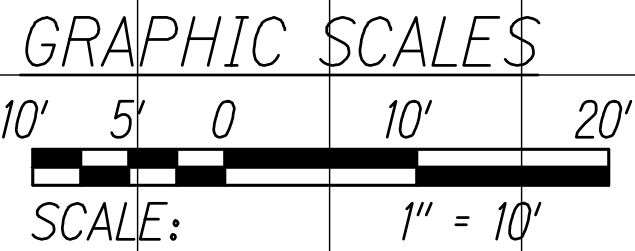


WAIMEA CANYON DRIVE
Scale: 1" = 10'

12/13/24 3 Revised Sections

DATE REVISION


STATE OF HAWAII
DEPARTMENT OF TRANSPORTATION
HIGHWAYS DIVISION
ROADWAY CROSS SECTIONS
WAIMEA CANYON DRIVE /
KOEKE ROAD IMPROVEMENTS, PHASE 2B
MILE POST 4.6 TO MILE POST 11.5
Federal-Aid Project No. STP-0550(006)
Scale: 1" = 10' Date: July 2024

SHEET No. X26 OF 122 SHEETS

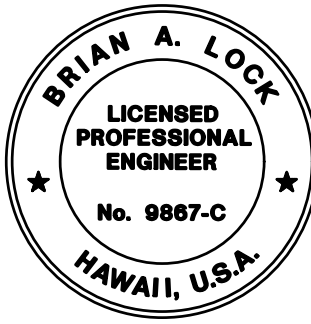


THIS WORK WAS PREPARED BY
ME OR UNDER MY SUPERVISION.
[Signature]
WILSON OKAMOTO CORPORATION
APRIL 30, 2026
LIC. EXP. DATE

DIST. NO.	STATE	FED. AID PROJ. NO.	FISCAL YEAR	SHEET NO.	TOTAL SHEETS
KAUAI	HAW.	STP-0550(006)	2024	ADD.229	325

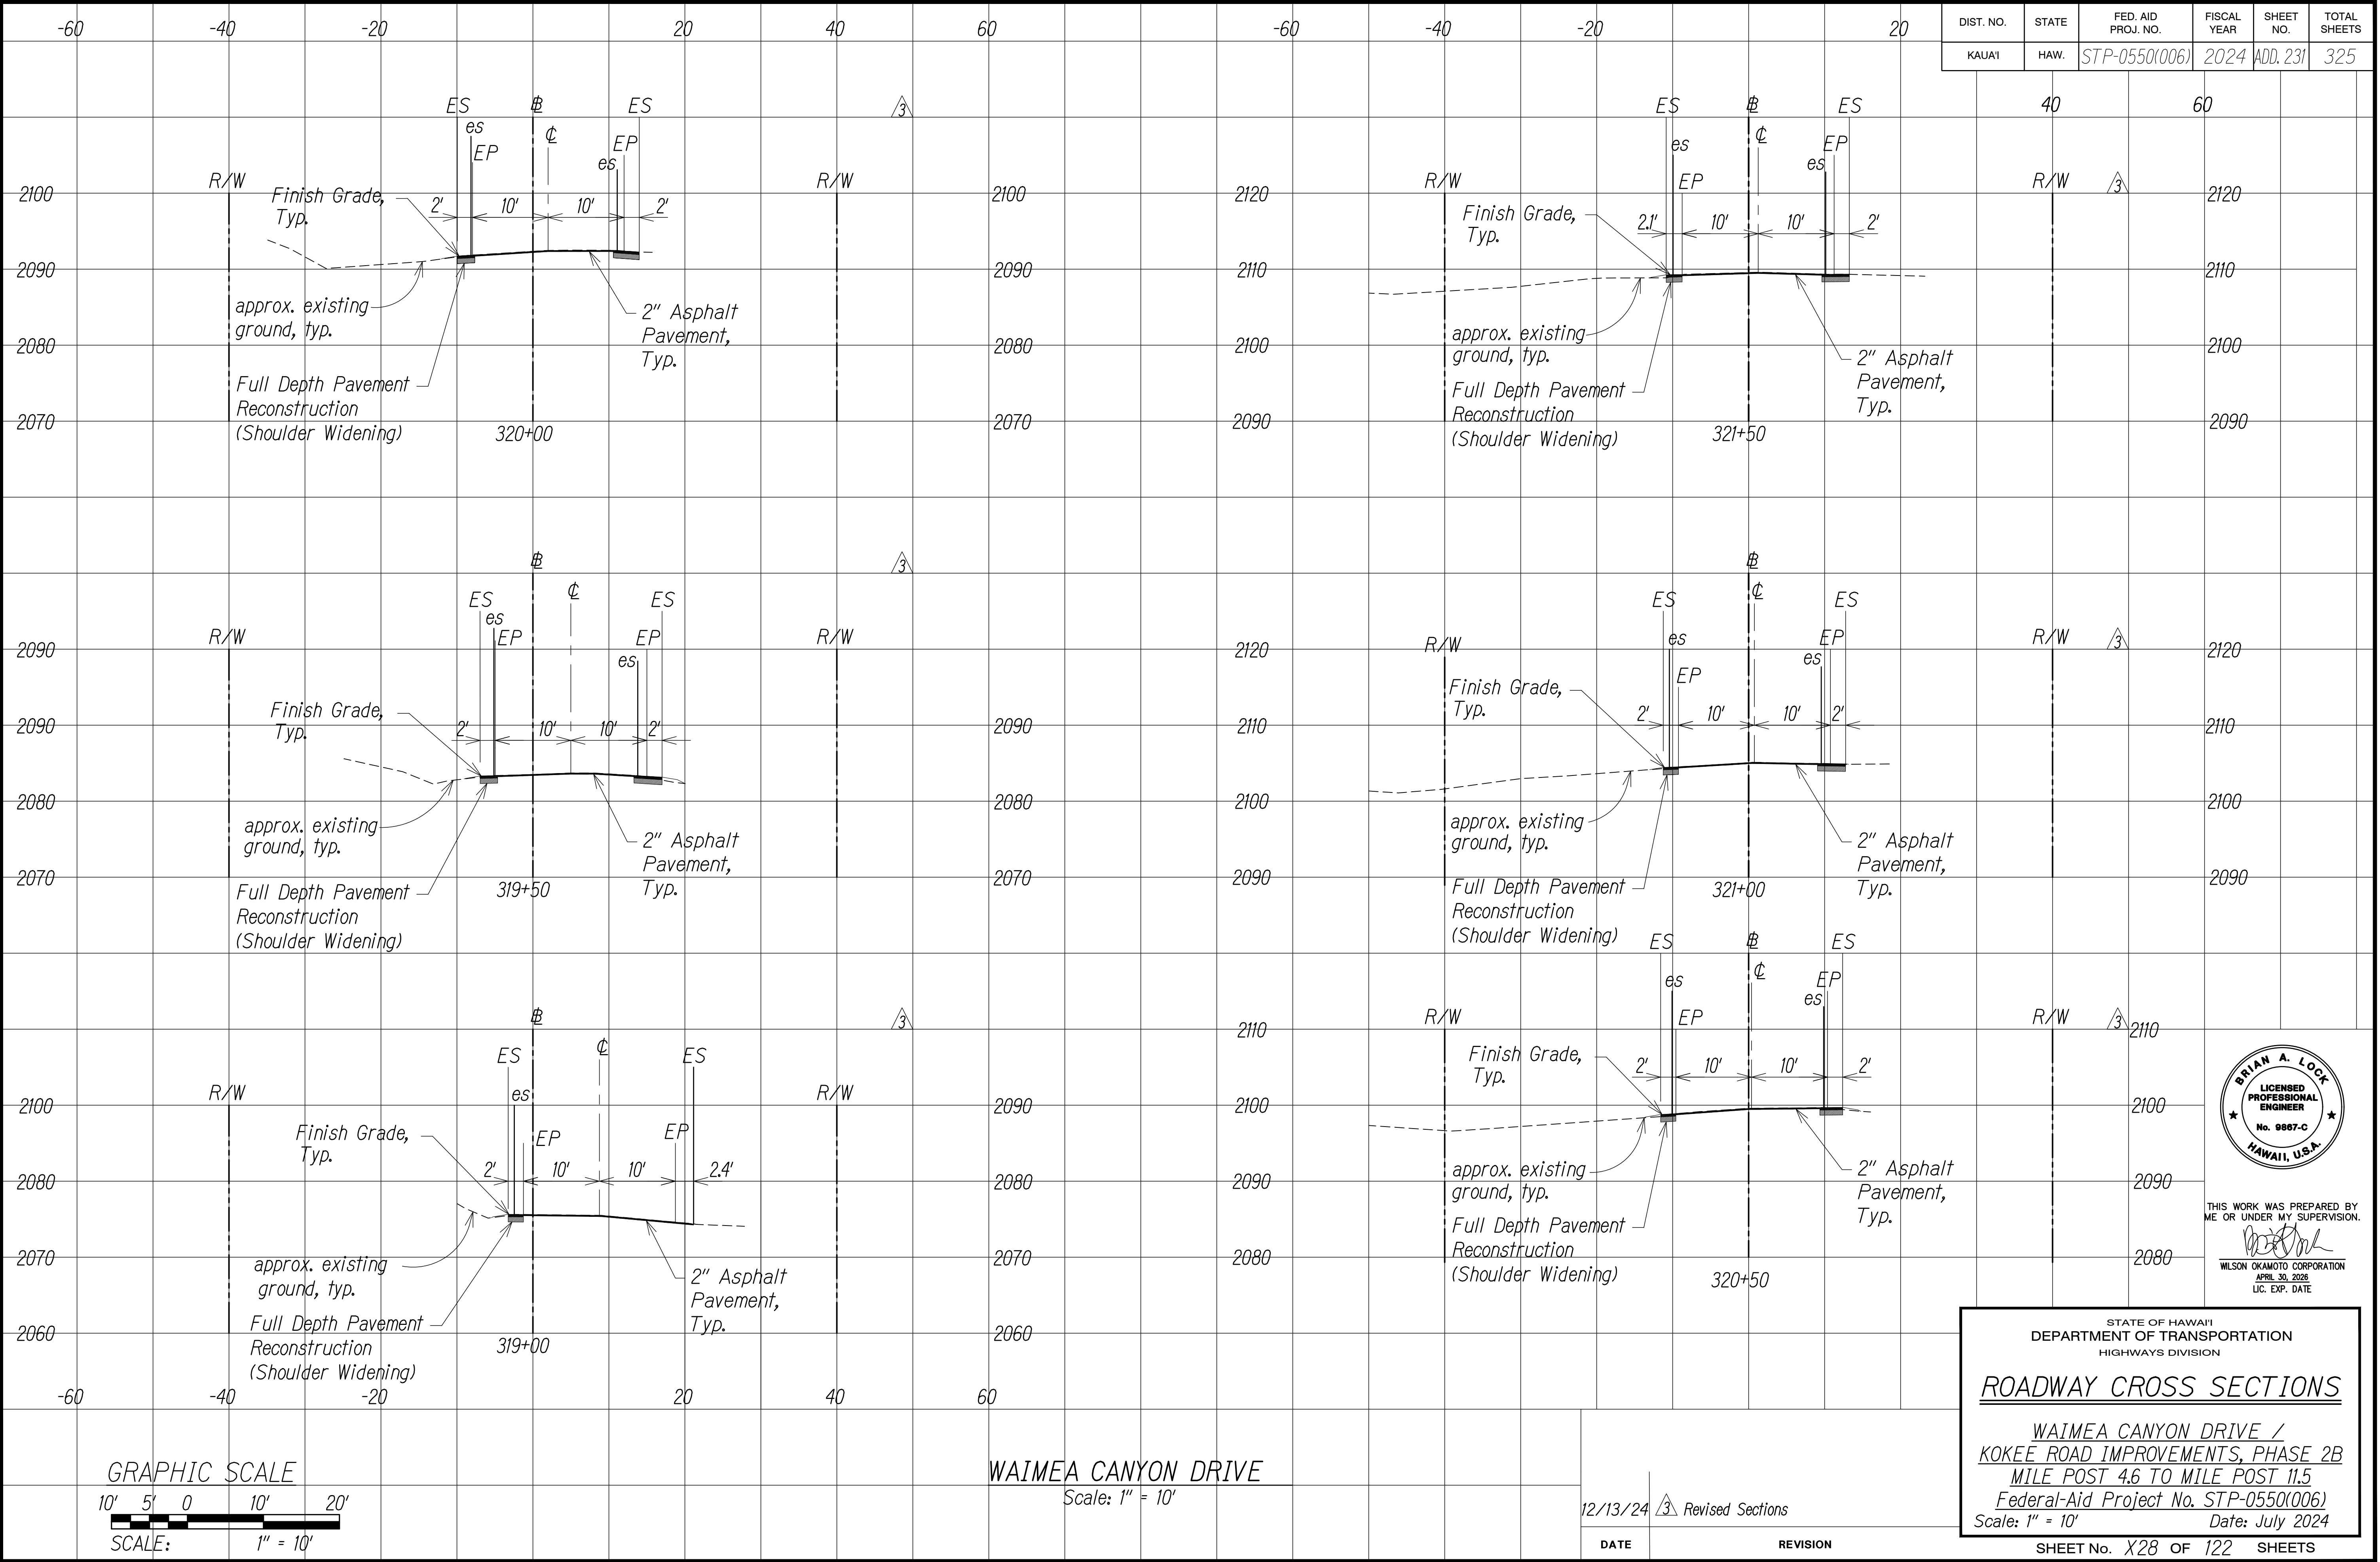

SURVEY PLOTTED BY	DATE
DESIGNED BY	
TRACED BY	
QUANTITIES BY	
CHECKED BY	
ORIGINAL PLAN	
NOTE BOOK	
No.	

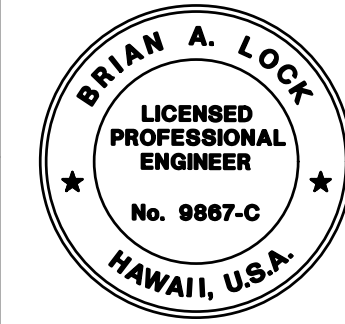

THIS WORK WAS PREPARED BY
ME OR UNDER MY SUPERVISION.
[Signature]
WILSON OKAMOTO CORPORATION
APRIL 30, 2026
LIC. EXP. DATE


STATE OF HAWAII
DEPARTMENT OF TRANSPORTATION
HIGHWAYS DIVISION
ROADWAY CROSS SECTIONS
WAIMEA CANYON DRIVE /
KOKEE ROAD IMPROVEMENTS, PHASE 2B
MILE POST 4.6 TO MILE POST 11.5
Federal-Aid Project No. STP-0550(006)
Scale: 1" = 10"
Date: July 2024

12/13/24 3 Revised Sections


DATE REVISION

SHEET No. X28 OF 122 SHEETS

DIST. NO.	STATE	FED. AID PROJ. NO.	FISCAL YEAR	SHEET NO.	TOTAL SHEETS
KAUAI	HAW.	STP-0550(006)	2024	ADD.232	325

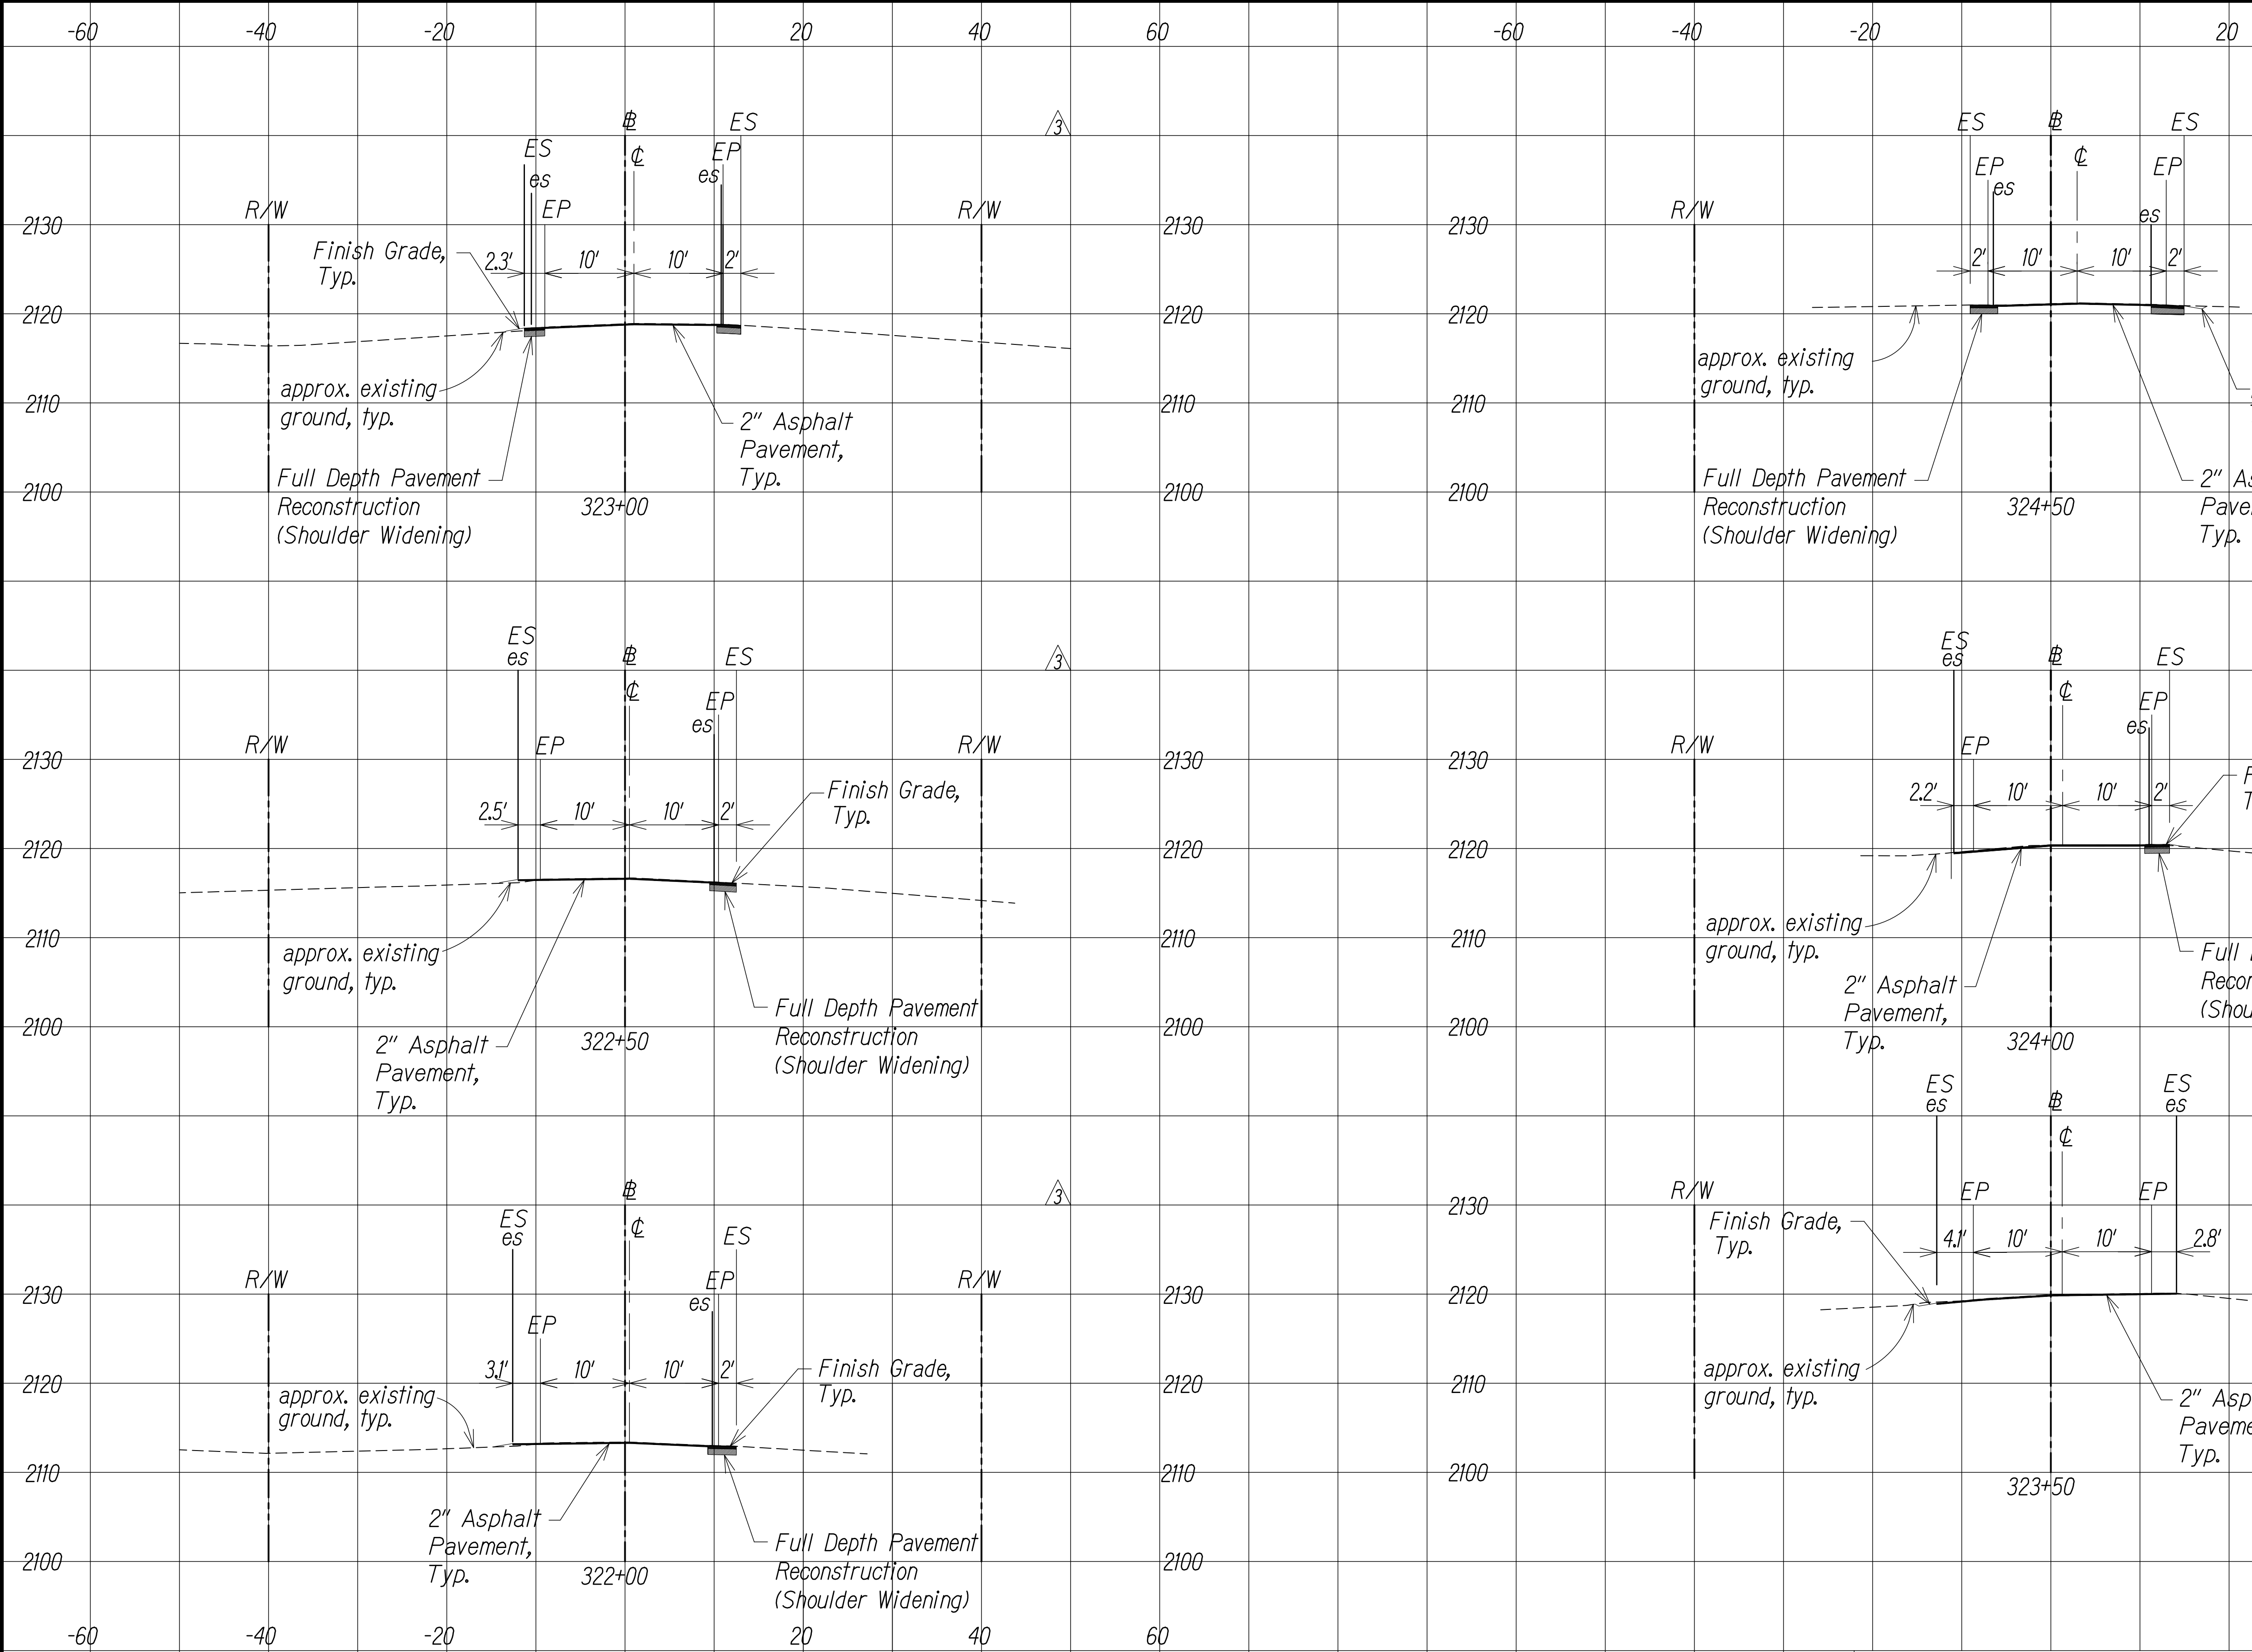


SURVEY PLOTTED BY	DATE
DESIGNED BY	
TRACED BY	
QUANTITIES BY	
CHECKED BY	
ORIGINAL PLAN	
NOTE BOOK	
No.	

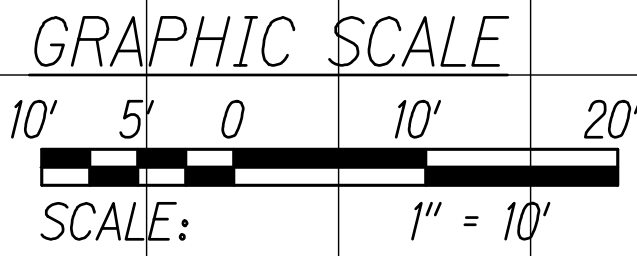

WAIMEA CANYON DRIVE
Scale: 1" = 10'

12/13/24 3 Revised Sections

DATE	REVISION
------	----------

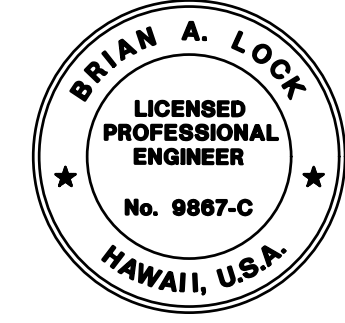


THIS WORK WAS PREPARED BY
ME OR UNDER MY SUPERVISION.
[Signature]
WILSON OKAMOTO CORPORATION
APRIL 30, 2026
LIC. EXP. DATE

STATE OF HAWAII
DEPARTMENT OF TRANSPORTATION
HIGHWAYS DIVISION
ROADWAY CROSS SECTIONS
WAIMEA CANYON DRIVE /
KOEKE ROAD IMPROVEMENTS, PHASE 2B
MILE POST 4.6 TO MILE POST 11.5
Federal-Aid Project No. STP-0550(006)
Scale: 1" = 10' Date: July 2024

SHEET No. X29 OF 122 SHEETS


-60	-40	-20			20	40	60			-60	-40	-20			20
-----	-----	-----	--	--	----	----	----	--	--	-----	-----	-----	--	--	----

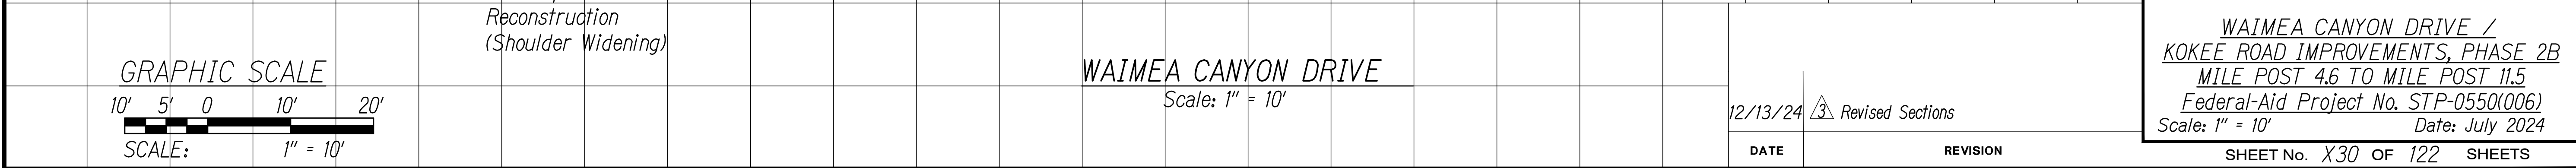


SHEET No. *X30* OF *122* SHEETS

ORIGINAL PLAN	SURVEY PLOTTED BY _____ DATE _____	
	DRAWN BY _____	
NOTE BOOK	TRACED BY _____	
	DESIGNED BY _____	
	QUANTITIES BY _____	
	CHECKED BY _____	
No. _____		

DIST. NO.	STATE	FED. AID PROJ. NO.	FISCAL YEAR	SHEET NO.	TOTAL SHEETS
KAUAI	HAW.	STP-0550(006)	2024	ADD.234	325

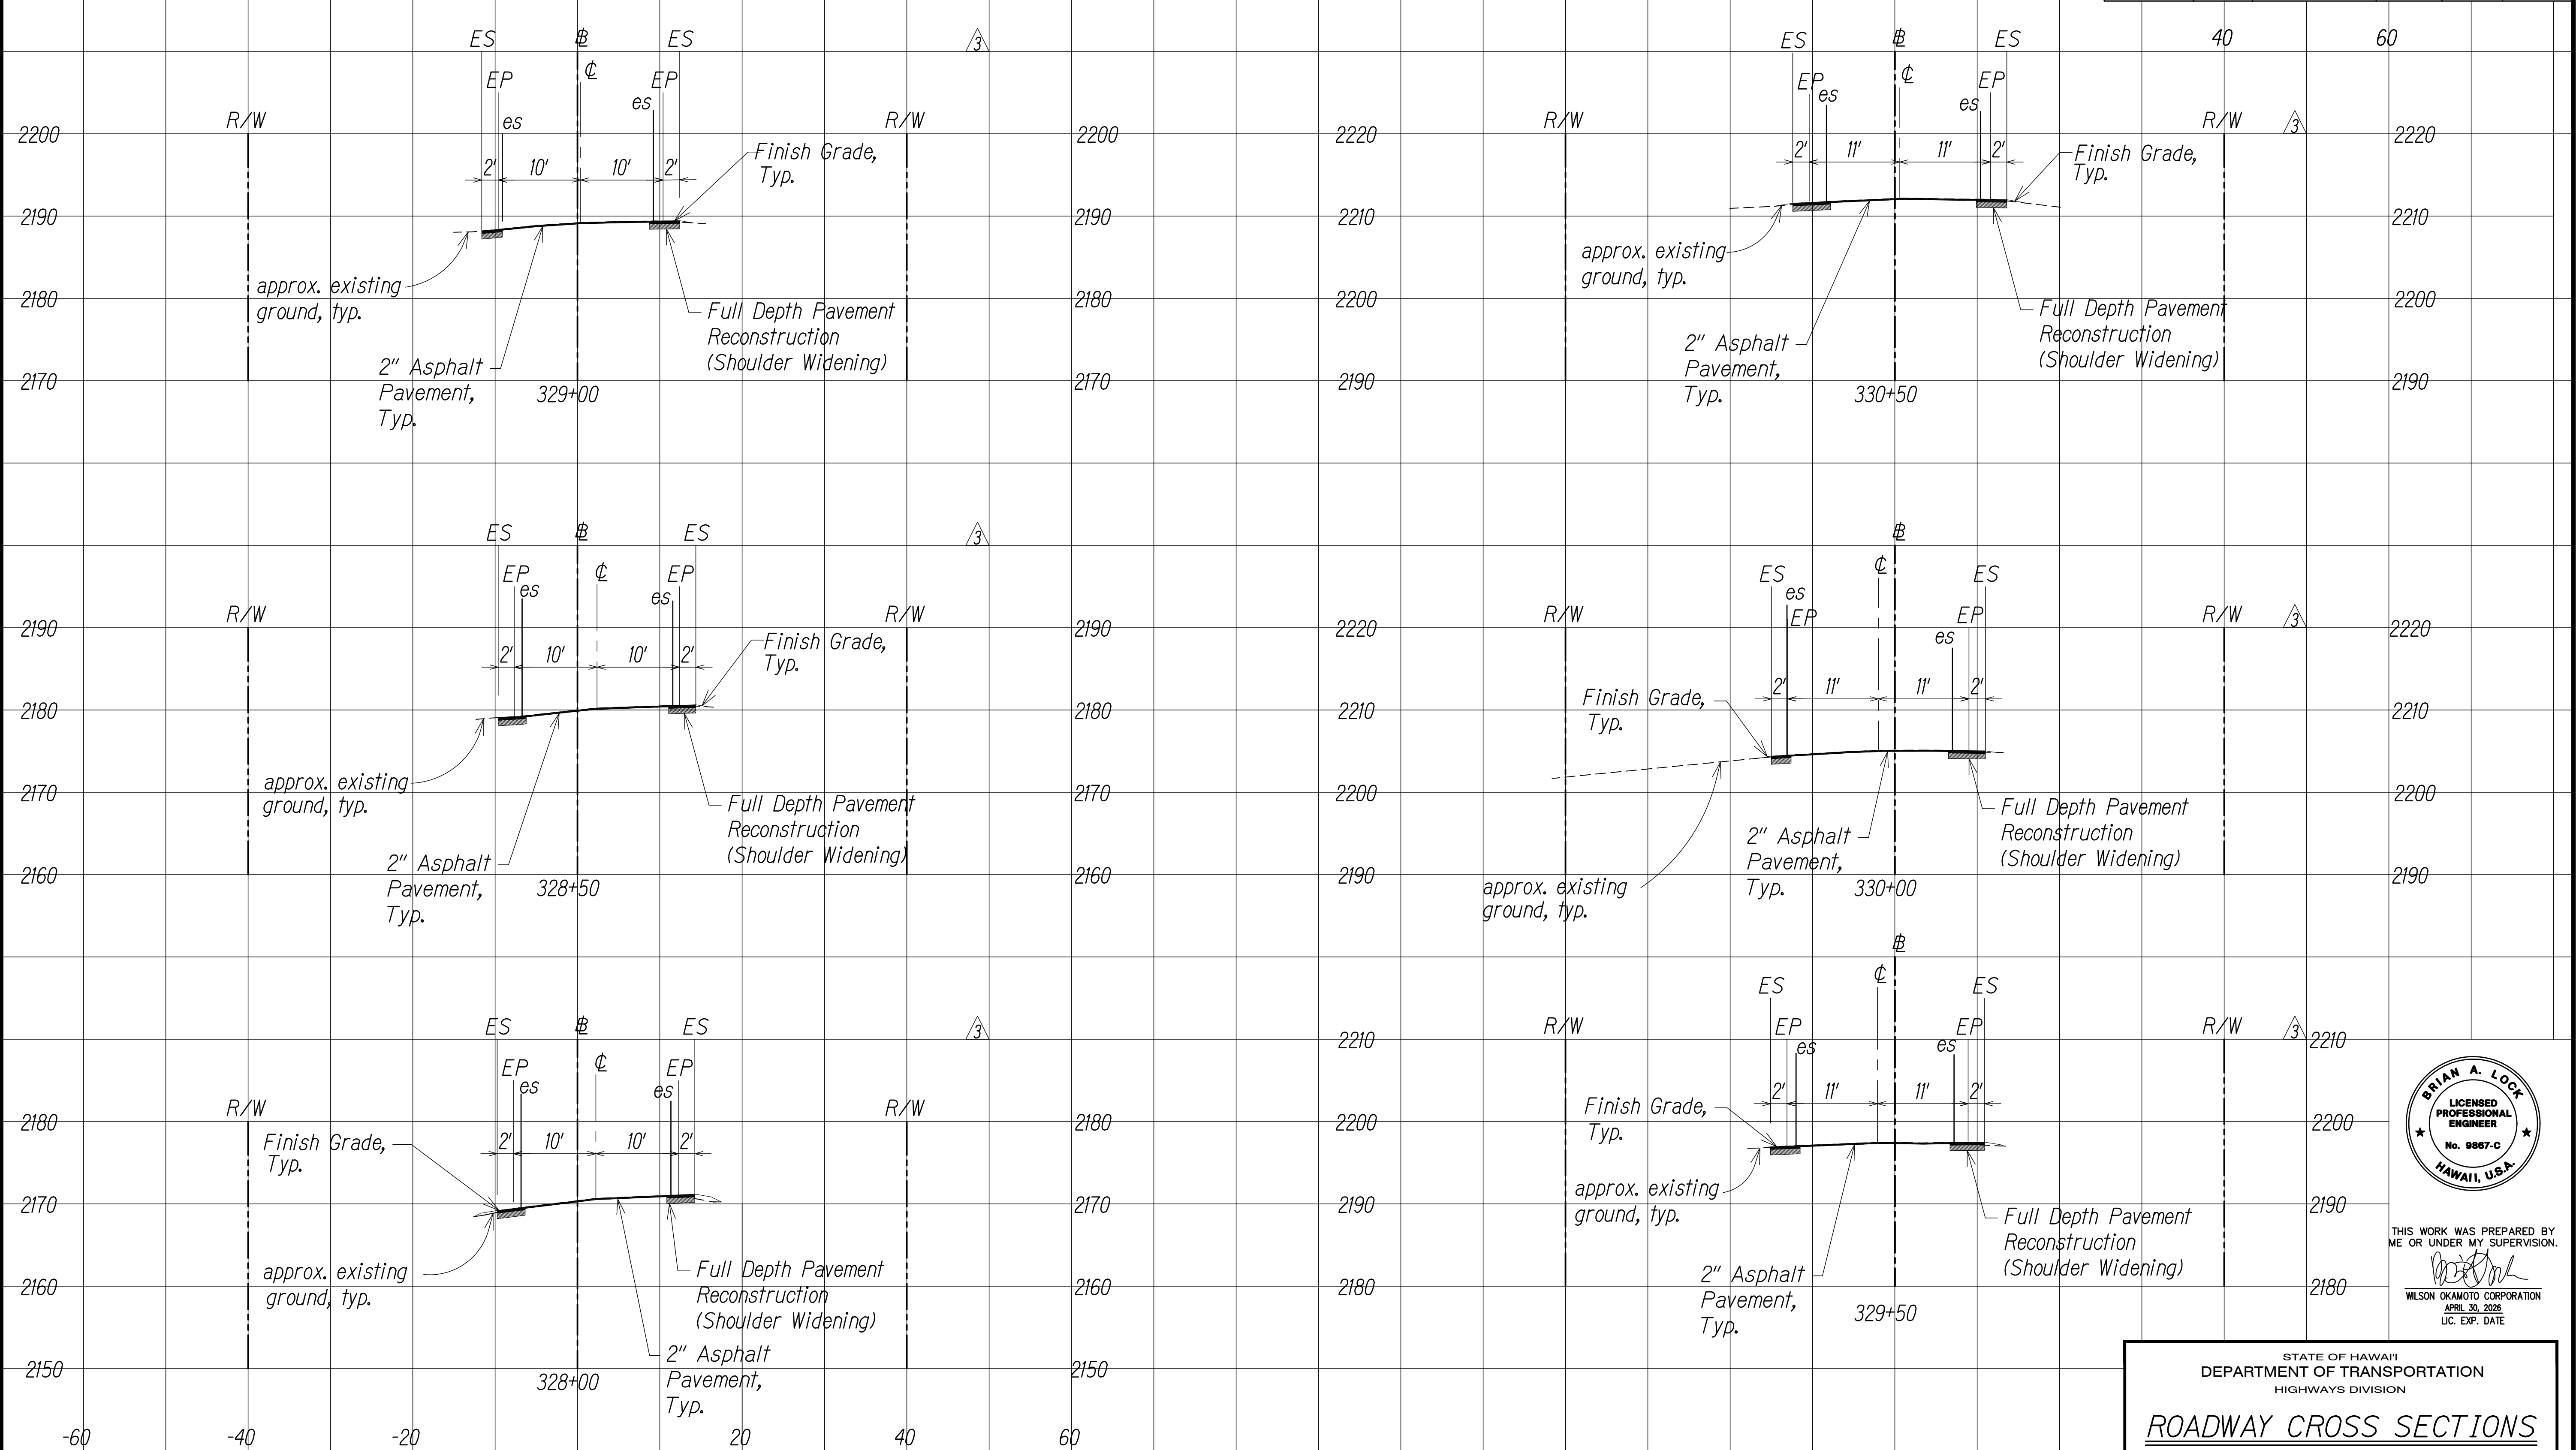

SURVEY PLOTTED BY	DATE
DESIGNED BY	
TRACED BY	
NOTED BY	
QUANTITIES BY	
CHECKED BY	

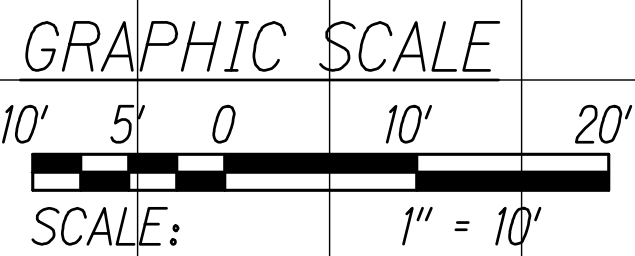

WAIMEA CANYON DRIVE
Scale: 1" = 10'


12/13/24 3 Revised Sections

DATE REVISION

STATE OF HAWAII
DEPARTMENT OF TRANSPORTATION
HIGHWAYS DIVISION


ROADWAY CROSS SECTIONS

WAIMEA CANYON DRIVE /
KOKEE ROAD IMPROVEMENTS, PHASE 2B
MILE POST 4.6 TO MILE POST 11.5
Federal-Aid Project No. STP-0550(006)
Scale: 1" = 10' Date: July 2024

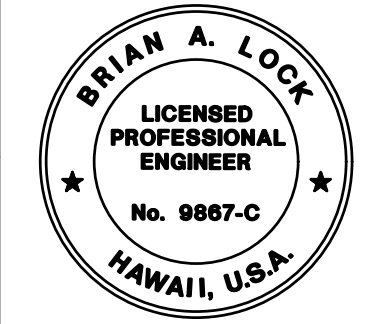


THIS WORK WAS PREPARED BY
ME OR UNDER MY SUPERVISION.
[Signature]
WILSON OKAMOTO CORPORATION
APRIL 30, 2026
LIC. EXP. DATE

SHEET No. X31 OF 122 SHEETS

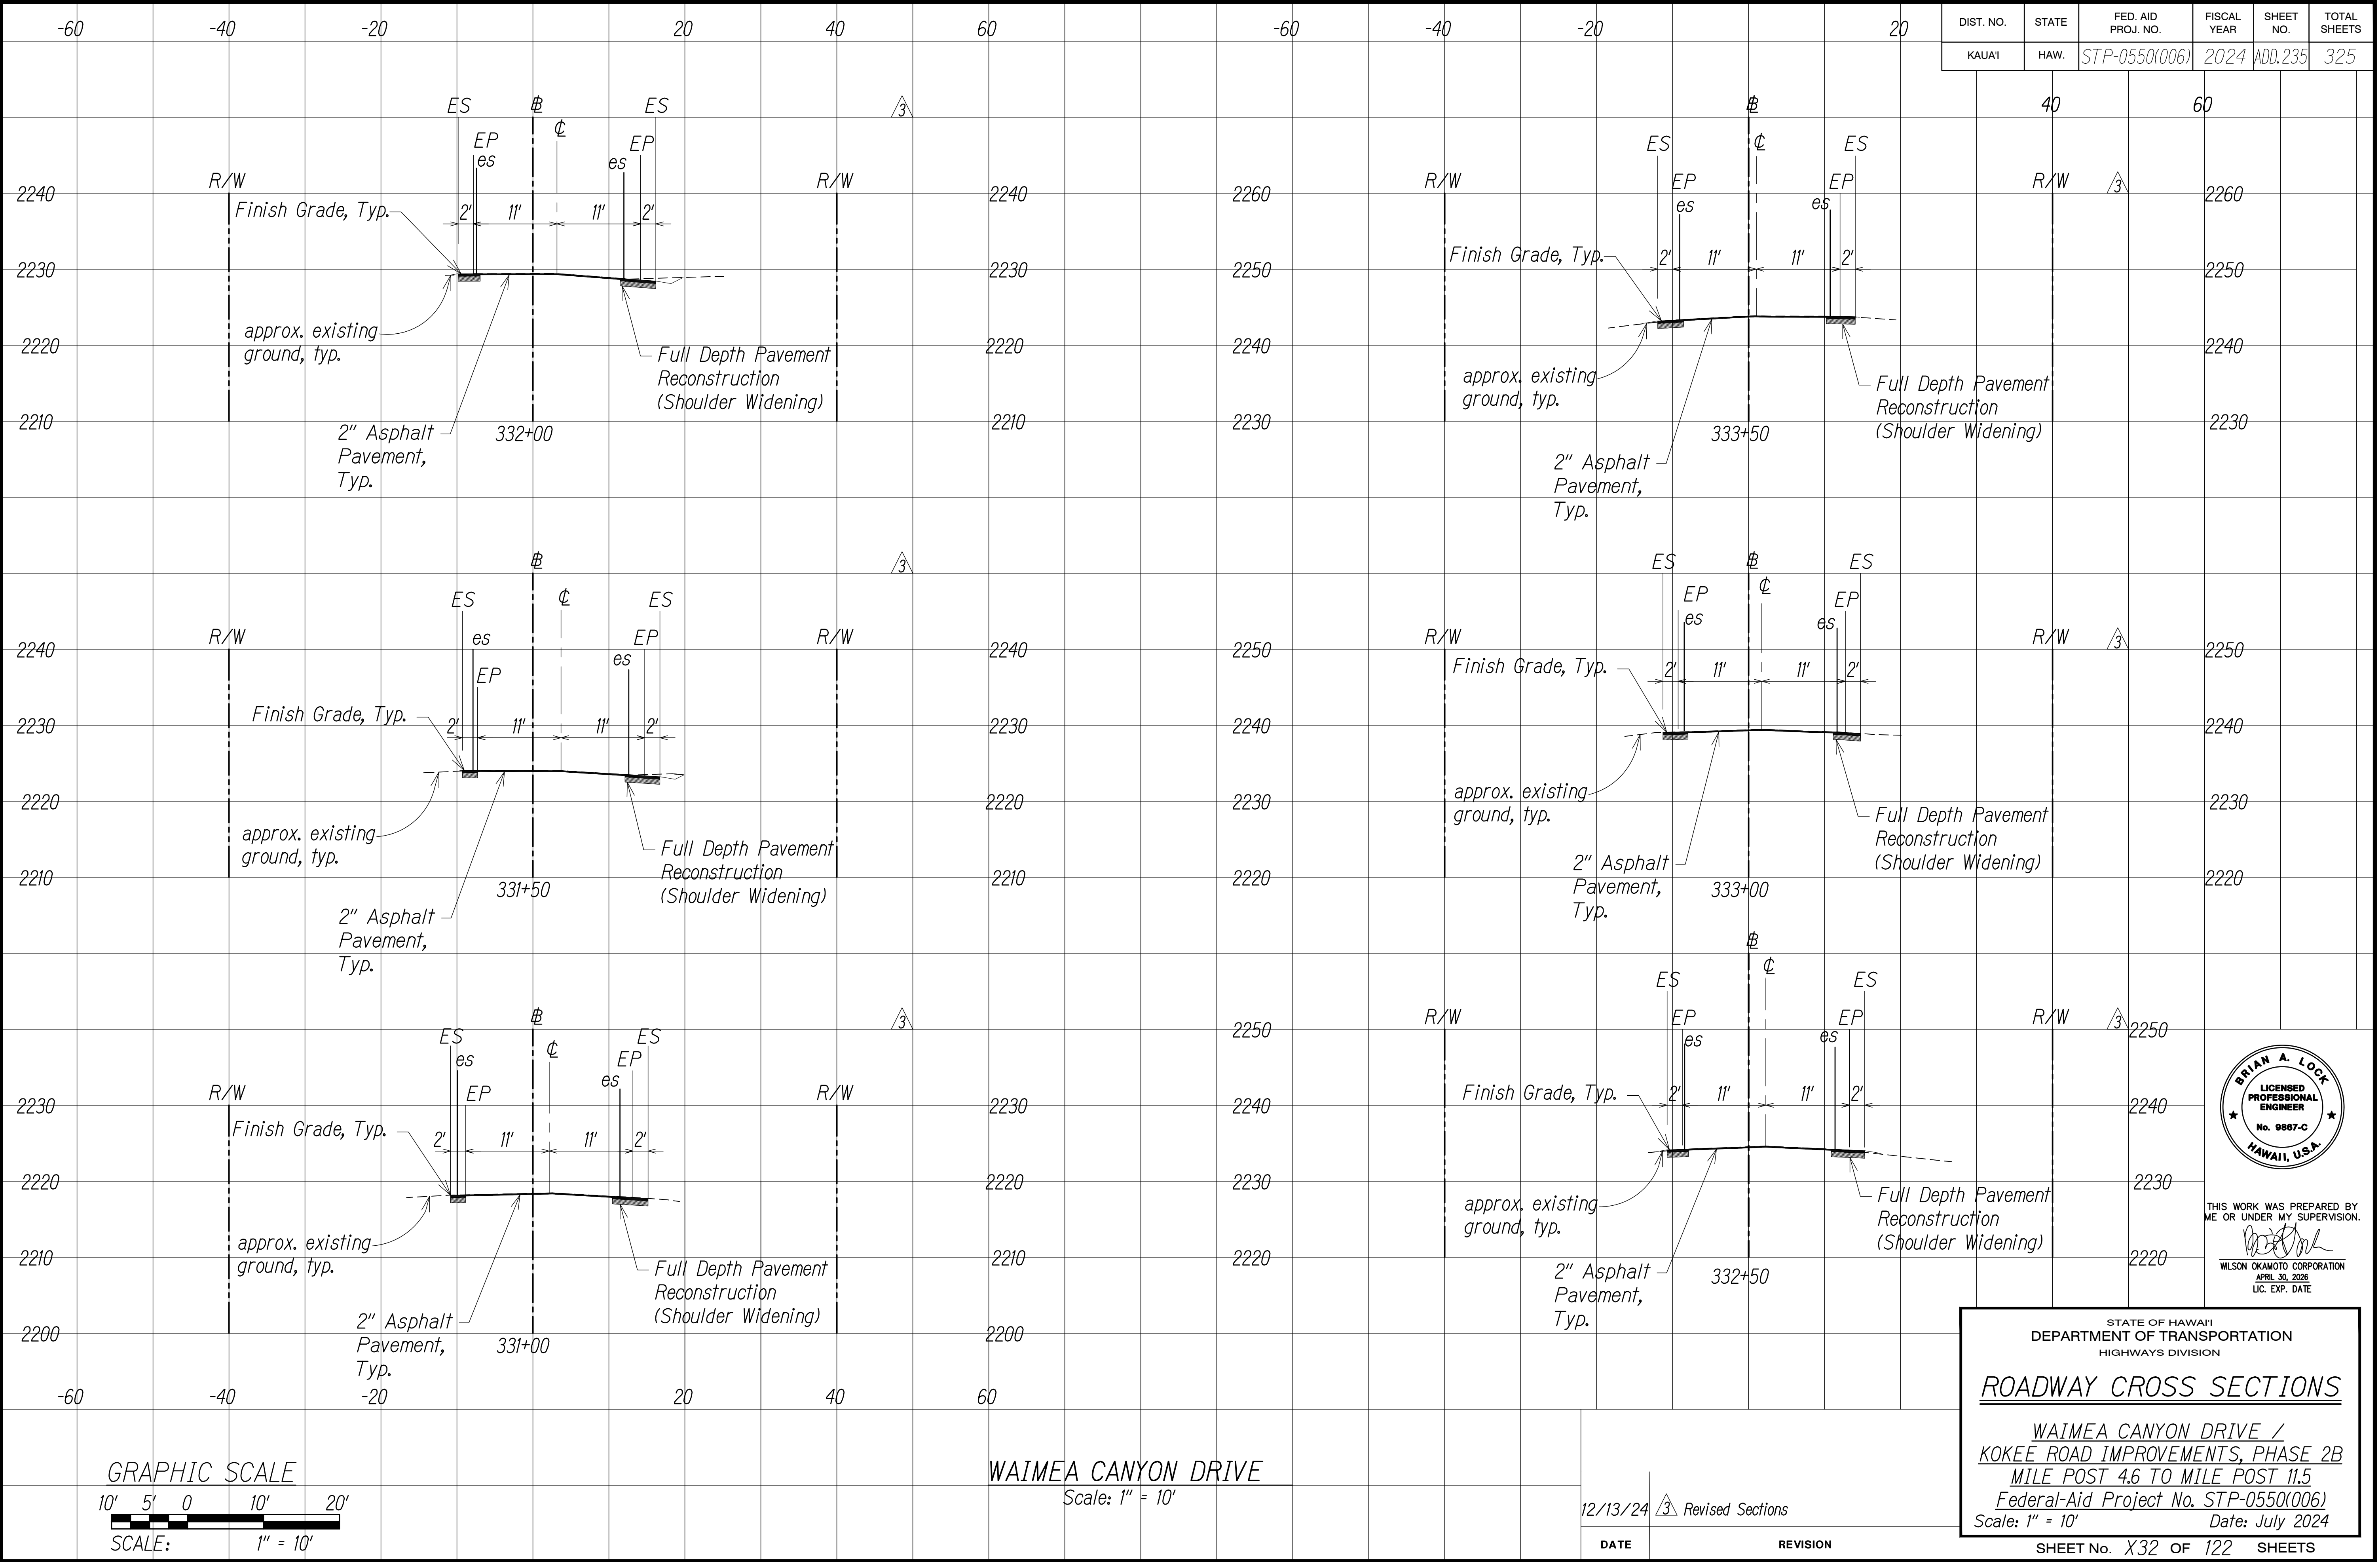


DIST. NO.	STATE	FED. AID PROJ. NO.	FISCAL YEAR	SHEET NO.	TOTAL SHEETS
KAUAI	HAW.	STP-0550(006)	2024	ADD.235	325

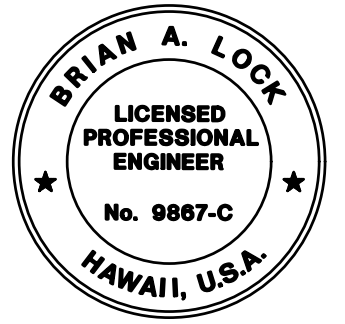

THIS WORK WAS PREPARED BY ME OR UNDER MY SUPERVISION.
WILSON OKAMOTO CORPORATION
APRIL 30, 2026
LIC. EXP. DATE


SURVEY PLOTTED BY	DATE
DESIGNED BY	
TRACED BY	
QUANTITIES BY	
CHECKED BY	
ORIGINAL PLAN	
NOTE BOOK	
No.	

DIST. NO.	STATE	FED. AID PROJ. NO.	FISCAL YEAR	SHEET NO.	TOTAL SHEETS
KAUA'I	HAW.	STP-0550(006)	2024	ADD.236	325

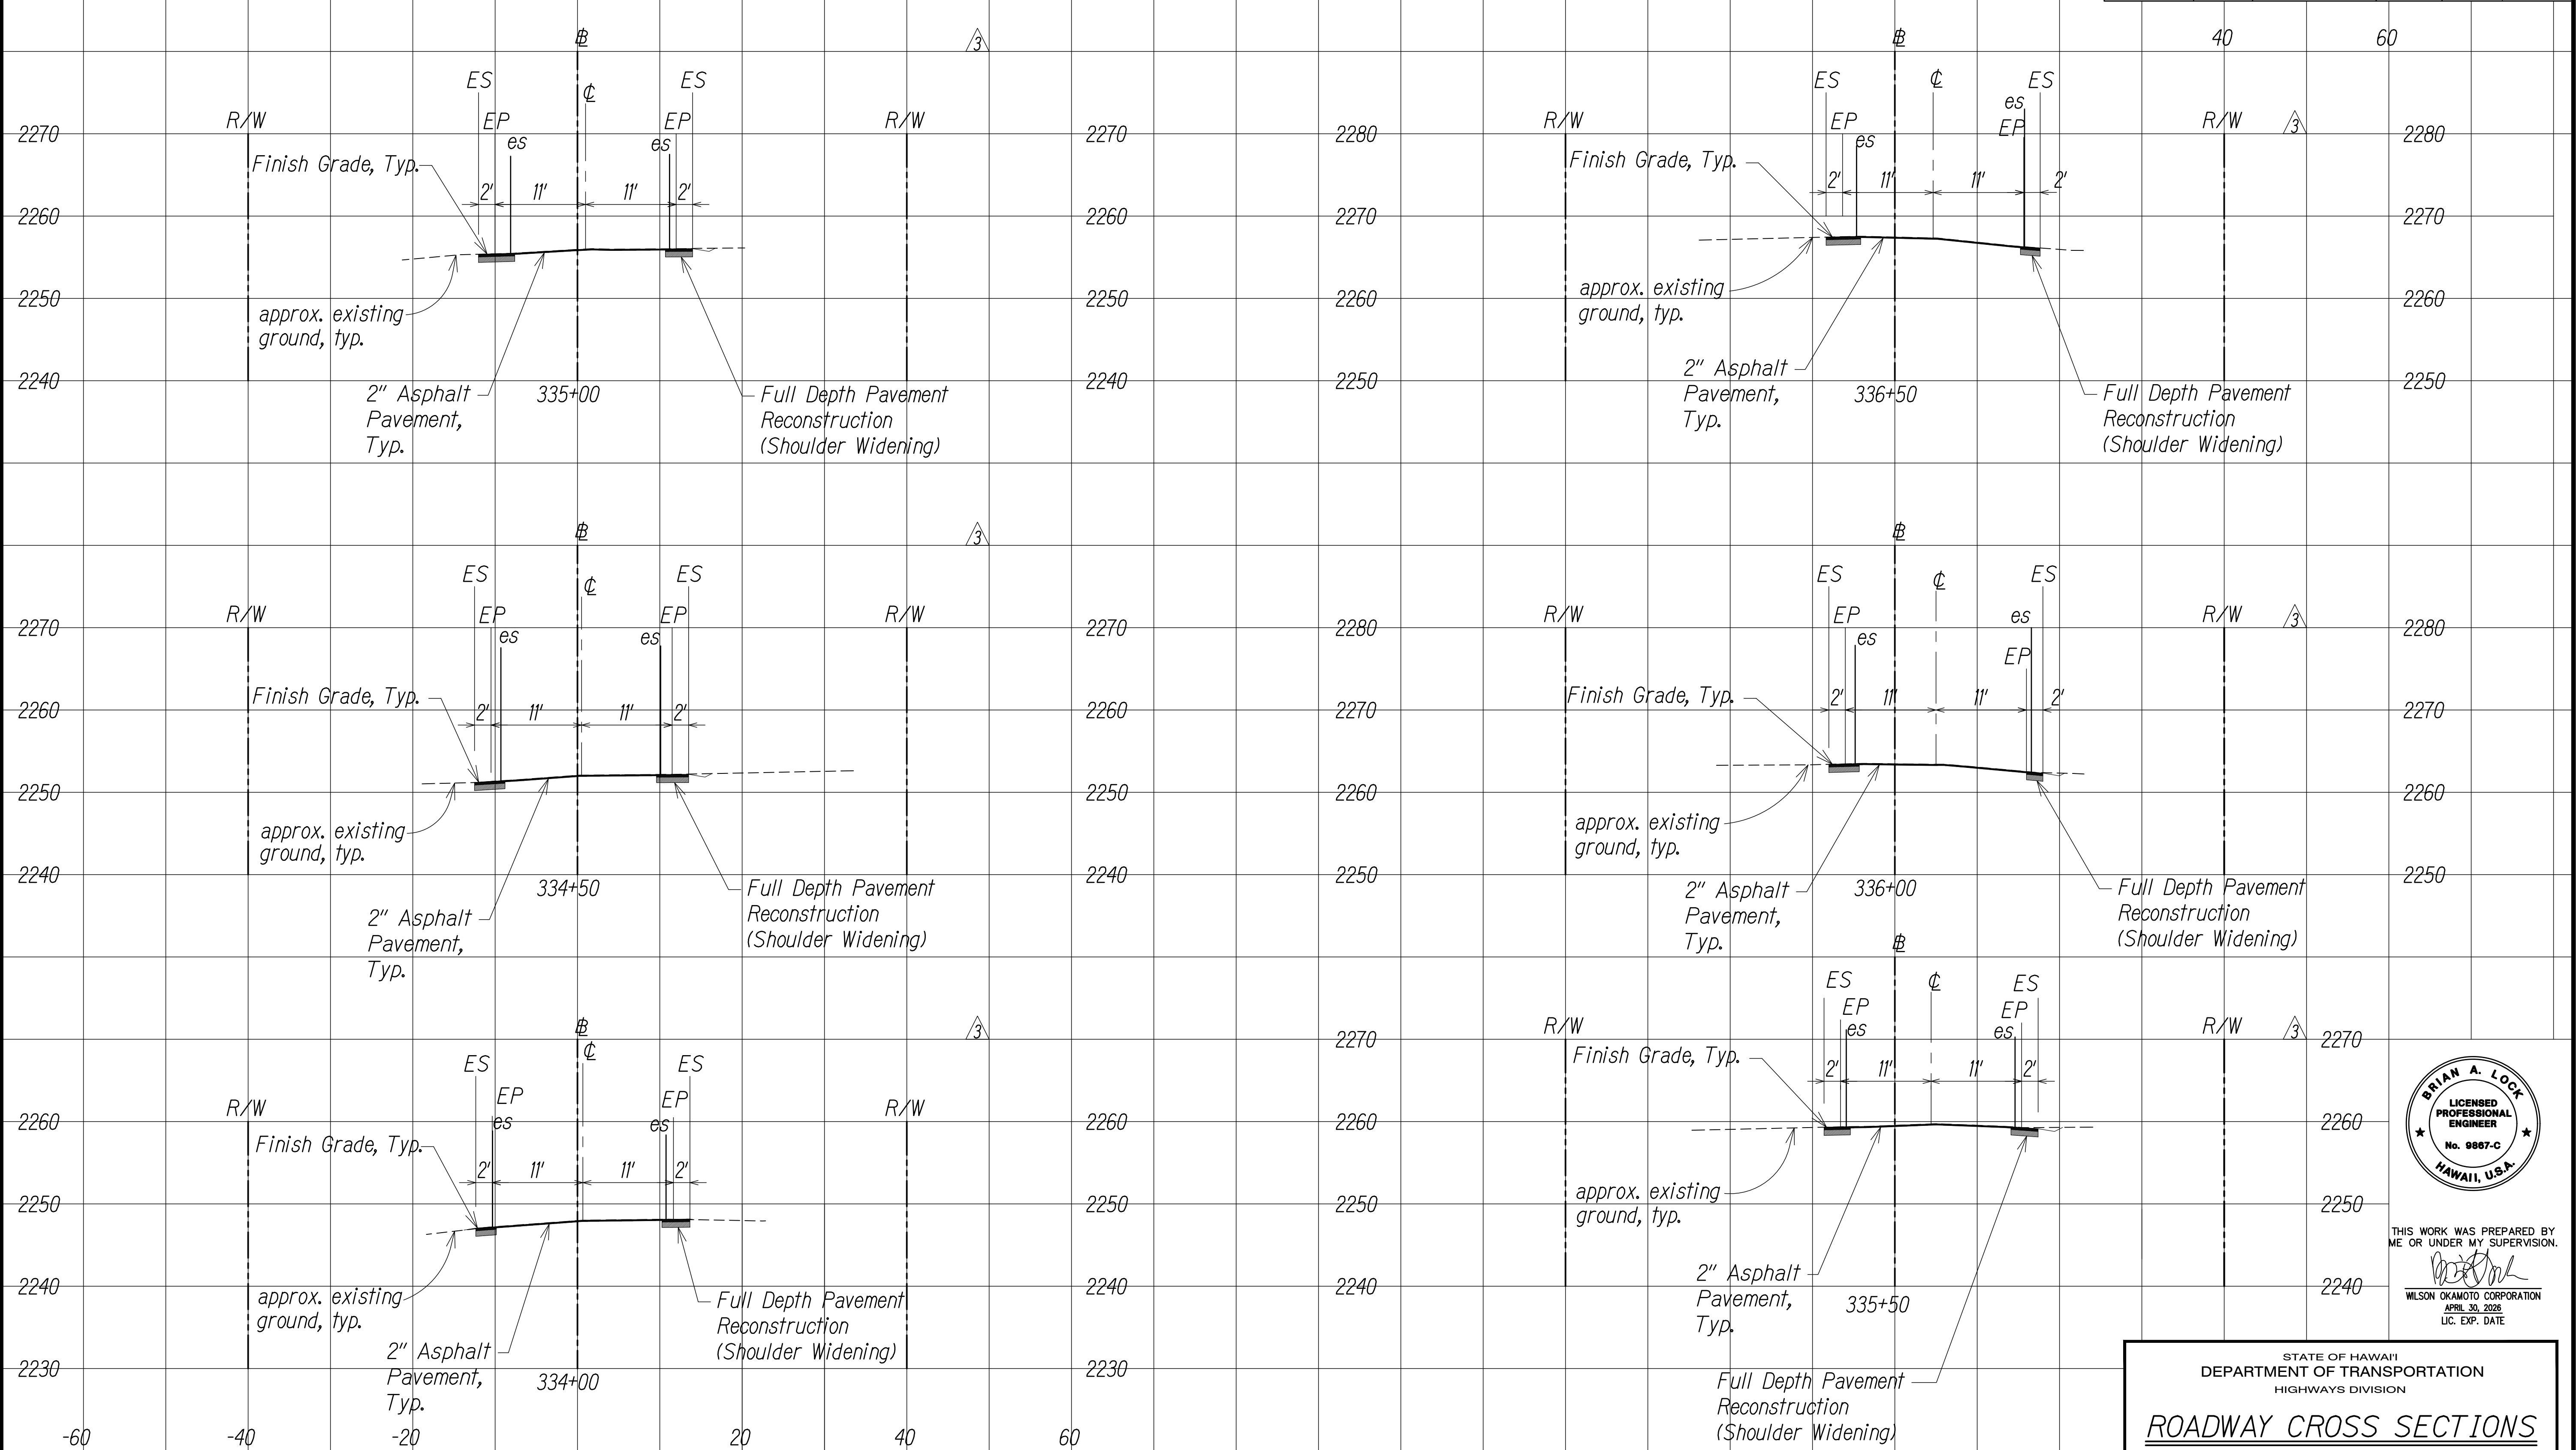

SURVEY PLOTTED BY	DATE
DESIGNED BY	
TRACED BY	
QUANTITIES BY	
CHECKED BY	

ORIGINAL PLAN	No.
NOTE BOOK	

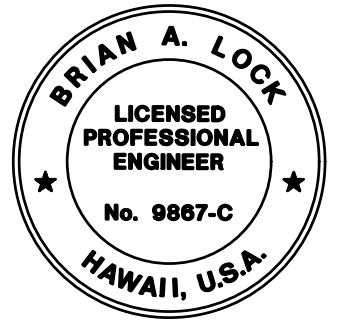


THIS WORK WAS PREPARED BY
ME OR UNDER MY SUPERVISION.
[Signature]
WILSON OKAMOTO CORPORATION
APRIL 30, 2026
LIC. EXP. DATE

STATE OF HAWAII
DEPARTMENT OF TRANSPORTATION
HIGHWAYS DIVISION
ROADWAY CROSS SECTIONS
WAIMEA CANYON DRIVE /
KOEKEE ROAD IMPROVEMENTS, PHASE 2B
MILE POST 4.6 TO MILE POST 11.5
Federal-Aid Project No. STP-0550(006)
Scale: 1" = 10' Date: July 2024

12/13/24 3 Revised Sections

DATE REVISION


SHEET No. X33 OF 122 SHEETS

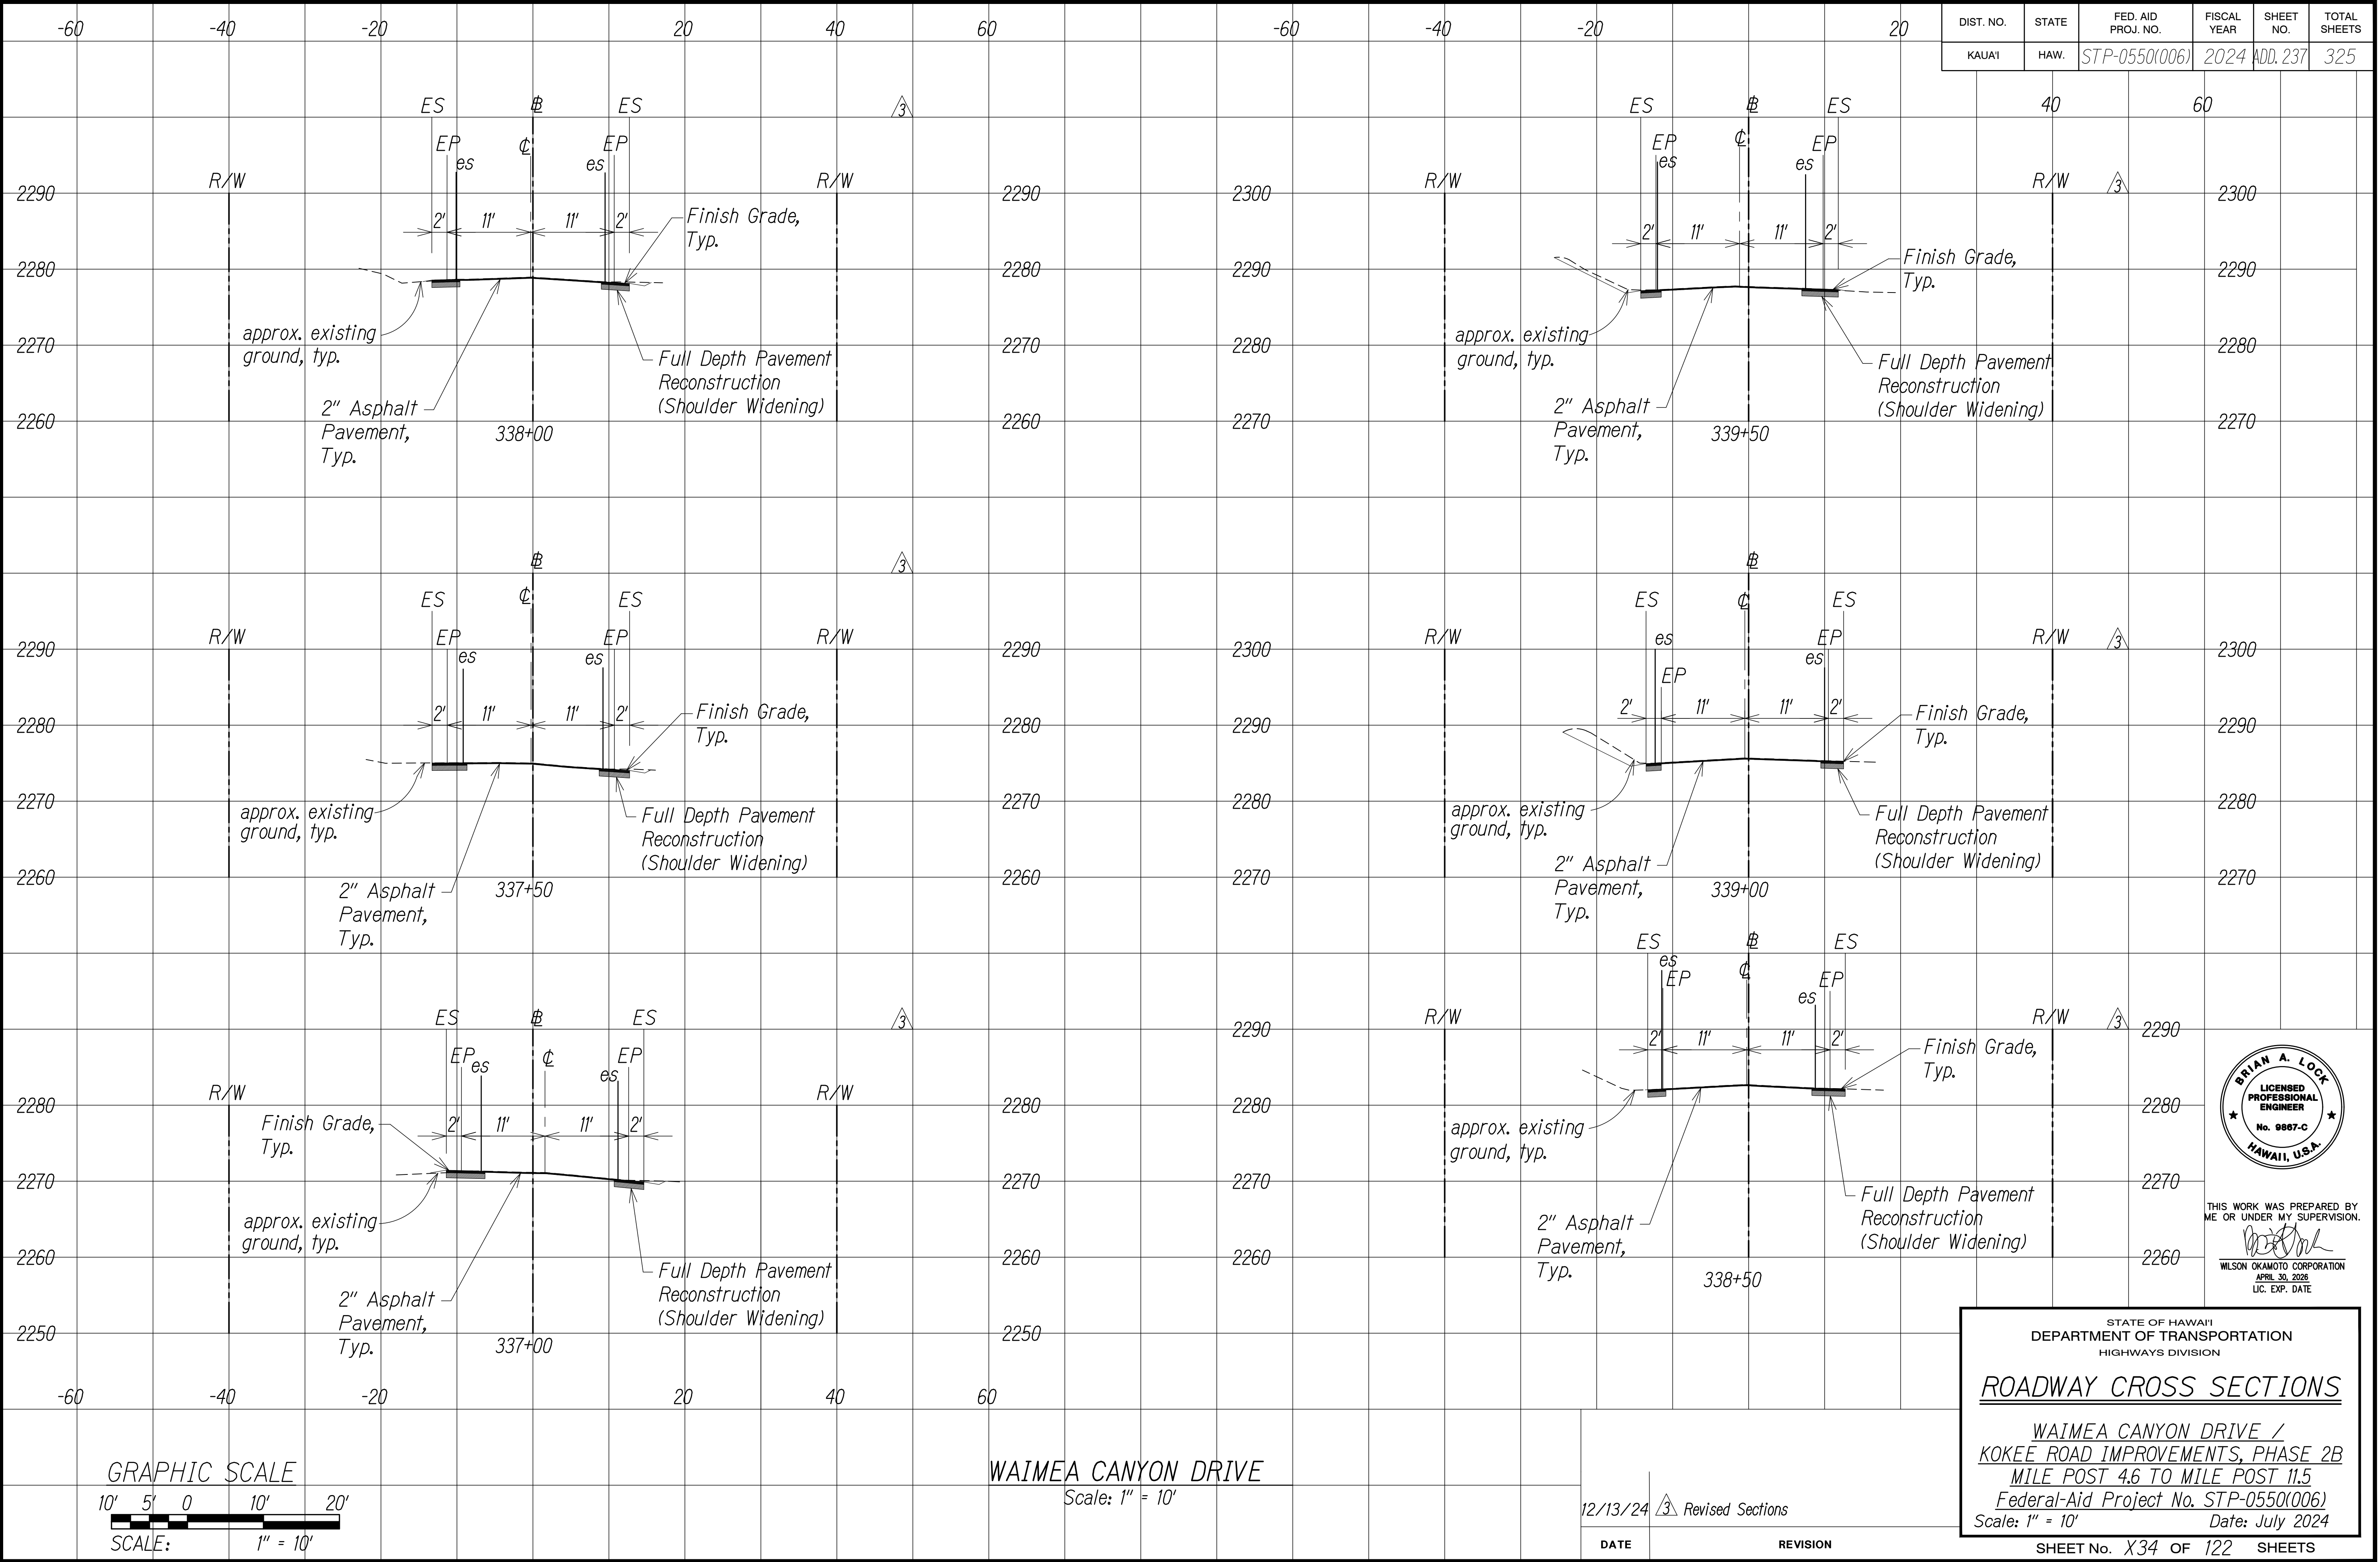

DIST. NO.	STATE	FED. AID PROJ. NO.	FISCAL YEAR	SHEET NO.	TOTAL SHEETS
KAUA'I	HAW.	STP-0550(006)	2024	ADD. 237	325


SURVEY PLOTTED BY	DATE
DESIGNED BY	
TRACED BY	
QUANTITIES BY	
CHECKED BY	

ORIGINAL PLAN	No.
NOTE BOOK	

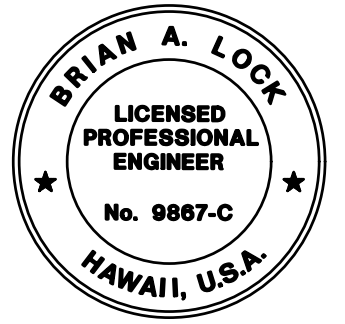


THIS WORK WAS PREPARED BY ME OR UNDER MY SUPERVISION.
WILSON OKAMOTO CORPORATION
APRIL 30, 2026
LIC. EXP. DATE

STATE OF HAWAII
DEPARTMENT OF TRANSPORTATION
HIGHWAYS DIVISION
ROADWAY CROSS SECTIONS
WAIMEA CANYON DRIVE /
KOEKOE ROAD IMPROVEMENTS, PHASE 2B
MILE POST 4.6 TO MILE POST 11.5
Federal-Aid Project No. STP-0550(006)
Scale: 1" = 10' Date: July 2024

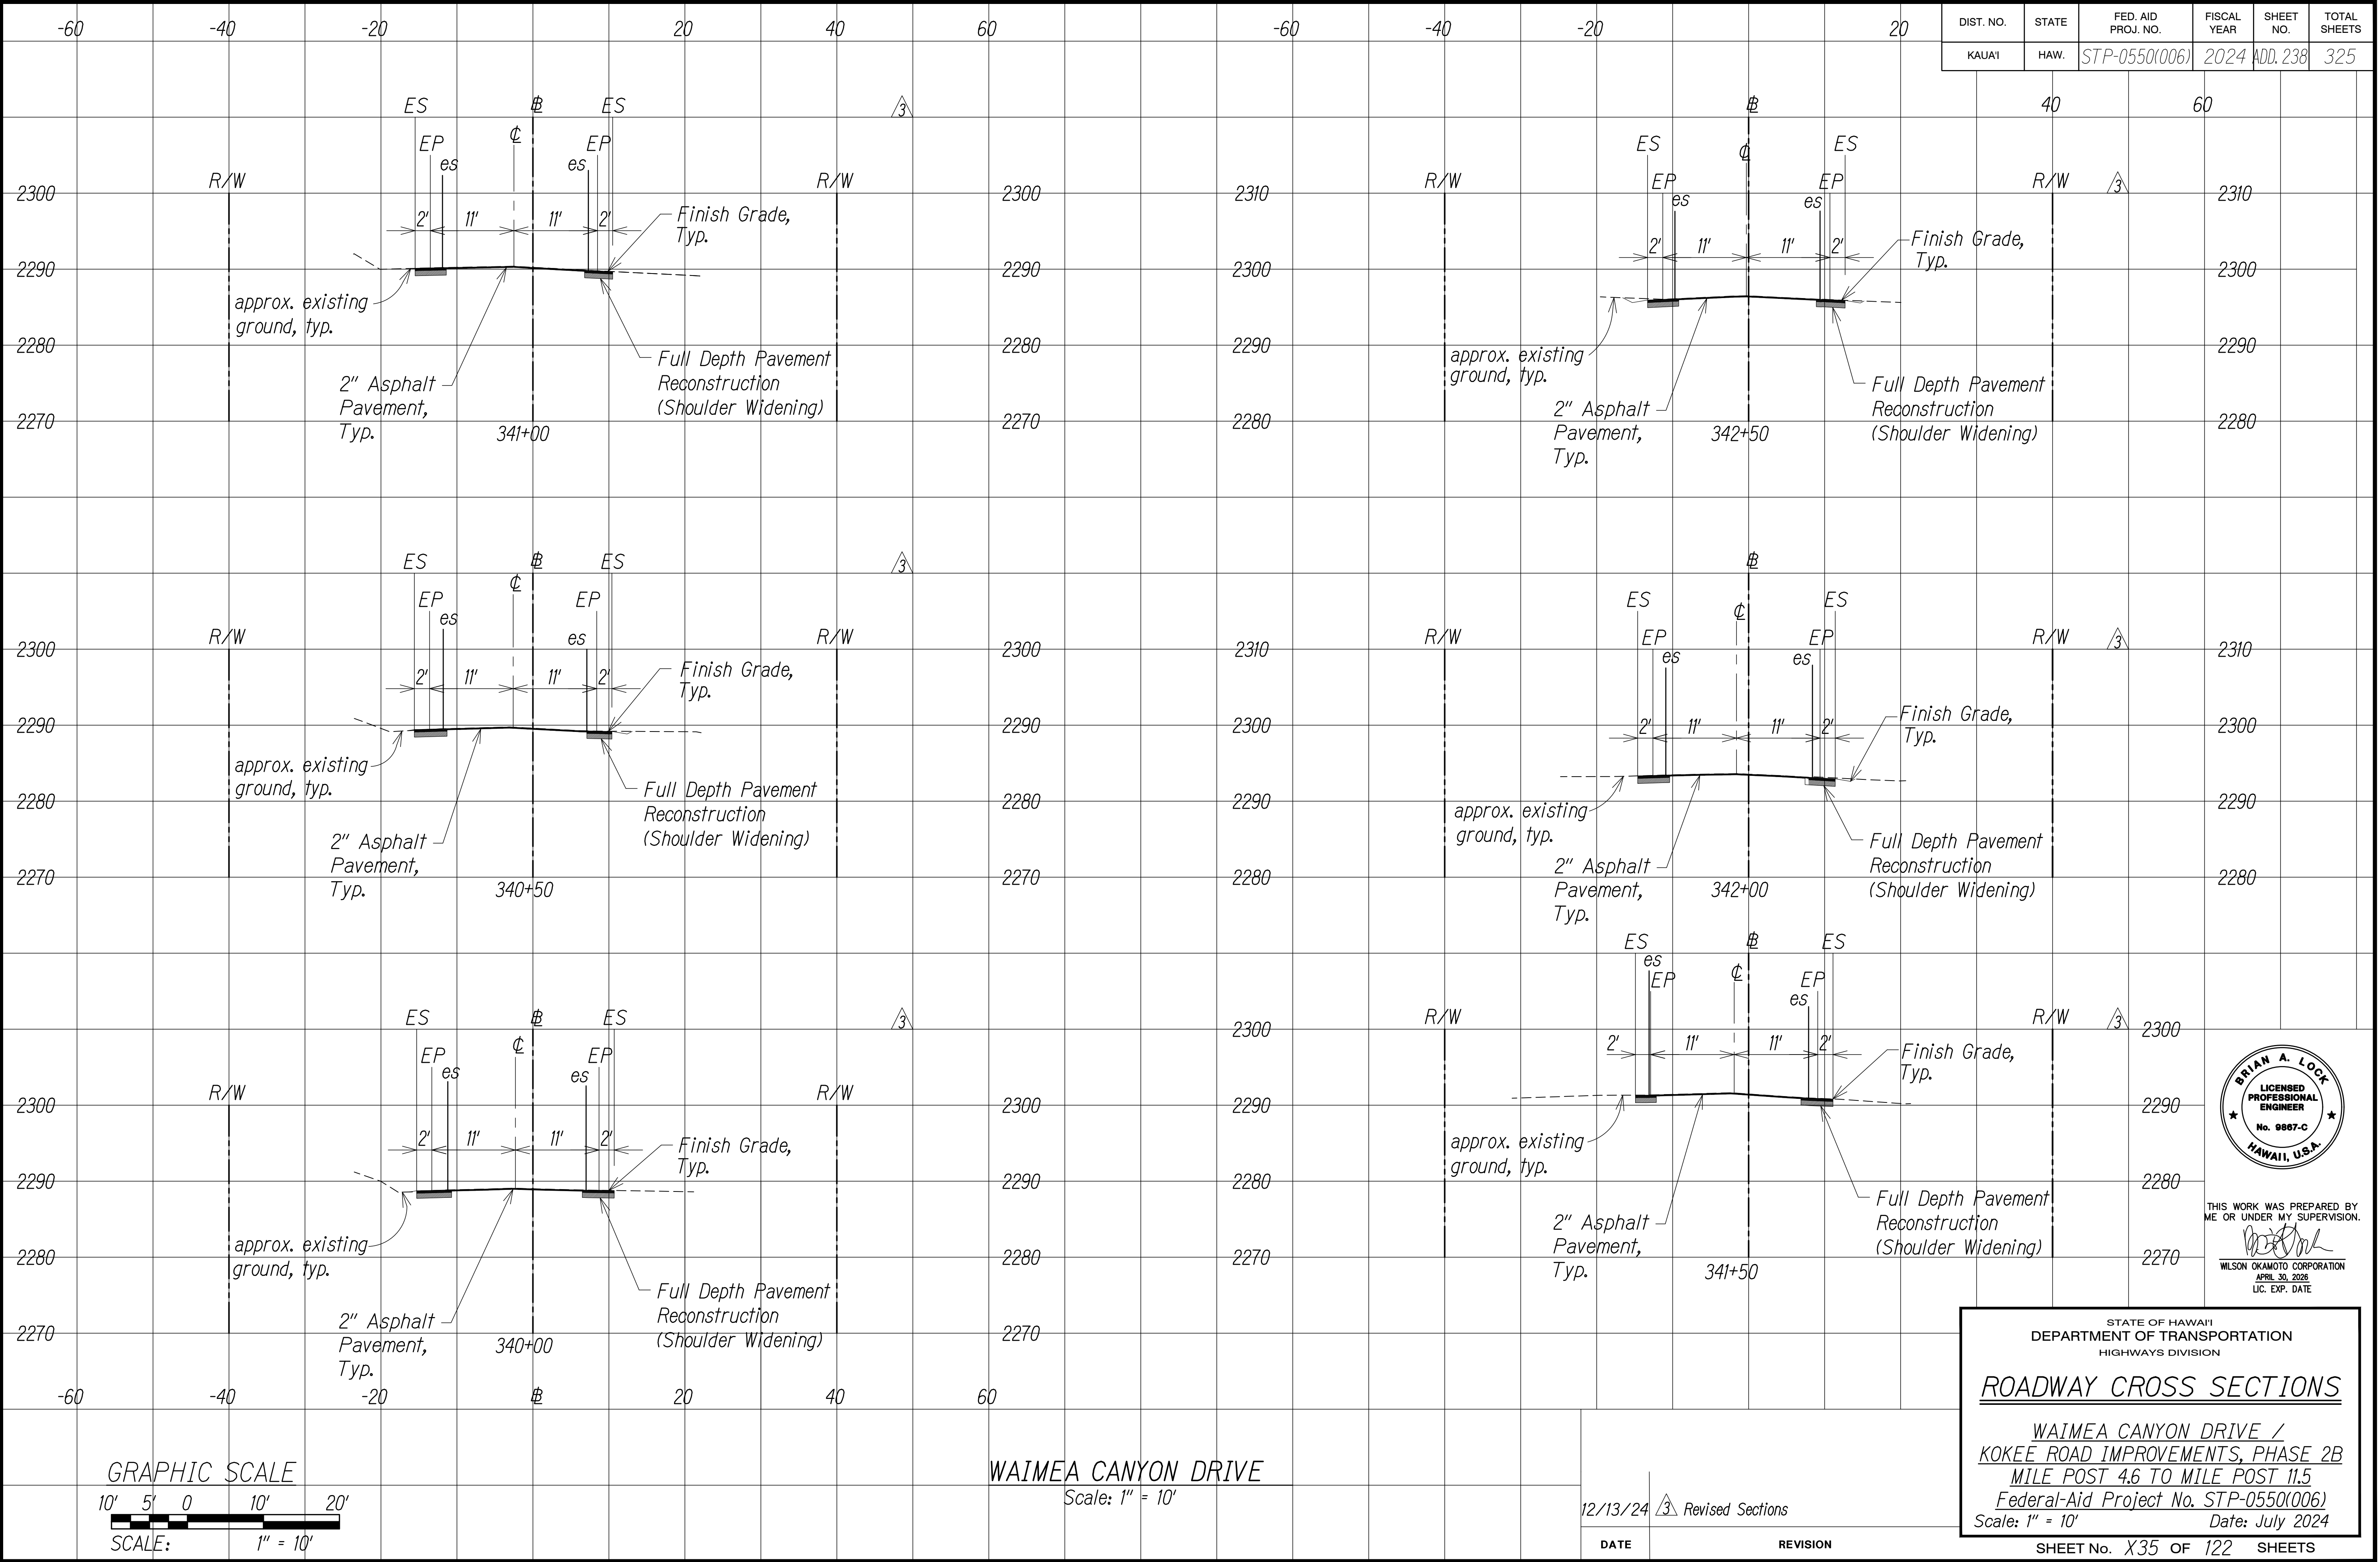

SURVEY PLOTTED BY	DATE
DESIGNED BY	
TRACED BY	
QUANTITIES BY	
CHECKED BY	
ORIGINAL PLAN	
NOTE BOOK	
No.	

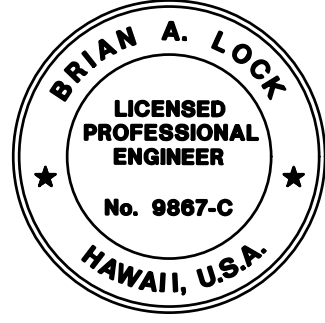

THIS WORK WAS PREPARED BY
ME OR UNDER MY SUPERVISION.
[Signature]
WILSON OKAMOTO CORPORATION
APRIL 30, 2026
LIC. EXP. DATE

STATE OF HAWAII
DEPARTMENT OF TRANSPORTATION
HIGHWAYS DIVISION


ROADWAY CROSS SECTIONS

WAIMEA CANYON DRIVE /
KOKEE ROAD IMPROVEMENTS, PHASE 2B
MILE POST 4.6 TO MILE POST 11.5
Federal-Aid Project No. STP-0550(006)
Scale: 1" = 10' Date: July 2024

12/13/24 3 Revised Sections


DATE	REVISION
------	----------

SHEET No. X35 OF 122 SHEETS

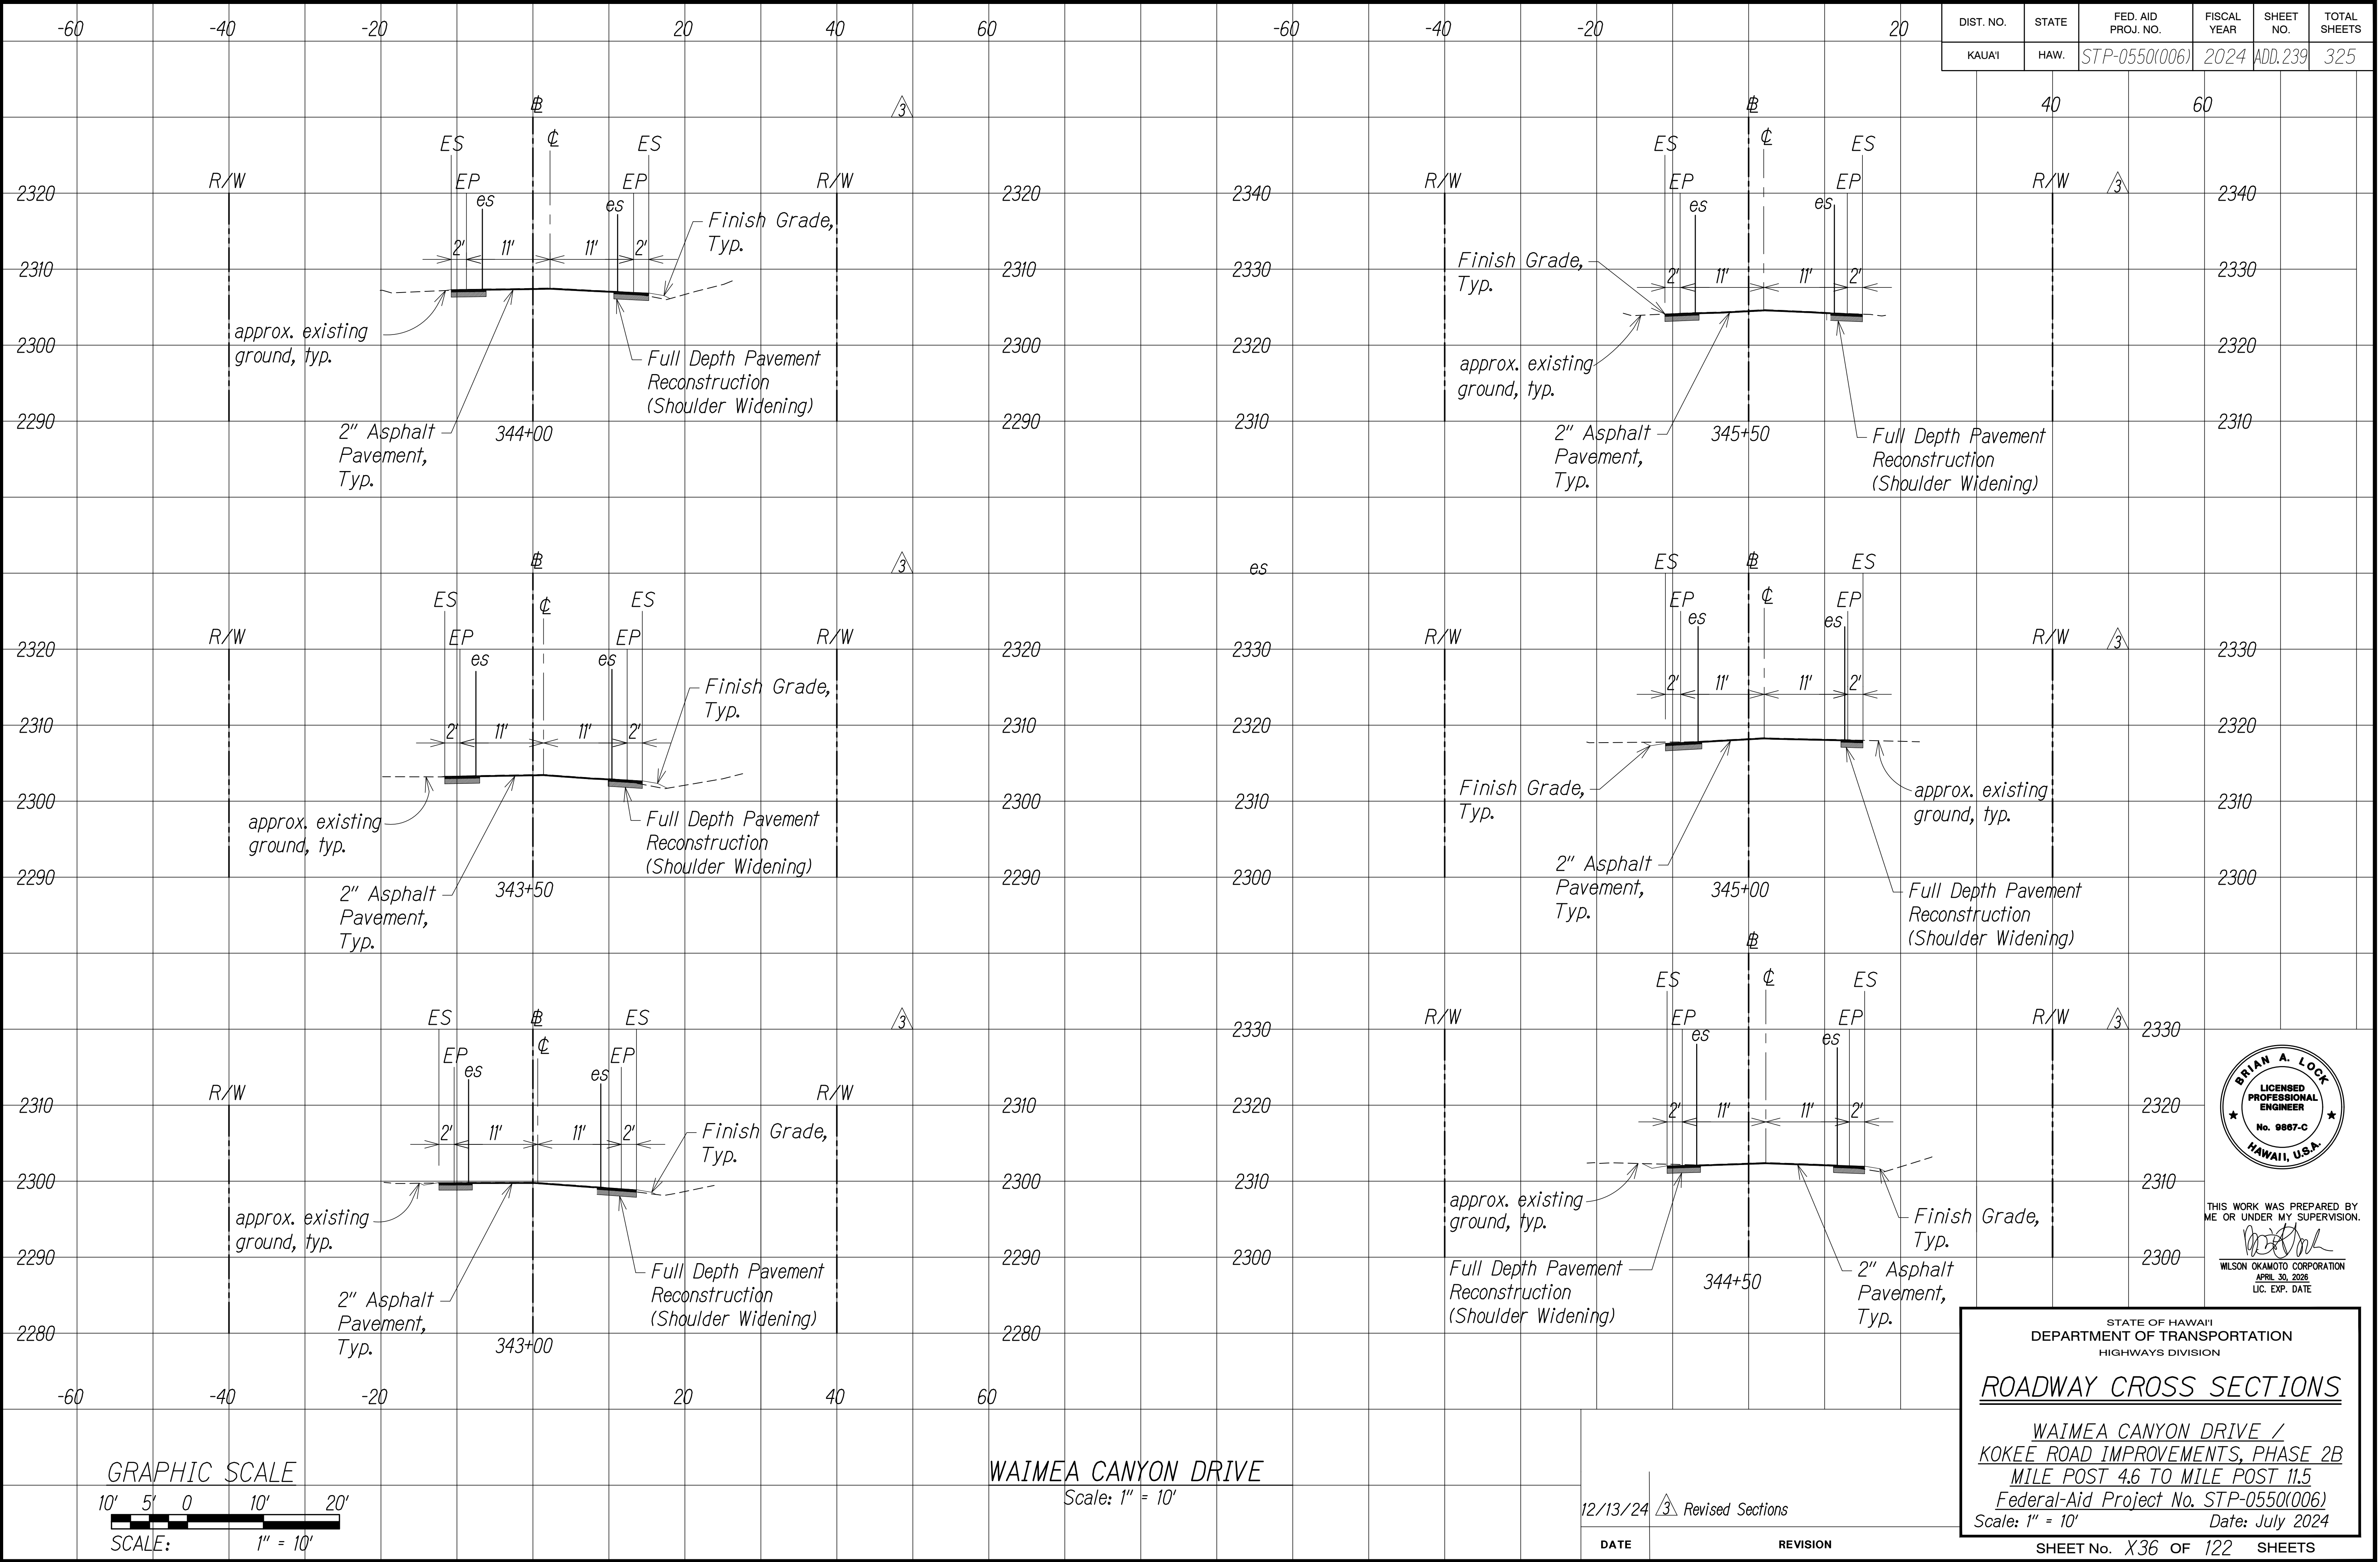

DIST. NO.	STATE	FED. AID PROJ. NO.	FISCAL YEAR	SHEET NO.	TOTAL SHEETS
KAUA'I	HAW.	STP-0550(006)	2024	ADD.239	325

SURVEY PLOTTED BY	DATE
DESIGNED BY	
TRACED BY	
QUANTITIES BY	
CHECKED BY	
ORIGINAL PLAN	
NOTE BOOK	
No.	

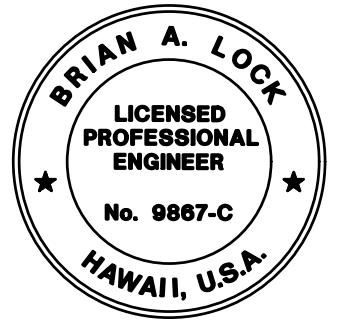

THIS WORK WAS PREPARED BY ME OR UNDER MY SUPERVISION.
[Signature]
WILSON OKAMOTO CORPORATION
APRIL 30, 2026
LIC. EXP. DATE

STATE OF HAWAII
DEPARTMENT OF TRANSPORTATION
HIGHWAYS DIVISION


ROADWAY CROSS SECTIONS

WAIMEA CANYON DRIVE /
KOEKEE ROAD IMPROVEMENTS, PHASE 2B
MILE POST 4.6 TO MILE POST 11.5
Federal-Aid Project No. STP-0550(006)
Scale: 1" = 10' Date: July 2024

12/13/24 3 Revised Sections


DATE	REVISION
------	----------

SHEET No. X36 OF 122 SHEETS

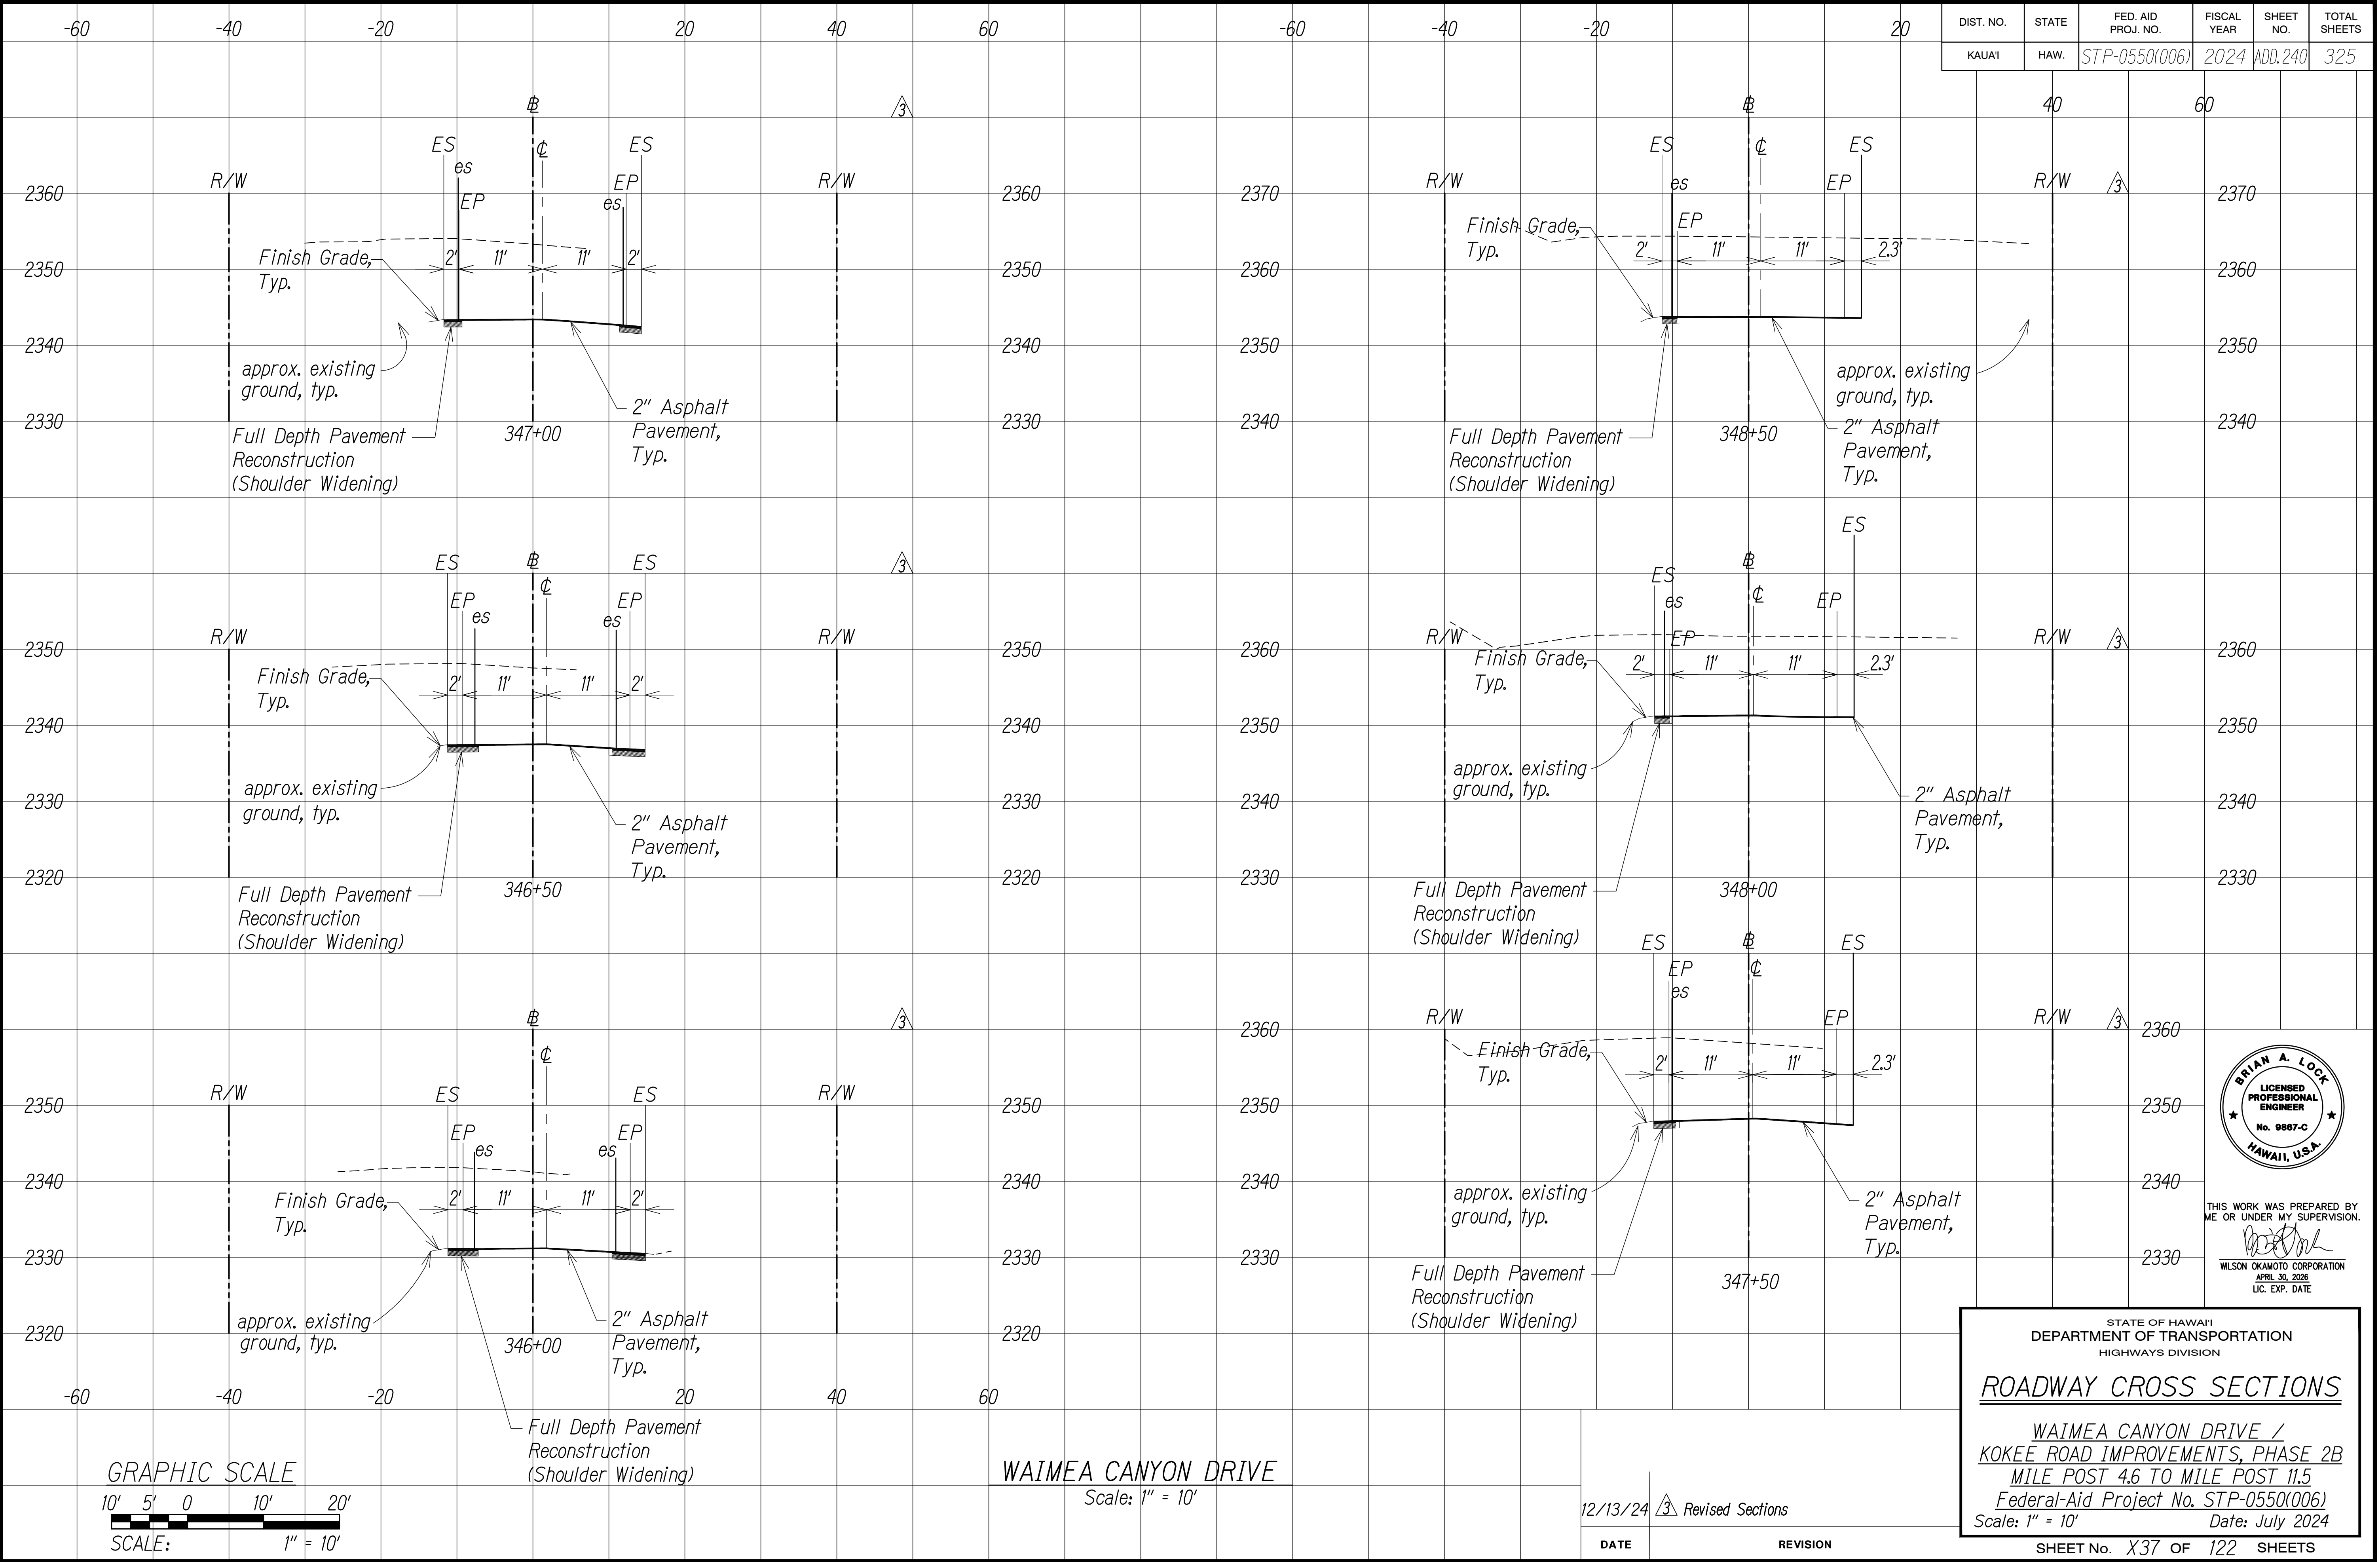

DIST. NO.	STATE	FED. AID PROJ. NO.	FISCAL YEAR	SHEET NO.	TOTAL SHEETS
KAUA'I	HAW.	STP-0550(006)	2024	ADD.240	325

SURVEY PLOTTED BY	DATE
DESIGNED BY	
TRACED BY	
QUANTITIES BY	
CHECKED BY	
ORIGINAL PLAN	
NOTE BOOK	
No.	

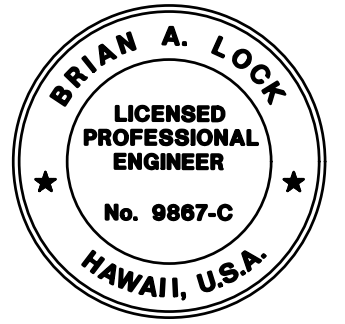

THIS WORK WAS PREPARED BY ME OR UNDER MY SUPERVISION.
[Signature]
WILSON OKAMOTO CORPORATION
APRIL 30, 2026
LIC. EXP. DATE

STATE OF HAWAII
DEPARTMENT OF TRANSPORTATION
HIGHWAYS DIVISION


ROADWAY CROSS SECTIONS

WAIMEA CANYON DRIVE /
KOEKE ROAD IMPROVEMENTS, PHASE 2B
MILE POST 4.6 TO MILE POST 11.5
Federal-Aid Project No. STP-0550(006)
Scale: 1" = 10' Date: July 2024

12/13/24 3 Revised Sections

DATE	REVISION
------	----------


SHEET No. X37 OF 122 SHEETS

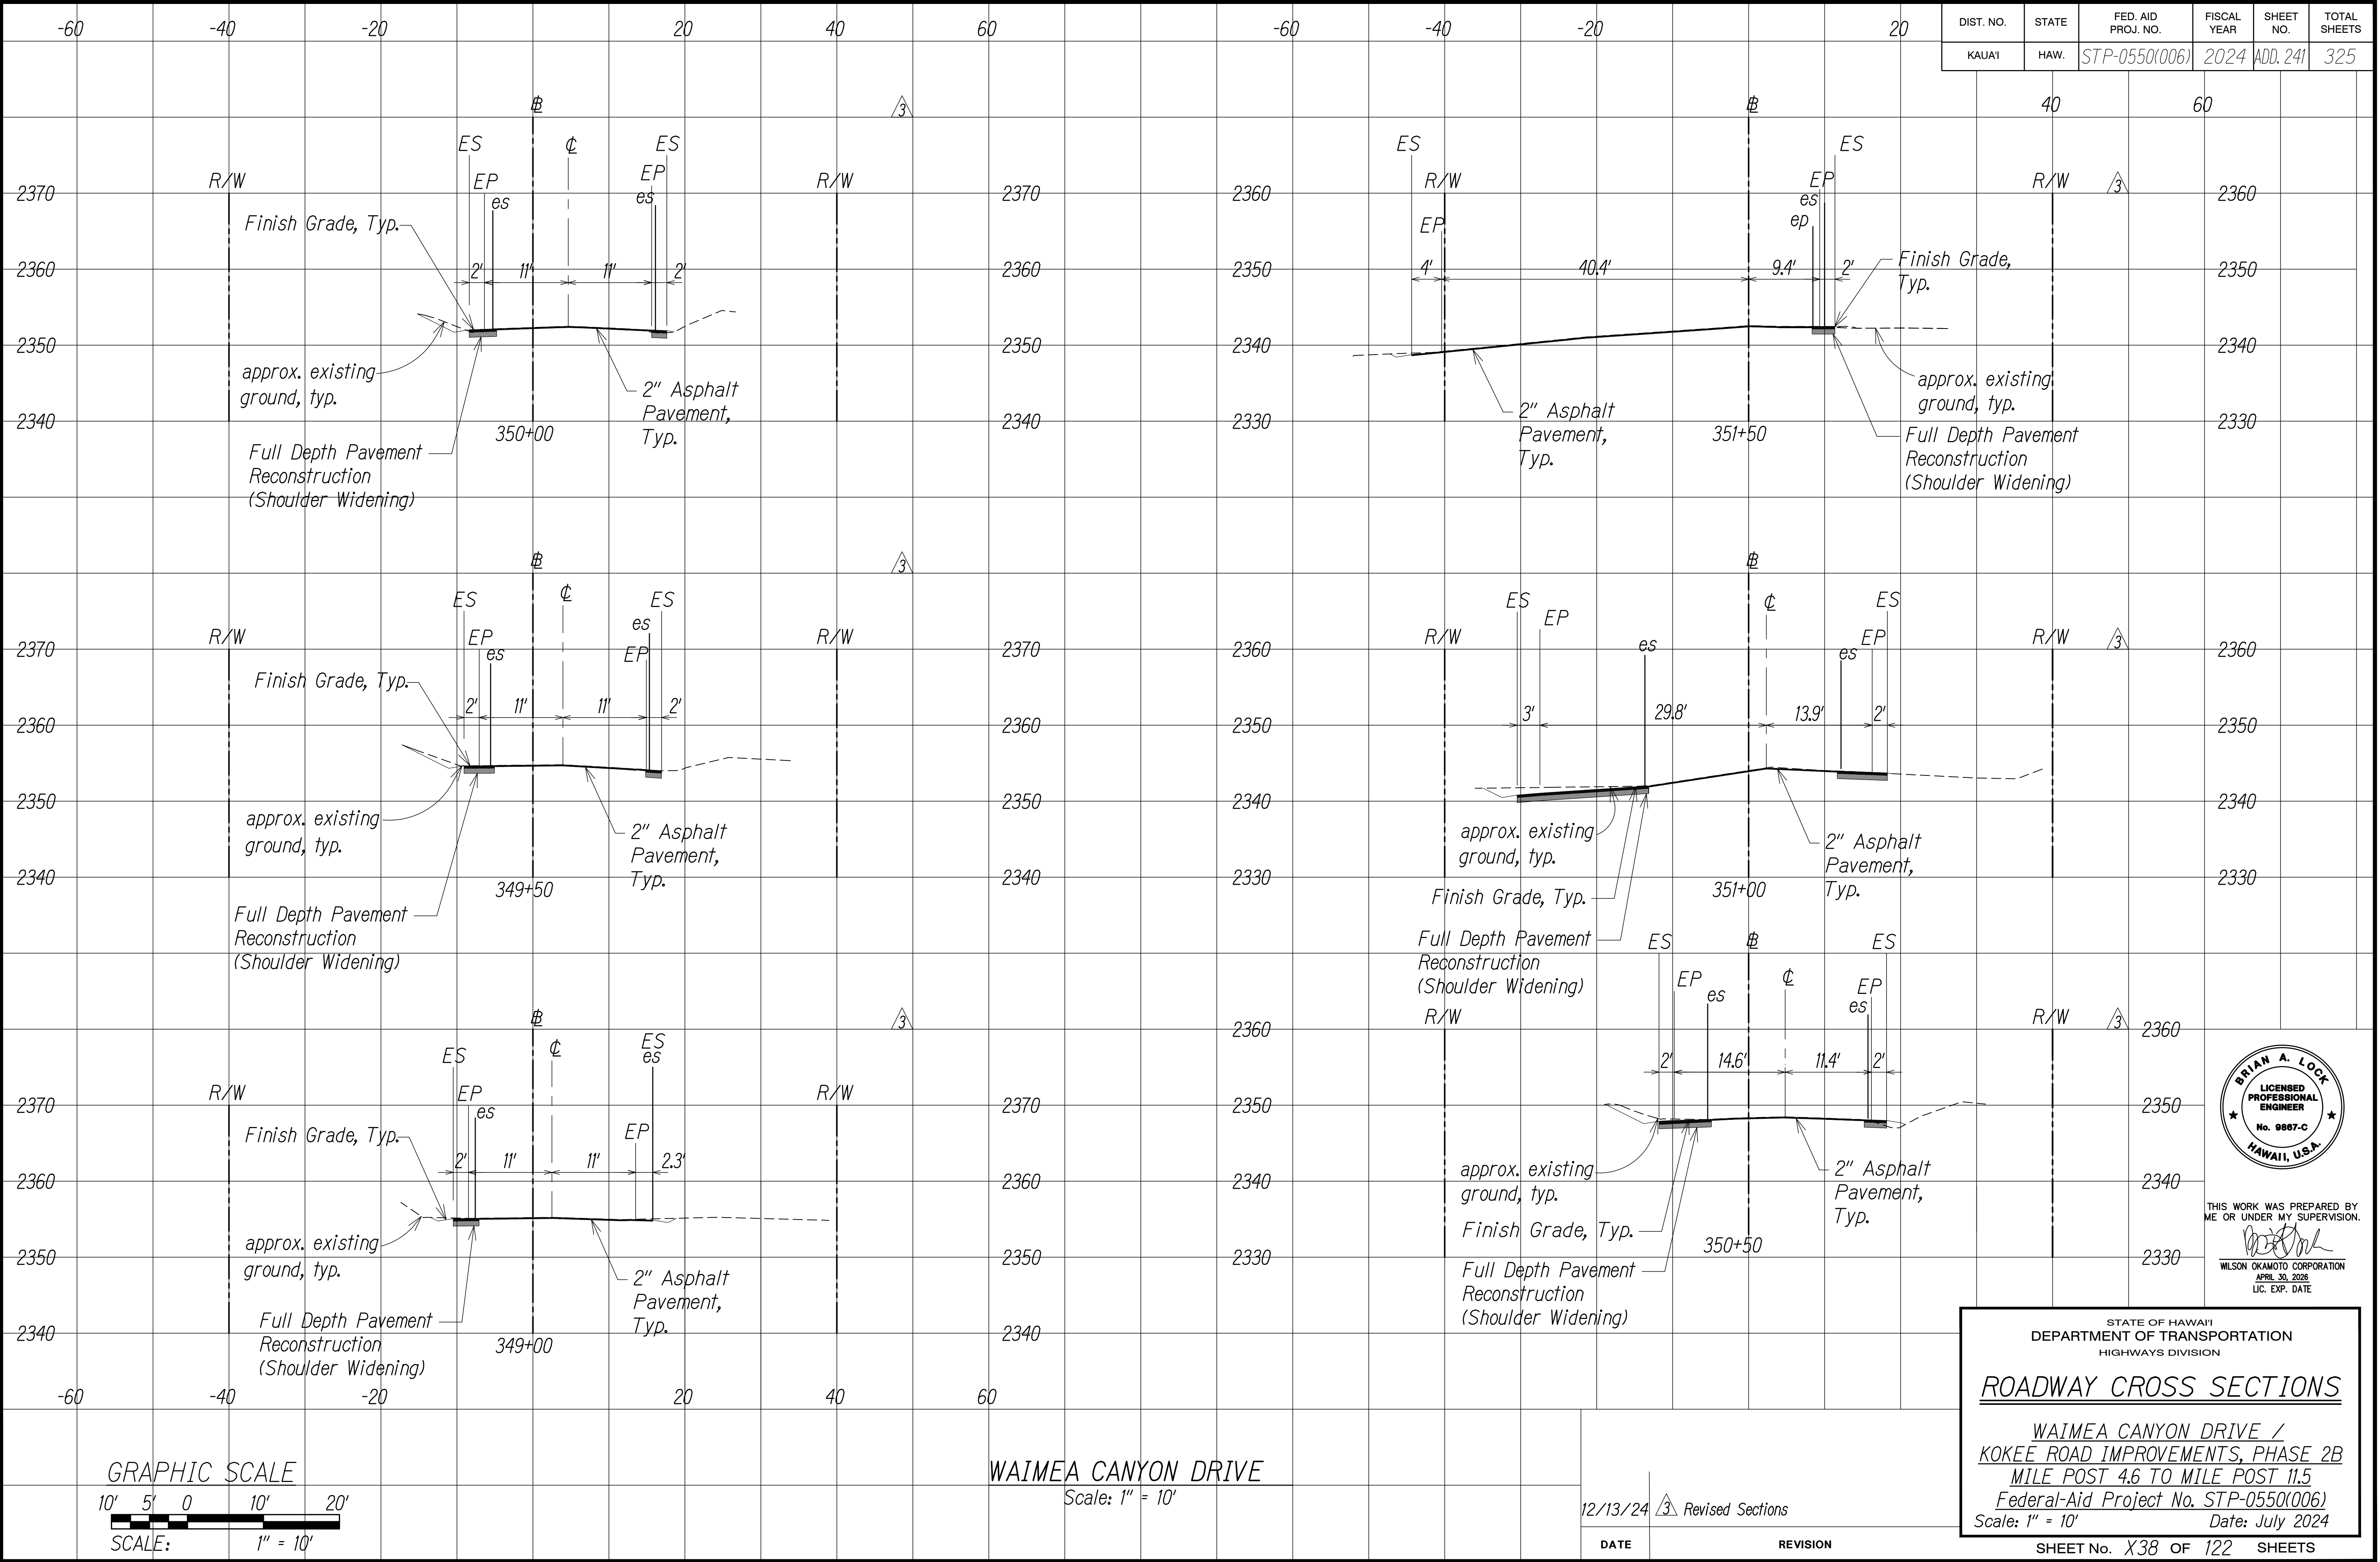

DIST. NO.	STATE	FED. AID PROJ. NO.	FISCAL YEAR	SHEET NO.	TOTAL SHEETS
KAUA'I	HAW.	STP-0550(006)	2024	ADD. 241	325

SURVEY PLOTTED BY	DATE
DESIGNED BY	
TRACED BY	
QUANTITIES BY	
CHECKED BY	


ORIGINAL PLAN	No.
NOTE BOOK	

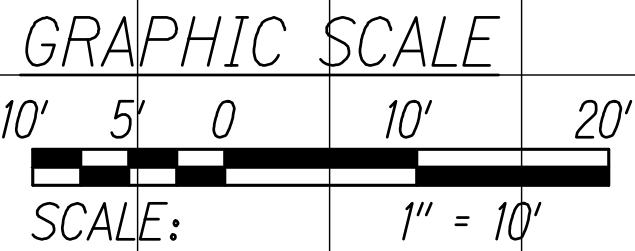

WAIMEA CANYON DRIVE
Scale: 1" = 10'

12/13/24 3 Revised Sections


DATE REVISION

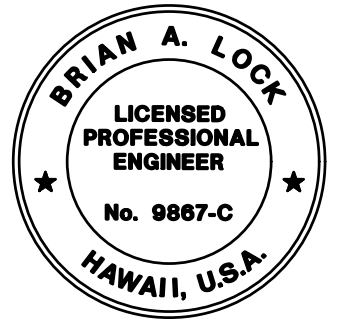

THIS WORK WAS PREPARED BY ME OR UNDER MY SUPERVISION.
WILSON OKAMOTO CORPORATION
APRIL 30, 2026
LIC. EXP. DATE


STATE OF HAWAII
DEPARTMENT OF TRANSPORTATION
HIGHWAYS DIVISION
ROADWAY CROSS SECTIONS
WAIMEA CANYON DRIVE /
KOEKEE ROAD IMPROVEMENTS, PHASE 2B
MILE POST 4.6 TO MILE POST 11.5
Federal-Aid Project No. STP-0550(006)
Scale: 1" = 10' Date: July 2024

SHEET No. X38 OF 122 SHEETS

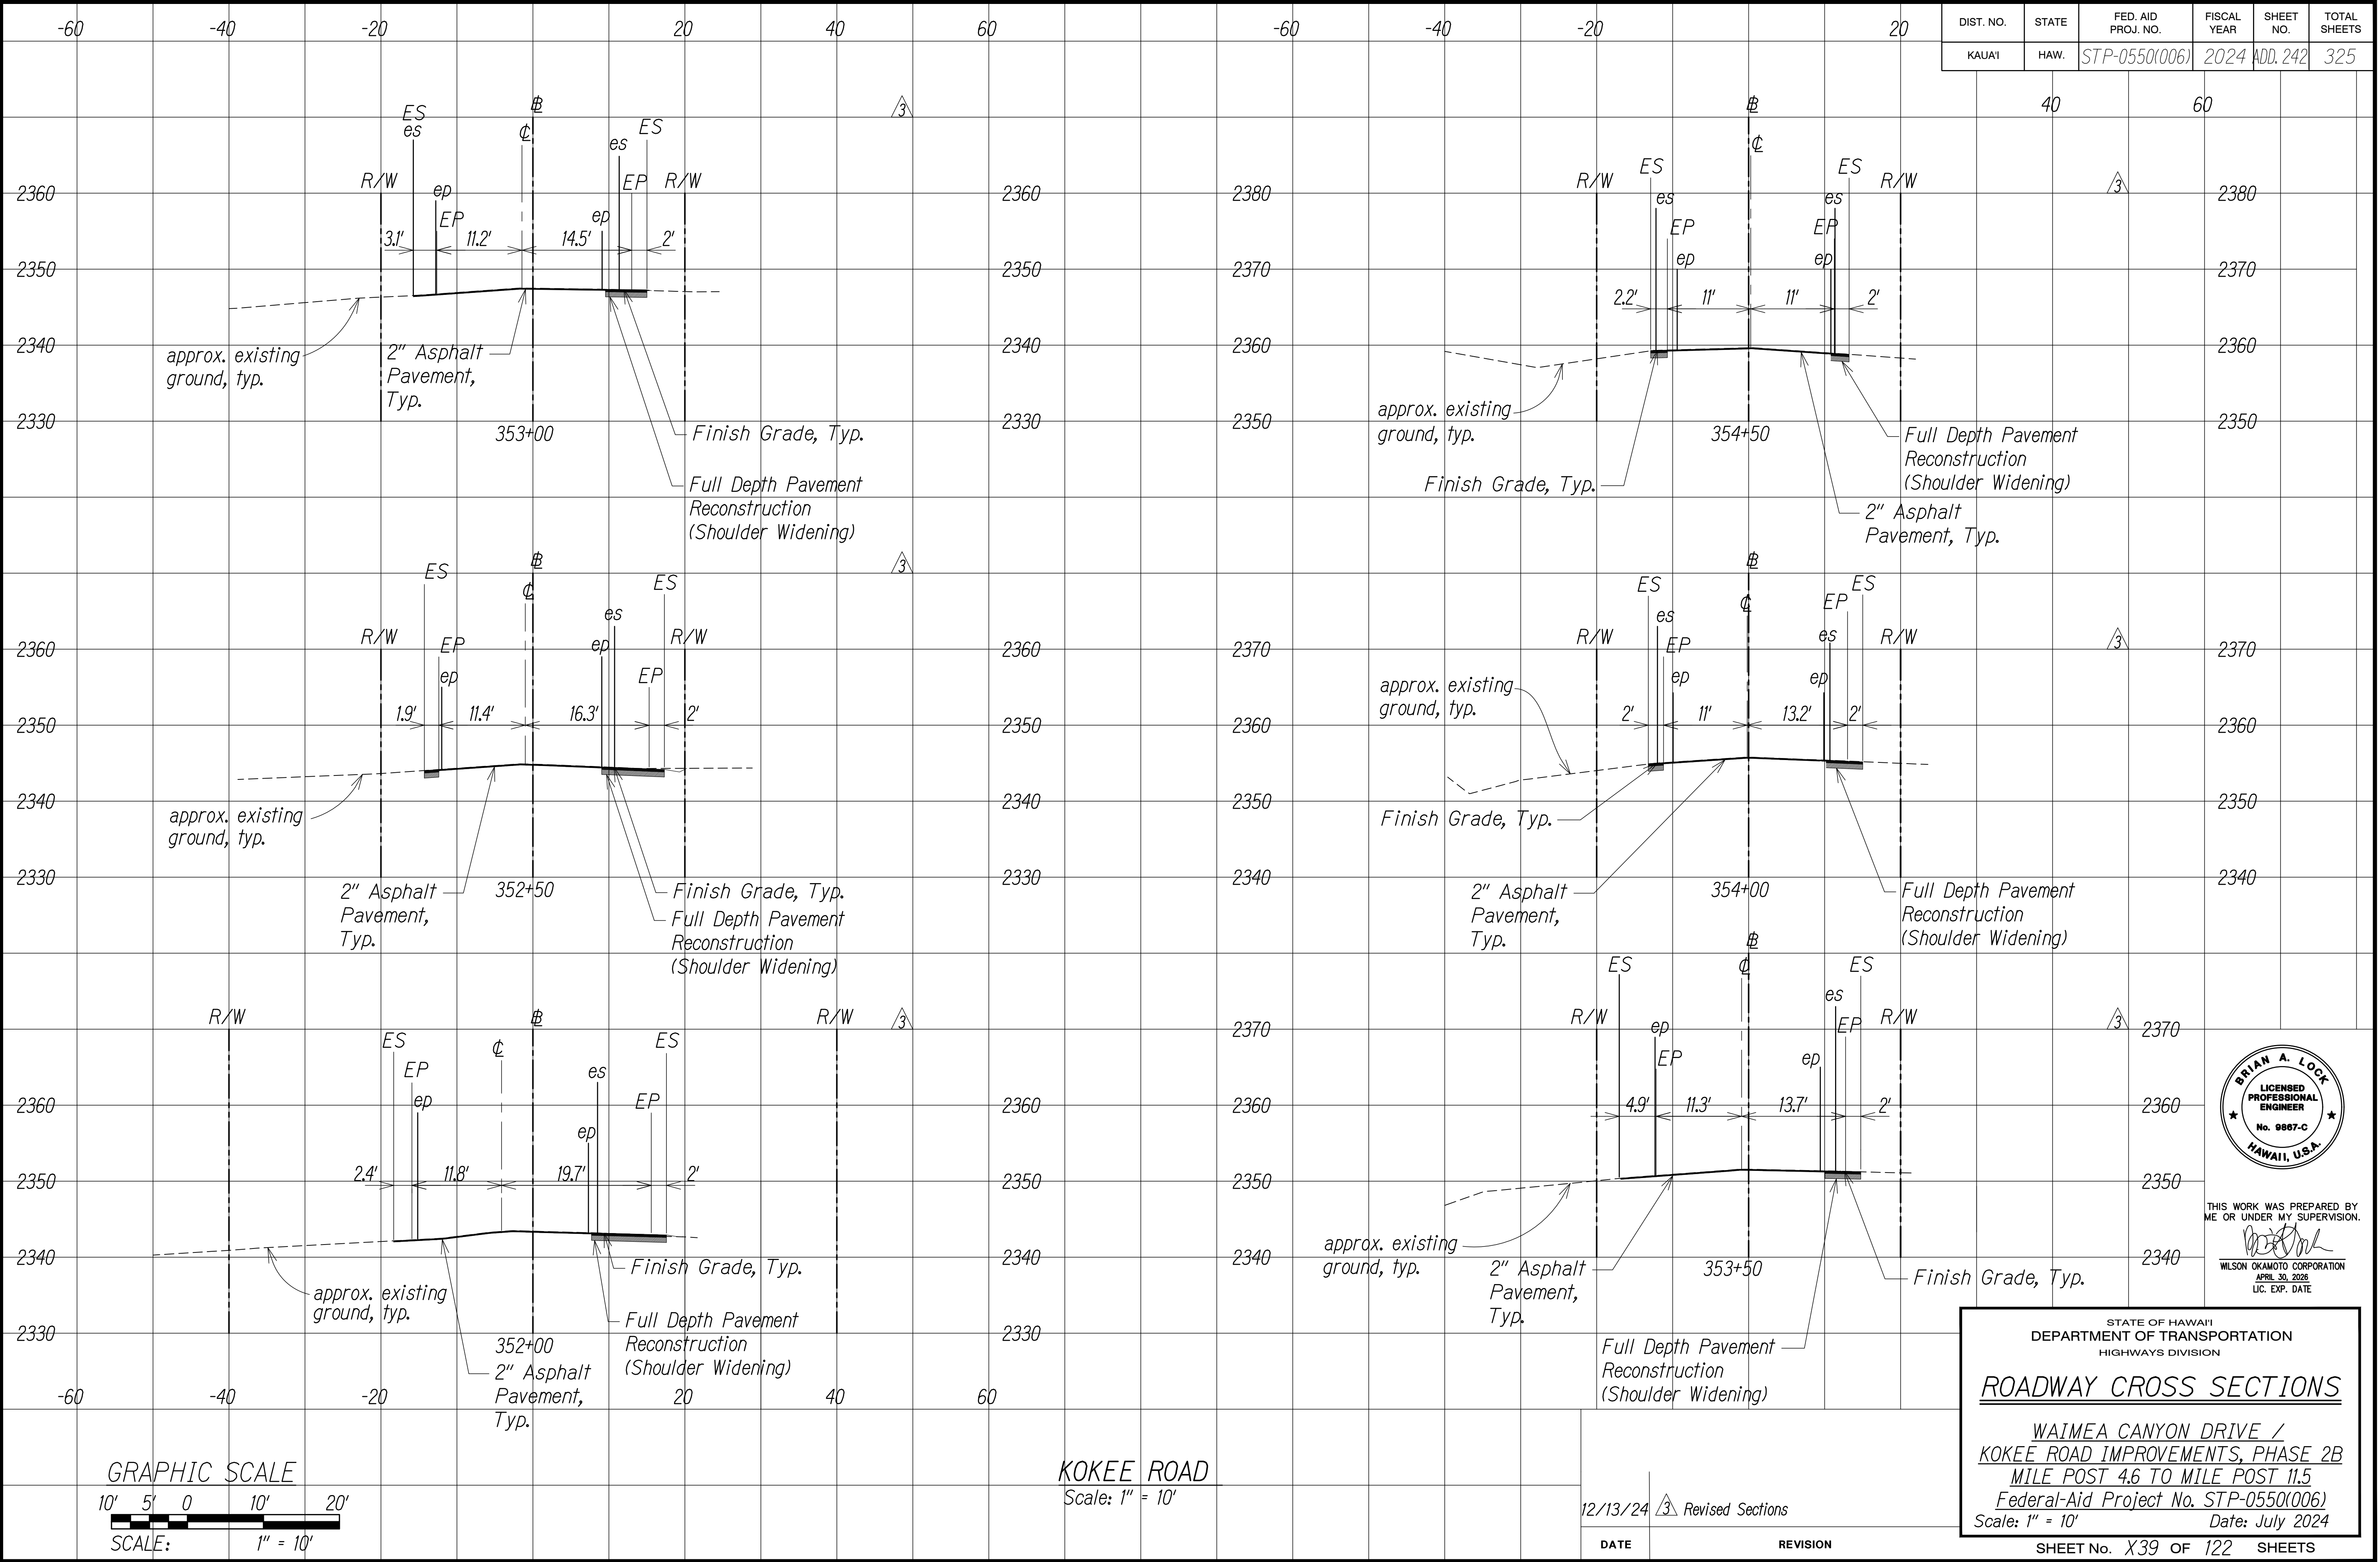


DIST. NO.	STATE	FED. AID PROJ. NO.	FISCAL YEAR	SHEET NO.	TOTAL SHEETS
KAUAI	HAW.	STP-0550(006)	2024	ADD. 242	325

SURVEY PLOTTED BY	DATE
DESIGNED BY	
TRACED BY	
QUANTITIES BY	
CHECKED BY	
NOTE BOOK	
No.	

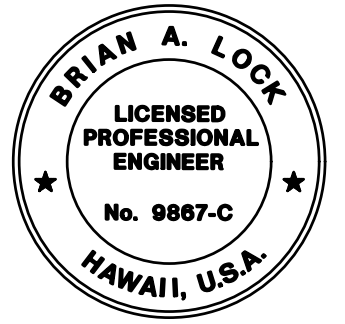


THIS WORK WAS PREPARED BY
ME OR UNDER MY SUPERVISION.
[Signature]
WILSON OKAMOTO CORPORATION
APRIL 30, 2026
LIC. EXP. DATE

DIST. NO.	STATE	FED. AID PROJ. NO.	FISCAL YEAR	SHEET NO.	TOTAL SHEETS
KAUAI	HAW.	STP-0550(006)	2024	ADD.243	325

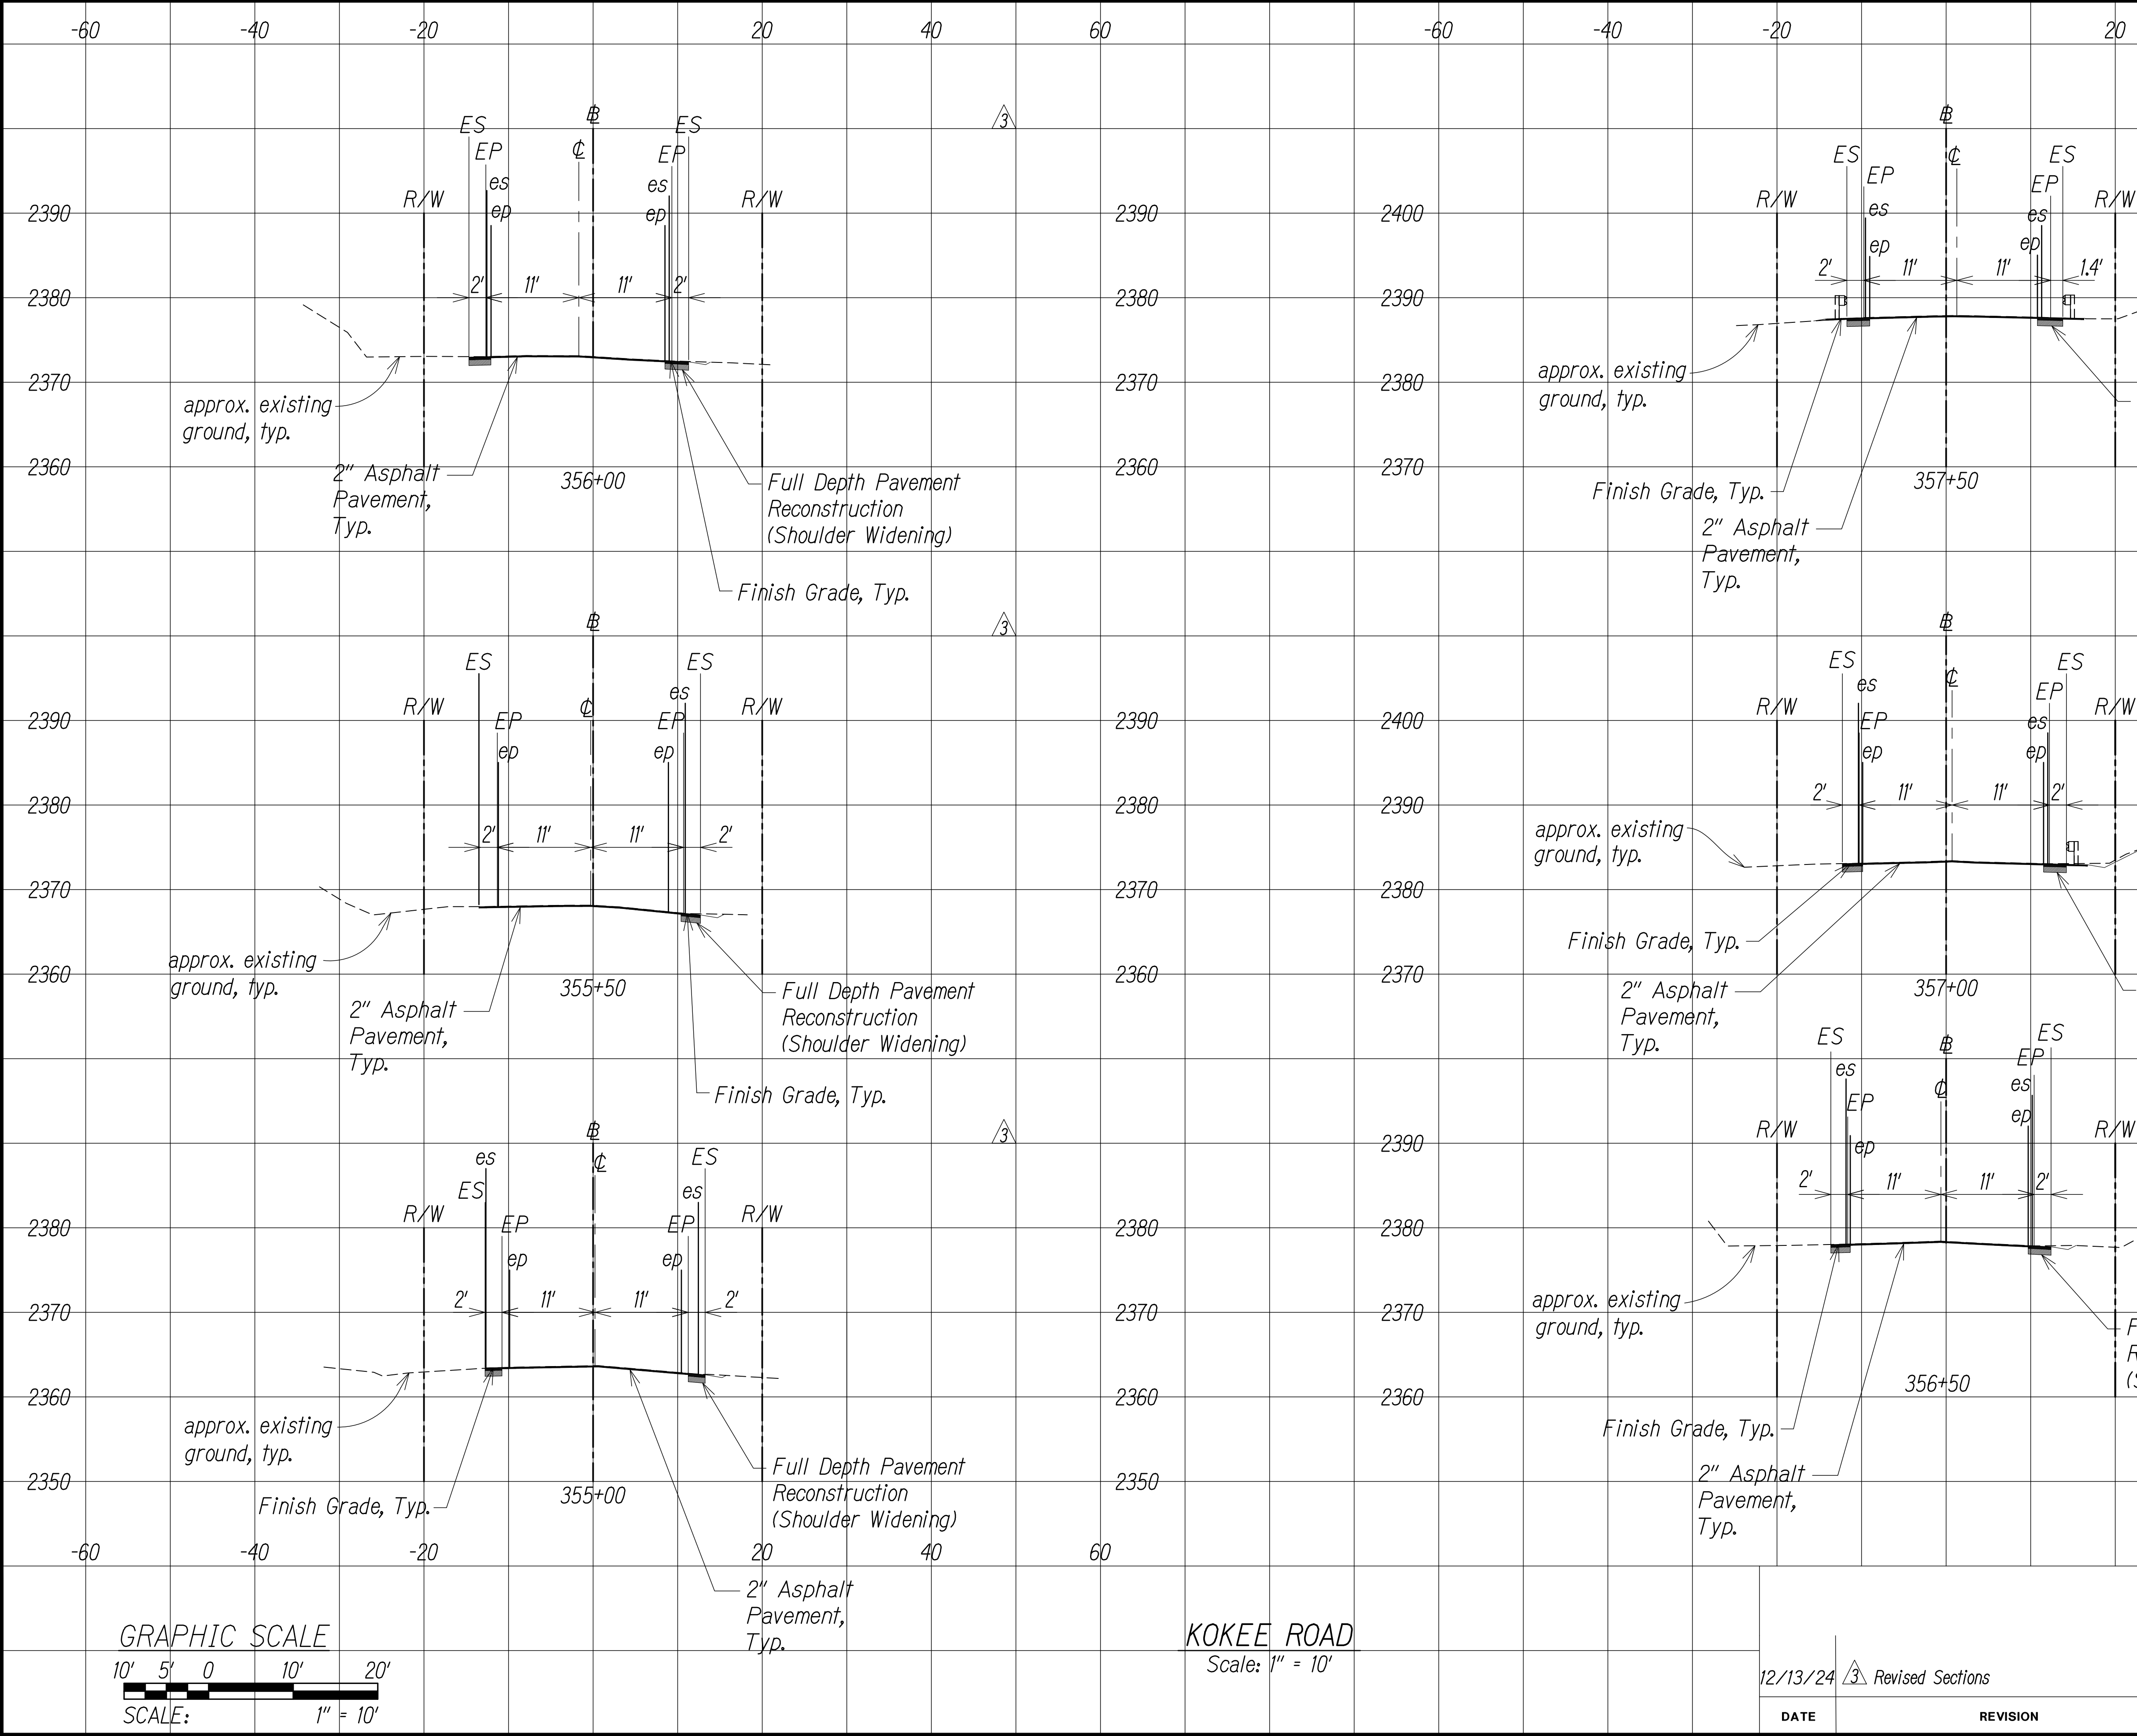

SURVEY PLOTTED BY	DATE
DESIGNED BY	
TRACED BY	
NOTED BY	
QUANTITIES BY	
CHECKED BY	

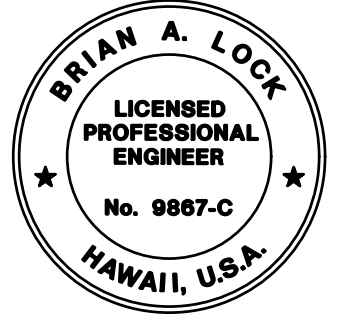

THIS WORK WAS PREPARED BY
ME OR UNDER MY SUPERVISION.
[Signature]
WILSON OKAMOTO CORPORATION
APRIL 30, 2024
LIC. EXP. DATE


STATE OF HAWAII
DEPARTMENT OF TRANSPORTATION
HIGHWAYS DIVISION
ROADWAY CROSS SECTIONS
WAIMEA CANYON DRIVE /
KOEKEE ROAD IMPROVEMENTS, PHASE 2B
MILE POST 4.6 TO MILE POST 11.5
Federal-Aid Project No. STP-0550(006)
Scale: 1" = 10' Date: July 2024

12/13/24 3 Revised Sections

DATE REVISION


SHEET No. X40 OF 122 SHEETS

DIST. NO.	STATE	FED. AID PROJ. NO.	FISCAL YEAR	SHEET NO.	TOTAL SHEETS
KAUAI	HAW.	STP-0550(006)	2024	ADD.244	325

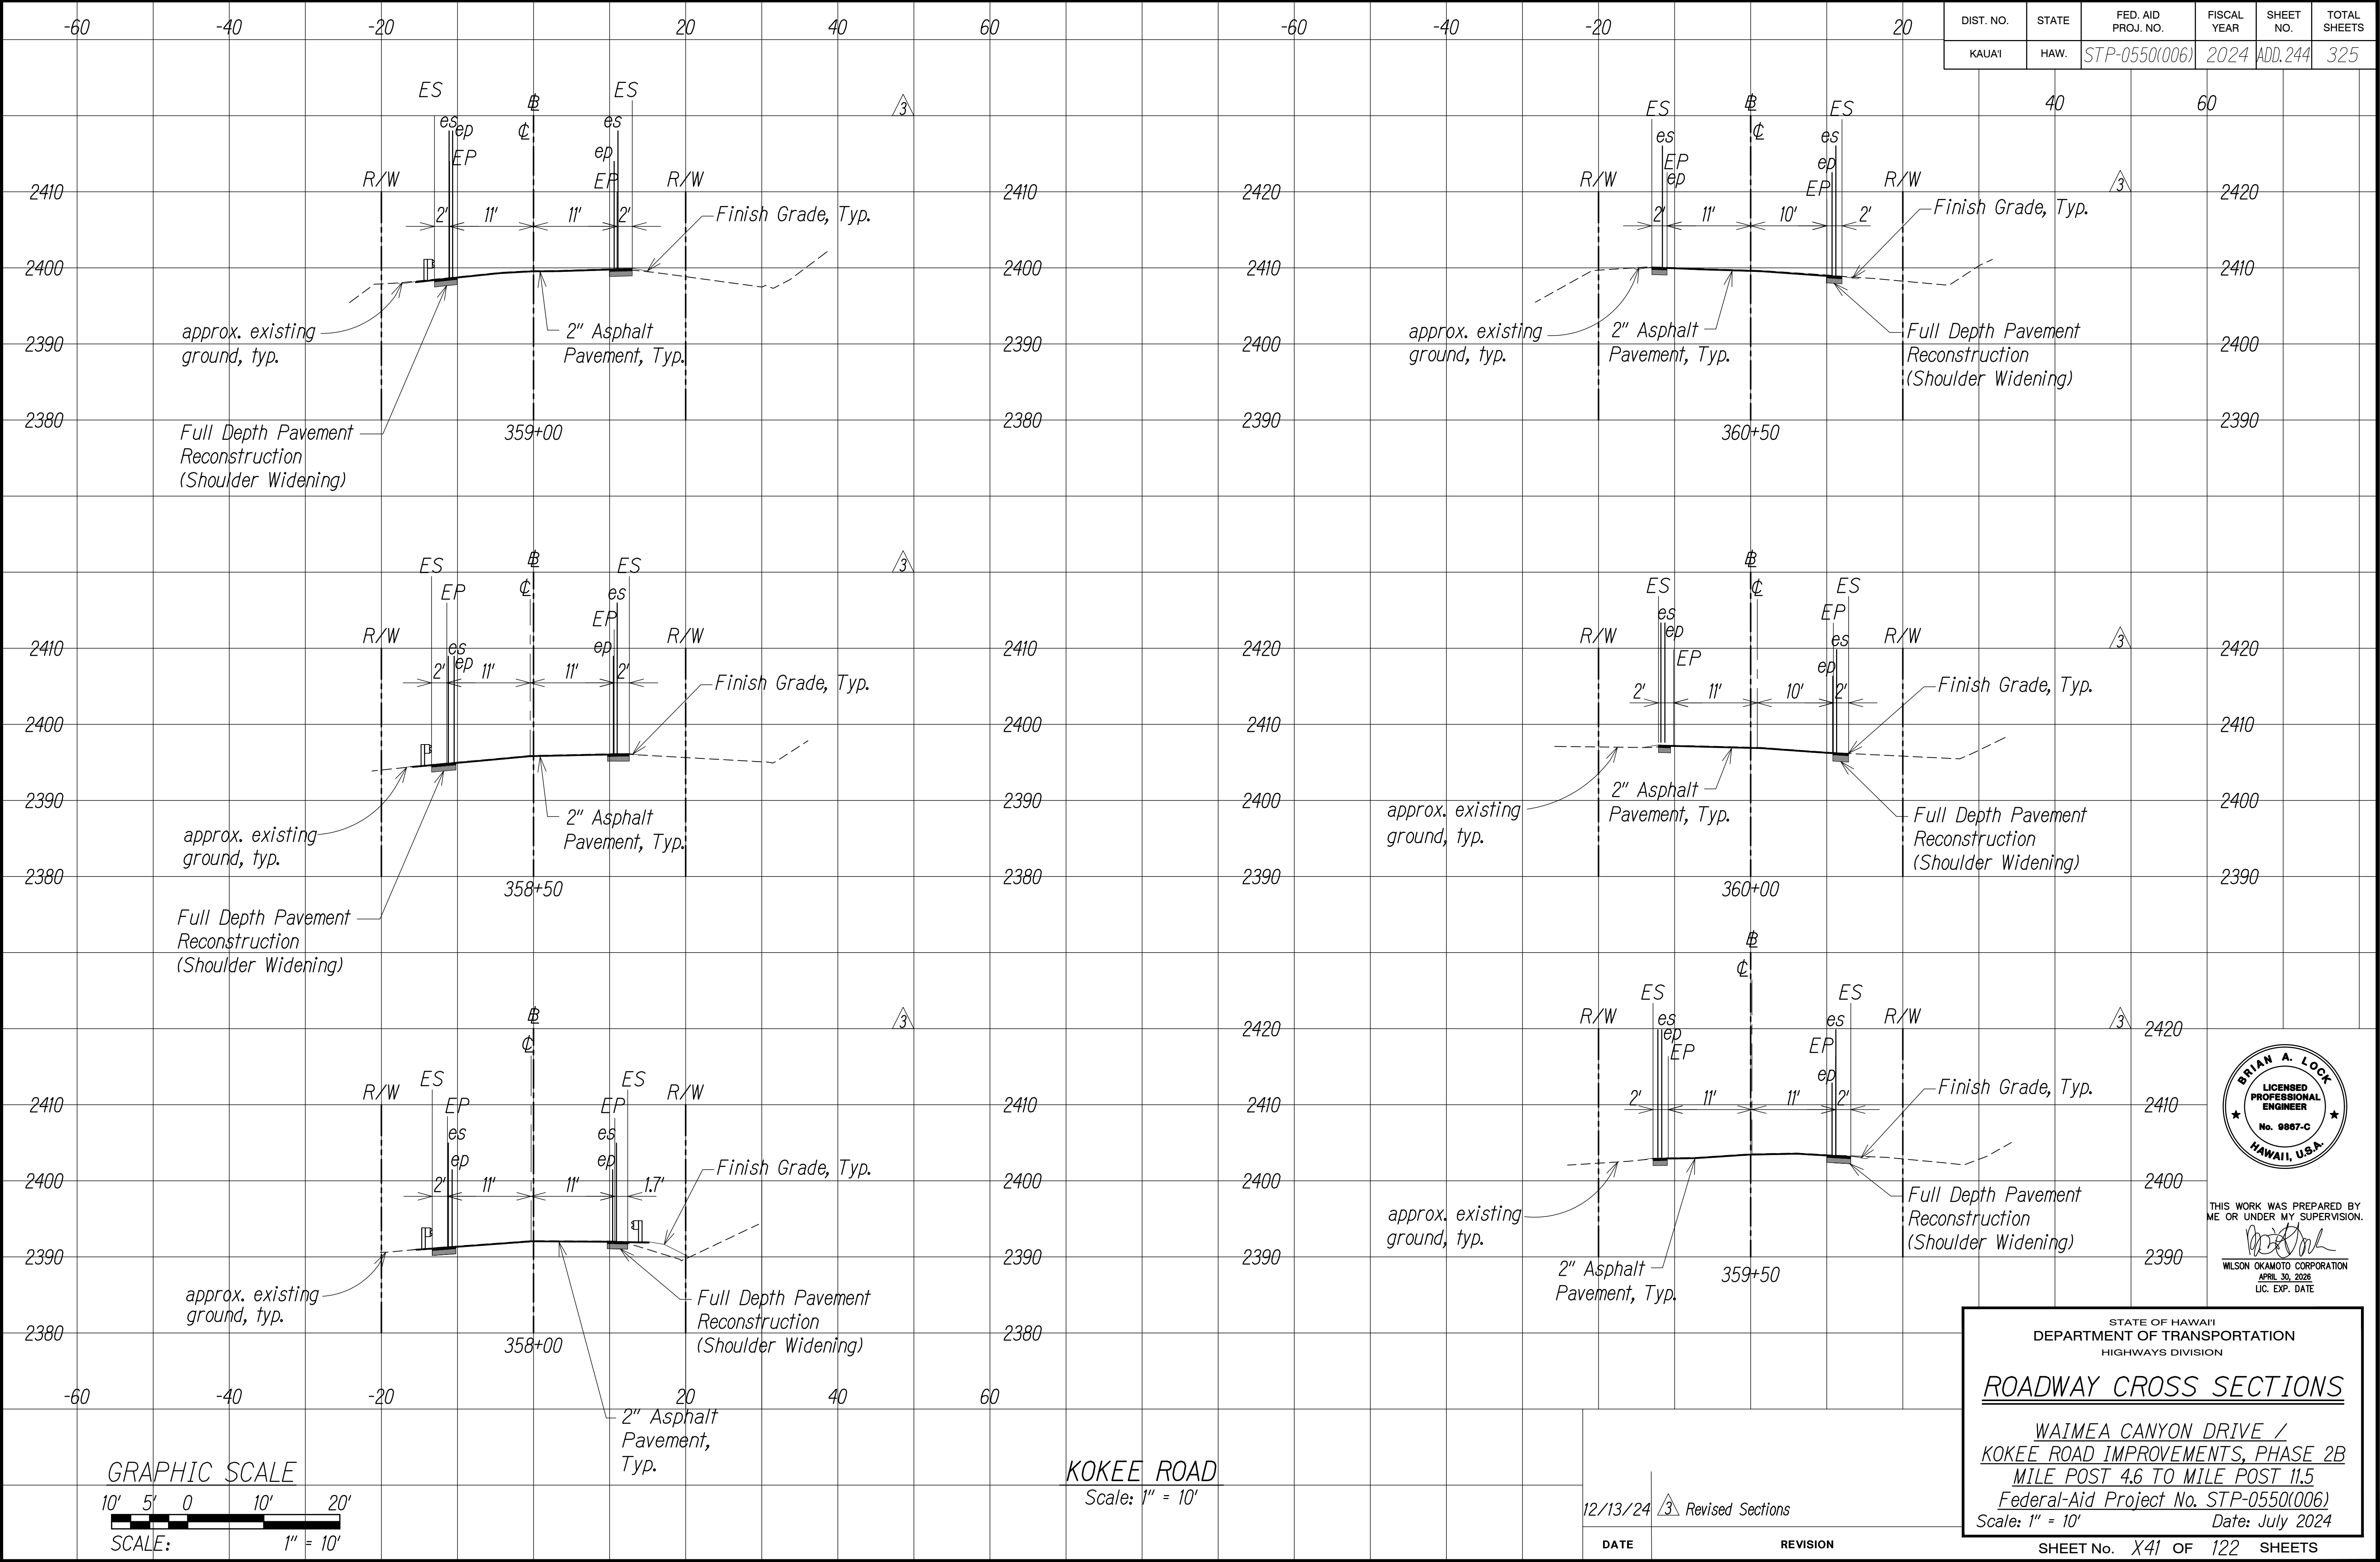

SURVEY PLOTTED BY	DATE
DESIGNED BY	
TRACED BY	
QUANTITIES BY	
CHECKED BY	


ORIGINAL PLAN	NOTE BOOK
No.	No.

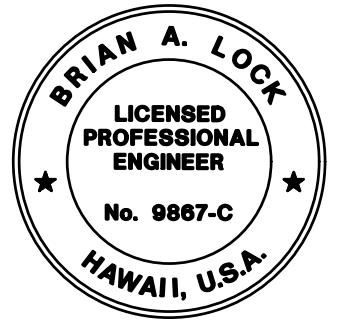

THIS WORK WAS PREPARED BY
ME OR UNDER MY SUPERVISION.

[Signature]


WILSON OKAMOTO CORPORATION
APRIL 30, 2026
LIC. EXP. DATE

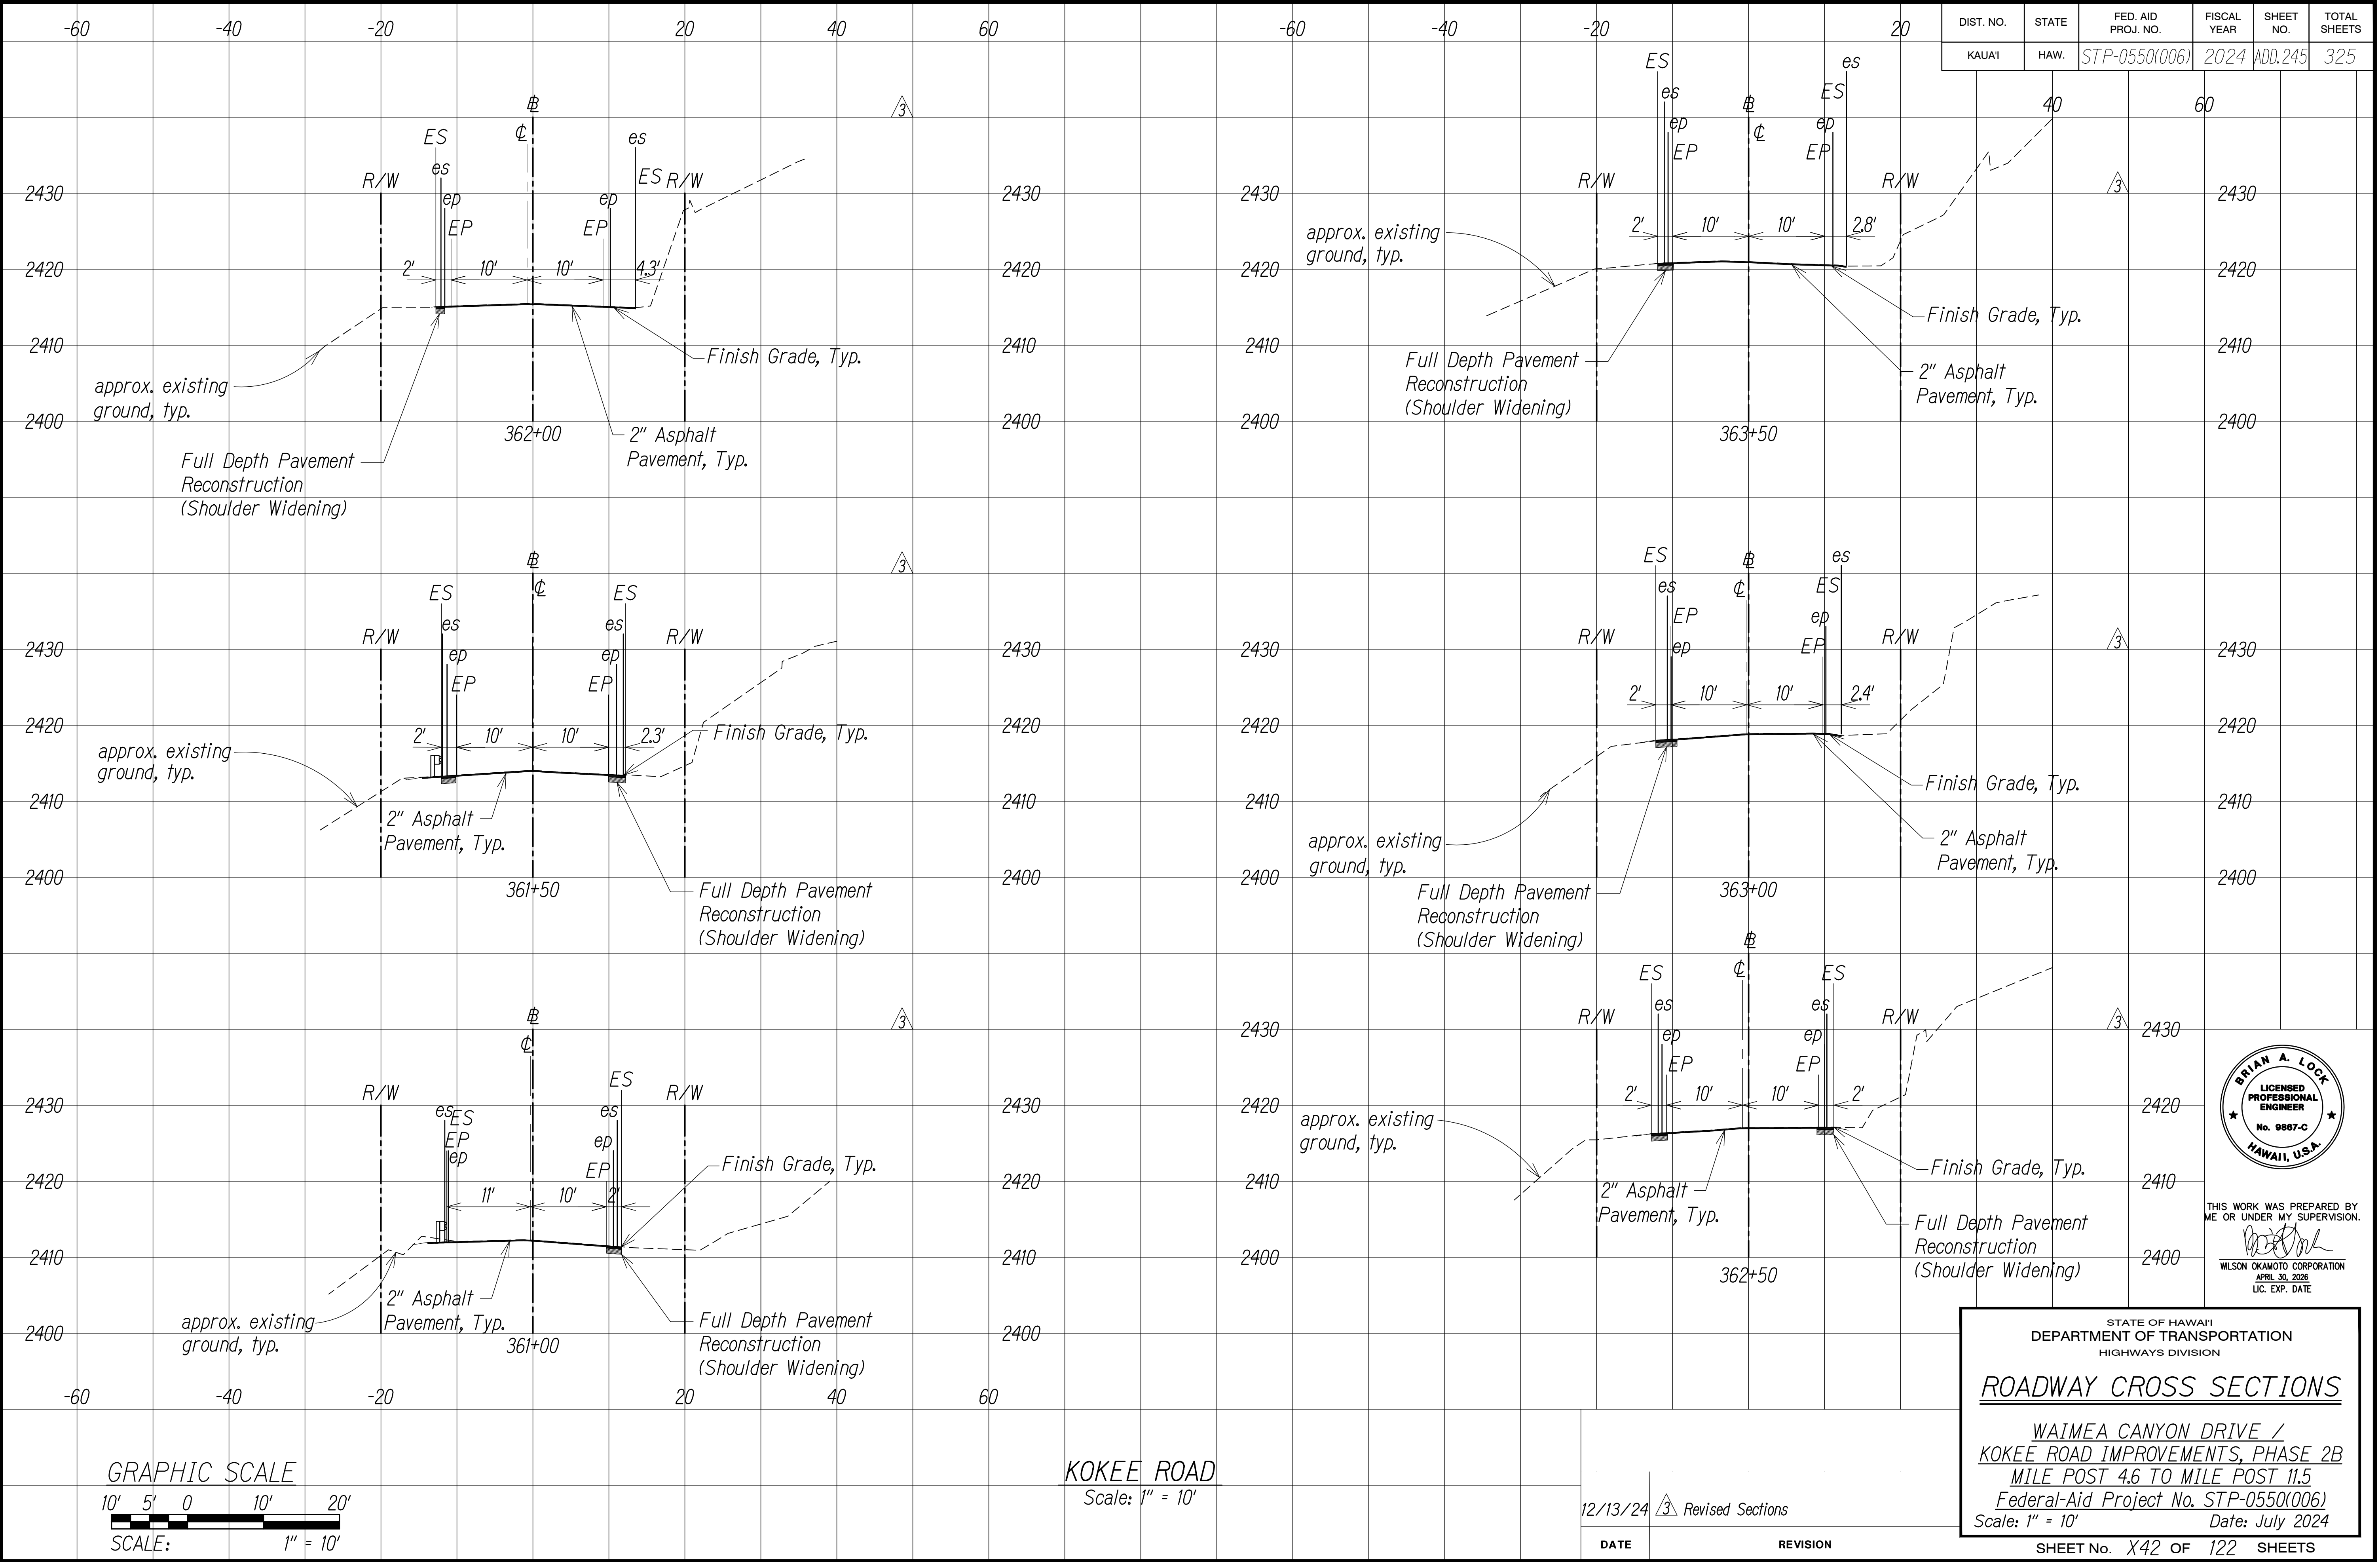

DIST. NO.	STATE	FED. AID PROJ. NO.	FISCAL YEAR	SHEET NO.	TOTAL SHEETS
KAUAI	HAW.	STP-0550(006)	2024	ADD.245	325

SURVEY PLOTTED BY	DATE
DESIGNED BY	
TRACED BY	
QUANTITIES BY	
CHECKED BY	

ORIGINAL PLAN	NOTE BOOK
No.	

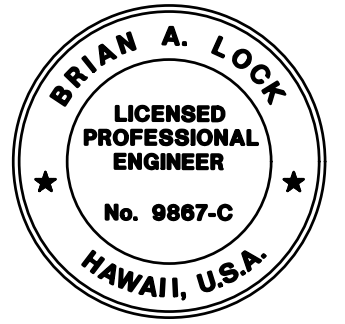

THIS WORK WAS PREPARED BY ME OR UNDER MY SUPERVISION.
[Signature]
WILSON OKAMOTO CORPORATION
APRIL 30, 2026
LIC. EXP. DATE


STATE OF HAWAII
DEPARTMENT OF TRANSPORTATION
HIGHWAYS DIVISION
ROADWAY CROSS SECTIONS
WAIMEA CANYON DRIVE /
KOEKE ROAD IMPROVEMENTS, PHASE 2B
MILE POST 4.6 TO MILE POST 11.5
Federal-Aid Project No. STP-0550(006)
Scale: 1" = 10' Date: July 2024

12/13/24 3 Revised Sections

DATE	REVISION
------	----------


SHEET No. X42 OF 122 SHEETS

ADD245

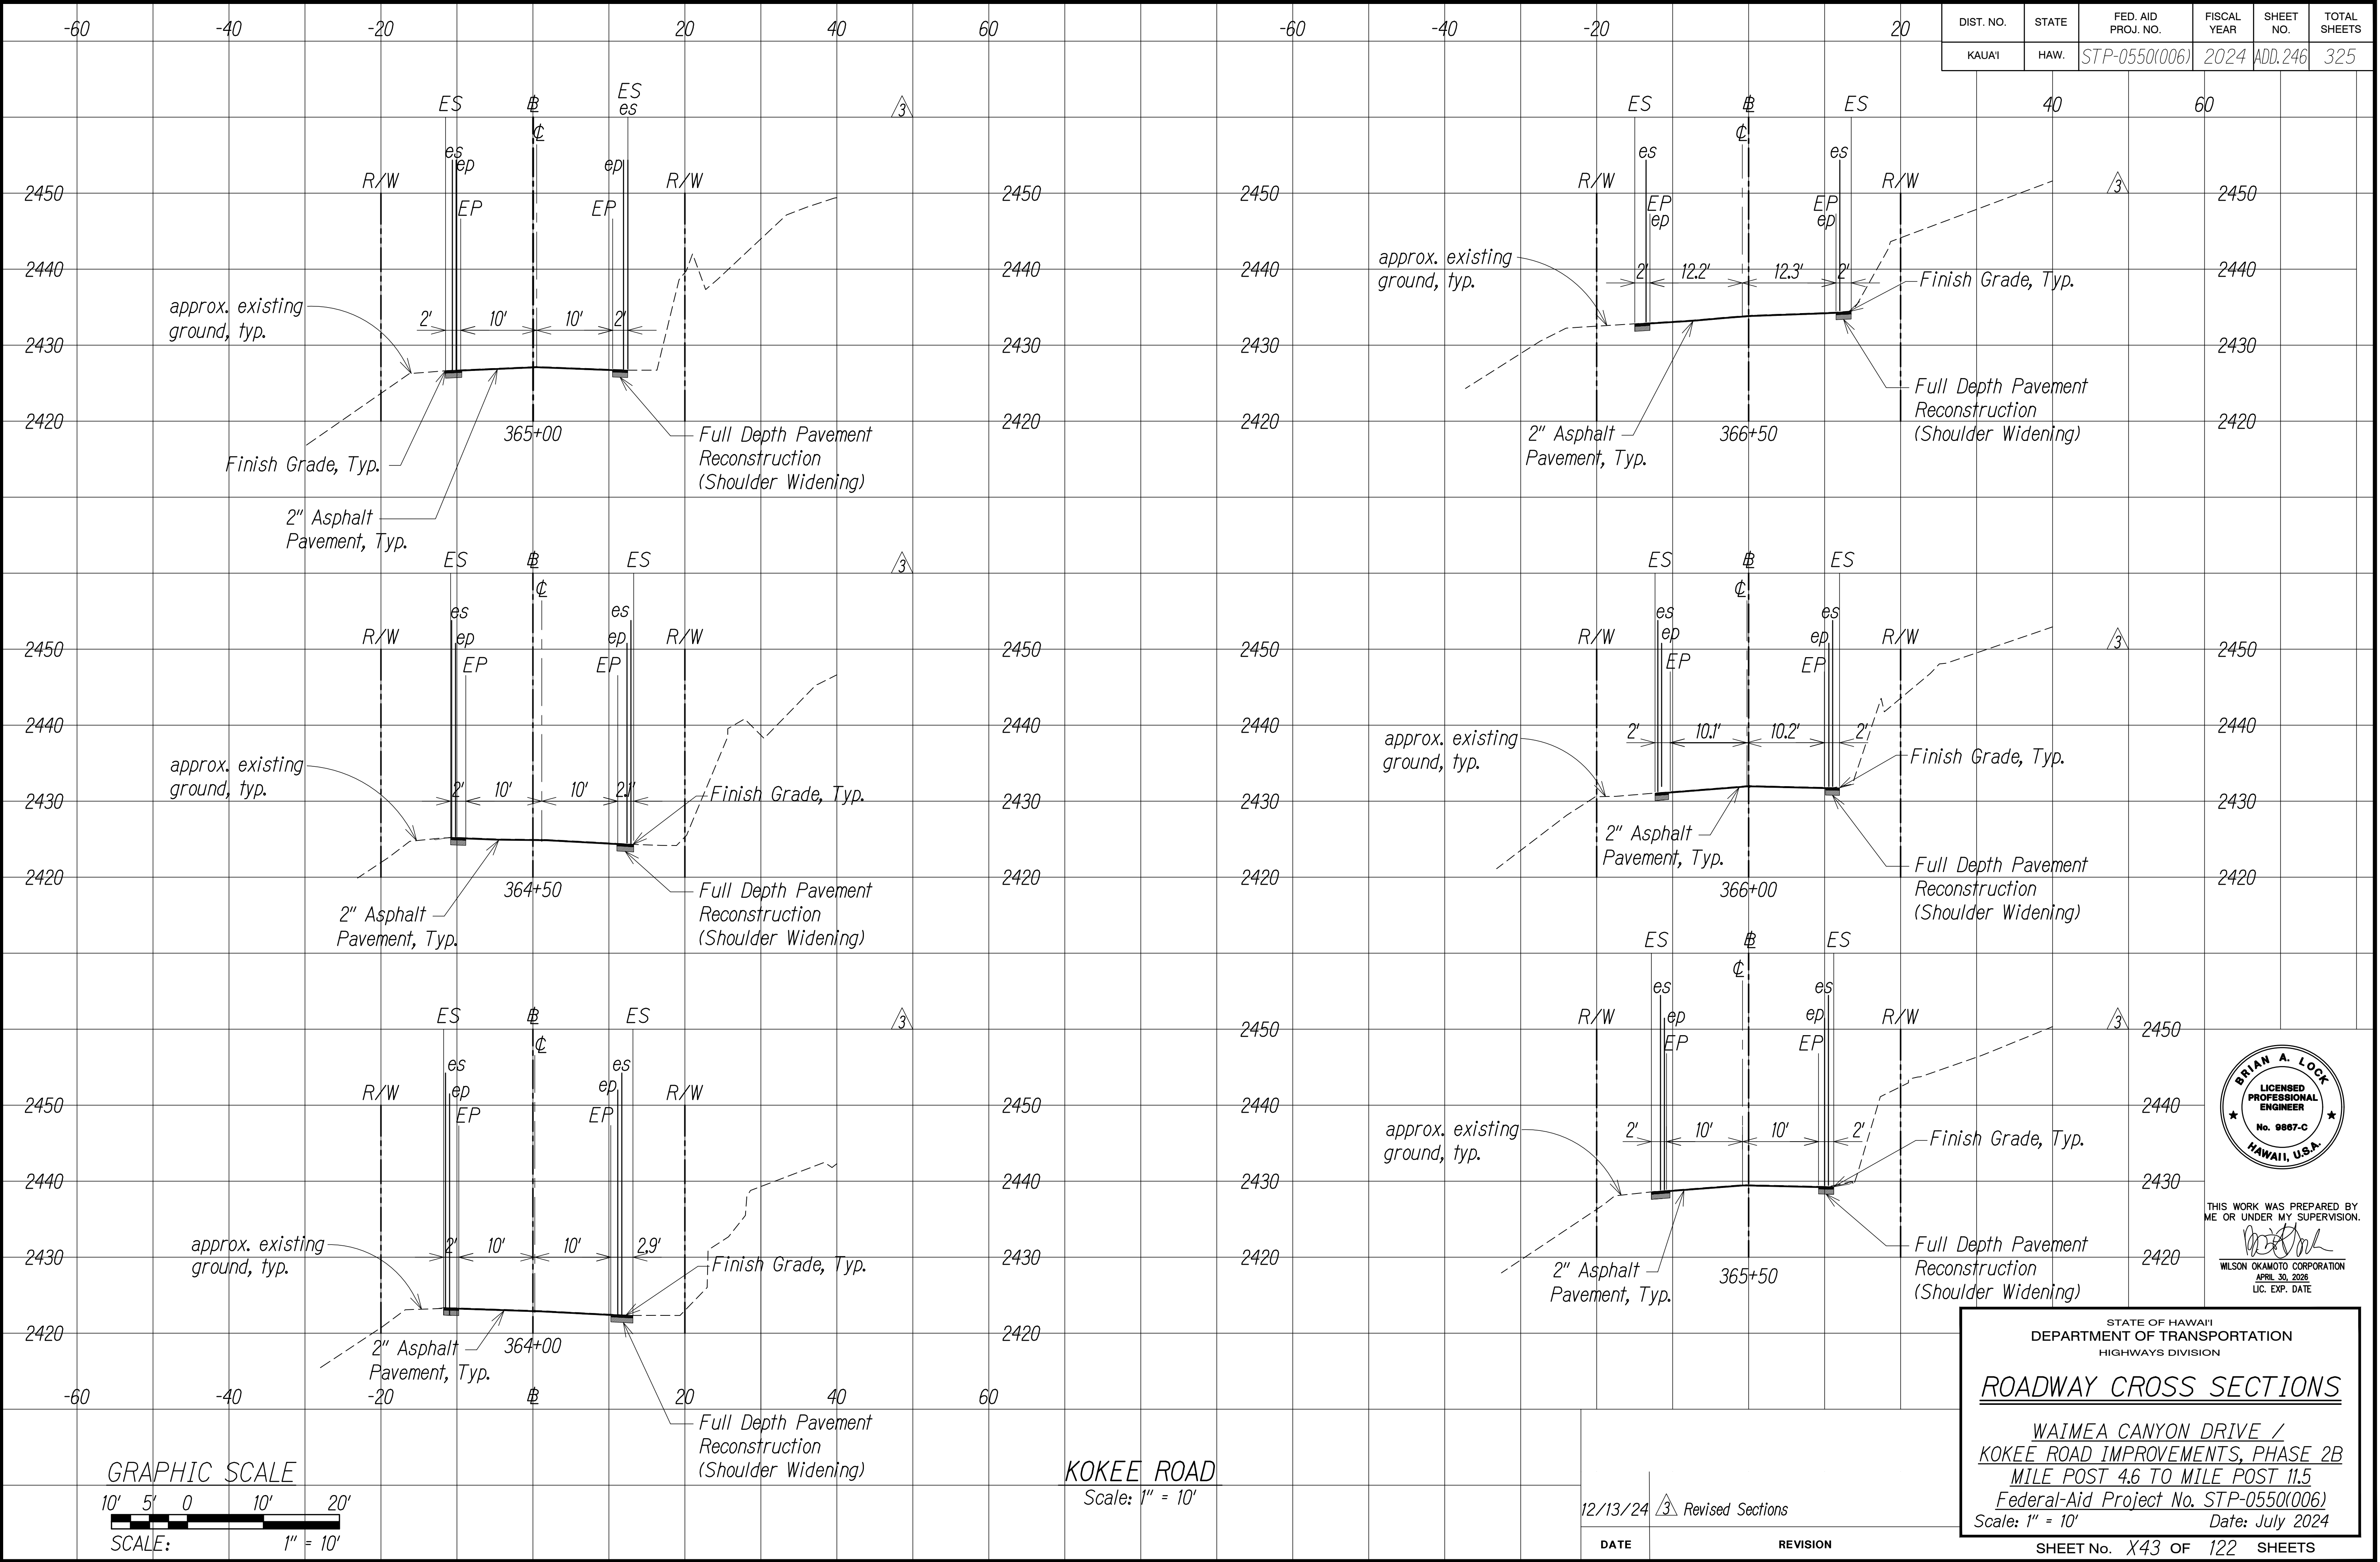

DIST. NO.	STATE	FED. AID PROJ. NO.	FISCAL YEAR	SHEET NO.	TOTAL SHEETS
KAUAI	HAW.	STP-0550(006)	2024	ADD.246	325

SURVEY PLOTTED BY	DATE
DESIGNED BY	
TRACED BY	
NOTED BY	
QUANTITIES BY	
CHECKED BY	

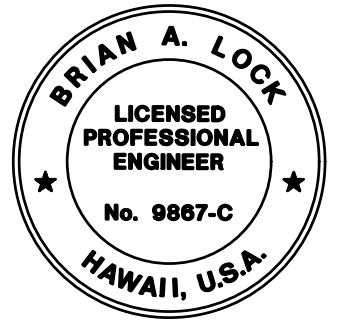


THIS WORK WAS PREPARED BY
ME OR UNDER MY SUPERVISION.
[Signature]
WILSON OKAMOTO CORPORATION
APRIL 30, 2026
LIC. EXP. DATE

STATE OF HAWAII
DEPARTMENT OF TRANSPORTATION
HIGHWAYS DIVISION
ROADWAY CROSS SECTIONS
WAIMEA CANYON DRIVE /
Kokee Road Improvements, Phase 2B
MILE POST 4.6 TO MILE POST 11.5
Federal-Aid Project No. STP-0550(006)
Scale: 1" = 10' Date: July 2024


12/13/24 3 Revised Sections

DATE REVISION

SHEET No. X43 OF 122 SHEETS

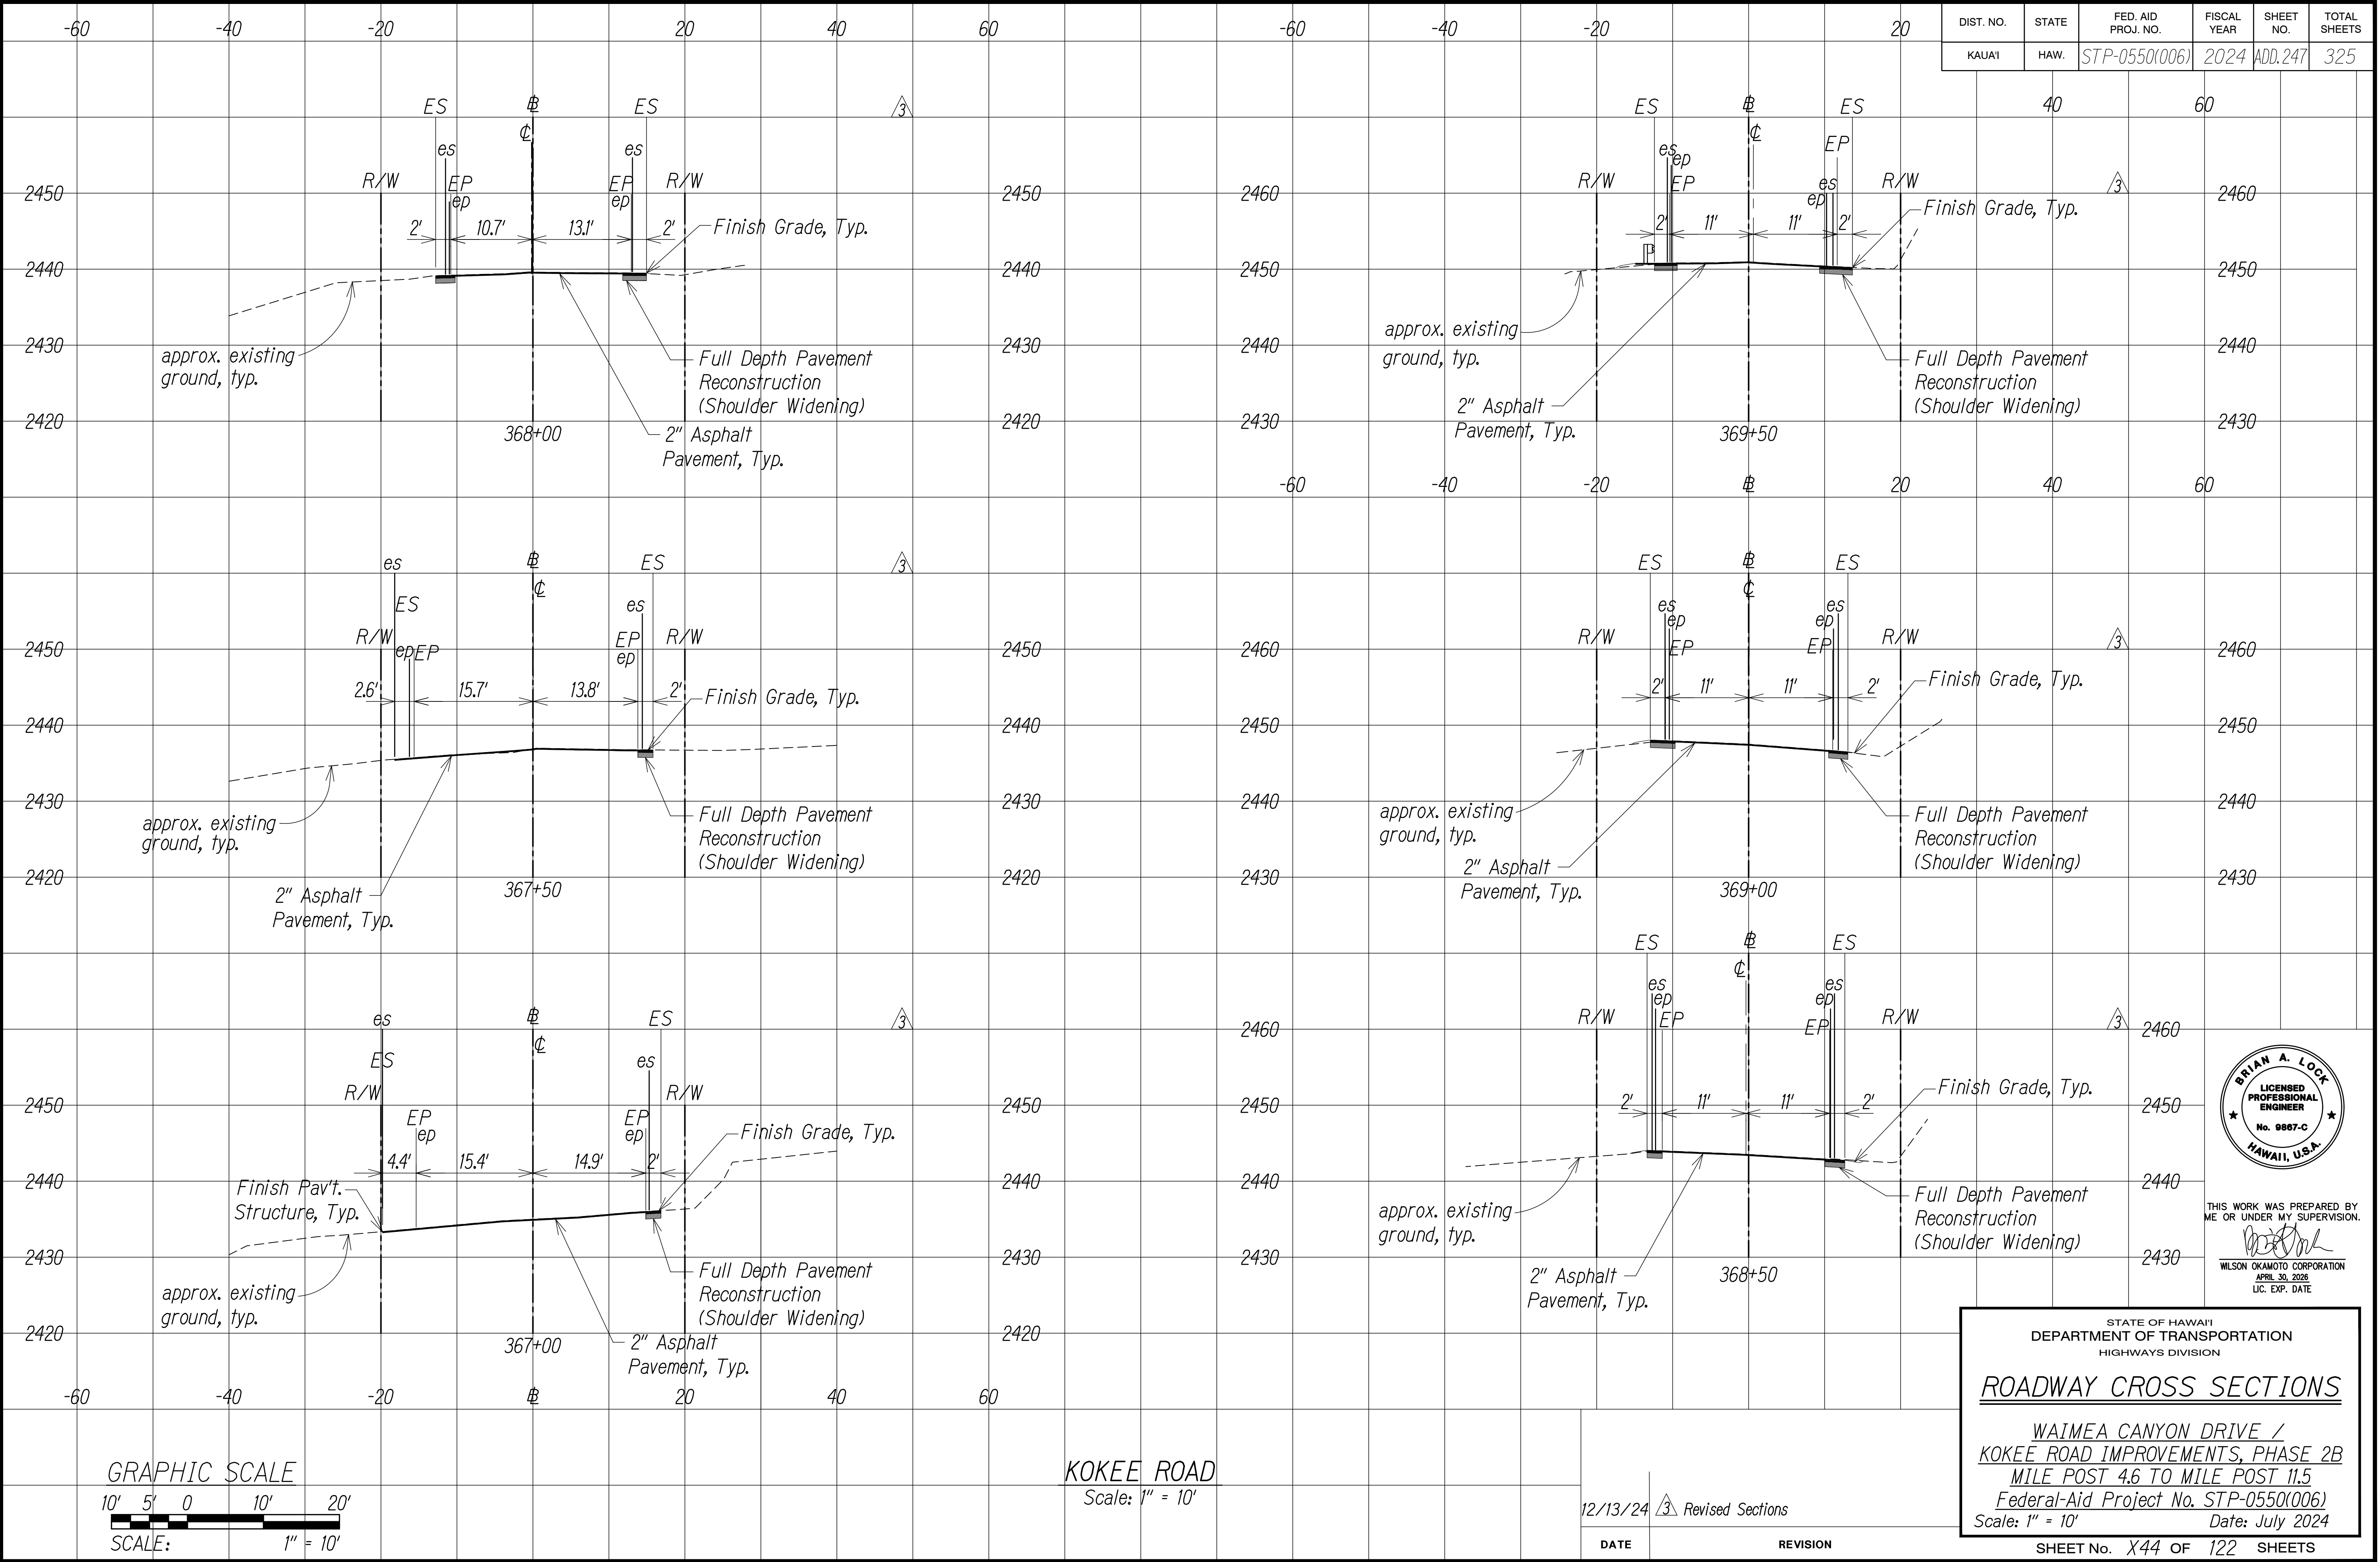

SURVEY PLOTTED BY	DATE
DESIGNED BY	
TRACED BY	
QUANTITIES BY	
CHECKED BY	
NOTE BOOK	
No.	

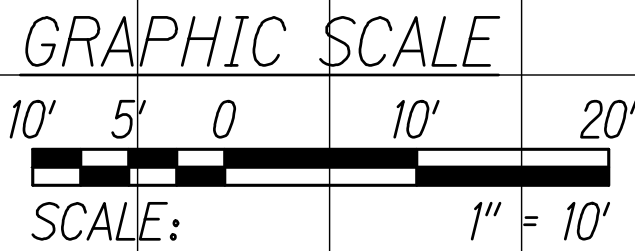


KOKEE ROAD

Scale: 1" = 10'

12/13/24 3 Revised Sections

DATE REVISION

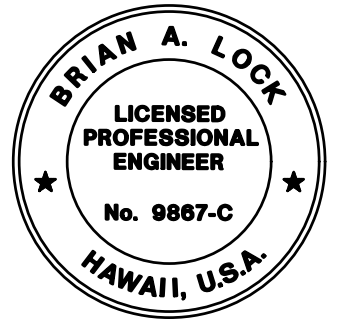

THIS WORK WAS PREPARED BY
ME OR UNDER MY SUPERVISION.

[Signature]

WILSON OKAMOTO CORPORATION
APRIL 30, 2026
LIC. EXP. DATE

STATE OF HAWAII
DEPARTMENT OF TRANSPORTATION
HIGHWAYS DIVISION


ROADWAY CROSS SECTIONS

WAIMEA CANYON DRIVE /
KOKEE ROAD IMPROVEMENTS, PHASE 2B
MILE POST 4.6 TO MILE POST 11.5
Federal-Aid Project No. STP-0550(006)
Scale: 1" = 10' Date: July 2024


SHEET No. X44 OF 122 SHEETS

DIST. NO.	STATE	FED. AID PROJ. NO.	FISCAL YEAR	SHEET NO.	TOTAL SHEETS
KAUAI	HAW.	STP-0550(006)	2024	ADD.247	325

DIST. NO.	STATE	FED. AID PROJ. NO.	FISCAL YEAR	SHEET NO.	TOTAL SHEETS
KAUAI	HAW.	STP-0550(006)	2024	ADD.248	325

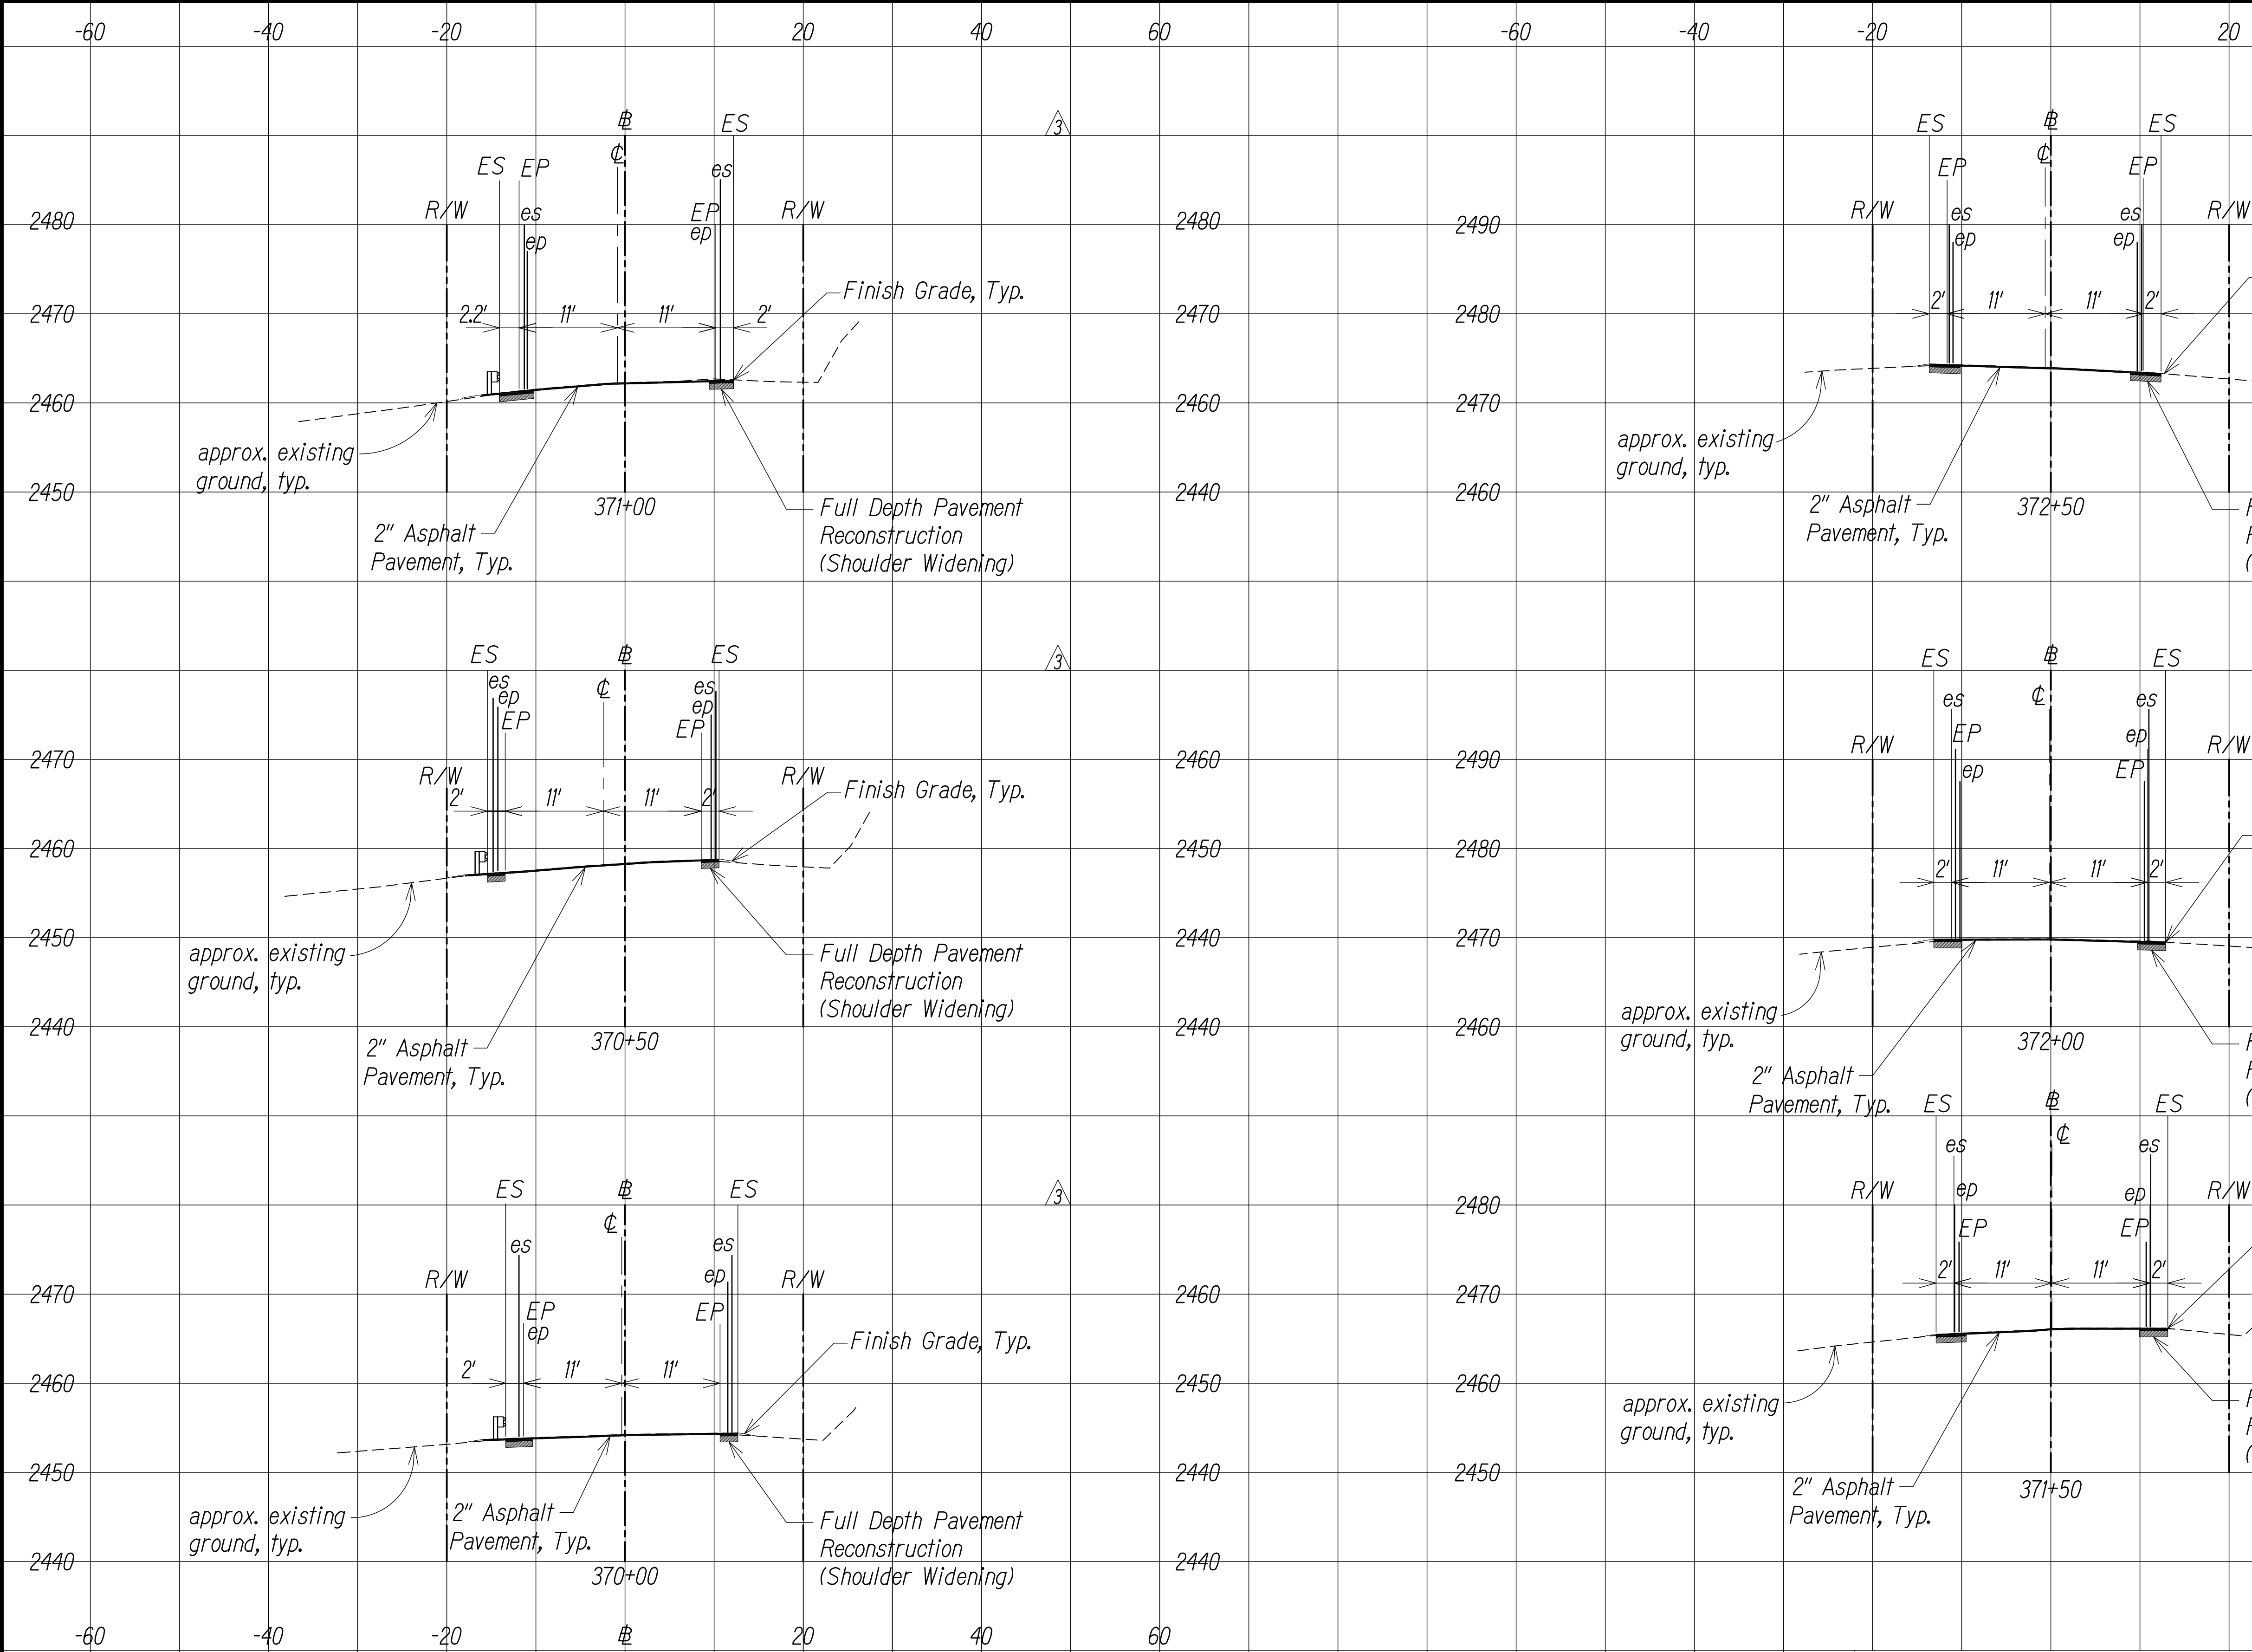


SURVEY PLOTTED BY	DATE
DESIGNED BY	
TRACED BY	
QUANTITIES BY	
CHECKED BY	
NOTE BOOK	
No.	

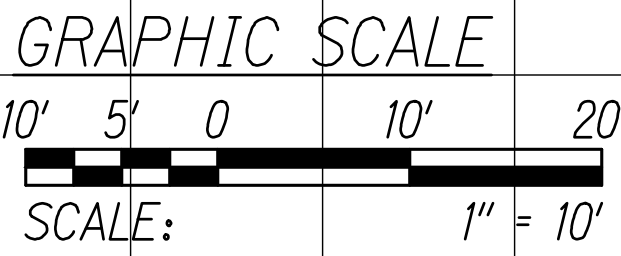

KOKEE ROAD
Scale: 1" = 10'

12/13/24 3 Revised Sections

DATE	REVISION
------	----------

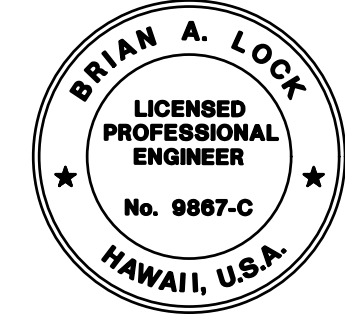


THIS WORK WAS PREPARED BY
ME OR UNDER MY SUPERVISION.
[Signature]
WILSON OKAMOTO CORPORATION
APRIL 30, 2026
LIC. EXP. DATE

STATE OF HAWAII
DEPARTMENT OF TRANSPORTATION
HIGHWAYS DIVISION
ROADWAY CROSS SECTIONS
WAIMEA CANYON DRIVE /
KOKEE ROAD IMPROVEMENTS, PHASE 2B
MILE POST 4.6 TO MILE POST 11.5
Federal-Aid Project No. STP-0550(006)
Scale: 1" = 10' Date: July 2024

SHEET No. X45 OF 122 SHEETS


ADD248

DIST. NO.	STATE	FED. AID PROJ. NO.	FISCAL YEAR	SHEET NO.	TOTAL SHEETS
KAUAI	HAW.	STP-0550(006)	2024	ADD.249	325

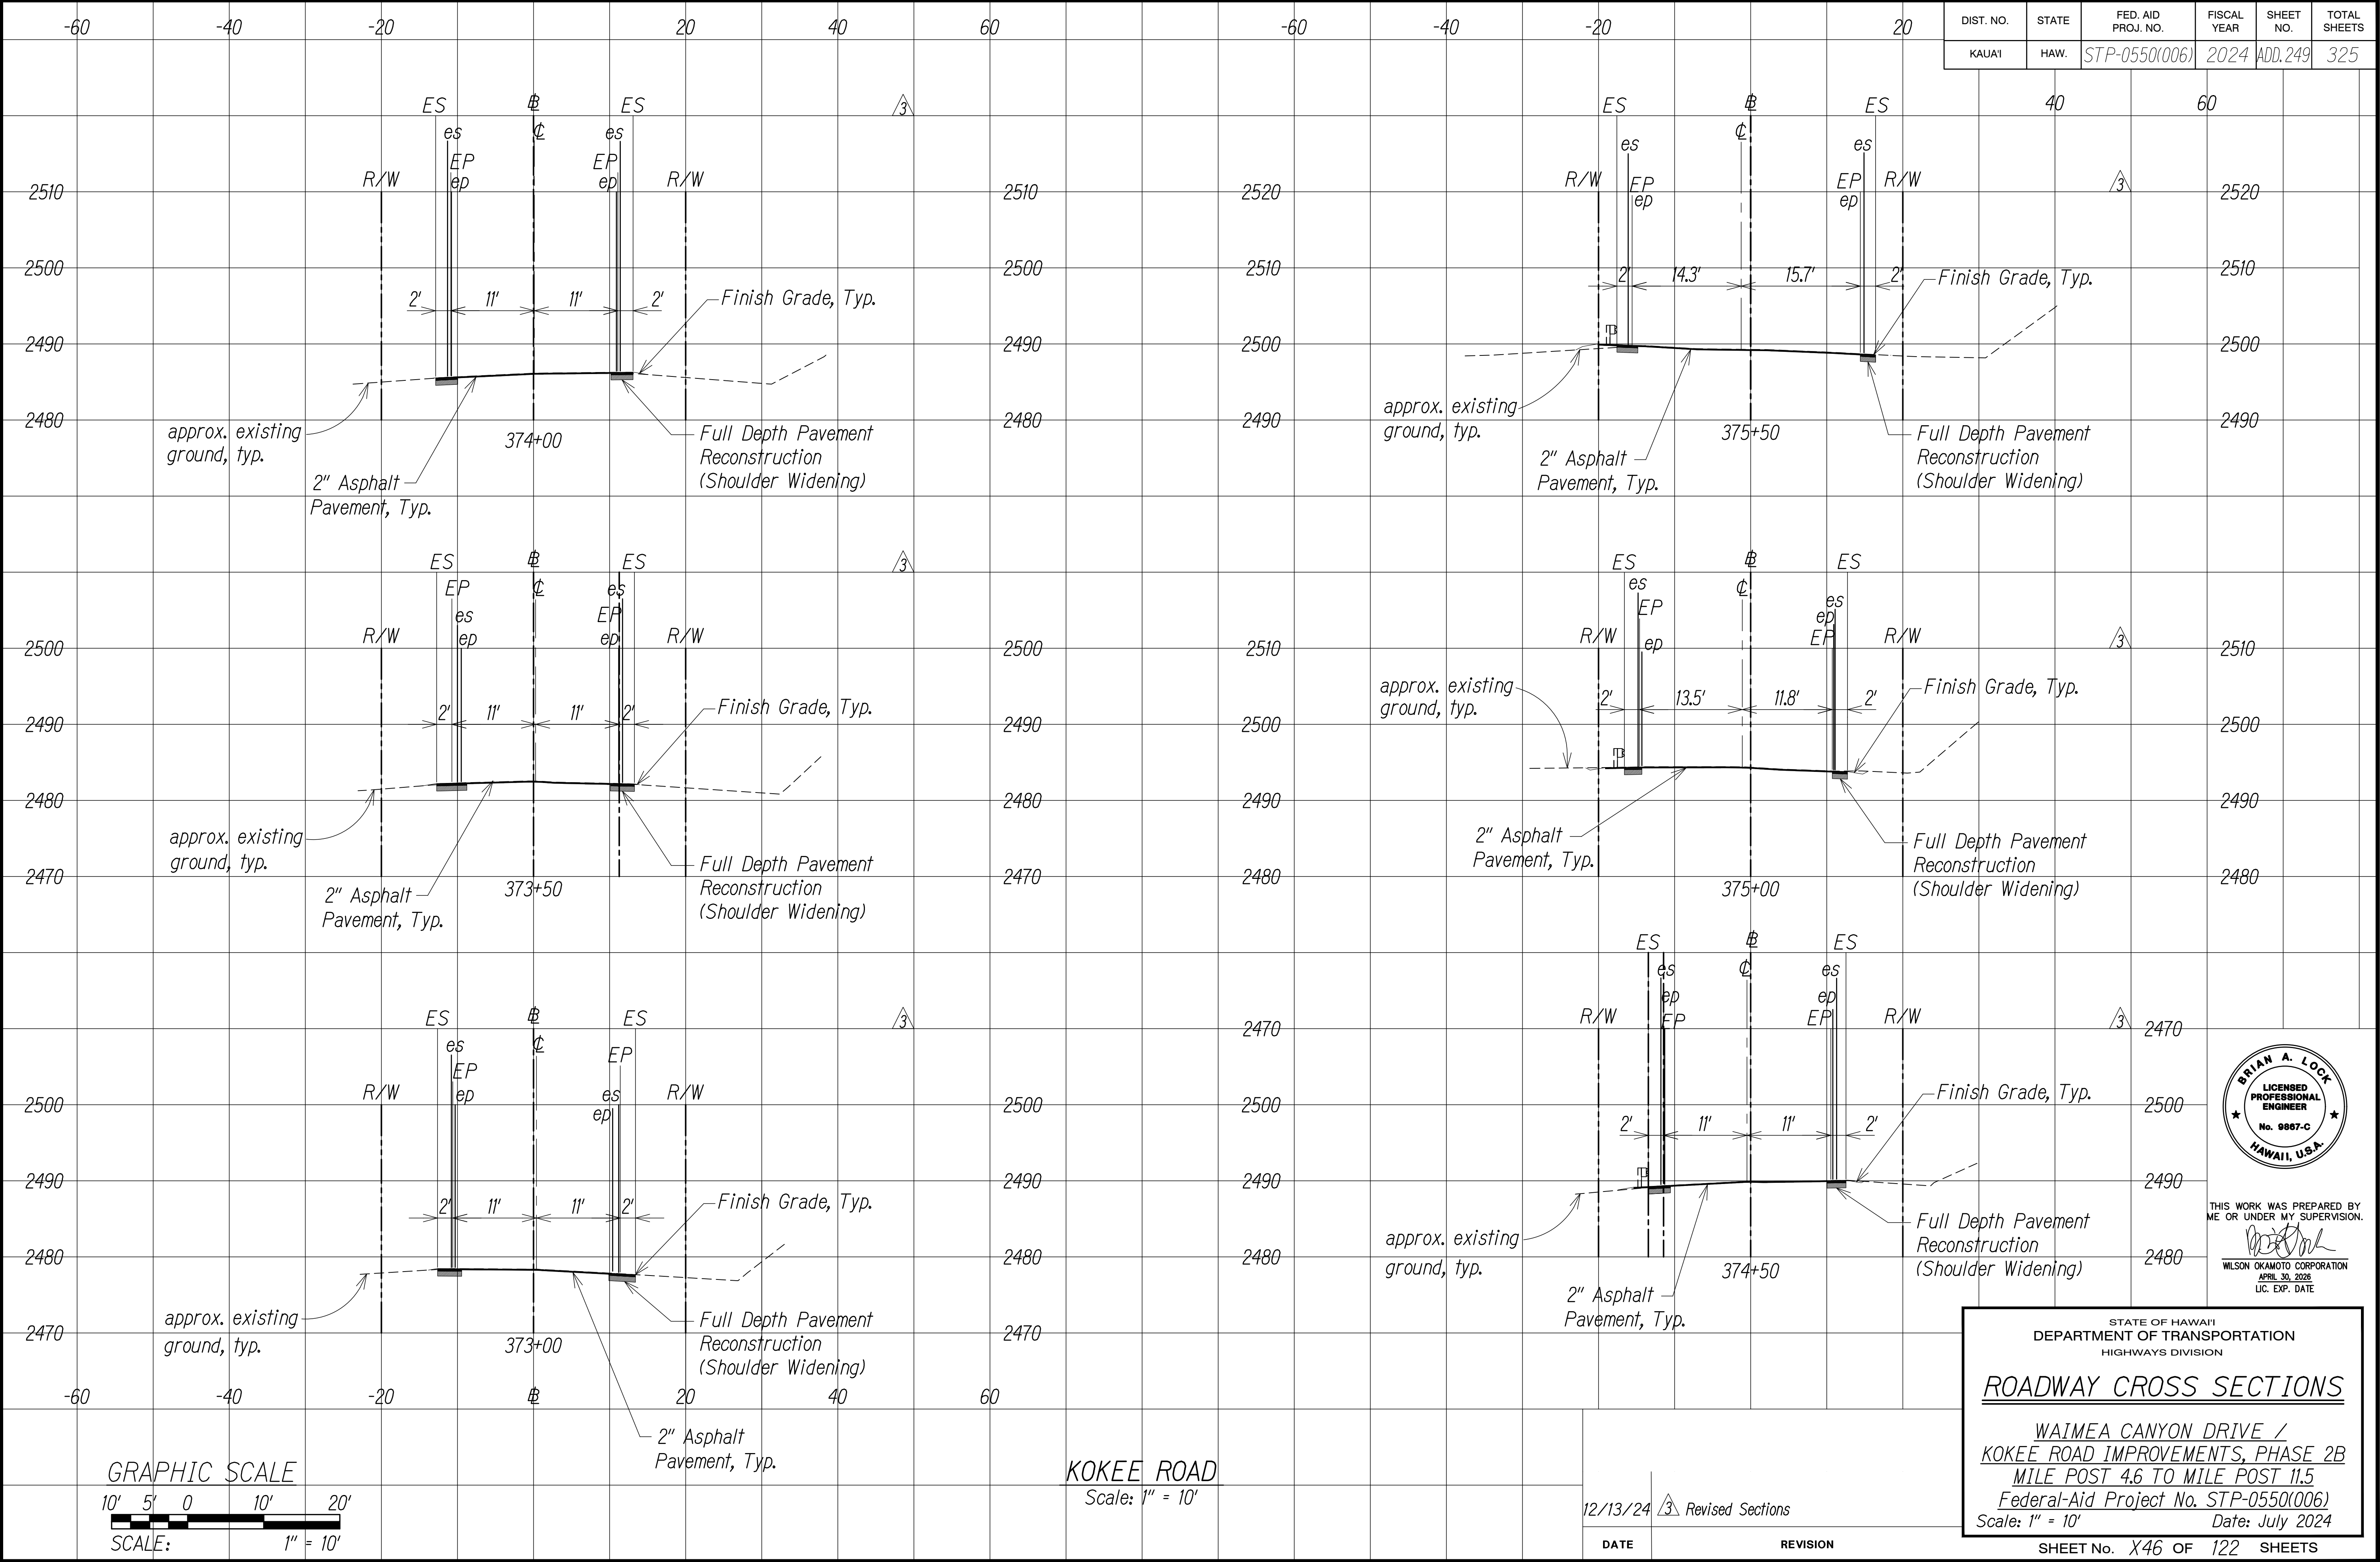

SURVEY PLOTTED BY	DATE
DESIGNED BY	
TRACED BY	
QUANTITIES BY	
CHECKED BY	

ORIGINAL PLAN	No.
NOTE BOOK	

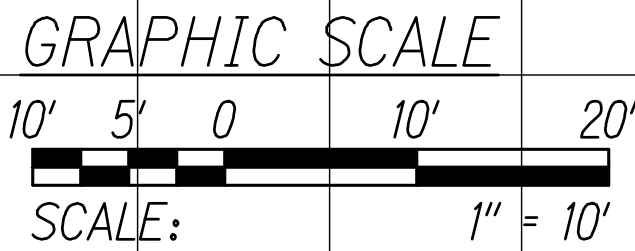


KOKEE ROAD
Scale: 1" = 10'

12/13/24 3 Revised Sections


DATE REVISION

STATE OF HAWAII
DEPARTMENT OF TRANSPORTATION
HIGHWAYS DIVISION
ROADWAY CROSS SECTIONS
WAIMEA CANYON DRIVE /
KOKEE ROAD IMPROVEMENTS, PHASE 2B
MILE POST 4.6 TO MILE POST 11.5
Federal-Aid Project No. STP-0550(006)
Scale: 1" = 10' Date: July 2024

SHEET No. X46 OF 122 SHEETS

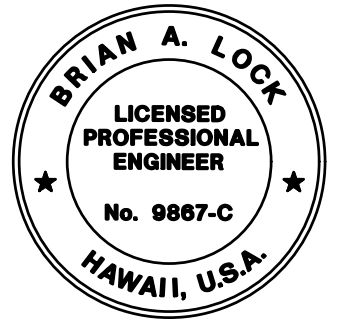


THIS WORK WAS PREPARED BY
ME OR UNDER MY SUPERVISION.
[Signature]
WILSON OKAMOTO CORPORATION
APRIL 30, 2026
LIC. EXP. DATE

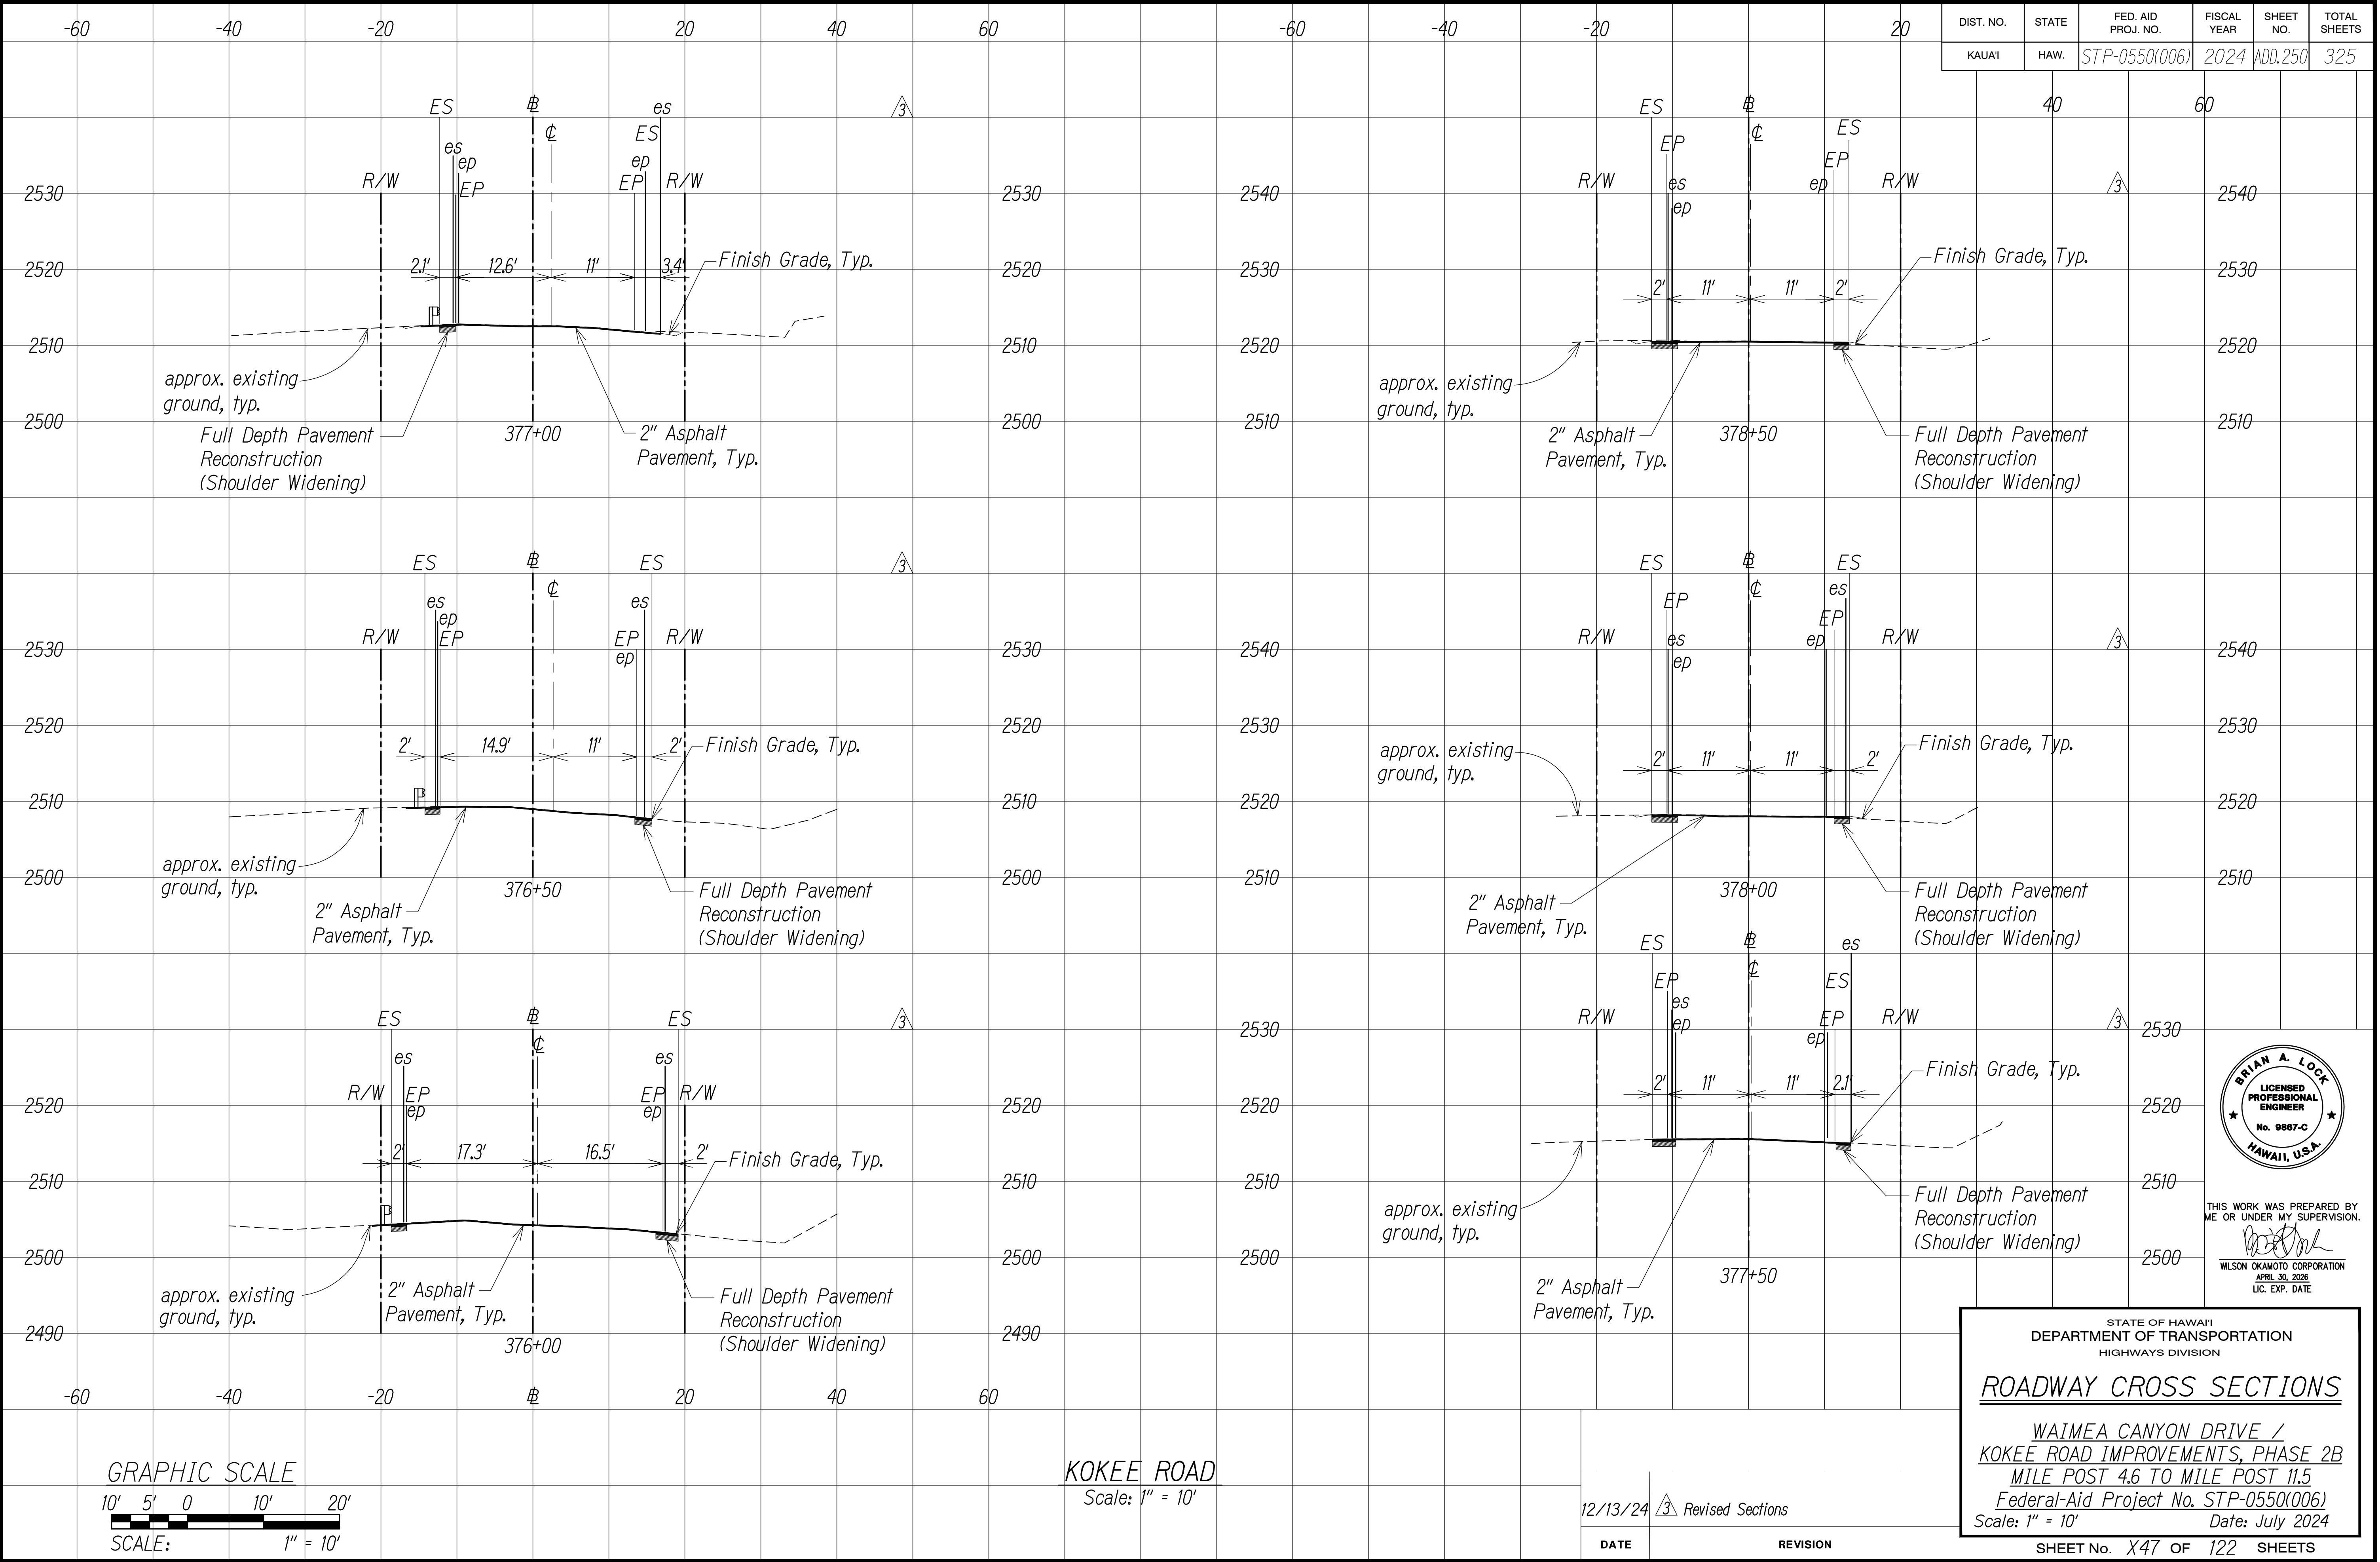

DIST. NO.	STATE	FED. AID PROJ. NO.	FISCAL YEAR	SHEET NO.	TOTAL SHEETS
KAUAI	HAW.	STP-0550(006)	2024	ADD.250	325

SURVEY PLOTTED BY	DATE
DESIGNED BY	
TRACED BY	
QUANTITIES BY	
CHECKED BY	

ORIGINAL PLAN	NOTE BOOK
No.	

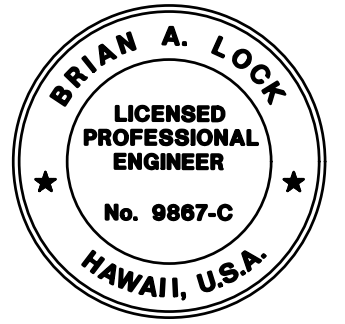

THIS WORK WAS PREPARED BY ME OR UNDER MY SUPERVISION.
[Signature]
WILSON OKAMOTO CORPORATION
APRIL 30, 2026
LIC. EXP. DATE

STATE OF HAWAII
DEPARTMENT OF TRANSPORTATION
HIGHWAYS DIVISION

ROADWAY CROSS SECTIONS


WAIMEA CANYON DRIVE /
KOEKEE ROAD IMPROVEMENTS, PHASE 2B
MILE POST 4.6 TO MILE POST 11.5
Federal-Aid Project No. STP-0550(006)
Scale: 1" = 10' Date: July 2024

12/13/24 3 Revised Sections

DATE	REVISION
------	----------

SHEET No. X47 OF 122 SHEETS


ADD250

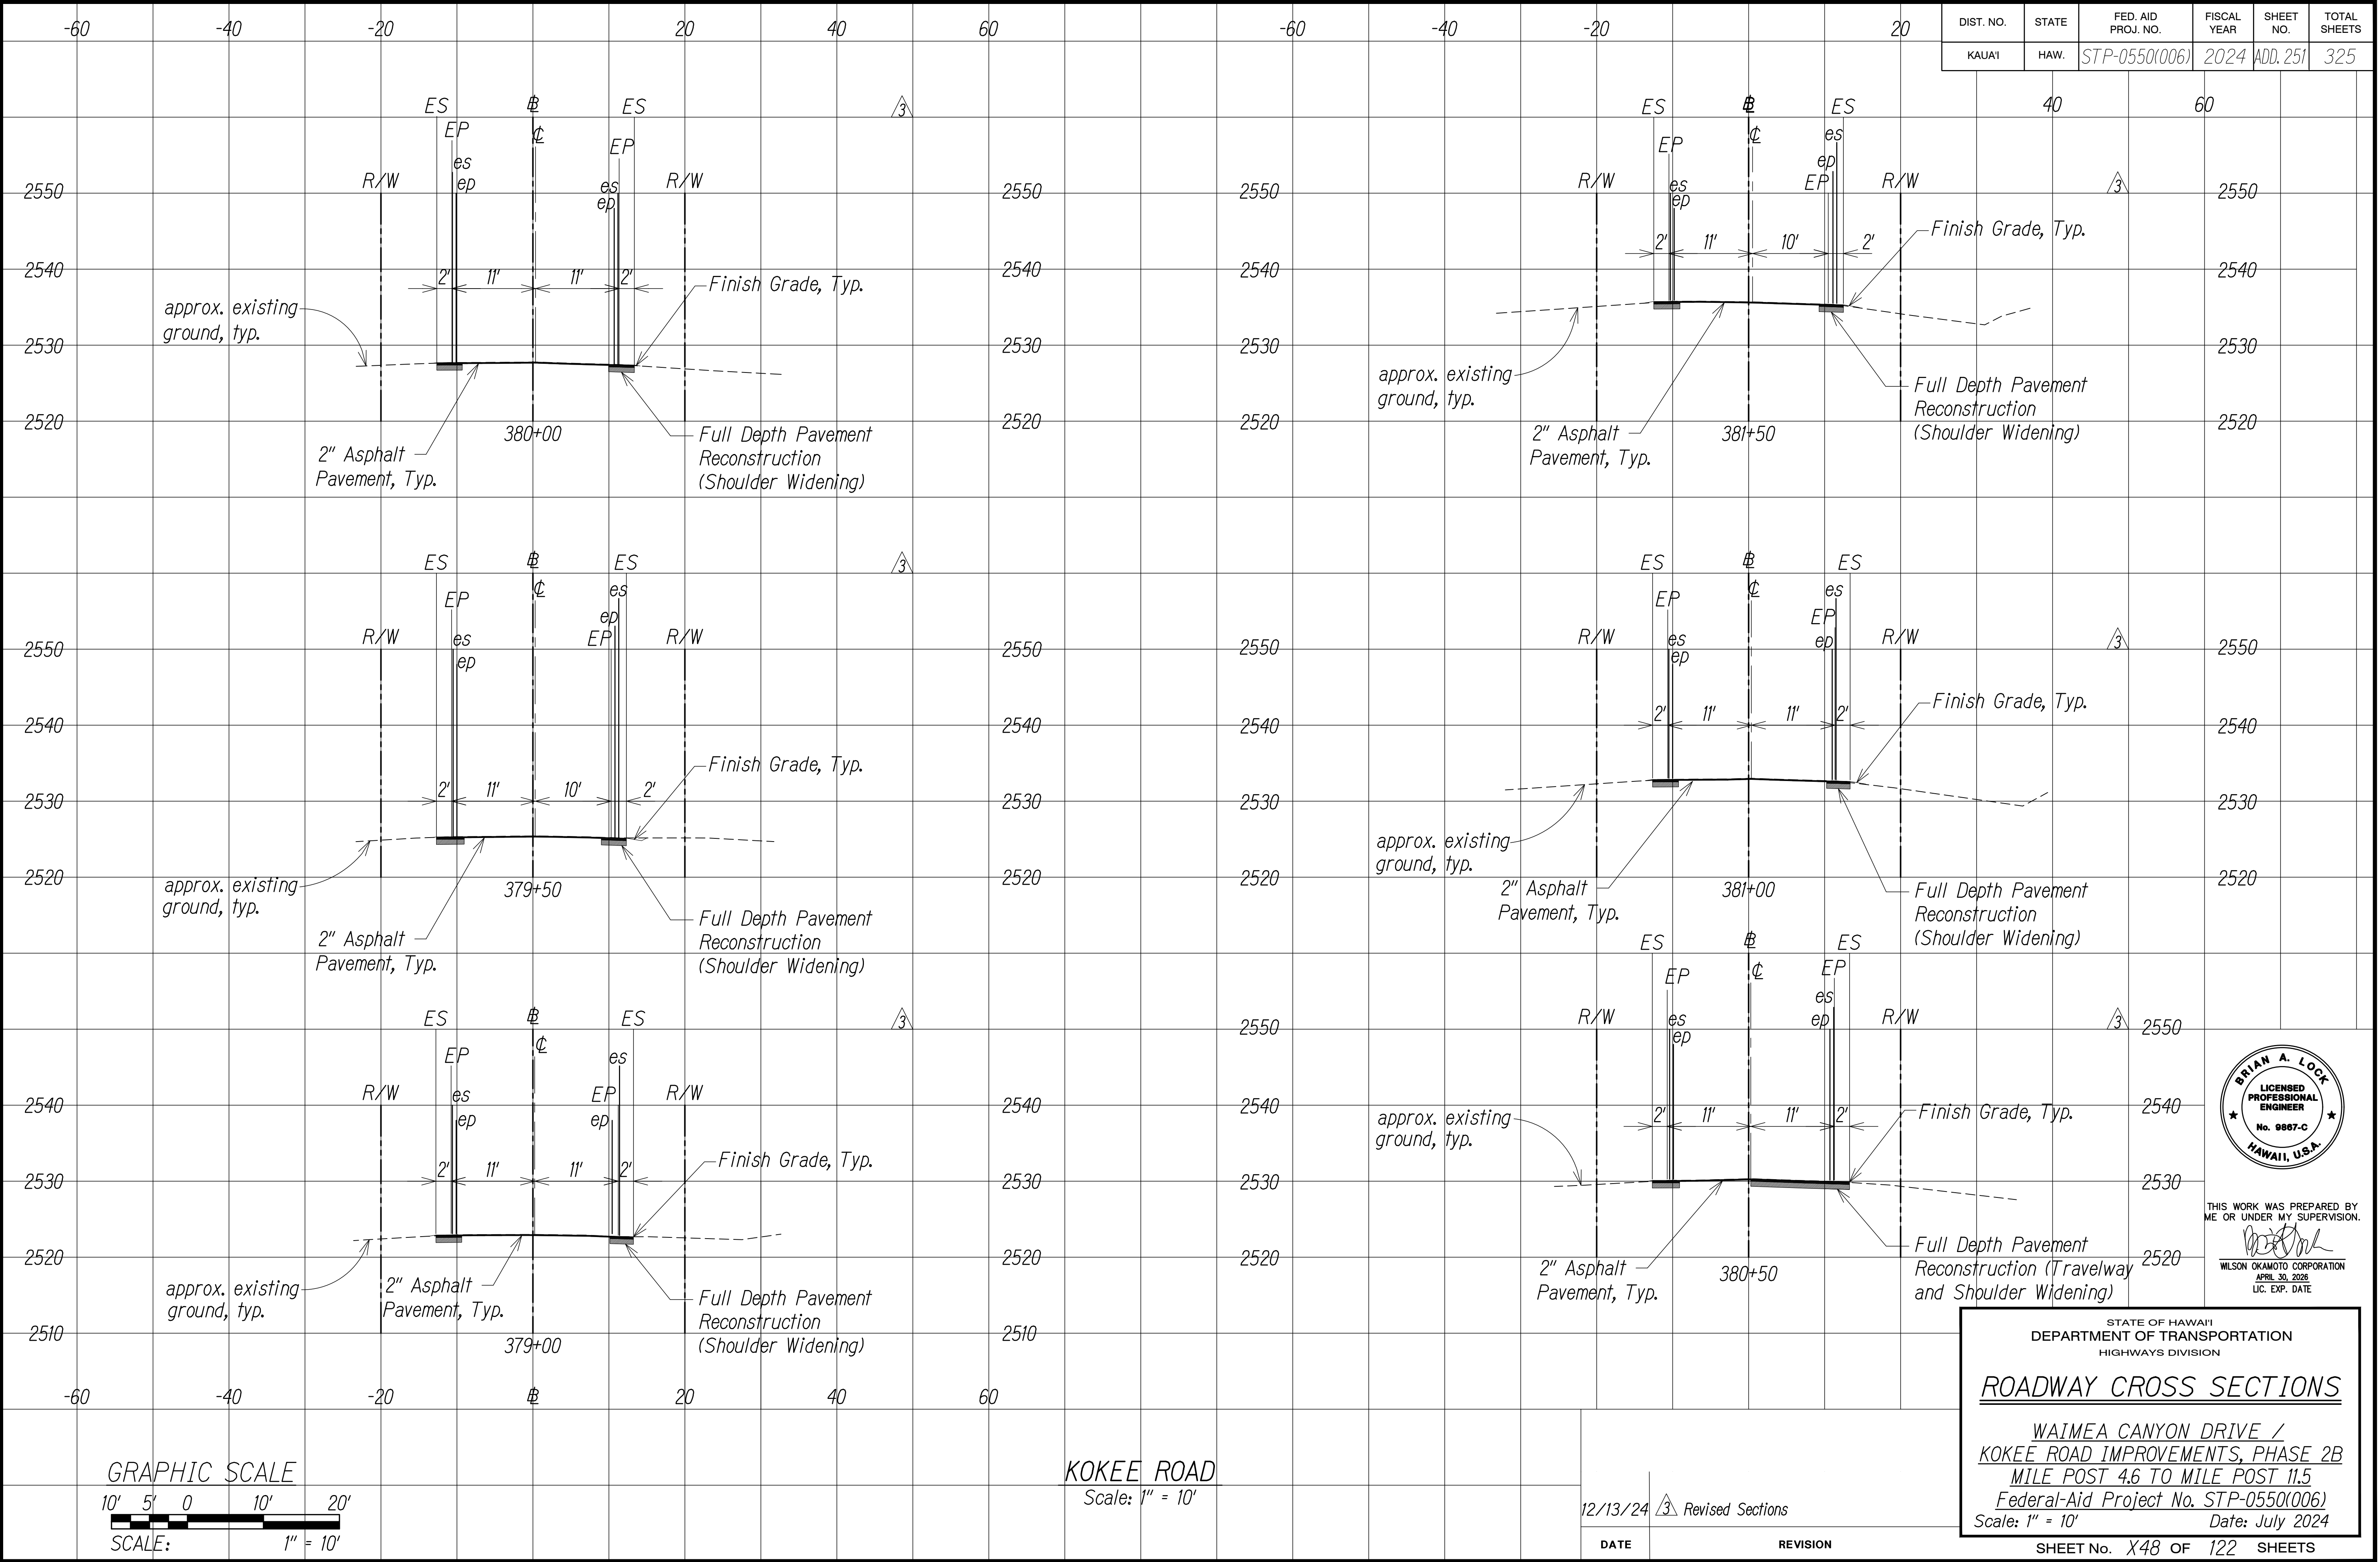

DIST. NO.	STATE	FED. AID PROJ. NO.	FISCAL YEAR	SHEET NO.	TOTAL SHEETS
KAUA'I	HAW.	STP-0550(006)	2024	ADD. 251	325


SURVEY PLOTTED BY	DATE
DESIGNED BY	
TRACED BY	
QUANTITIES BY	
CHECKED BY	

ORIGINAL PLAN	No.
NOTE BOOK	

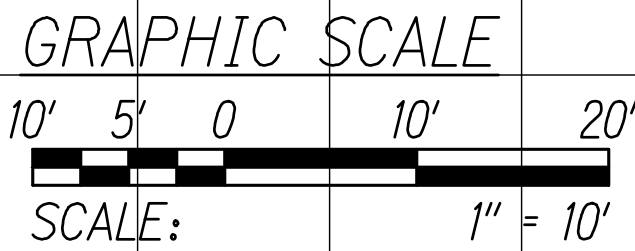

KOKEE ROAD

Scale: 1" = 10'

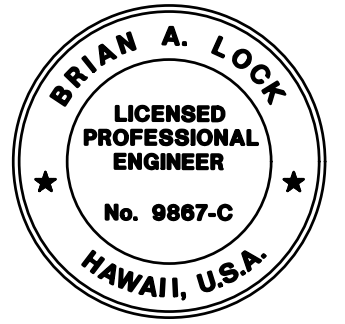

THIS WORK WAS PREPARED BY ME OR UNDER MY SUPERVISION.

[Signature]

WILSON OKAMOTO CORPORATION
APRIL 30, 2026
LIC. EXP. DATE

STATE OF HAWAII
DEPARTMENT OF TRANSPORTATION
HIGHWAYS DIVISION


ROADWAY CROSS SECTIONS

WAIMEA CANYON DRIVE /
KOKEE ROAD IMPROVEMENTS, PHASE 2B
MILE POST 4.6 TO MILE POST 11.5
Federal-Aid Project No. STP-0550(006)
Scale: 1" = 10' Date: July 2024

12/13/24 3 Revised Sections

DATE REVISION


SHEET No. X48 OF 122 SHEETS

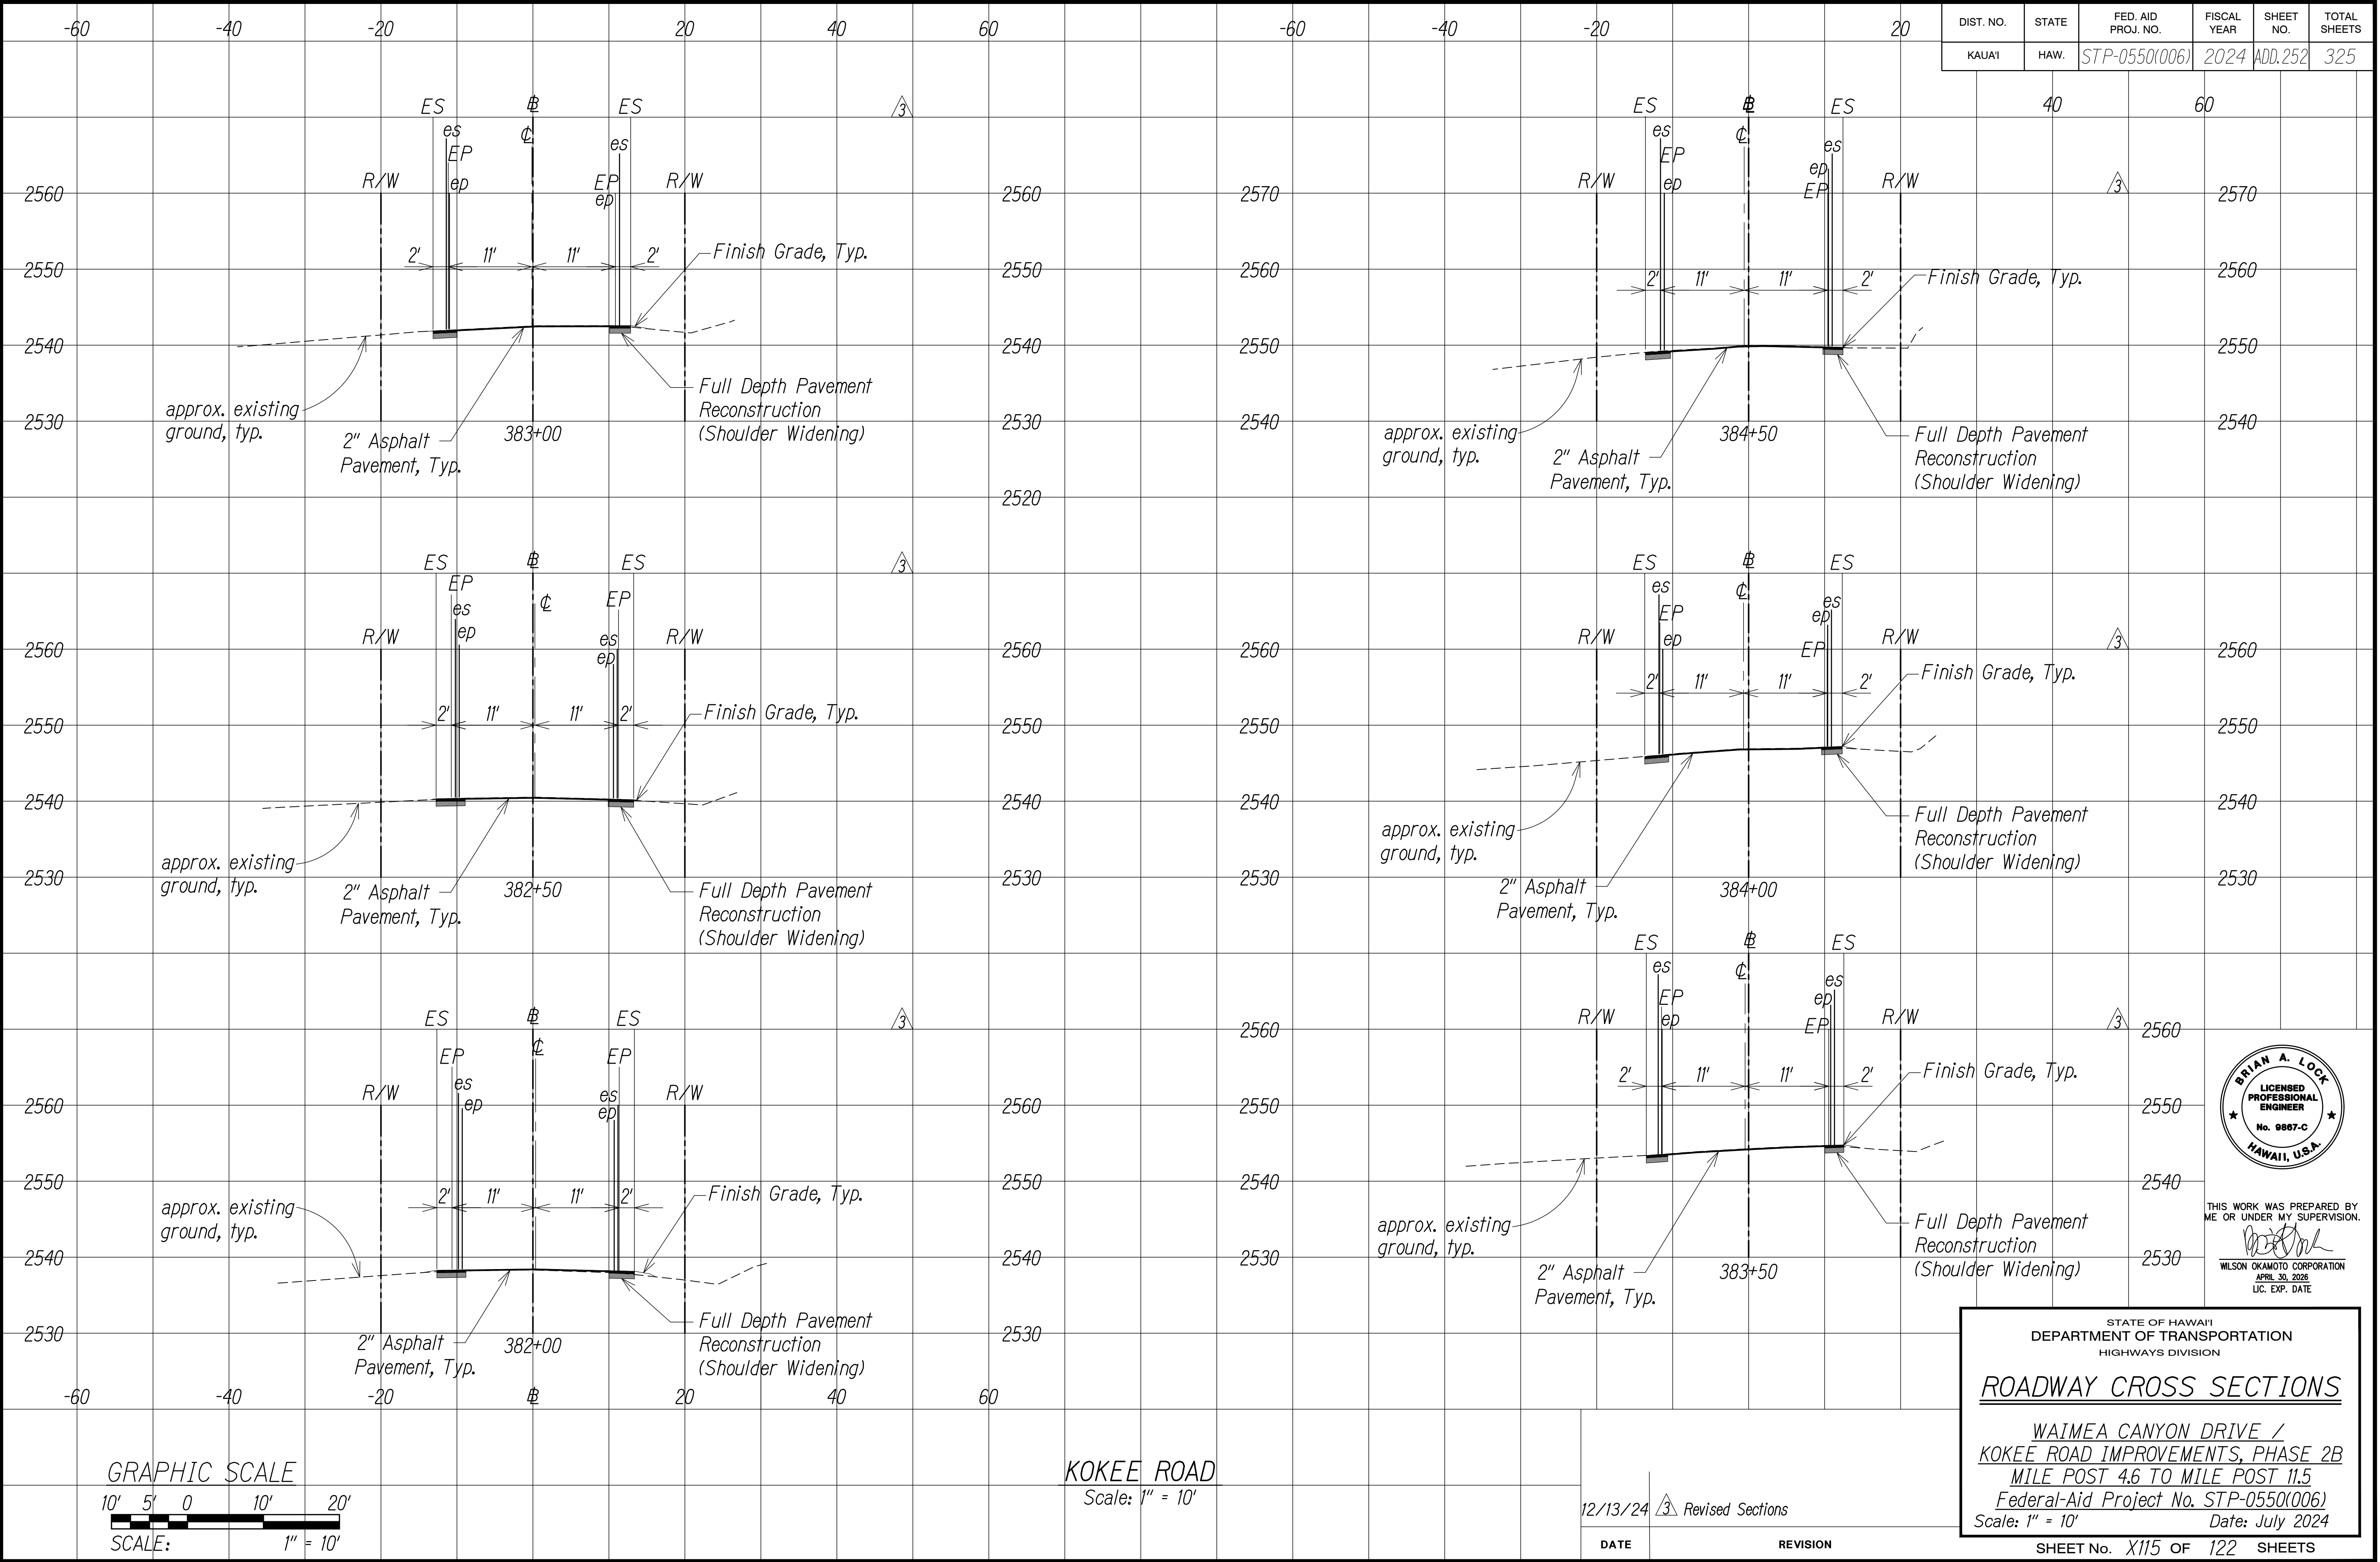

DIST. NO.	STATE	FED. AID PROJ. NO.	FISCAL YEAR	SHEET NO.	TOTAL SHEETS
KAUAI	HAW.	STP-0550(006)	2024	ADD.252	325

SURVEY PLOTTED BY	DATE
DESIGNED BY	
TRACED BY	
QUANTITIES BY	
CHECKED BY	


ORIGINAL PLAN	No.
NOTE BOOK	

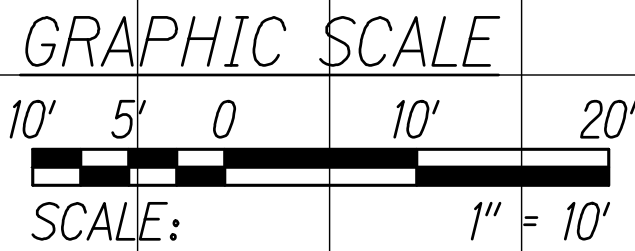

KOKEE ROAD
Scale: 1" = 10'

12/13/24 3 Revised Sections

DATE REVISION

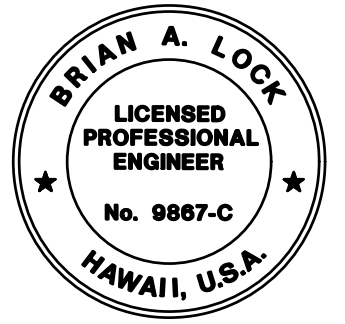


THIS WORK WAS PREPARED BY ME OR UNDER MY SUPERVISION.
WILSON OKAMOTO CORPORATION
APRIL 30, 2026
LIC. EXP. DATE

STATE OF HAWAII
DEPARTMENT OF TRANSPORTATION
HIGHWAYS DIVISION
ROADWAY CROSS SECTIONS
WAIMEA CANYON DRIVE /
KOKEE ROAD IMPROVEMENTS, PHASE 2B
MILE POST 4.6 TO MILE POST 11.5
Federal-Aid Project No. STP-0550(006)
Scale: 1" = 10' Date: July 2024


SHEET No. X115 OF 122 SHEETS

DIST. NO.	STATE	FED. AID PROJ. NO.	FISCAL YEAR	SHEET NO.	TOTAL SHEETS
KAUA'I	HAW.	STP-0550(006)	2024	ADD.253	325

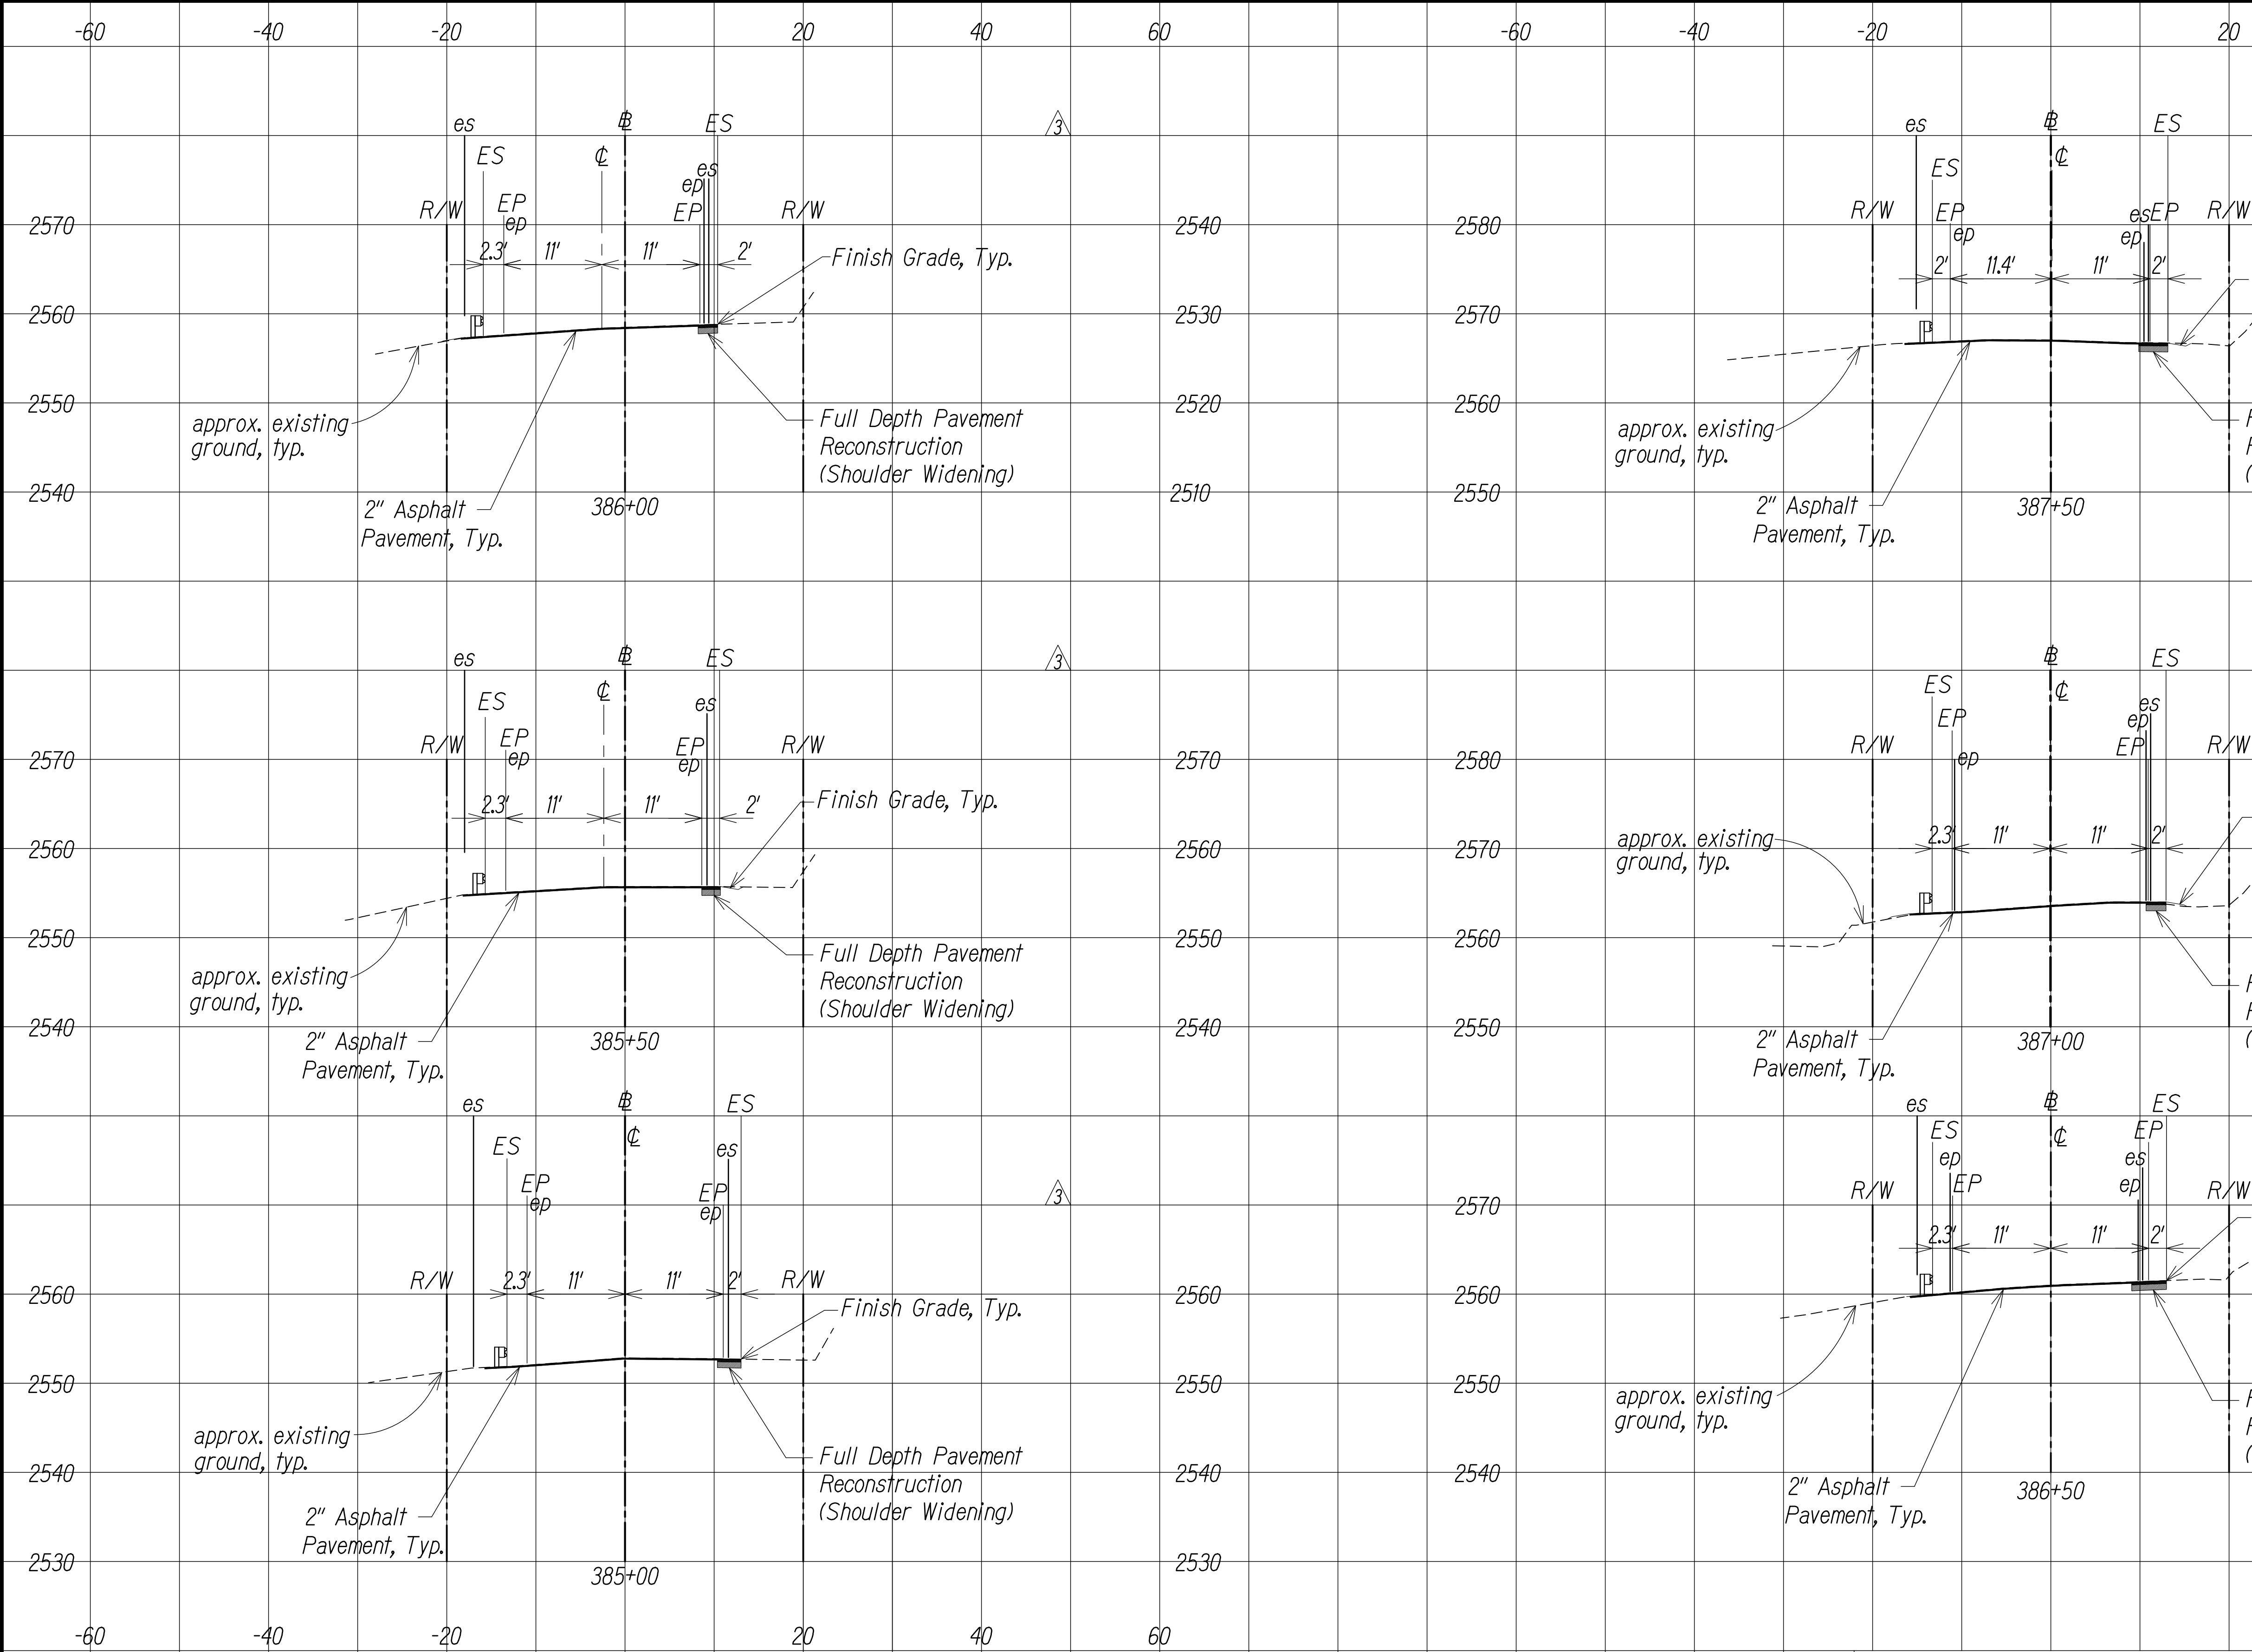


SURVEY PLOTTED BY	DATE
DESIGNED BY	
TRACED BY	
QUANTITIES BY	
CHECKED BY	

ORIGINAL PLAN	No.
NOTE BOOK	

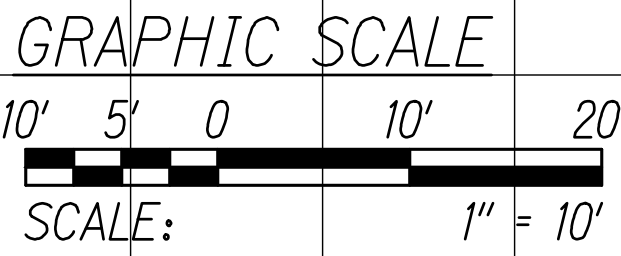

KOKEE ROAD
Scale: 1" = 10'

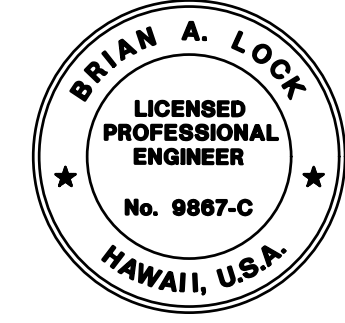

THIS WORK WAS PREPARED BY ME OR UNDER MY SUPERVISION.
WILSON OKAMOTO CORPORATION
APRIL 30, 2026
LIC. EXP. DATE

STATE OF HAWAII
DEPARTMENT OF TRANSPORTATION
HIGHWAYS DIVISION


ROADWAY CROSS SECTIONS

WAIMEA CANYON DRIVE /
KOKEE ROAD IMPROVEMENTS, PHASE 2B
MILE POST 4.6 TO MILE POST 11.5
Federal-Aid Project No. STP-0550(006)
Scale: 1" = 10' Date: July 2024

DATE: 12/13/24 REVISION: 3 Revised Sections


SHEET No. X50 OF 122 SHEETS

DIST. NO.	STATE	FED. AID PROJ. NO.	FISCAL YEAR	SHEET NO.	TOTAL SHEETS
KAUAI	HAW.	STP-0550(006)	2024	ADD.254	325

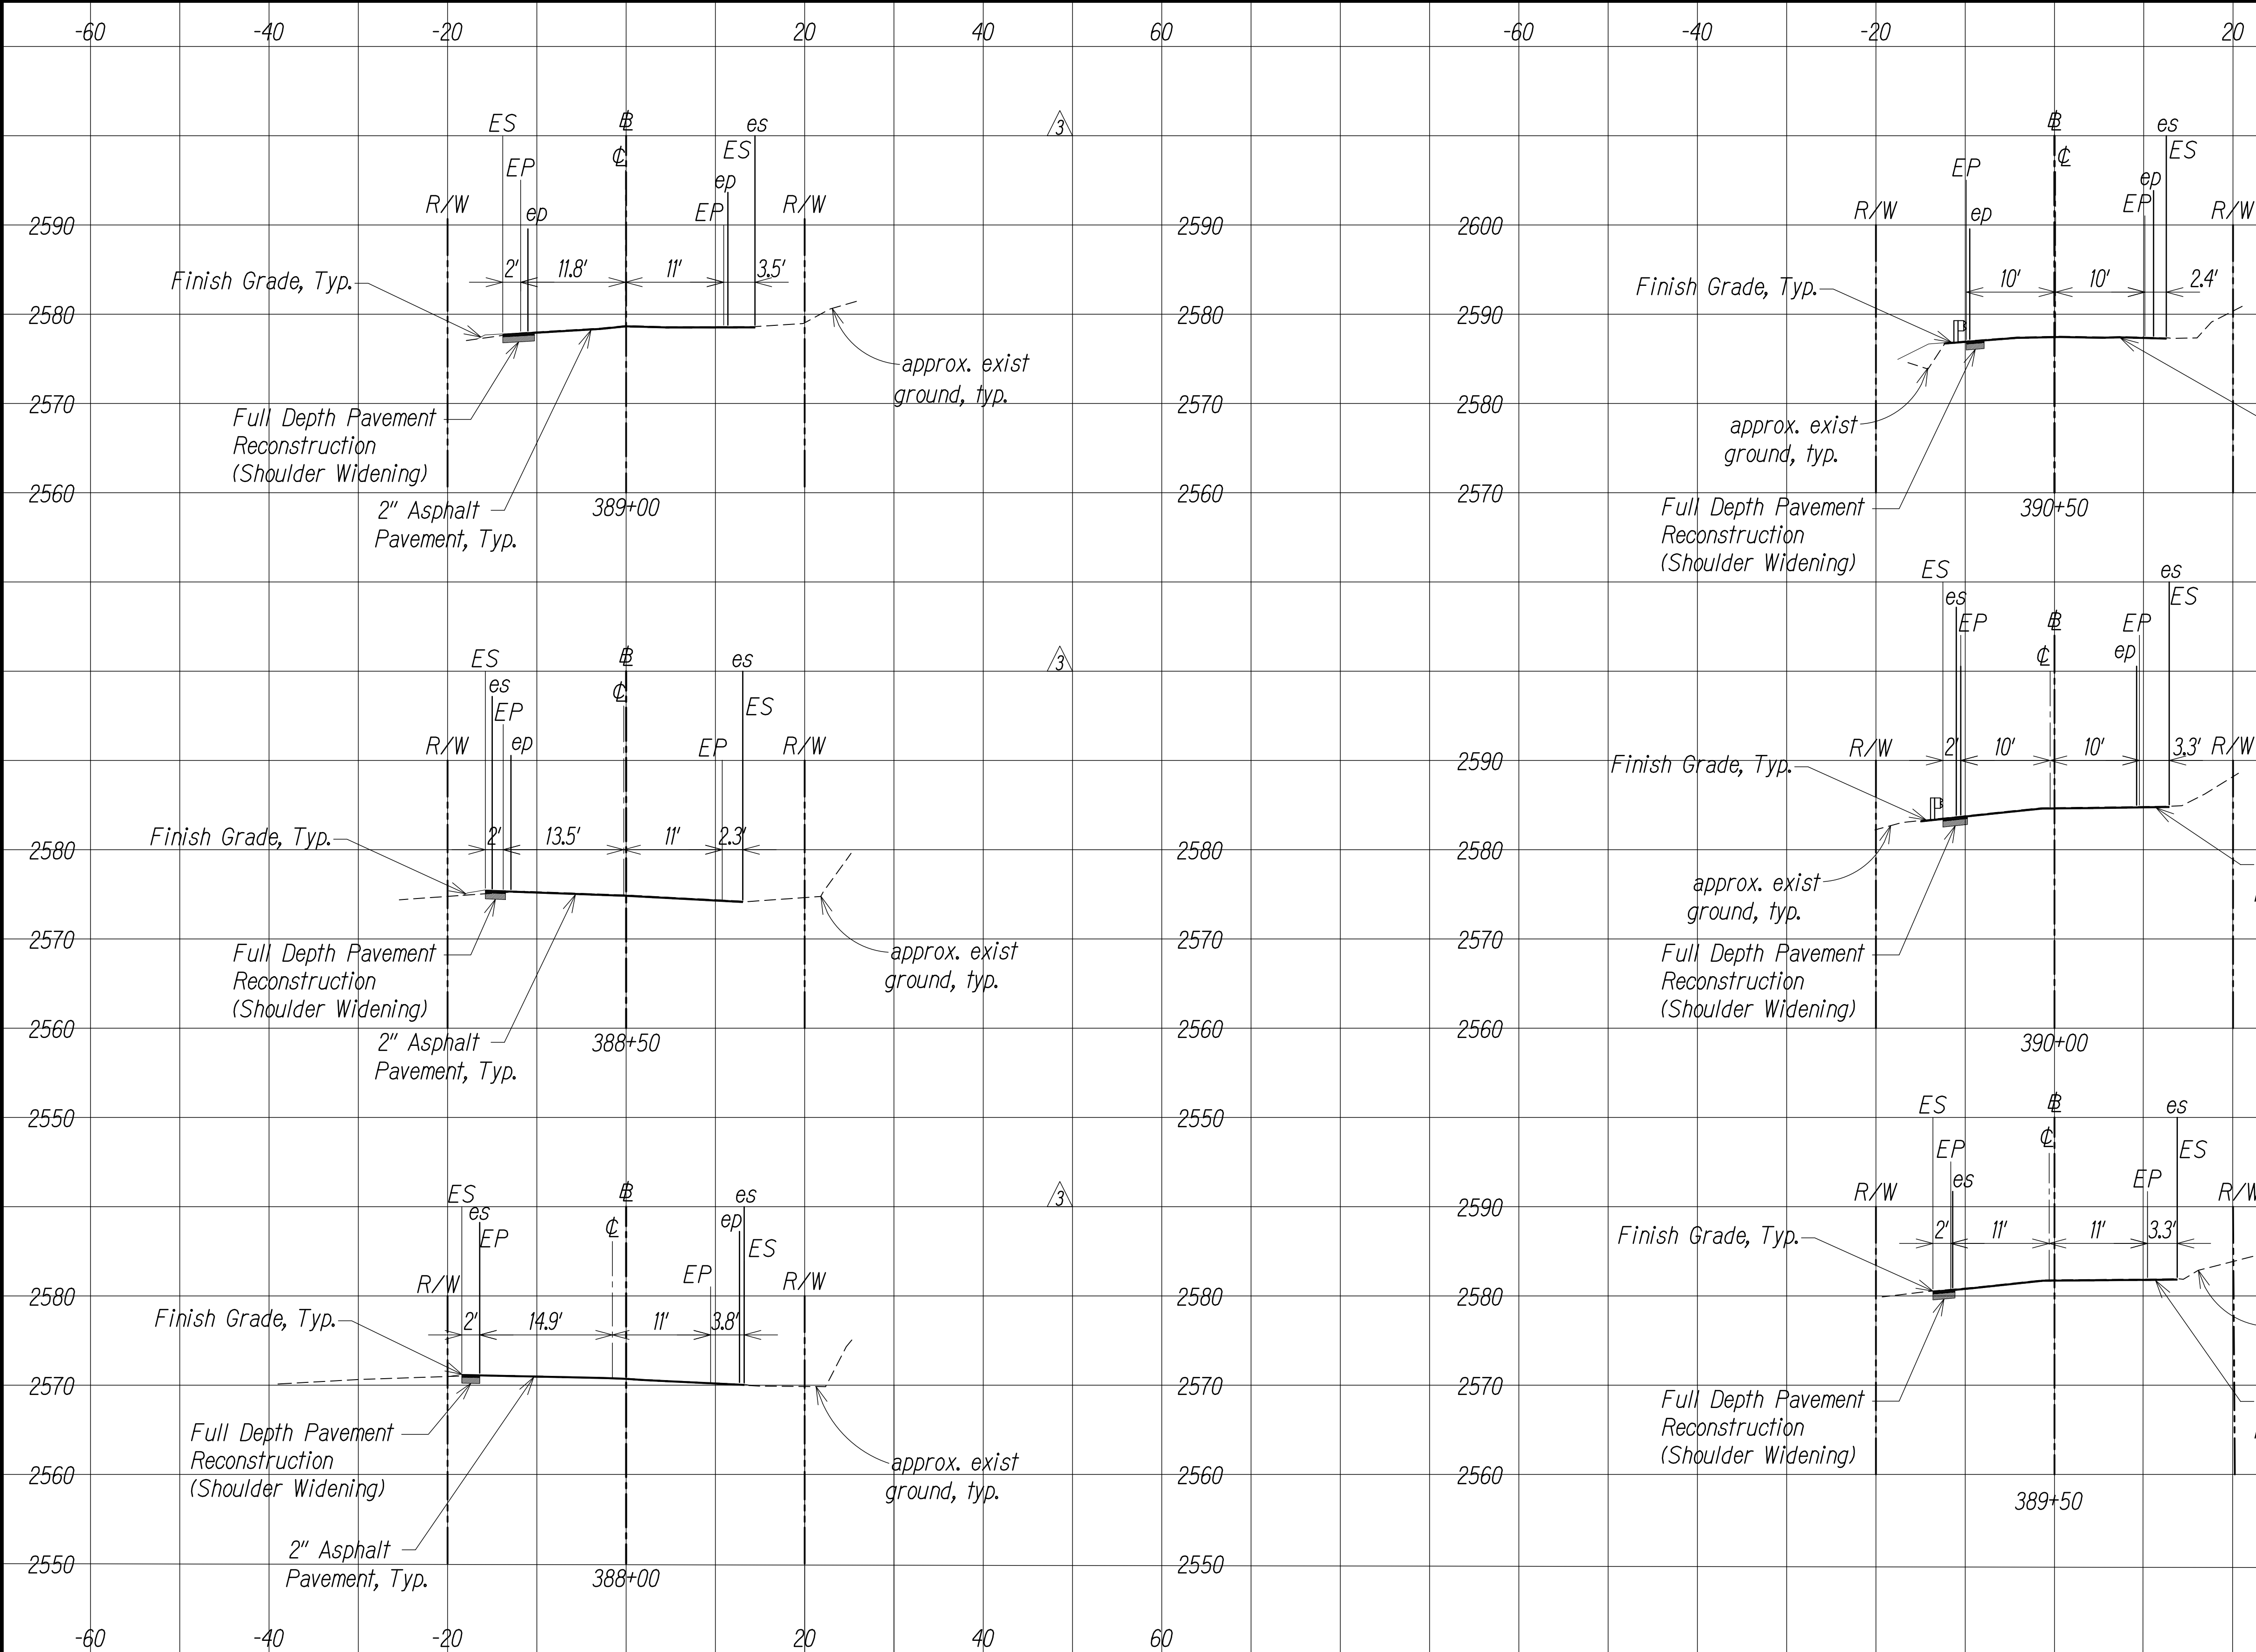

SURVEY PLOTTED BY	DATE
DESIGNED BY	
TRACED BY	
QUANTITIES BY	
CHECKED BY	

ORIGINAL PLAN	No.
NOTE BOOK	

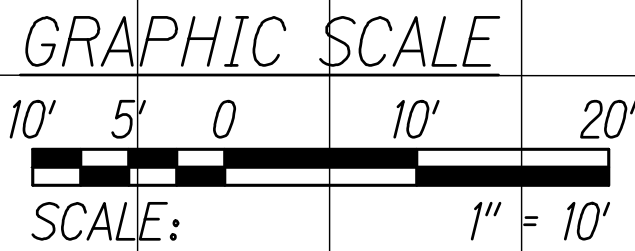


KOKEE ROAD

Scale: 1" = 10'

12/13/24 3 Revised Sections

DATE REVISION

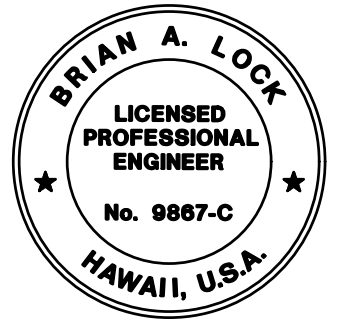

THIS WORK WAS PREPARED BY
ME OR UNDER MY SUPERVISION.

[Signature]


WILSON OKAMOTO CORPORATION
APRIL 30, 2026
LIC. EXP. DATE

STATE OF HAWAII
DEPARTMENT OF TRANSPORTATION
HIGHWAYS DIVISION


ROADWAY CROSS SECTIONS

WAIMEA CANYON DRIVE /
KOKEE ROAD IMPROVEMENTS, PHASE 2B
MILE POST 4.6 TO MILE POST 11.5
Federal-Aid Project No. STP-0550(006)
Scale: 1" = 10' Date: July 2024

SHEET No. X51 OF 122 SHEETS

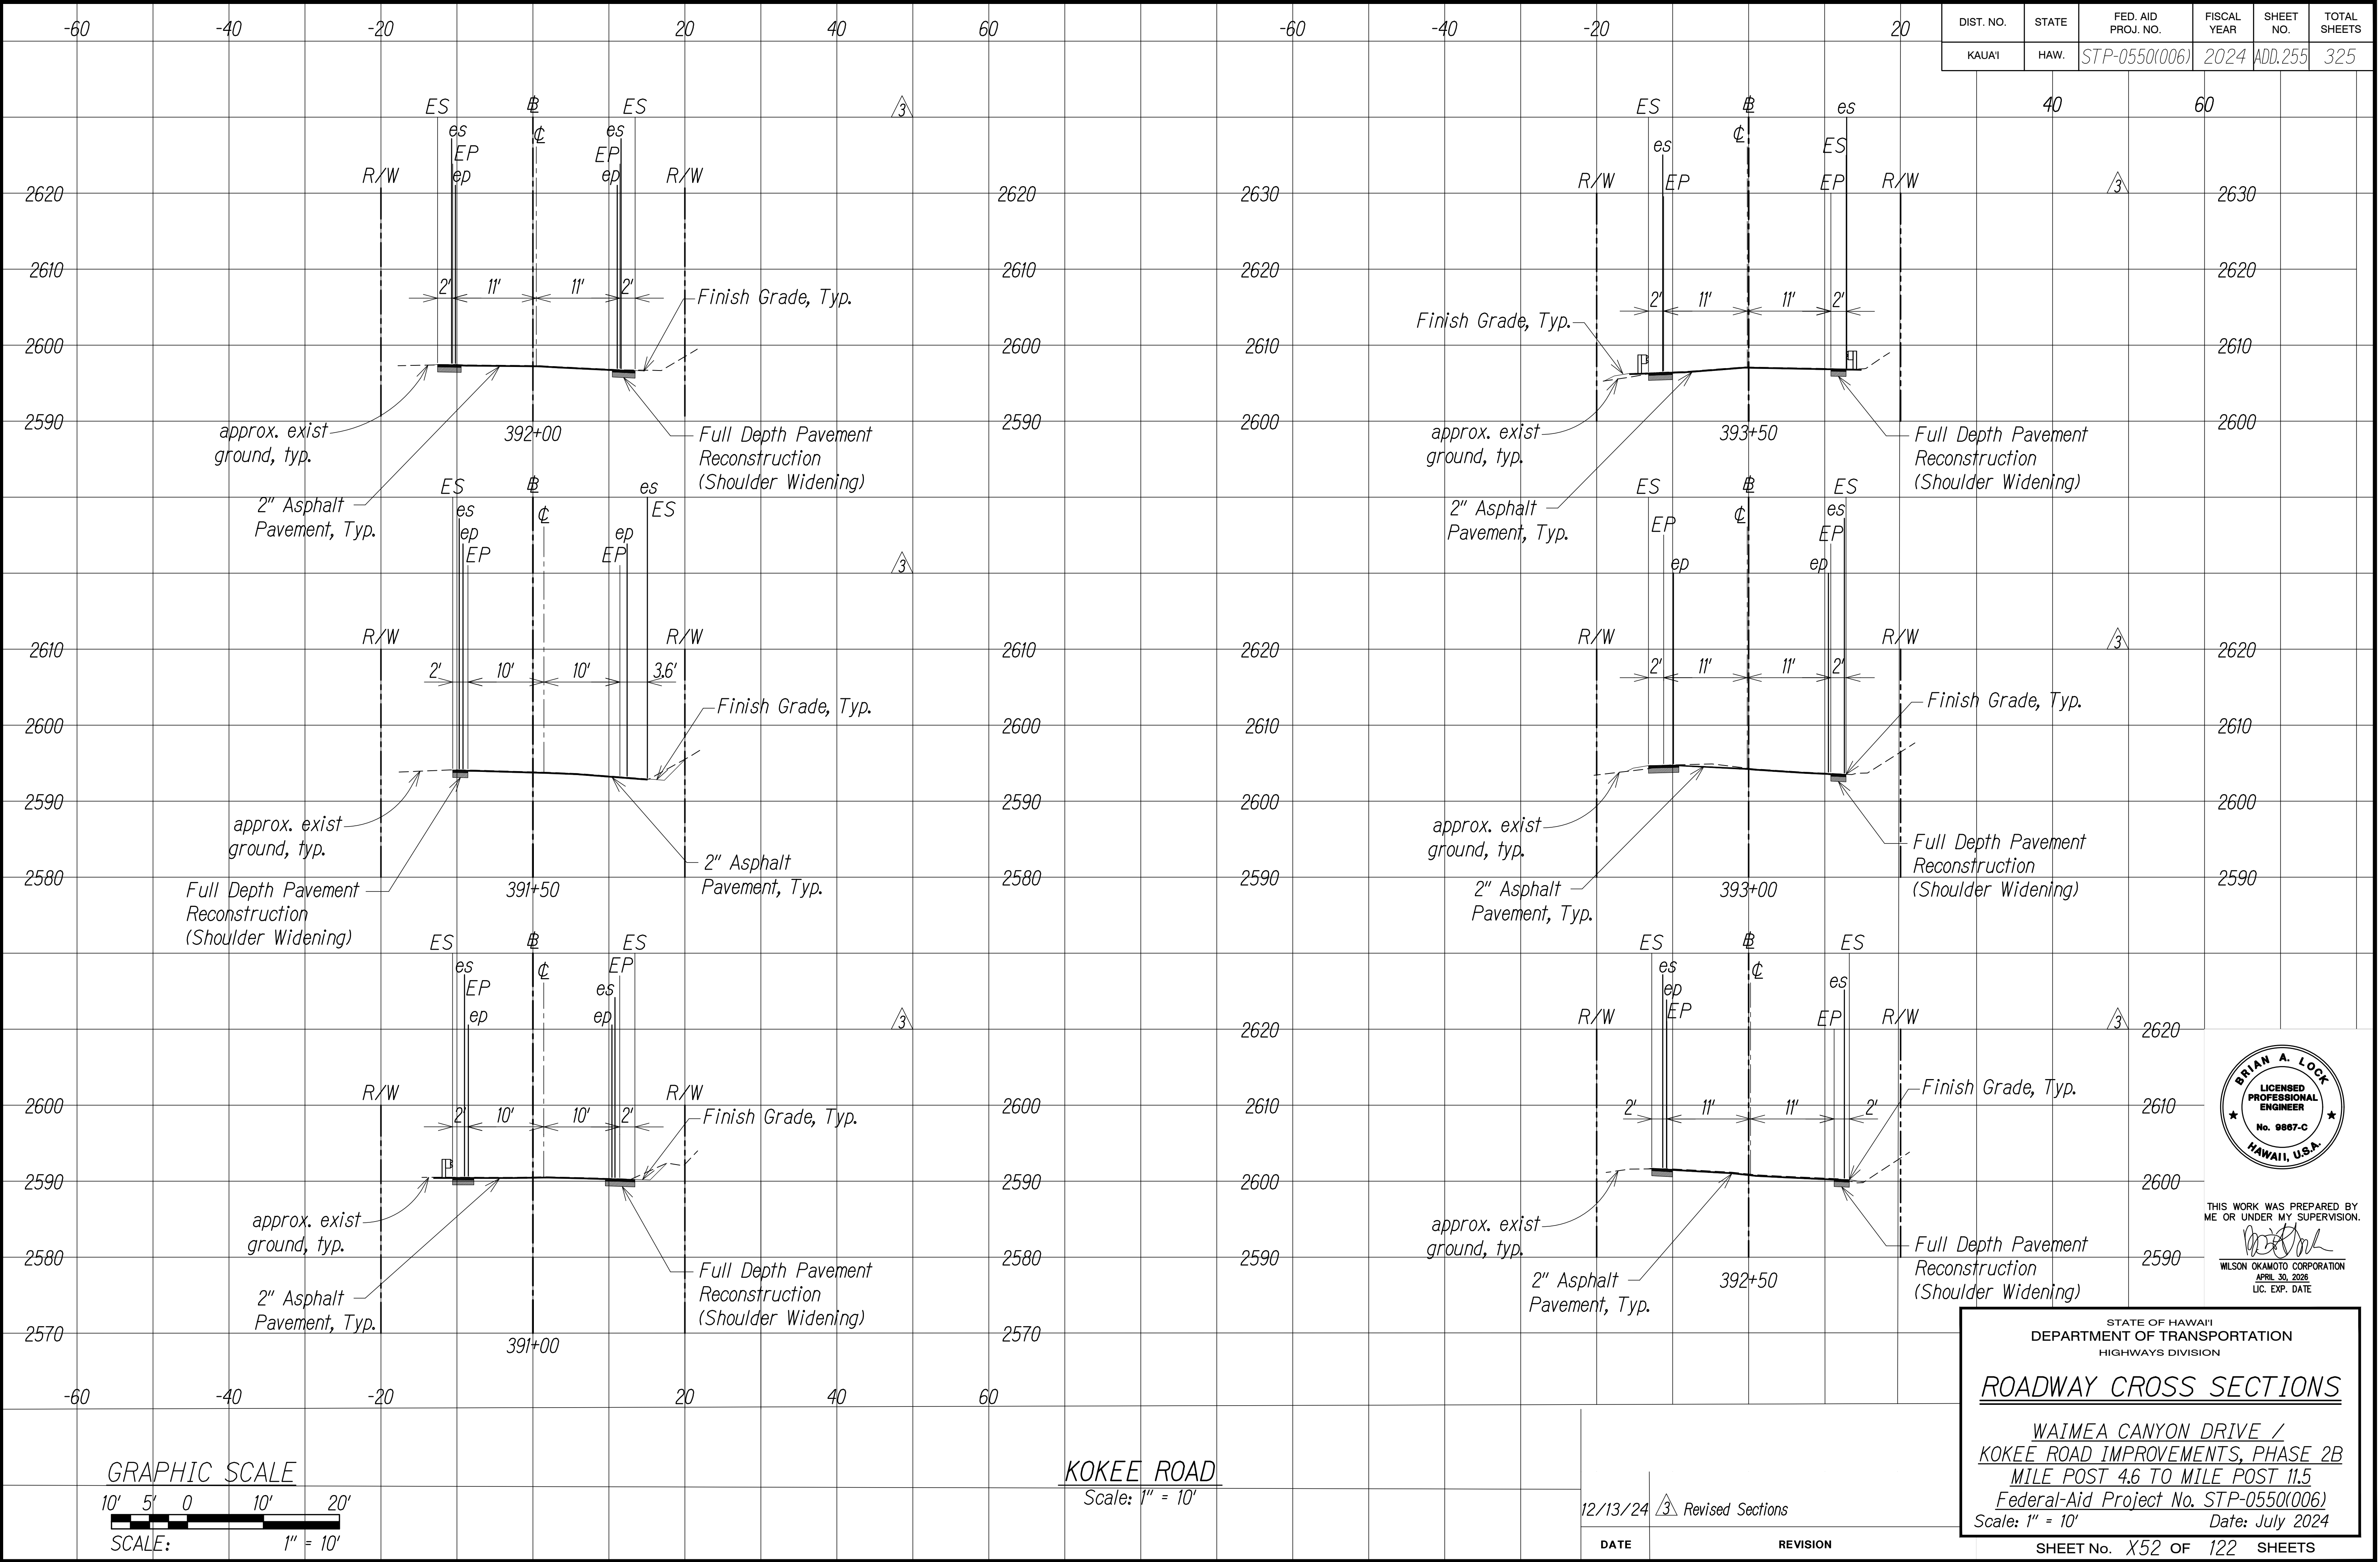

SURVEY PLOTTED BY	DATE
DESIGNED BY	
TRACED BY	
QUANTITIES BY	
CHECKED BY	
ORIGINAL PLAN	
NOTE BOOK	
No.	

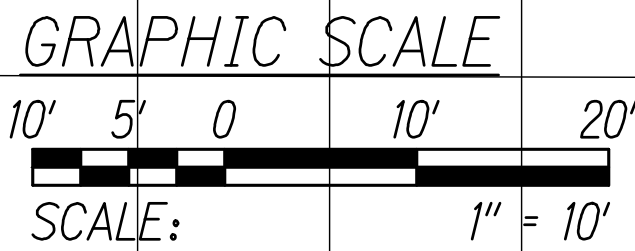

KOKEE ROAD
Scale: 1" = 10'

12/13/24 3 Revised Sections


DATE REVISION

STATE OF HAWAII
DEPARTMENT OF TRANSPORTATION
HIGHWAYS DIVISION

ROADWAY CROSS SECTIONS


WAIMEA CANYON DRIVE /
KOKEE ROAD IMPROVEMENTS, PHASE 2B
MILE POST 4.6 TO MILE POST 11.5
Federal-Aid Project No. STP-0550(006)
Scale: 1" = 10' Date: July 2024

SHEET No. X52 OF 122 SHEETS

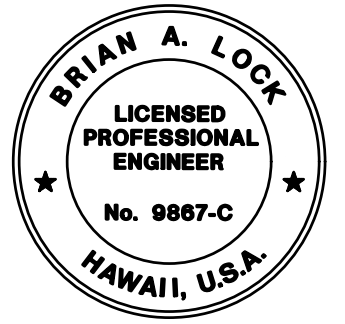


THIS WORK WAS PREPARED BY
ME OR UNDER MY SUPERVISION.
[Signature]
WILSON OKAMOTO CORPORATION
APRIL 30, 2026
LIC. EXP. DATE

DIST. NO.	STATE	FED. AID PROJ. NO.	FISCAL YEAR	SHEET NO.	TOTAL SHEETS
KAUA'I	HAW.	STP-0550(006)	2024	ADD.256	325

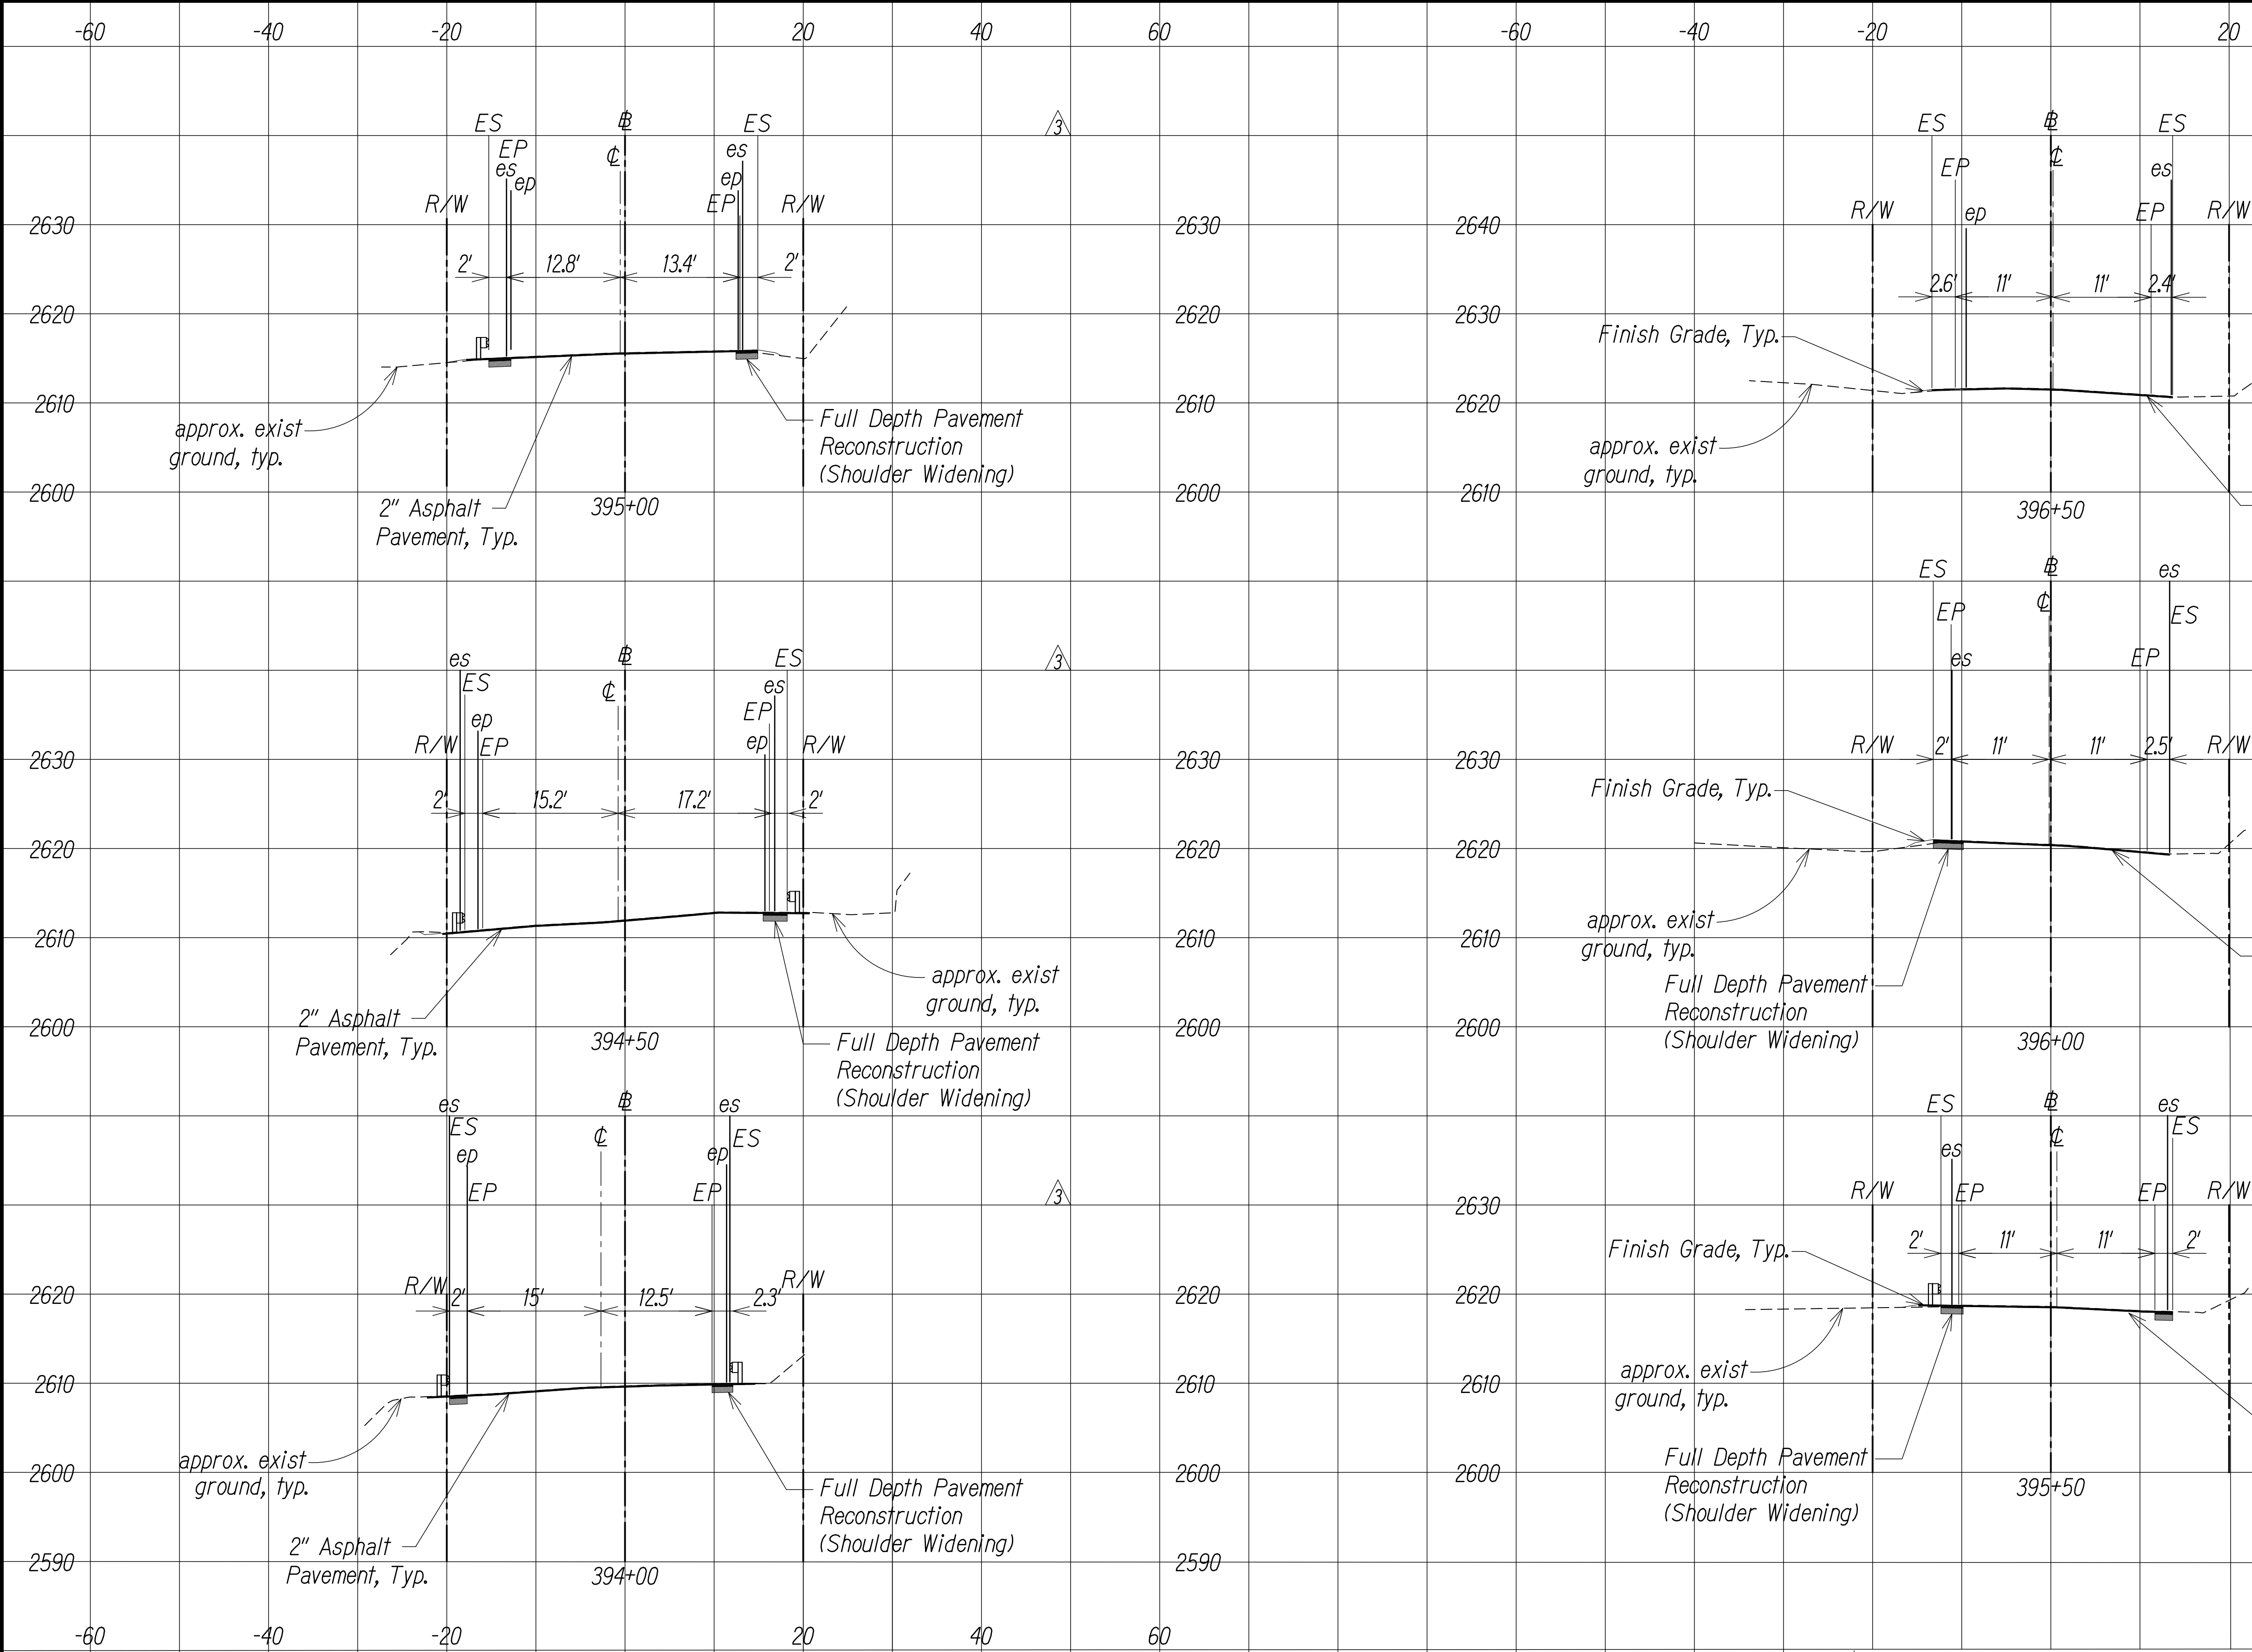

SURVEY PLOTTED BY	DATE
DESIGNED BY	
TRACED BY	
QUANTITIES BY	
CHECKED BY	


ORIGINAL PLAN	NOTE BOOK
No.	No.

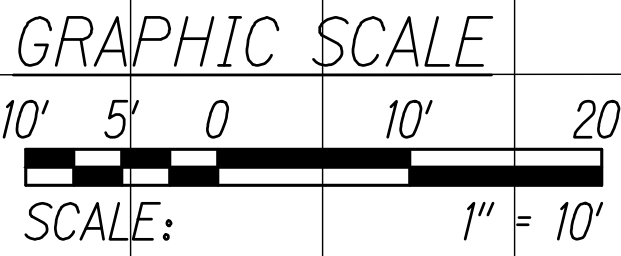

KOKEE ROAD
Scale: 1" = 10'

12/13/24 3 Revised Sections

DATE	REVISION
------	----------

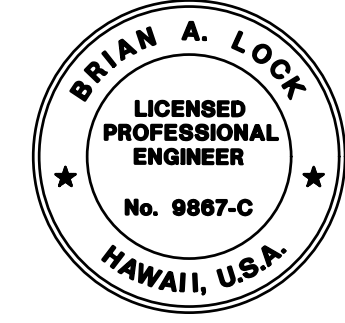


THIS WORK WAS PREPARED BY ME OR UNDER MY SUPERVISION.
WILSON OKAMOTO CORPORATION
APRIL 30, 2026
LIC. EXP. DATE

STATE OF HAWAII
DEPARTMENT OF TRANSPORTATION
HIGHWAYS DIVISION
ROADWAY CROSS SECTIONS
WAIMEA CANYON DRIVE /
KOKEE ROAD IMPROVEMENTS, PHASE 2B
MILE POST 4.6 TO MILE POST 11.5
Federal-Aid Project No. STP-0550(006)
Scale: 1" = 10' Date: July 2024


SHEET No. X53 OF 122 SHEETS

DIST. NO.	STATE	FED. AID PROJ. NO.	FISCAL YEAR	SHEET NO.	TOTAL SHEETS
KAUA'I	HAW.	STP-0550(006)	2024	ADD.257	325

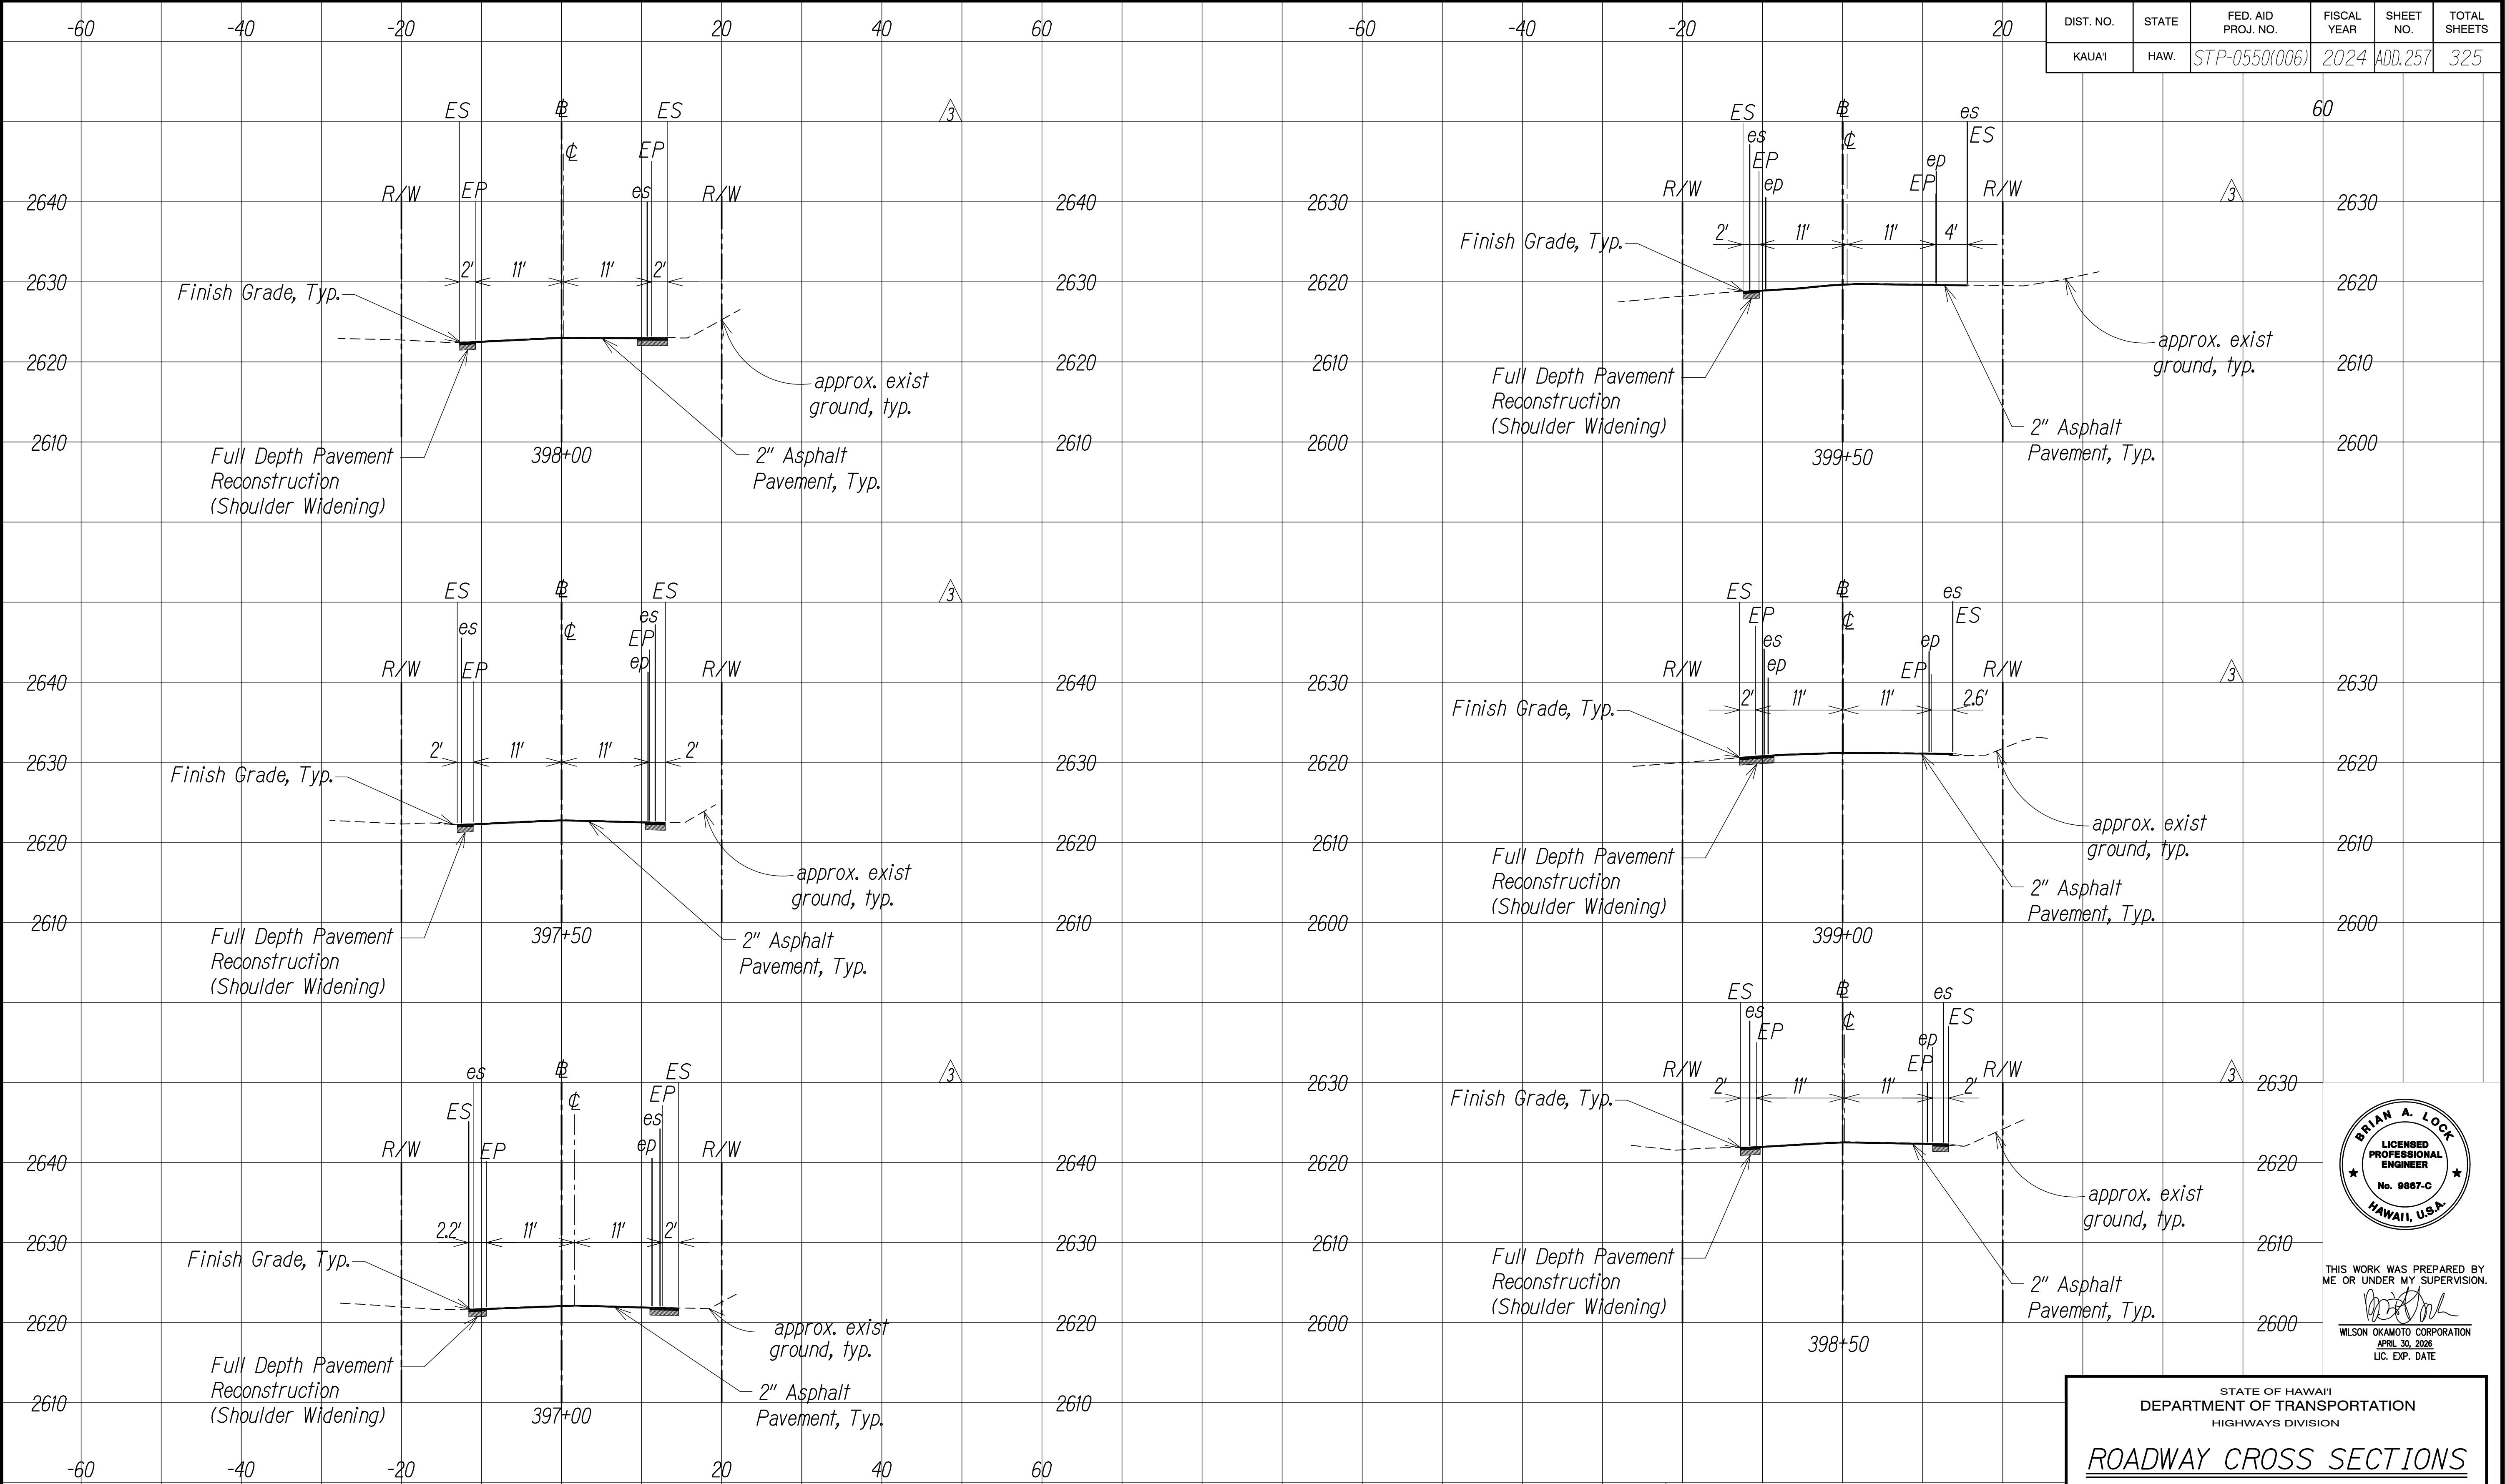


SURVEY PLOTTED BY	DATE
DESIGNED BY	
TRACED BY	
QUANTITIES BY	
CHECKED BY	

ORIGINAL PLAN	No.
NOTE BOOK	

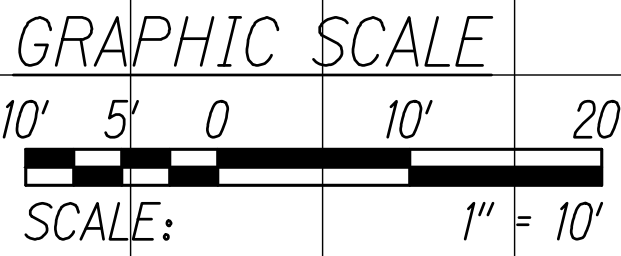

KOKEE ROAD

Scale: 1" = 10'

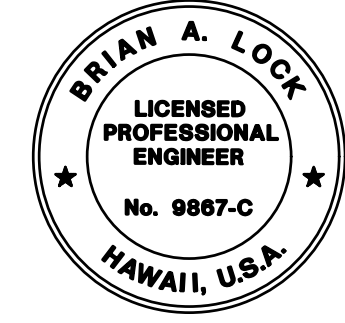

THIS WORK WAS PREPARED BY ME OR UNDER MY SUPERVISION.

[Signature]

WILSON OKAMOTO CORPORATION

APRIL 30, 2026

LIC. EXP. DATE

STATE OF HAWAII
DEPARTMENT OF TRANSPORTATION
HIGHWAYS DIVISION

ROADWAY CROSS SECTIONS


WAIMEA CANYON DRIVE /
KOKEE ROAD IMPROVEMENTS, PHASE 2B
MILE POST 4.6 TO MILE POST 11.5
Federal-Aid Project No. STP-0550(006)
Scale: 1" = 10' Date: July 2024


12/13/24 3 Revised Sections

DATE REVISION

SHEET No. X54 OF 122 SHEETS

DIST. NO.	STATE	FED. AID PROJ. NO.	FISCAL YEAR	SHEET NO.	TOTAL SHEETS
KAUAI	HAW.	STP-0550(006)	2024	ADD.258	325

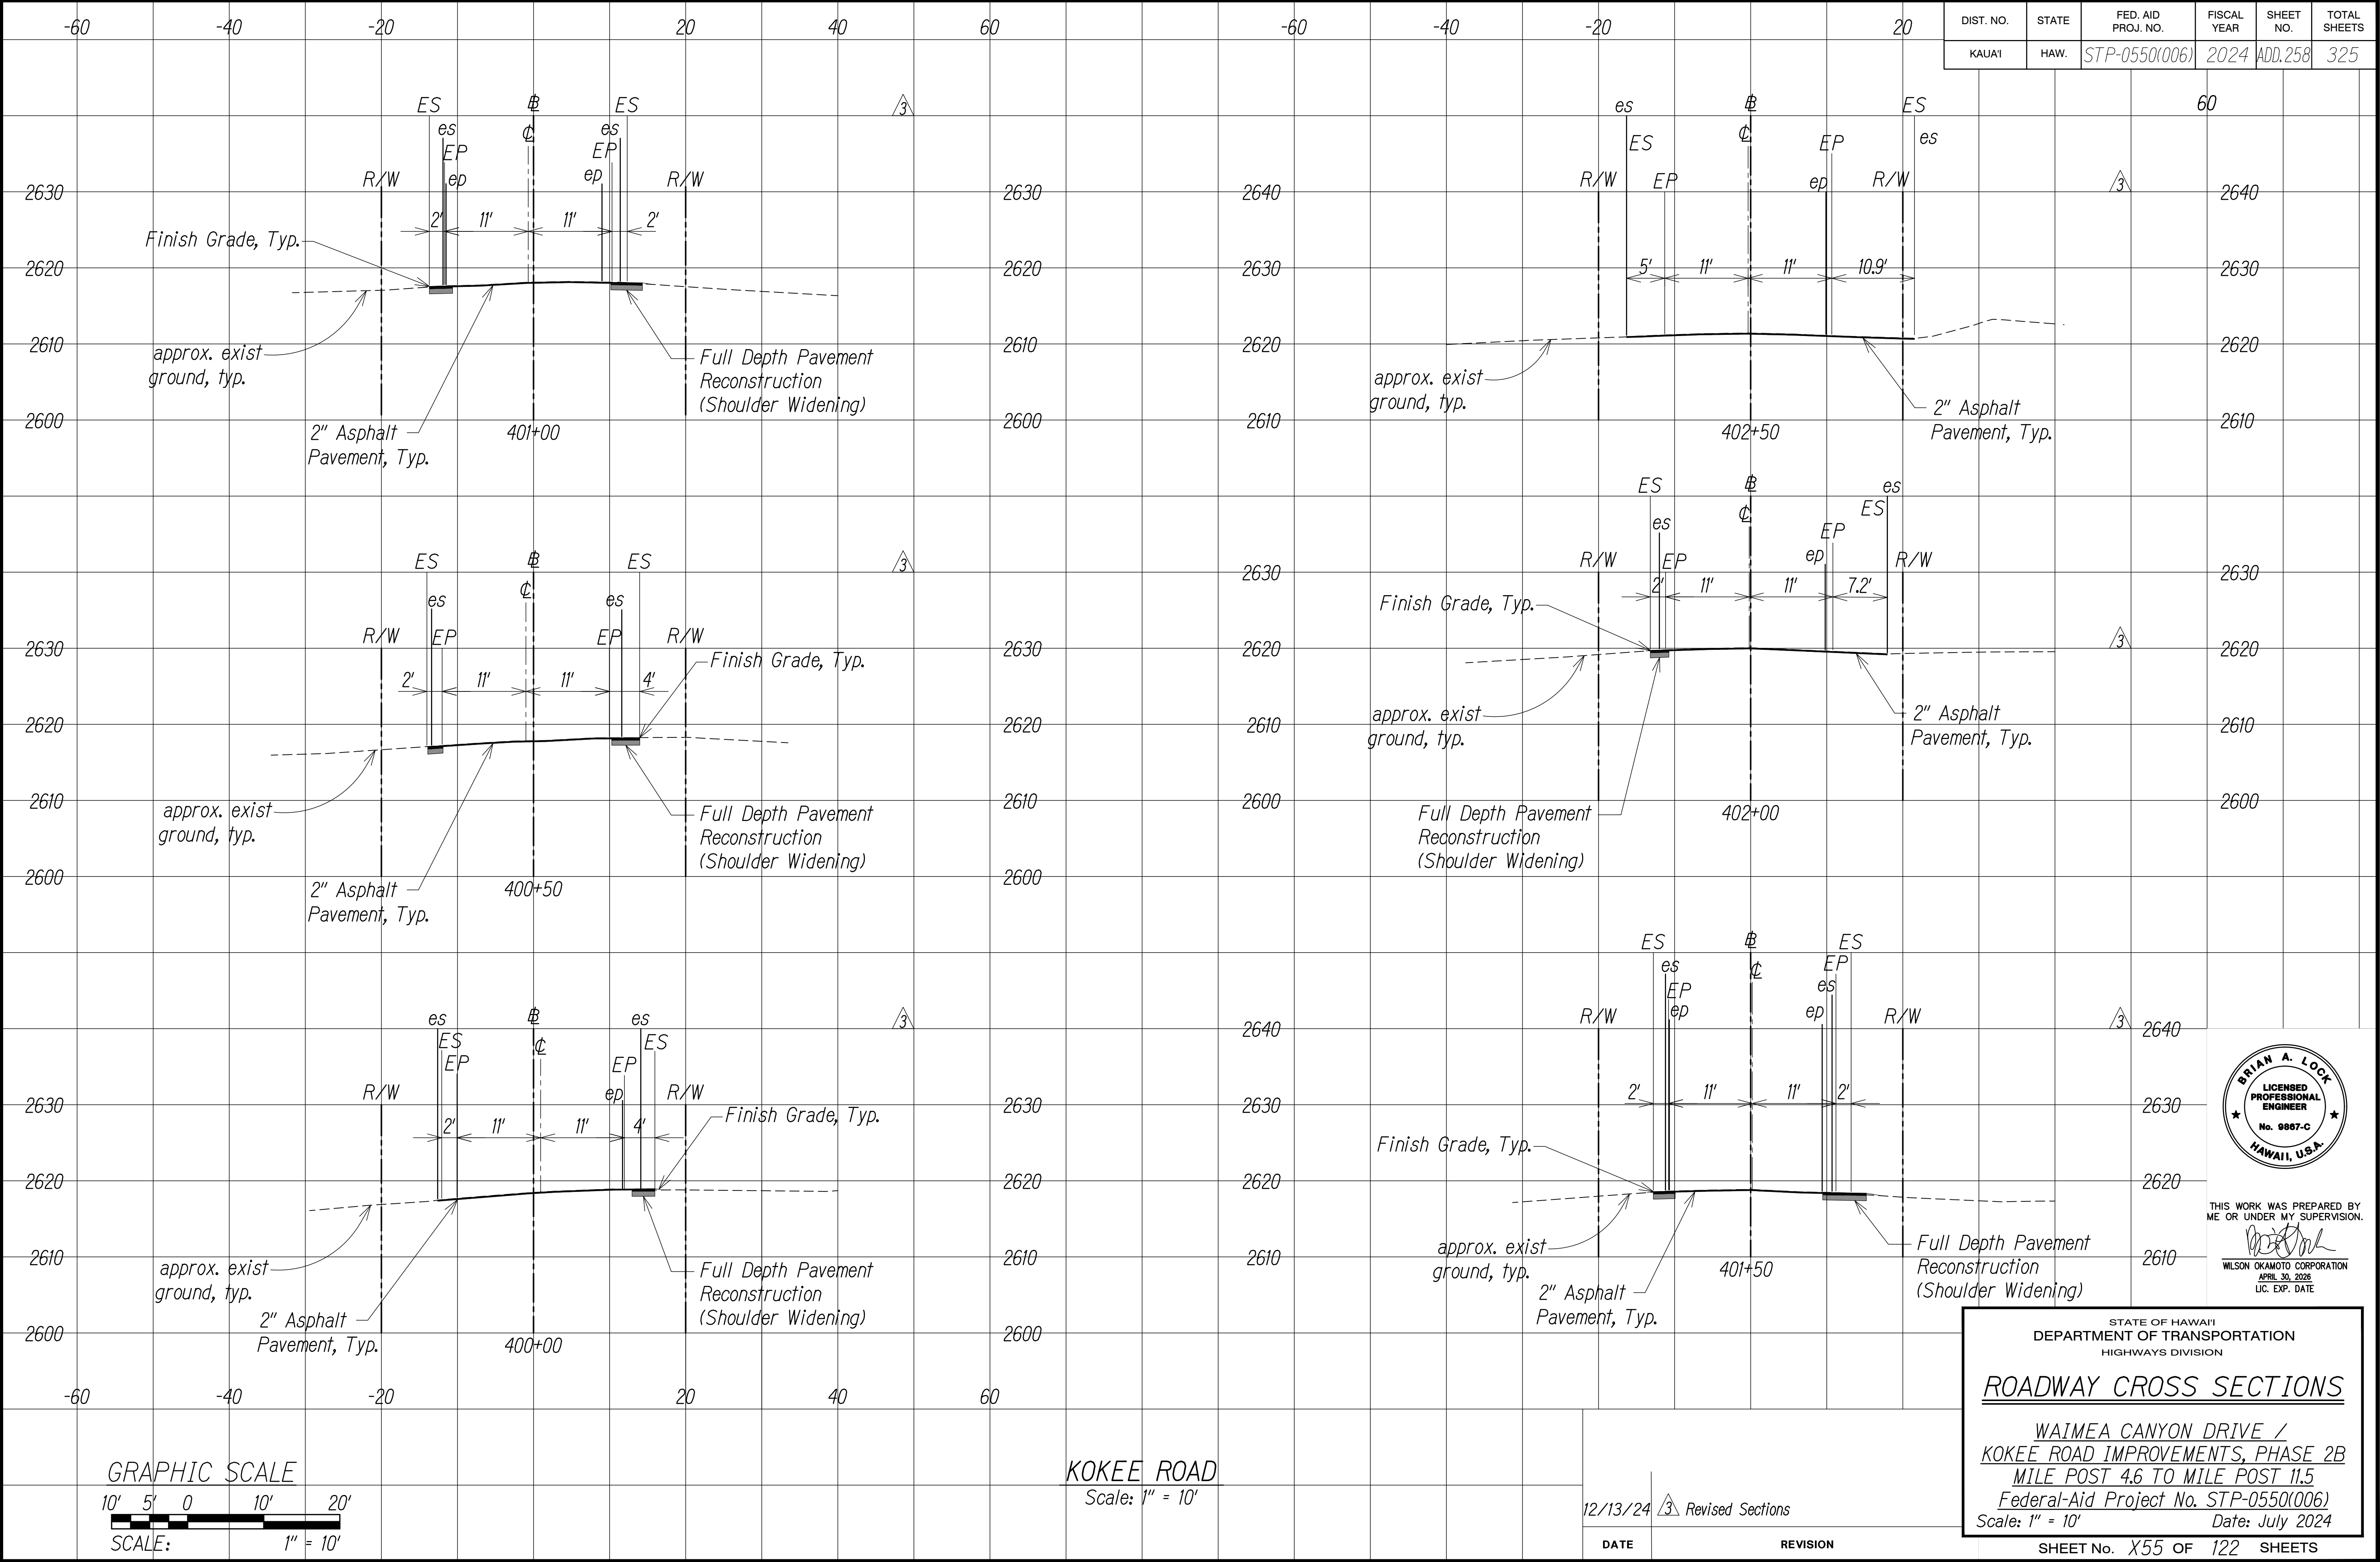


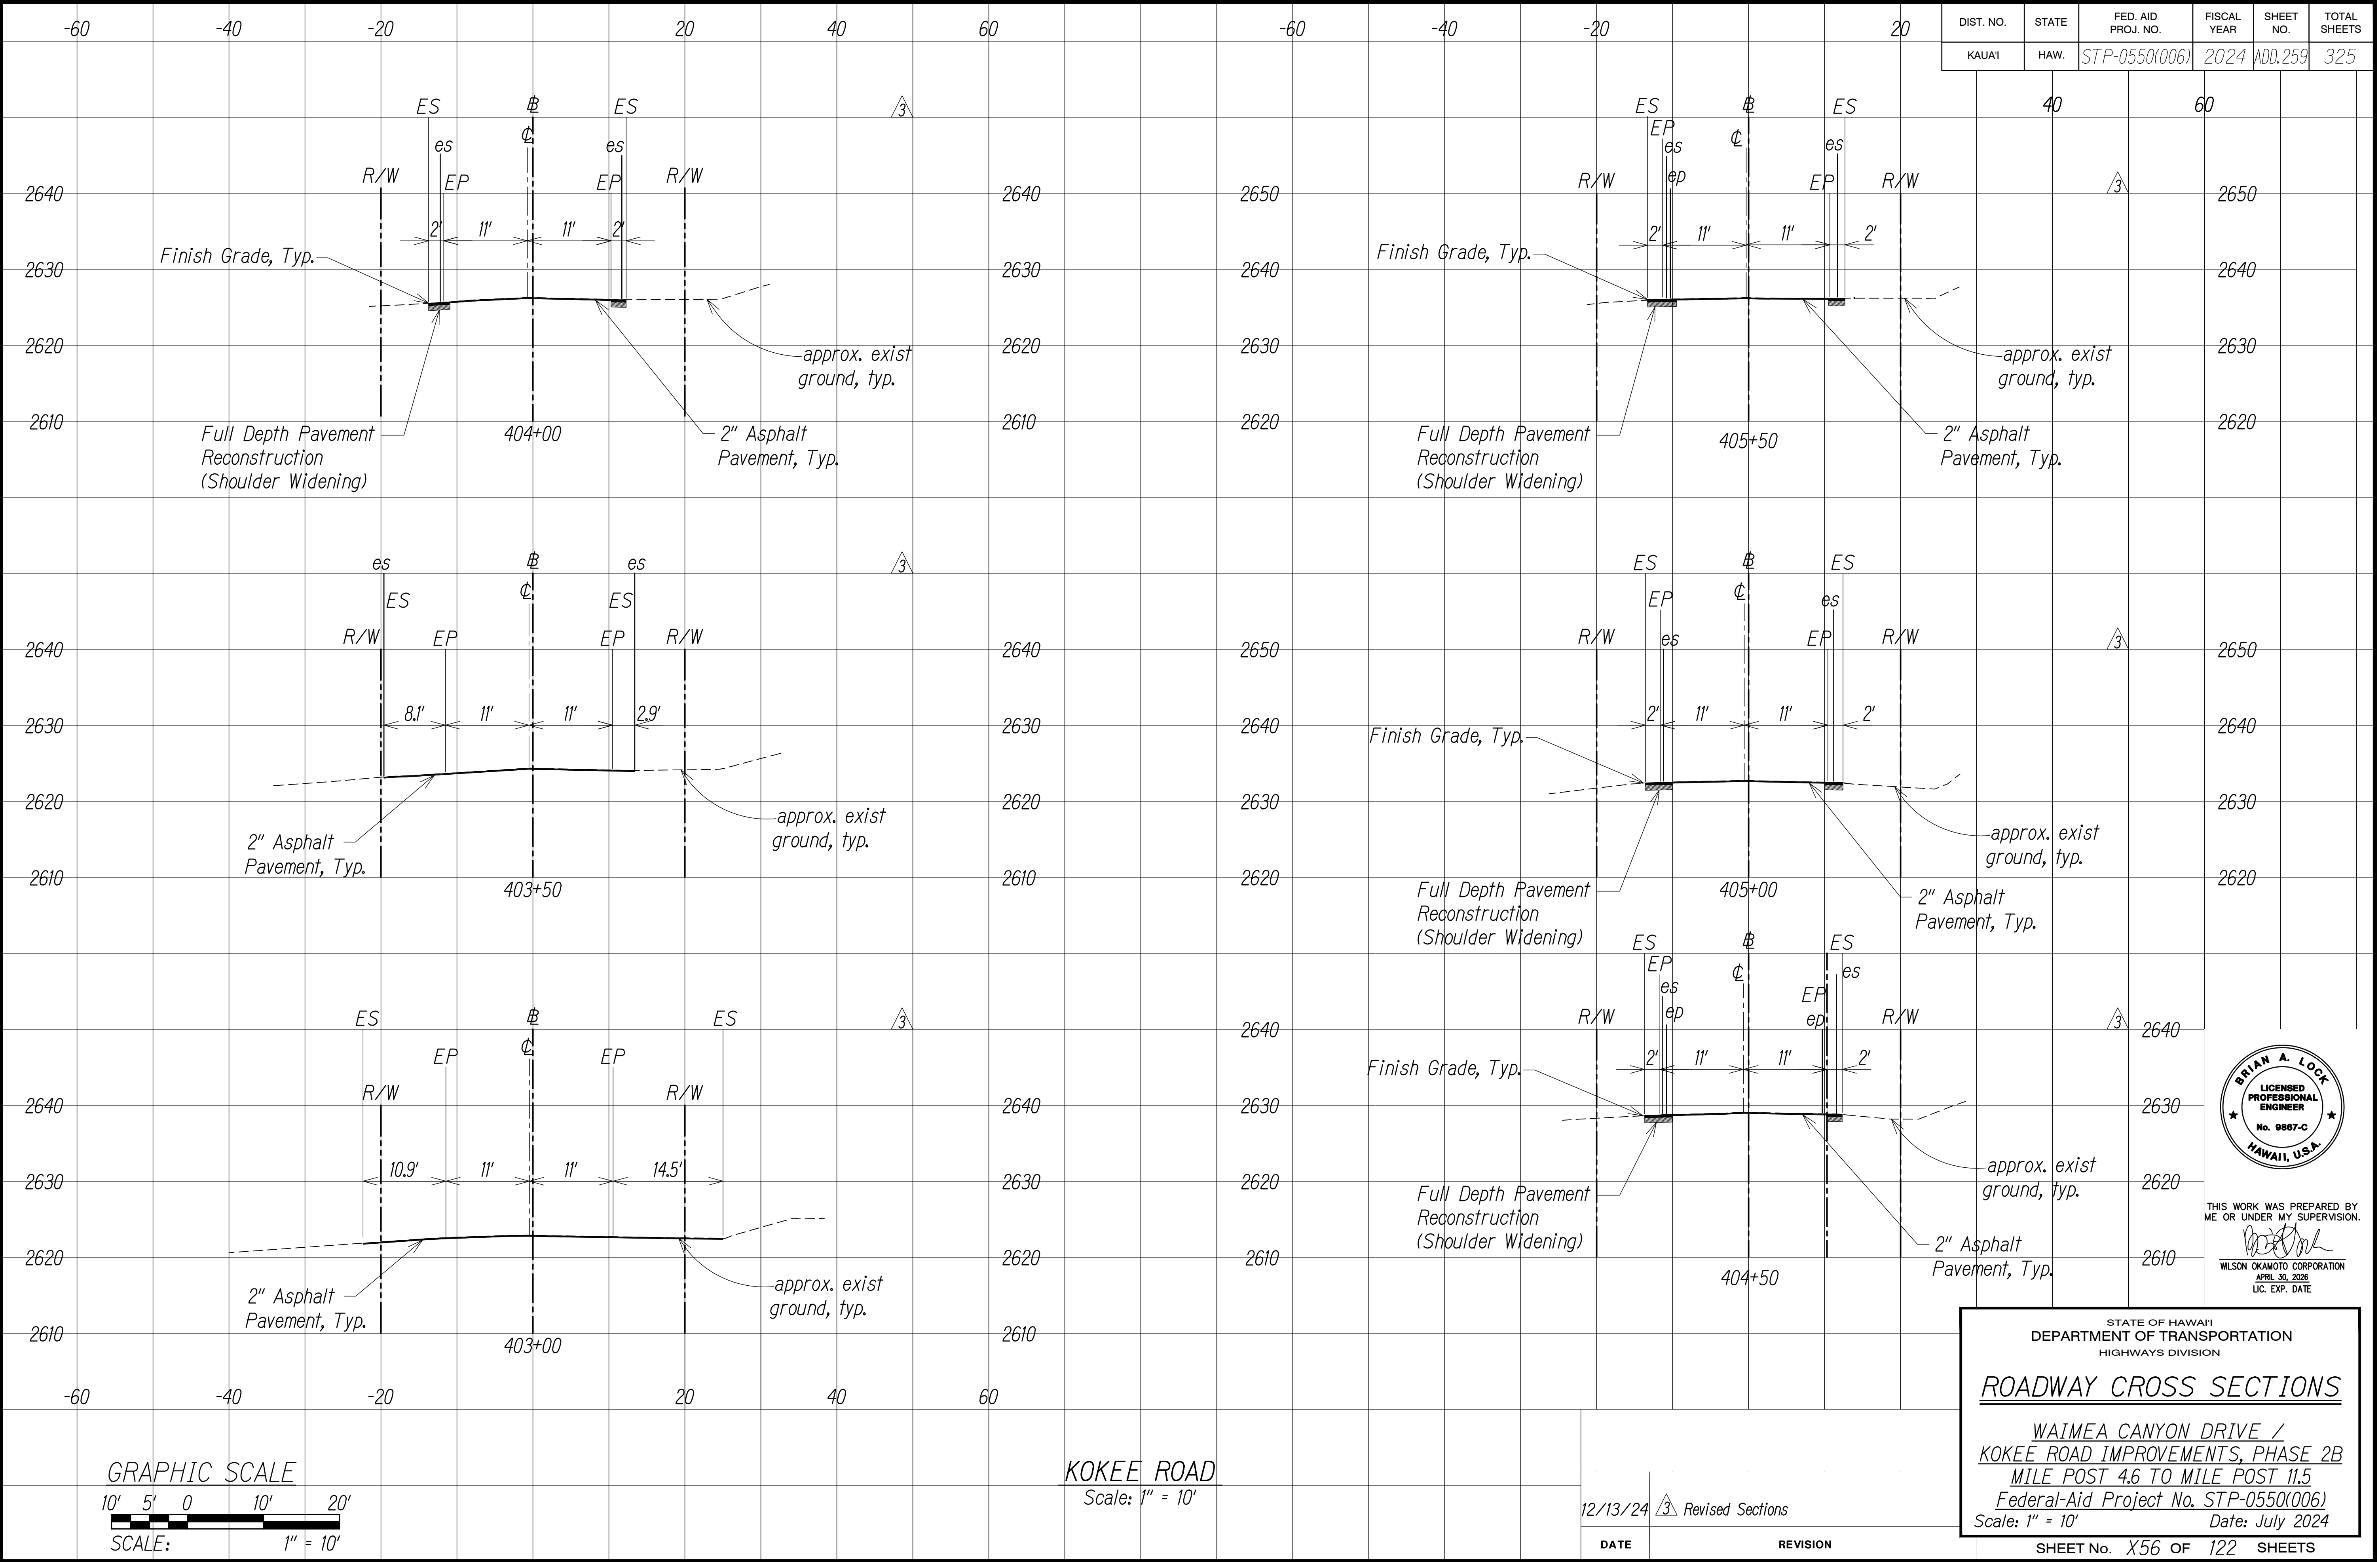

DIST. NO.	STATE	FED. AID PROJ. NO.	FISCAL YEAR	SHEET NO.	TOTAL SHEETS
KAUA'I	HAW.	STP-0550(006)	2024	ADD.259	325

SURVEY PLOTTED BY	DATE
DESIGNED BY	
TRACED BY	
DESIGNED BY	
QUANTITIES BY	
CHECKED BY	

ORIGINAL PLAN	No.
NOTE BOOK	

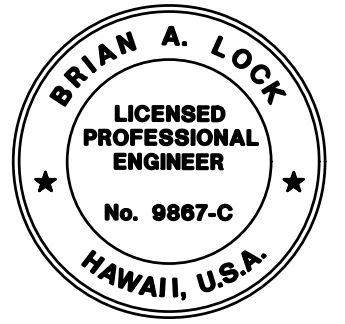

THIS WORK WAS PREPARED BY ME OR UNDER MY SUPERVISION.
[Signature]
WILSON OKAMOTO CORPORATION
APRIL 30, 2026
LIC. EXP. DATE

STATE OF HAWAII
DEPARTMENT OF TRANSPORTATION
HIGHWAYS DIVISION

ROADWAY CROSS SECTIONS


WAIMEA CANYON DRIVE /
Kokee Road Improvements, Phase 2B
MILE POST 4.6 TO MILE POST 11.5
Federal-Aid Project No. STP-0550(006)
Scale: 1" = 10' Date: July 2024

12/13/24 3 Revised Sections

DATE	REVISION
------	----------


SHEET No. X56 OF 122 SHEETS

DIST. NO.	STATE	FED. AID PROJ. NO.	FISCAL YEAR	SHEET NO.	TOTAL SHEETS
KAUAI	HAW.	STP-0550(006)	2024	ADD.260	325

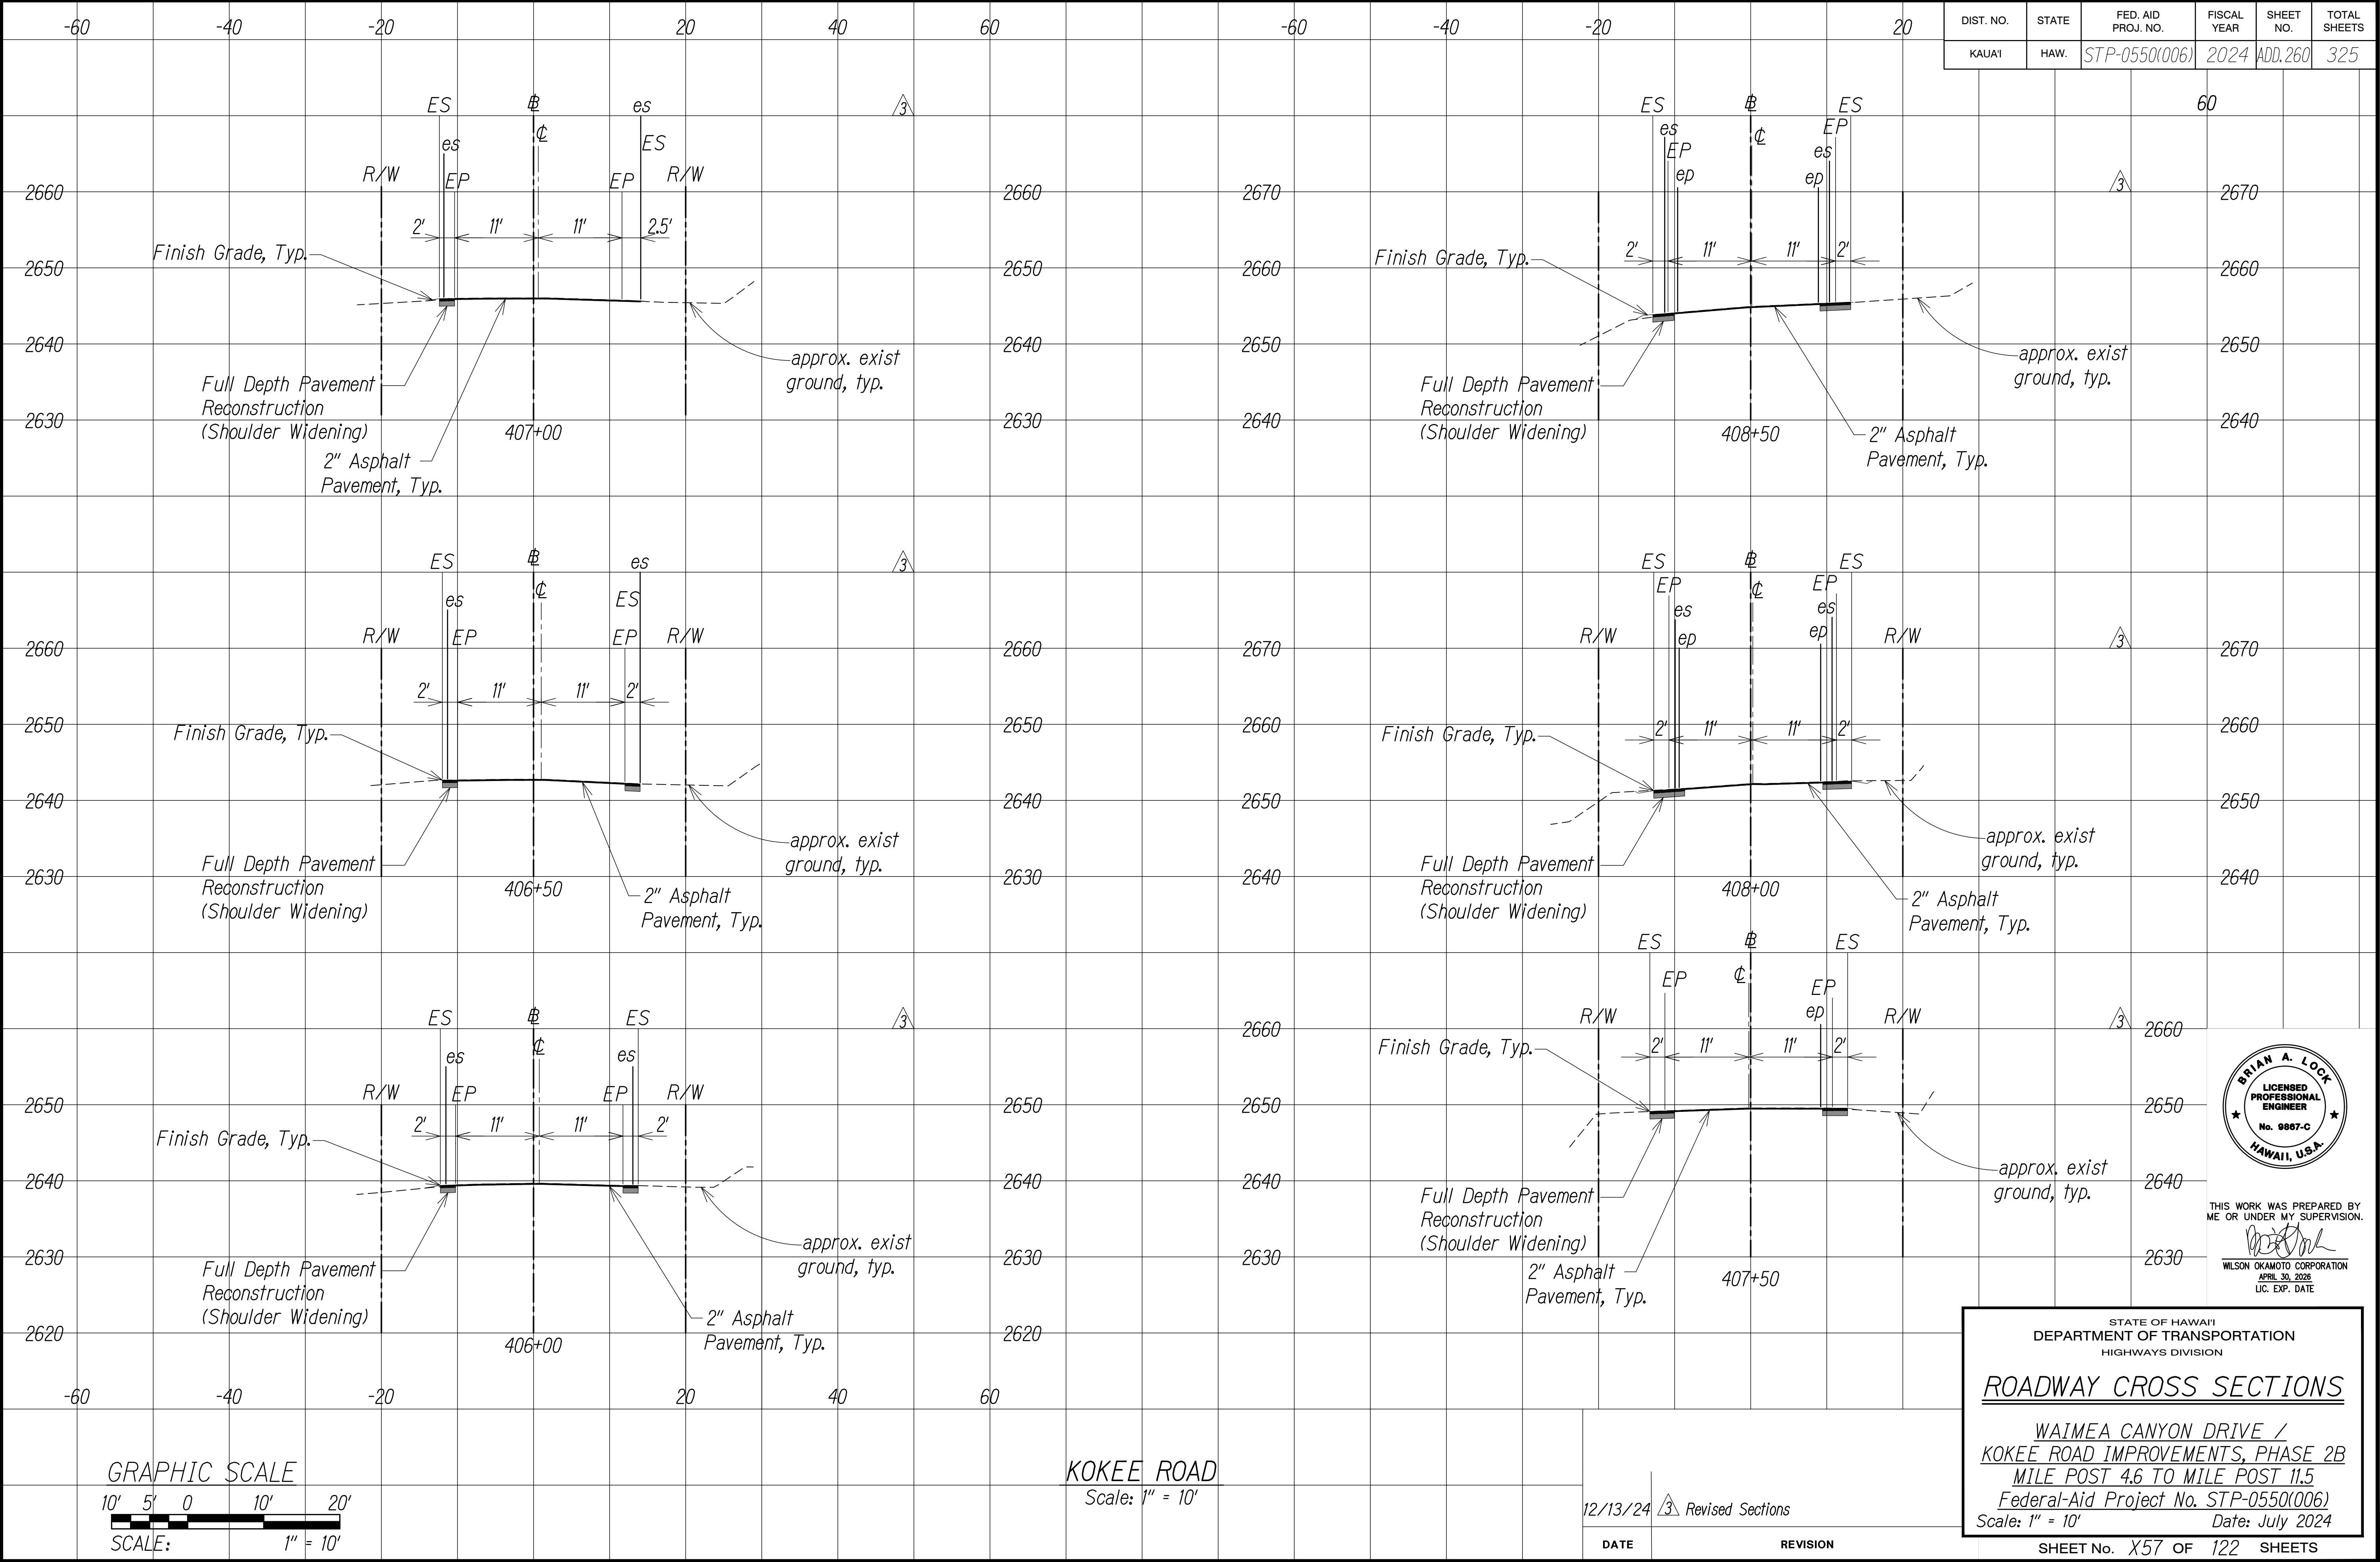

SURVEY PLOTTED BY	DATE
DESIGNED BY	
TRACED BY	
DESIGNED BY	
QUANTITIES BY	
CHECKED BY	

ORIGINAL PLAN	No.
NOTE BOOK	

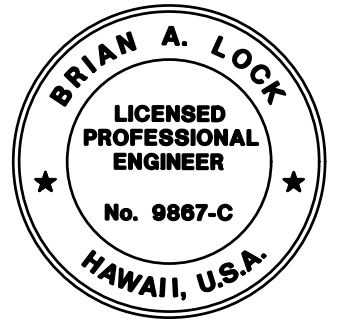

THIS WORK WAS PREPARED BY
ME OR UNDER MY SUPERVISION.


[Signature]

WILSON OKAMOTO CORPORATION
APRIL 30, 2026
LIC. EXP. DATE

STATE OF HAWAII
DEPARTMENT OF TRANSPORTATION
HIGHWAYS DIVISION

ROADWAY CROSS SECTIONS

WAIMEA CANYON DRIVE /
KOKEE ROAD IMPROVEMENTS, PHASE 2B
MILE POST 4.6 TO MILE POST 11.5
Federal-Aid Project No. STP-0550(006)
Scale: 1" = 10' Date: July 2024

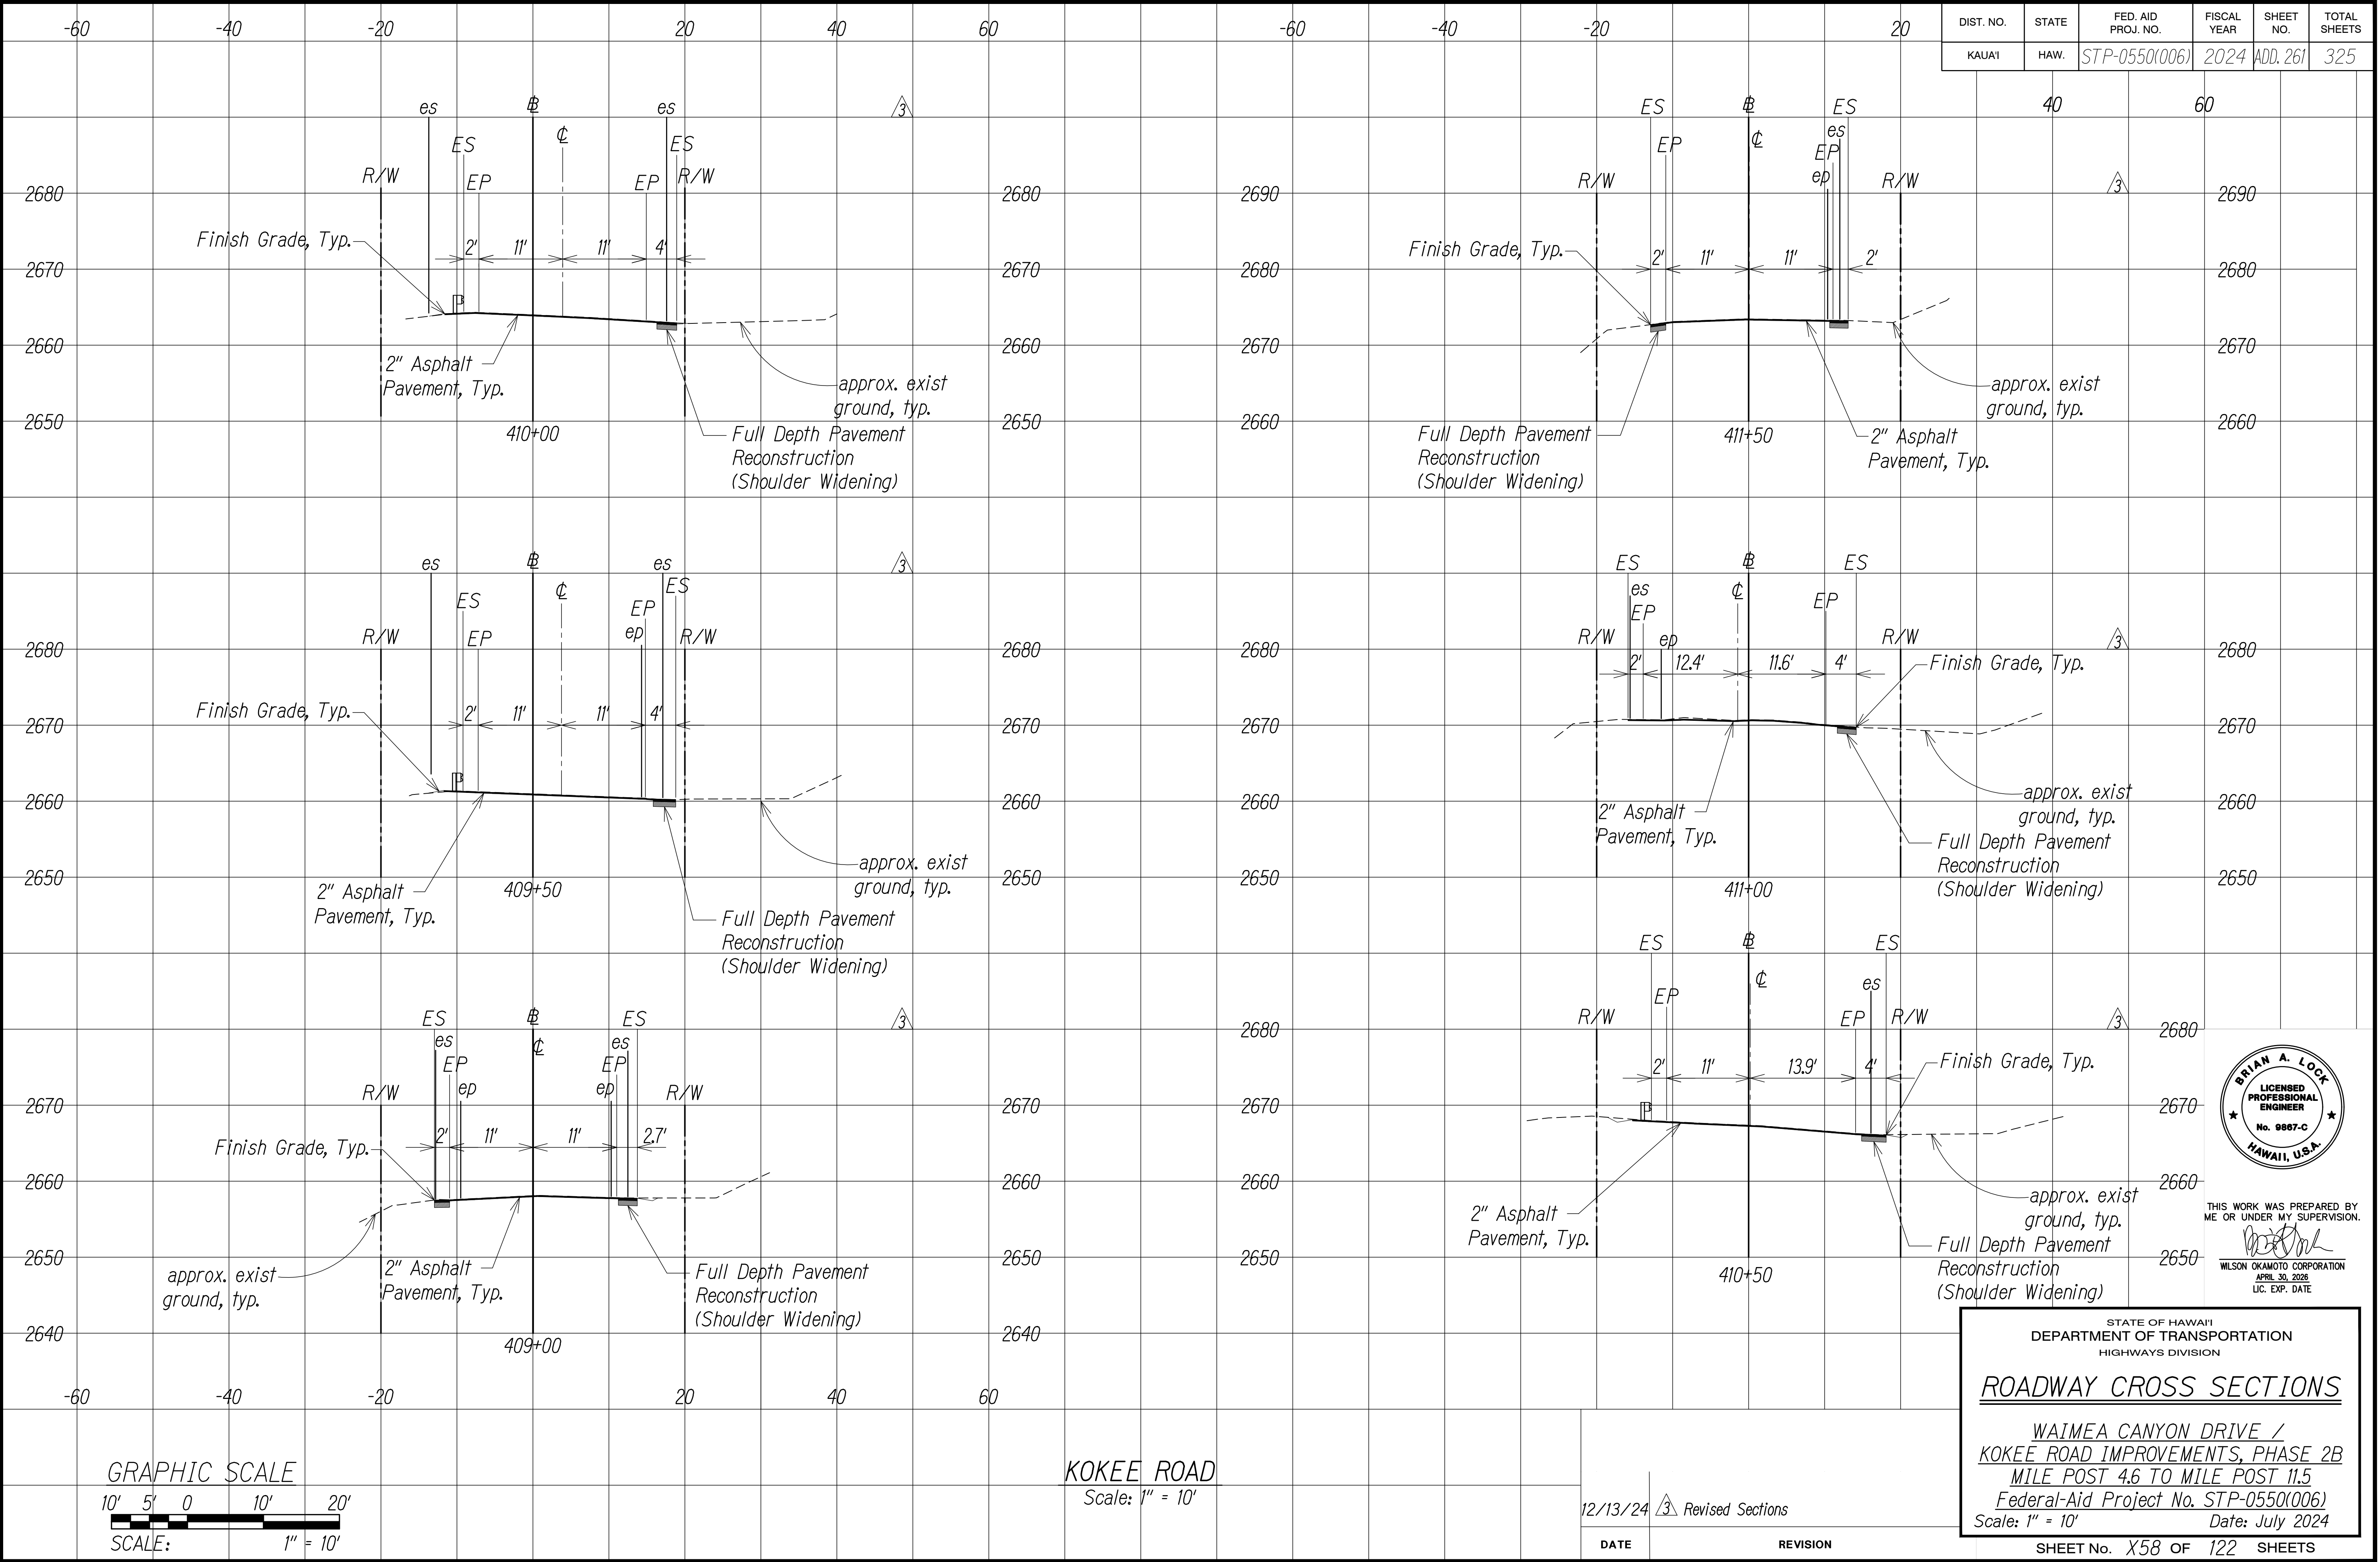


STATE OF HAWAII
DEPARTMENT OF TRANSPORTATION
HIGHWAYS DIVISION

ROADWAY CROSS SECTIONS


WAIMEA CANYON DRIVE /
KOKEE ROAD IMPROVEMENTS, PHASE 2B
MILE POST 4.6 TO MILE POST 11.5
Federal-Aid Project No. STP-0550(006)
Scale: 1" = 10' Date: July 2024

DIST. NO.	STATE	FED. AID PROJ. NO.	FISCAL YEAR	SHEET NO.	TOTAL SHEETS
KAUAI	HAW.	STP-0550(006)	2024	ADD.262	325

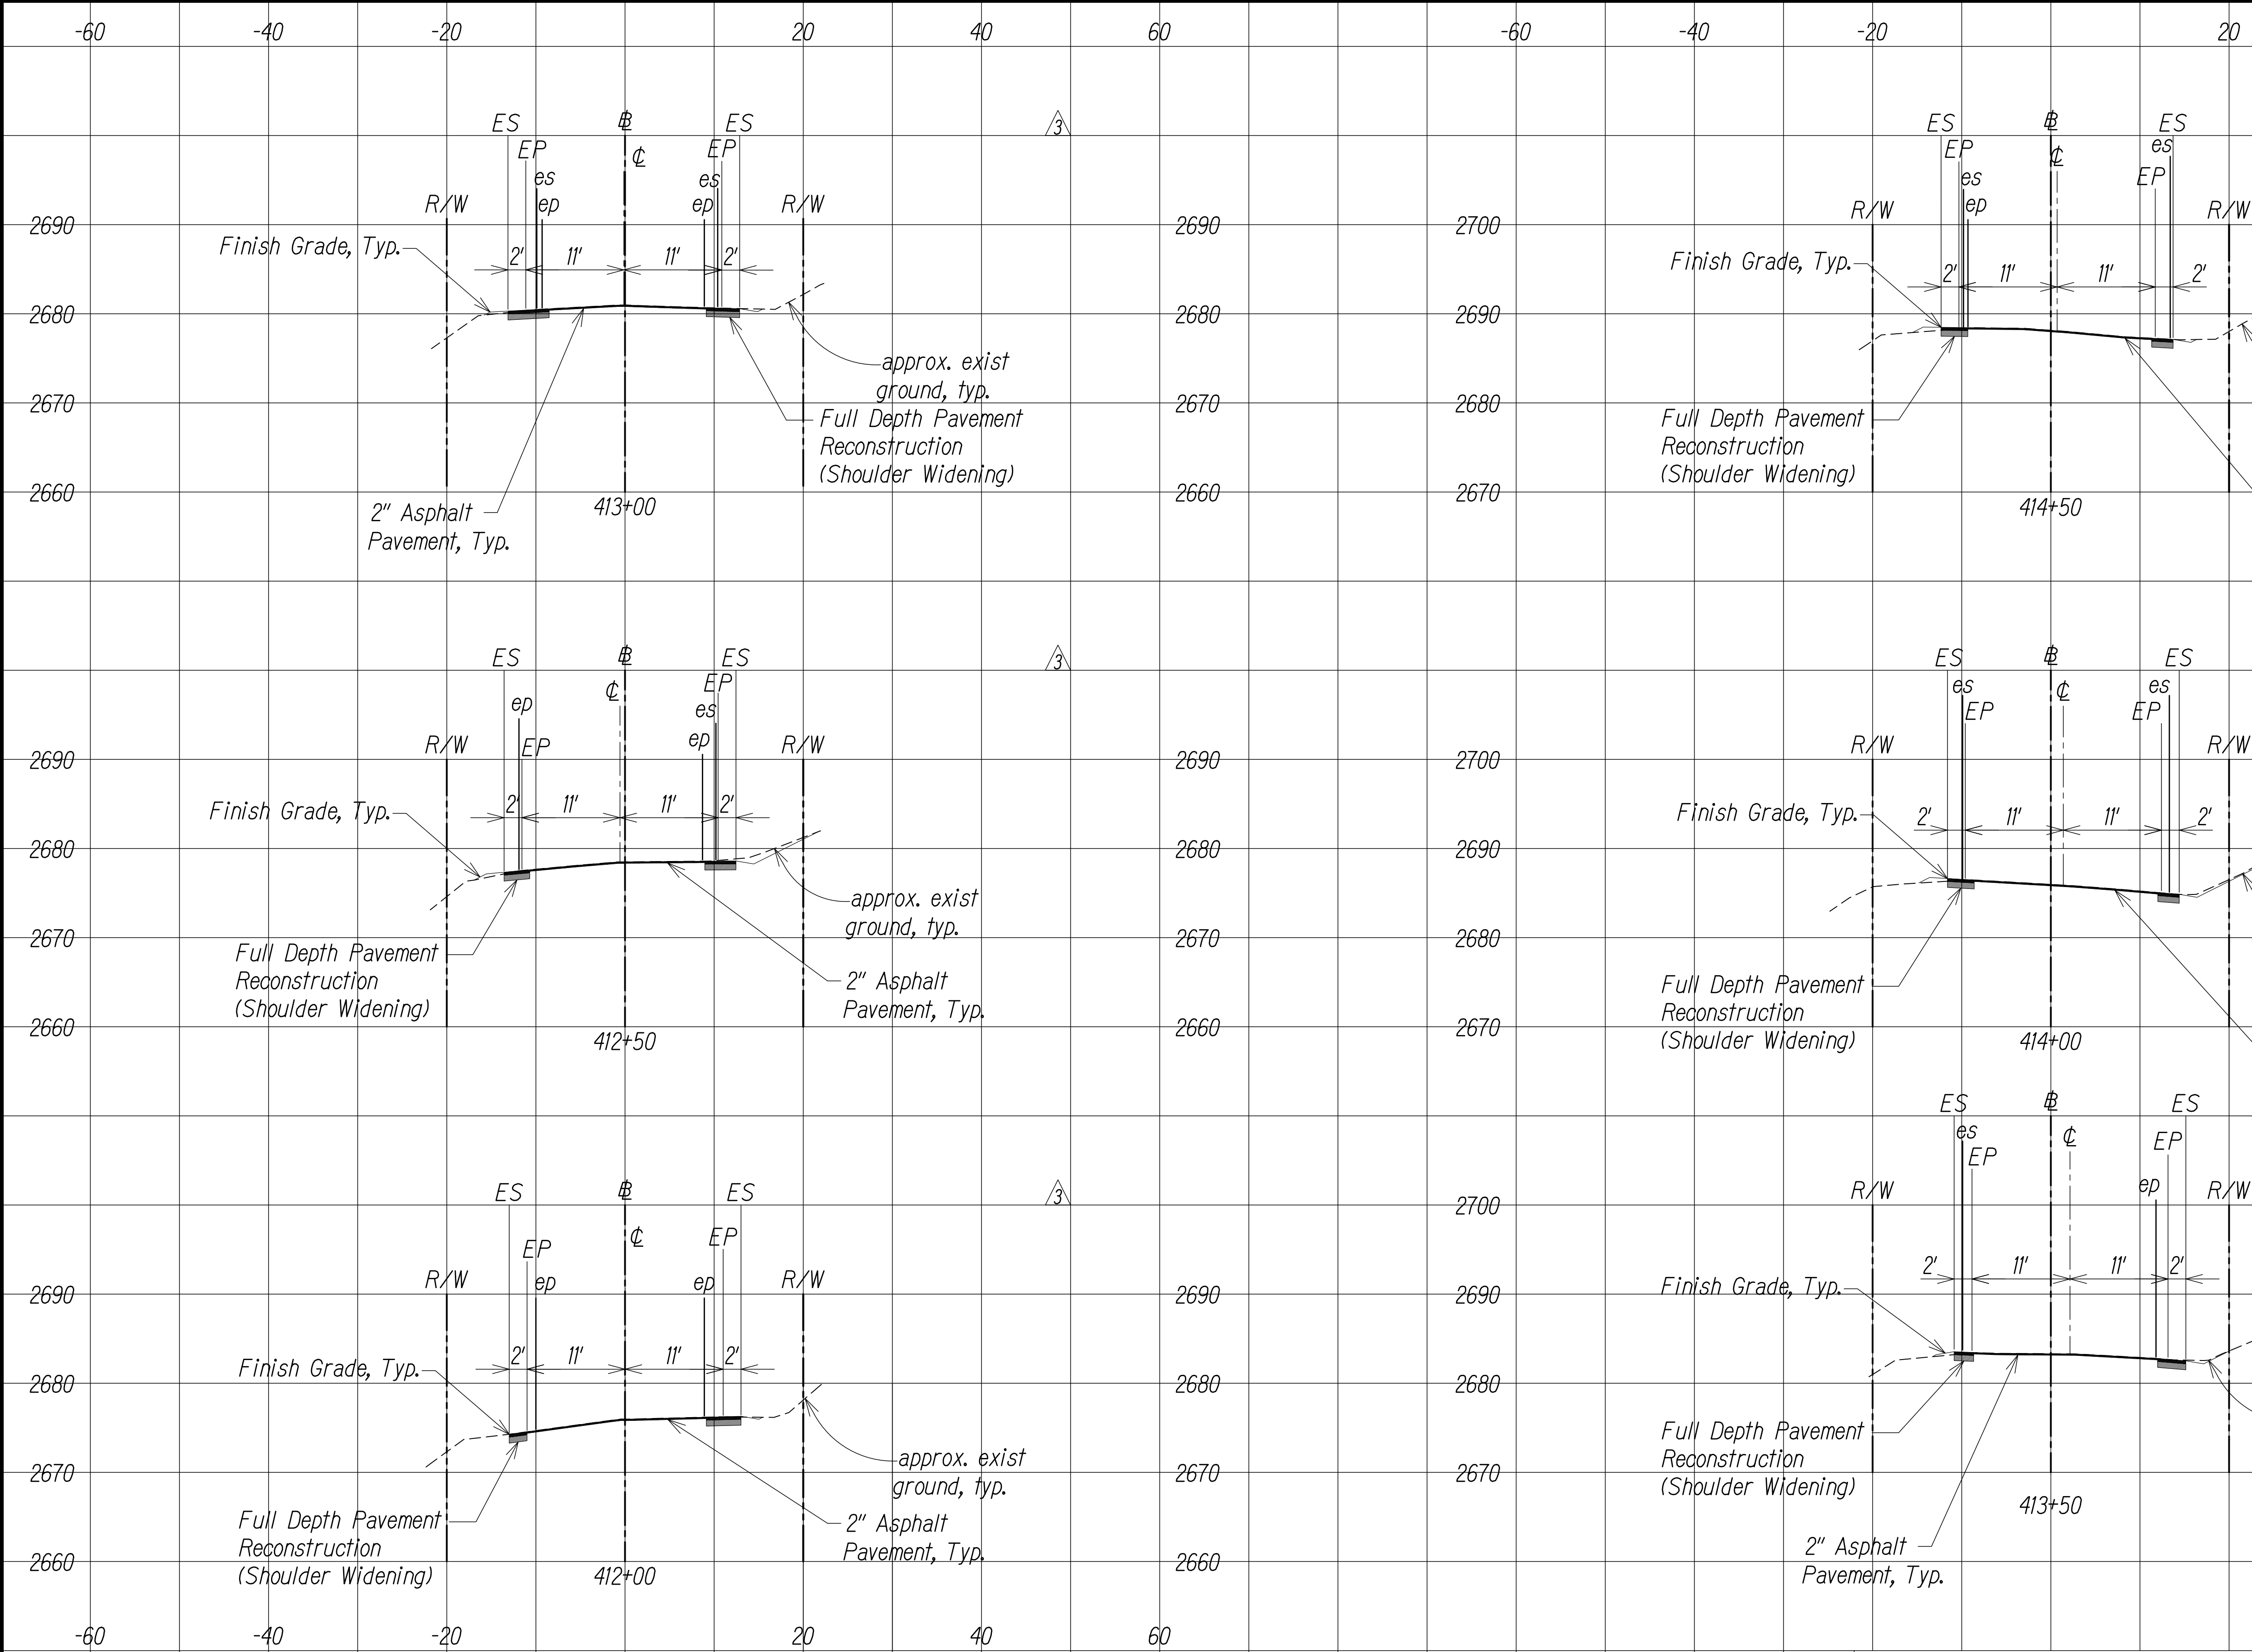


SURVEY PLOTTED BY	DATE
DESIGNED BY	
TRACED BY	
QUANTITIES BY	
CHECKED BY	

ORIGINAL PLAN	NO.
NOTE BOOK	

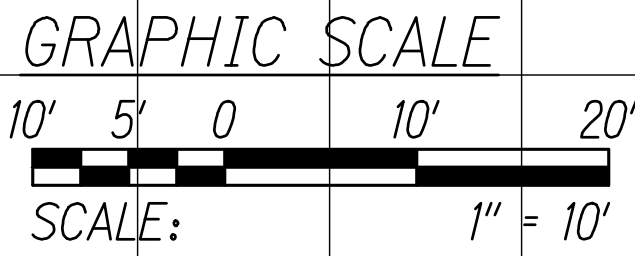

KOKEE ROAD
Scale: 1" = 10'

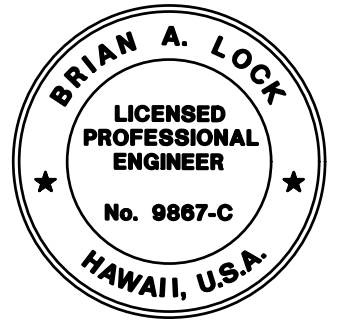


THIS WORK WAS PREPARED BY
ME OR UNDER MY SUPERVISION.
[Signature]
WILSON OKAMOTO CORPORATION
APRIL 30, 2026
LIC. EXP. DATE

STATE OF HAWAII
DEPARTMENT OF TRANSPORTATION
HIGHWAYS DIVISION
ROADWAY CROSS SECTIONS
WAIMEA CANYON DRIVE /
KOKEE ROAD IMPROVEMENTS, PHASE 2B
MILE POST 4.6 TO MILE POST 11.5
Federal-Aid Project No. STP-0550(006)
Scale: 1" = 10' Date: July 2024

12/13/24 3 Revised Sections


DATE REVISION

SHEET No. X59 OF 122 SHEETS

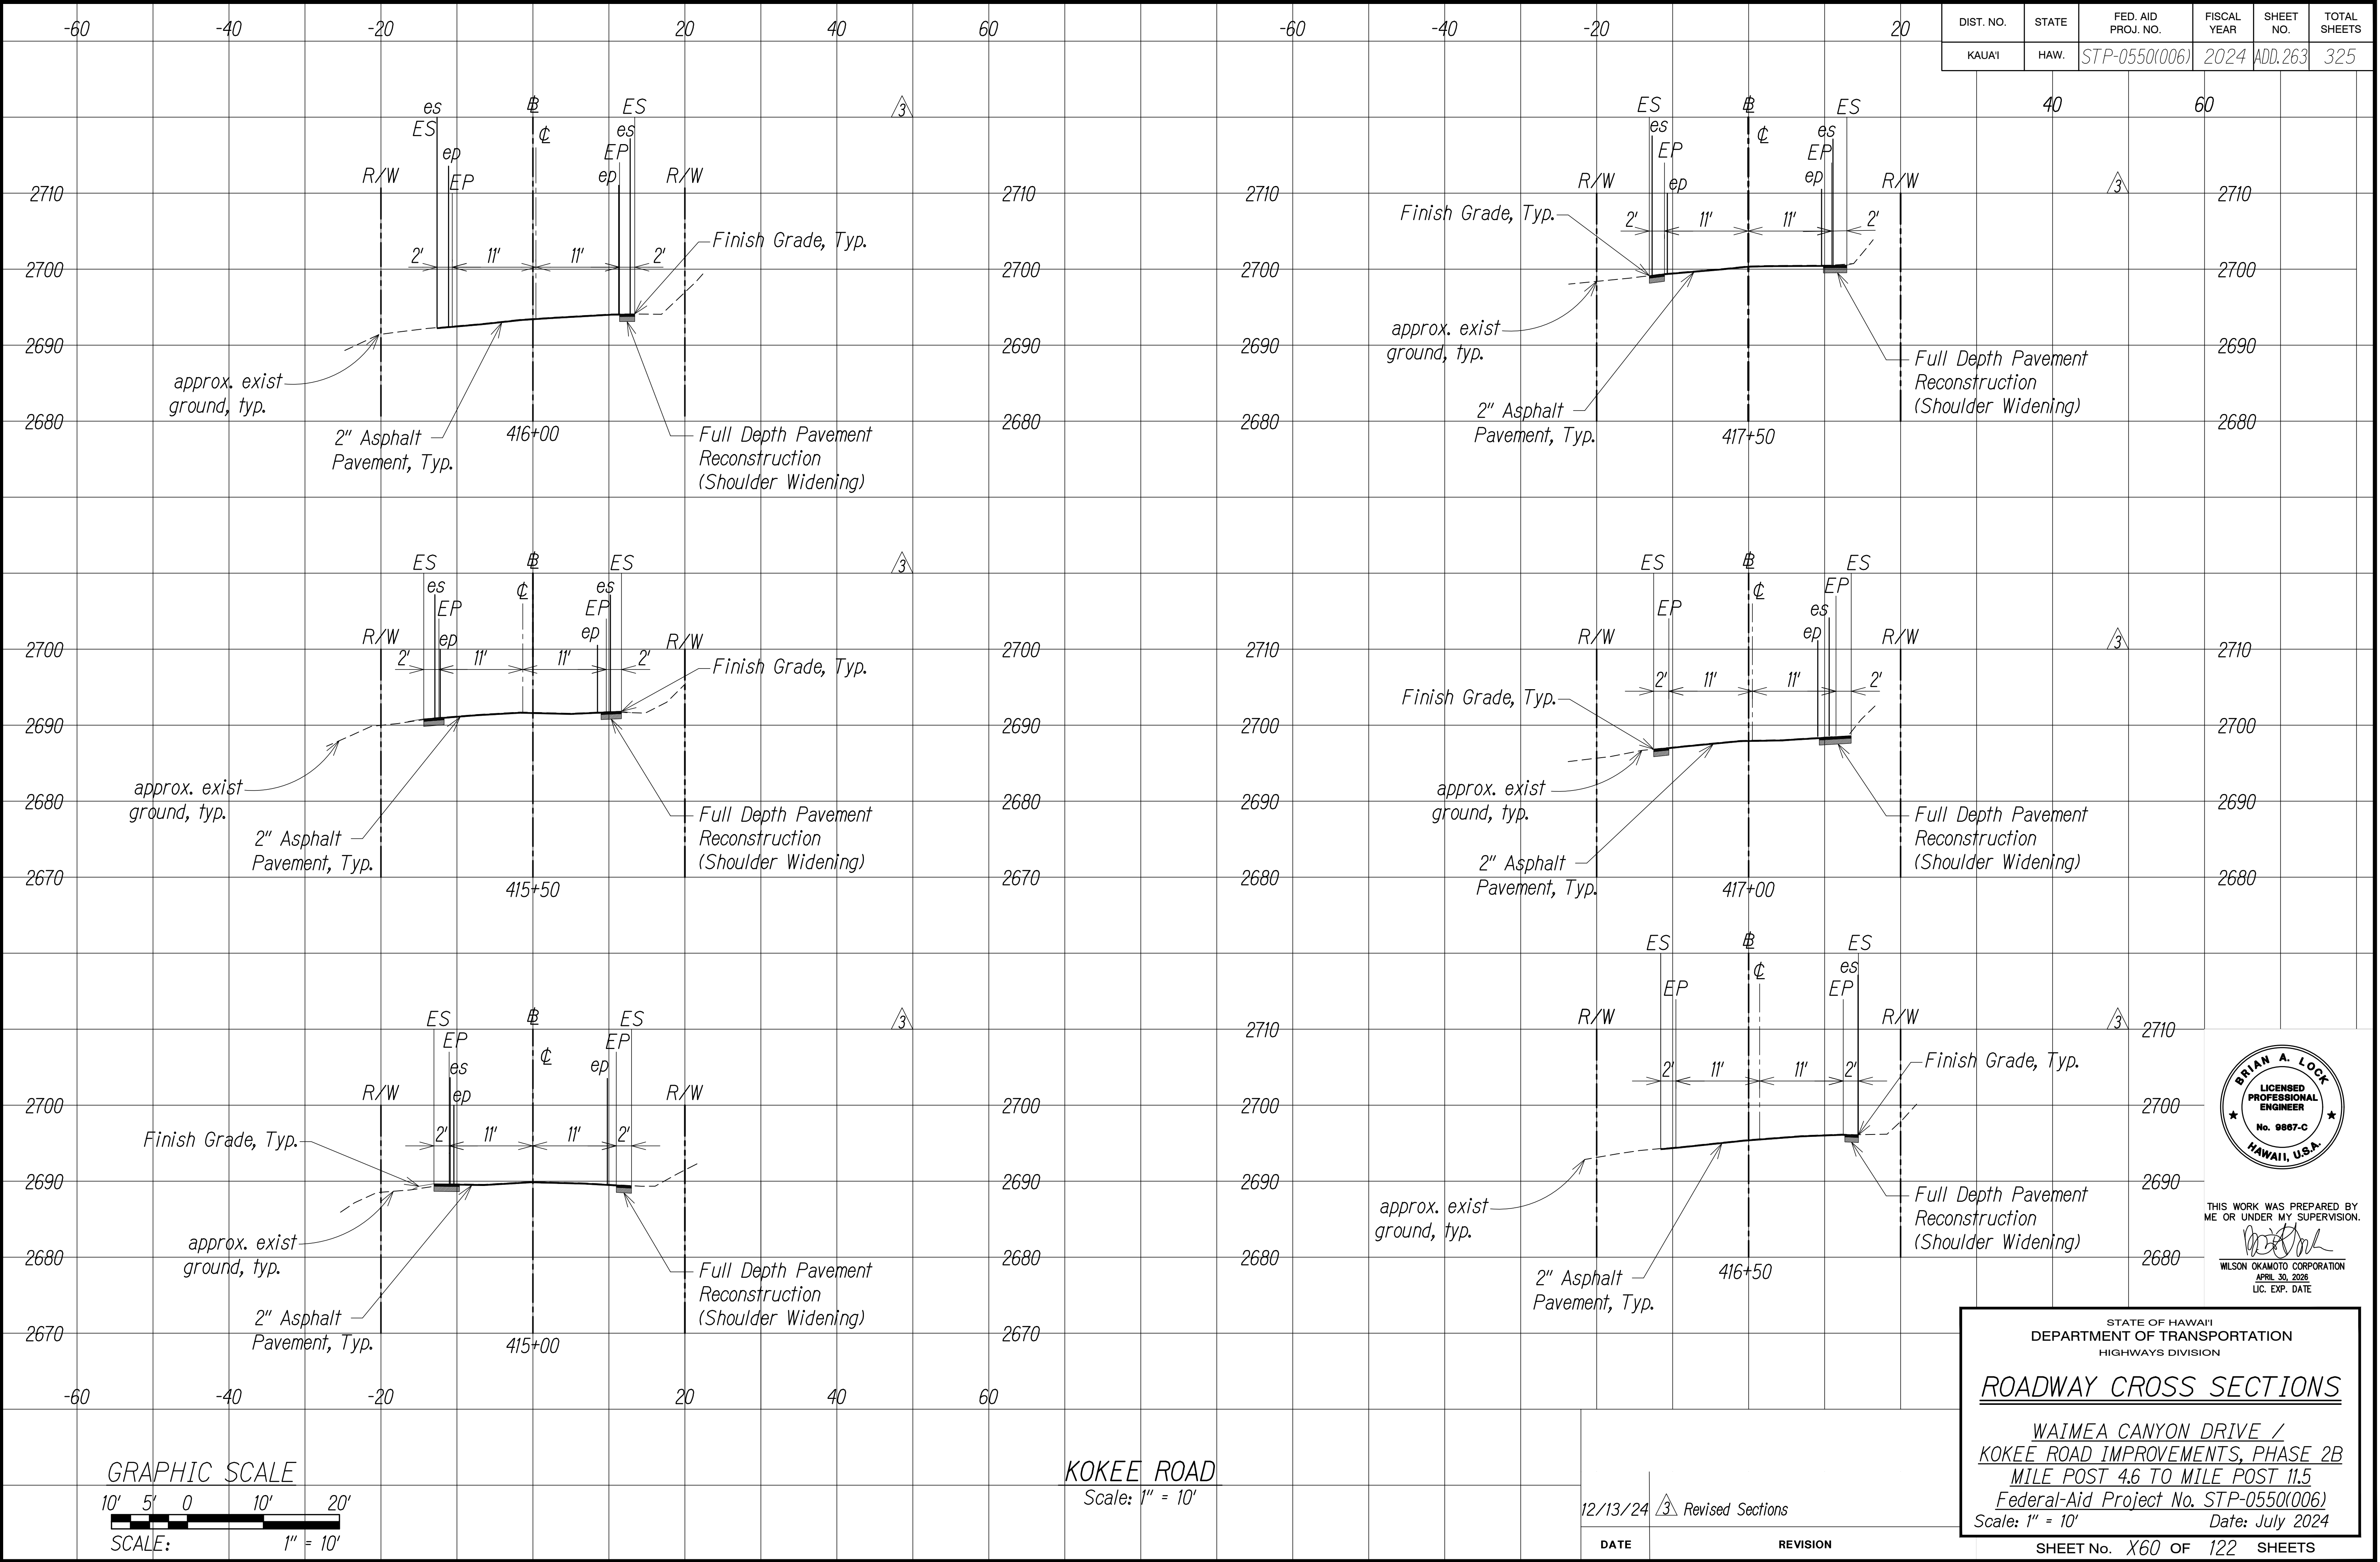

SURVEY PLOTTED BY	DATE
DESIGNED BY	
TRACED BY	
QUANTITIES BY	
CHECKED BY	

ORIGINAL PLAN	No.
NOTE BOOK	

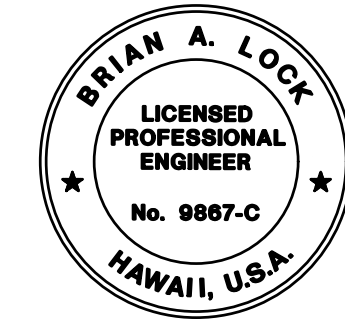

THIS WORK WAS PREPARED BY
ME OR UNDER MY SUPERVISION.
[Signature]
WILSON OKAMOTO CORPORATION
APRIL 30, 2024
LIC. EXP. DATE


STATE OF HAWAII
DEPARTMENT OF TRANSPORTATION
HIGHWAYS DIVISION
ROADWAY CROSS SECTIONS
WAIMEA CANYON DRIVE /
Kokee Road Improvements, Phase 2B
MILE POST 4.6 TO MILE POST 11.5
Federal-Aid Project No. STP-0550(006)
Scale: 1" = 10' Date: July 2024

12/13/24 3 Revised Sections

DATE	REVISION
------	----------


SHEET No. X60 OF 122 SHEETS

DIST. NO.	STATE	FED. AID PROJ. NO.	FISCAL YEAR	SHEET NO.	TOTAL SHEETS
KAUAI	HAW.	STP-0550(006)	2024	ADD.264	325

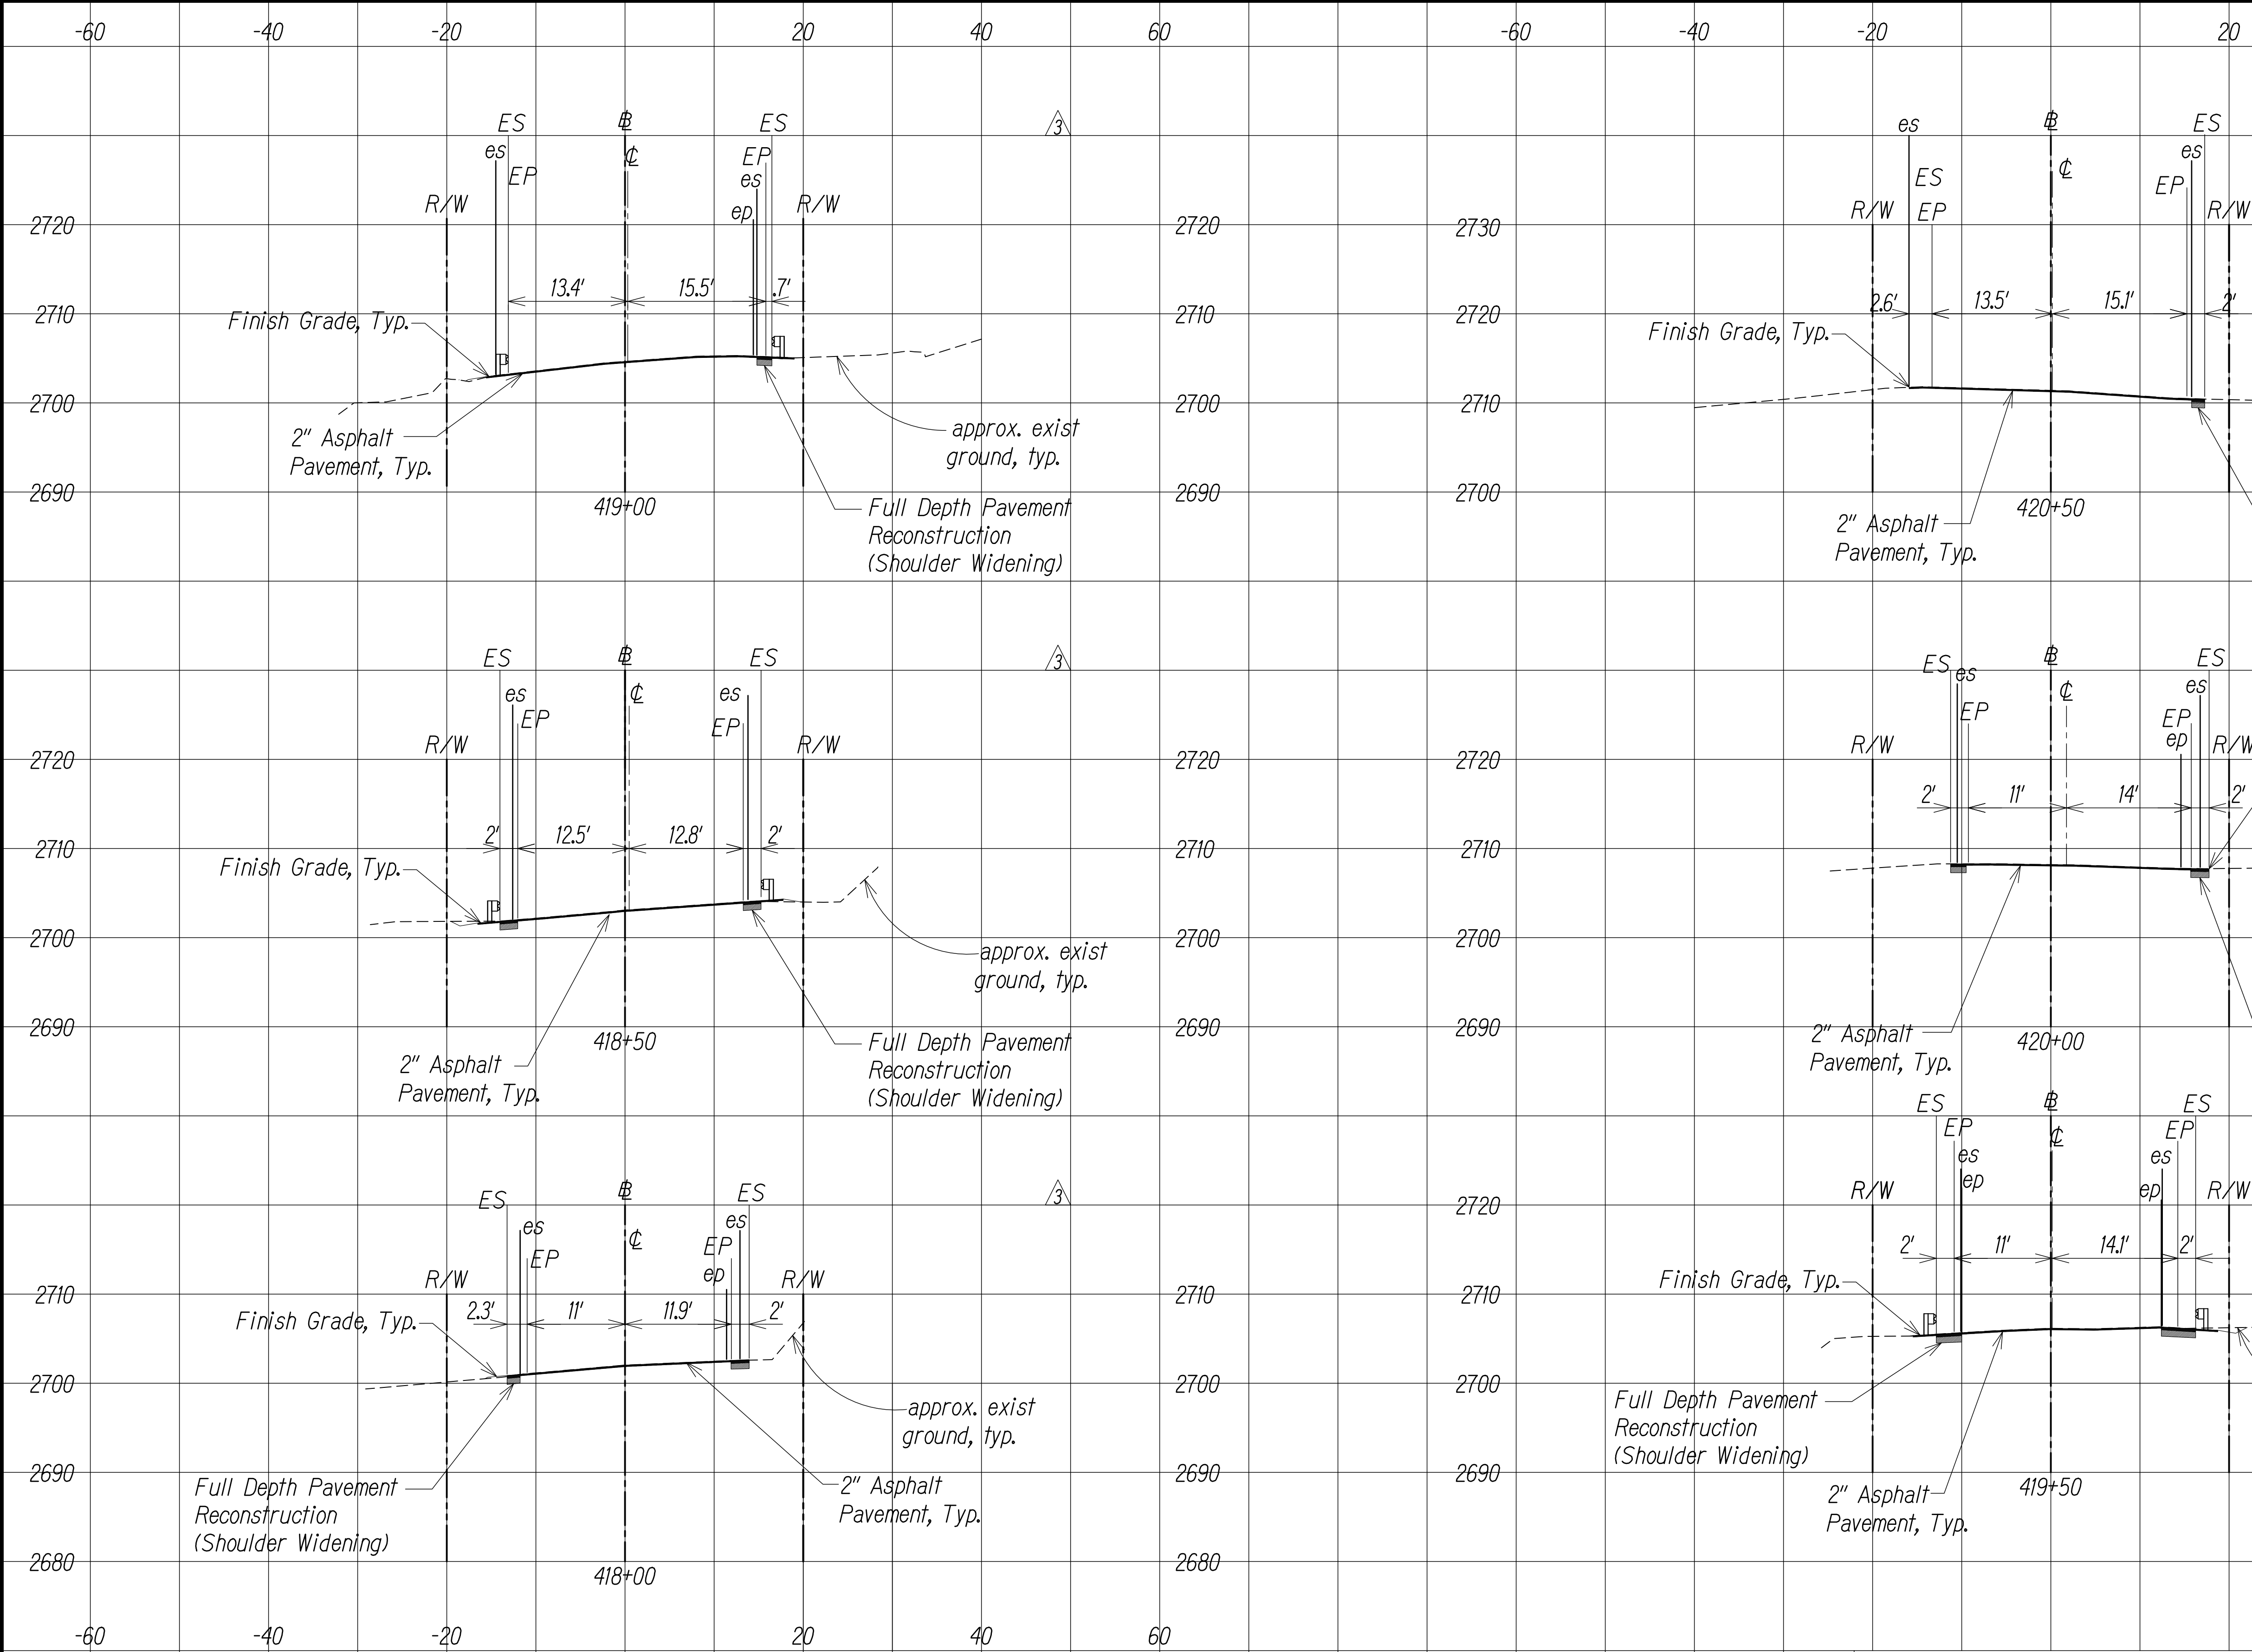

SURVEY PLOTTED BY	DATE
DESIGNED BY	
TRACED BY	
QUANTITIES BY	
CHECKED BY	


ORIGINAL PLAN	No.
NOTE BOOK	

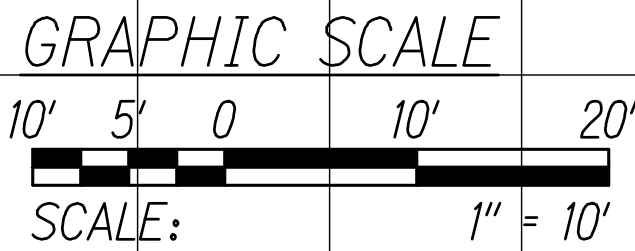

KOKEE ROAD
Scale: 1" = 10'


12/13/24 3 Revised Sections

DATE REVISION

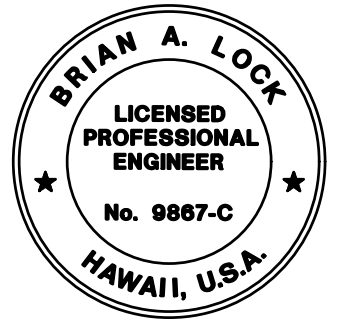


THIS WORK WAS PREPARED BY
ME OR UNDER MY SUPERVISION.
[Signature]
WILSON OKAMOTO CORPORATION
APRIL 30, 2026
LIC. EXP. DATE

STATE OF HAWAII
DEPARTMENT OF TRANSPORTATION
HIGHWAYS DIVISION
ROADWAY CROSS SECTIONS
WAIMEA CANYON DRIVE /
KOKEE ROAD IMPROVEMENTS, PHASE 2B
MILE POST 4.6 TO MILE POST 11.5
Federal-Aid Project No. STP-0550(006)
Scale: 1" = 10' Date: July 2024
SHEET No. X61 OF 122 SHEETS

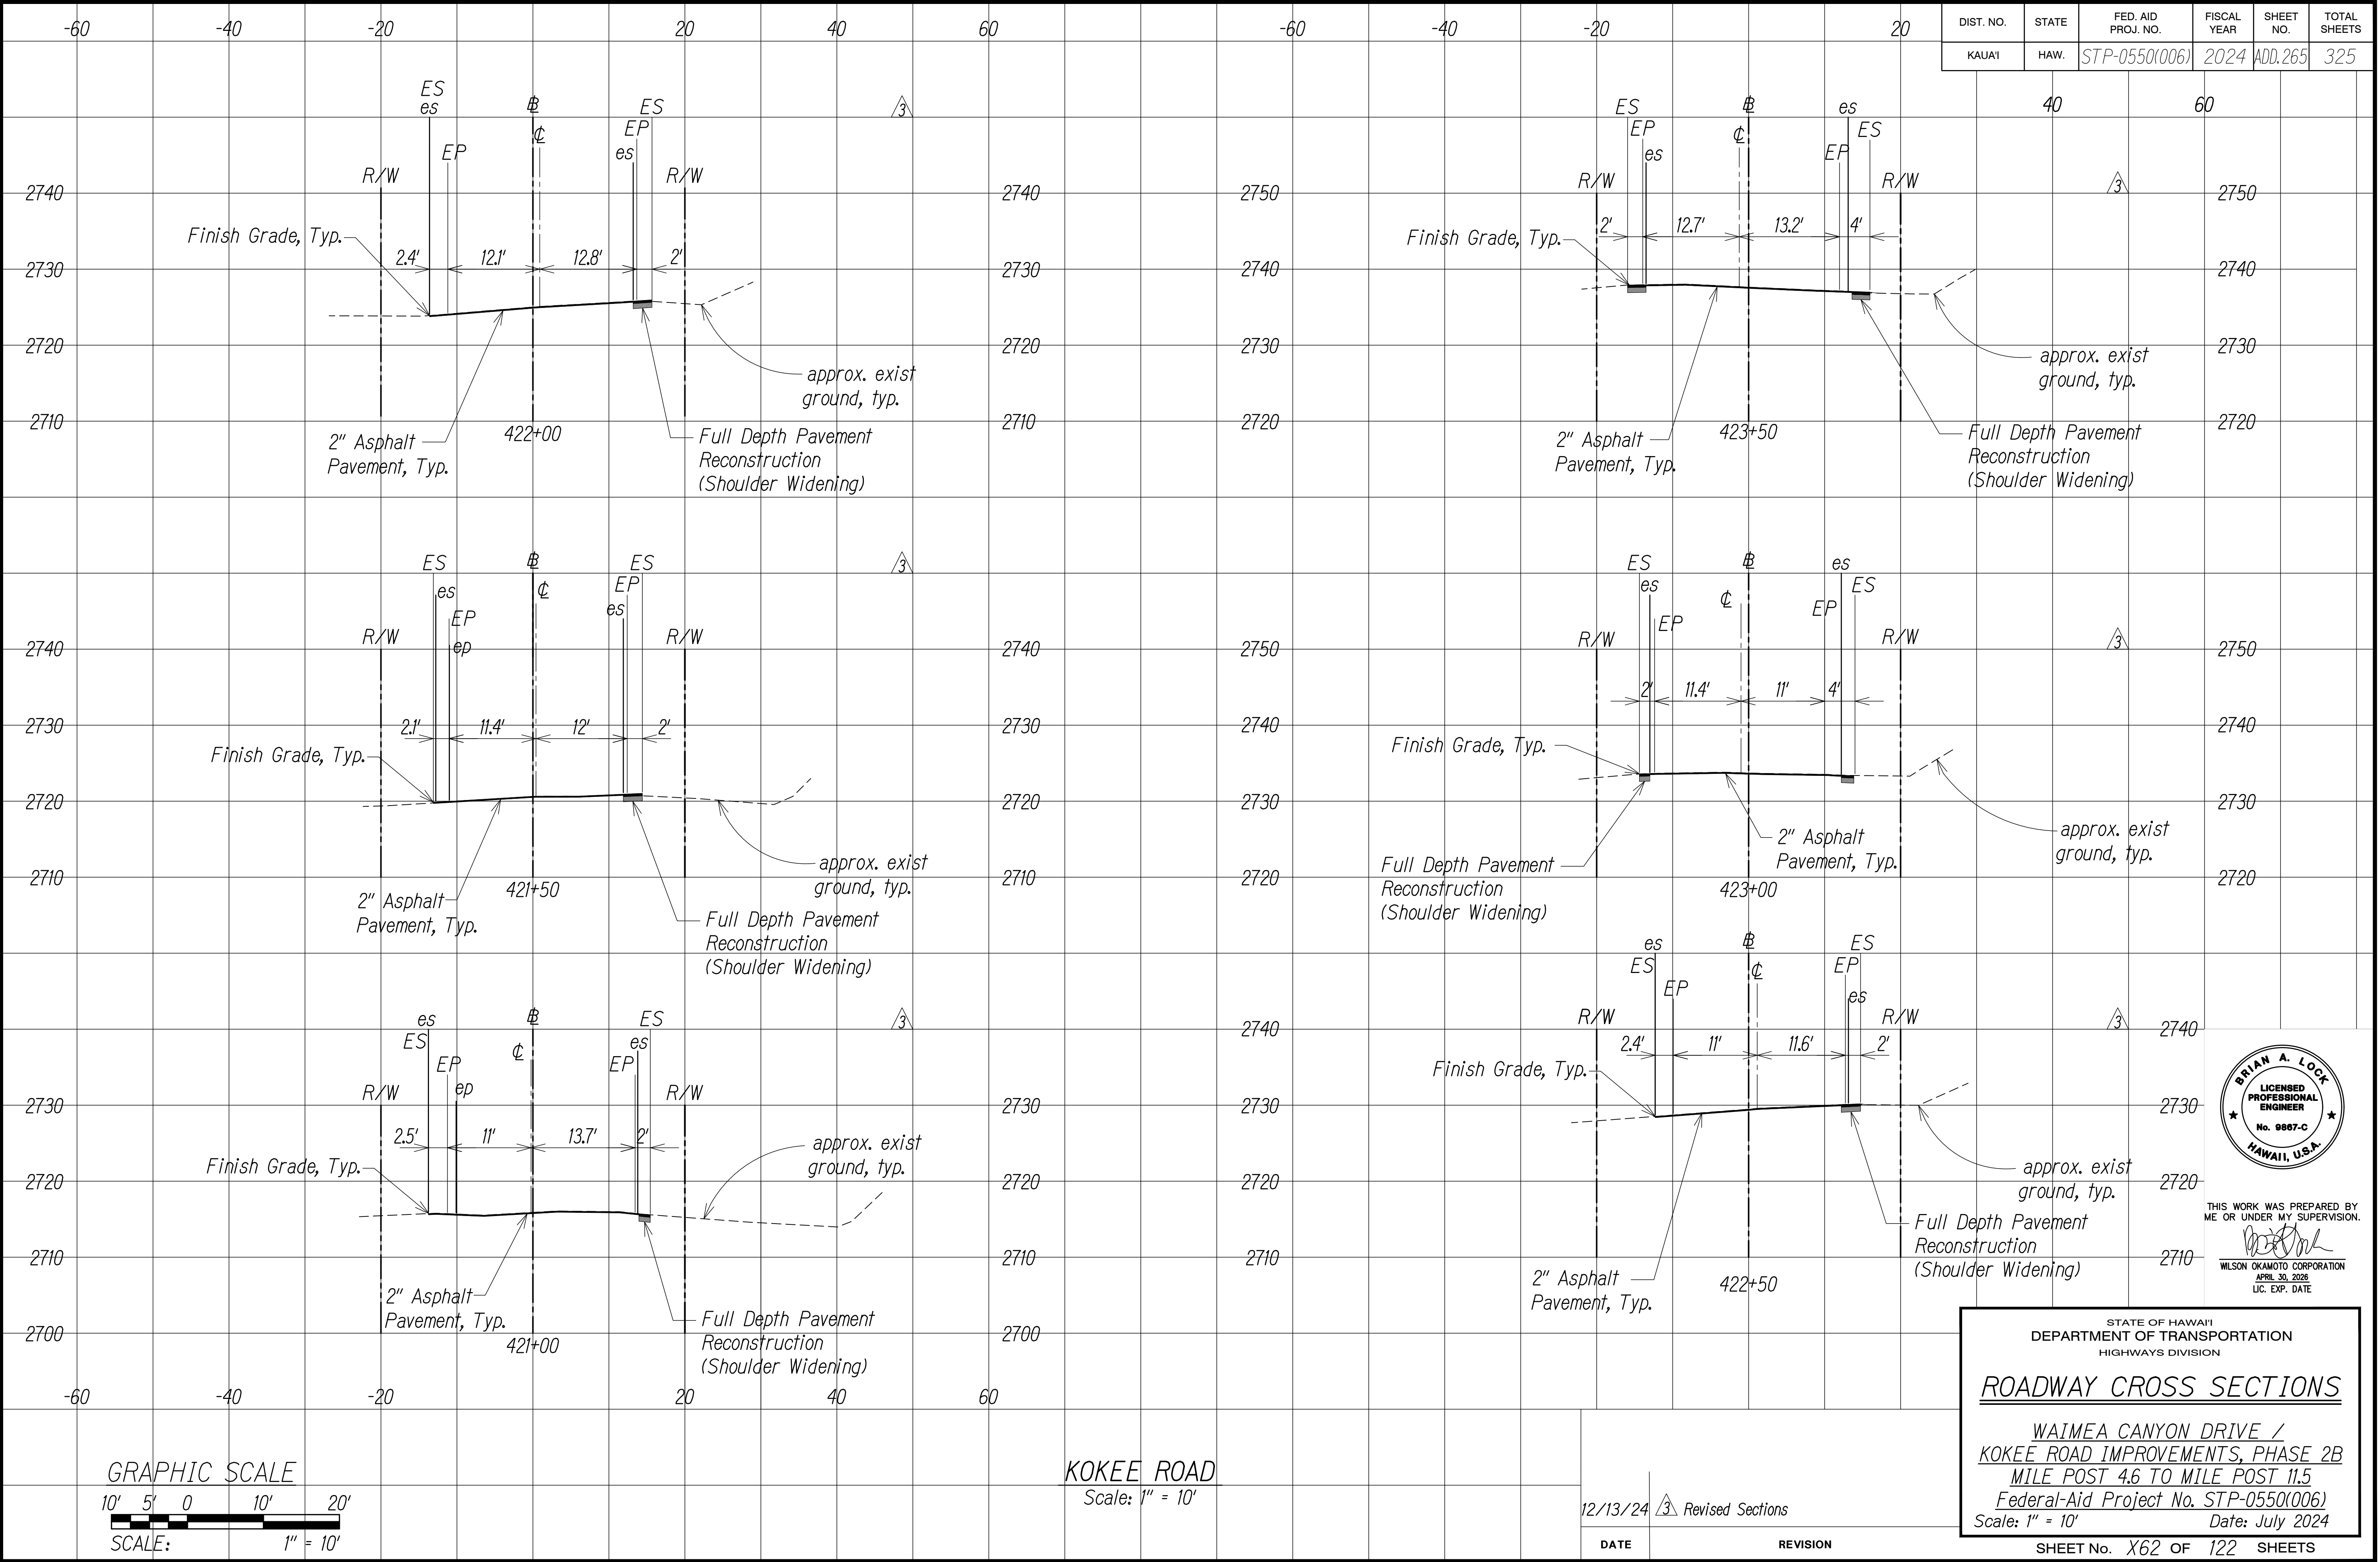

SURVEY PLOTTED BY	DATE
DESIGNED BY	
TRACED BY	
NOTED BY	
QUANTITIES BY	
CHECKED BY	

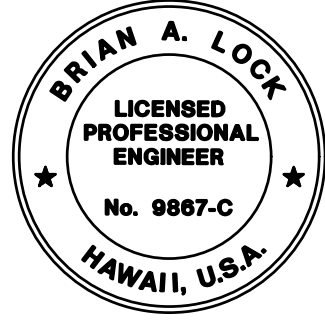

THIS WORK WAS PREPARED BY
ME OR UNDER MY SUPERVISION.
[Signature]
WILSON OKAMOTO CORPORATION
APR 30, 2026
LIC. EXP. DATE



STATE OF HAWAII
DEPARTMENT OF TRANSPORTATION
HIGHWAYS DIVISION
ROADWAY CROSS SECTIONS
WAIMEA CANYON DRIVE /
Kokee Road Improvements, Phase 2B
MILE POST 4.6 TO MILE POST 11.5
Federal-Aid Project No. STP-0550(006)
Scale: 1" = 10' Date: July 2024

12/13/24 3 Revised Sections


DATE	REVISION

SHEET No. X62 OF 122 SHEETS

DIST. NO.	STATE	FED. AID PROJ. NO.	FISCAL YEAR	SHEET NO.	TOTAL SHEETS
KAUAI	HAW.	STP-0550(006)	2024	ADD.266	325

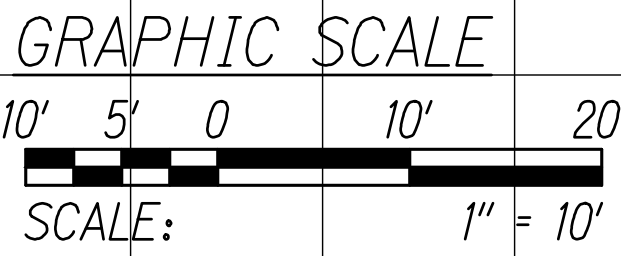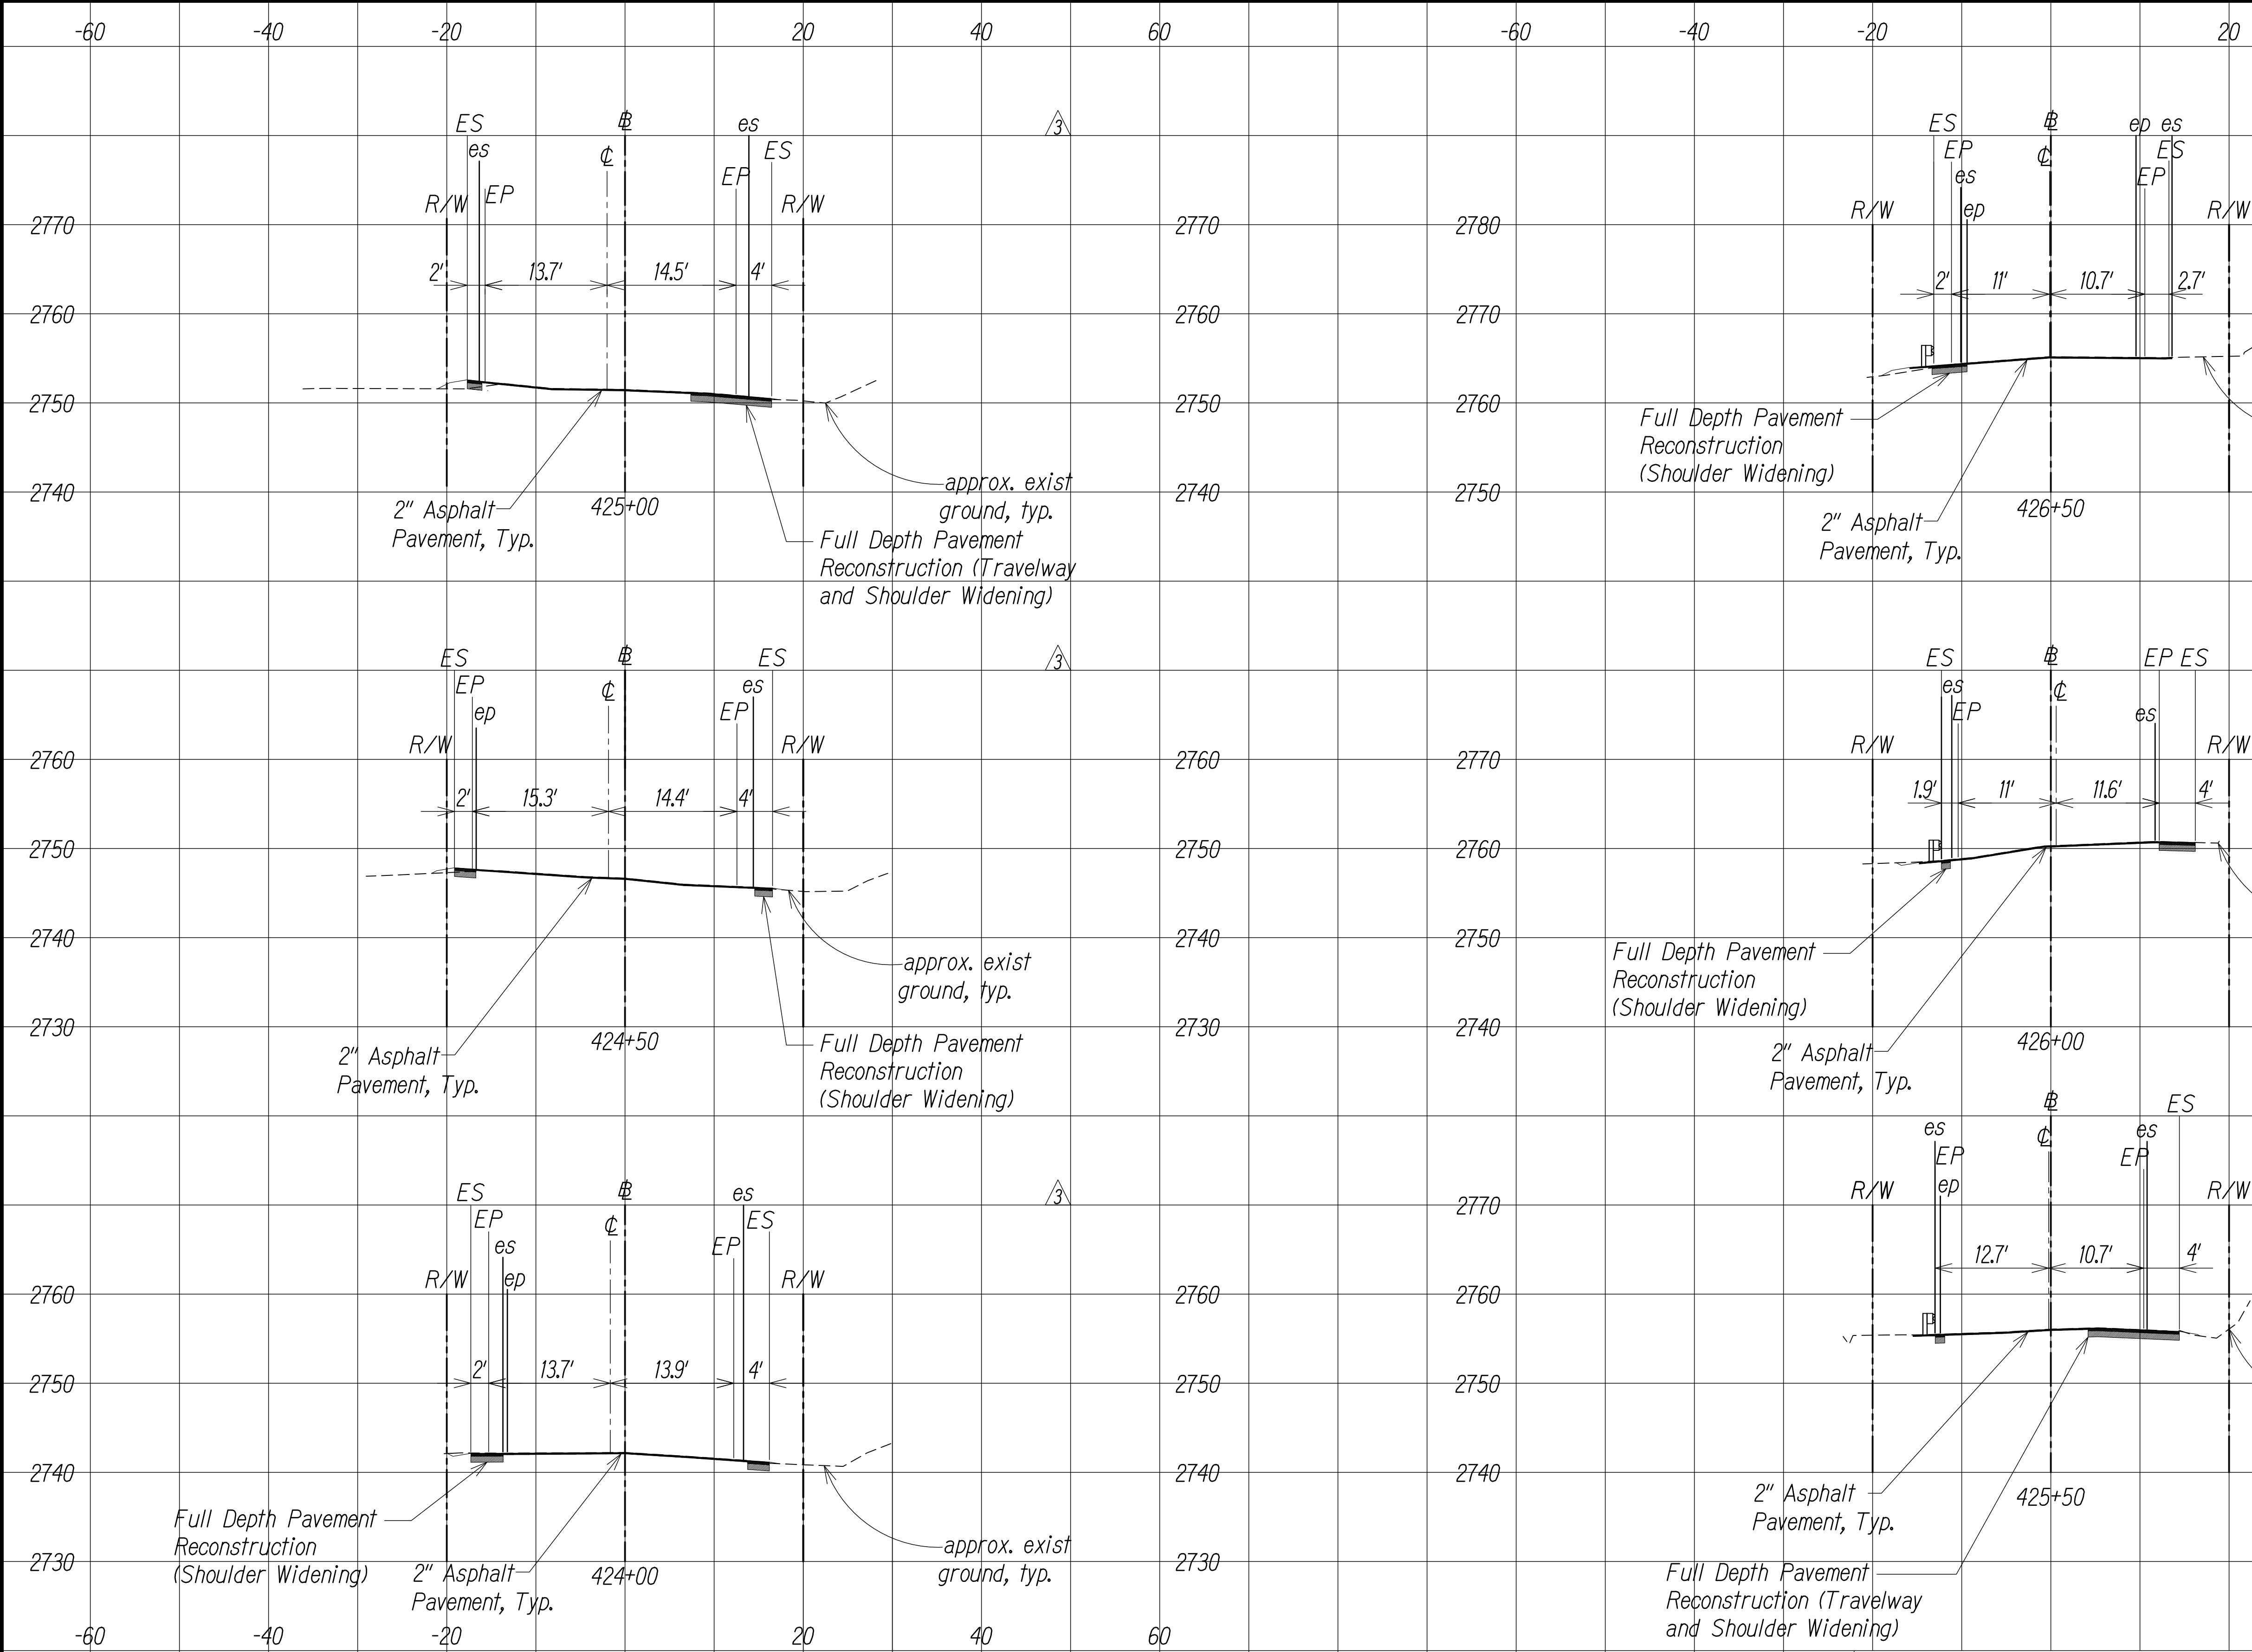

KOKEE ROAD
Scale: 1" = 10'

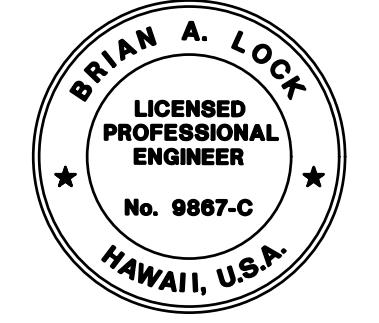


THIS WORK WAS PREPARED BY
ME OR UNDER MY SUPERVISION.
[Signature]
WILSON OKAMOTO CORPORATION
APRIL 30, 2026
LIC. EXP. DATE

STATE OF HAWAII
DEPARTMENT OF TRANSPORTATION
HIGHWAYS DIVISION
ROADWAY CROSS SECTIONS
WAIMEA CANYON DRIVE /
KOKEE ROAD IMPROVEMENTS, PHASE 2B
MILE POST 4.6 TO MILE POST 11.5
Federal-Aid Project No. STP-0550(006)
Scale: 1" = 10' Date: July 2024

12/13/24 3 Revised Sections

DATE	REVISION
------	----------


SHEET No. X63 OF 122 SHEETS

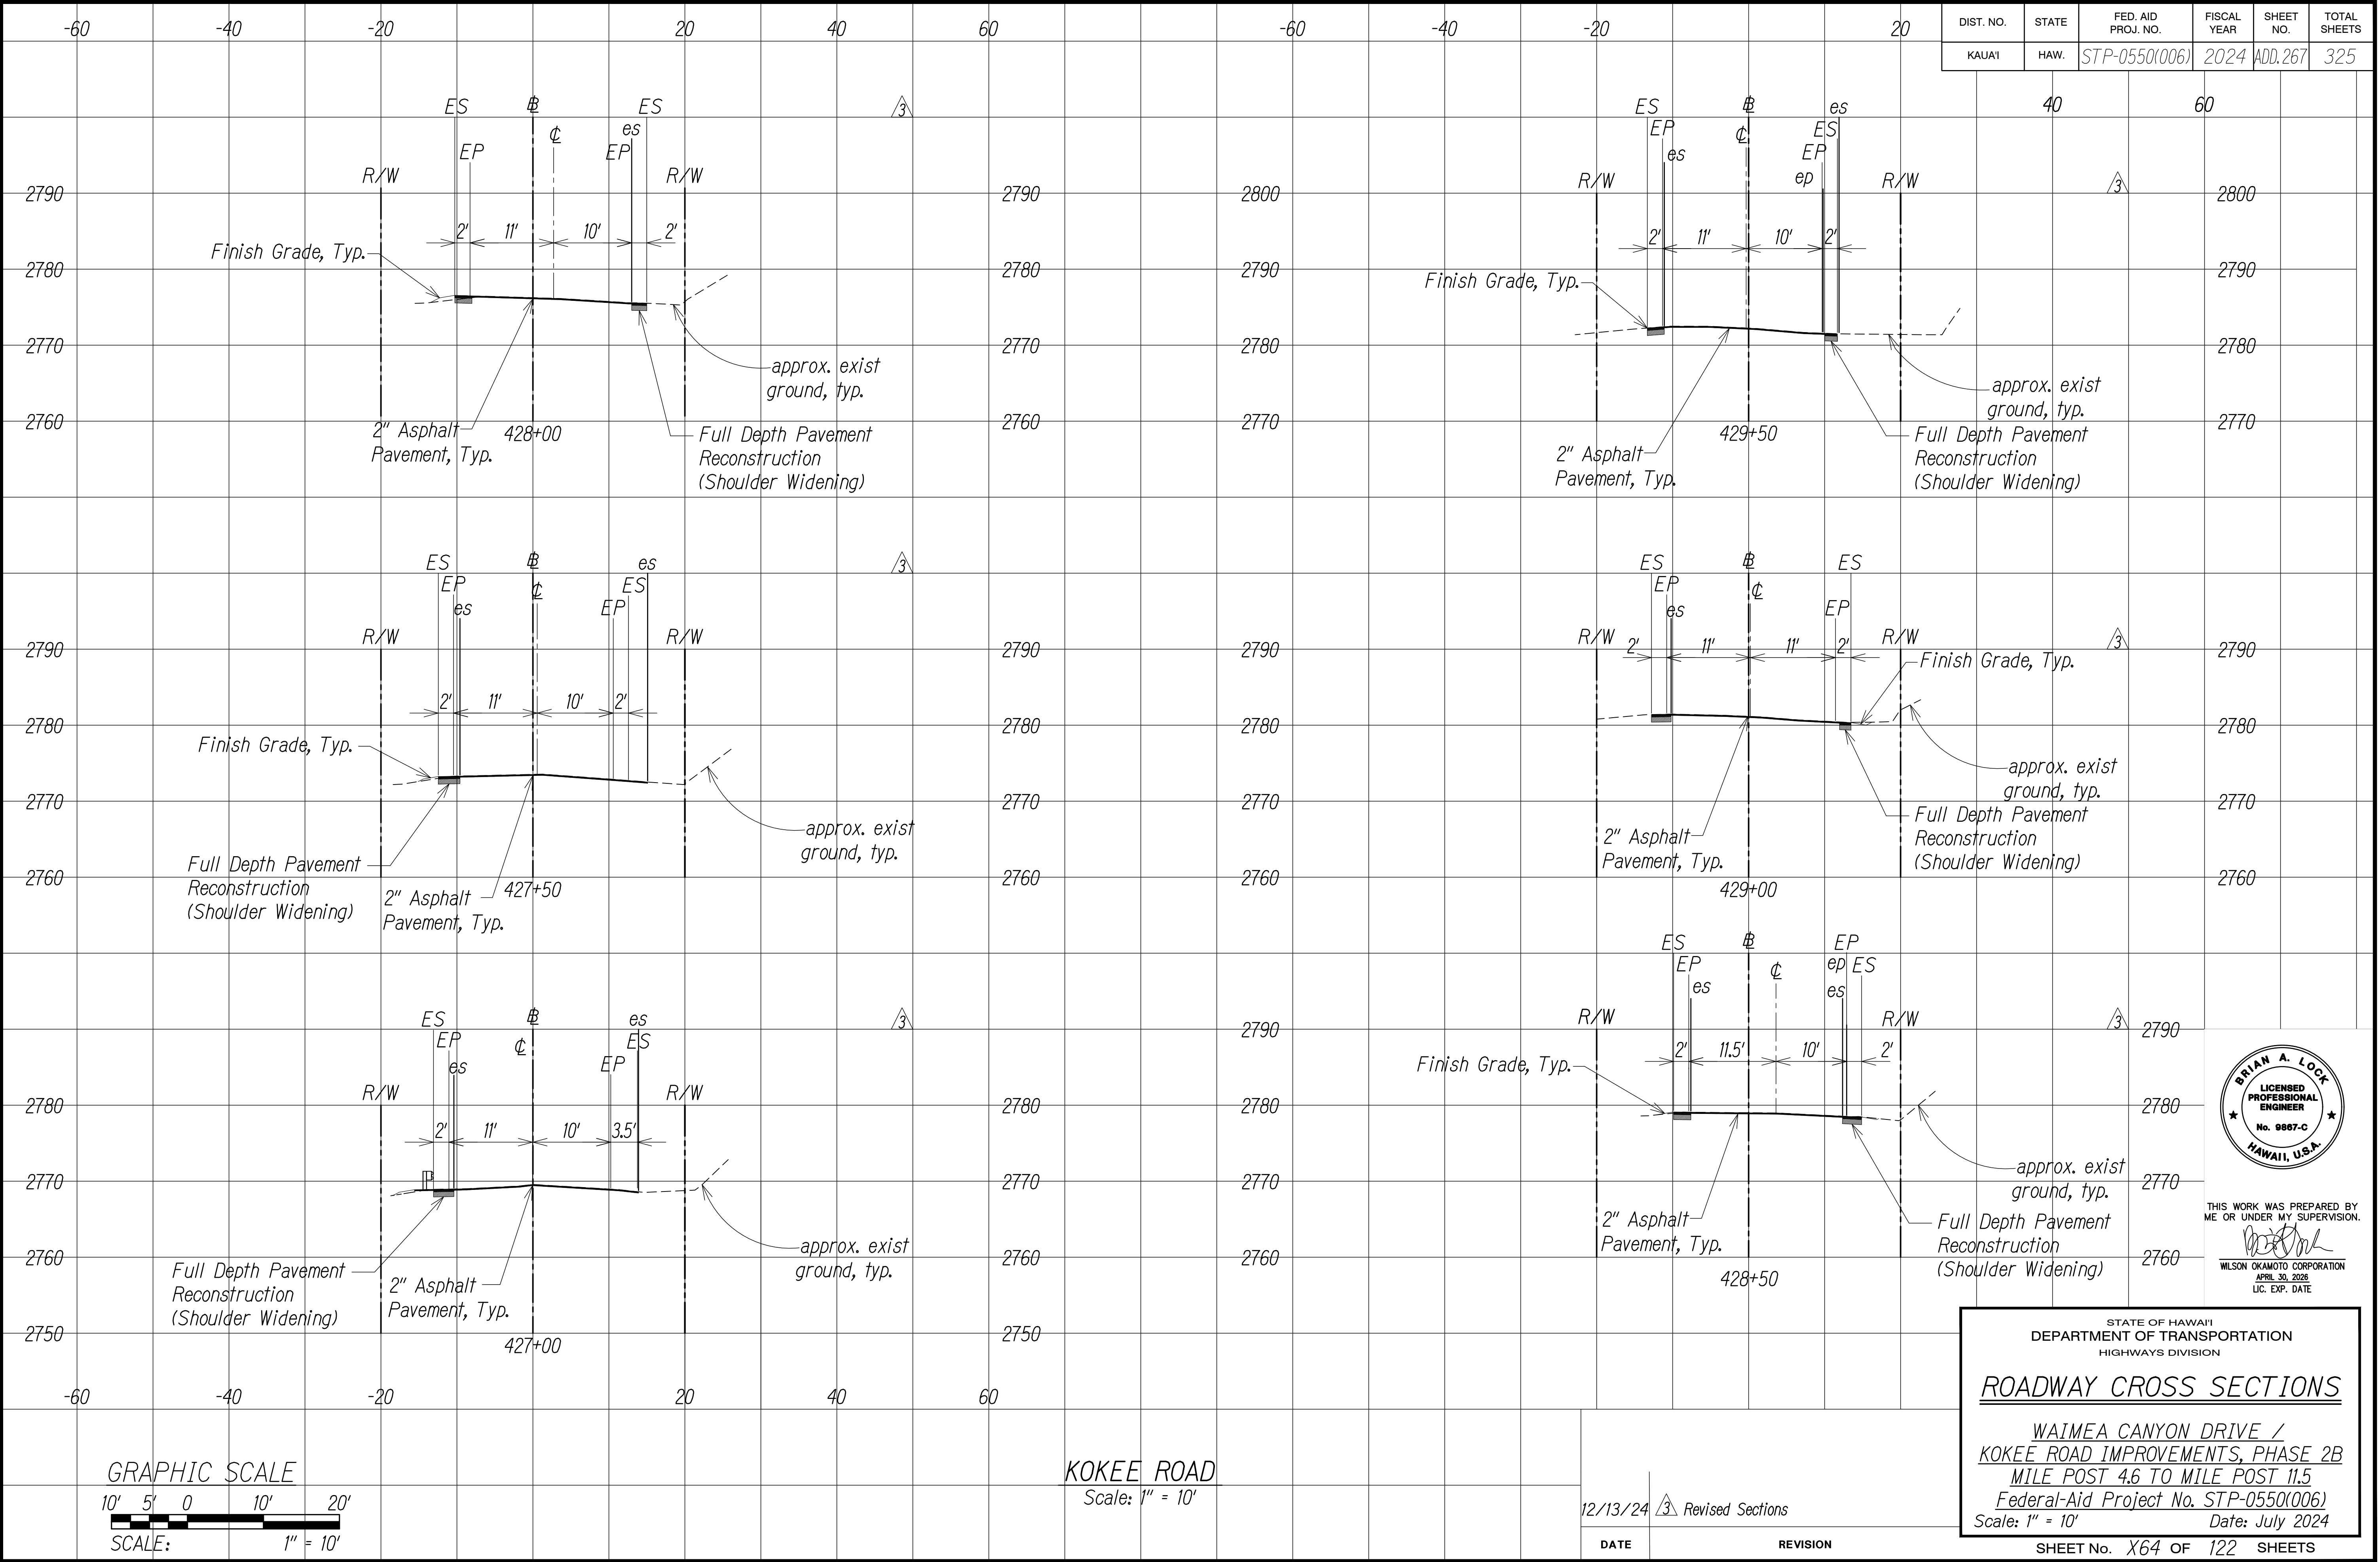

DIST. NO.	STATE	FED. AID PROJ. NO.	FISCAL YEAR	SHEET NO.	TOTAL SHEETS
KAUAI	HAW.	STP-0550(006)	2024	ADD.267	325

SURVEY PLOTTED BY	DATE
DESIGNED BY	
TRACED BY	
QUANTITIES BY	
CHECKED BY	

ORIGINAL PLAN	No.
NOTE BOOK	

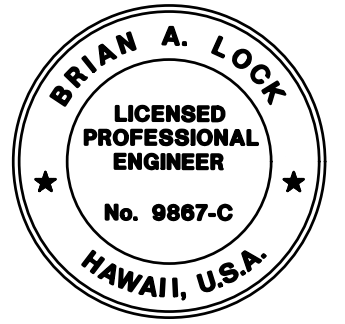

THIS WORK WAS PREPARED BY ME OR UNDER MY SUPERVISION.
[Signature]
WILSON OKAMOTO CORPORATION
APRIL 30, 2026
LIC. EXP. DATE

STATE OF HAWAII
DEPARTMENT OF TRANSPORTATION
HIGHWAYS DIVISION


ROADWAY CROSS SECTIONS

WAIMEA CANYON DRIVE /
KOEKE ROAD IMPROVEMENTS, PHASE 2B
MILE POST 4.6 TO MILE POST 11.5
Federal-Aid Project No. STP-0550(006)
Scale: 1" = 10' Date: July 2024

DATE: 12/13/24 REVISION: 3 Revised Sections


SHEET No. X64 OF 122 SHEETS

DIST. NO.	STATE	FED. AID PROJ. NO.	FISCAL YEAR	SHEET NO.	TOTAL SHEETS
KAUAI	HAW.	STP-0550(006)	2024	ADD.268	325

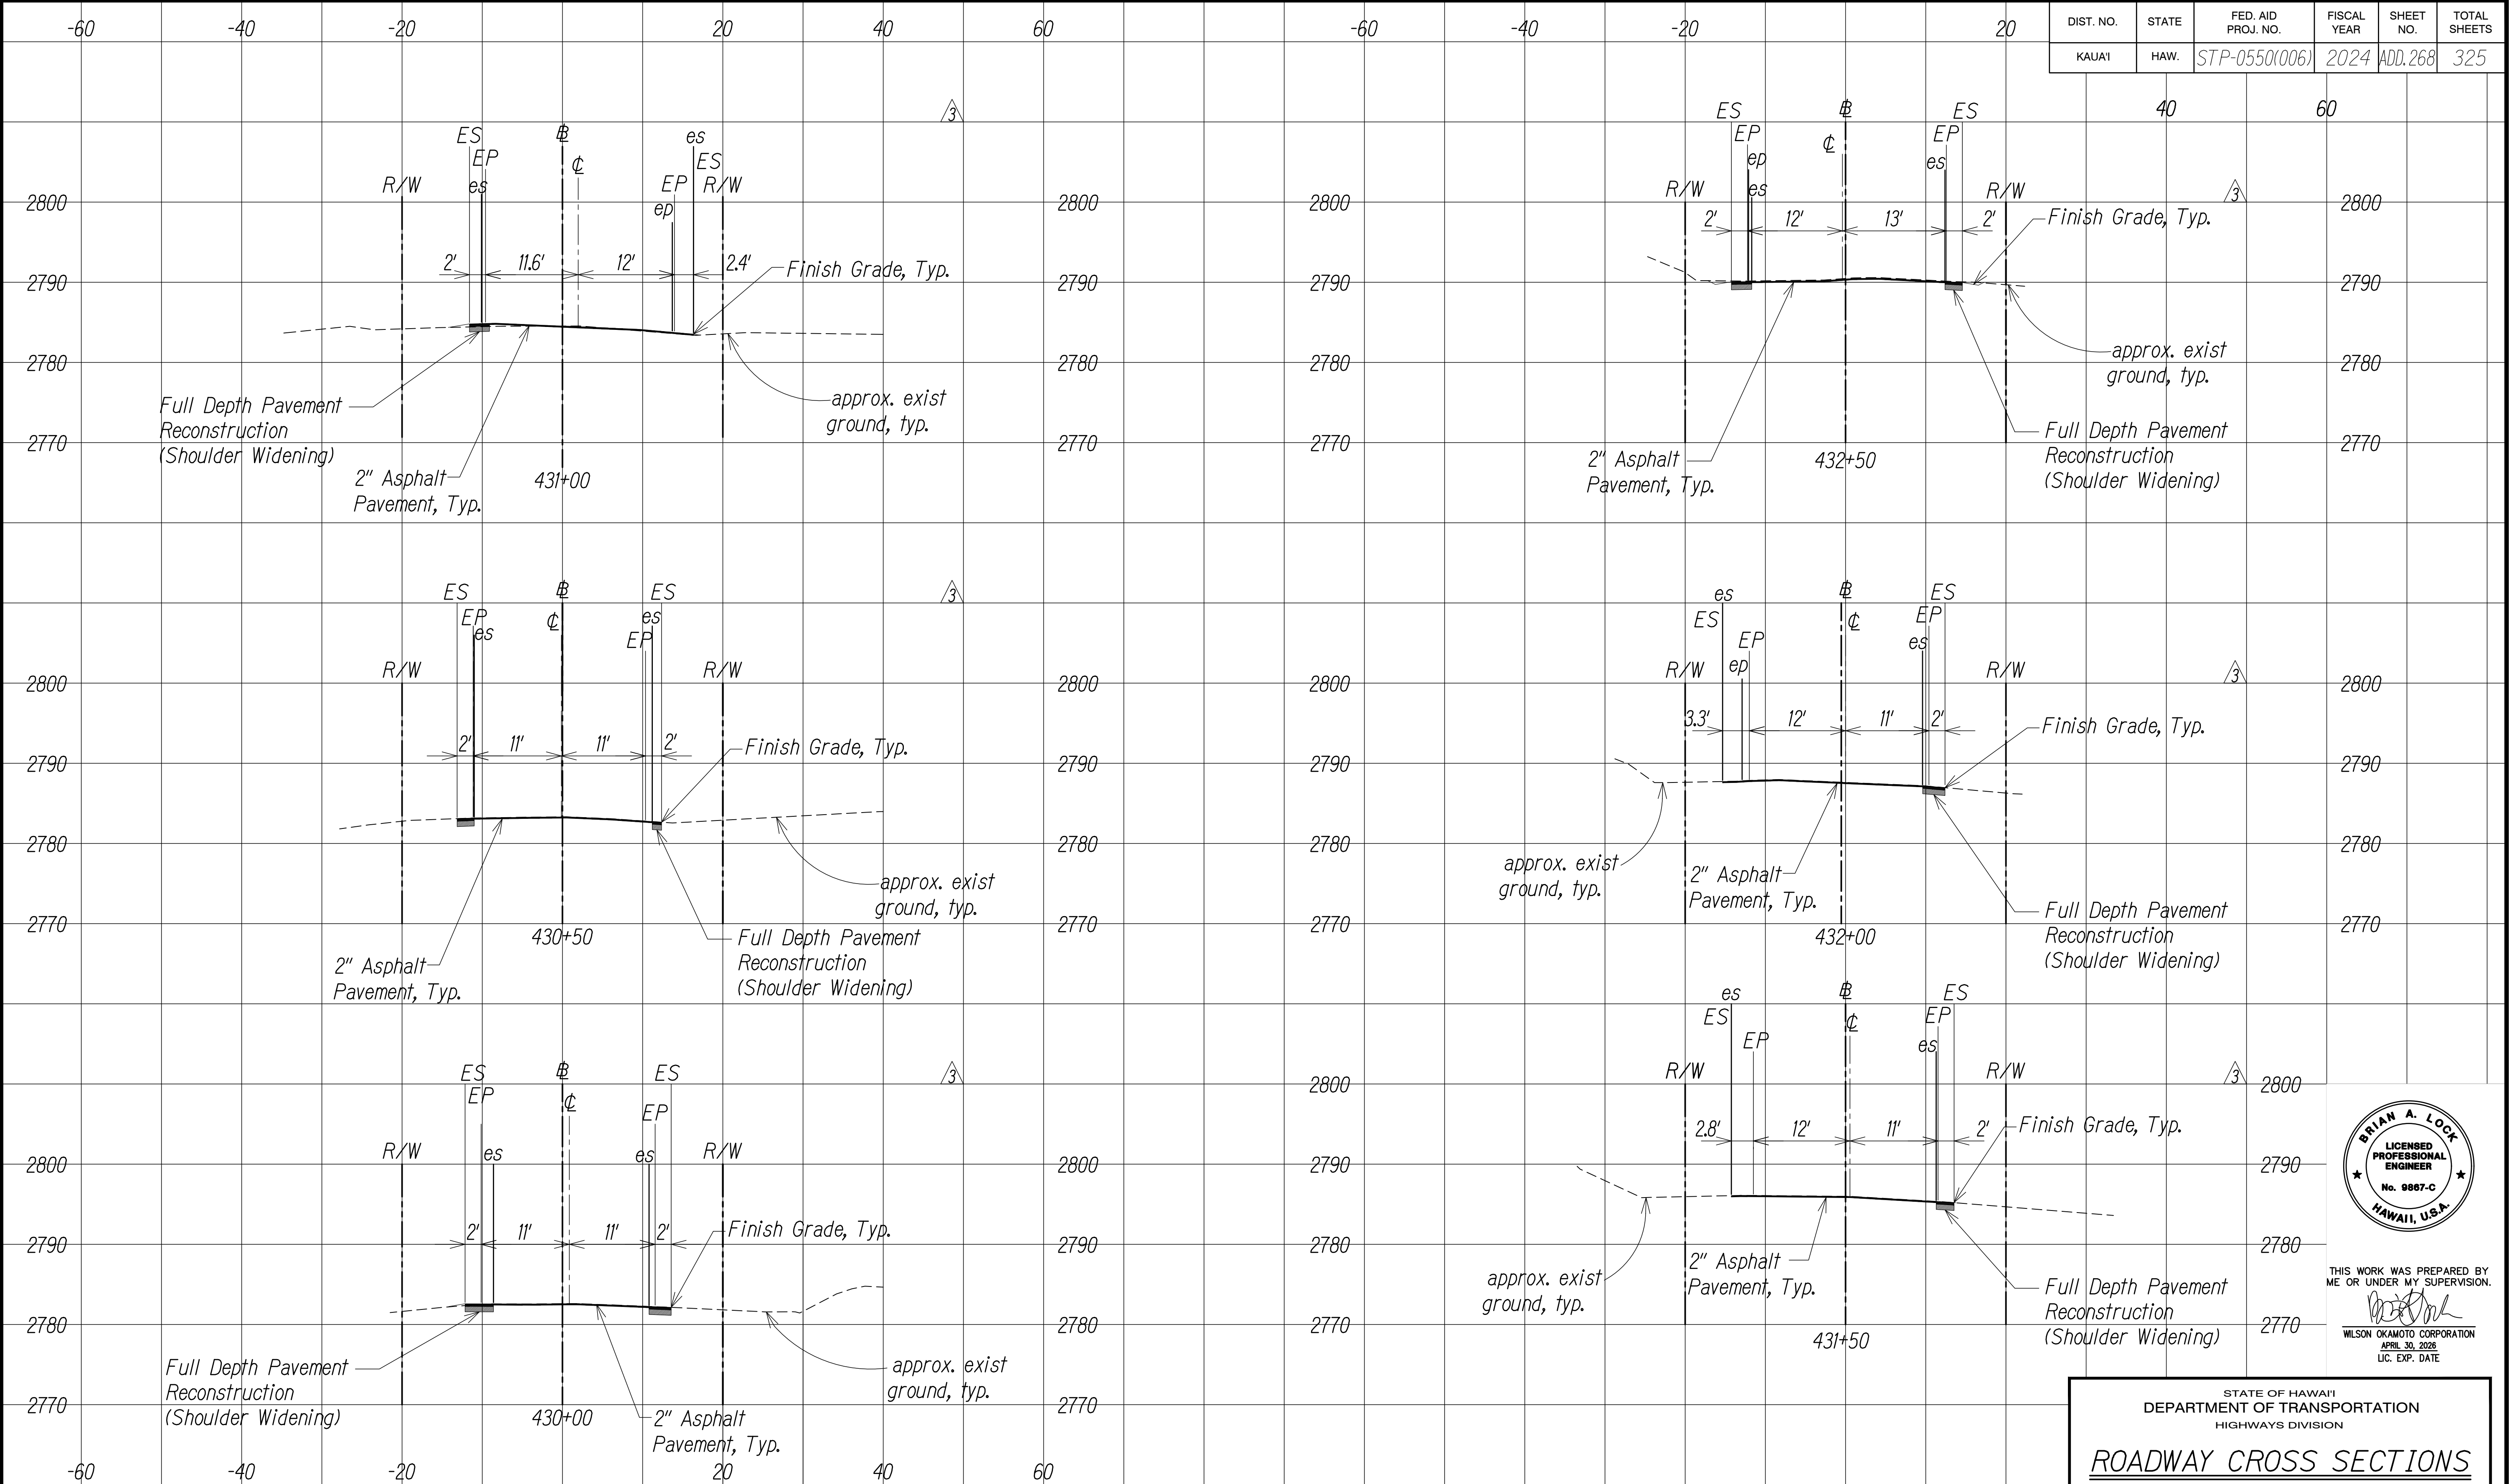

SURVEY PLOTTED BY	DATE
DESIGNED BY	
TRACED BY	
QUANTITIES BY	
CHECKED BY	

ORIGINAL PLAN	No.
NOTE BOOK	

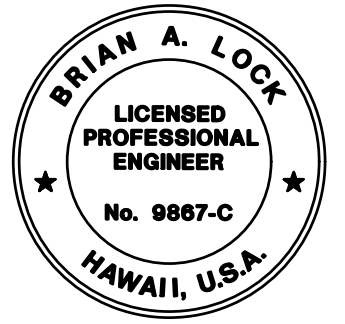

THIS WORK WAS PREPARED BY ME OR UNDER MY SUPERVISION.
[Signature]
WILSON OKAMOTO CORPORATION
APRIL 30, 2026
LIC. EXP. DATE


STATE OF HAWAII
DEPARTMENT OF TRANSPORTATION
HIGHWAYS DIVISION
ROADWAY CROSS SECTIONS
WAIMEA CANYON DRIVE /
KOEKEE ROAD IMPROVEMENTS, PHASE 2B
MILE POST 4.6 TO MILE POST 11.5
Federal-Aid Project No. STP-0550(006)
Scale: 1" = 10' Date: July 2024

12/13/24 3 Revised Sections

DATE	REVISION
------	----------


SHEET No. X65 OF 122 SHEETS

ADD268

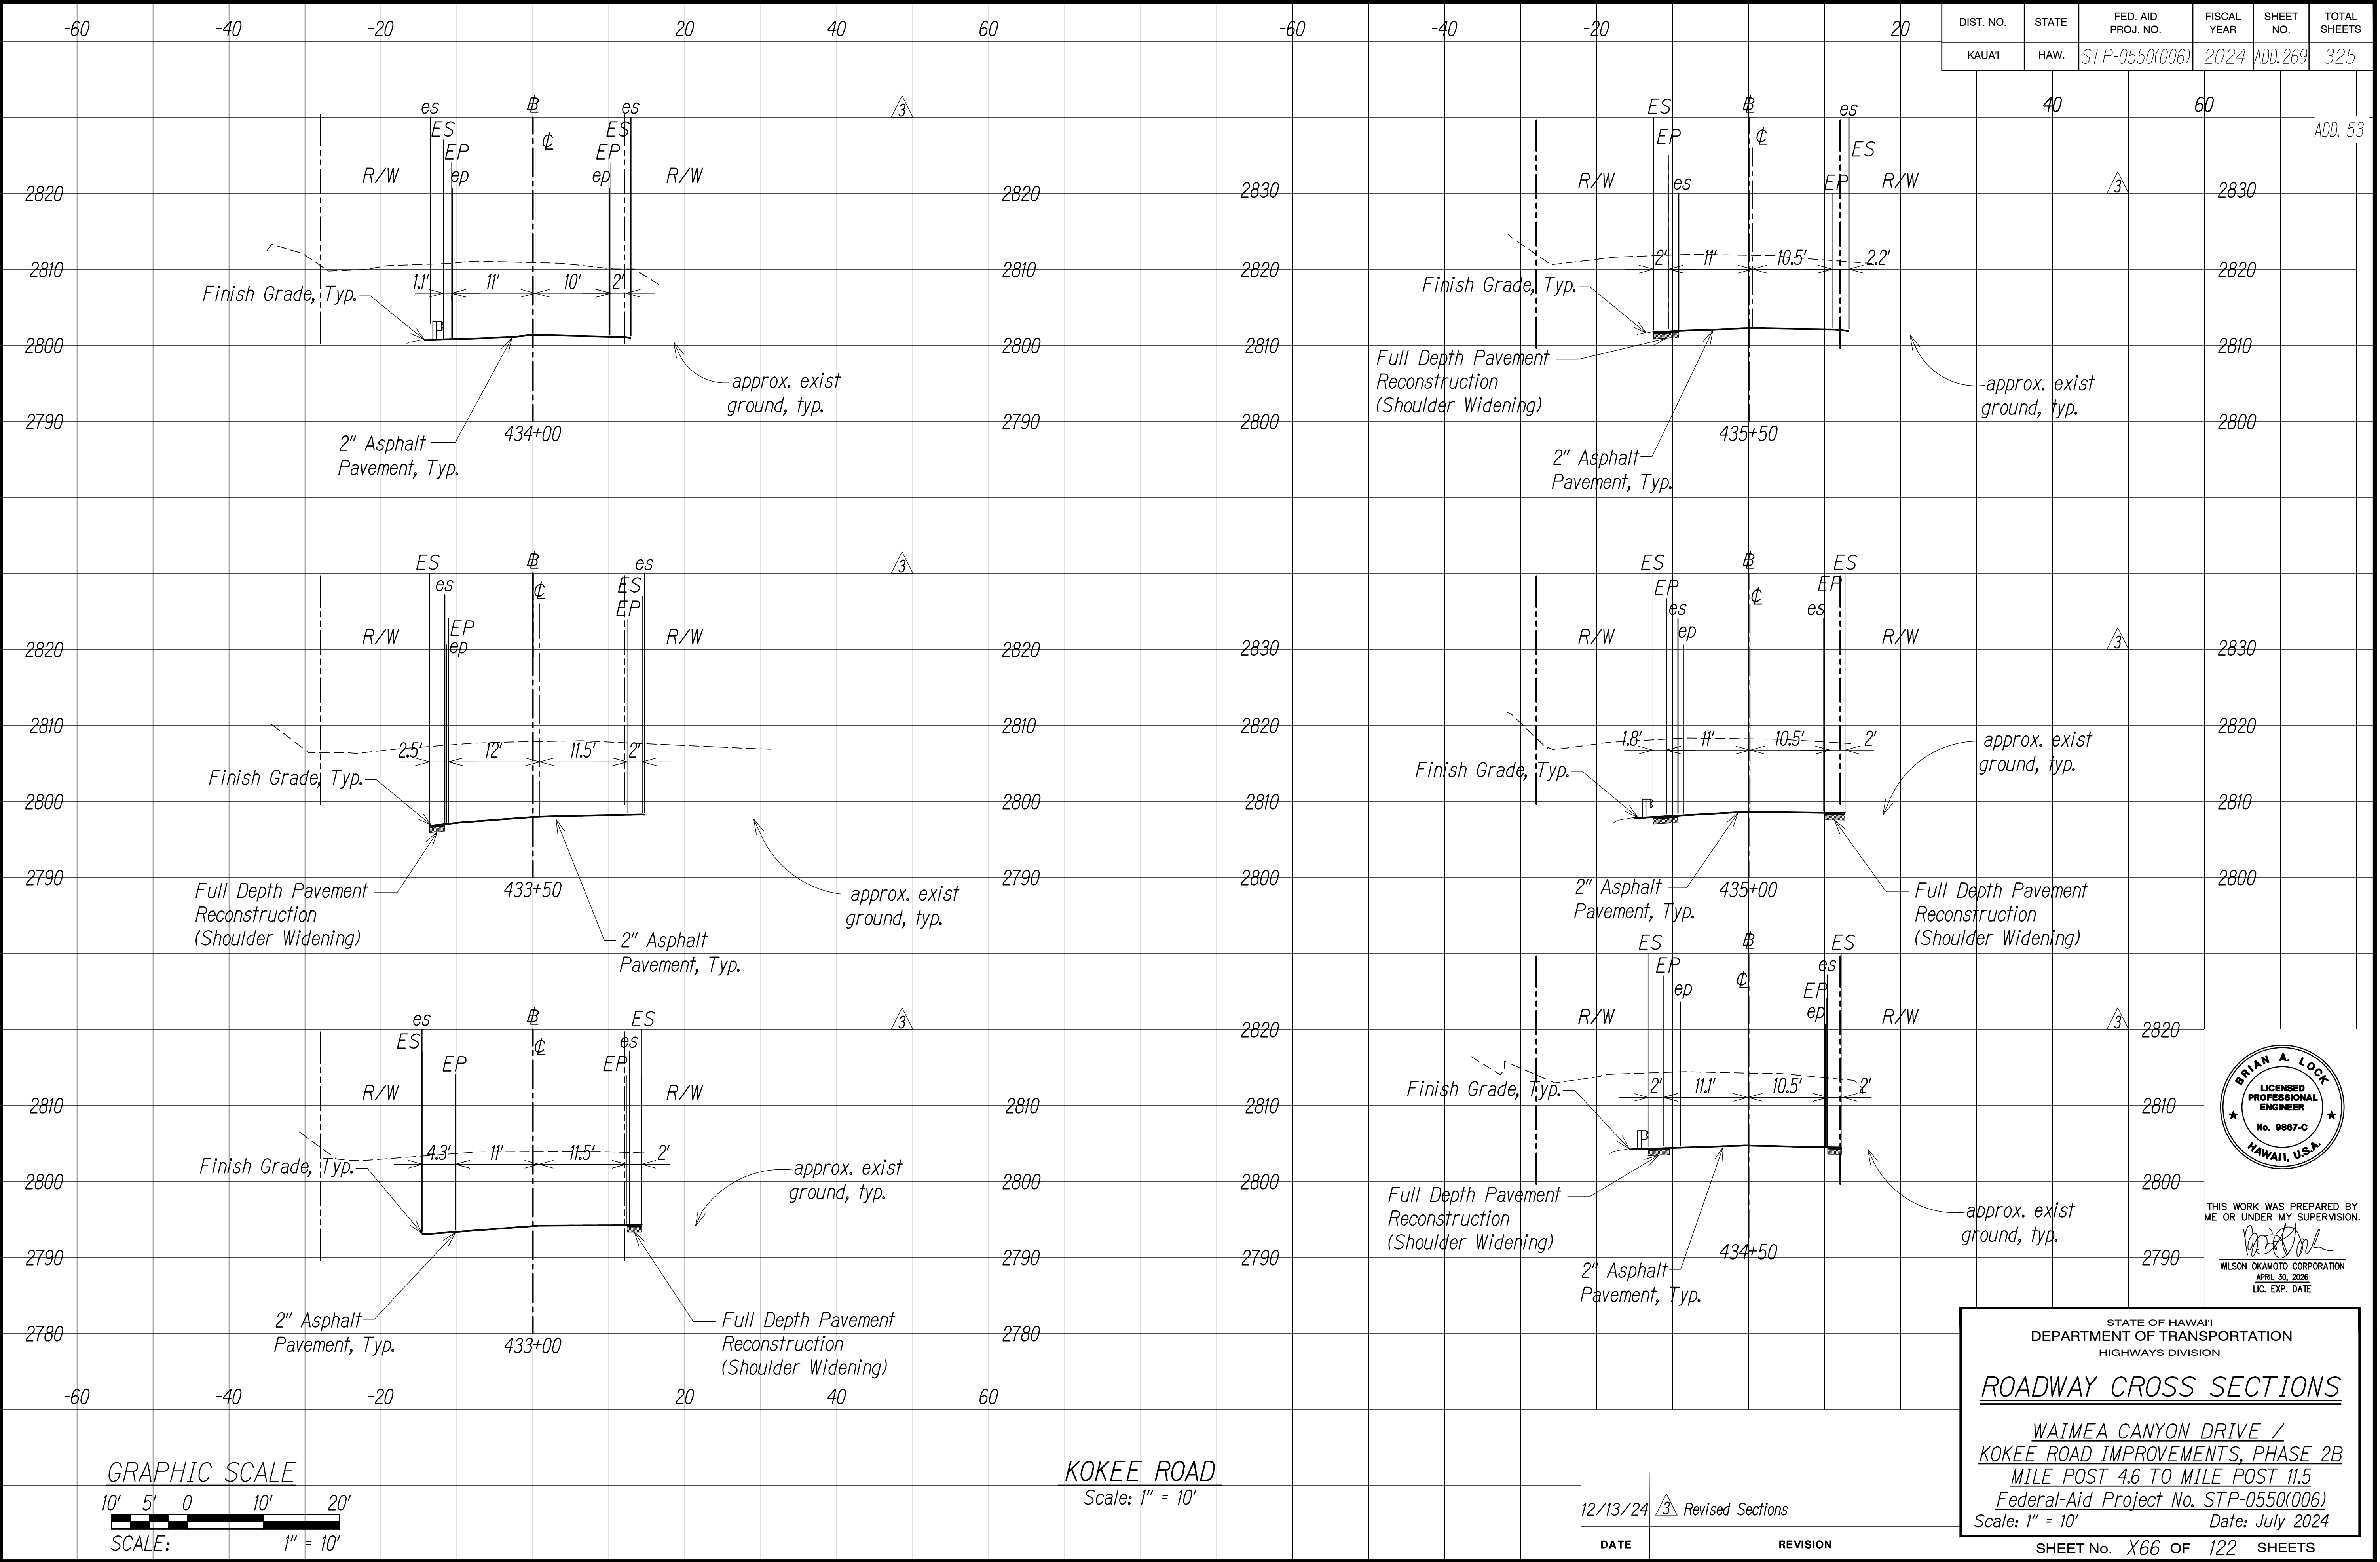


DIST. NO.	STATE	FED. AID PROJ. NO.	FISCAL YEAR	SHEET NO.	TOTAL SHEETS
KAUAI	HAW.	STP-0550(006)	2024	ADD.269	325

SURVEY PLOTTED BY	DATE
DESIGNED BY	
TRACED BY	
QUANTITIES BY	
CHECKED BY	
ORIGINAL PLAN	
NOTE BOOK	
No.	

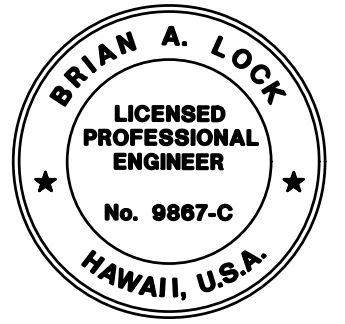


THIS WORK WAS PREPARED BY
ME OR UNDER MY SUPERVISION.
[Signature]
WILSON OKAMOTO CORPORATION
APRIL 30, 2026
LIC. EXP. DATE

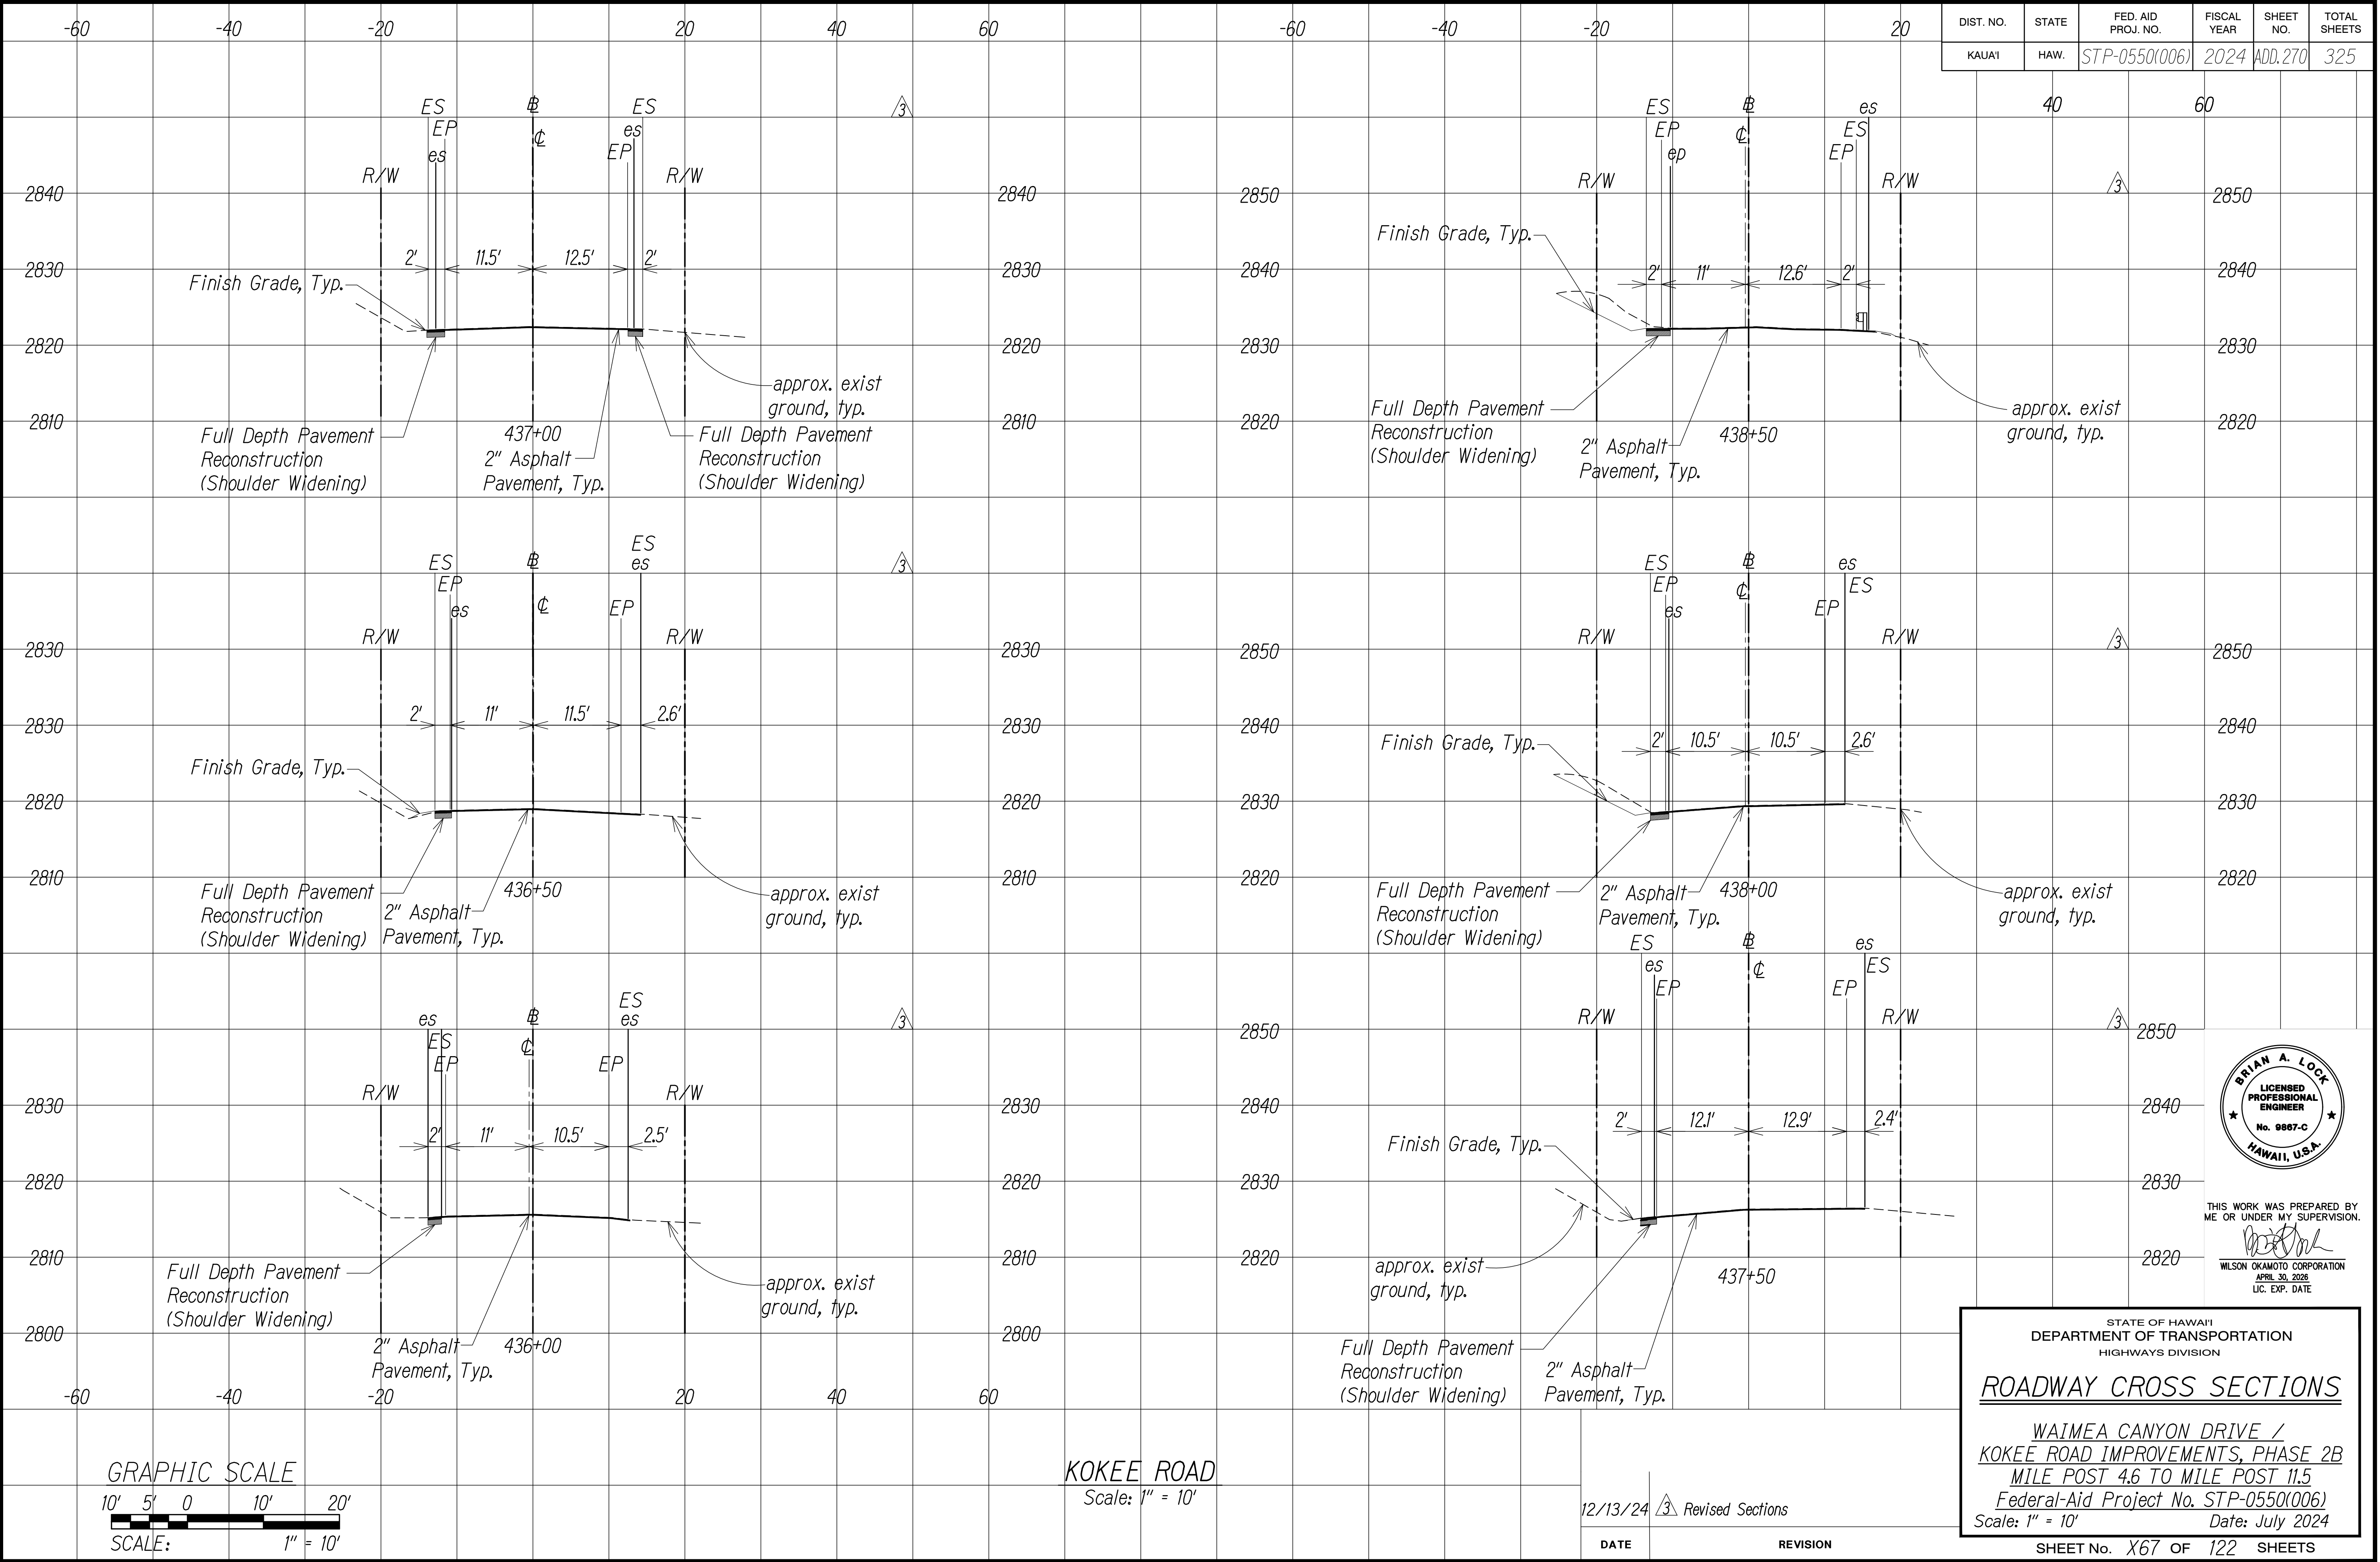

DIST. NO.	STATE	FED. AID PROJ. NO.	FISCAL YEAR	SHEET NO.	TOTAL SHEETS
KAUAI	HAW.	STP-0550(006)	2024	ADD.270	325

SURVEY PLOTTED BY	DATE
DESIGNED BY	
TRACED BY	
QUANTITIES BY	
CHECKED BY	
ORIGINAL PLAN	
NOTE BOOK	
No.	

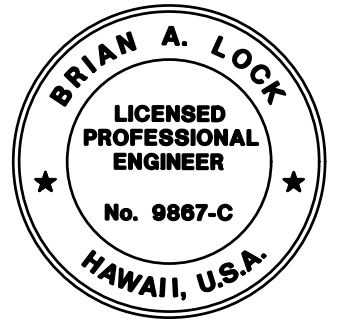

THIS WORK WAS PREPARED BY
ME OR UNDER MY SUPERVISION.


[Signature]

WILSON OKAMOTO CORPORATION
APRIL 30, 2026
LIC. EXP. DATE

STATE OF HAWAII
DEPARTMENT OF TRANSPORTATION
HIGHWAYS DIVISION

ROADWAY CROSS SECTIONS


WAIMEA CANYON DRIVE /
KOKEE ROAD IMPROVEMENTS, PHASE 2B
MILE POST 4.6 TO MILE POST 11.5
Federal-Aid Project No. STP-0550(006)
Scale: 1" = 10' Date: July 2024

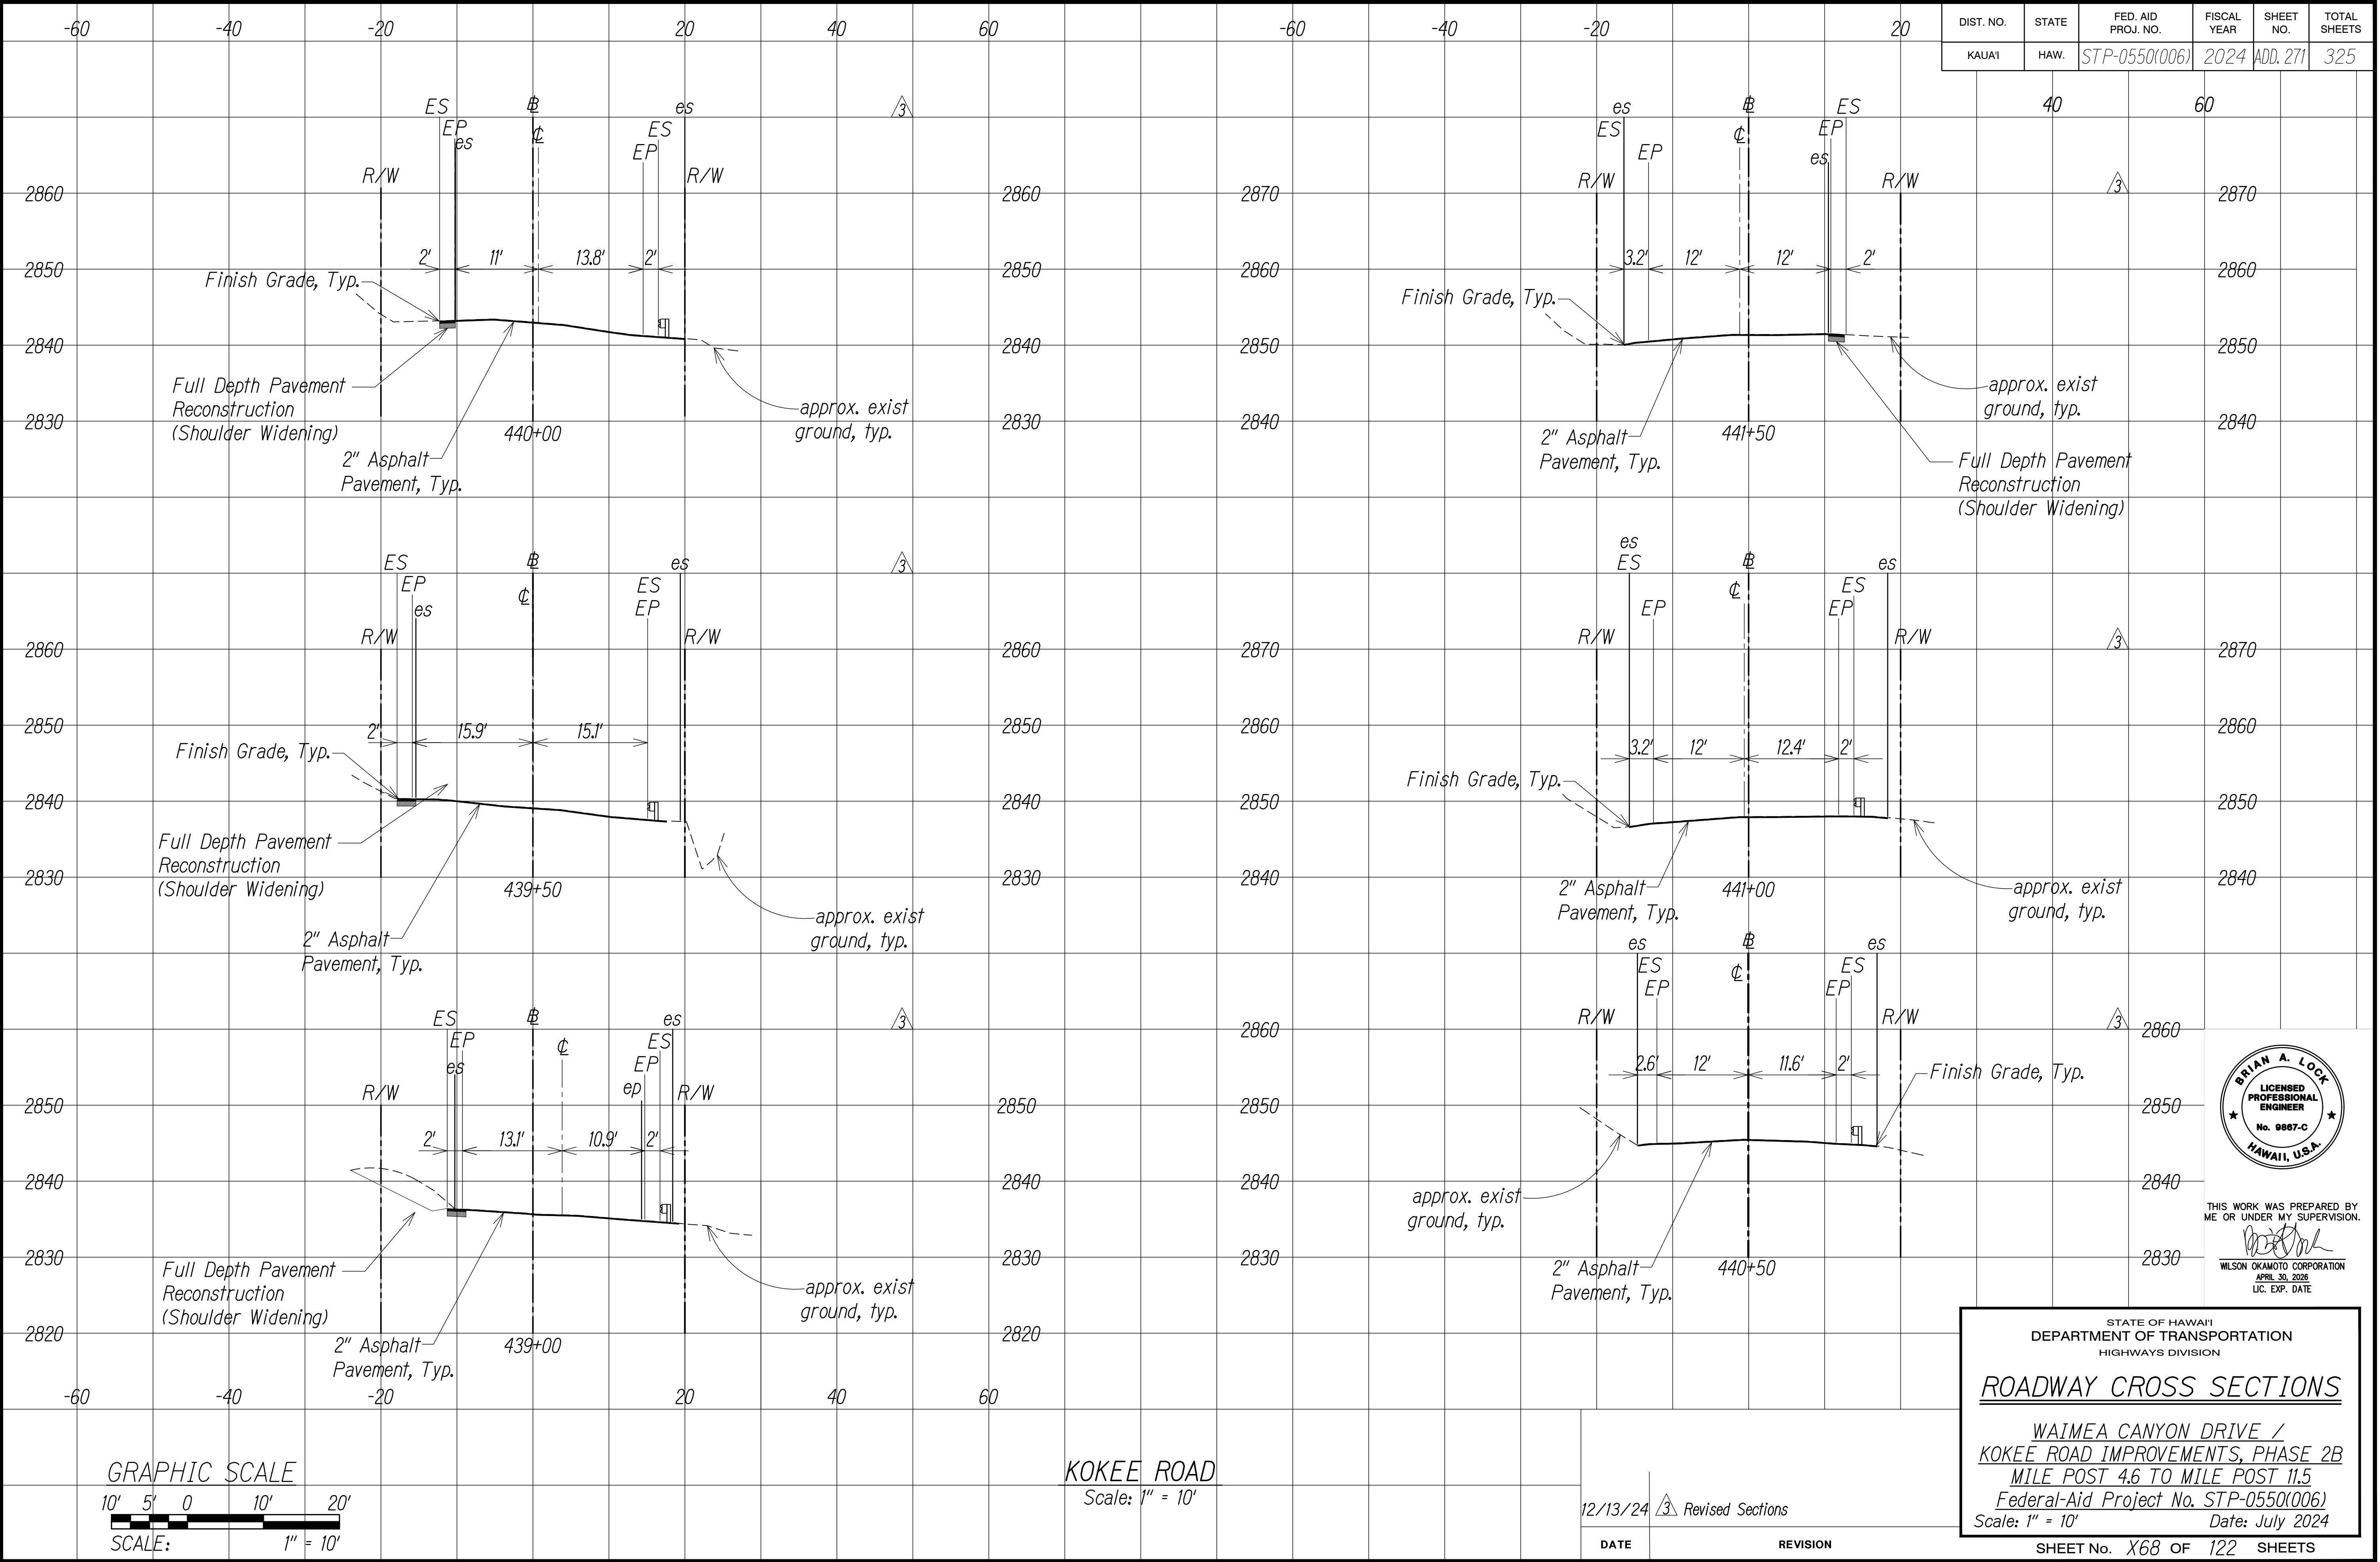

DIST. NO.	STATE	FED. AID PROJ. NO.	FISCAL YEAR	SHEET NO.	TOTAL SHEETS
KAUAI	HAW.	STP-0550(006)	2024	ADD. 271	325

SURVEY PLOTTED BY	DATE
DESIGNED BY	
TRACED BY	
DESIGNED BY	
QUANTITIES BY	
CHECKED BY	

ORIGINAL PLAN	No.
NOTE BOOK	

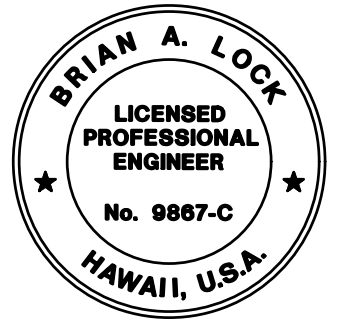

THIS WORK WAS PREPARED BY ME OR UNDER MY SUPERVISION.
[Signature]
WILSON OKAMOTO CORPORATION
APRIL 30, 2026
LIC. EXP. DATE

STATE OF HAWAII
DEPARTMENT OF TRANSPORTATION
HIGHWAYS DIVISION

ROADWAY CROSS SECTIONS


WAIMEA CANYON DRIVE /
Kokee Road Improvements, Phase 2B
MILE POST 4.6 TO MILE POST 11.5
Federal-Aid Project No. STP-0550(006)
Scale: 1" = 10' Date: July 2024

12/13/24 3 Revised Sections

DATE	REVISION
------	----------


SHEET No. X68 OF 122 SHEETS

DIST. NO.	STATE	FED. AID PROJ. NO.	FISCAL YEAR	SHEET NO.	TOTAL SHEETS
KAUAI	HAW.	STP-0550(006)	2024	ADD.272	325

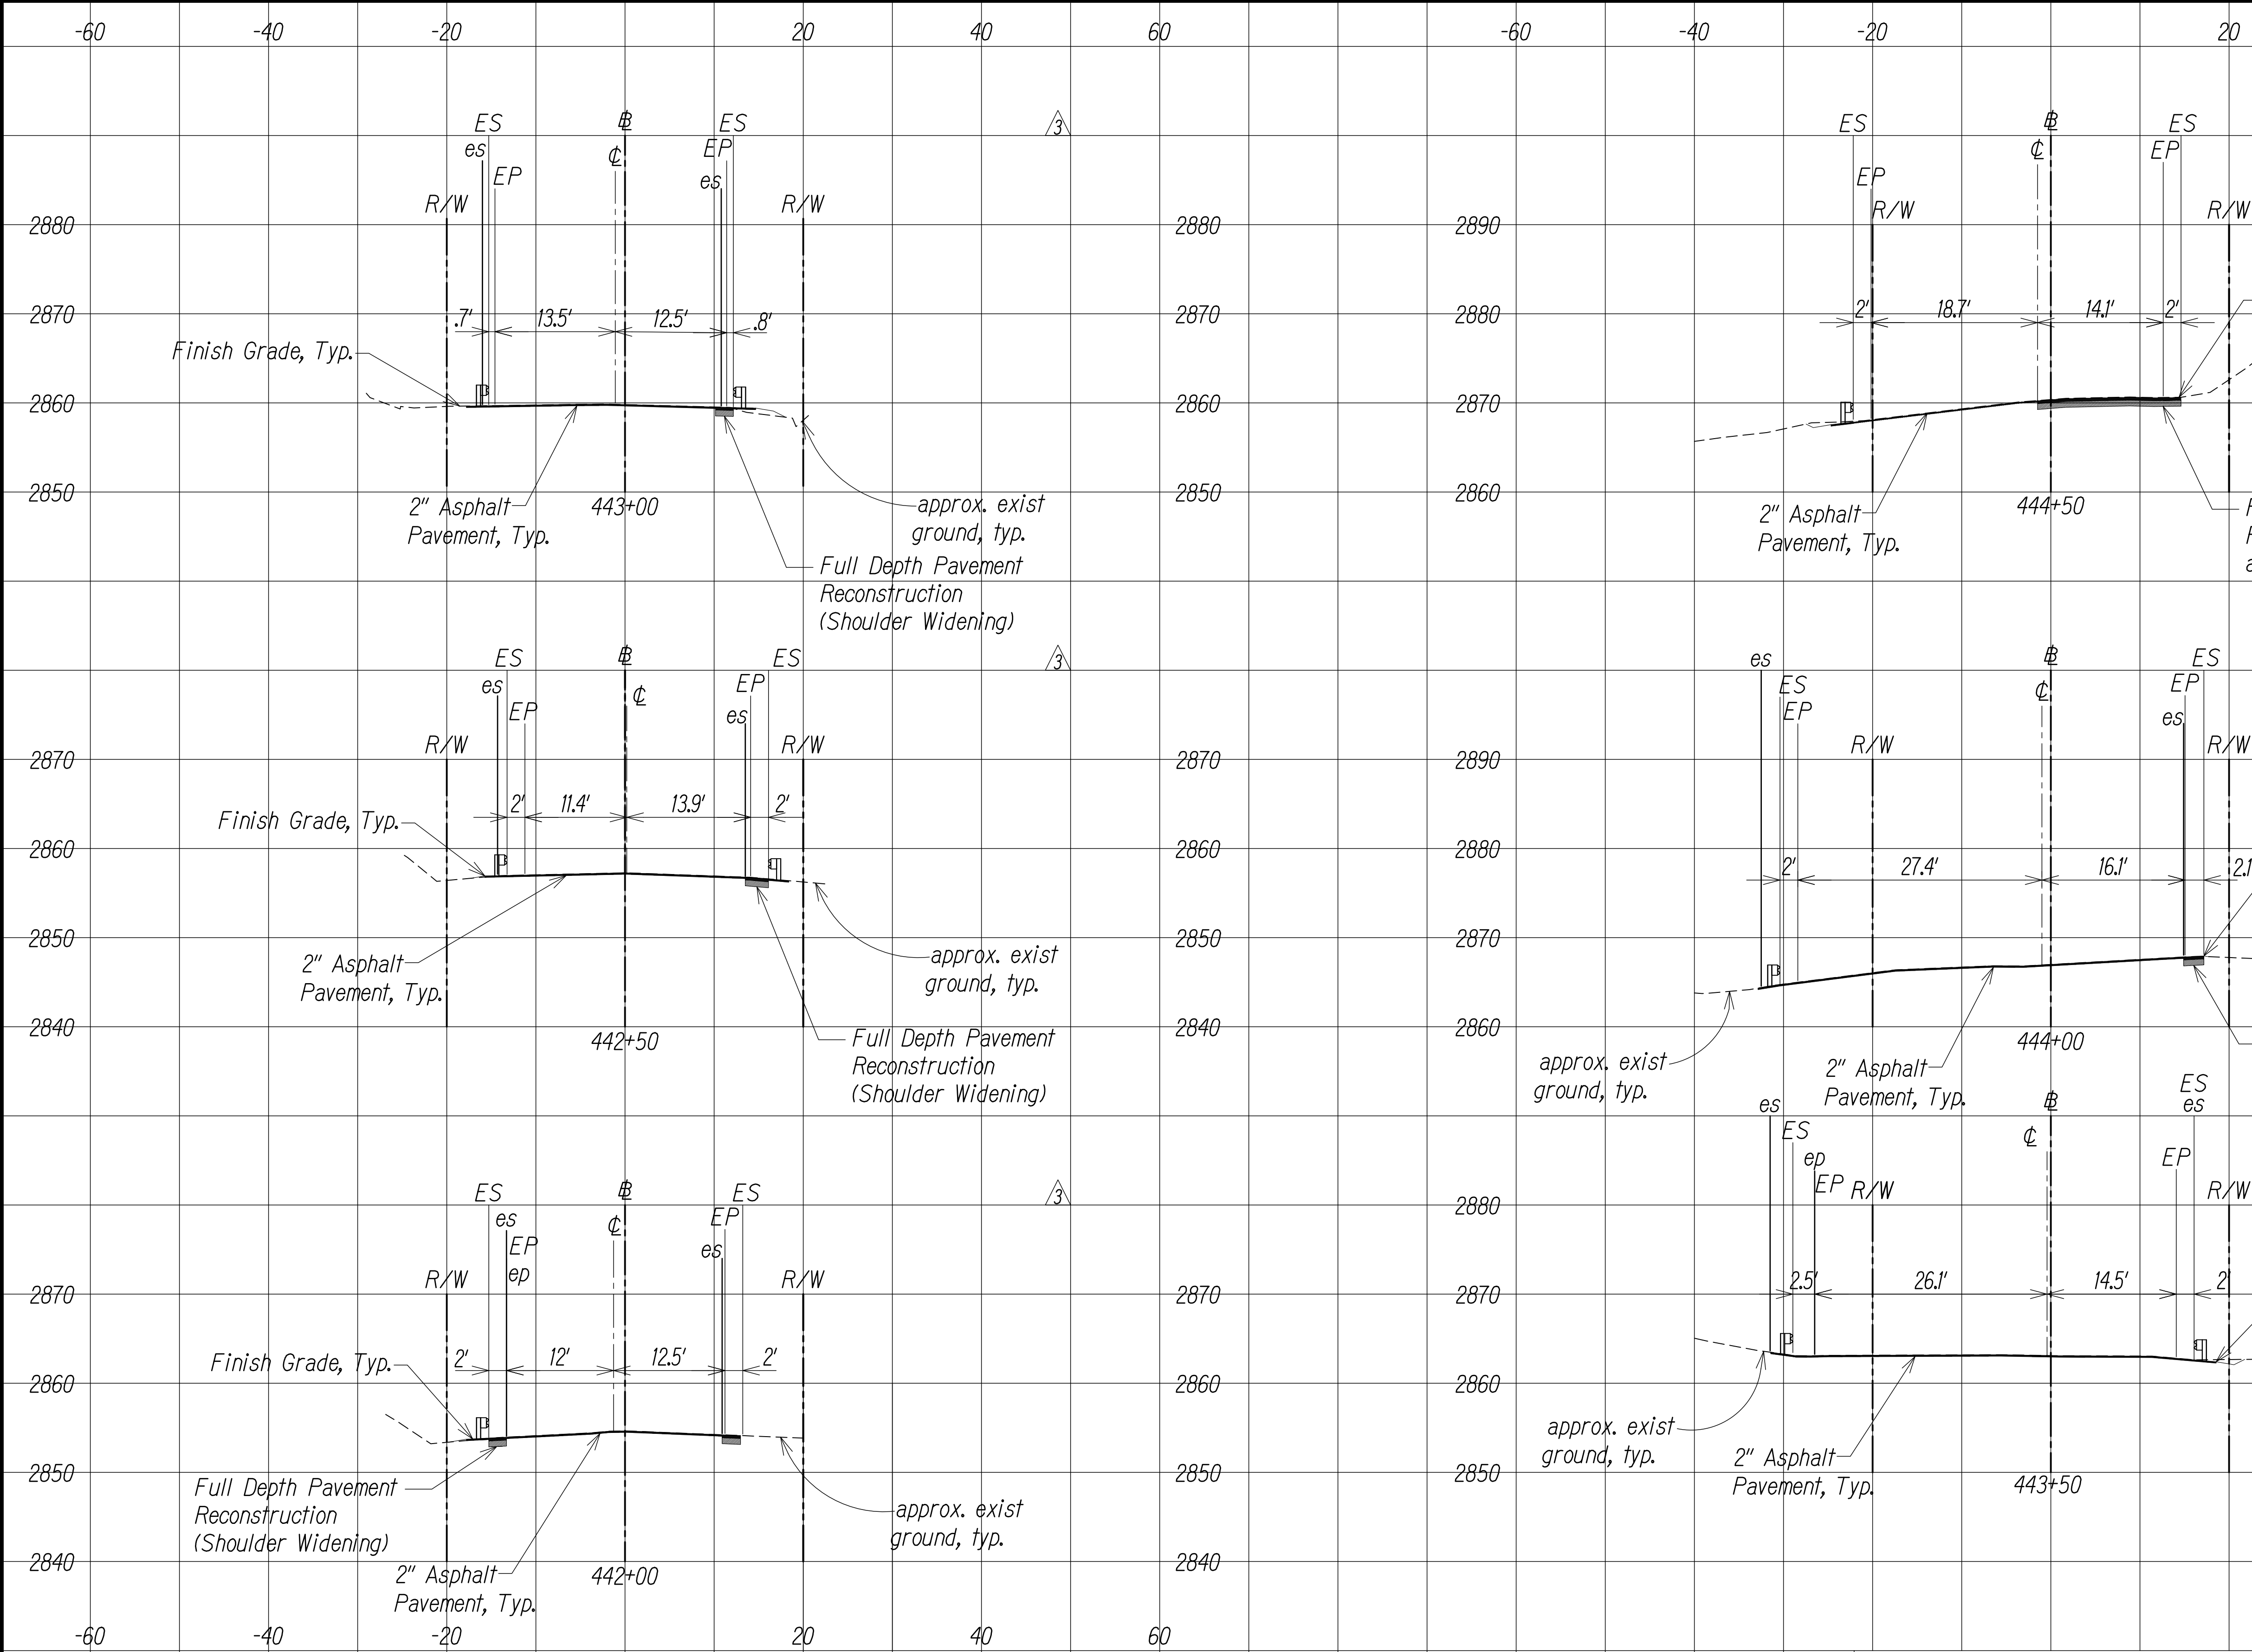

SURVEY PLOTTED BY	DATE
DESIGNED BY	
TRACED BY	
QUANTITIES BY	
CHECKED BY	


ORIGINAL PLAN	NOTE BOOK
No.	No.

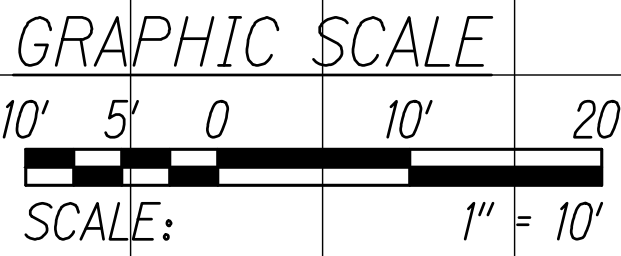

KOKEE ROAD
Scale: 1" = 10'

12/13/24 3 Revised Sections


DATE	REVISION
------	----------

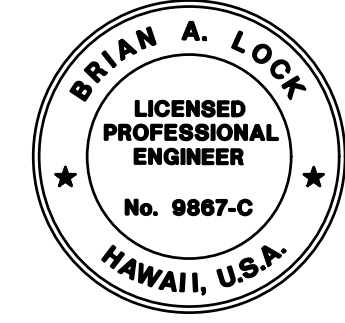


THIS WORK WAS PREPARED BY ME OR UNDER MY SUPERVISION.
[Signature]
WILSON OKAMOTO CORPORATION
APRIL 30, 2026
LIC. EXP. DATE

STATE OF HAWAII
DEPARTMENT OF TRANSPORTATION
HIGHWAYS DIVISION
ROADWAY CROSS SECTIONS
WAIMEA CANYON DRIVE /
KOKEE ROAD IMPROVEMENTS, PHASE 2B
MILE POST 4.6 TO MILE POST 11.5
Federal-Aid Project No. STP-0550(006)
Scale: 1" = 10' Date: July 2024


SHEET No. X69 OF 122 SHEETS

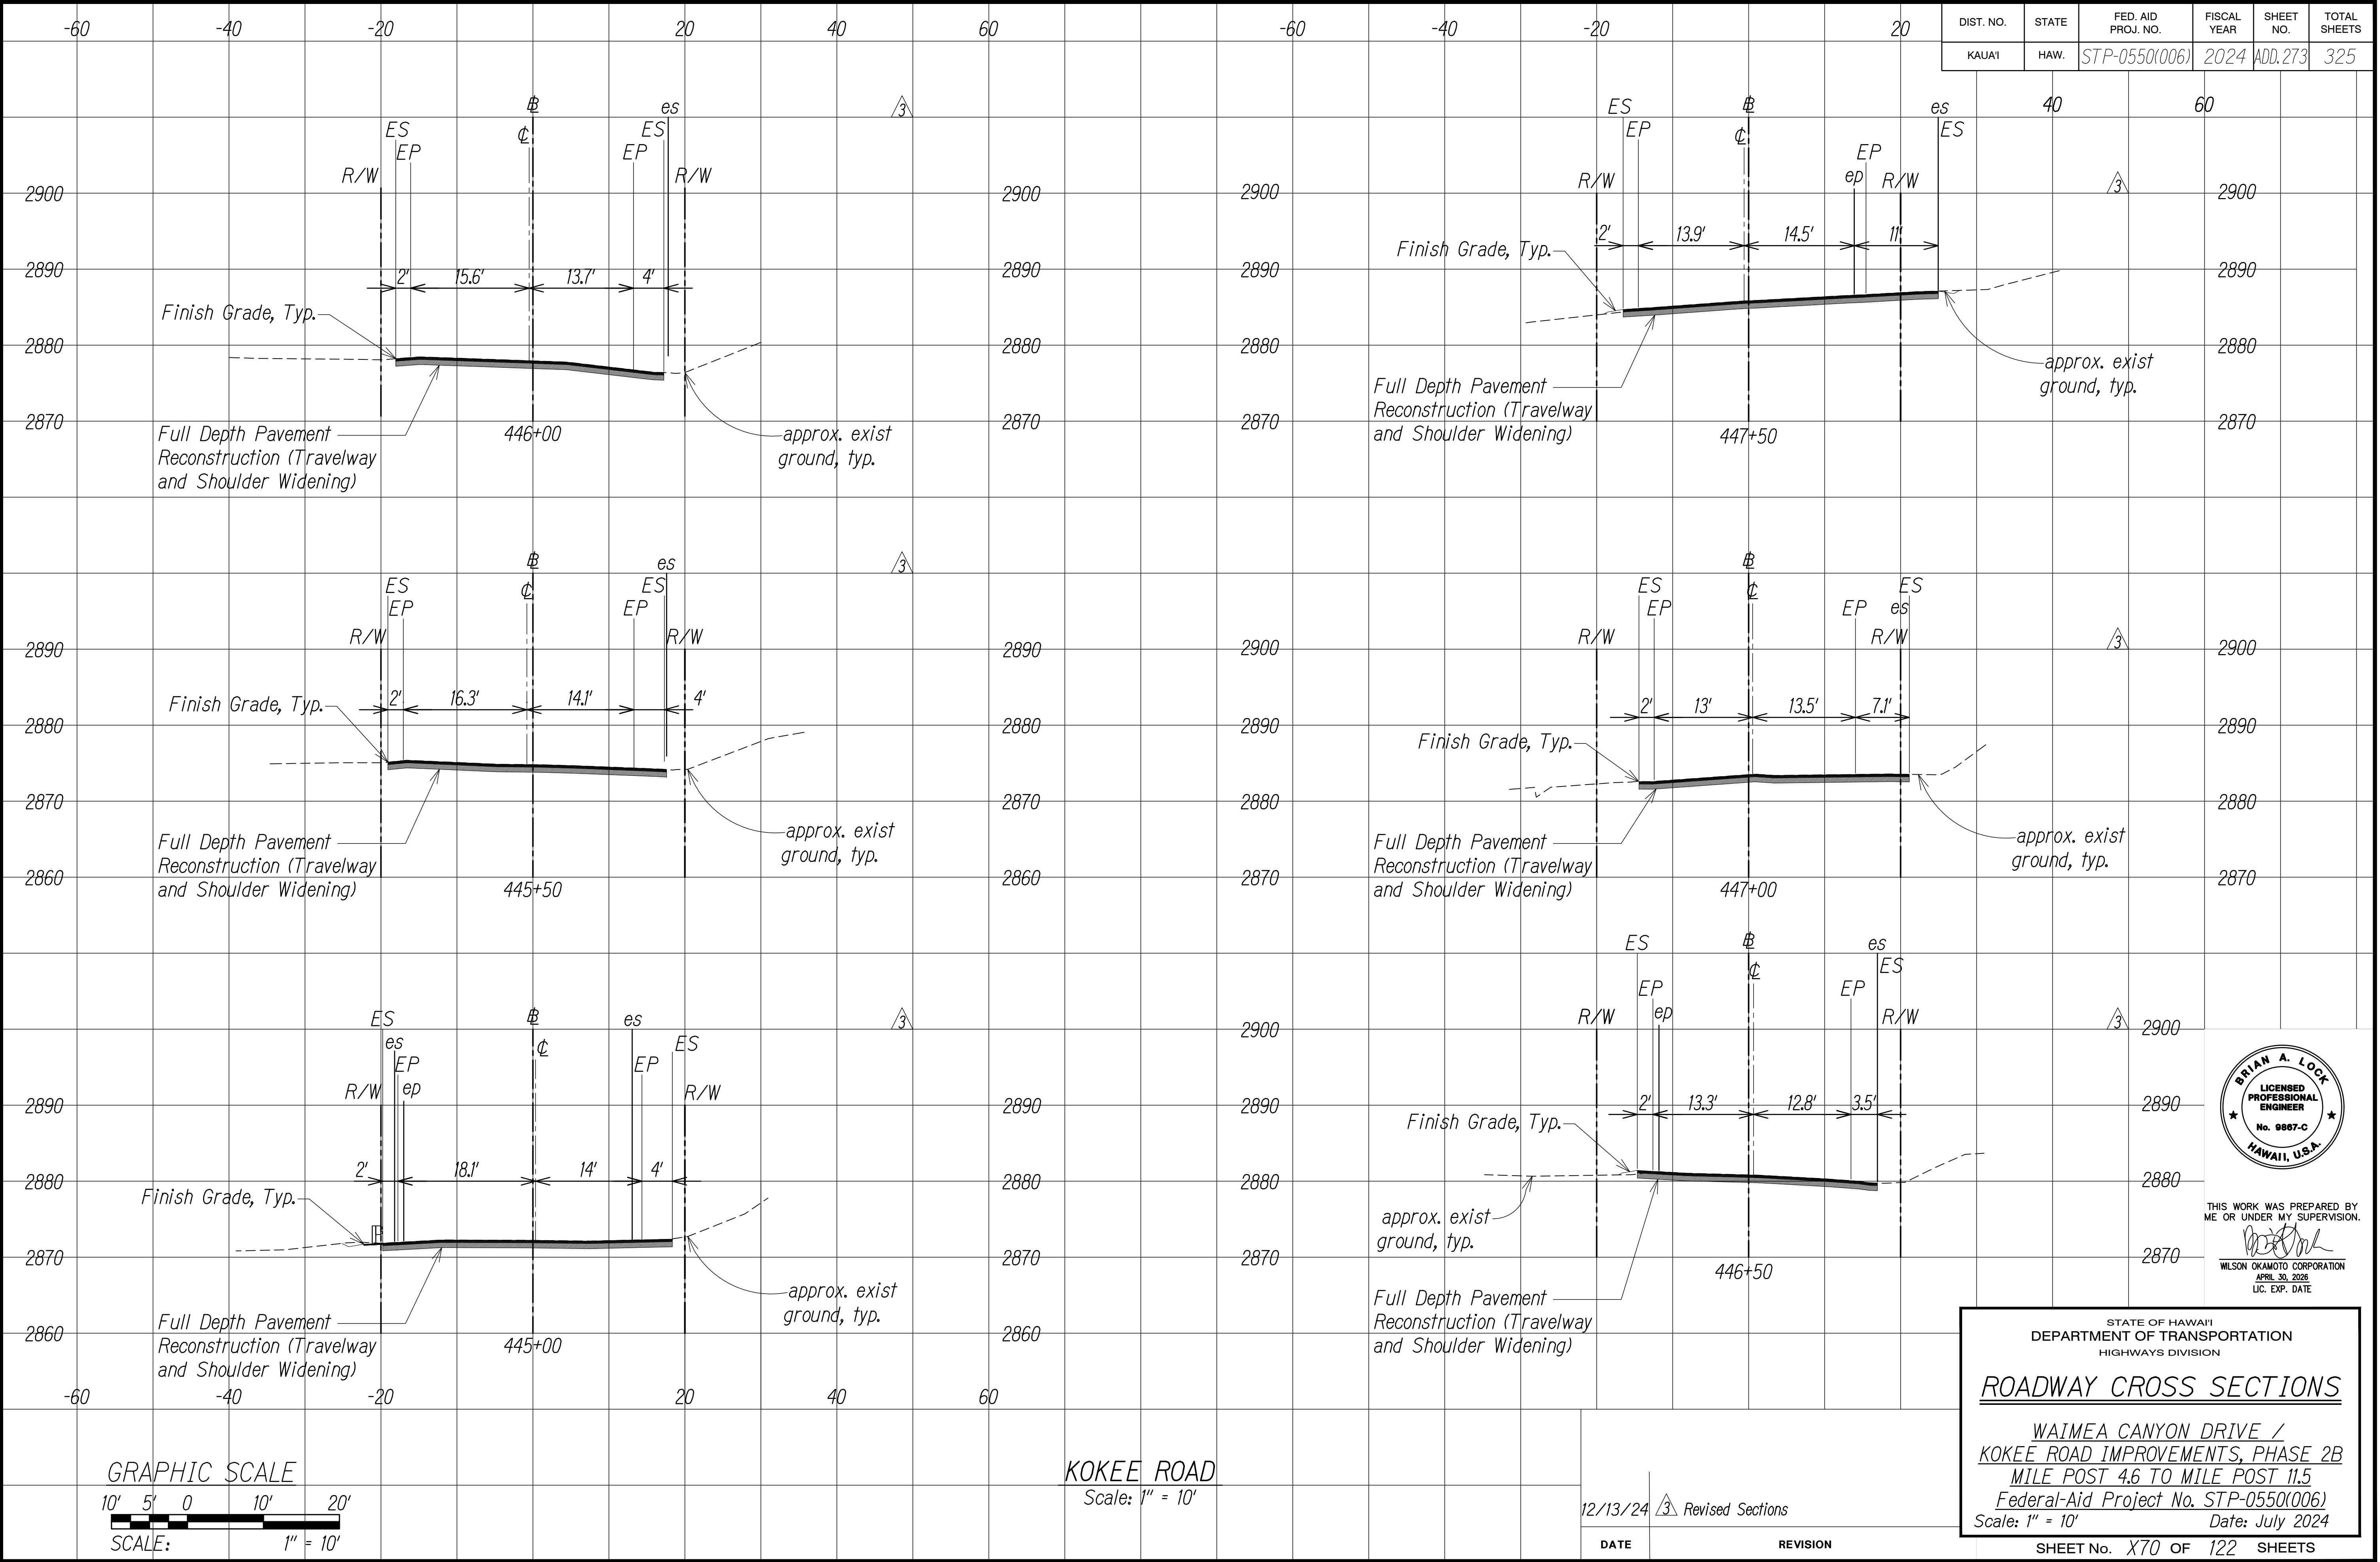

SURVEY PLOTTED BY	DATE
DESIGNED BY	
TRACED BY	
NOTED BY	
QUANTITIES BY	
CHECKED BY	

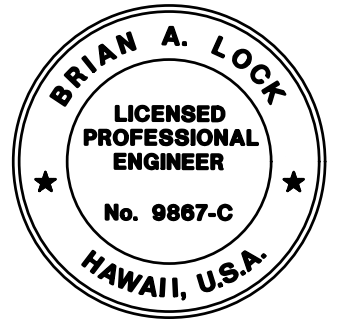


THIS WORK WAS PREPARED BY
ME OR UNDER MY SUPERVISION.
[Signature]
WILSON OKAMOTO CORPORATION
APRIL 30, 2026
LIC. EXP. DATE

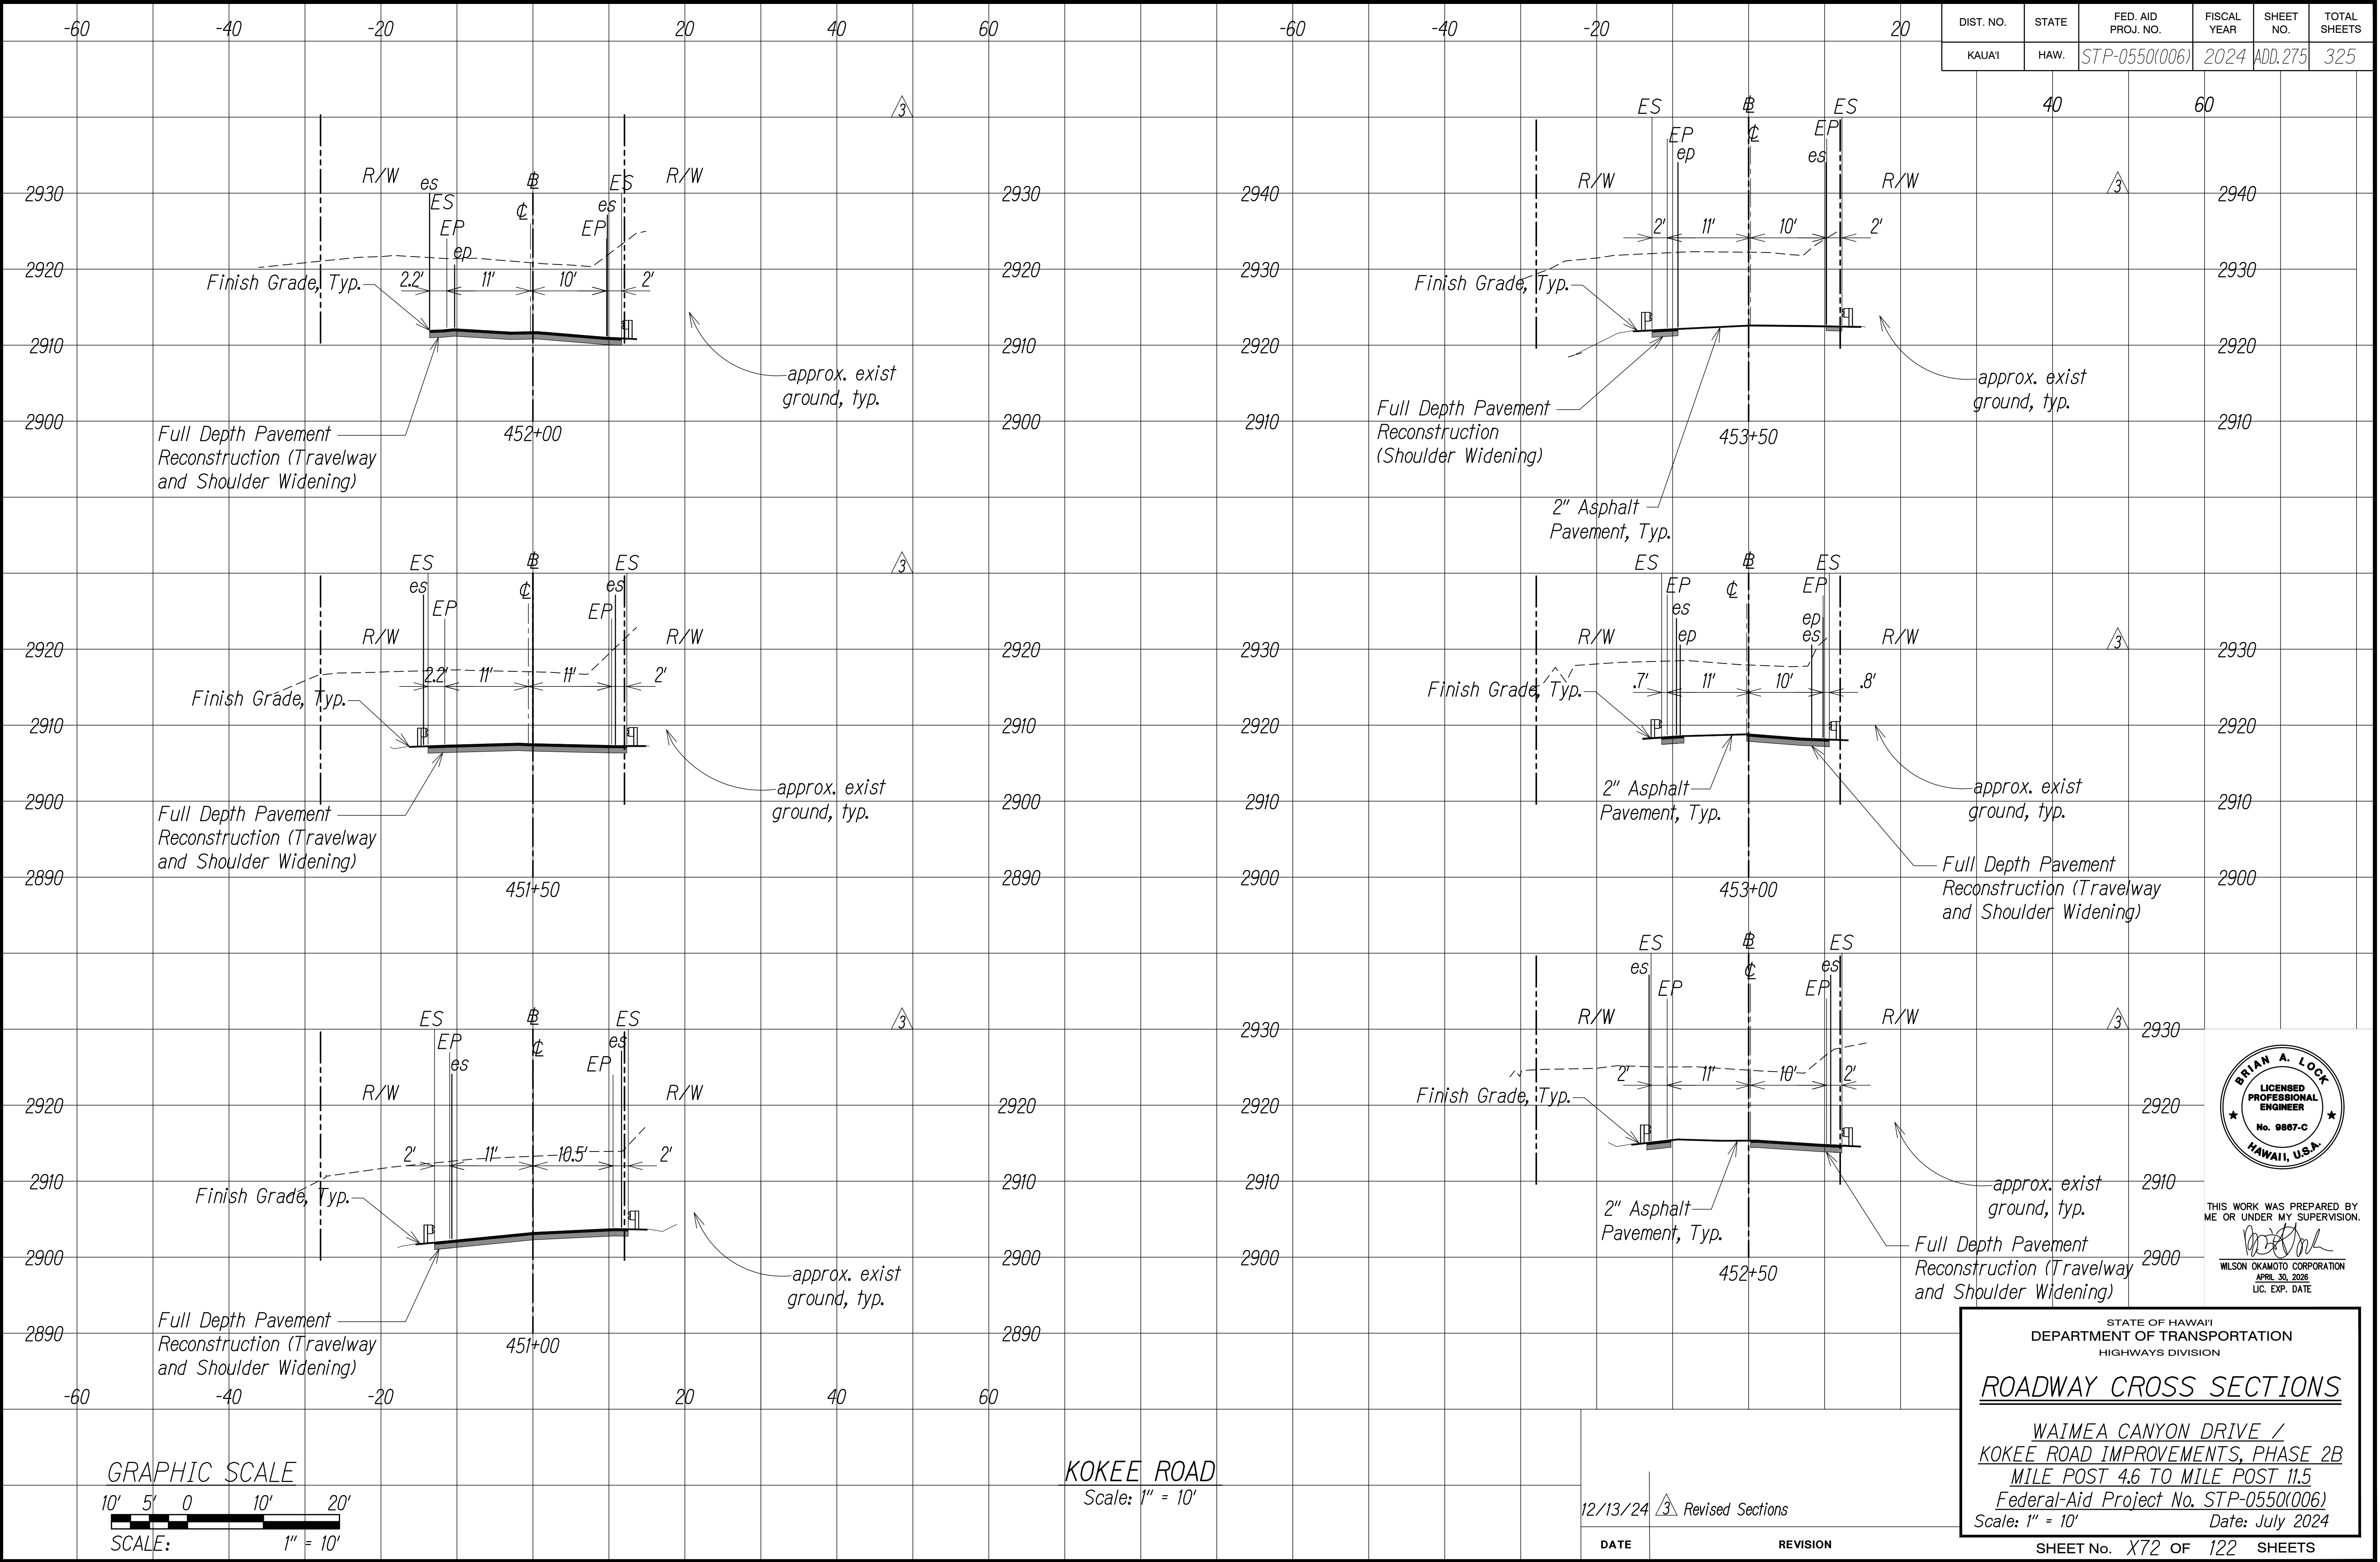

DIST. NO.	STATE	FED. AID PROJ. NO.	FISCAL YEAR	SHEET NO.	TOTAL SHEETS
KAUAI	HAW.	STP-0550(006)	2024	ADD.275	325

SURVEY PLOTTED BY	DATE
DESIGNED BY	
TRACED BY	
QUANTITIES BY	
CHECKED BY	
NOTE BOOK	
No.	

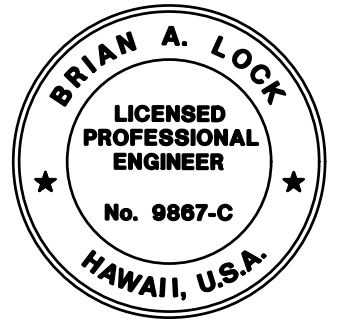

THIS WORK WAS PREPARED BY
ME OR UNDER MY SUPERVISION.

[Signature]



WILSON OKAMOTO CORPORATION
APRIL 30, 2026
LIC. EXP. DATE

STATE OF HAWAII
DEPARTMENT OF TRANSPORTATION
HIGHWAYS DIVISION


ROADWAY CROSS SECTIONS

WAIMEA CANYON DRIVE /
KOKEE ROAD IMPROVEMENTS, PHASE 2B
MILE POST 4.6 TO MILE POST 11.5
Federal-Aid Project No. STP-0550(006)
Scale: 1" = 10' Date: July 2024

DIST. NO.	STATE	FED. AID PROJ. NO.	FISCAL YEAR	SHEET NO.	TOTAL SHEETS
KAUAI	HAW.	STP-0550(006)	2024	ADD.276	325

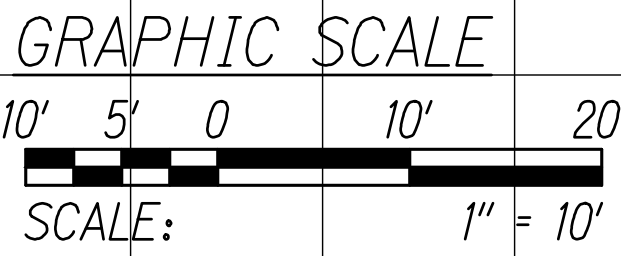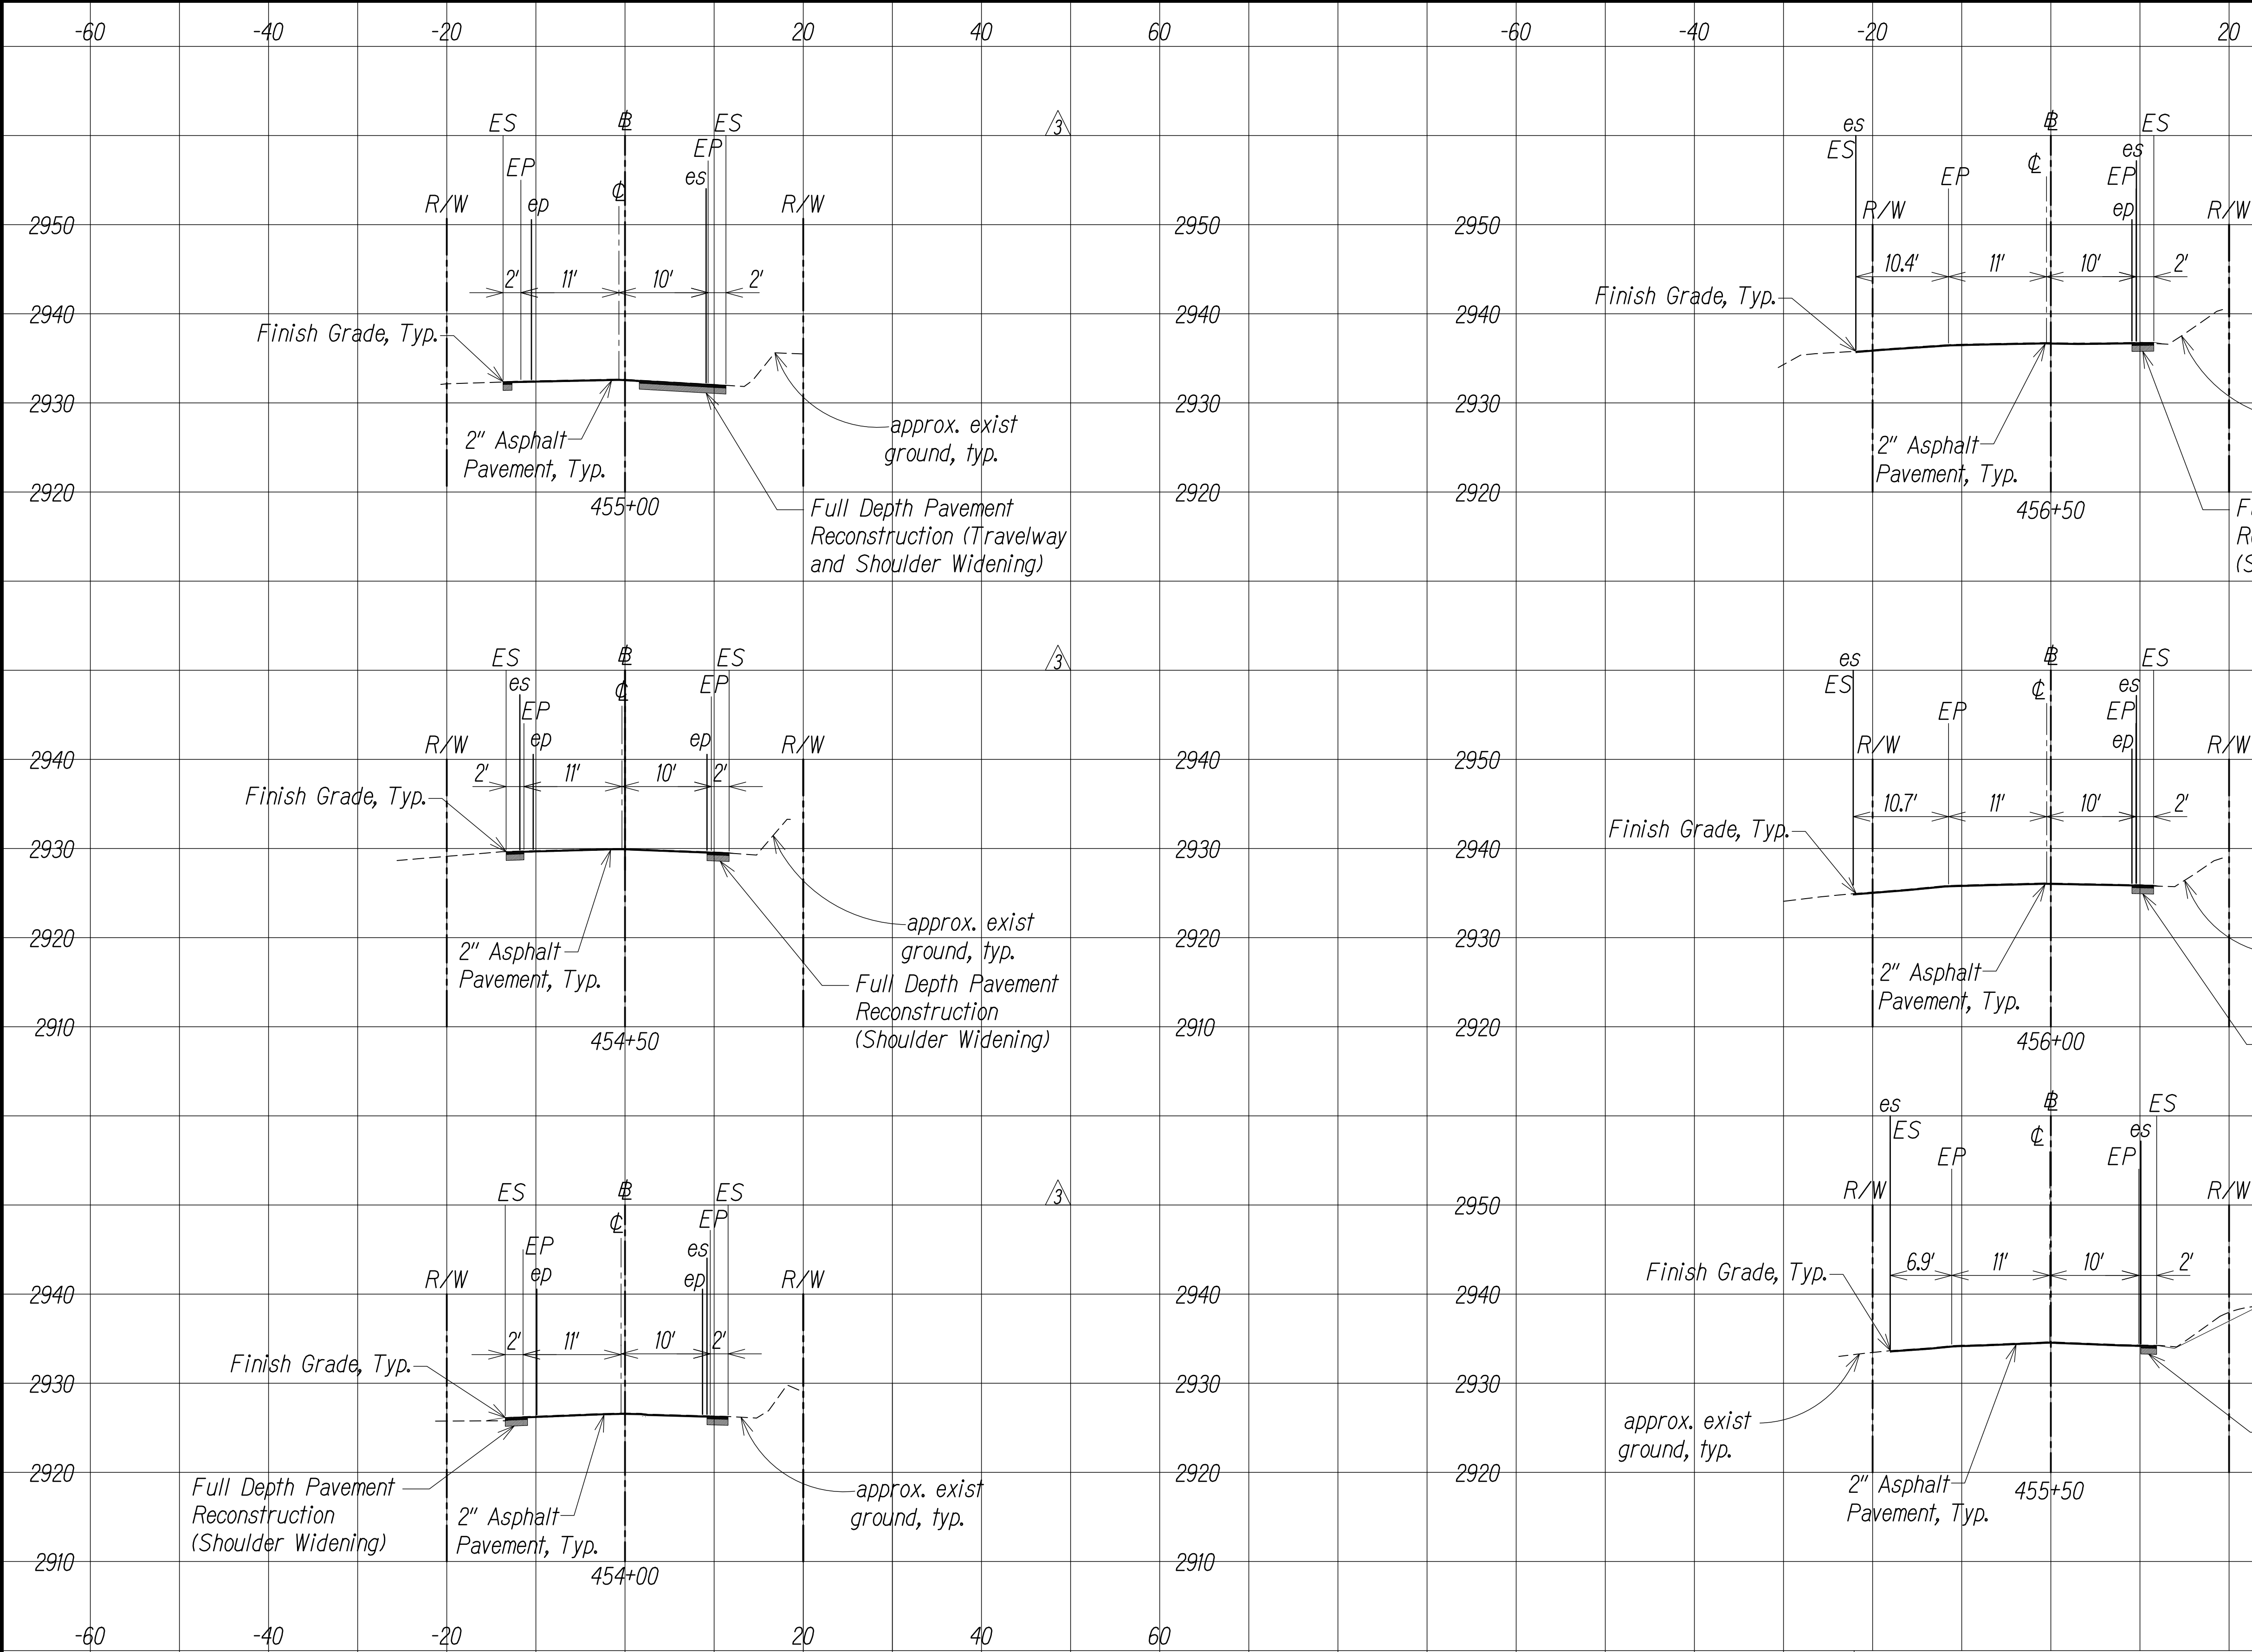

KOKEE ROAD
Scale: 1" = 10'

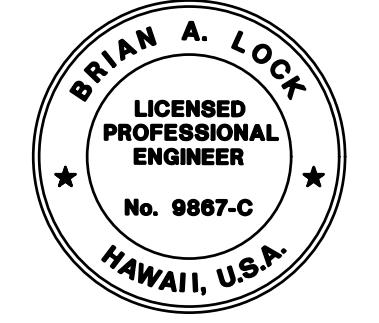

THIS WORK WAS PREPARED BY
ME OR UNDER MY SUPERVISION.
[Signature]
WILSON OKAMOTO CORPORATION
APRIL 30, 2026
LIC. EXP. DATE



STATE OF HAWAII
DEPARTMENT OF TRANSPORTATION
HIGHWAYS DIVISION
ROADWAY CROSS SECTIONS
WAIMEA CANYON DRIVE /
KOKEE ROAD IMPROVEMENTS, PHASE 2B
MILE POST 4.6 TO MILE POST 11.5
Federal-Aid Project No. STP-0550(006)
Scale: 1" = 10' Date: July 2024

12/13/24 3 Revised Sections

DATE	REVISION
------	----------

SHEET No. X73 OF 122 SHEETS

DIST. NO.	STATE	FED. AID PROJ. NO.	FISCAL YEAR	SHEET NO.	TOTAL SHEETS
KAUAI	HAW.	STP-0550(006)	2024	ADD.277	325

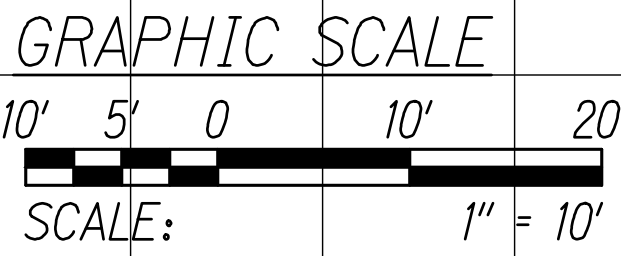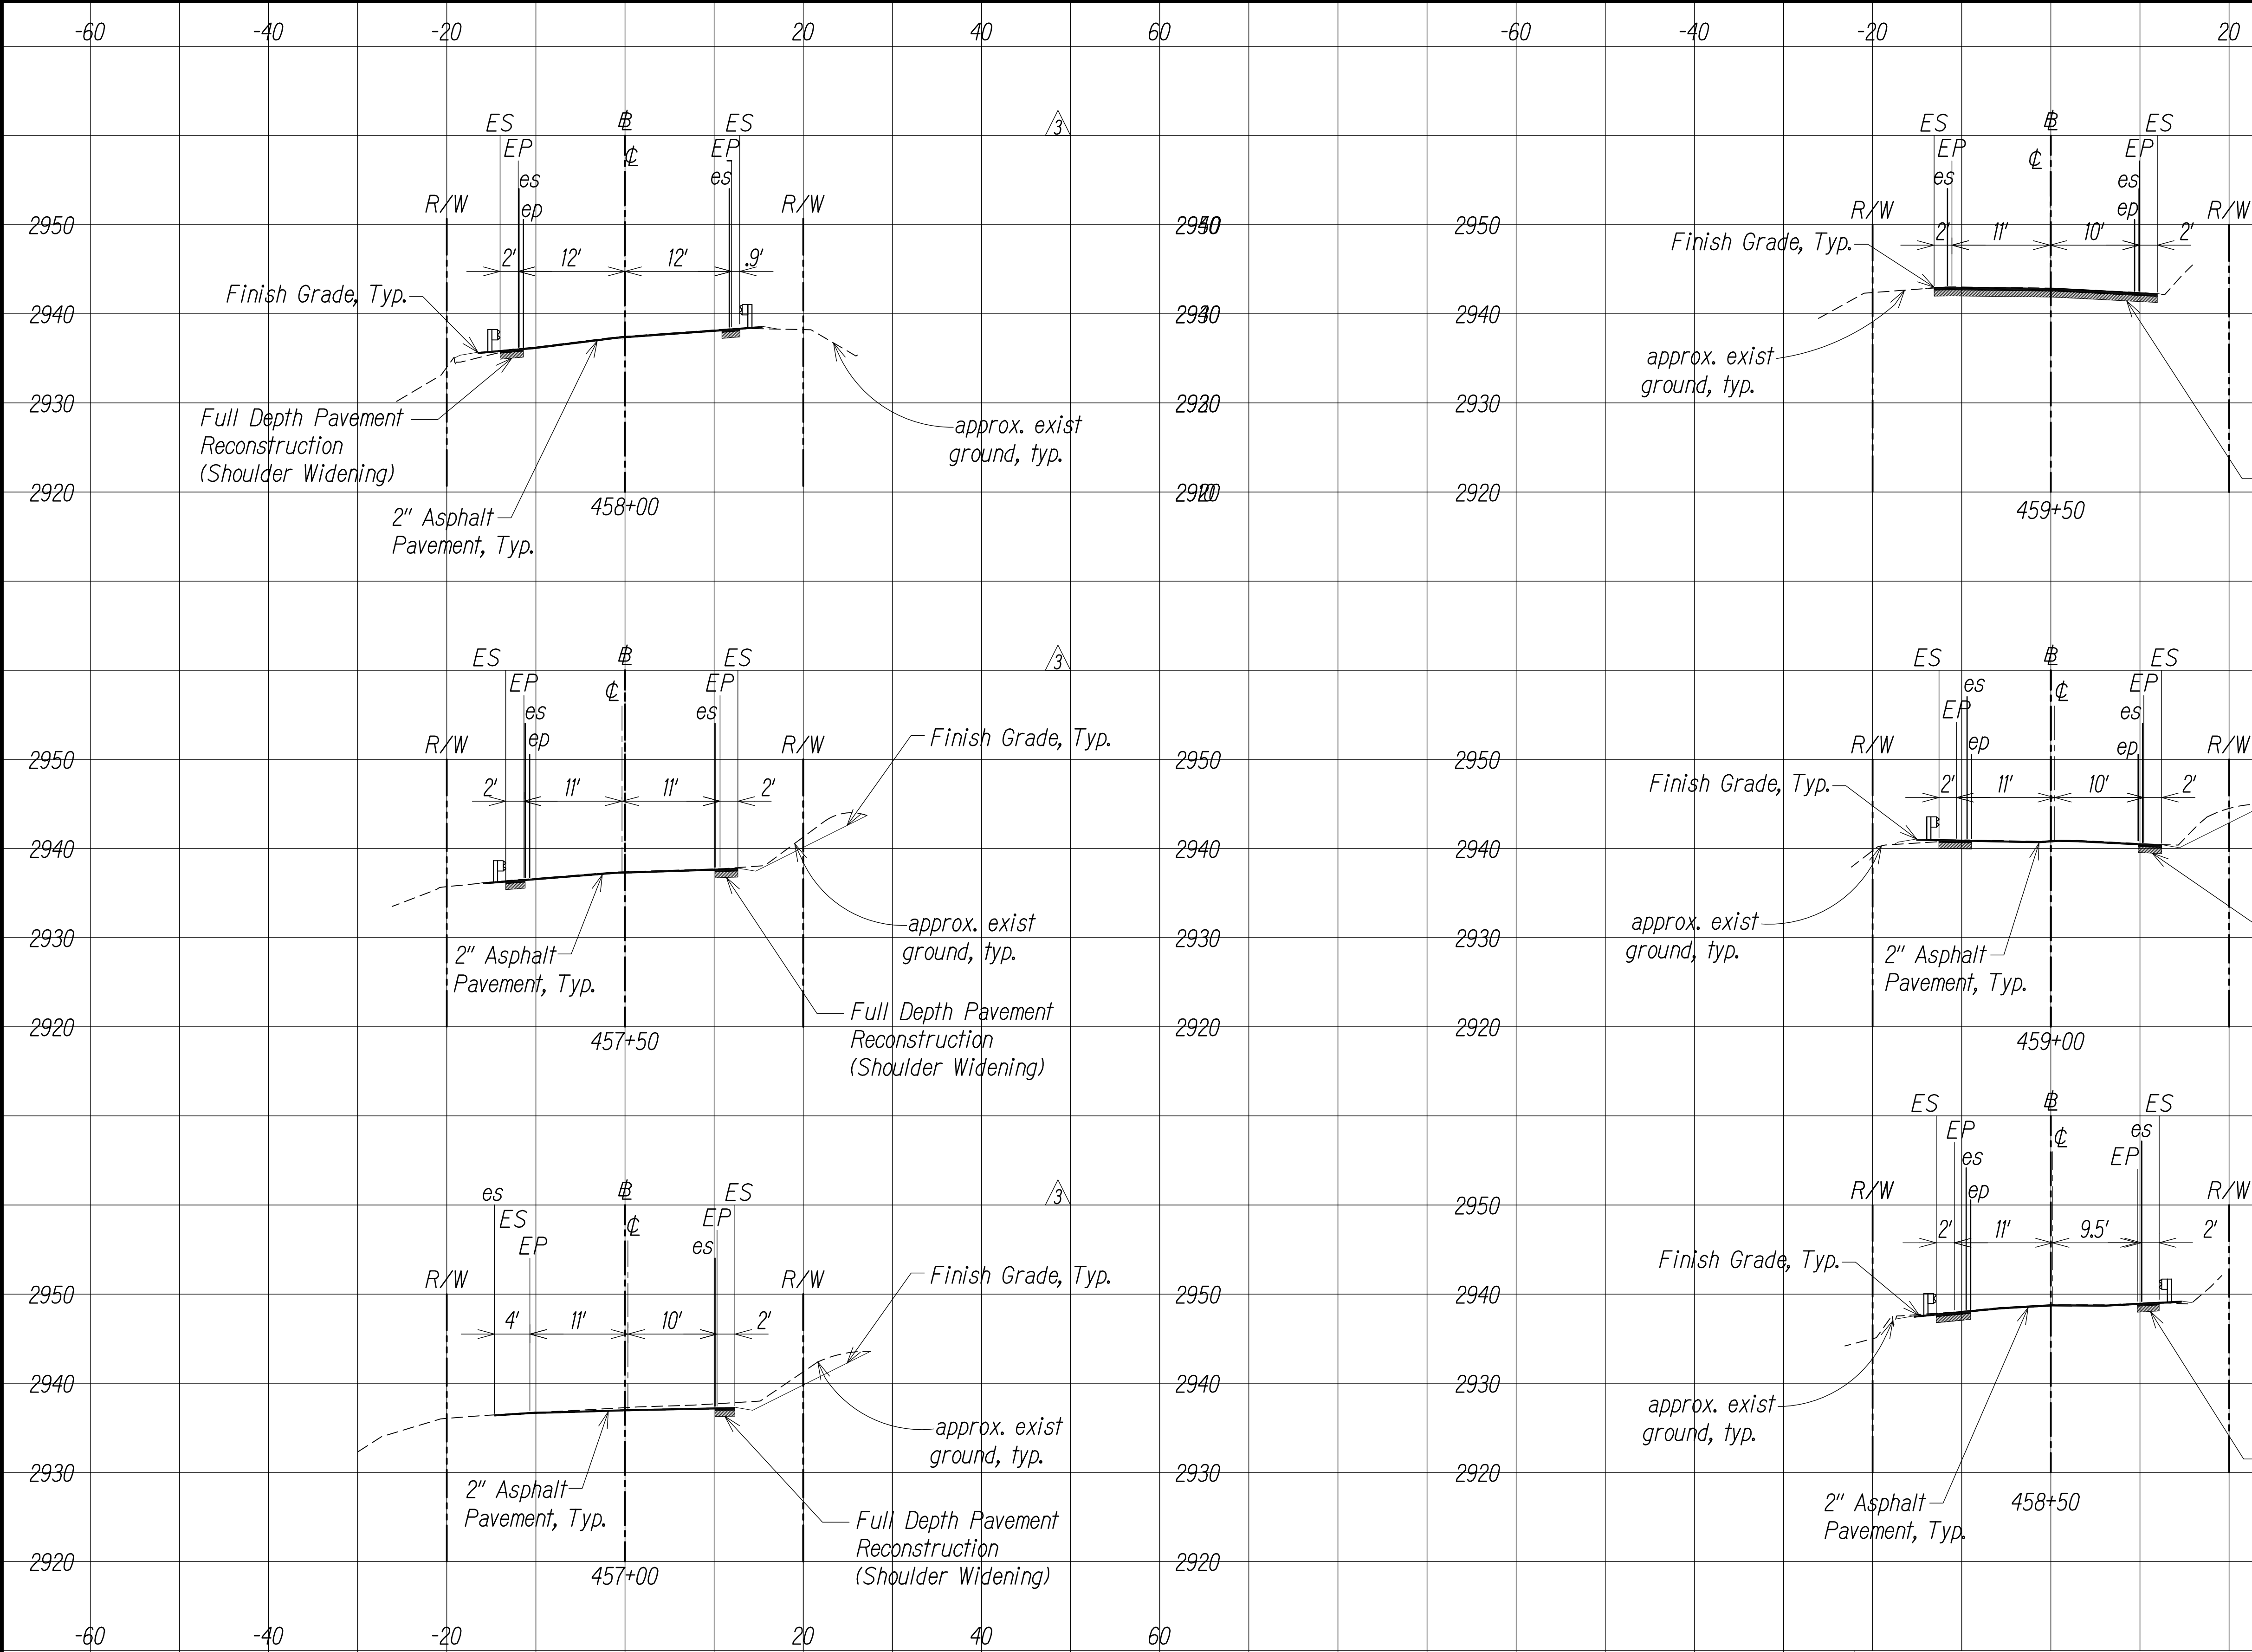

KOKEE ROAD
Scale: 1" = 10'

12/13/24 3 Revised Sections


DATE REVISION

STATE OF HAWAII
DEPARTMENT OF TRANSPORTATION
HIGHWAYS DIVISION

ROADWAY CROSS SECTIONS

WAIMEA CANYON DRIVE /
KOKEE ROAD IMPROVEMENTS, PHASE 2B
MILE POST 4.6 TO MILE POST 11.5
Federal-Aid Project No. STP-0550(006)
Scale: 1" = 10' Date: July 2024

SHEET No. X74 OF 122 SHEETS

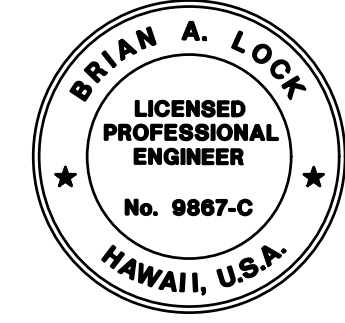


THIS WORK WAS PREPARED BY
ME OR UNDER MY SUPERVISION.
[Signature]
WILSON OKAMOTO CORPORATION
APRIL 30, 2026
LIC. EXP. DATE

SURVEY PLOTTED BY	DATE
DESIGNED BY	
TRACED BY	
QUANTITIES BY	
CHECKED BY	


ORIGINAL PLAN	No.
NOTE BOOK	

DIST. NO.	STATE	FED. AID PROJ. NO.	FISCAL YEAR	SHEET NO.	TOTAL SHEETS
KAUAI	HAW.	STP-0550(006)	2024	ADD.278	325

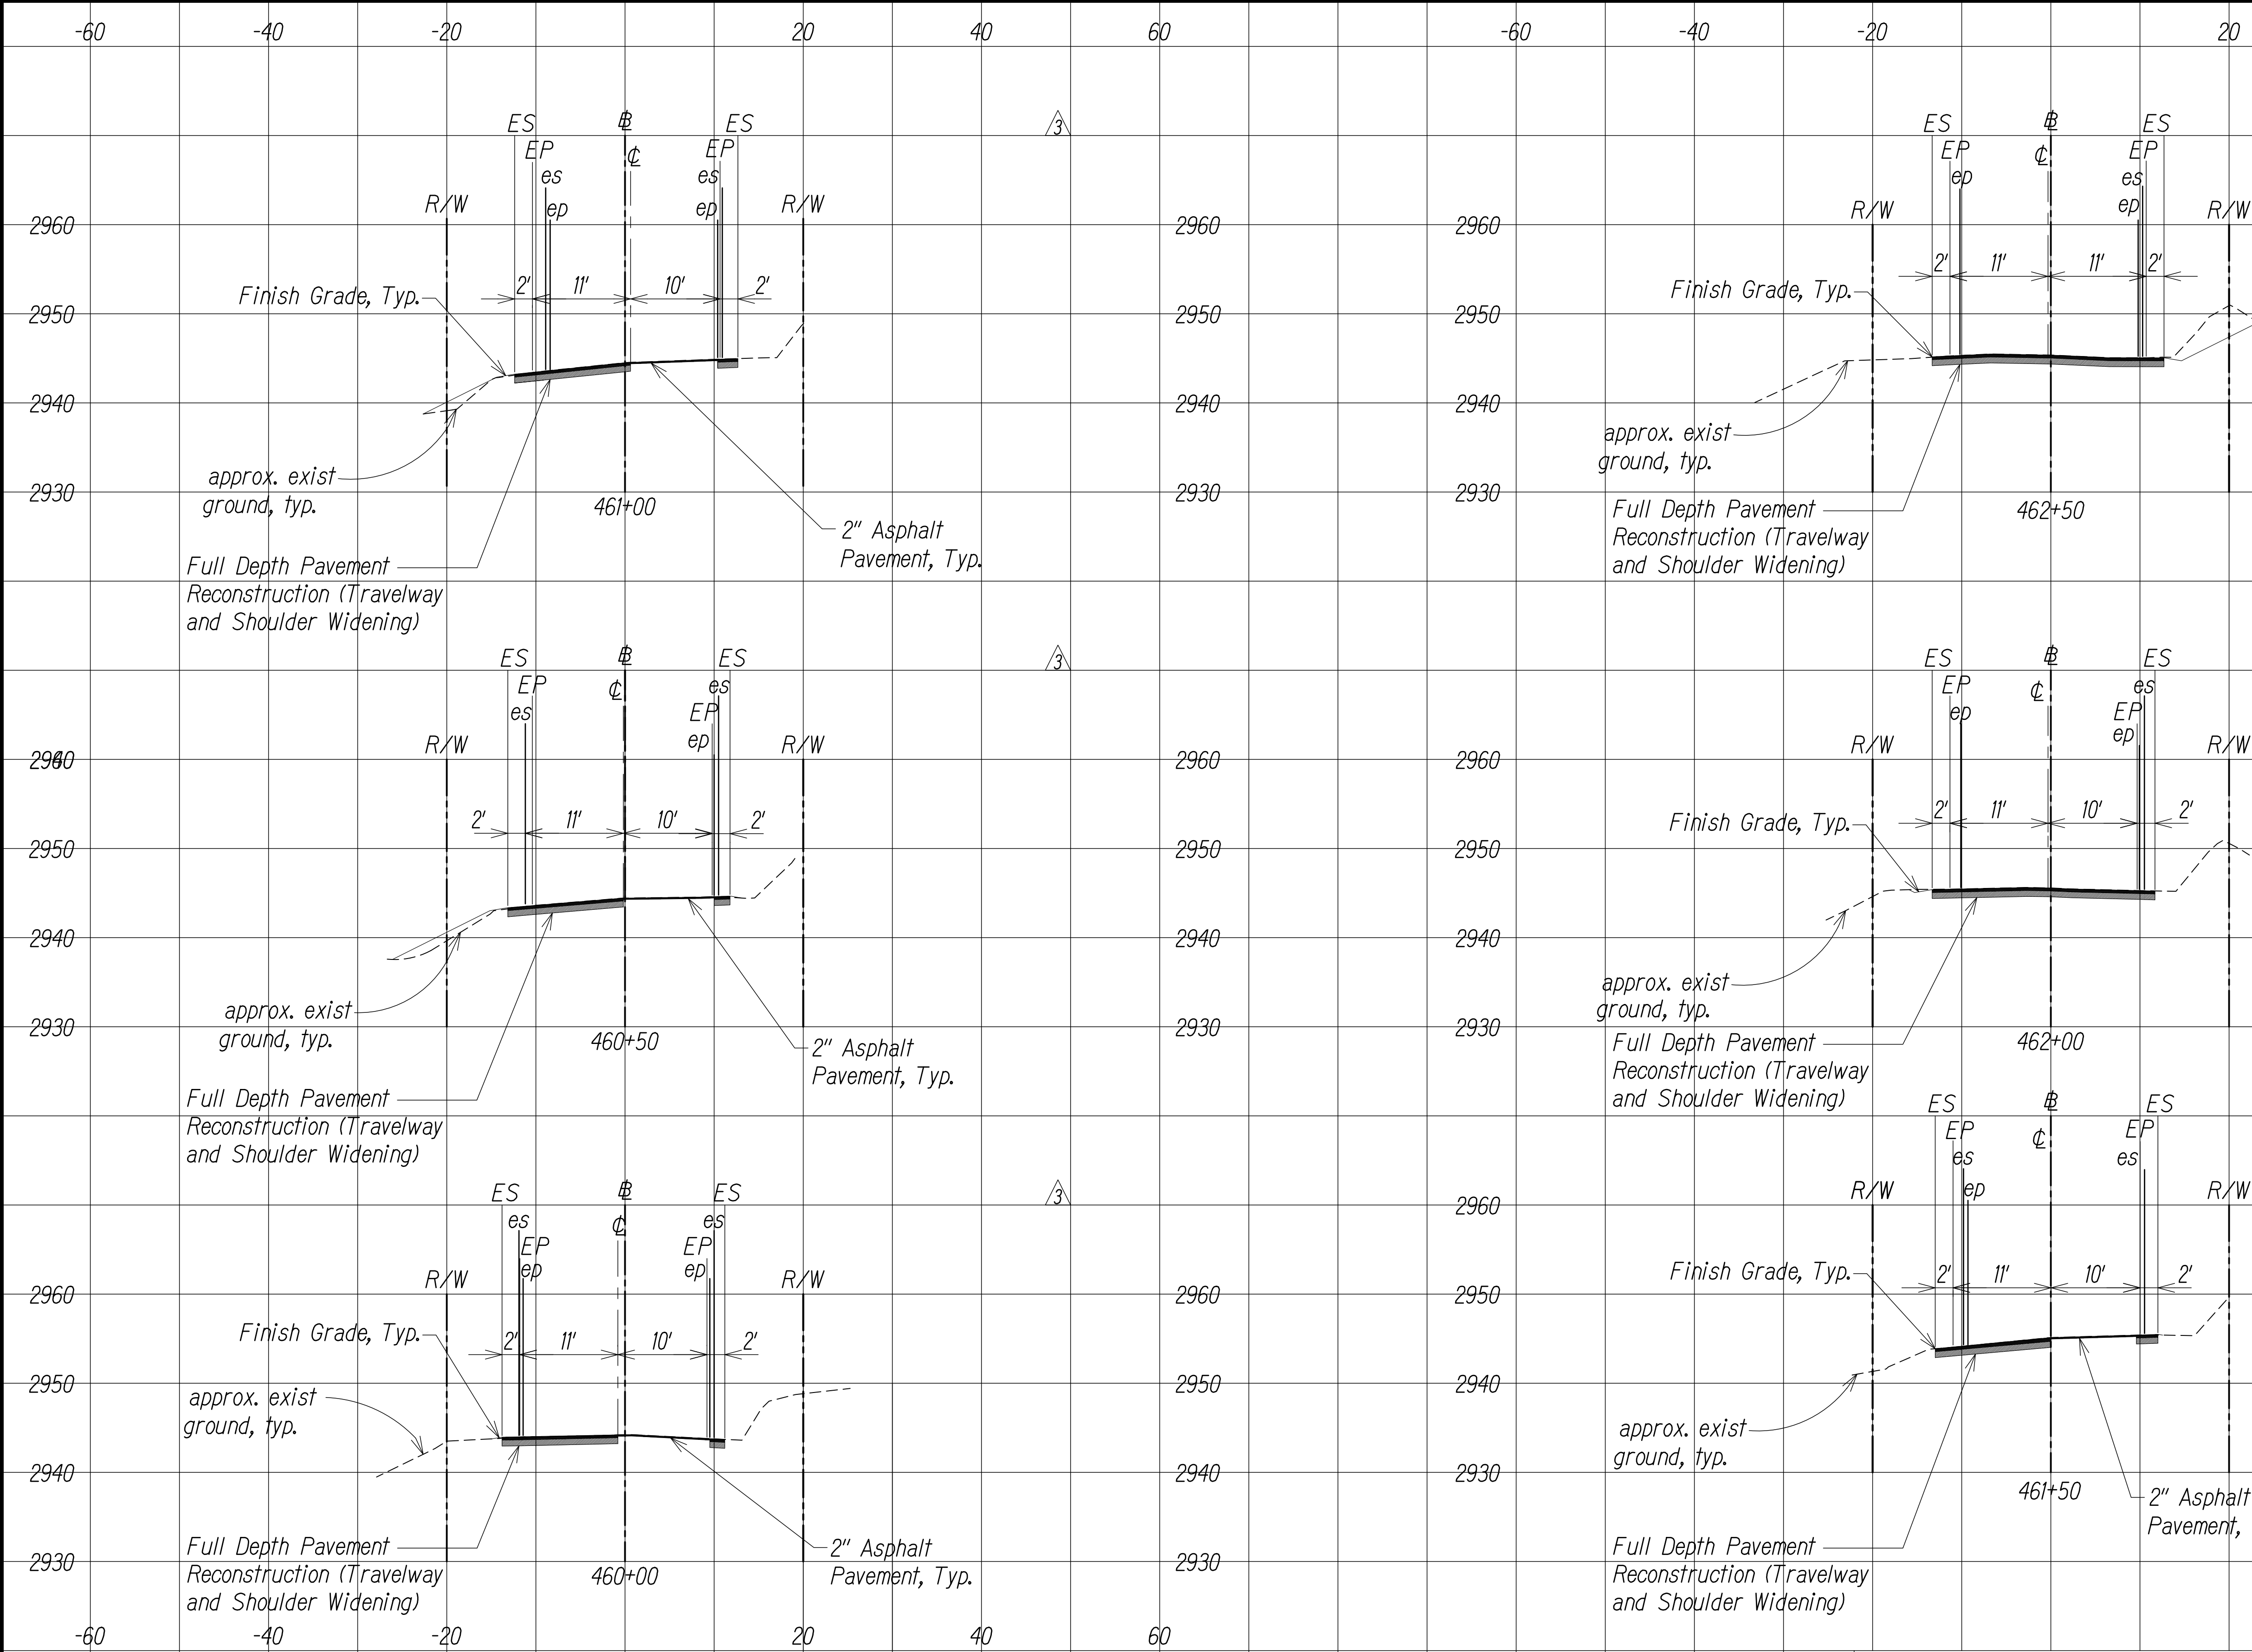

SURVEY PLOTTED BY	DATE
DESIGNED BY	
TRACED BY	
QUANTITIES BY	
CHECKED BY	


ORIGINAL PLAN	No.
NOTE BOOK	

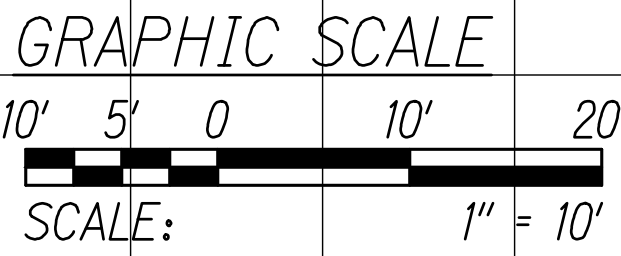

KOKEE ROAD
Scale: 1" = 10'

12/13/24 3 Revised Sections

DATE REVISION

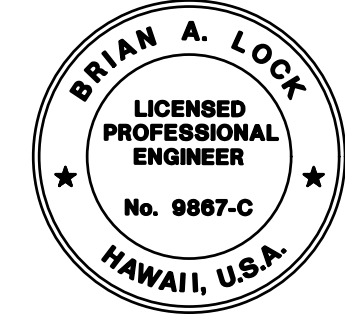


THIS WORK WAS PREPARED BY ME OR UNDER MY SUPERVISION.
WILSON OKAMOTO CORPORATION
APRIL 30, 2026
LIC. EXP. DATE

STATE OF HAWAII
DEPARTMENT OF TRANSPORTATION
HIGHWAYS DIVISION

ROADWAY CROSS SECTIONS


WAIMEA CANYON DRIVE /
KOKEE ROAD IMPROVEMENTS, PHASE 2B
MILE POST 4.6 TO MILE POST 11.5
Federal-Aid Project No. STP-0550(006)
Scale: 1" = 10' Date: July 2024

SHEET No. X75 OF 122 SHEETS

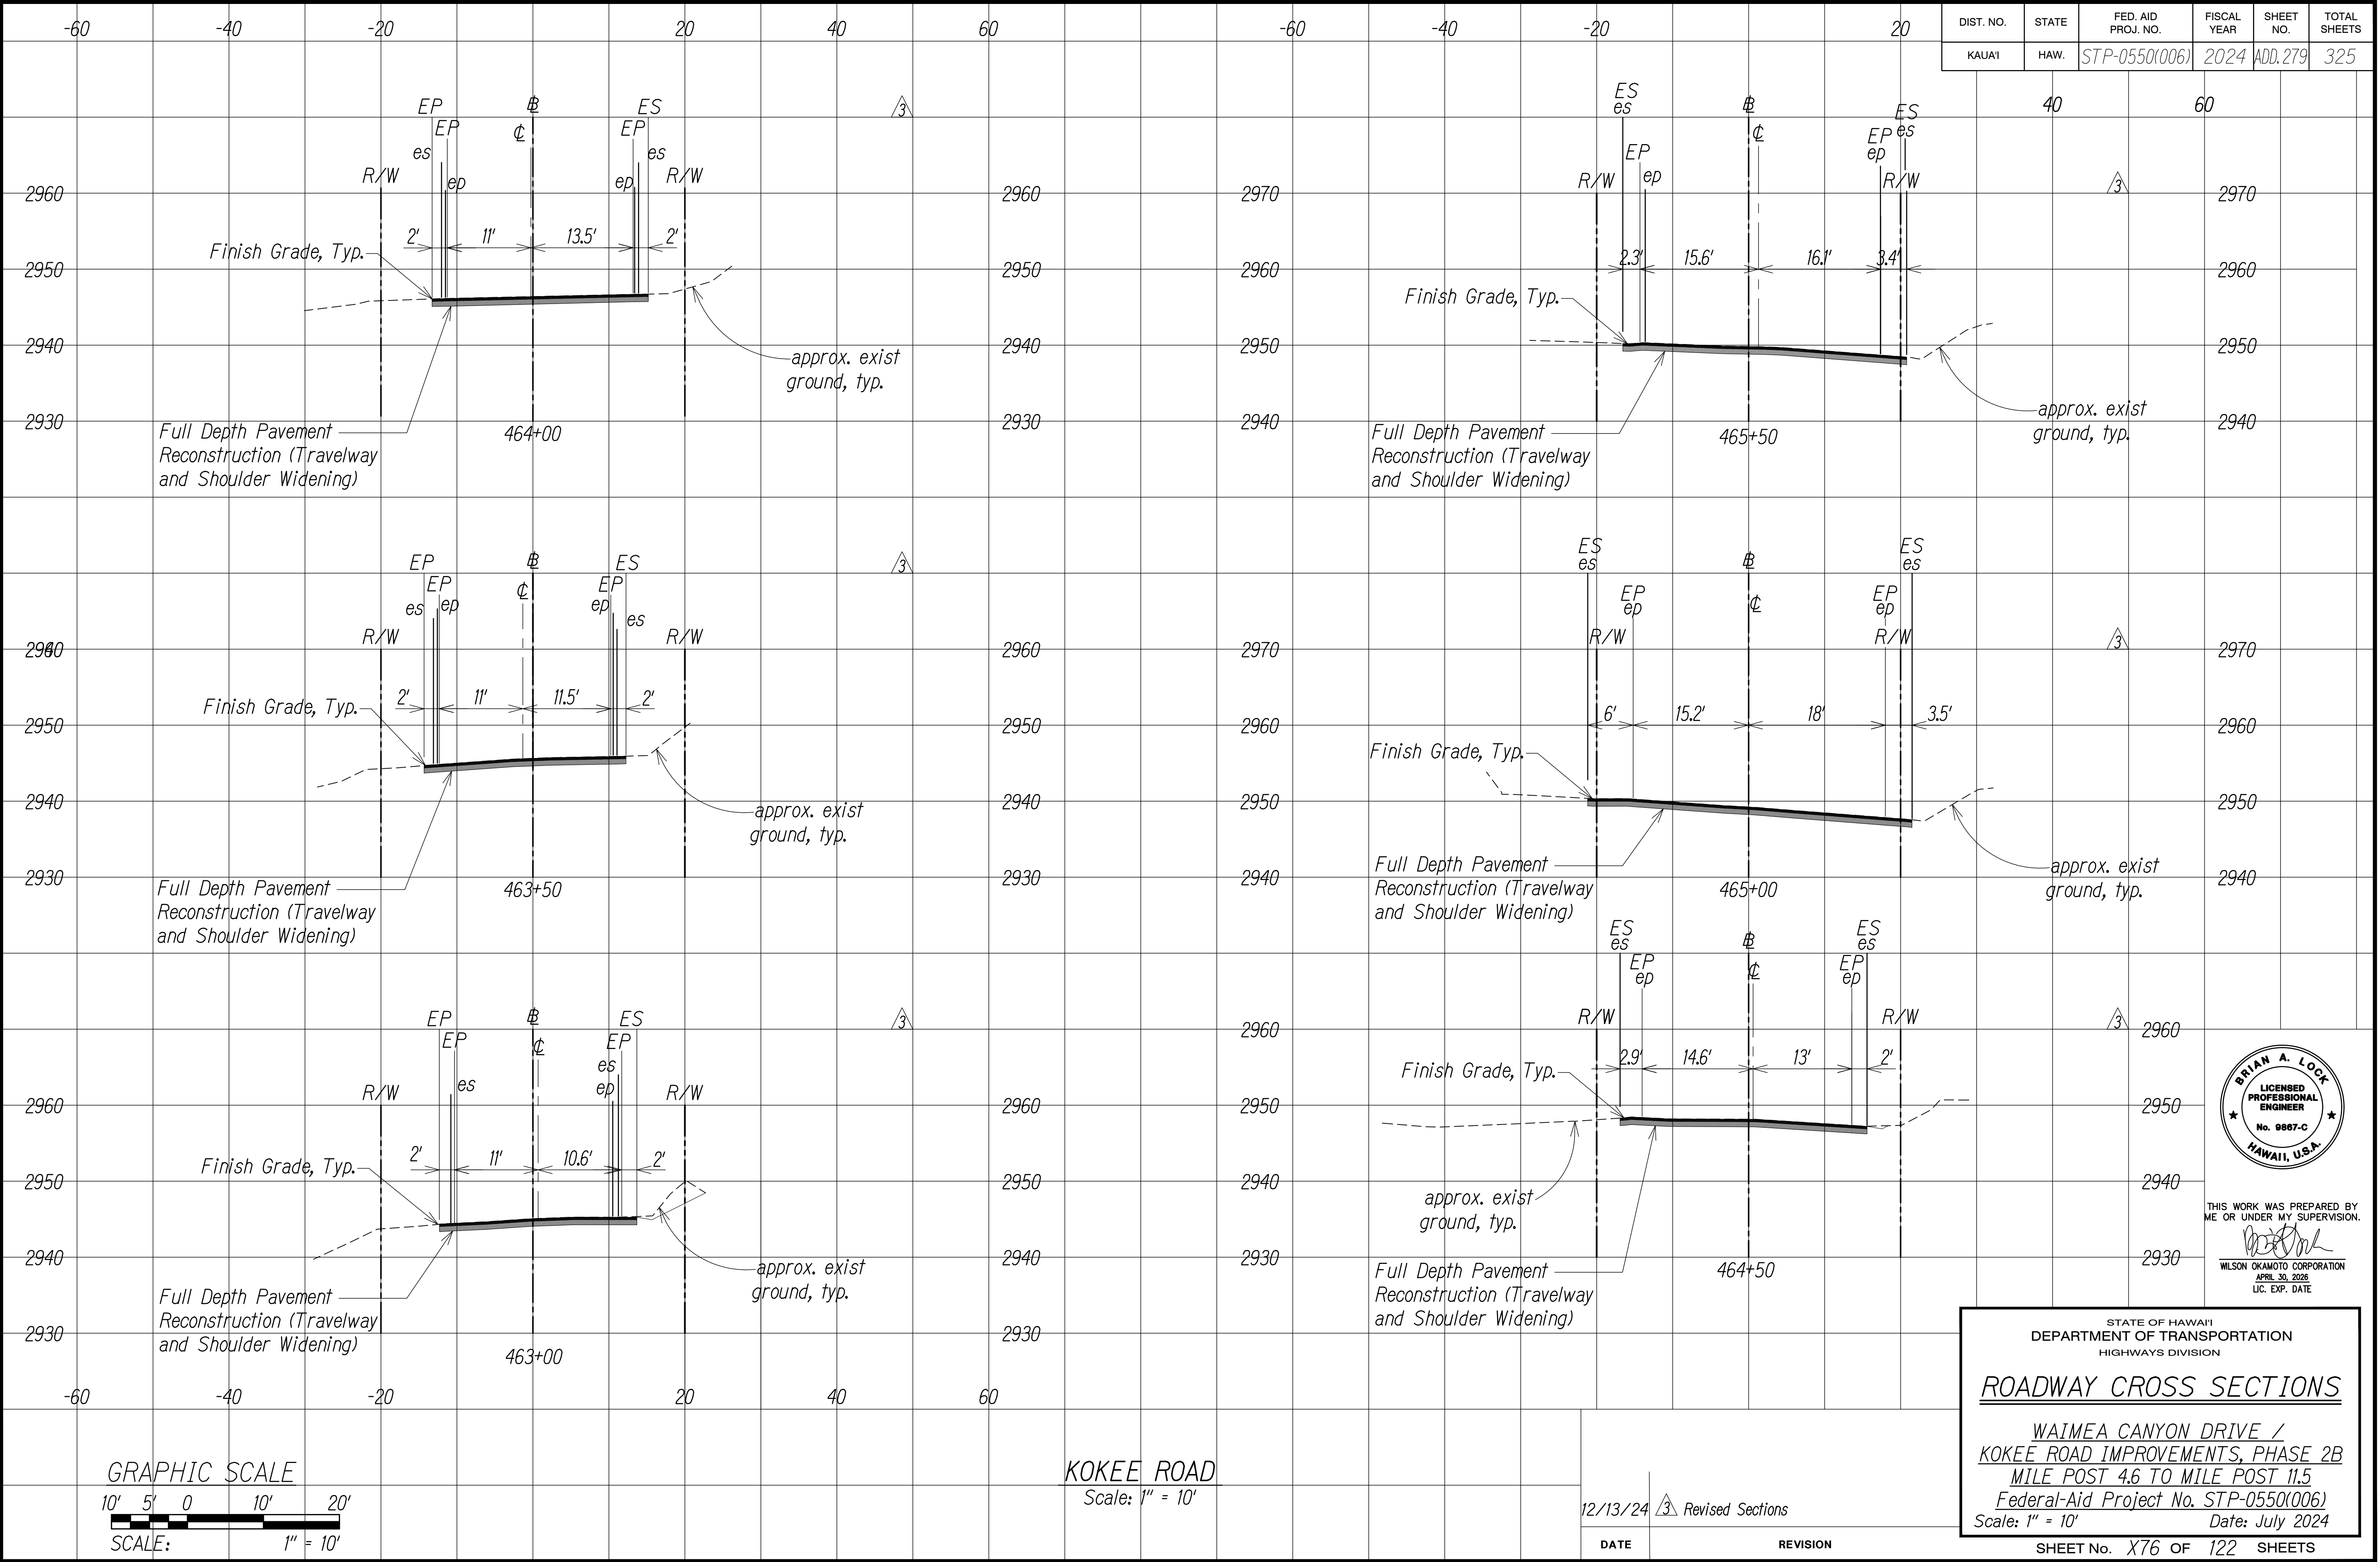


SURVEY PLOTTED BY	DATE
DESIGNED BY	
TRACED BY	
QUANTITIES BY	
CHECKED BY	

ORIGINAL PLAN	No.
NOTE BOOK	

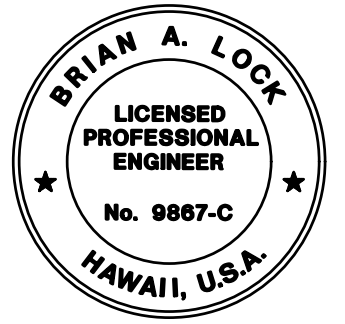


THIS WORK WAS PREPARED BY
ME OR UNDER MY SUPERVISION.
[Signature]
WILSON OKAMOTO CORPORATION
APRIL 30, 2026
LIC. EXP. DATE

DIST. NO.	STATE	FED. AID PROJ. NO.	FISCAL YEAR	SHEET NO.	TOTAL SHEETS
KAUA'I	HAW.	STP-0550(006)	2024	ADD.280	325

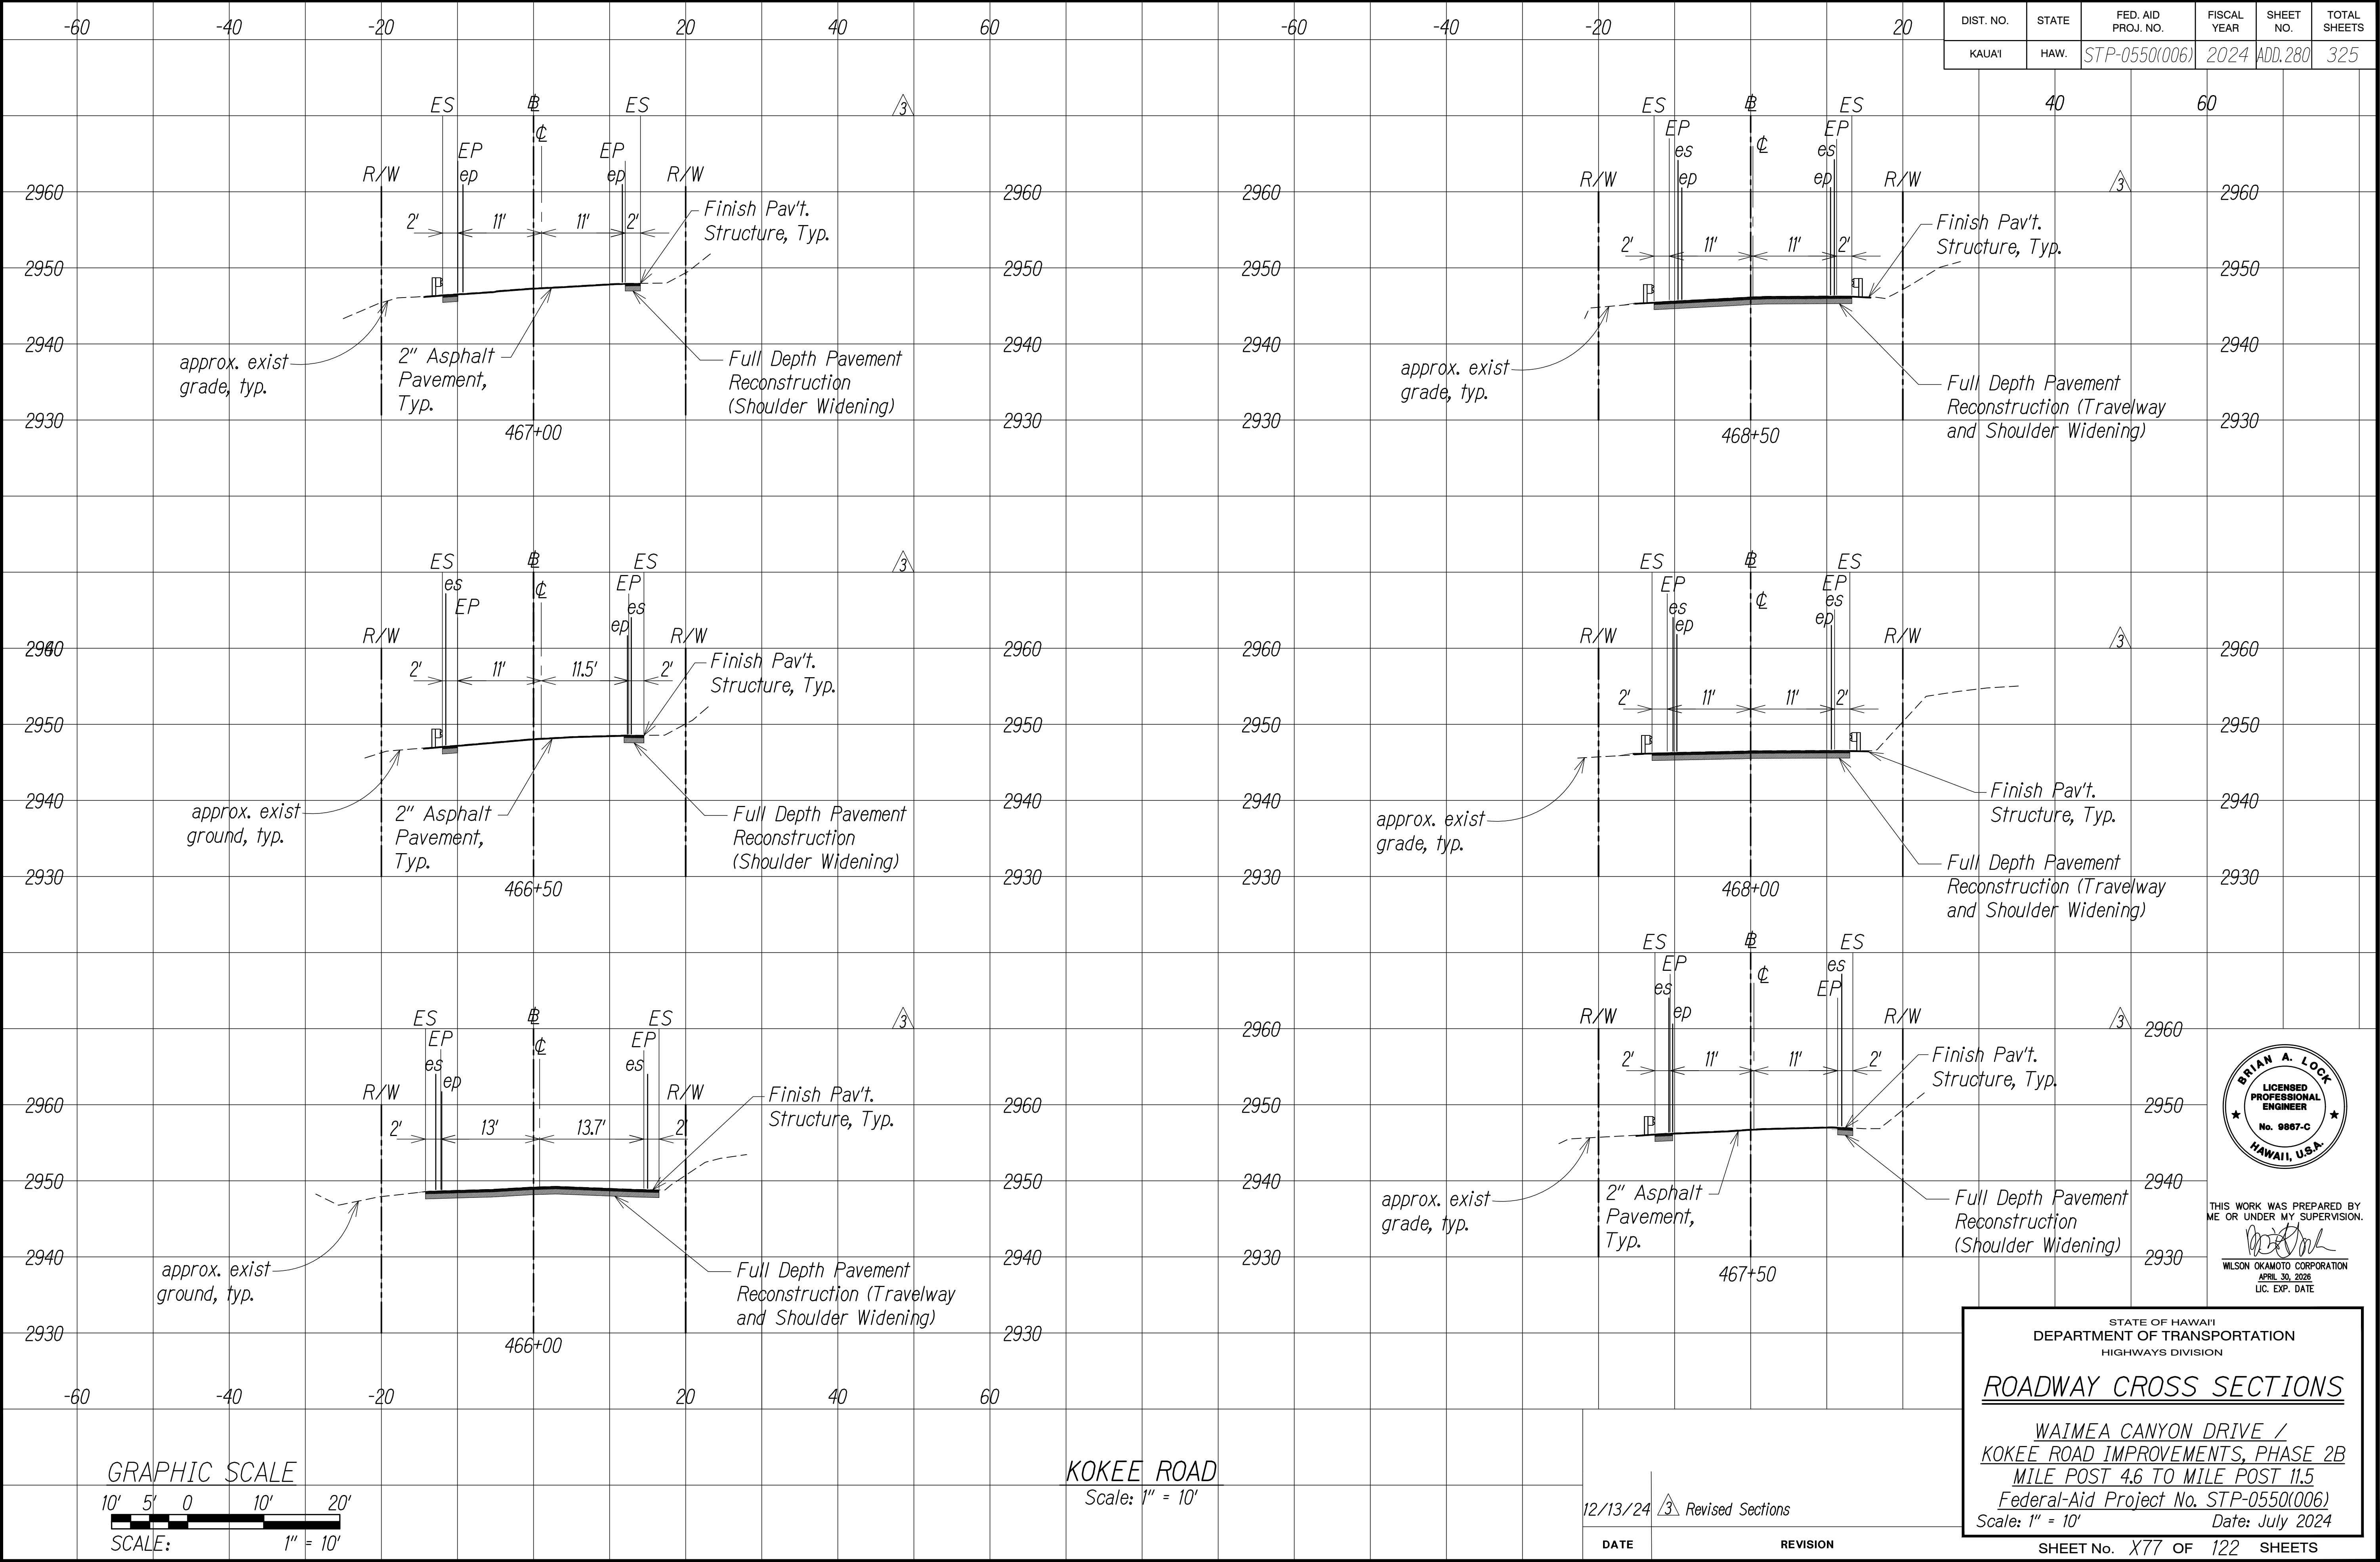

SURVEY PLOTTED BY	DATE
DESIGNED BY	
TRACED BY	
NOTED BY	
QUANTITIES BY	
CHECKED BY	

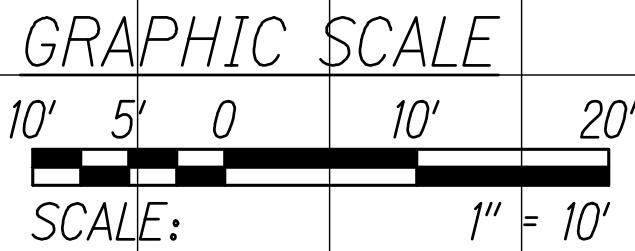

KOKEE ROAD
Scale: 1" = 10'

12/13/24 3 Revised Sections


DATE REVISION

STATE OF HAWAII
DEPARTMENT OF TRANSPORTATION
HIGHWAYS DIVISION


ROADWAY CROSS SECTIONS

WAIMEA CANYON DRIVE /
KOKEE ROAD IMPROVEMENTS, PHASE 2B
MILE POST 4.6 TO MILE POST 11.5
Federal-Aid Project No. STP-0550(006)
Scale: 1" = 10' Date: July 2024

SHEET No. X77 OF 122 SHEETS

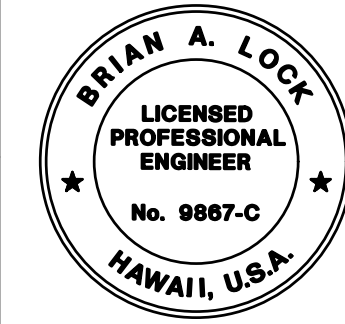


THIS WORK WAS PREPARED BY
ME OR UNDER MY SUPERVISION.
[Signature]
WILSON OKAMOTO CORPORATION
APRIL 30, 2026
LIC. EXP. DATE

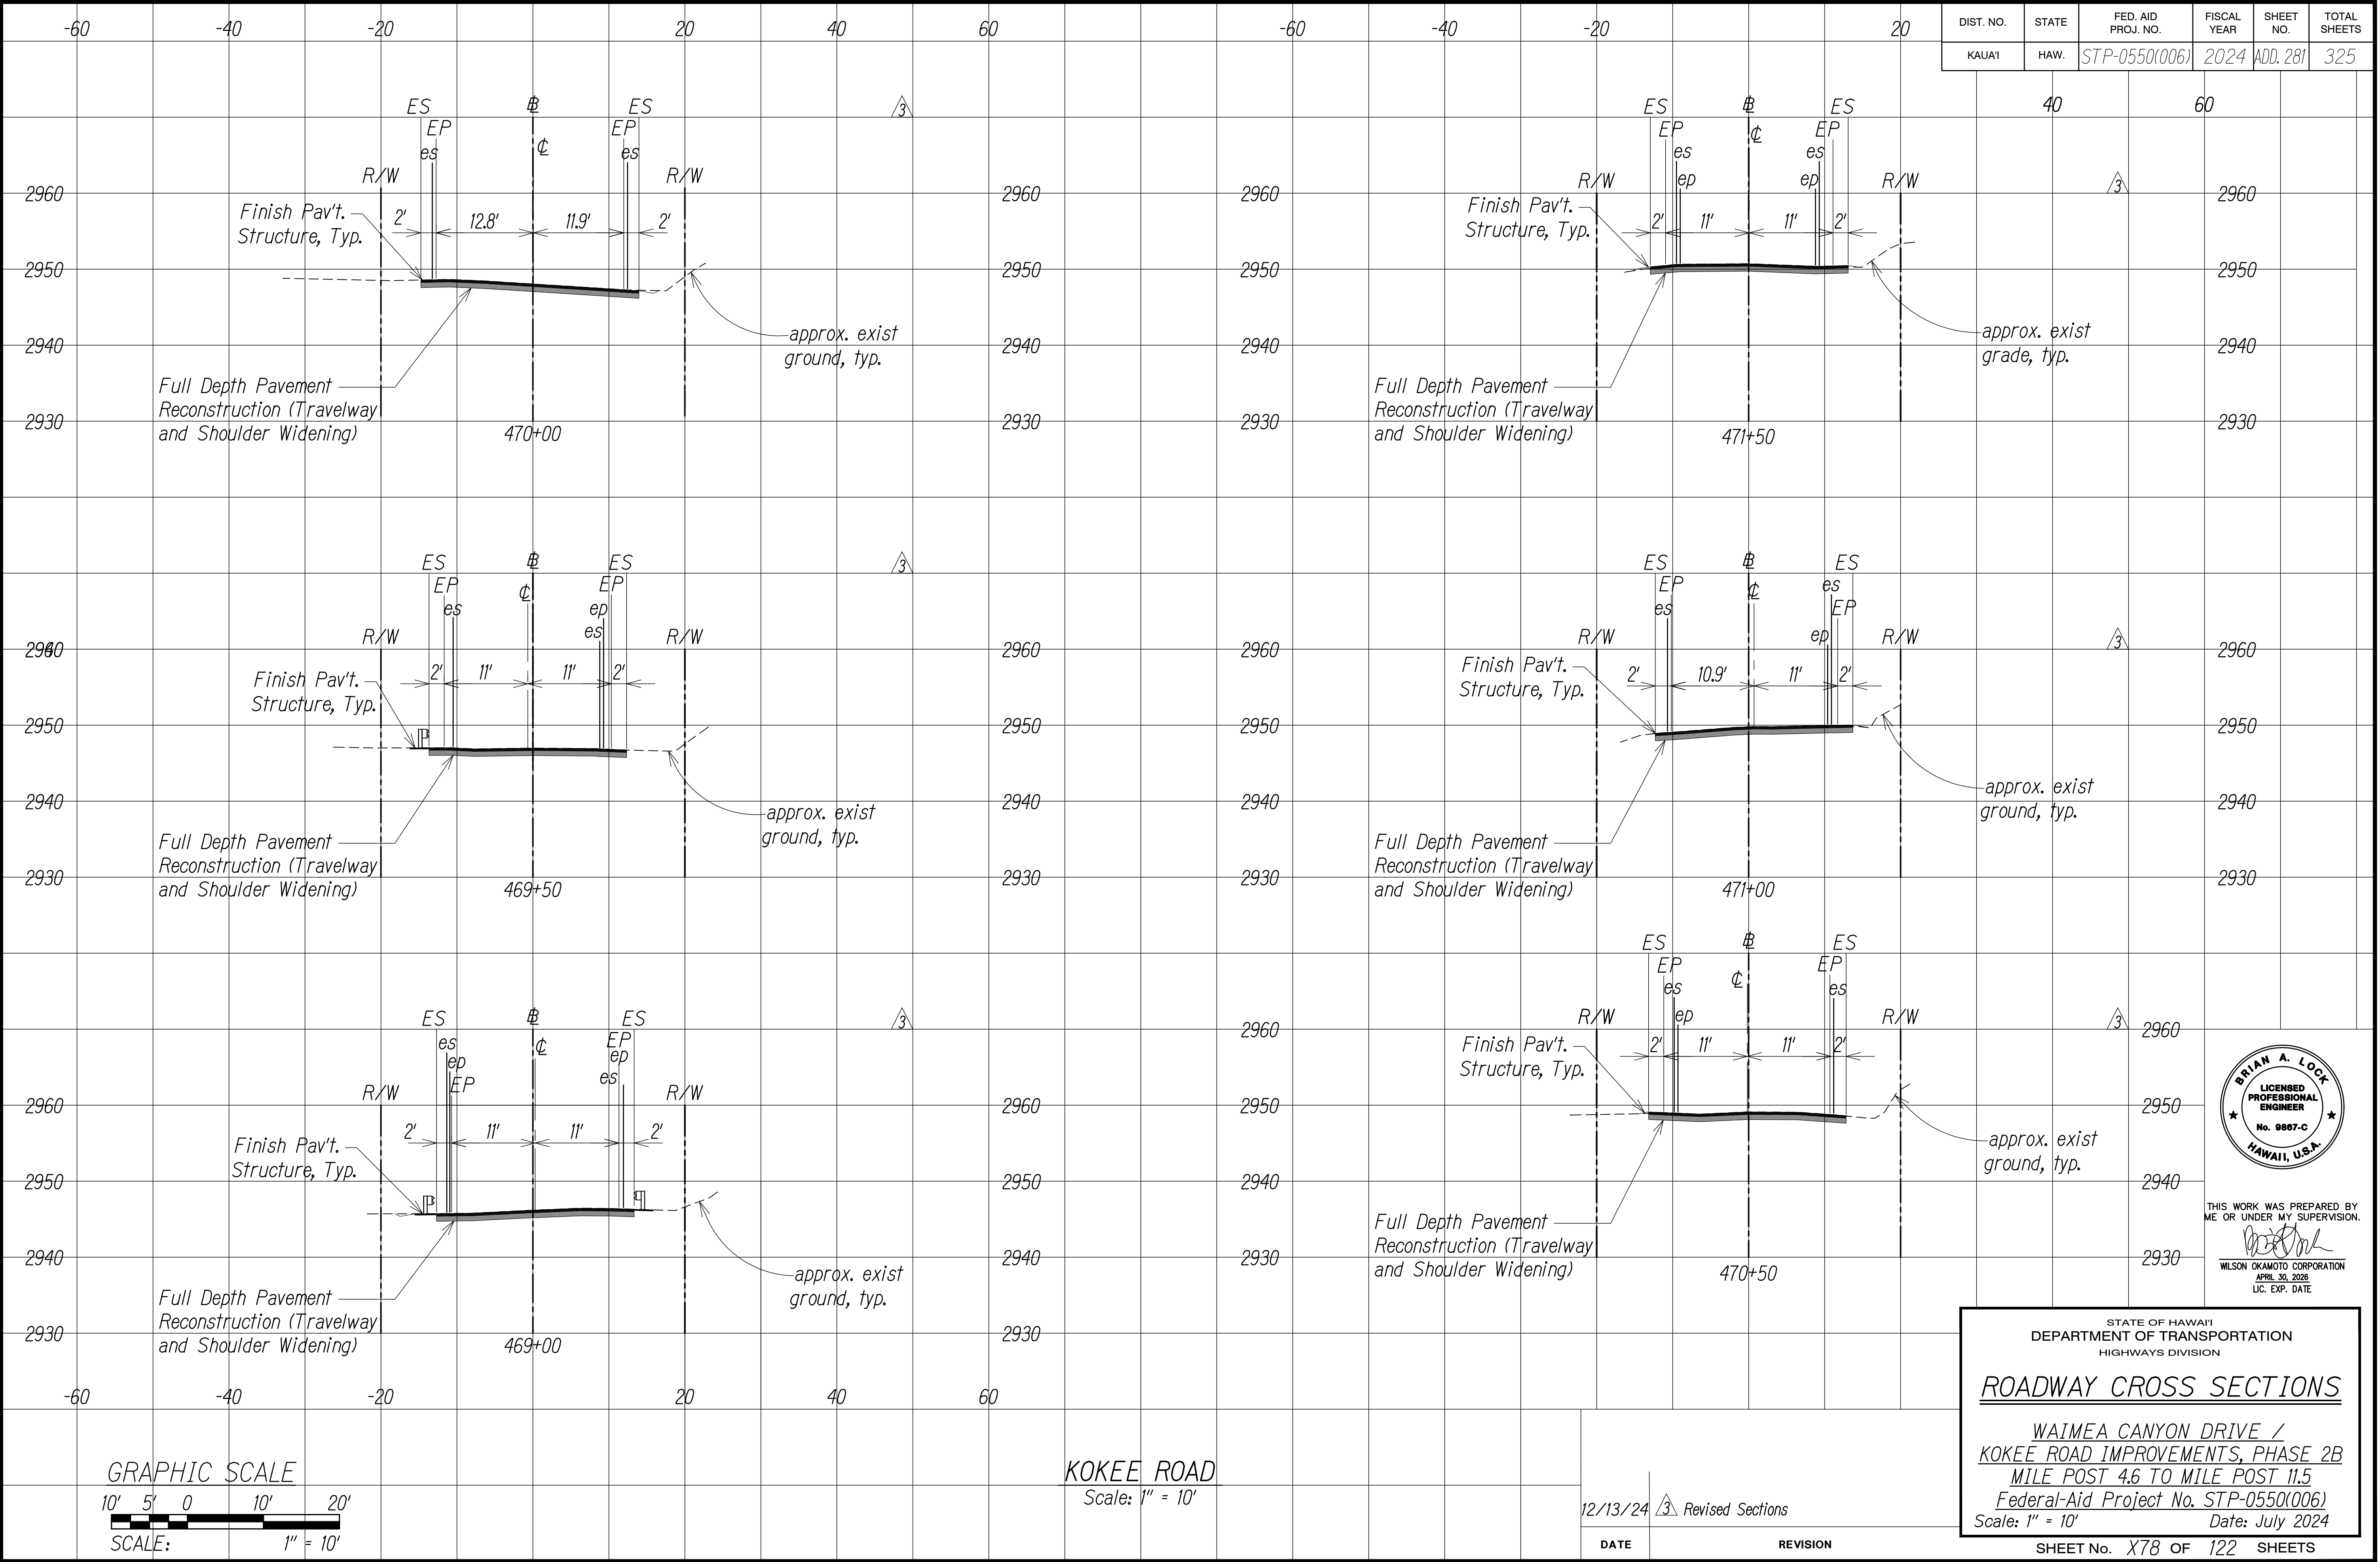

SURVEY PLOTTED BY	DATE
DESIGNED BY	
TRACED BY	
QUANTITIES BY	
CHECKED BY	

ORIGINAL PLAN	No.
NOTE BOOK	

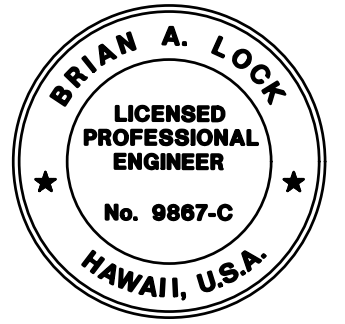

THIS WORK WAS PREPARED BY
ME OR UNDER MY SUPERVISION.
[Signature]
WILSON OKAMOTO CORPORATION
APRIL 30, 2024
LIC. EXP. DATE


STATE OF HAWAII
DEPARTMENT OF TRANSPORTATION
HIGHWAYS DIVISION
ROADWAY CROSS SECTIONS
WAIMEA CANYON DRIVE /
KOKEE ROAD IMPROVEMENTS, PHASE 2B
MILE POST 4.6 TO MILE POST 11.5
Federal-Aid Project No. STP-0550(006)
Scale: 1" = 10' Date: July 2024

12/13/24 3 Revised Sections

DATE REVISION


SHEET No. X78 OF 122 SHEETS

DIST. NO.	STATE	FED. AID PROJ. NO.	FISCAL YEAR	SHEET NO.	TOTAL SHEETS
KAUAI	HAW.	STP-0550(006)	2024	ADD.282	325

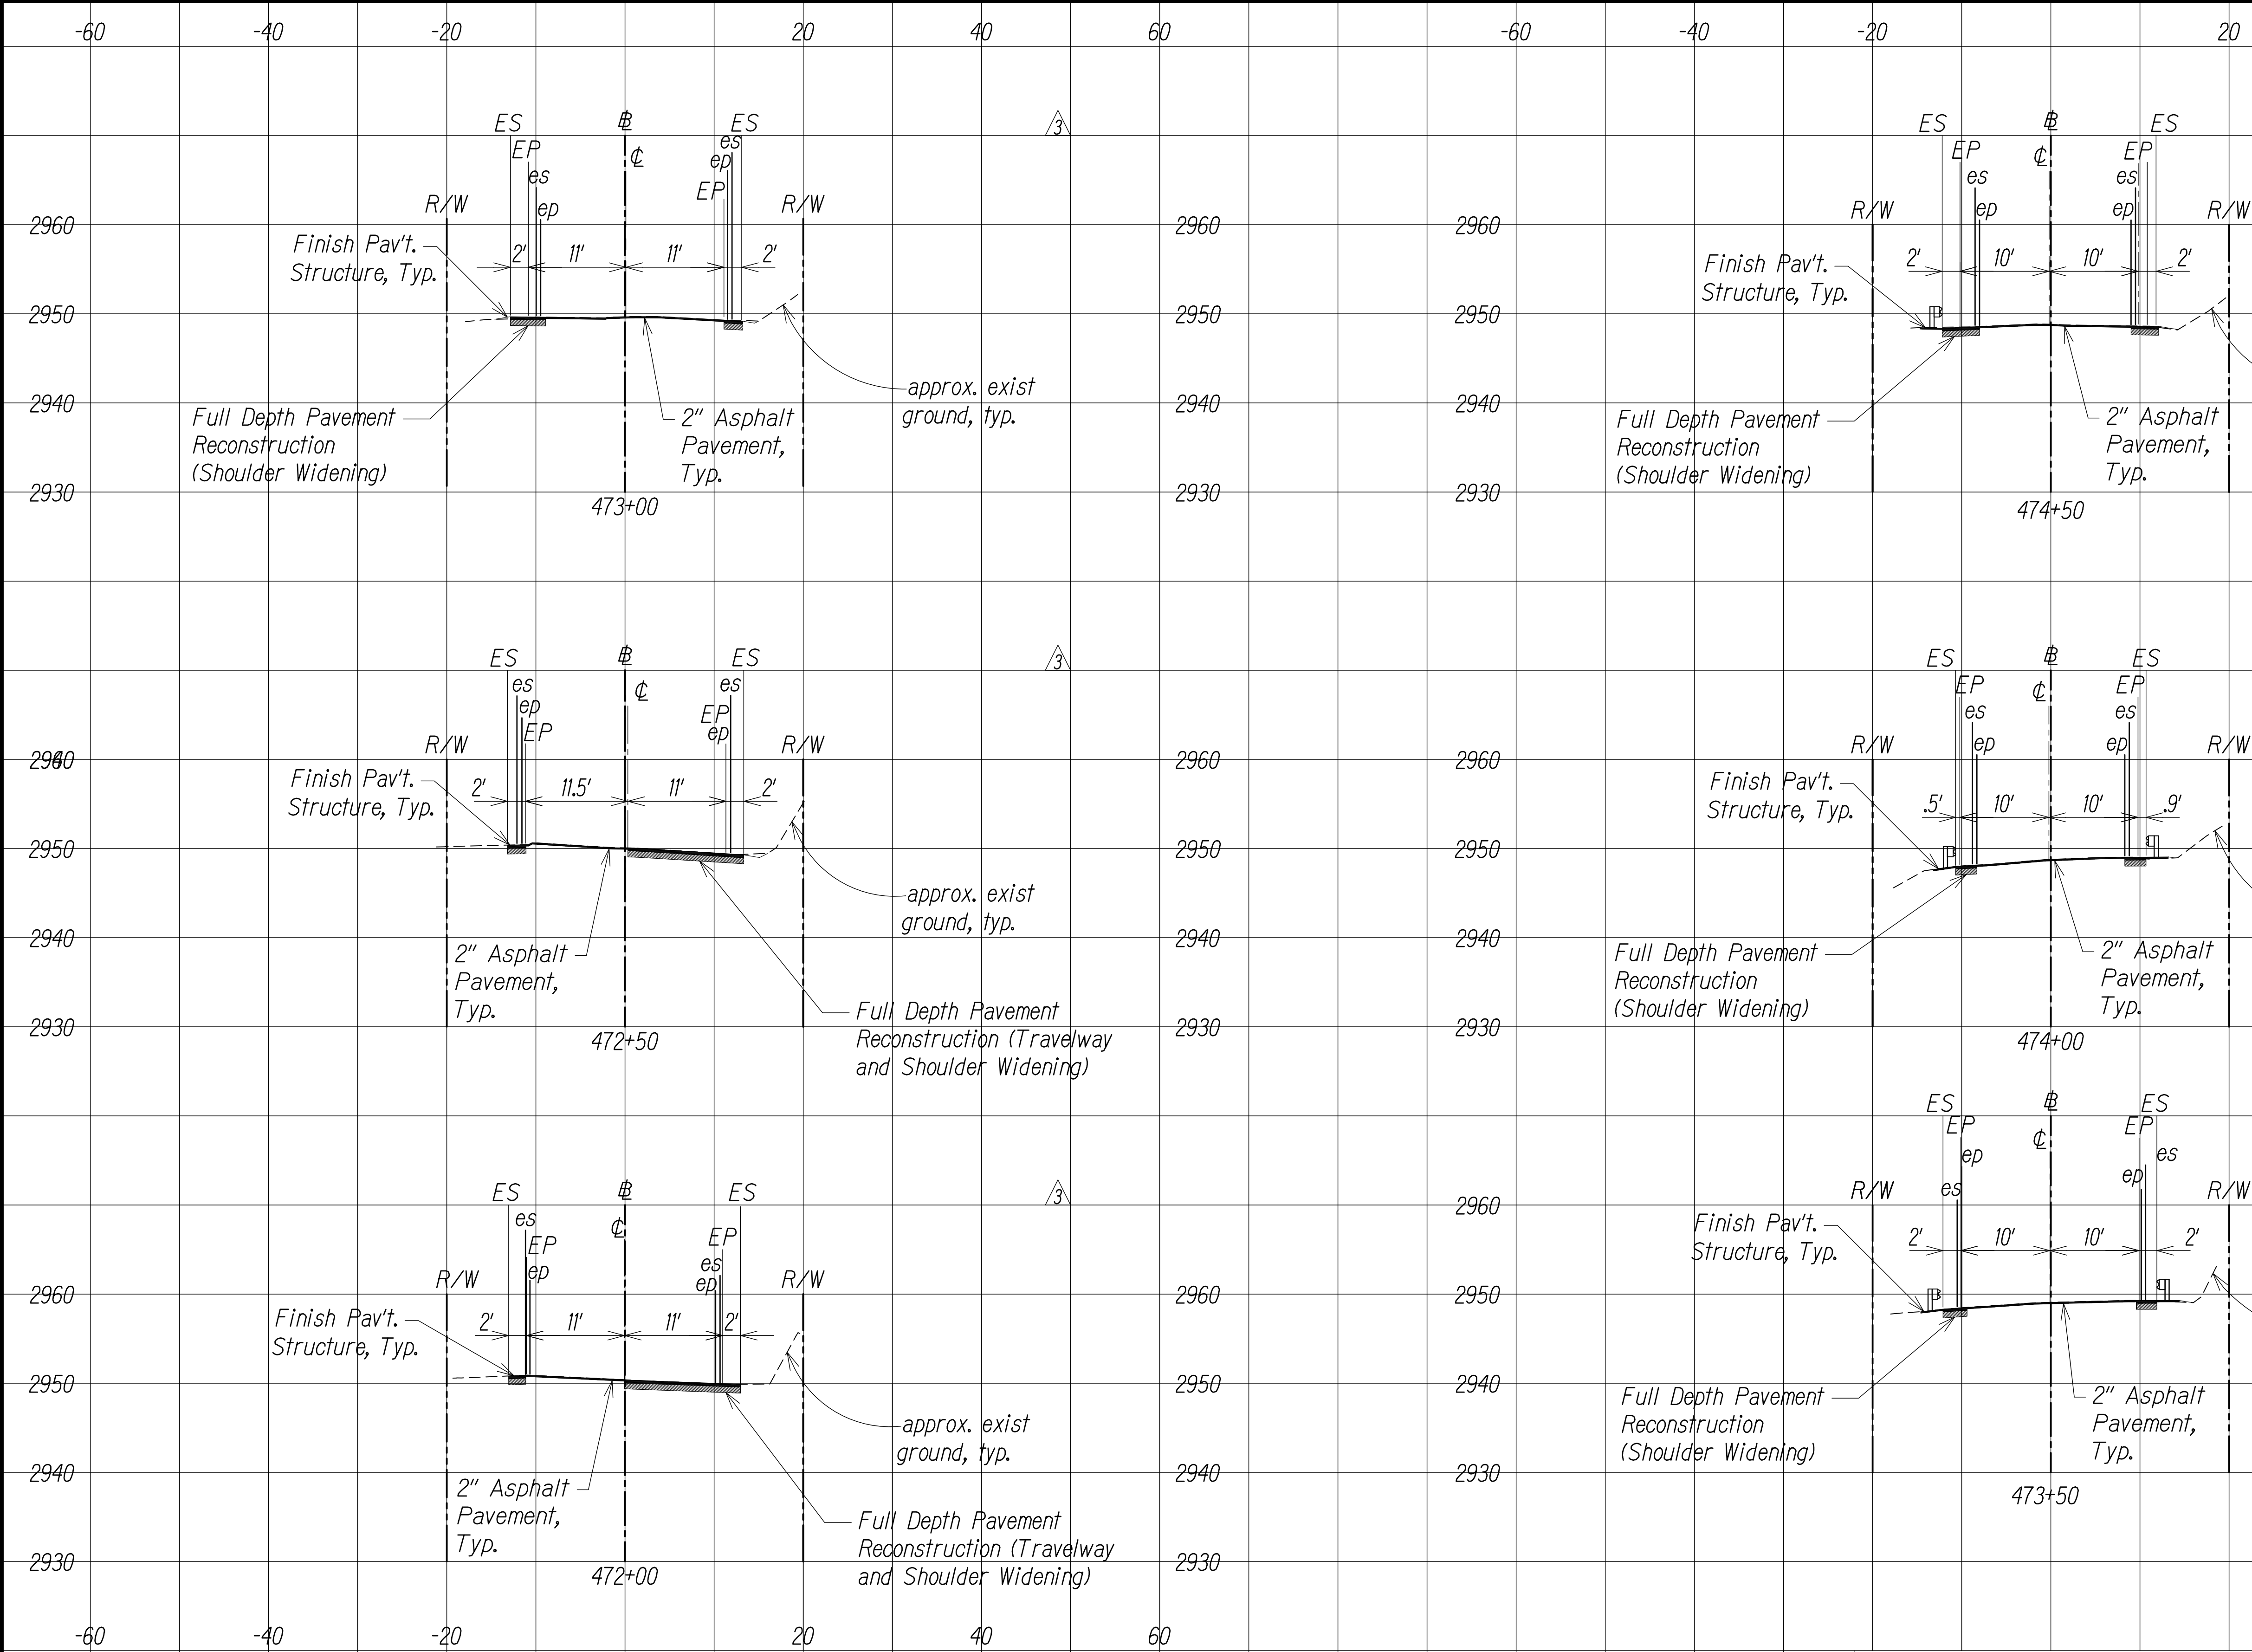


SURVEY PLOTTED BY	DATE
DESIGNED BY	
TRACED BY	
QUANTITIES BY	
CHECKED BY	

ORIGINAL PLAN	No.
NOTE BOOK	

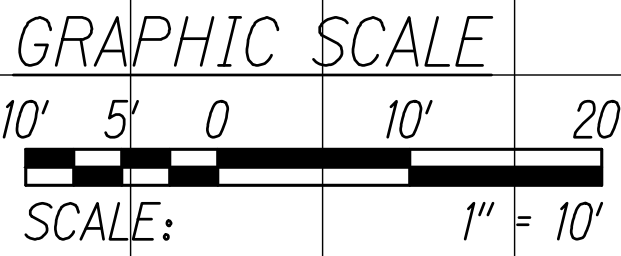

KOKEE ROAD
Scale: 1" = 10'

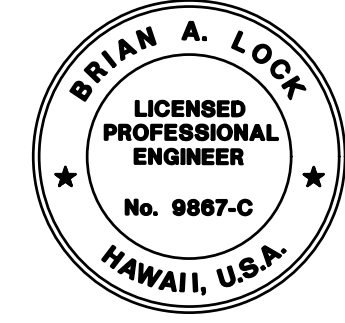

THIS WORK WAS PREPARED BY ME OR UNDER MY SUPERVISION.
[Signature]
WILSON OKAMOTO CORPORATION
APRIL 30, 2026
LIC. EXP. DATE

STATE OF HAWAII
DEPARTMENT OF TRANSPORTATION
HIGHWAYS DIVISION


ROADWAY CROSS SECTIONS

WAIMEA CANYON DRIVE /
KOKEE ROAD IMPROVEMENTS, PHASE 2B
MILE POST 4.6 TO MILE POST 11.5
Federal-Aid Project No. STP-0550(006)
Scale: 1" = 10' Date: July 2024

DATE: 12/13/24 REVISION: 3 Revised Sections


SHEET No. X79 OF 122 SHEETS

DIST. NO.	STATE	FED. AID PROJ. NO.	FISCAL YEAR	SHEET NO.	TOTAL SHEETS
KAUA'I	HAW.	STP-0550(006)	2024	ADD.283	325

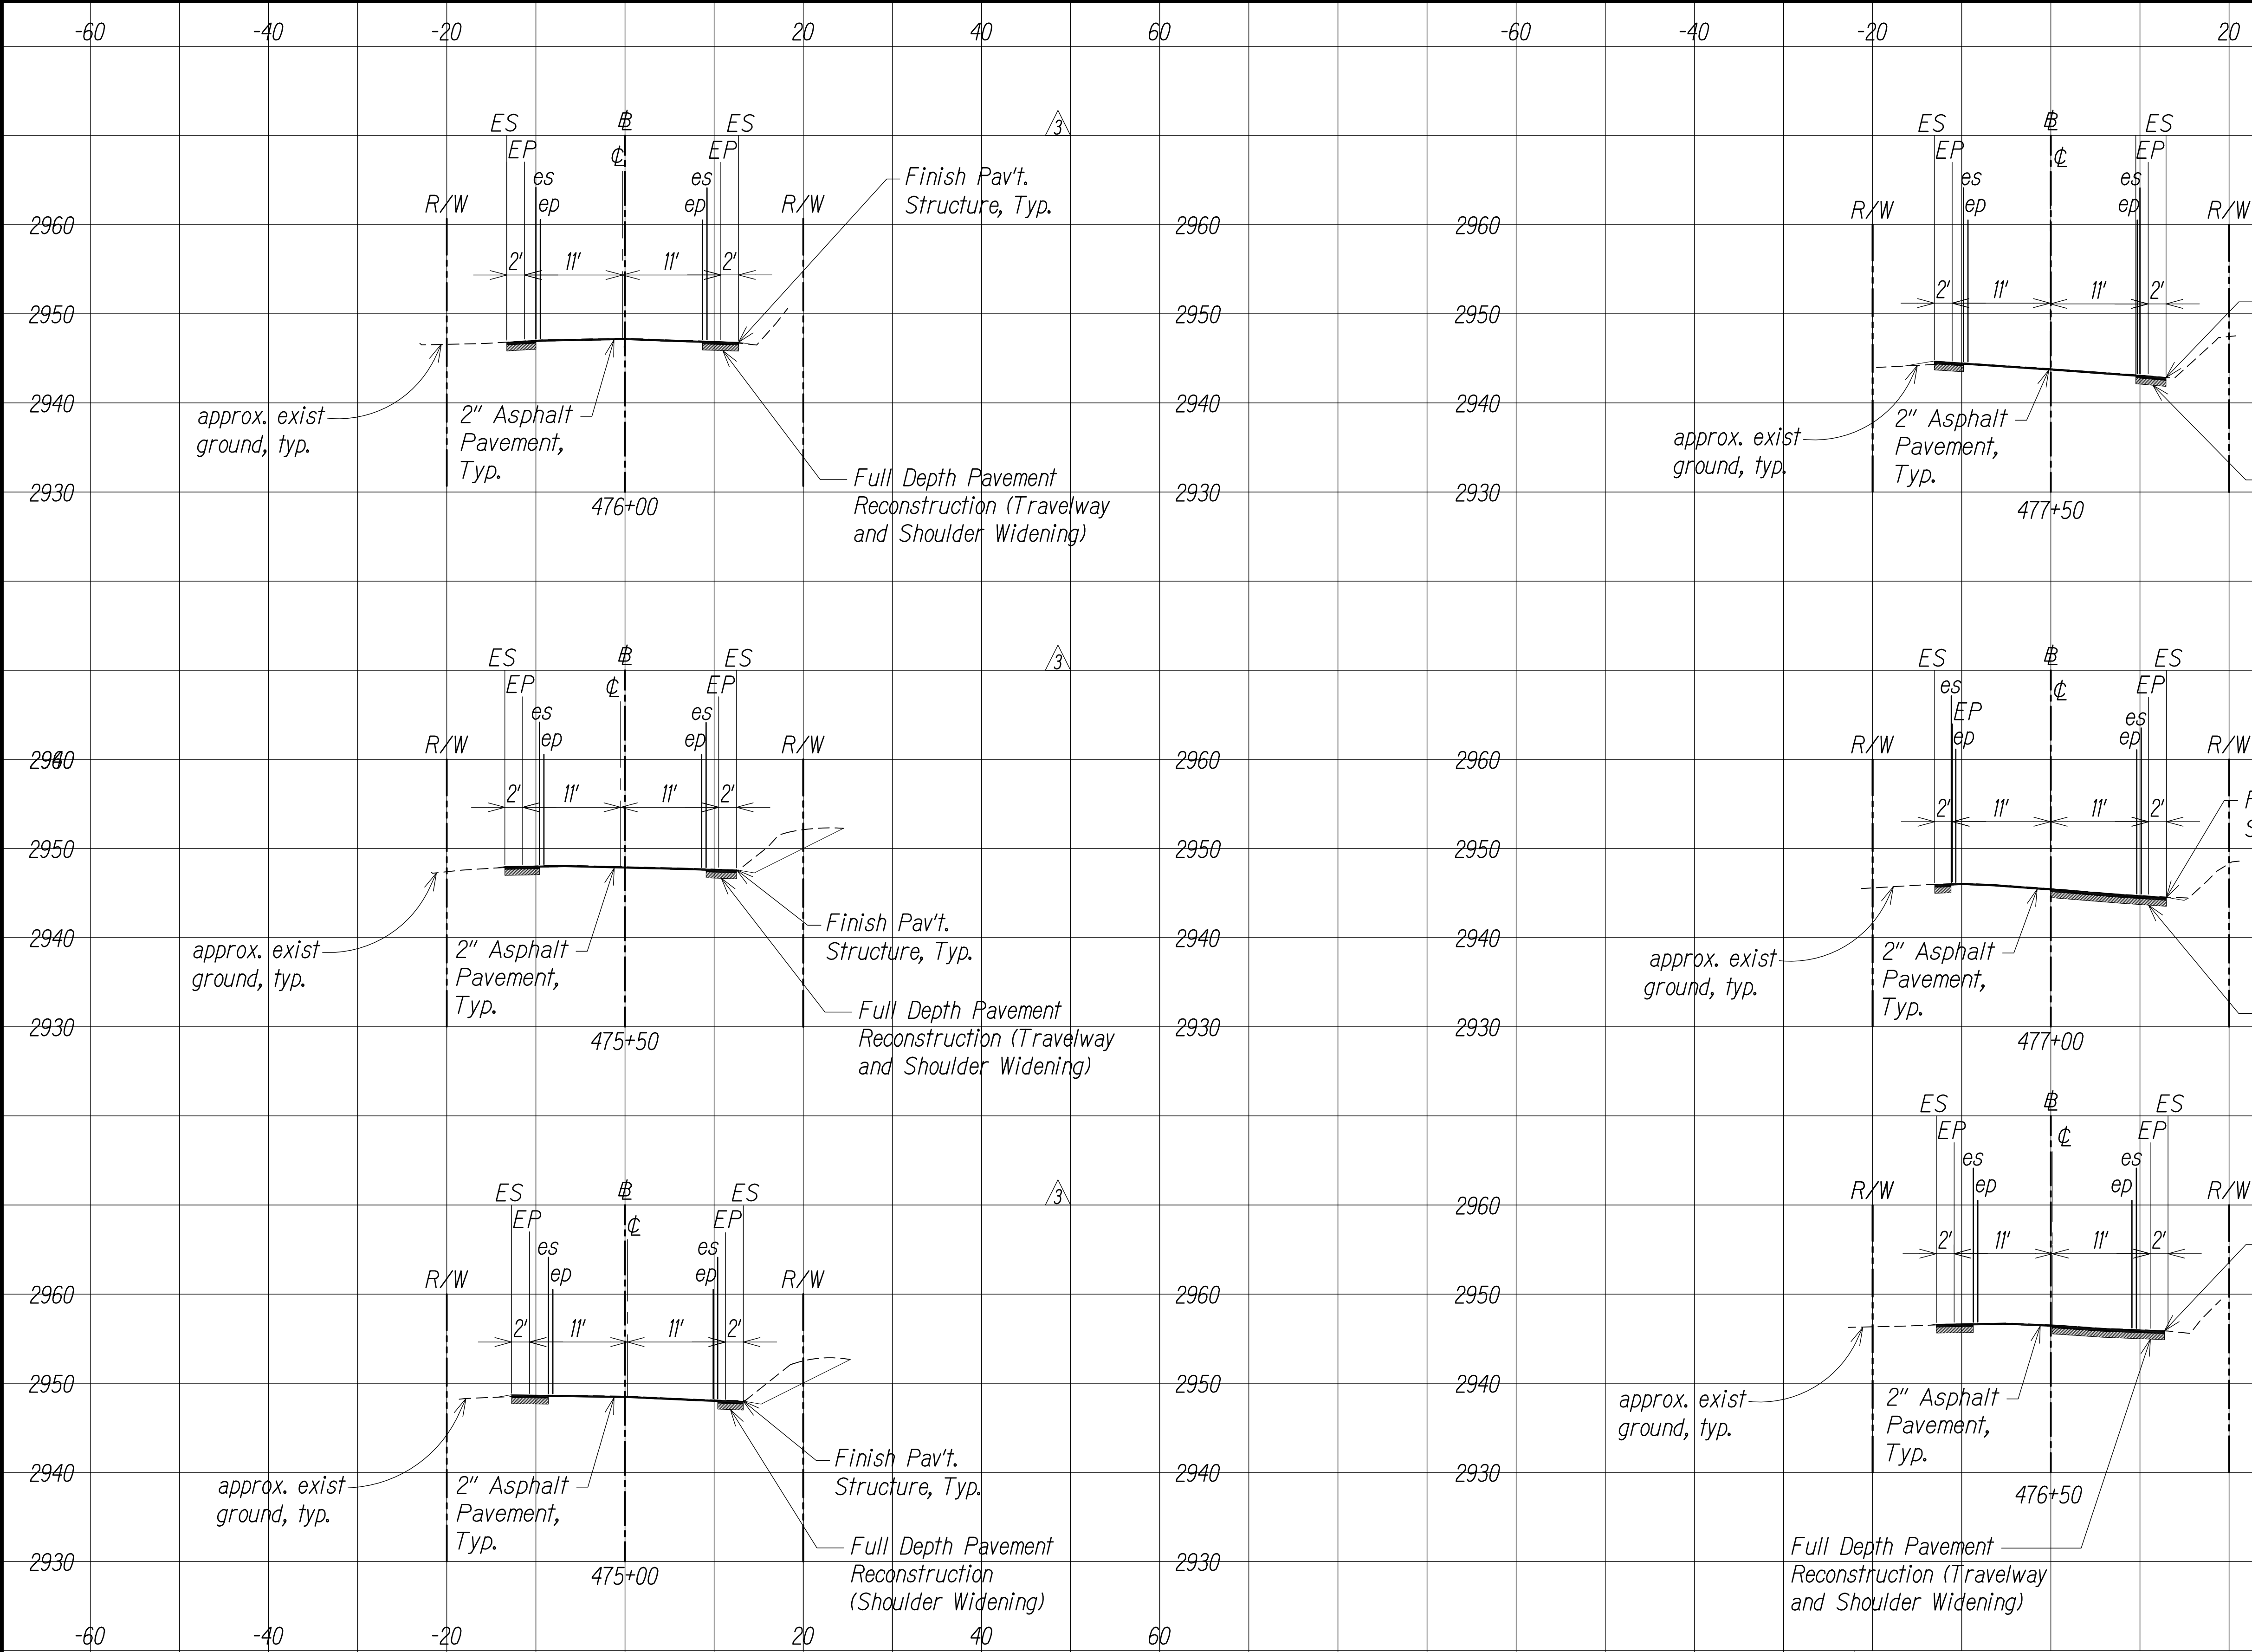

SURVEY PLOTTED BY	DATE
DESIGNED BY	
TRACED BY	
QUANTITIES BY	
CHECKED BY	


ORIGINAL PLAN	NO.
NOTE BOOK	

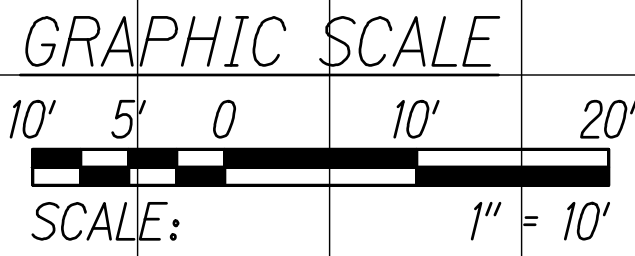

KOKEE ROAD
Scale: 1" = 10'

12/13/24 3 Revised Sections


DATE REVISION

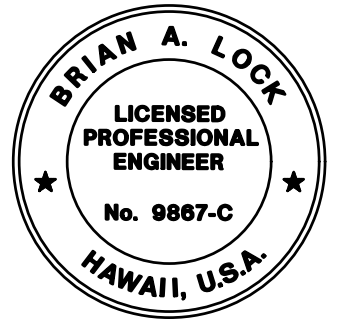

THIS WORK WAS PREPARED BY
ME OR UNDER MY SUPERVISION.
[Signature]
WILSON OKAMOTO CORPORATION
APRIL 30, 2026
LIC. EXP. DATE


STATE OF HAWAII
DEPARTMENT OF TRANSPORTATION
HIGHWAYS DIVISION
ROADWAY CROSS SECTIONS
WAIMEA CANYON DRIVE /
KOKEE ROAD IMPROVEMENTS, PHASE 2B
MILE POST 4.6 TO MILE POST 11.5
Federal-Aid Project No. STP-0550(006)
Scale: 1" = 10' Date: July 2024

SHEET No. X80 OF 122 SHEETS

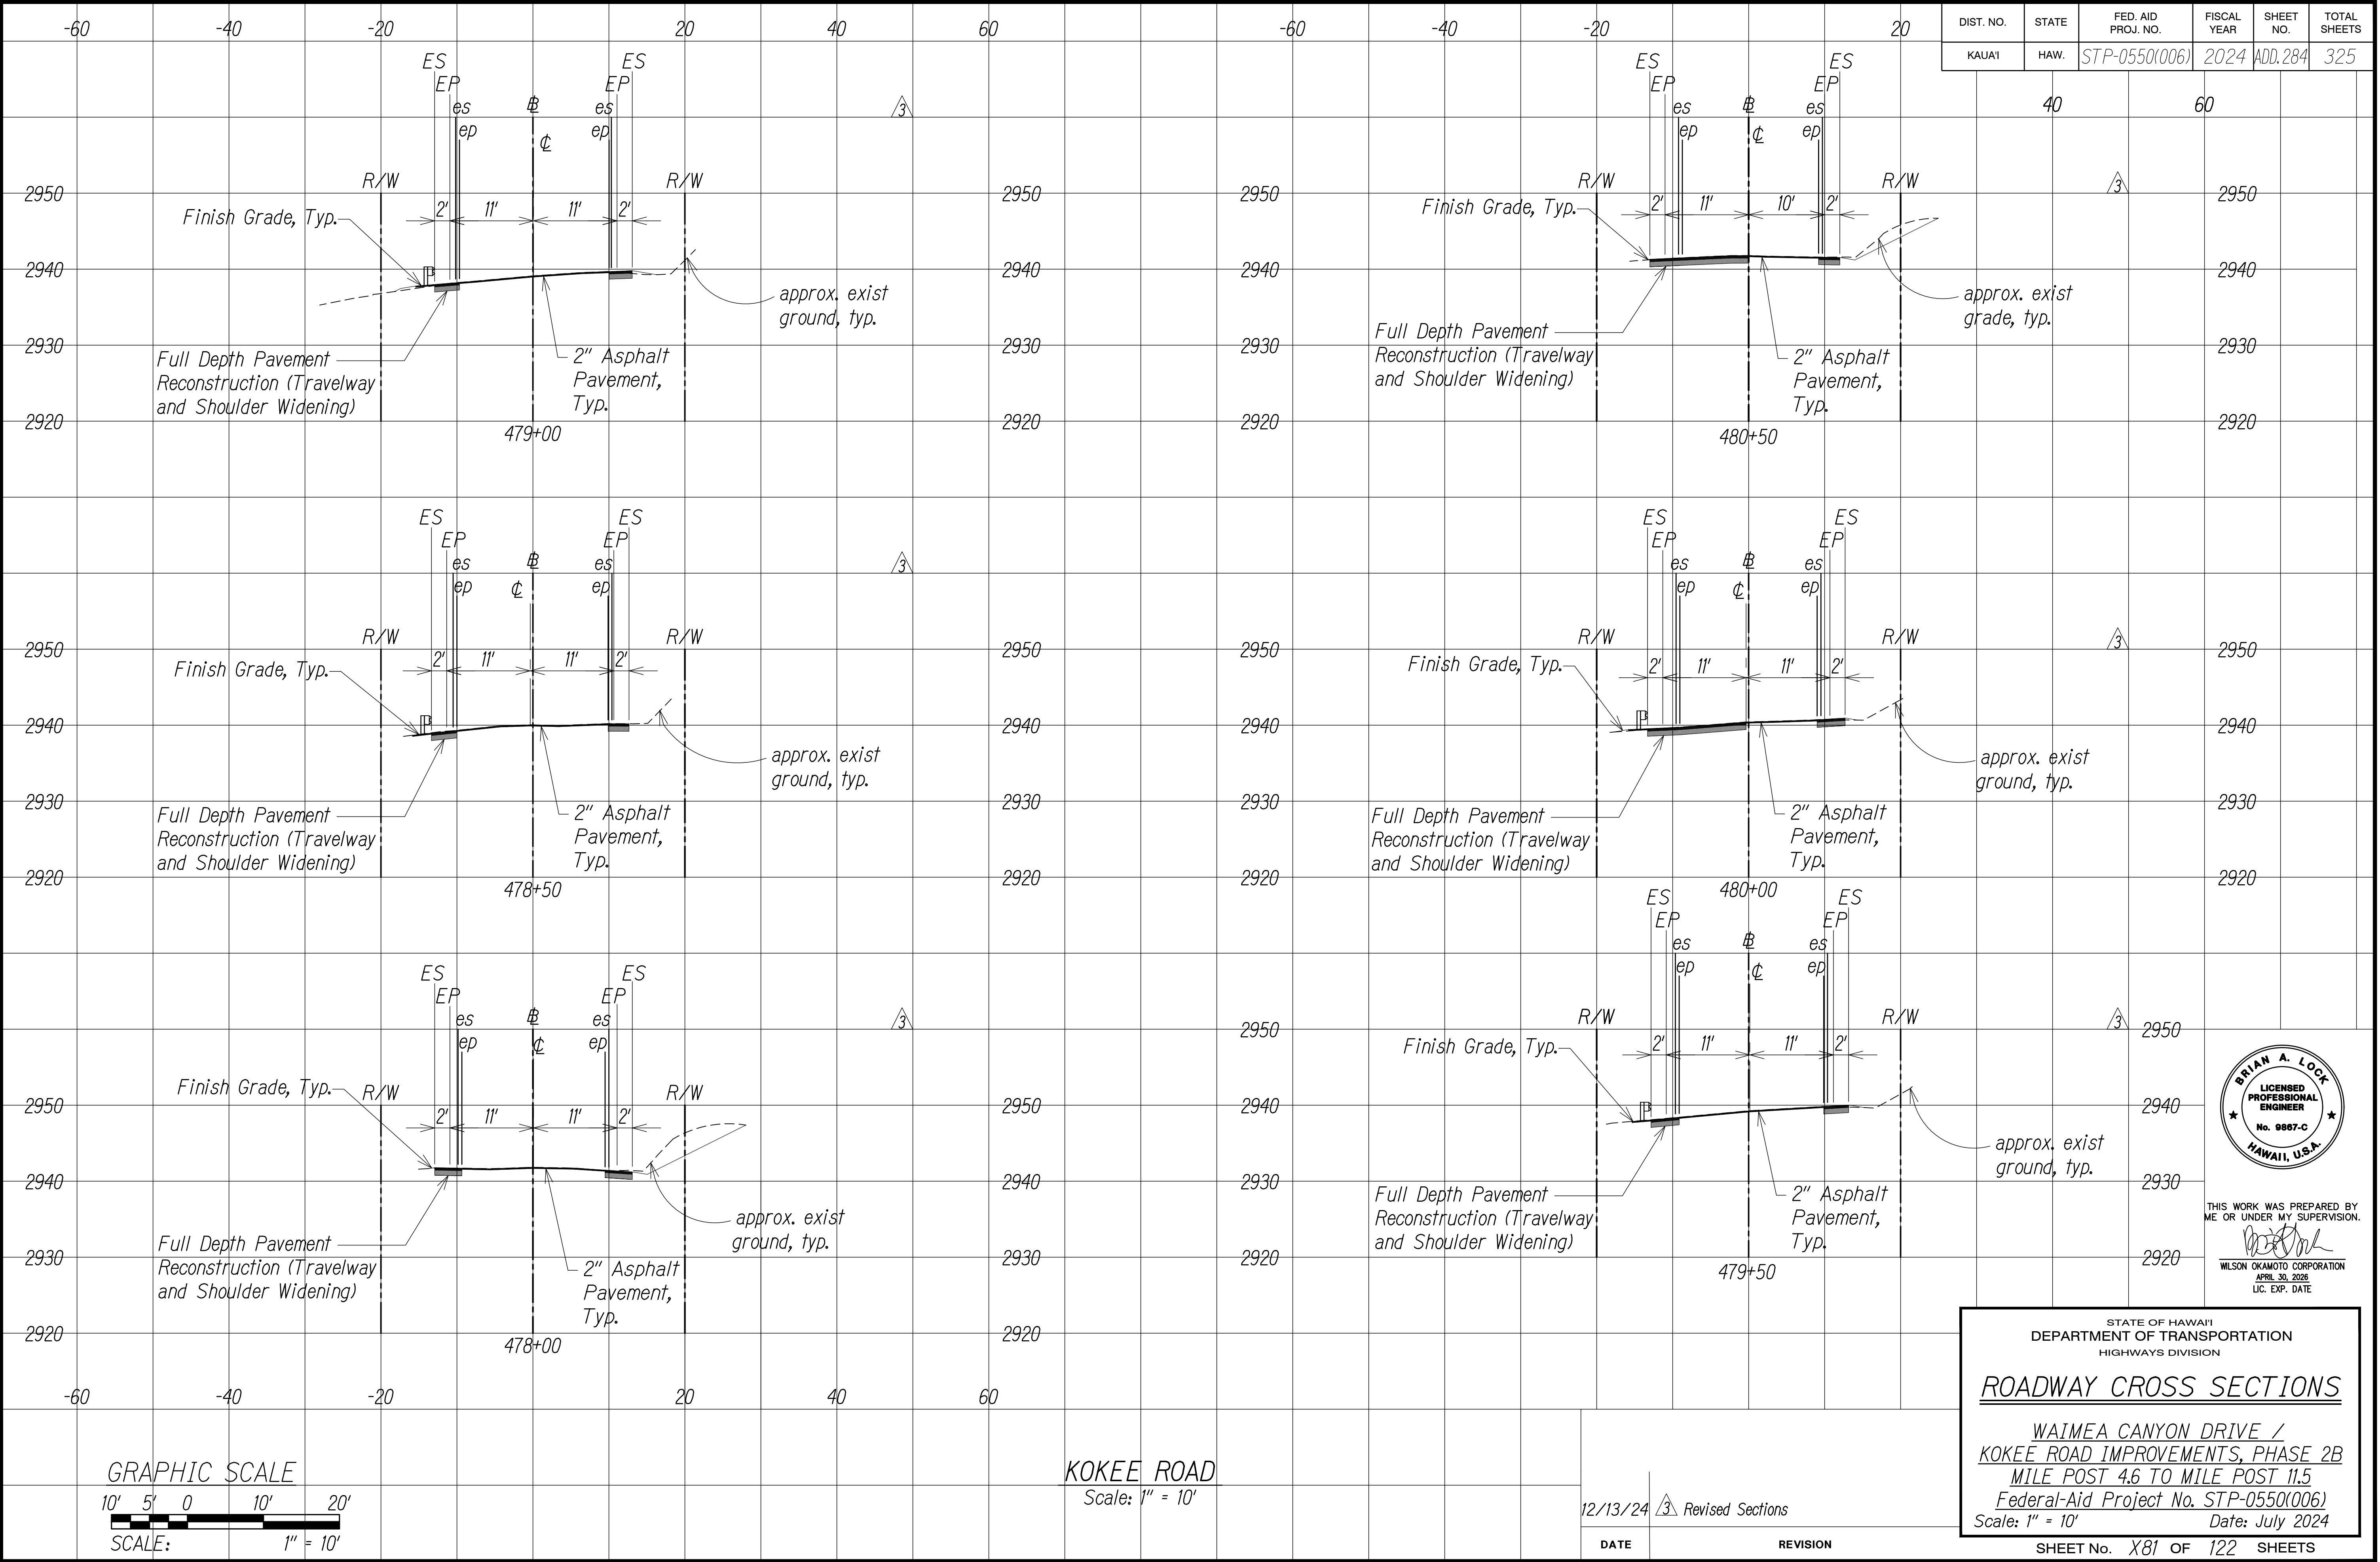

SURVEY PLOTTED BY	DATE
DESIGNED BY	
TRACED BY	
DESIGNED BY	
QUANTITIES BY	
CHECKED BY	


ORIGINAL PLAN	No.
NOTE BOOK	
CHECKED BY	

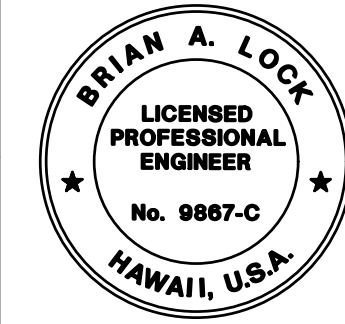

THIS WORK WAS PREPARED BY
ME OR UNDER MY SUPERVISION.

[Signature]


WILSON OKAMOTO CORPORATION
APRIL 30, 2026
LIC. EXP. DATE

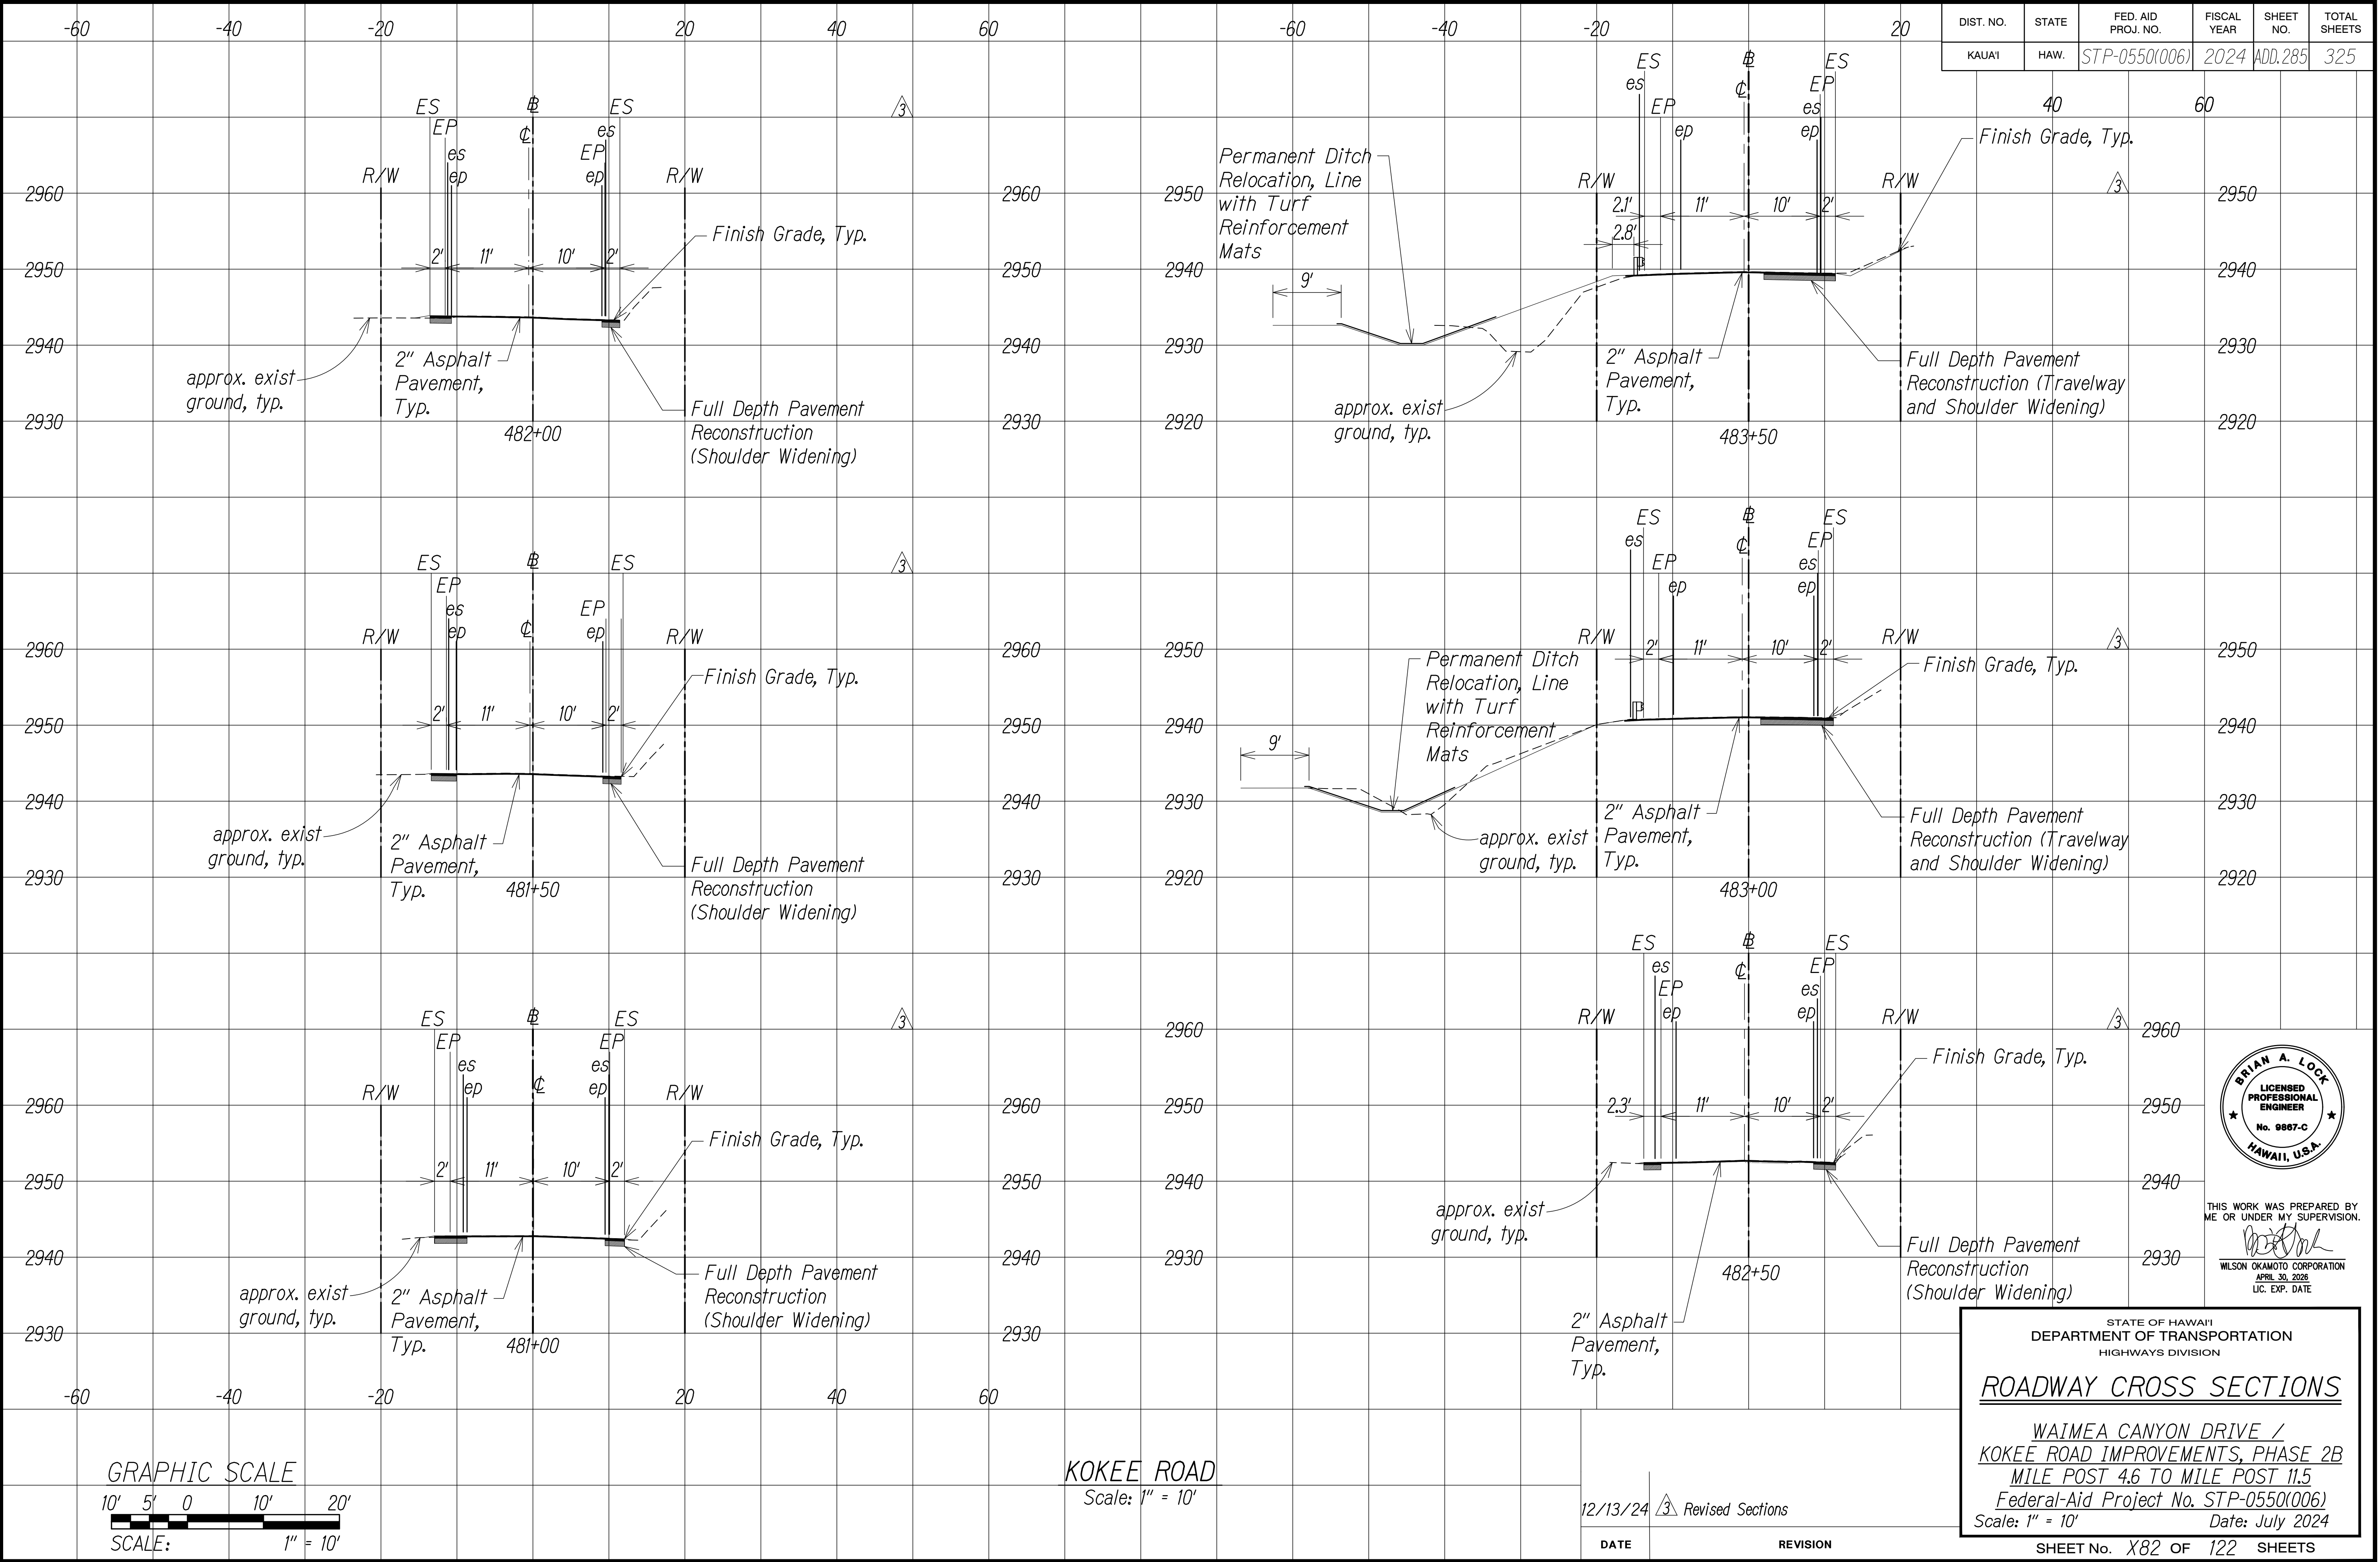

DIST. NO.	STATE	FED. AID PROJ. NO.	FISCAL YEAR	SHEET NO.	TOTAL SHEETS
KAUA'I	HAW.	STP-0550(006)	2024	ADD.285	325

SURVEY PLOTTED BY	DATE
DESIGNED BY	
TRACED BY	
QUANTITIES BY	
CHECKED BY	


ORIGINAL PLAN	No.
NOTE BOOK	

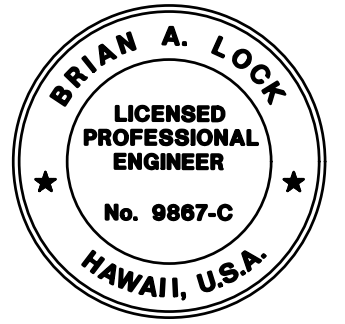

THIS WORK WAS PREPARED BY
ME OR UNDER MY SUPERVISION.

[Signature]

WILSON OKAMOTO CORPORATION
APRIL 30, 2026
LIC. EXP. DATE

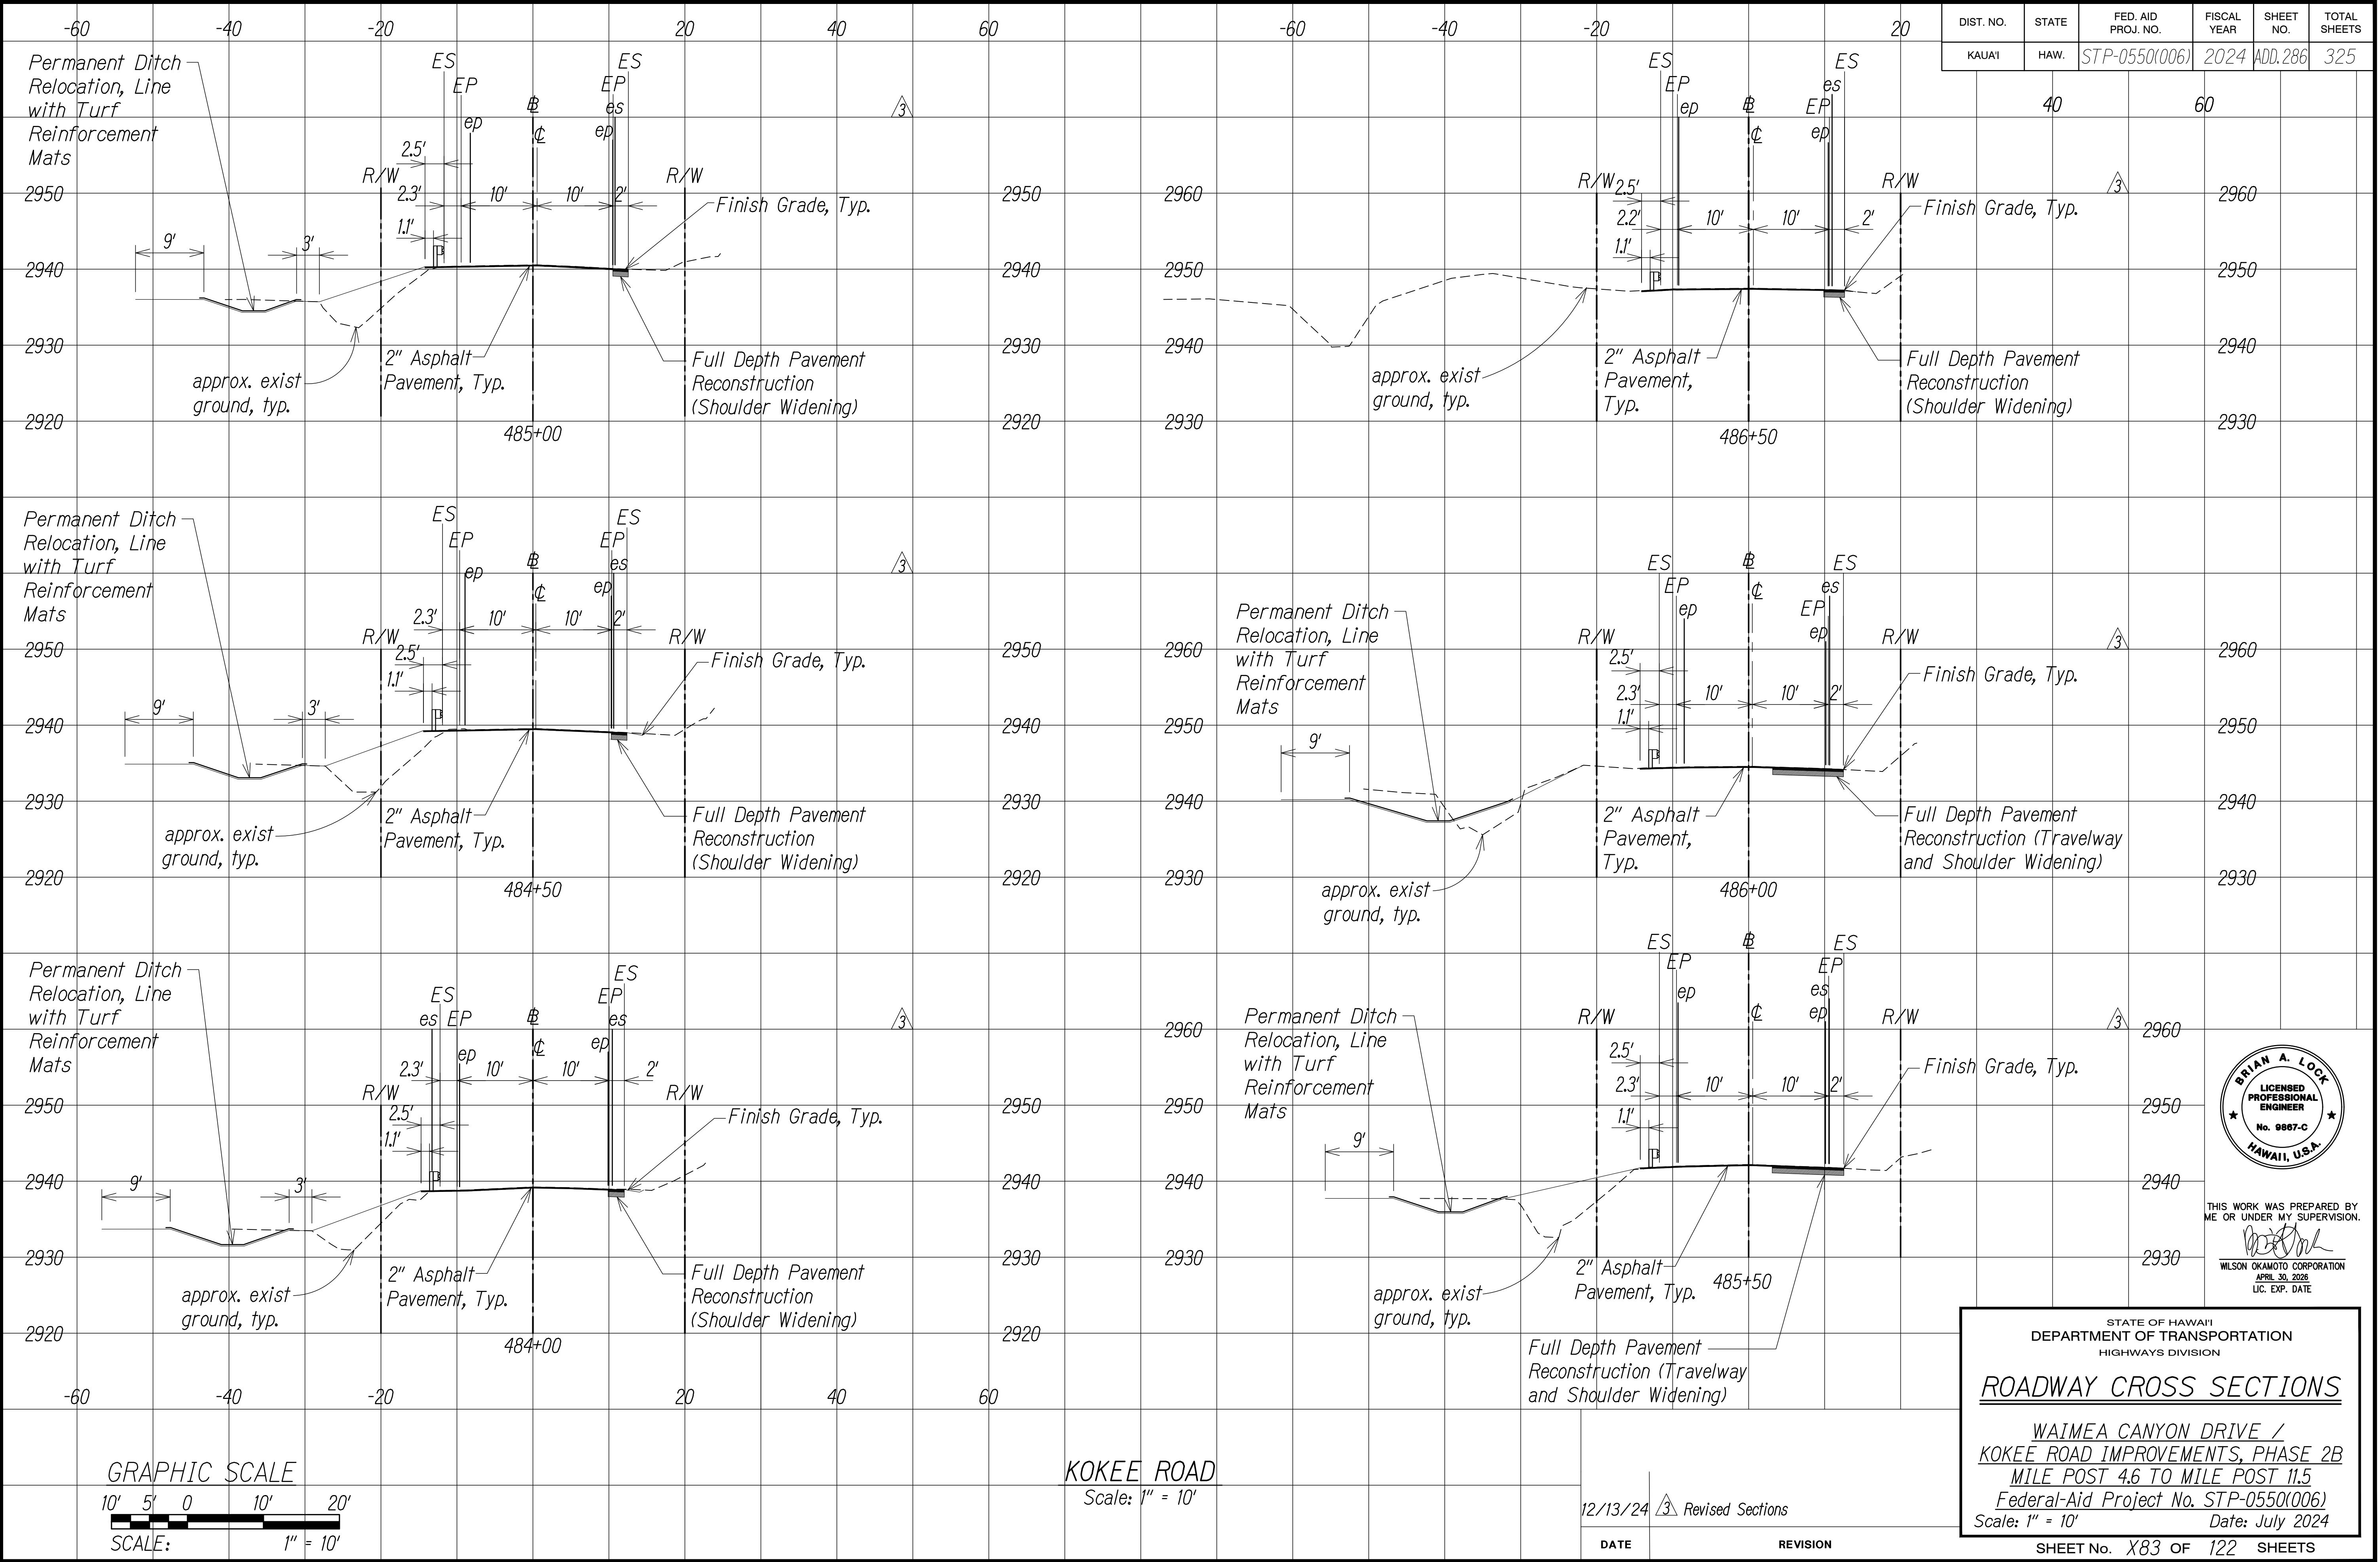

STATE OF HAWAII
DEPARTMENT OF TRANSPORTATION
HIGHWAYS DIVISION


ROADWAY CROSS SECTIONS

WAIMEA CANYON DRIVE /
Kokee Road Improvements, Phase 2B
MILE POST 4.6 TO MILE POST 11.5
Federal-Aid Project No. STP-0550(006)
Scale: 1" = 10' Date: July 2024

12/13/24 3 Revised Sections

DATE REVISION


SHEET No. X83 OF 122 SHEETS

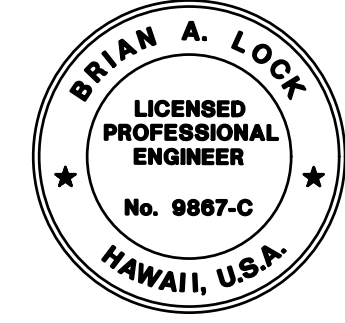


THIS WORK WAS PREPARED BY
ME OR UNDER MY SUPERVISION.

[Signature]
WILSON OKAMOTO CORPORATION
APRIL 30, 2026
LIC. EXP. DATE

SURVEY PLOTTED BY	DATE
DESIGNED BY	
TRACED BY	
QUANTITIES BY	
CHECKED BY	
ORIGINAL PLAN	
NOTE BOOK	
No.	

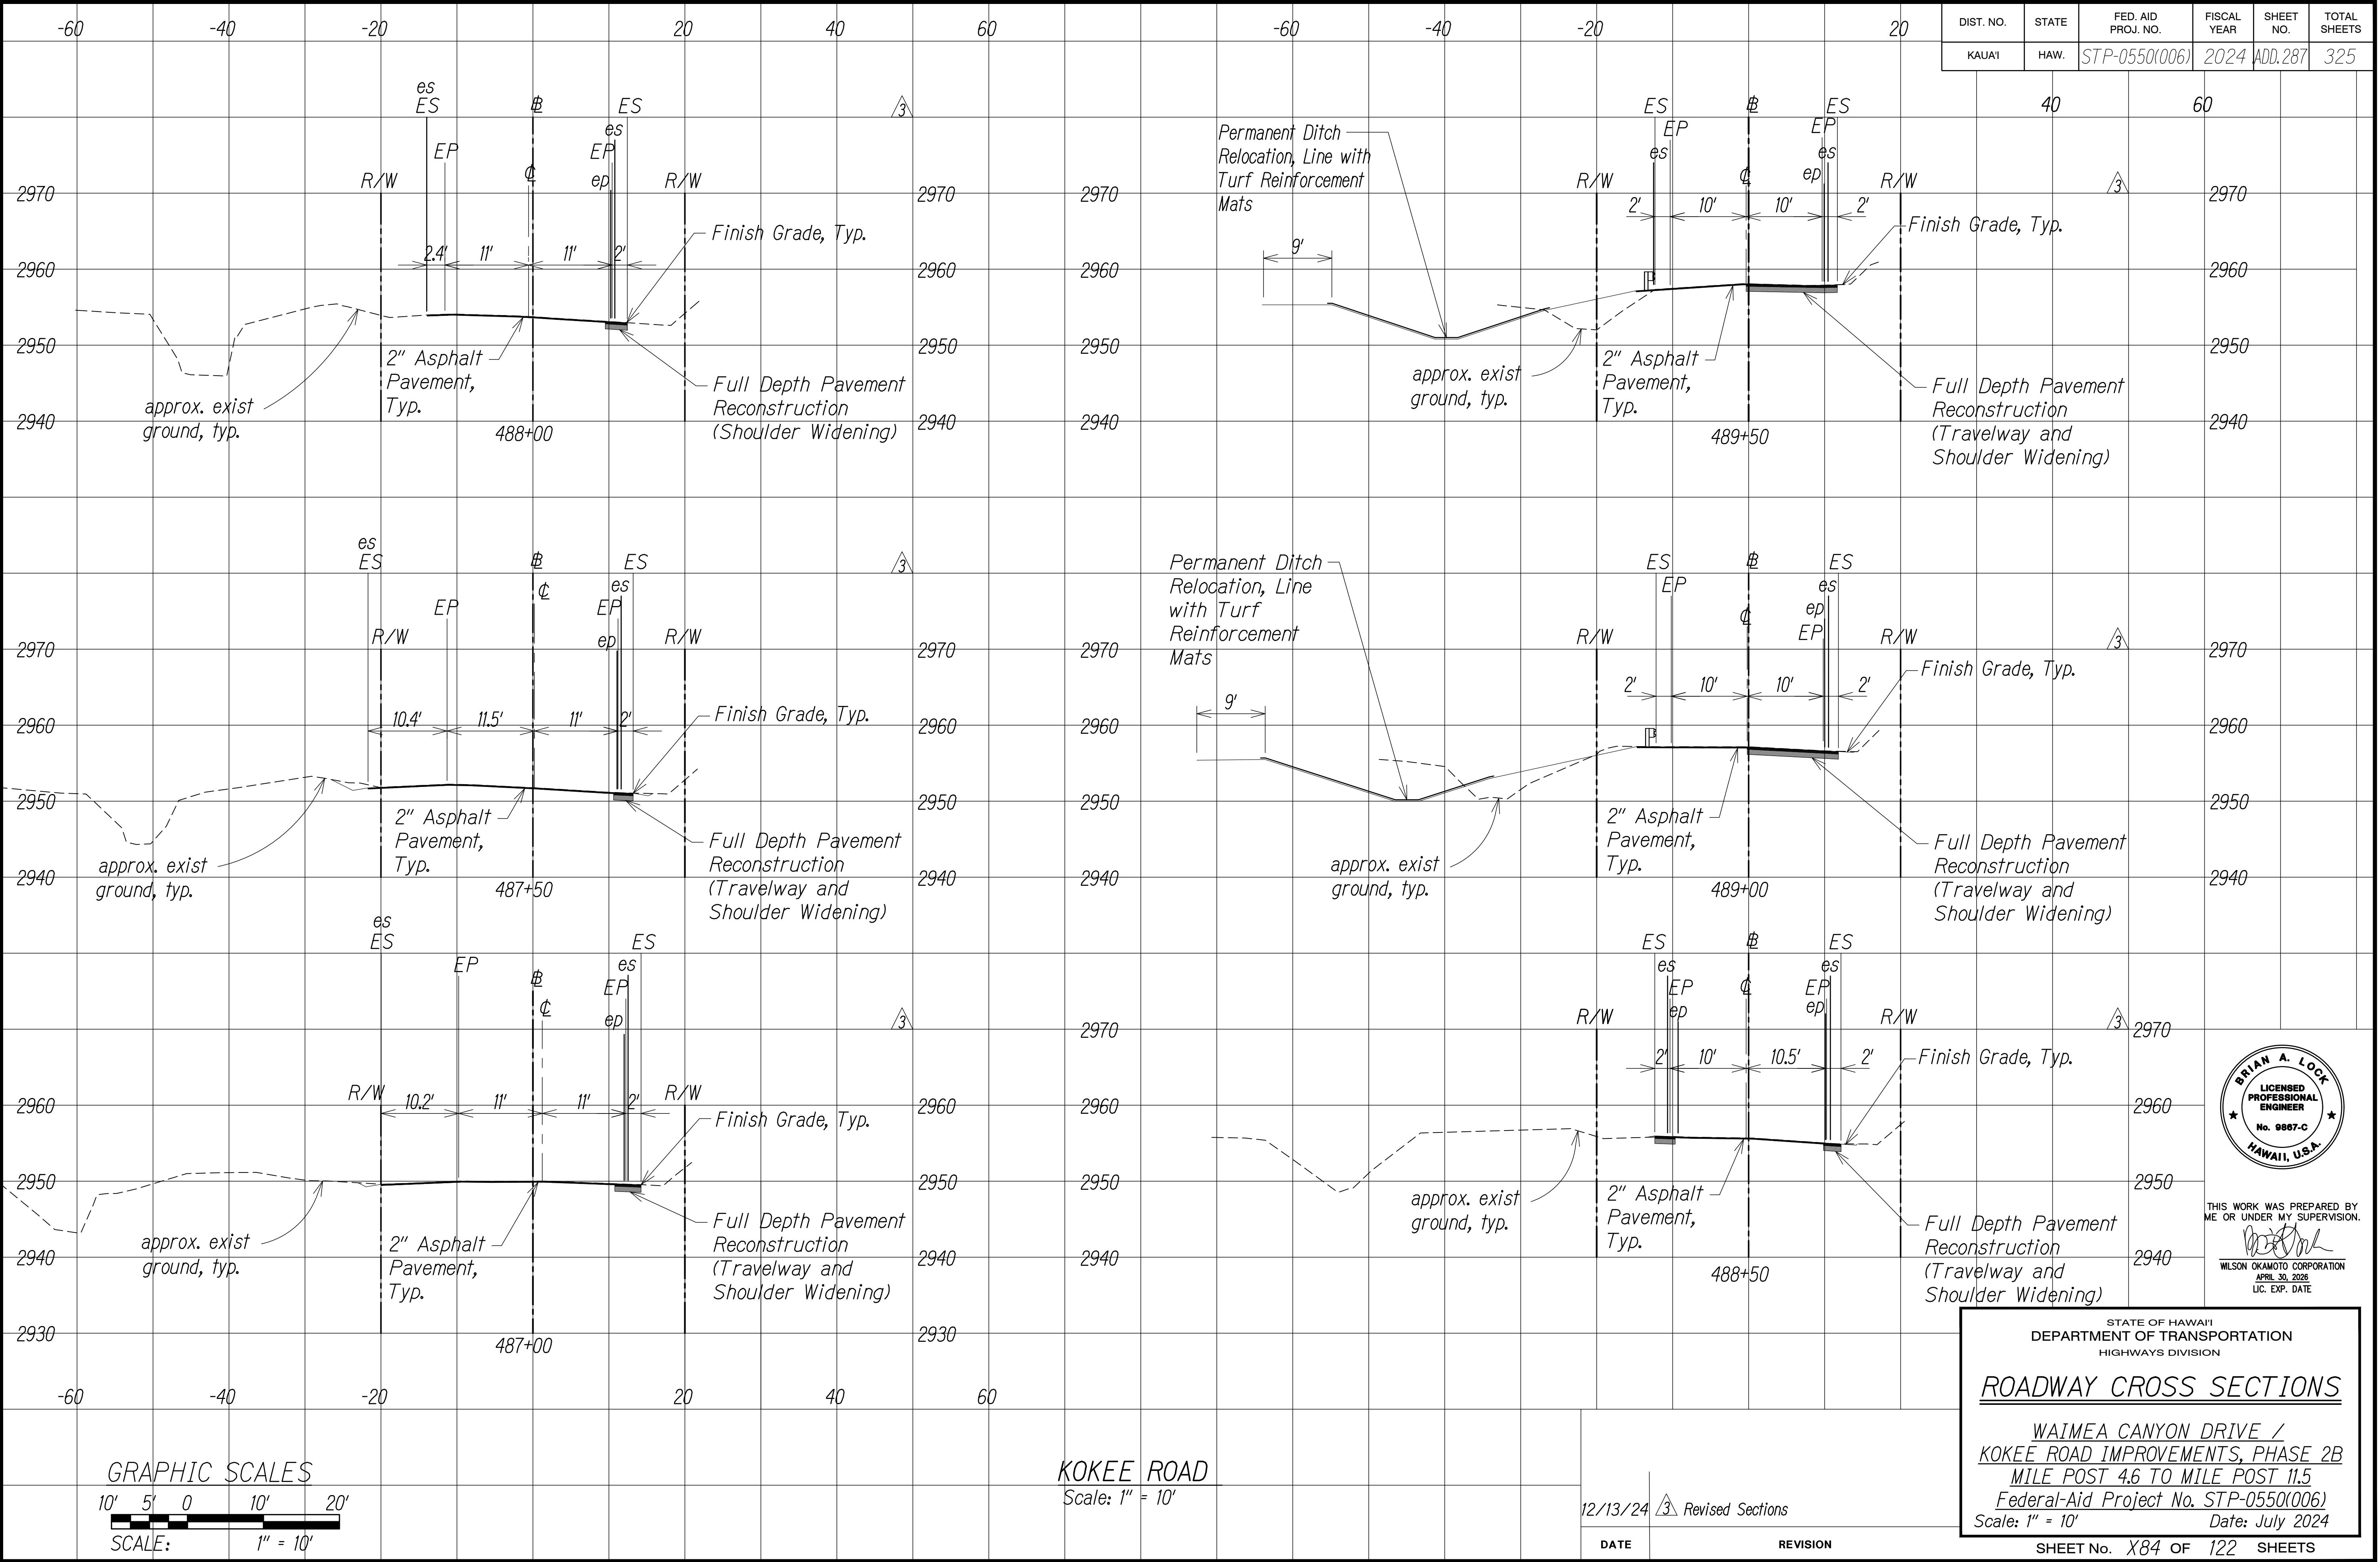

SURVEY PLOTTED BY	DATE
DESIGNED BY	
TRACED BY	
NOTED BY	
QUANTITIES BY	
CHECKED BY	

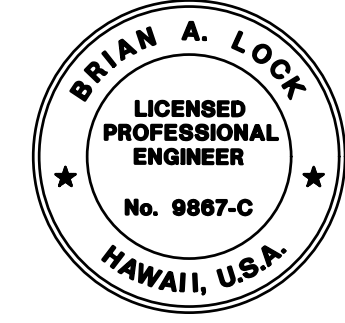


THIS WORK WAS PREPARED BY
ME OR UNDER MY SUPERVISION.
[Signature]
WILSON OKAMOTO CORPORATION
APRIL 30, 2026
LIC. EXP. DATE

STATE OF HAWAII
DEPARTMENT OF TRANSPORTATION
HIGHWAYS DIVISION
ROADWAY CROSS SECTIONS
WAIMEA CANYON DRIVE /
KOKEE ROAD IMPROVEMENTS, PHASE 2B
MILE POST 4.6 TO MILE POST 11.5
Federal-Aid Project No. STP-0550(006)
Scale: 1" = 10"
Date: July 2024

12/13/24 3 Revised Sections


DATE	REVISION
------	----------

SHEET No. X84 OF 122 SHEETS

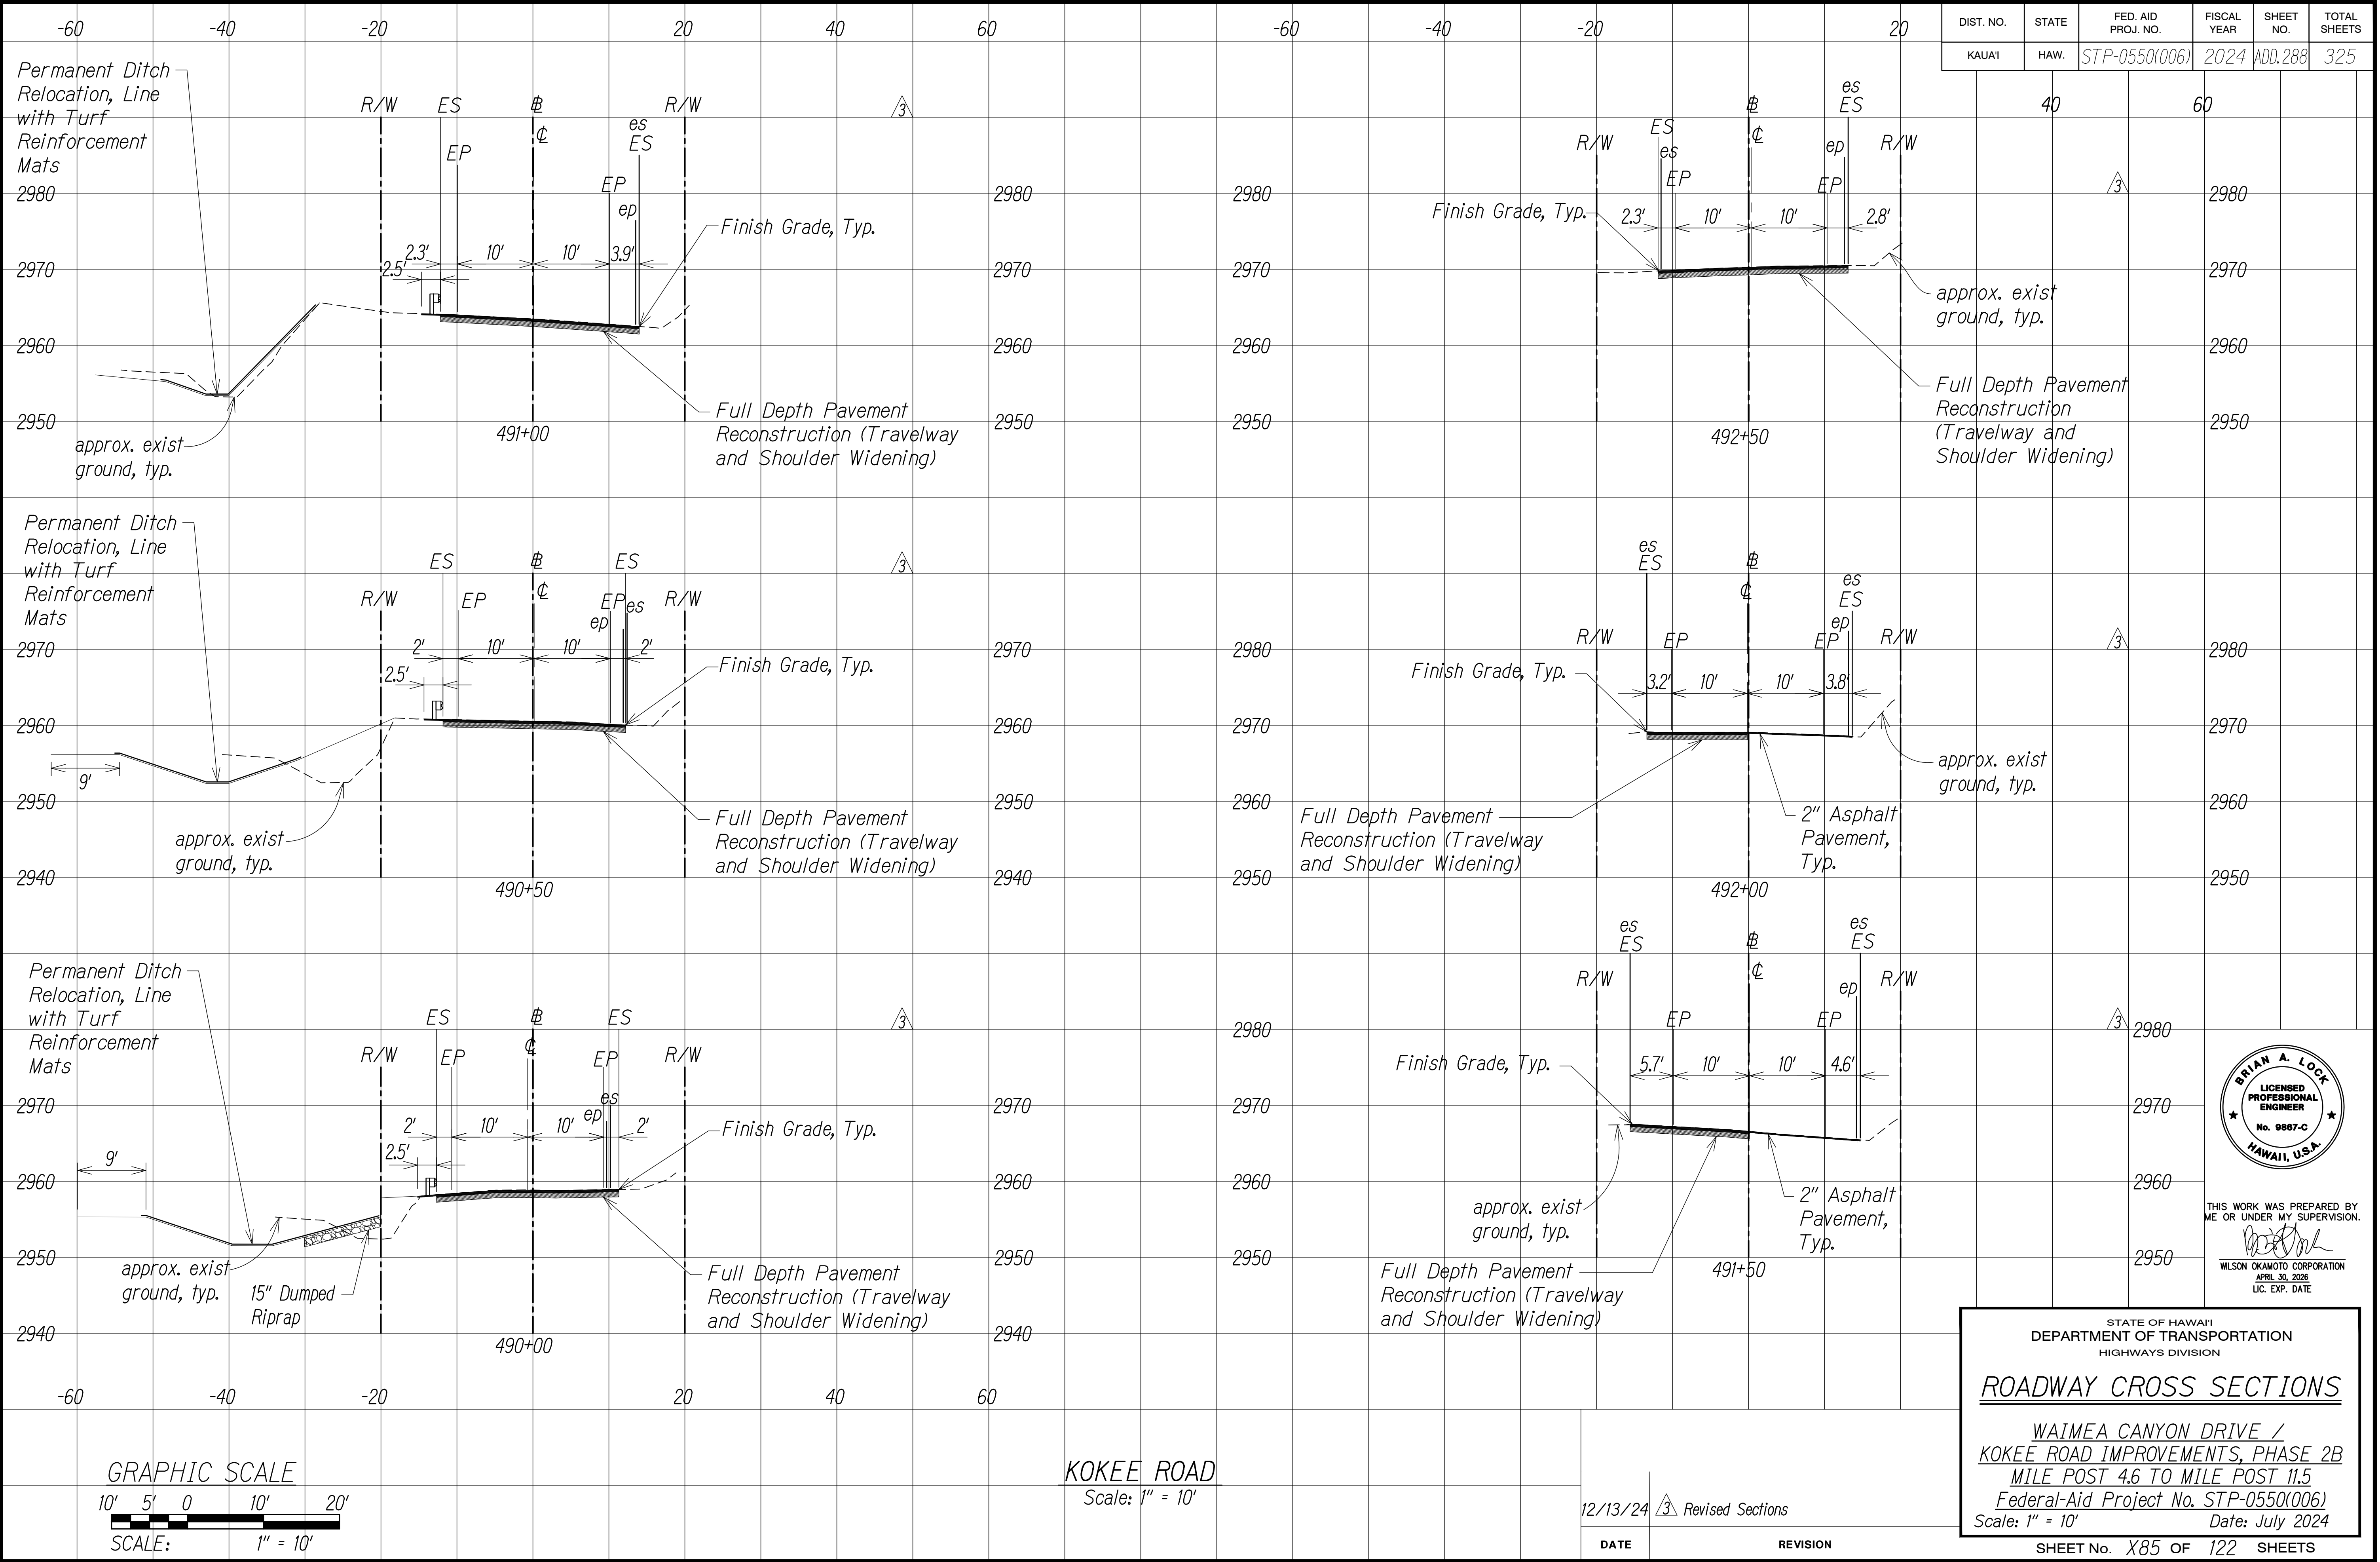

SURVEY PLOTTED BY	DATE
DESIGNED BY	
TRACED BY	
QUANTITIES BY	
CHECKED BY	


ORIGINAL PLAN	No.
NOTE BOOK	

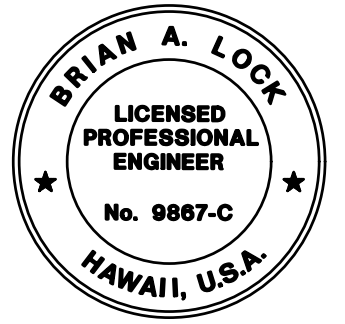


THIS WORK WAS PREPARED BY
ME OR UNDER MY SUPERVISION.

[Signature]

WILSON OKAMOTO CORPORATION
APRIL 30, 2026
LIC. EXP. DATE

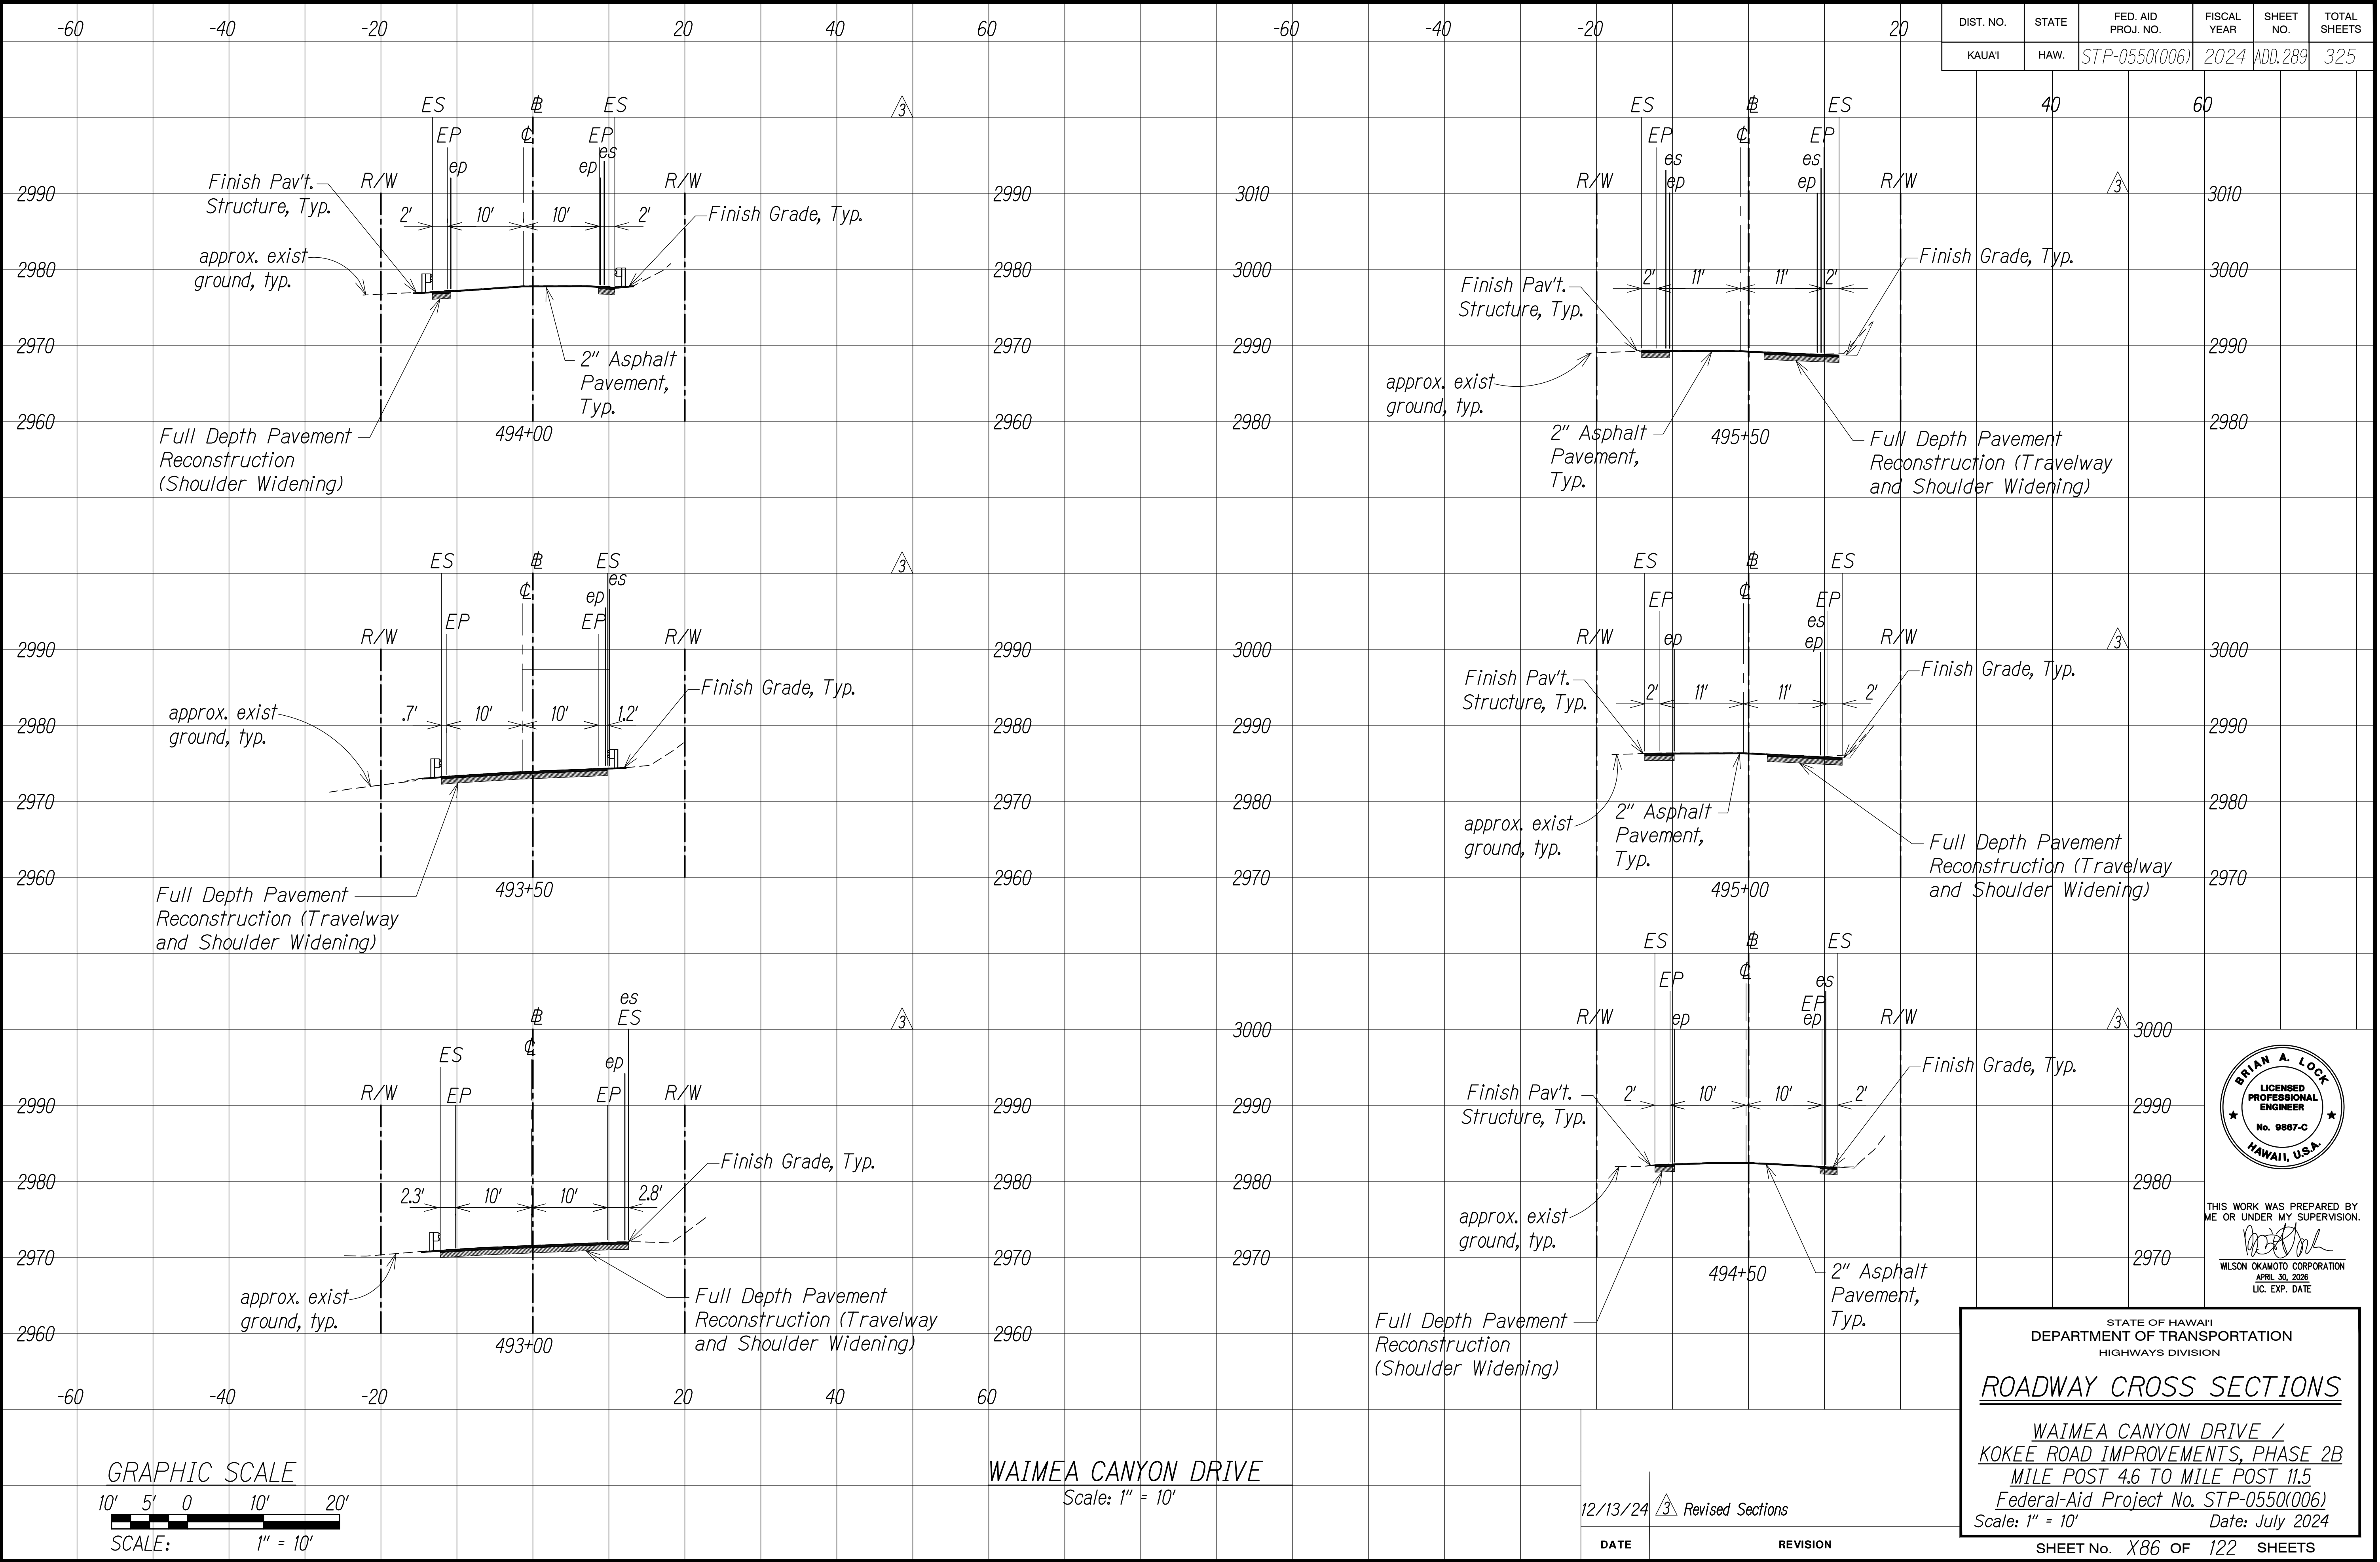

SURVEY PLOTTED BY	DATE
DESIGNED BY	
TRACED BY	
NOTED BY	
QUANTITIES BY	
CHECKED BY	

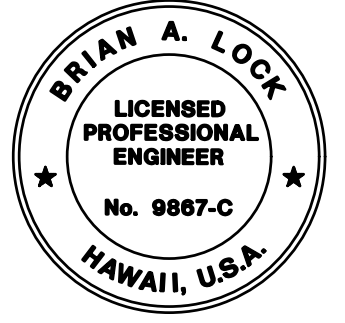

THIS WORK WAS PREPARED BY
ME OR UNDER MY SUPERVISION.
[Signature]
WILSON OKAMOTO CORPORATION
APRIL 30, 2026
LIC. EXP. DATE

STATE OF HAWAII
DEPARTMENT OF TRANSPORTATION
HIGHWAYS DIVISION

ROADWAY CROSS SECTIONS


WAIMEA CANYON DRIVE /
KOEKE ROAD IMPROVEMENTS, PHASE 2B
MILE POST 4.6 TO MILE POST 11.5
Federal-Aid Project No. STP-0550(006)
Scale: 1" = 10' Date: July 2024

12/13/24 3 Revised Sections

DATE	REVISION
------	----------


SHEET No. X86 OF 122 SHEETS

DIST. NO.	STATE	FED. AID PROJ. NO.	FISCAL YEAR	SHEET NO.	TOTAL SHEETS
KAUA'I	HAW.	STP-0550(006)	2024	ADD.290	325

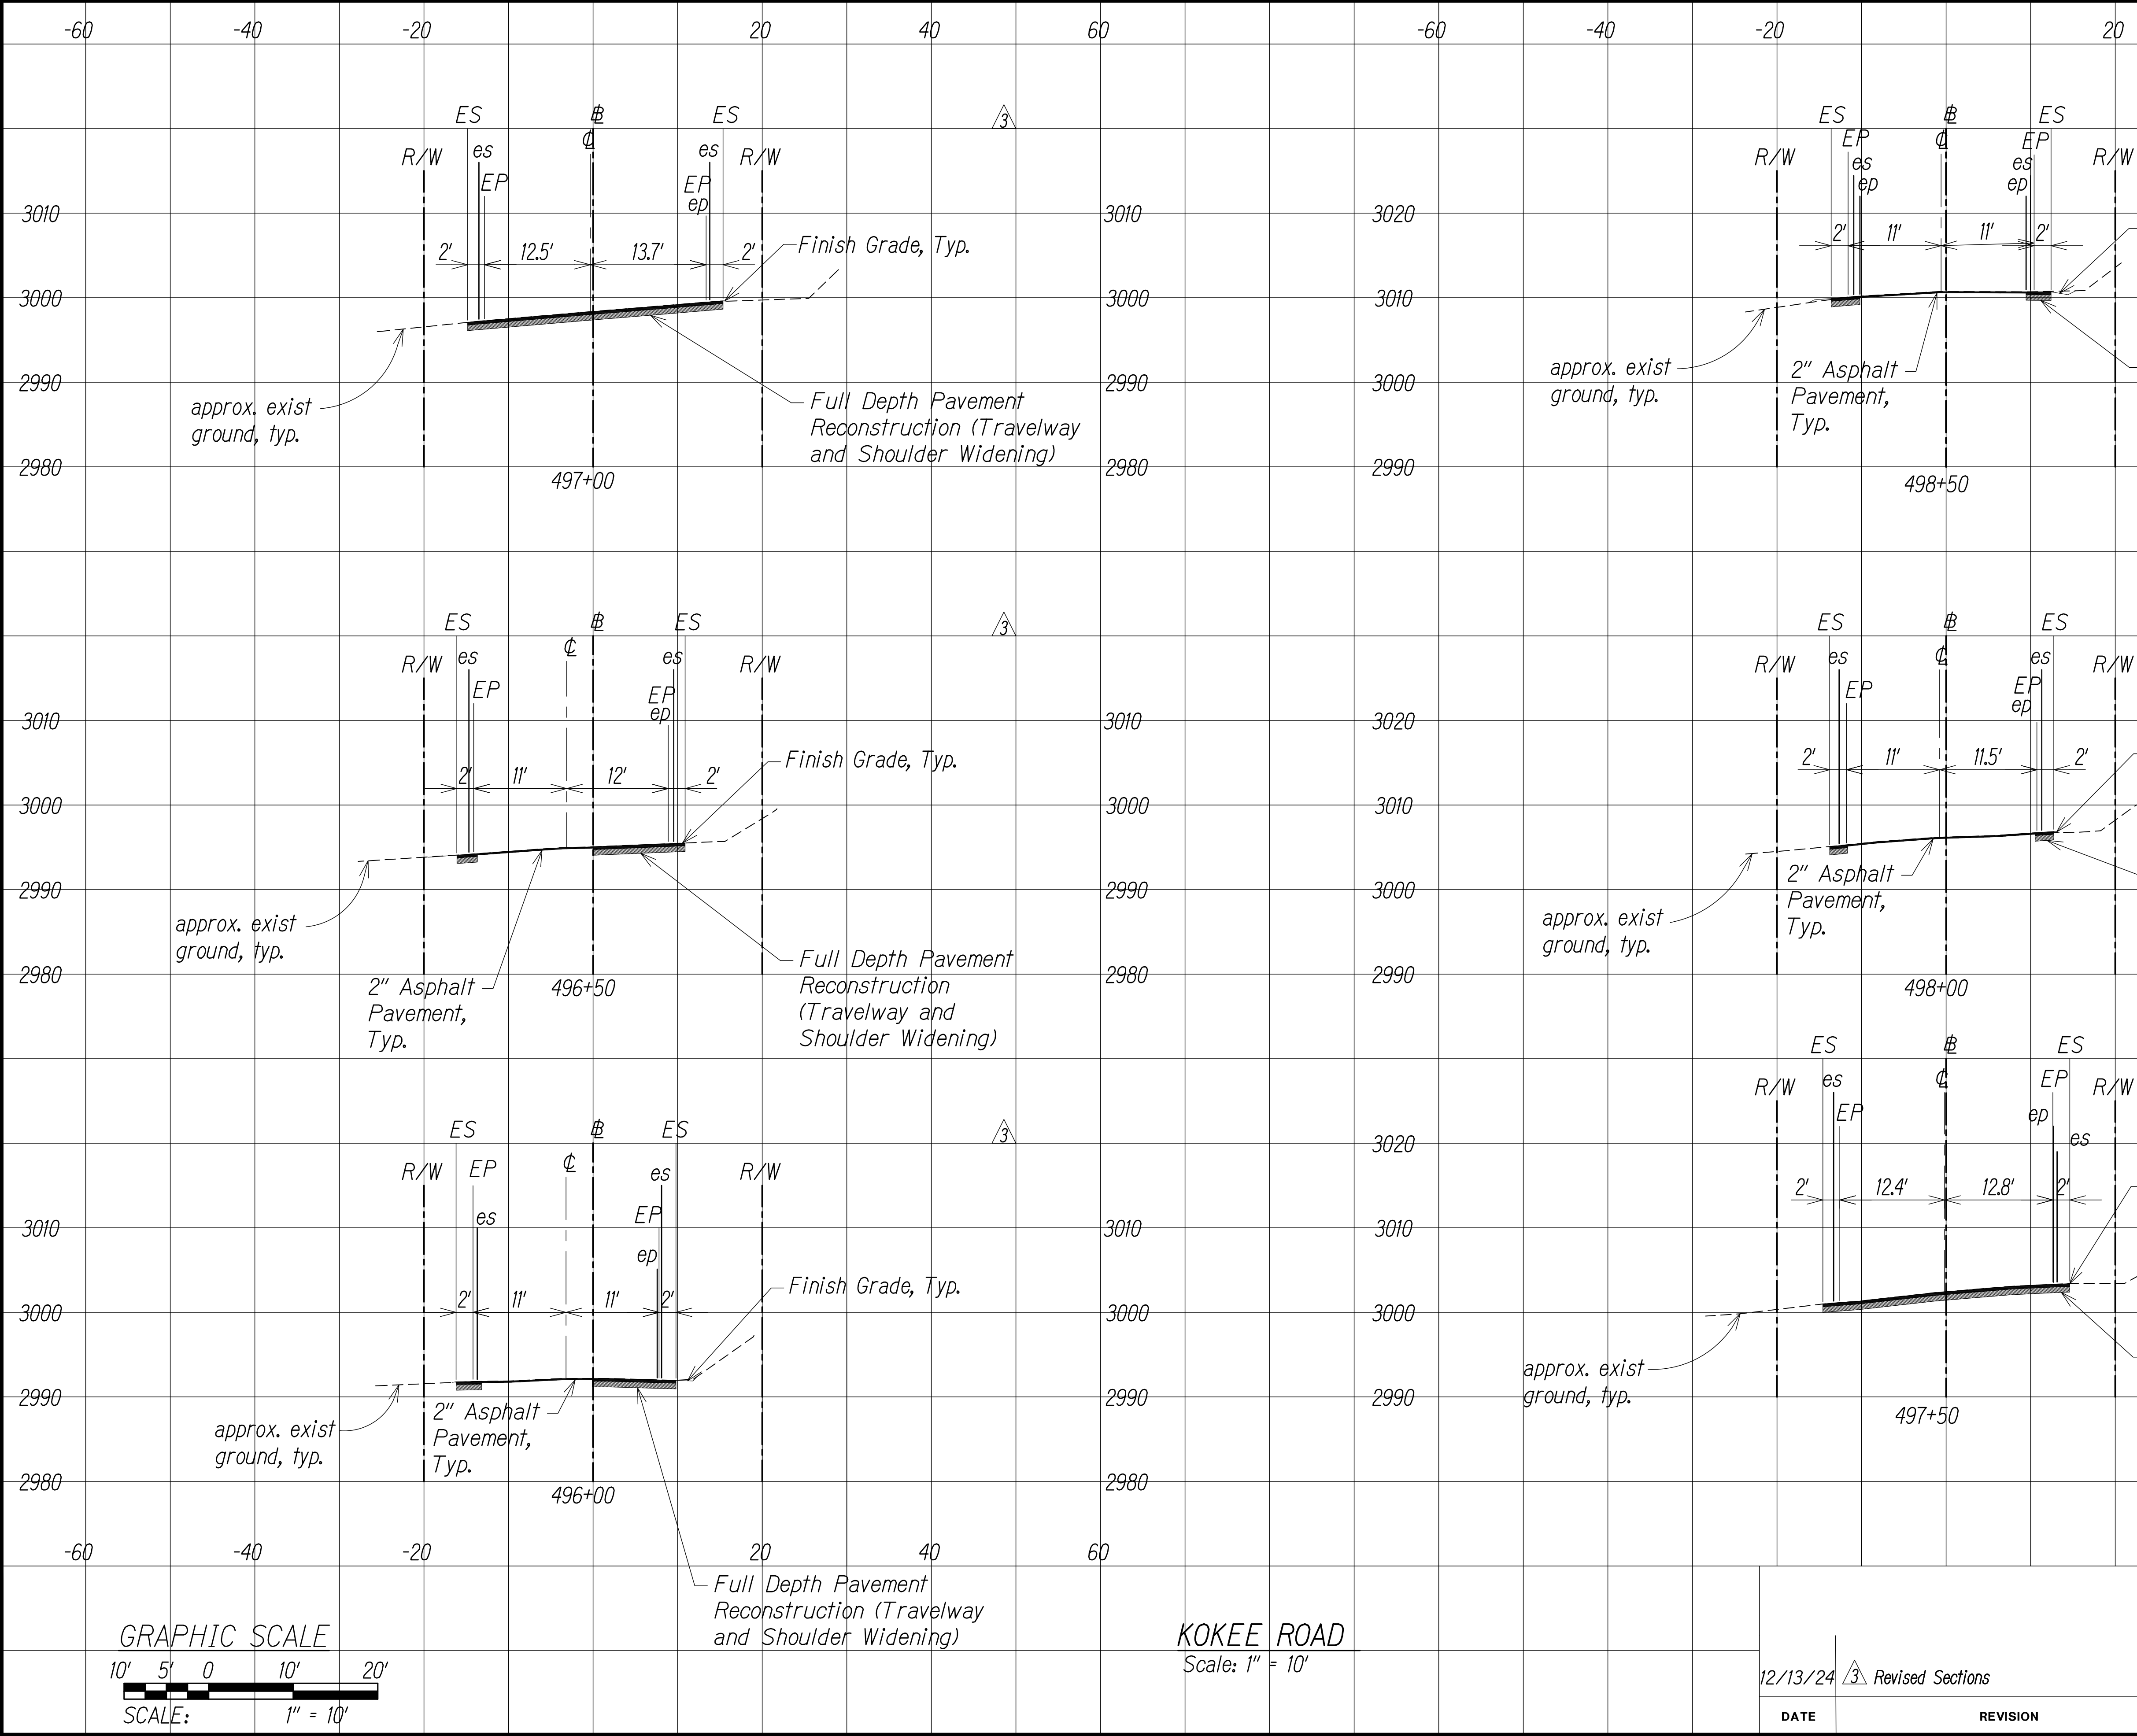

SURVEY PLOTTED BY	DATE
DESIGNED BY	
TRACED BY	
QUANTITIES BY	
CHECKED BY	


ORIGINAL PLAN	No.
NOTE BOOK	

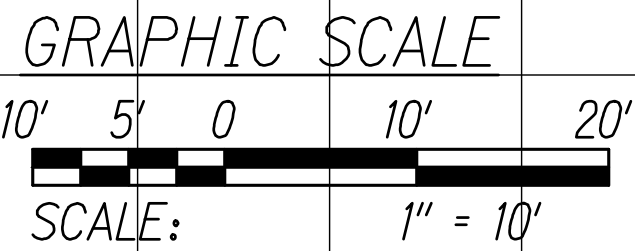

KOKEE ROAD
Scale: 1" = 10'

12/13/24 3 Revised Sections

DATE REVISION


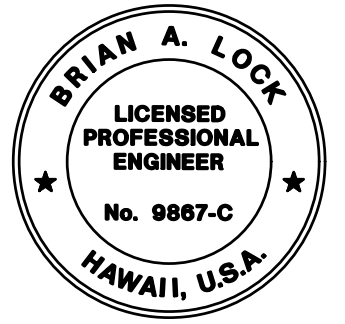


THIS WORK WAS PREPARED BY
ME OR UNDER MY SUPERVISION.
[Signature]
WILSON OKAMOTO CORPORATION
APRIL 30, 2026
LIC. EXP. DATE

STATE OF HAWAII
DEPARTMENT OF TRANSPORTATION
HIGHWAYS DIVISION
ROADWAY CROSS SECTIONS
WAIMEA CANYON DRIVE /
KOKEE ROAD IMPROVEMENTS, PHASE 2B
MILE POST 4.6 TO MILE POST 11.5
Federal-Aid Project No. STP-0550(006)
Scale: 1" = 10' Date: July 2024

SHEET No. X87 OF 122 SHEETS

DIST. NO.	STATE	FED. AID PROJ. NO.	FISCAL YEAR	SHEET NO.	TOTAL SHEETS
KAUAI	HAW.	STP-0550(006)	2024	ADD. 291	325

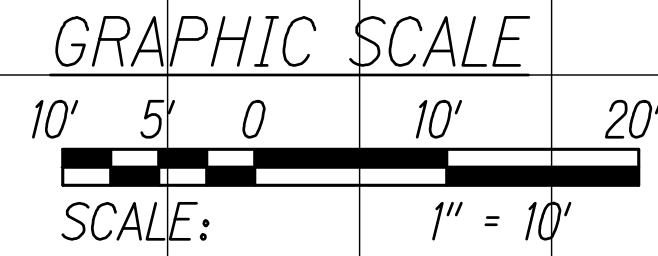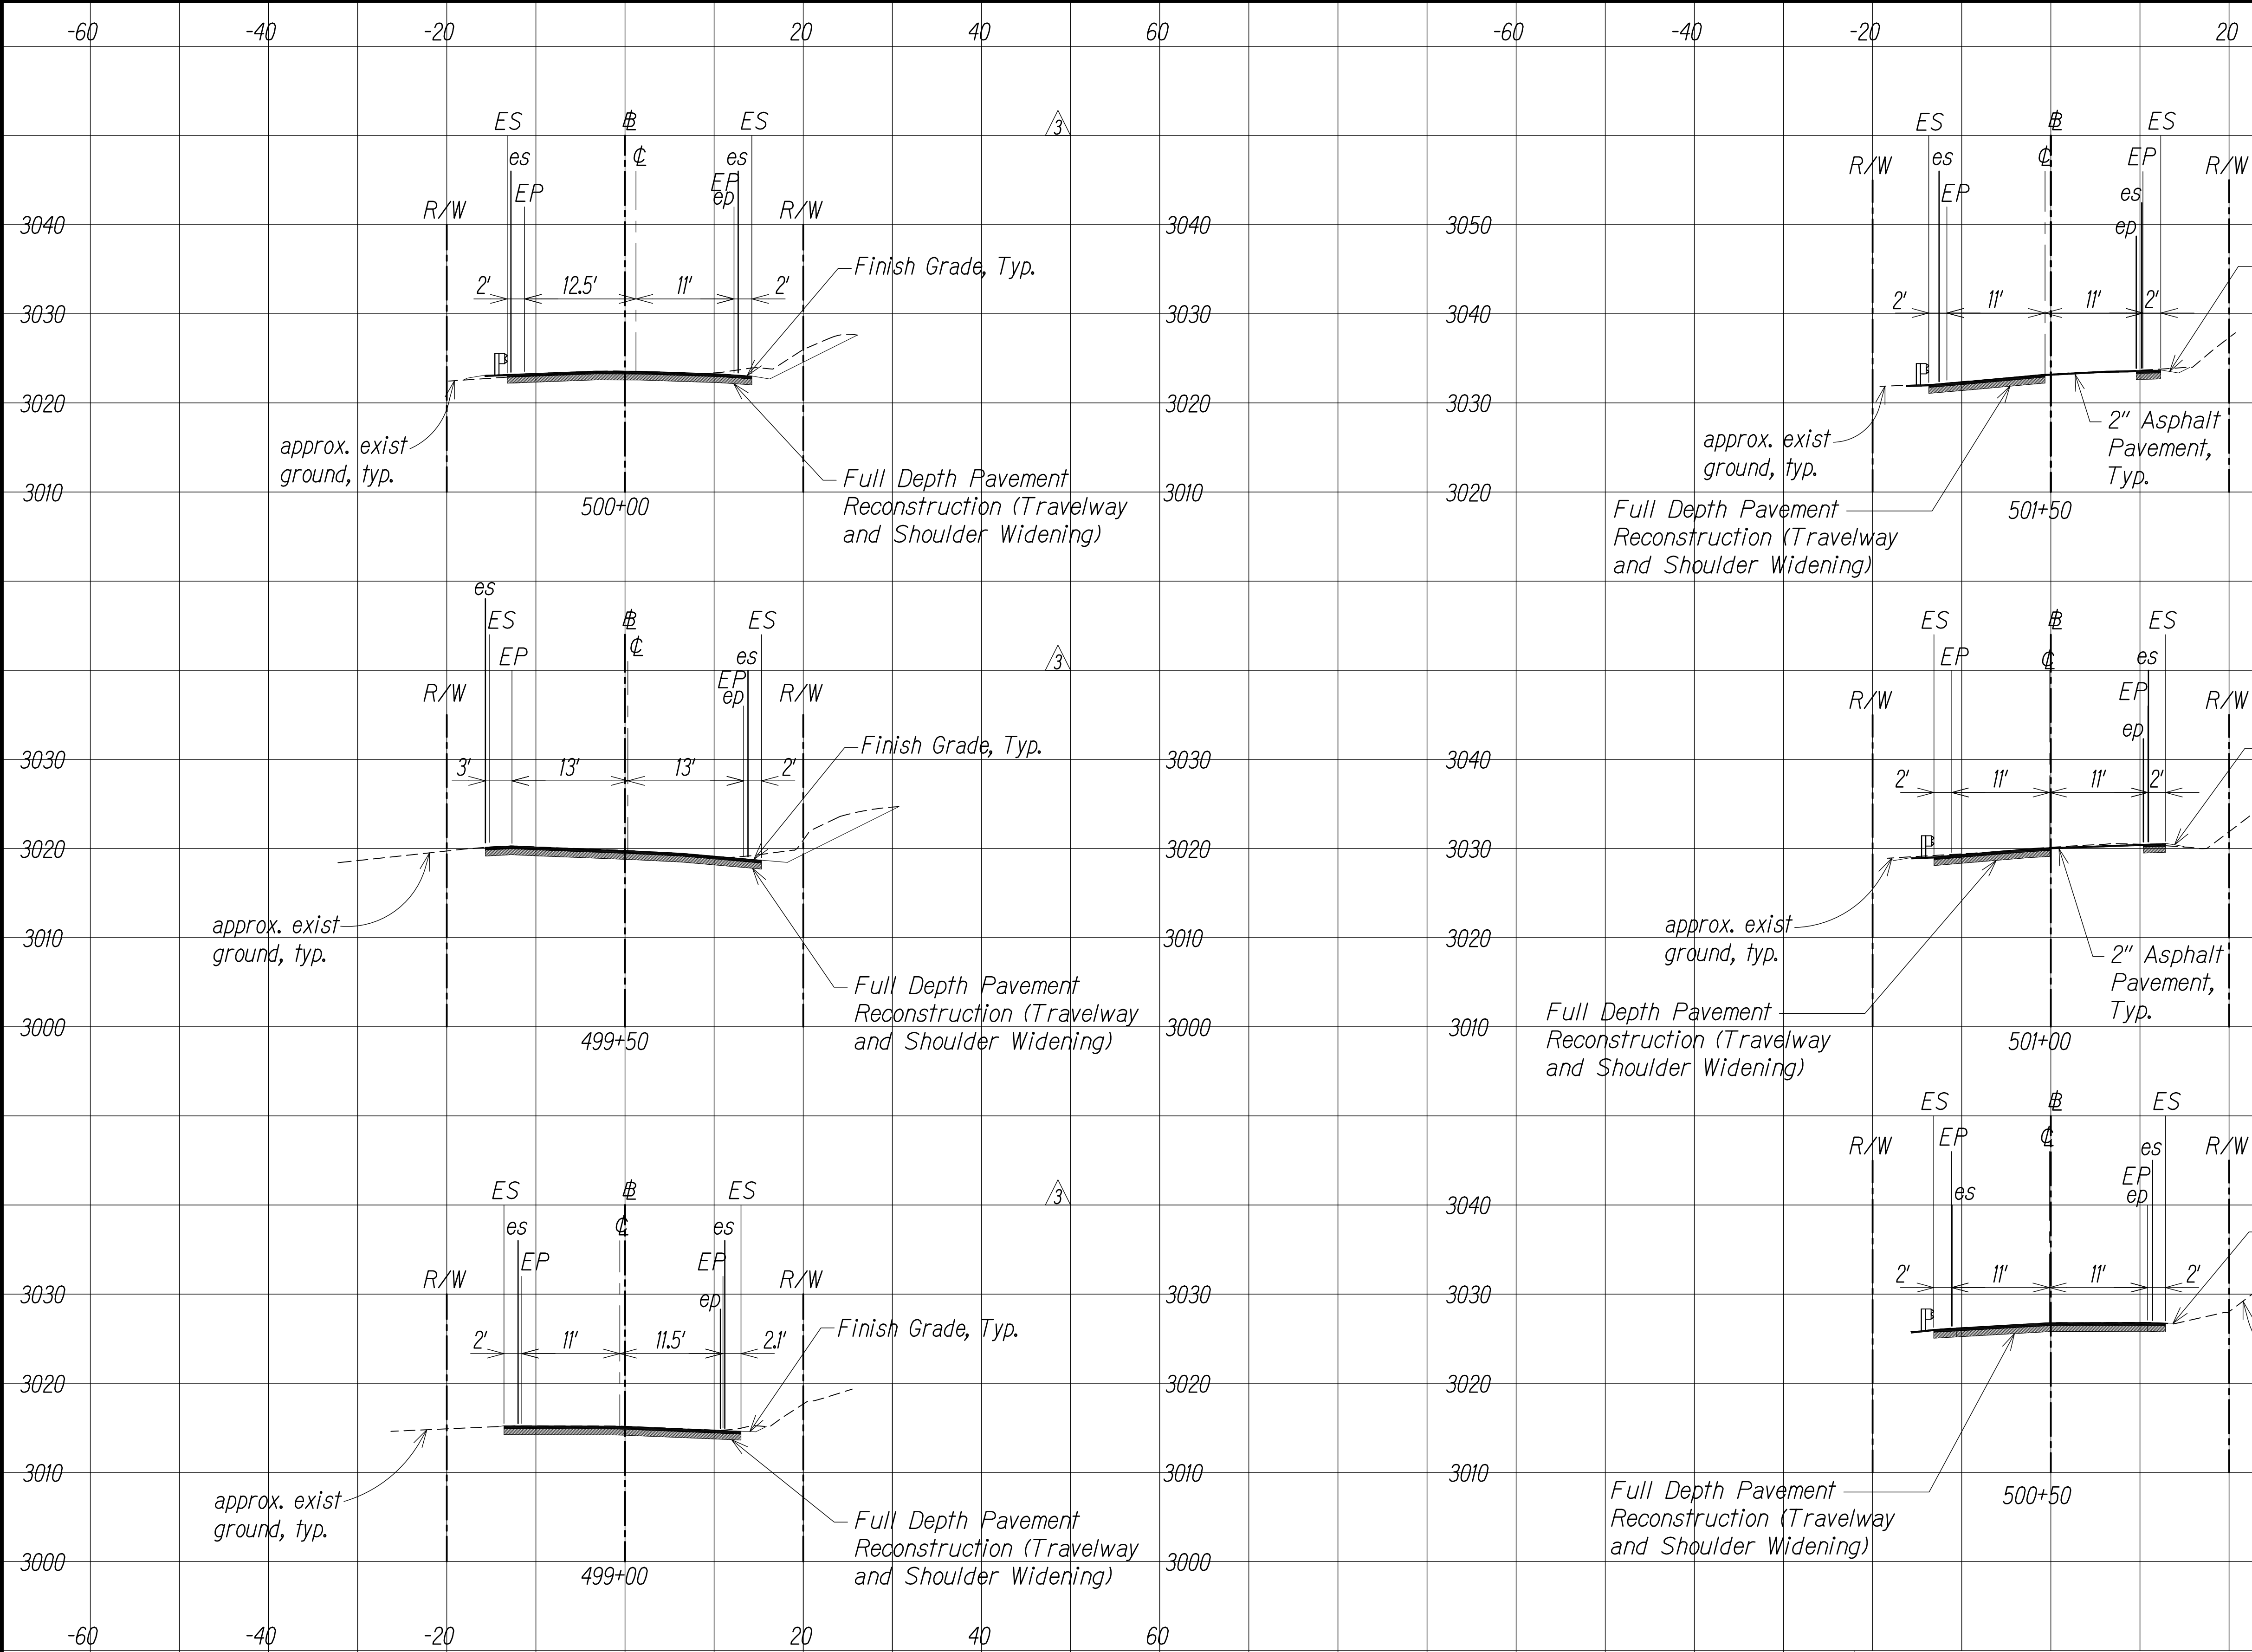

KOKEE ROAD
Scale: 1" = 10'

12/13/24 3 Revised Sections


DATE	REVISION
------	----------

STATE OF HAWAII
DEPARTMENT OF TRANSPORTATION
HIGHWAYS DIVISION

ROADWAY CROSS SECTIONS

WAIMEA CANYON DRIVE /
KOKEE ROAD IMPROVEMENTS, PHASE 2B
MILE POST 4.6 TO MILE POST 11.5
Federal-Aid Project No. STP-0550(006)
Scale: 1" = 10' Date: July 2024


SHEET No. X88 OF 122 SHEETS

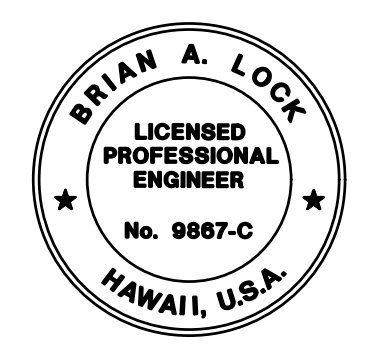


THIS WORK WAS PREPARED BY
ME OR UNDER MY SUPERVISION.
WILSON OKAMOTO CORPORATION
APRIL 30, 2026
LIC. EXP. DATE

SURVEY PLOTTED BY	DATE
DESIGNED BY	
TRACED BY	
QUANTITIES BY	
CHECKED BY	
ORIGINAL PLAN	
NOTE BOOK	
No.	


DIST. NO.	STATE	FED. AID PROJ. NO.	FISCAL YEAR	SHEET NO.	TOTAL SHEETS
KAUAI	HAW.	STP-0550(006)	2024	ADD.292	325

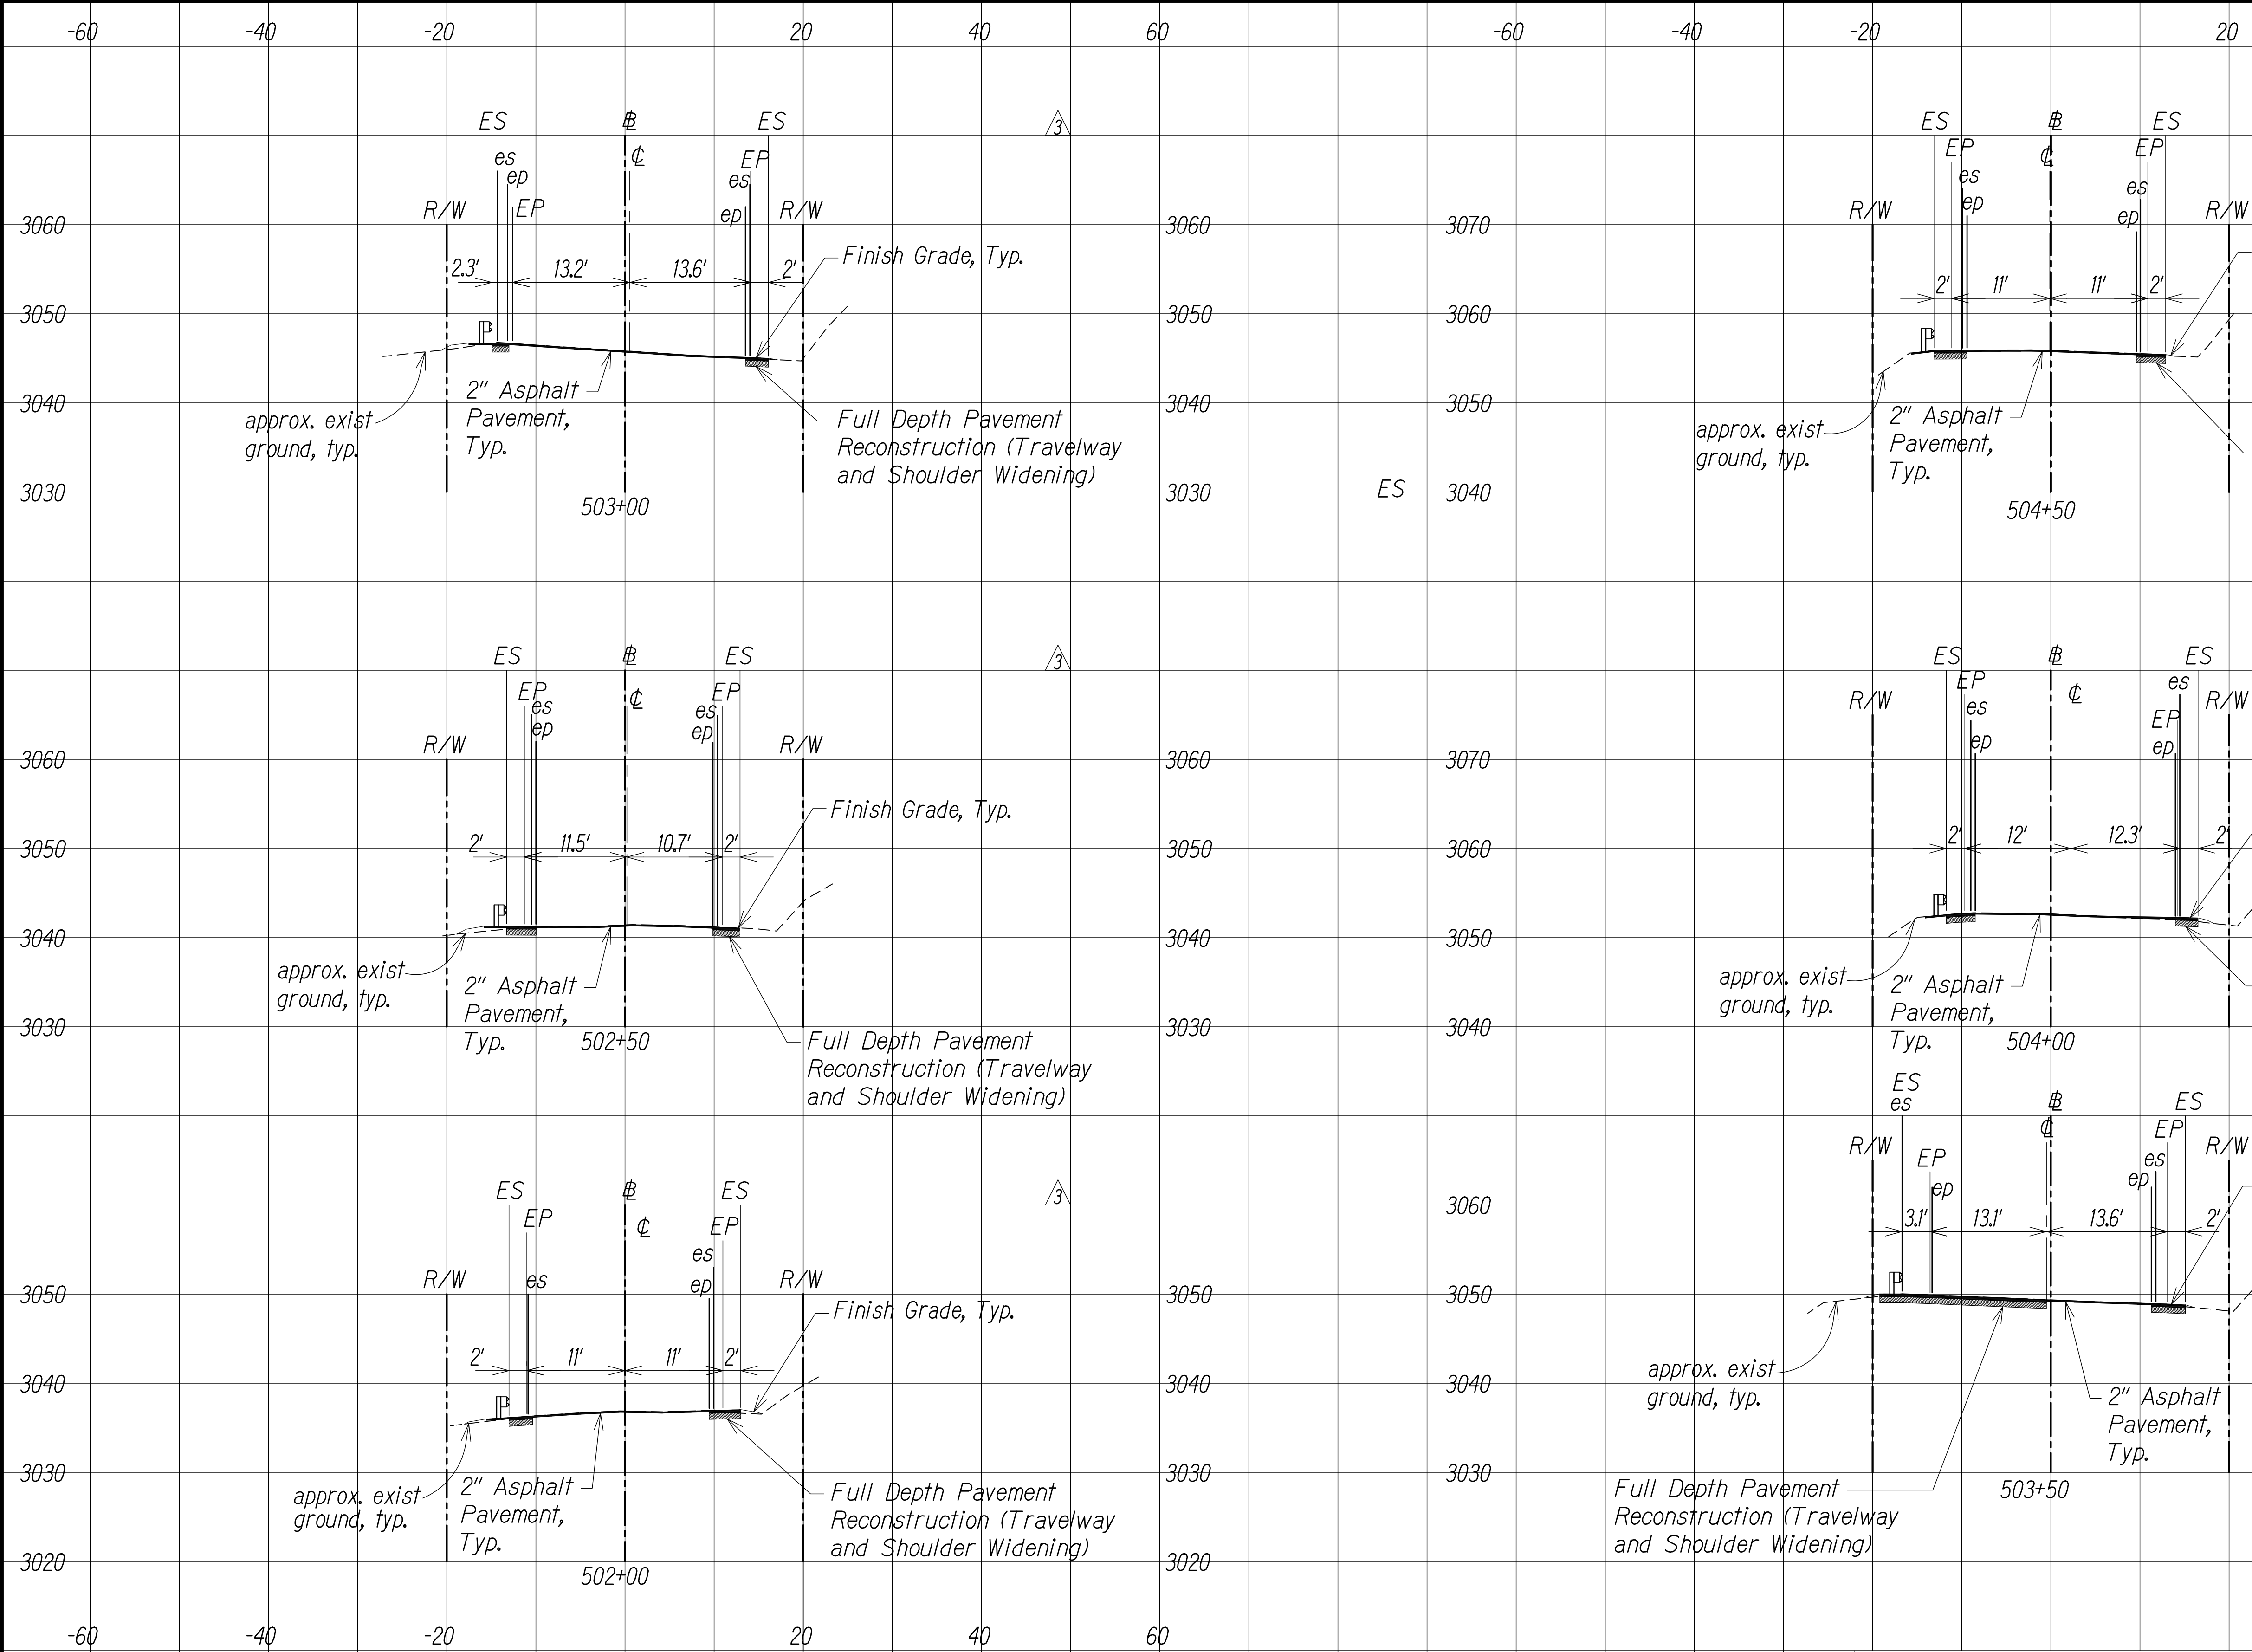

SURVEY PLOTTED BY	DATE
DESIGNED BY	
TRACED BY	
NOTED BY	
QUANTITIES BY	
CHECKED BY	

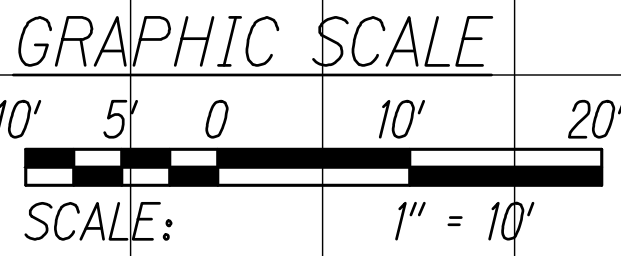

KOKEE ROAD
Scale: 1" = 10'

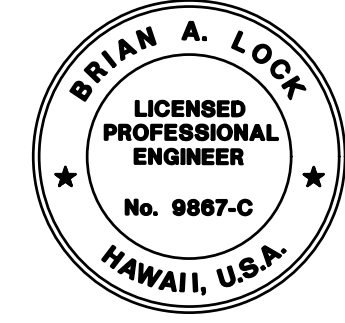

THIS WORK WAS PREPARED BY
ME OR UNDER MY SUPERVISION.
[Signature]
WILSON OKAMOTO CORPORATION
APRIL 30, 2026
LIC. EXP. DATE


STATE OF HAWAII
DEPARTMENT OF TRANSPORTATION
HIGHWAYS DIVISION
ROADWAY CROSS SECTIONS
WAIMEA CANYON DRIVE /
KOKEE ROAD IMPROVEMENTS, PHASE 2B
MILE POST 4.6 TO MILE POST 11.5
Federal-Aid Project No. STP-0550(006)
Scale: 1" = 10' Date: July 2024

12/13/24 3 Revised Sections


DATE	REVISION
------	----------

SHEET No. X89 OF 122 SHEETS

DIST. NO.	STATE	FED. AID PROJ. NO.	FISCAL YEAR	SHEET NO.	TOTAL SHEETS
KAUAI	HAW.	STP-0550(006)	2024	ADD.293	325

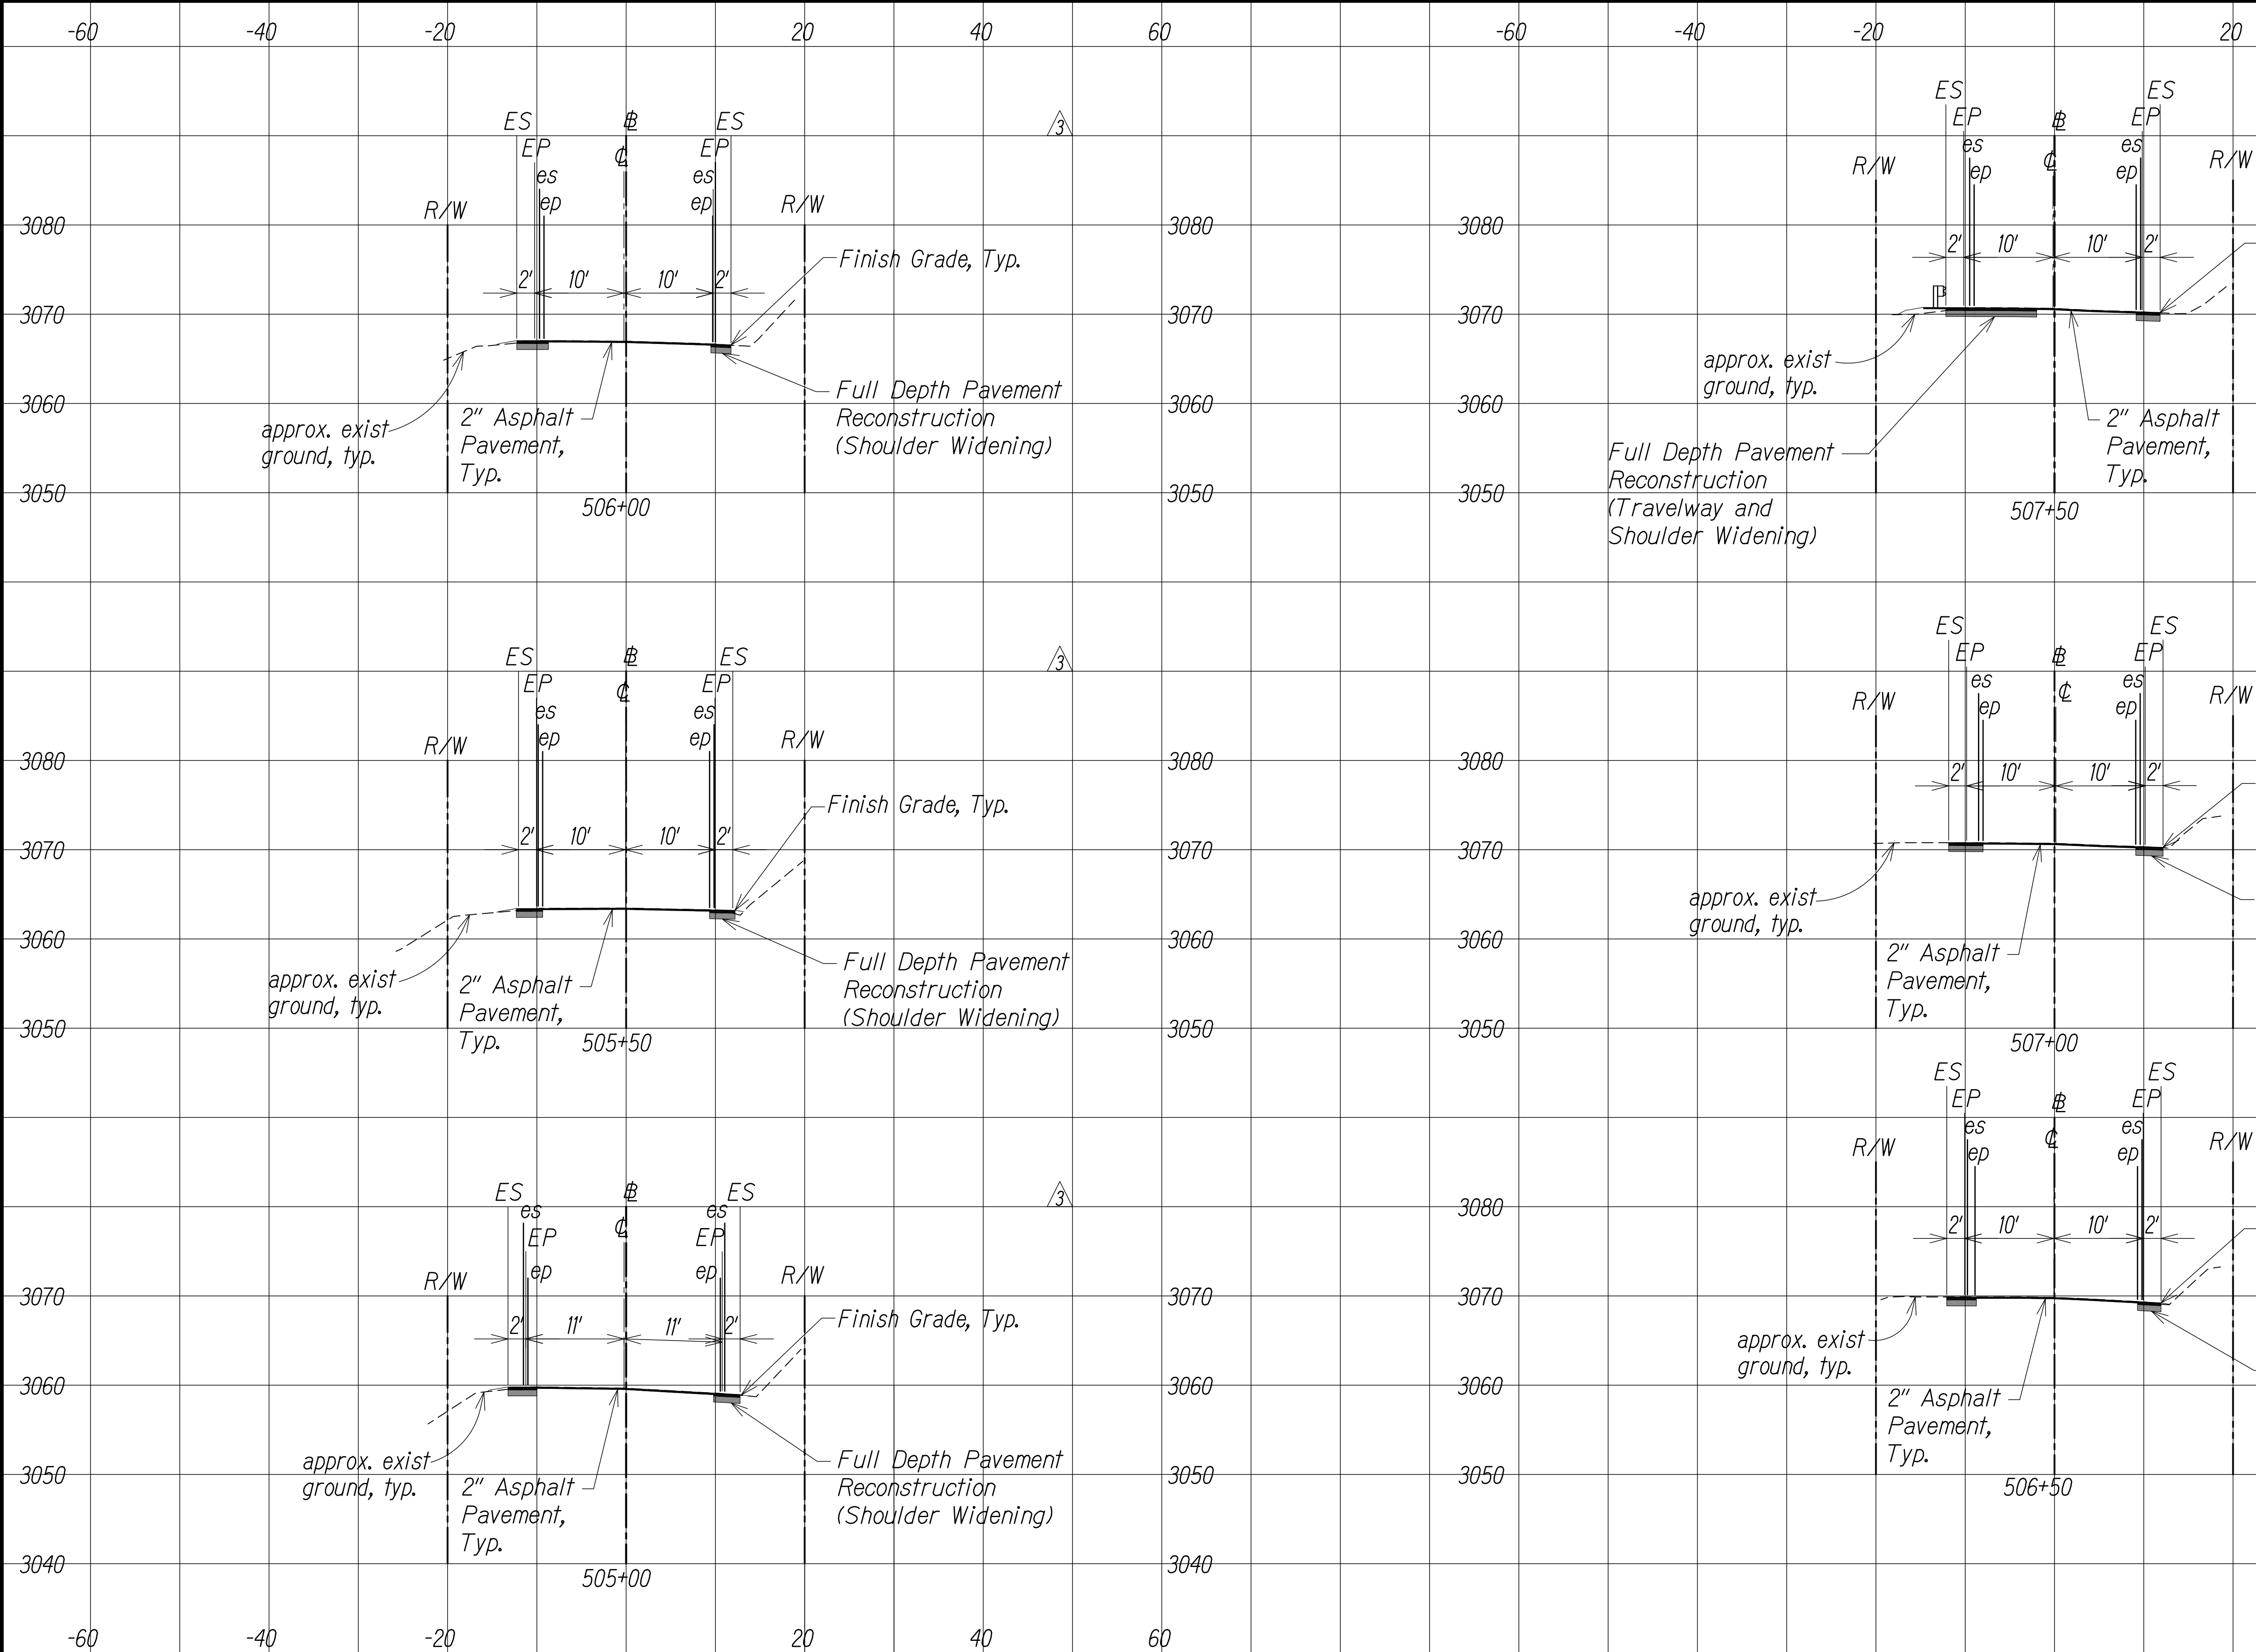

SURVEY PLOTTED BY	DATE
DESIGNED BY	
TRACED BY	
NOTED BY	
QUANTITIES BY	
CHECKED BY	

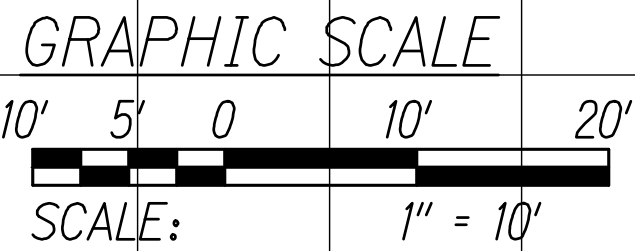

KOKEE ROAD
Scale: 1" = 10'


12/13/24 3 Revised Sections

DATE REVISION

STATE OF HAWAII
DEPARTMENT OF TRANSPORTATION
HIGHWAYS DIVISION

ROADWAY CROSS SECTIONS


WAIMEA CANYON DRIVE /
KOKEE ROAD IMPROVEMENTS, PHASE 2B
MILE POST 4.6 TO MILE POST 11.5
Federal-Aid Project No. STP-0550(006)
Scale: 1" = 10' Date: July 2024

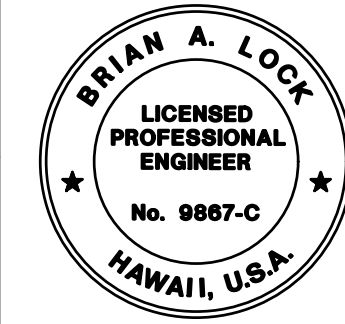


THIS WORK WAS PREPARED BY
ME OR UNDER MY SUPERVISION.
[Signature]
WILSON OKAMOTO CORPORATION
APRIL 30, 2026
LIC. EXP. DATE

SHEET No. X90 OF 122 SHEETS


DIST. NO.	STATE	FED. AID PROJ. NO.	FISCAL YEAR	SHEET NO.	TOTAL SHEETS
KAUAI	HAW.	STP-0550(006)	2024	ADD.294	325

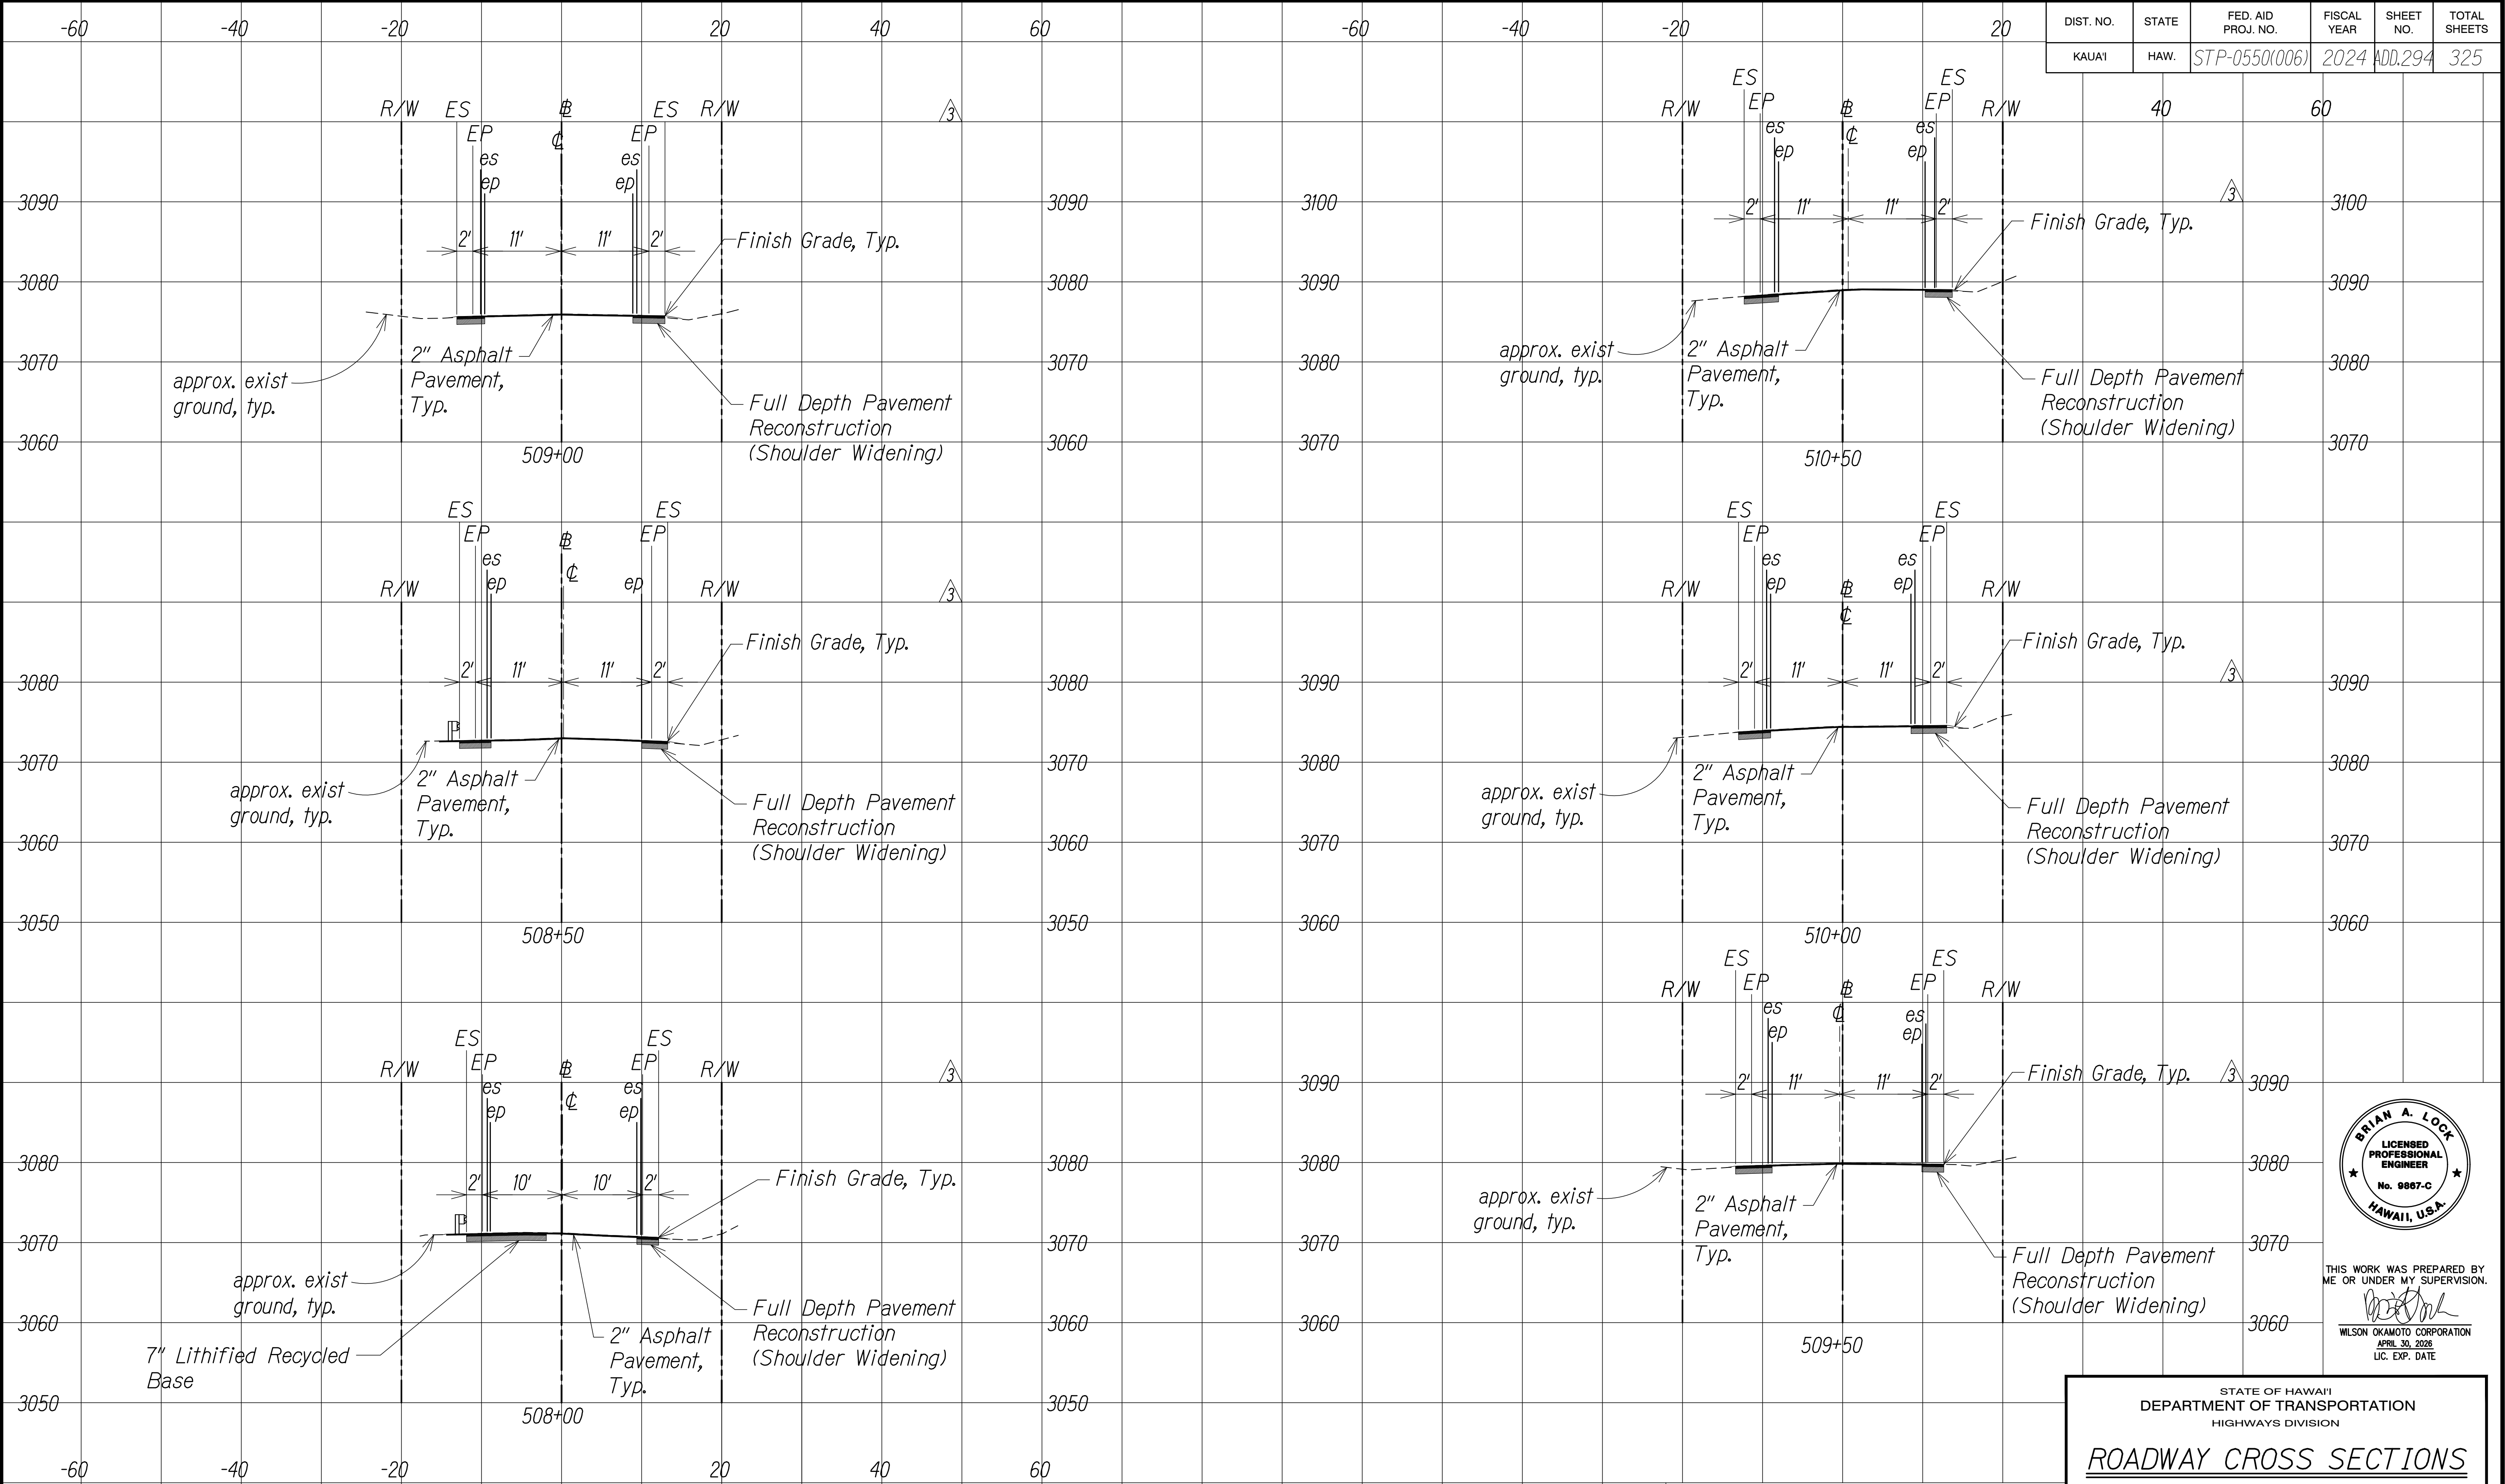

SURVEY PLOTTED BY	DATE
DESIGNED BY	
TRACED BY	
NOTED BY	
QUANTITIES BY	
CHECKED BY	

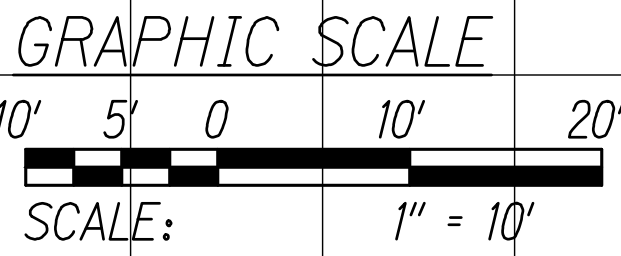

KOKEE ROAD
Scale: 1" = 10'

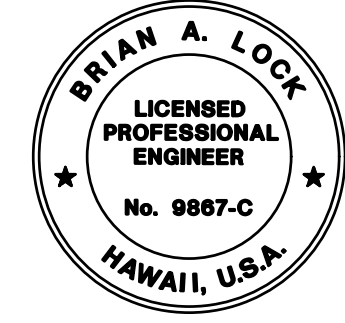

THIS WORK WAS PREPARED BY
ME OR UNDER MY SUPERVISION.
[Signature]
WILSON OKAMOTO CORPORATION
APRIL 30, 2026
LIC. EXP. DATE

STATE OF HAWAII
DEPARTMENT OF TRANSPORTATION
HIGHWAYS DIVISION


ROADWAY CROSS SECTIONS

WAIMEA CANYON DRIVE /
KOKEE ROAD IMPROVEMENTS, PHASE 2B
MILE POST 4.6 TO MILE POST 11.5
Federal-Aid Project No. STP-0550(006)
Scale: 1" = 10' Date: July 2024


DATE: 12/13/24 REVISION: 3 Revised Sections

SHEET No. X91 OF 122 SHEETS


DIST. NO.	STATE	FED. AID PROJ. NO.	FISCAL YEAR	SHEET NO.	TOTAL SHEETS
KAUAI	HAW.	STP-0550(006)	2024	ADD.296	325

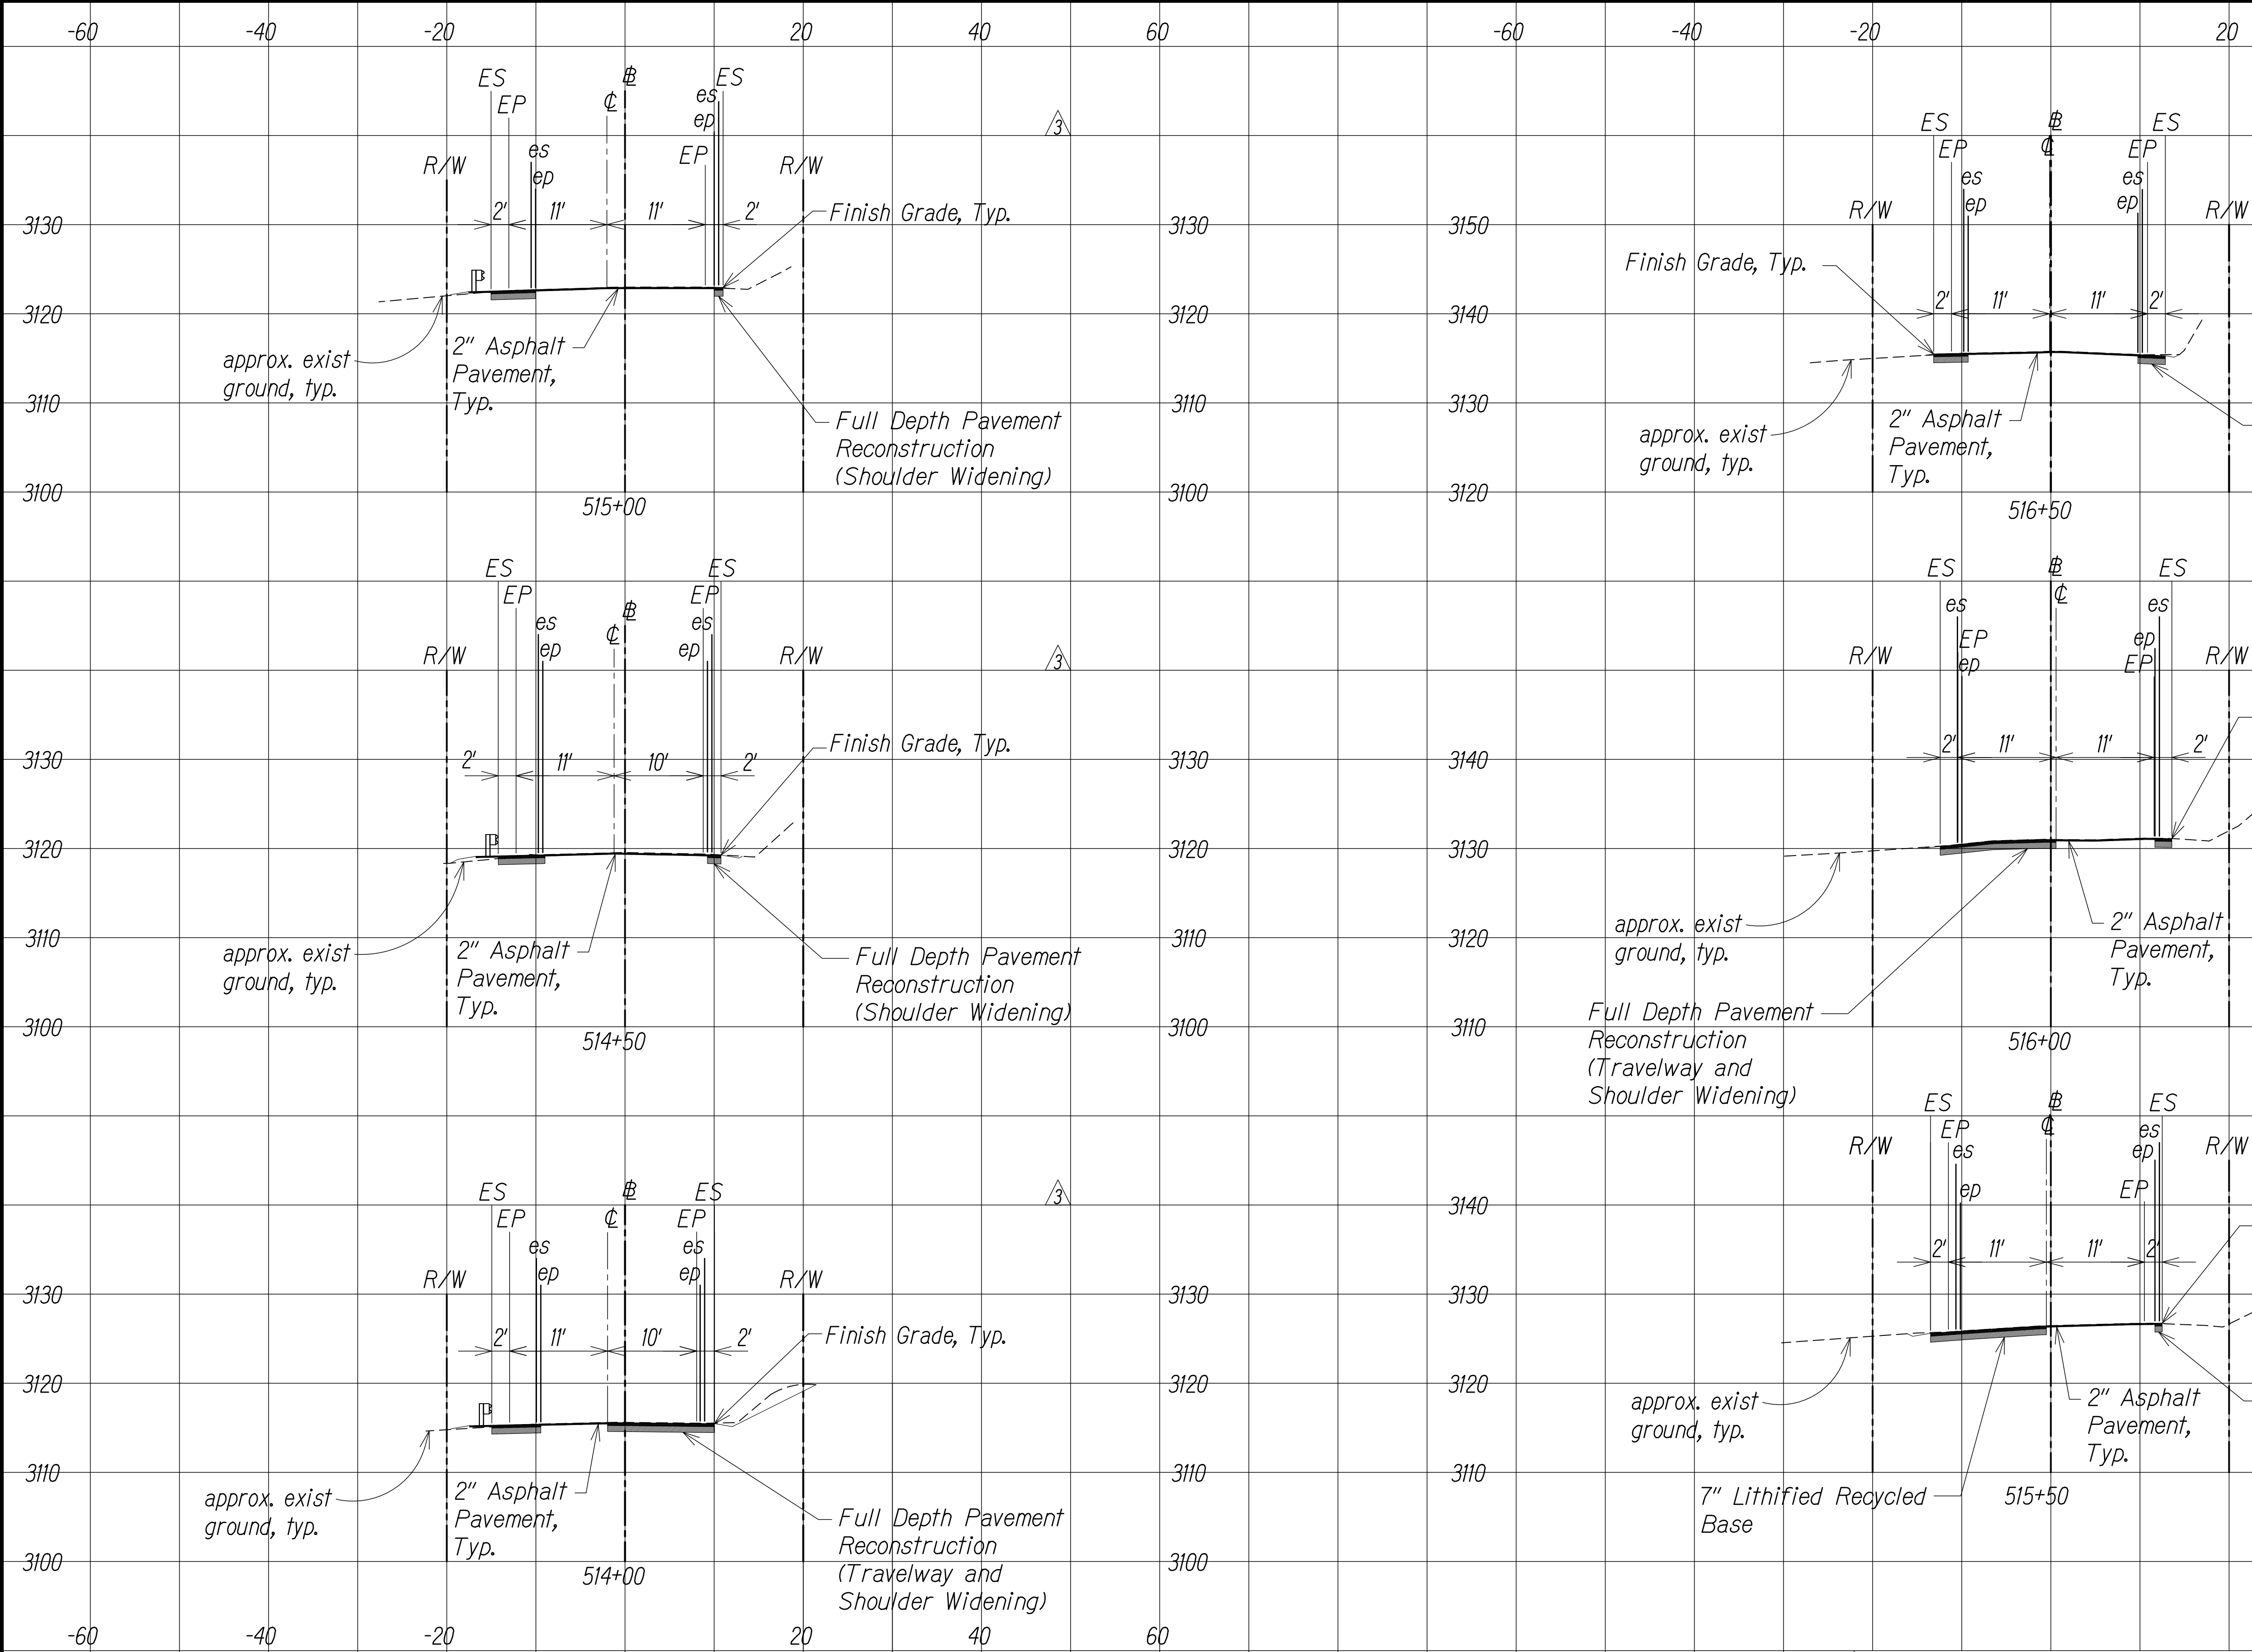

SURVEY PLOTTED BY	DATE
DESIGNED BY	
TRACED BY	
NOTED BY	
QUANTITIES BY	
CHECKED BY	

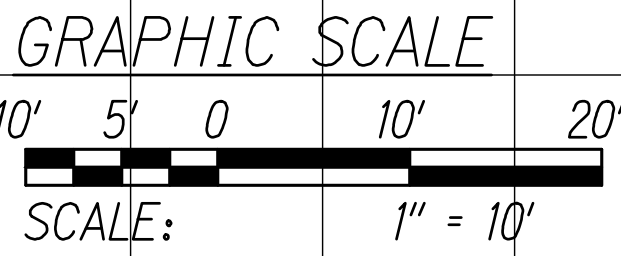

KOKEE ROAD
Scale: 1" = 10'

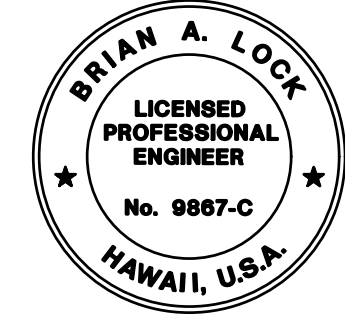

THIS WORK WAS PREPARED BY ME OR UNDER MY SUPERVISION.
WILSON OKAMOTO CORPORATION
APRIL 30, 2026
LIC. EXP. DATE

STATE OF HAWAII
DEPARTMENT OF TRANSPORTATION
HIGHWAYS DIVISION


ROADWAY CROSS SECTIONS

WAIMEA CANYON DRIVE /
KOKEE ROAD IMPROVEMENTS, PHASE 2B
MILE POST 4.6 TO MILE POST 11.5
Federal-Aid Project No. STP-0550(006)
Scale: 1" = 10' Date: July 2024

DATE: 12/13/24 REVISION: 3 Revised Sections


SHEET No. X93 OF 122 SHEETS

DIST. NO.	STATE	FED. AID PROJ. NO.	FISCAL YEAR	SHEET NO.	TOTAL SHEETS
KAUAI	HAW.	STP-0550(006)	2024	ADD.297	325

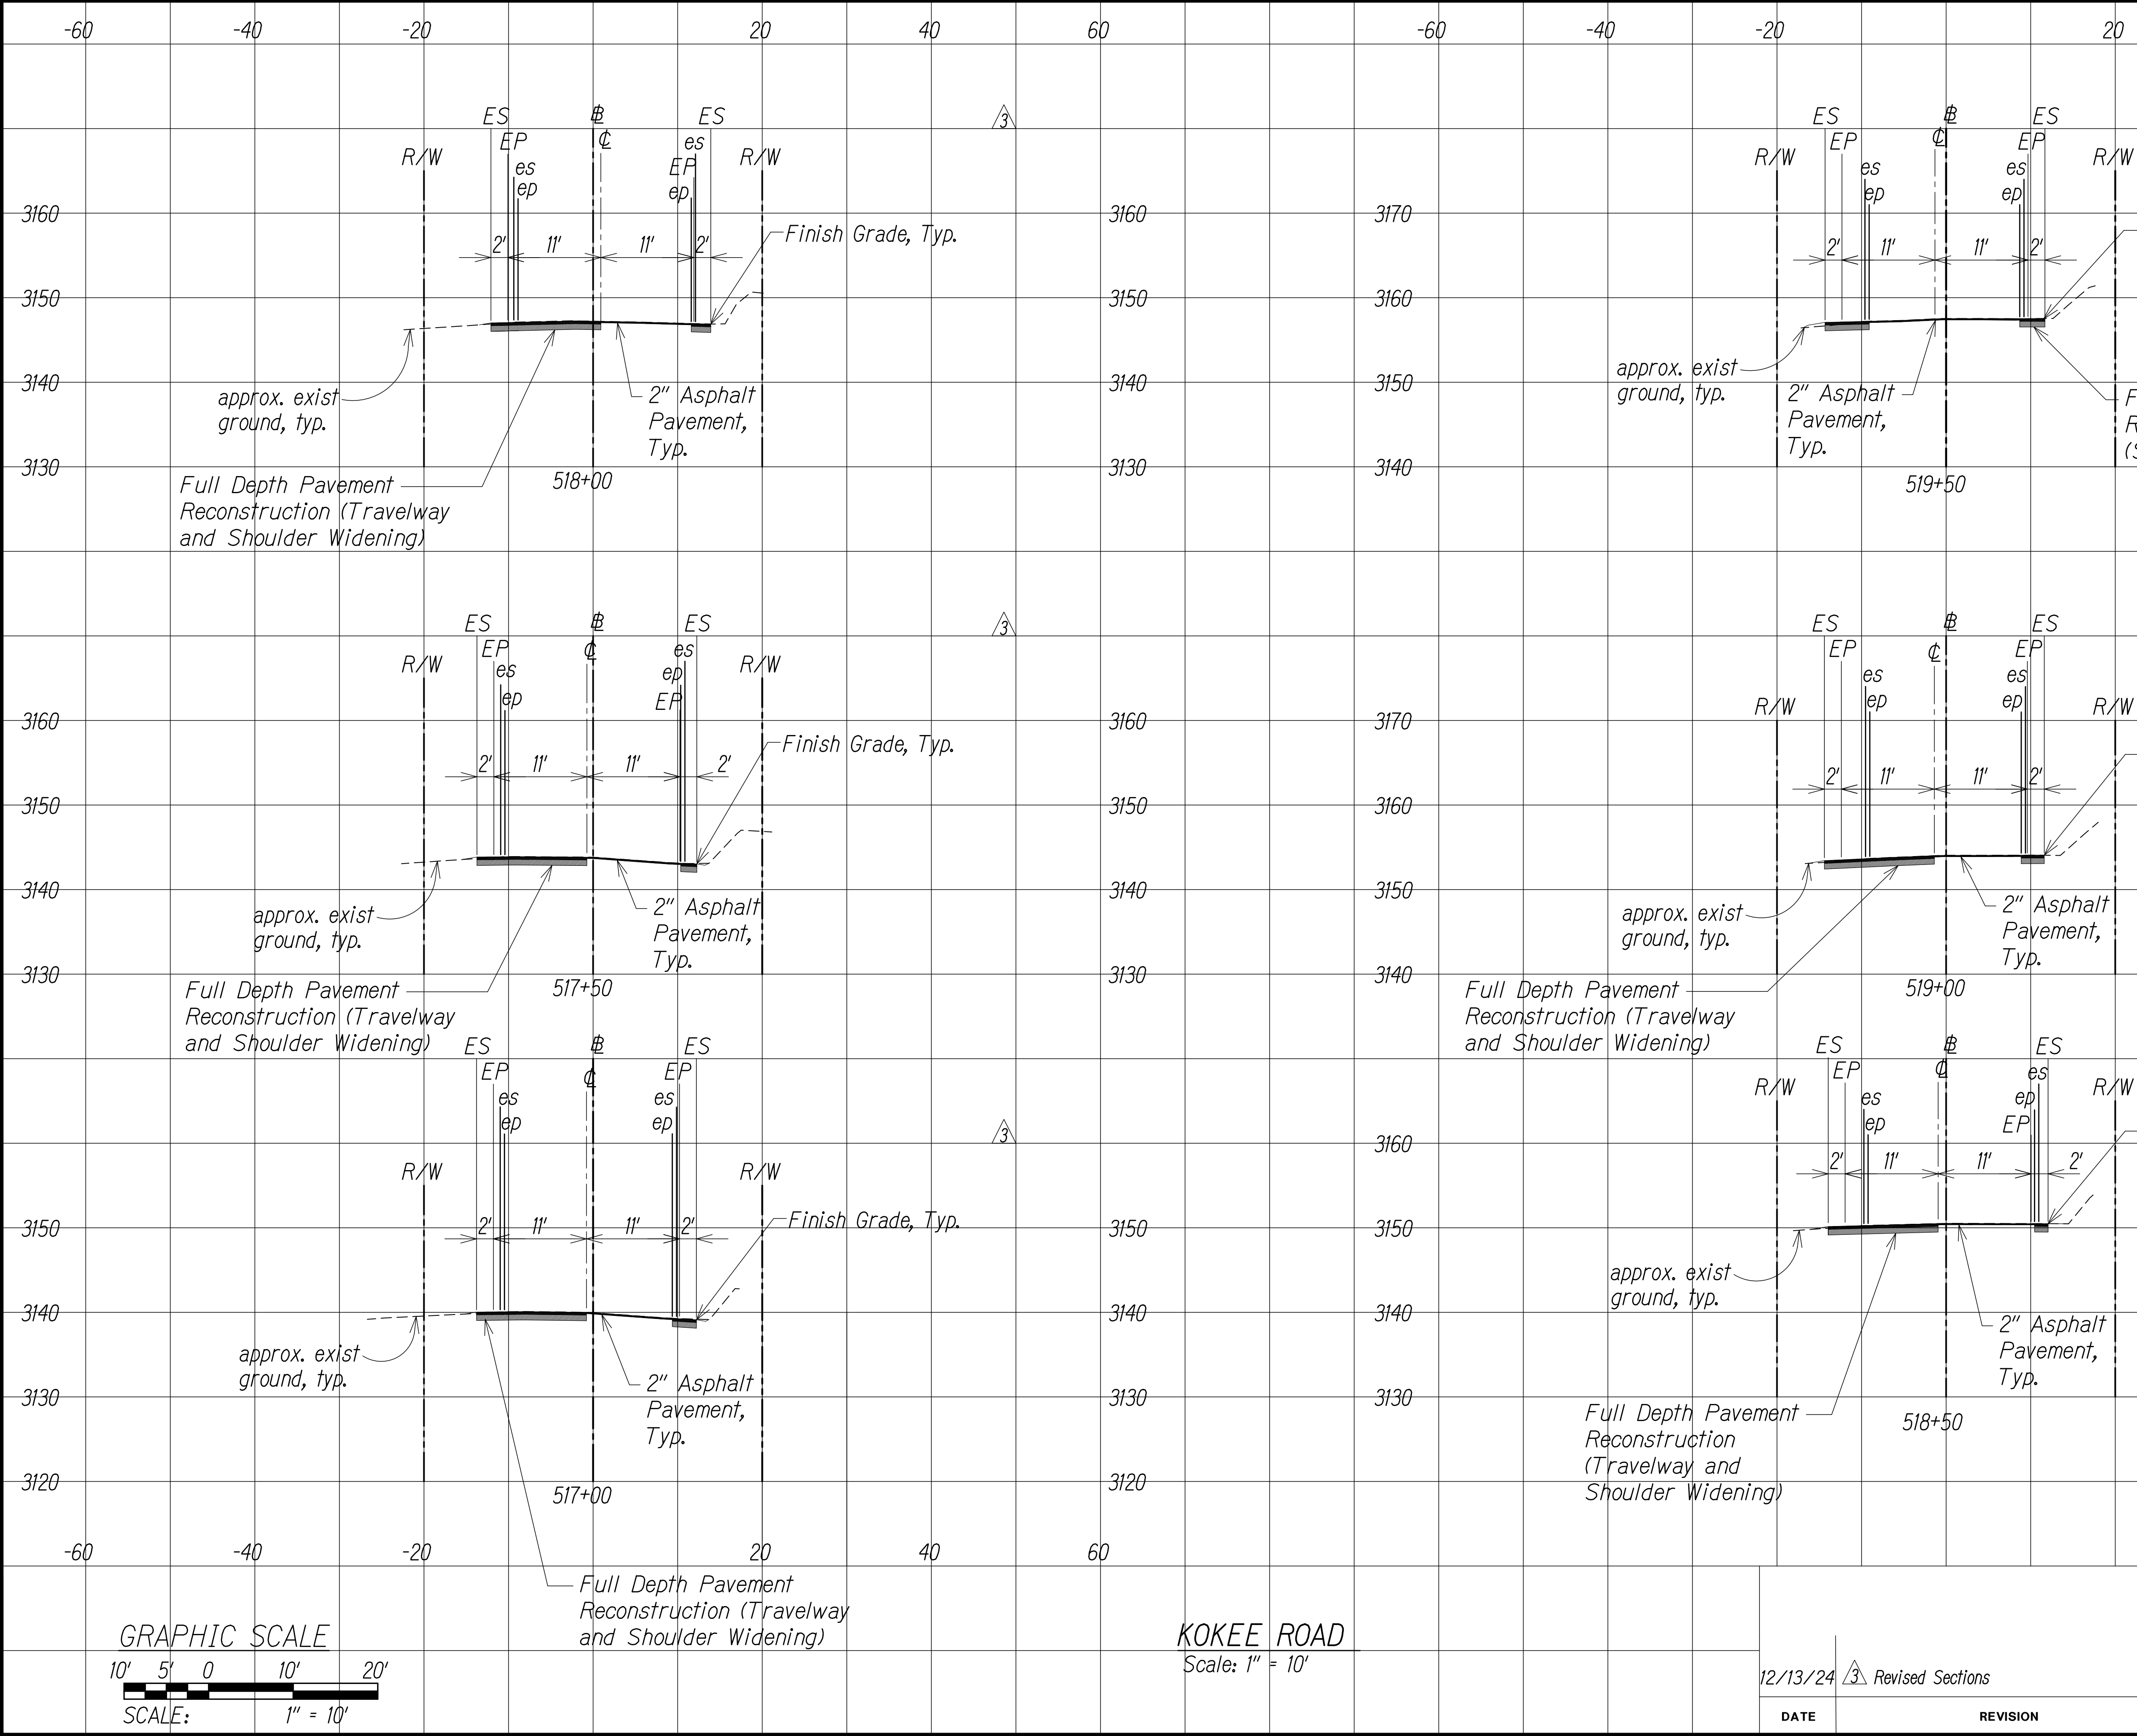

SURVEY PLOTTED BY	DATE
DESIGNED BY	
TRACED BY	
QUANTITIES BY	
CHECKED BY	


ORIGINAL PLAN	NOTE BOOK
No.	No.

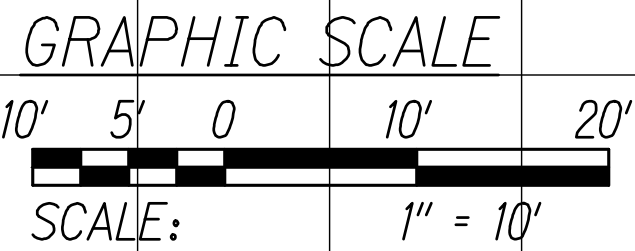

KOKEE ROAD
Scale: 1" = 10'

12/13/24 3 Revised Sections


DATE REVISION

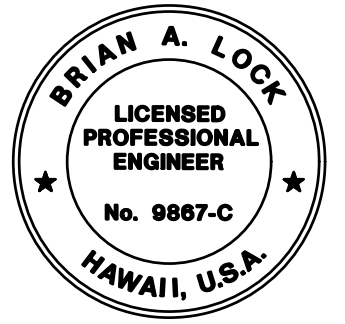

THIS WORK WAS PREPARED BY ME OR UNDER MY SUPERVISION.
WILSON OKAMOTO CORPORATION
APRIL 30, 2026
LIC. EXP. DATE

STATE OF HAWAII
DEPARTMENT OF TRANSPORTATION
HIGHWAYS DIVISION
ROADWAY CROSS SECTIONS
WAIMEA CANYON DRIVE /
KOKEE ROAD IMPROVEMENTS, PHASE 2B
MILE POST 4.6 TO MILE POST 11.5
Federal-Aid Project No. STP-0550(006)
Scale: 1" = 10' Date: July 2024


SHEET No. X94 OF 122 SHEETS

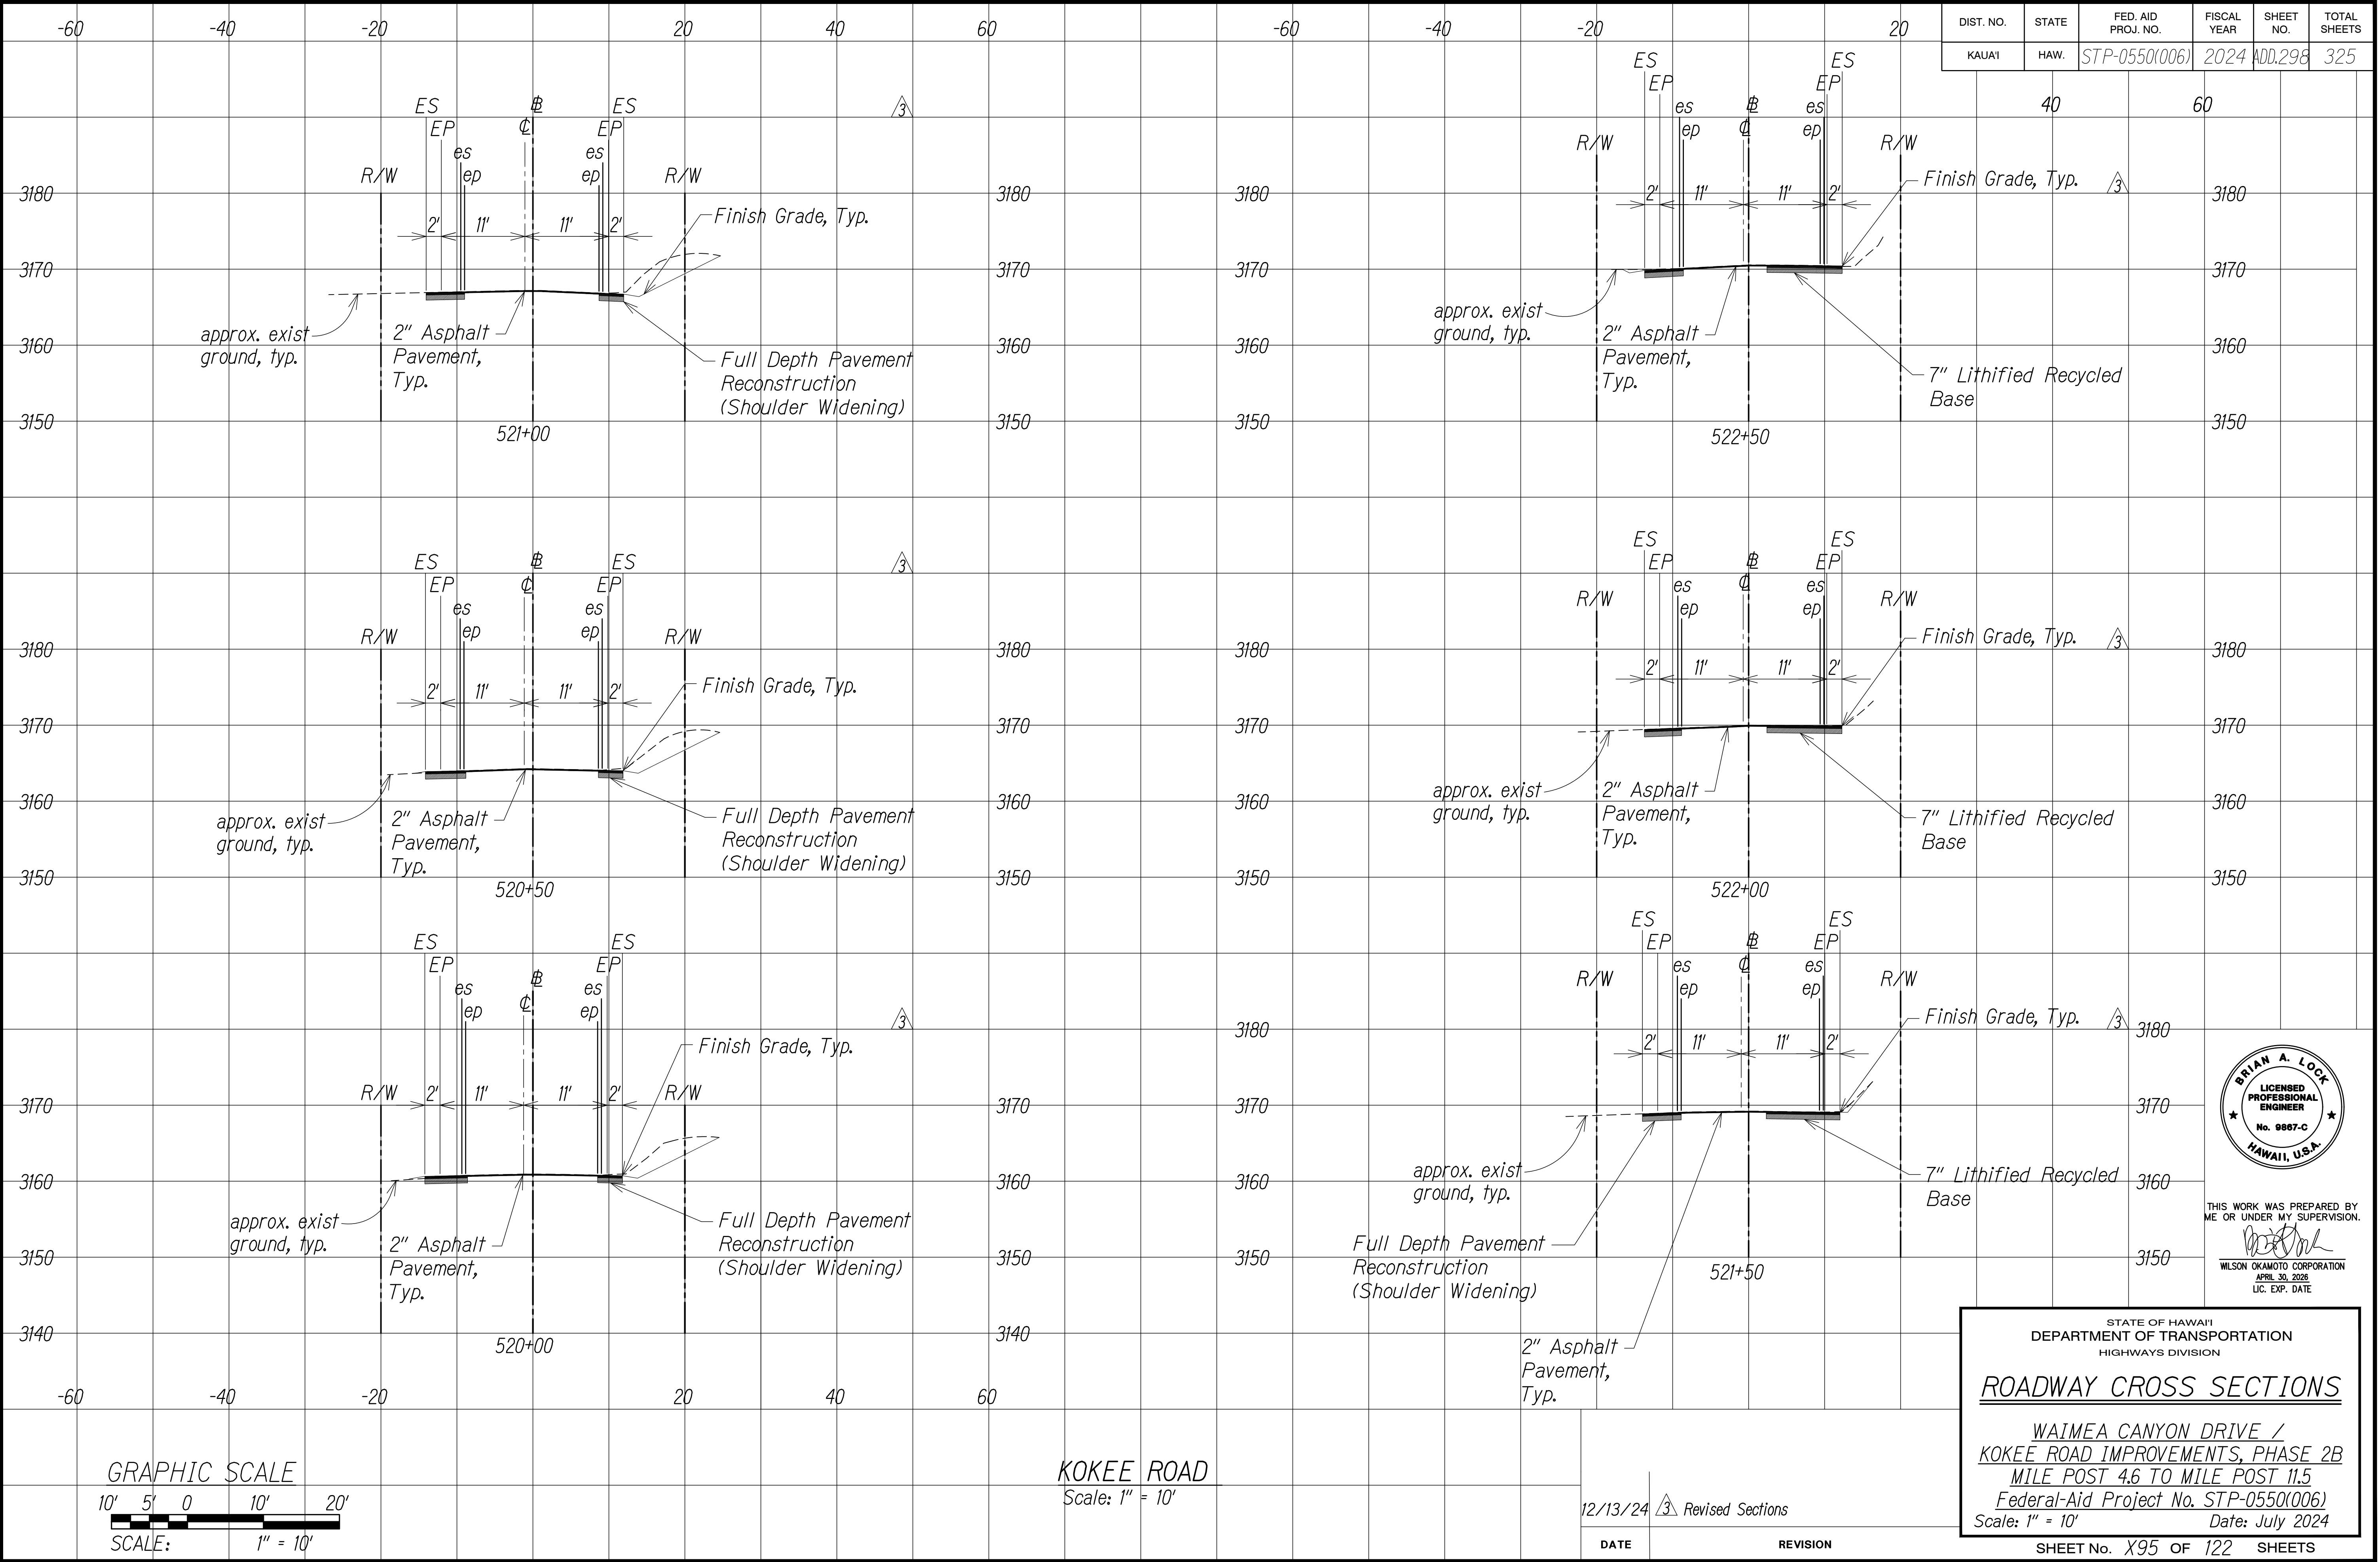

DIST. NO.	STATE	FED. AID PROJ. NO.	FISCAL YEAR	SHEET NO.	TOTAL SHEETS
KAUAI	HAW.	STP-0550(006)	2024	ADD.298	325

SURVEY PLOTTED BY	DATE
DESIGNED BY	
TRACED BY	
DESIGNED BY	
QUANTITIES BY	
CHECKED BY	

ORIGINAL PLAN	No.
NOTE BOOK	

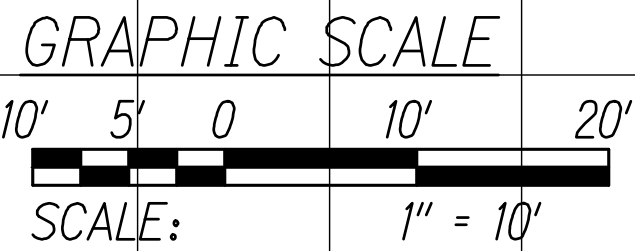


KOKEE ROAD

Scale: 1" = 10'

12/13/24 3 Revised Sections

DATE REVISION

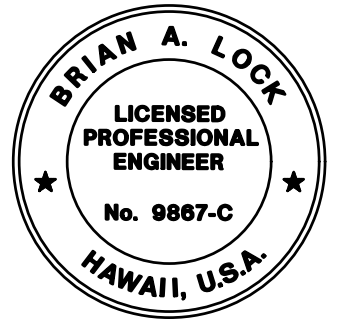

THIS WORK WAS PREPARED BY ME OR UNDER MY SUPERVISION.

[Signature]


WILSON OKAMOTO CORPORATION
APRIL 30, 2026
LIC. EXP. DATE

STATE OF HAWAII
DEPARTMENT OF TRANSPORTATION
HIGHWAYS DIVISION

ROADWAY CROSS SECTIONS


WAIMEA CANYON DRIVE /
KOKEE ROAD IMPROVEMENTS, PHASE 2B
MILE POST 4.6 TO MILE POST 11.5
Federal-Aid Project No. STP-0550(006)
Scale: 1" = 10' Date: July 2024

SHEET No. X95 OF 122 SHEETS

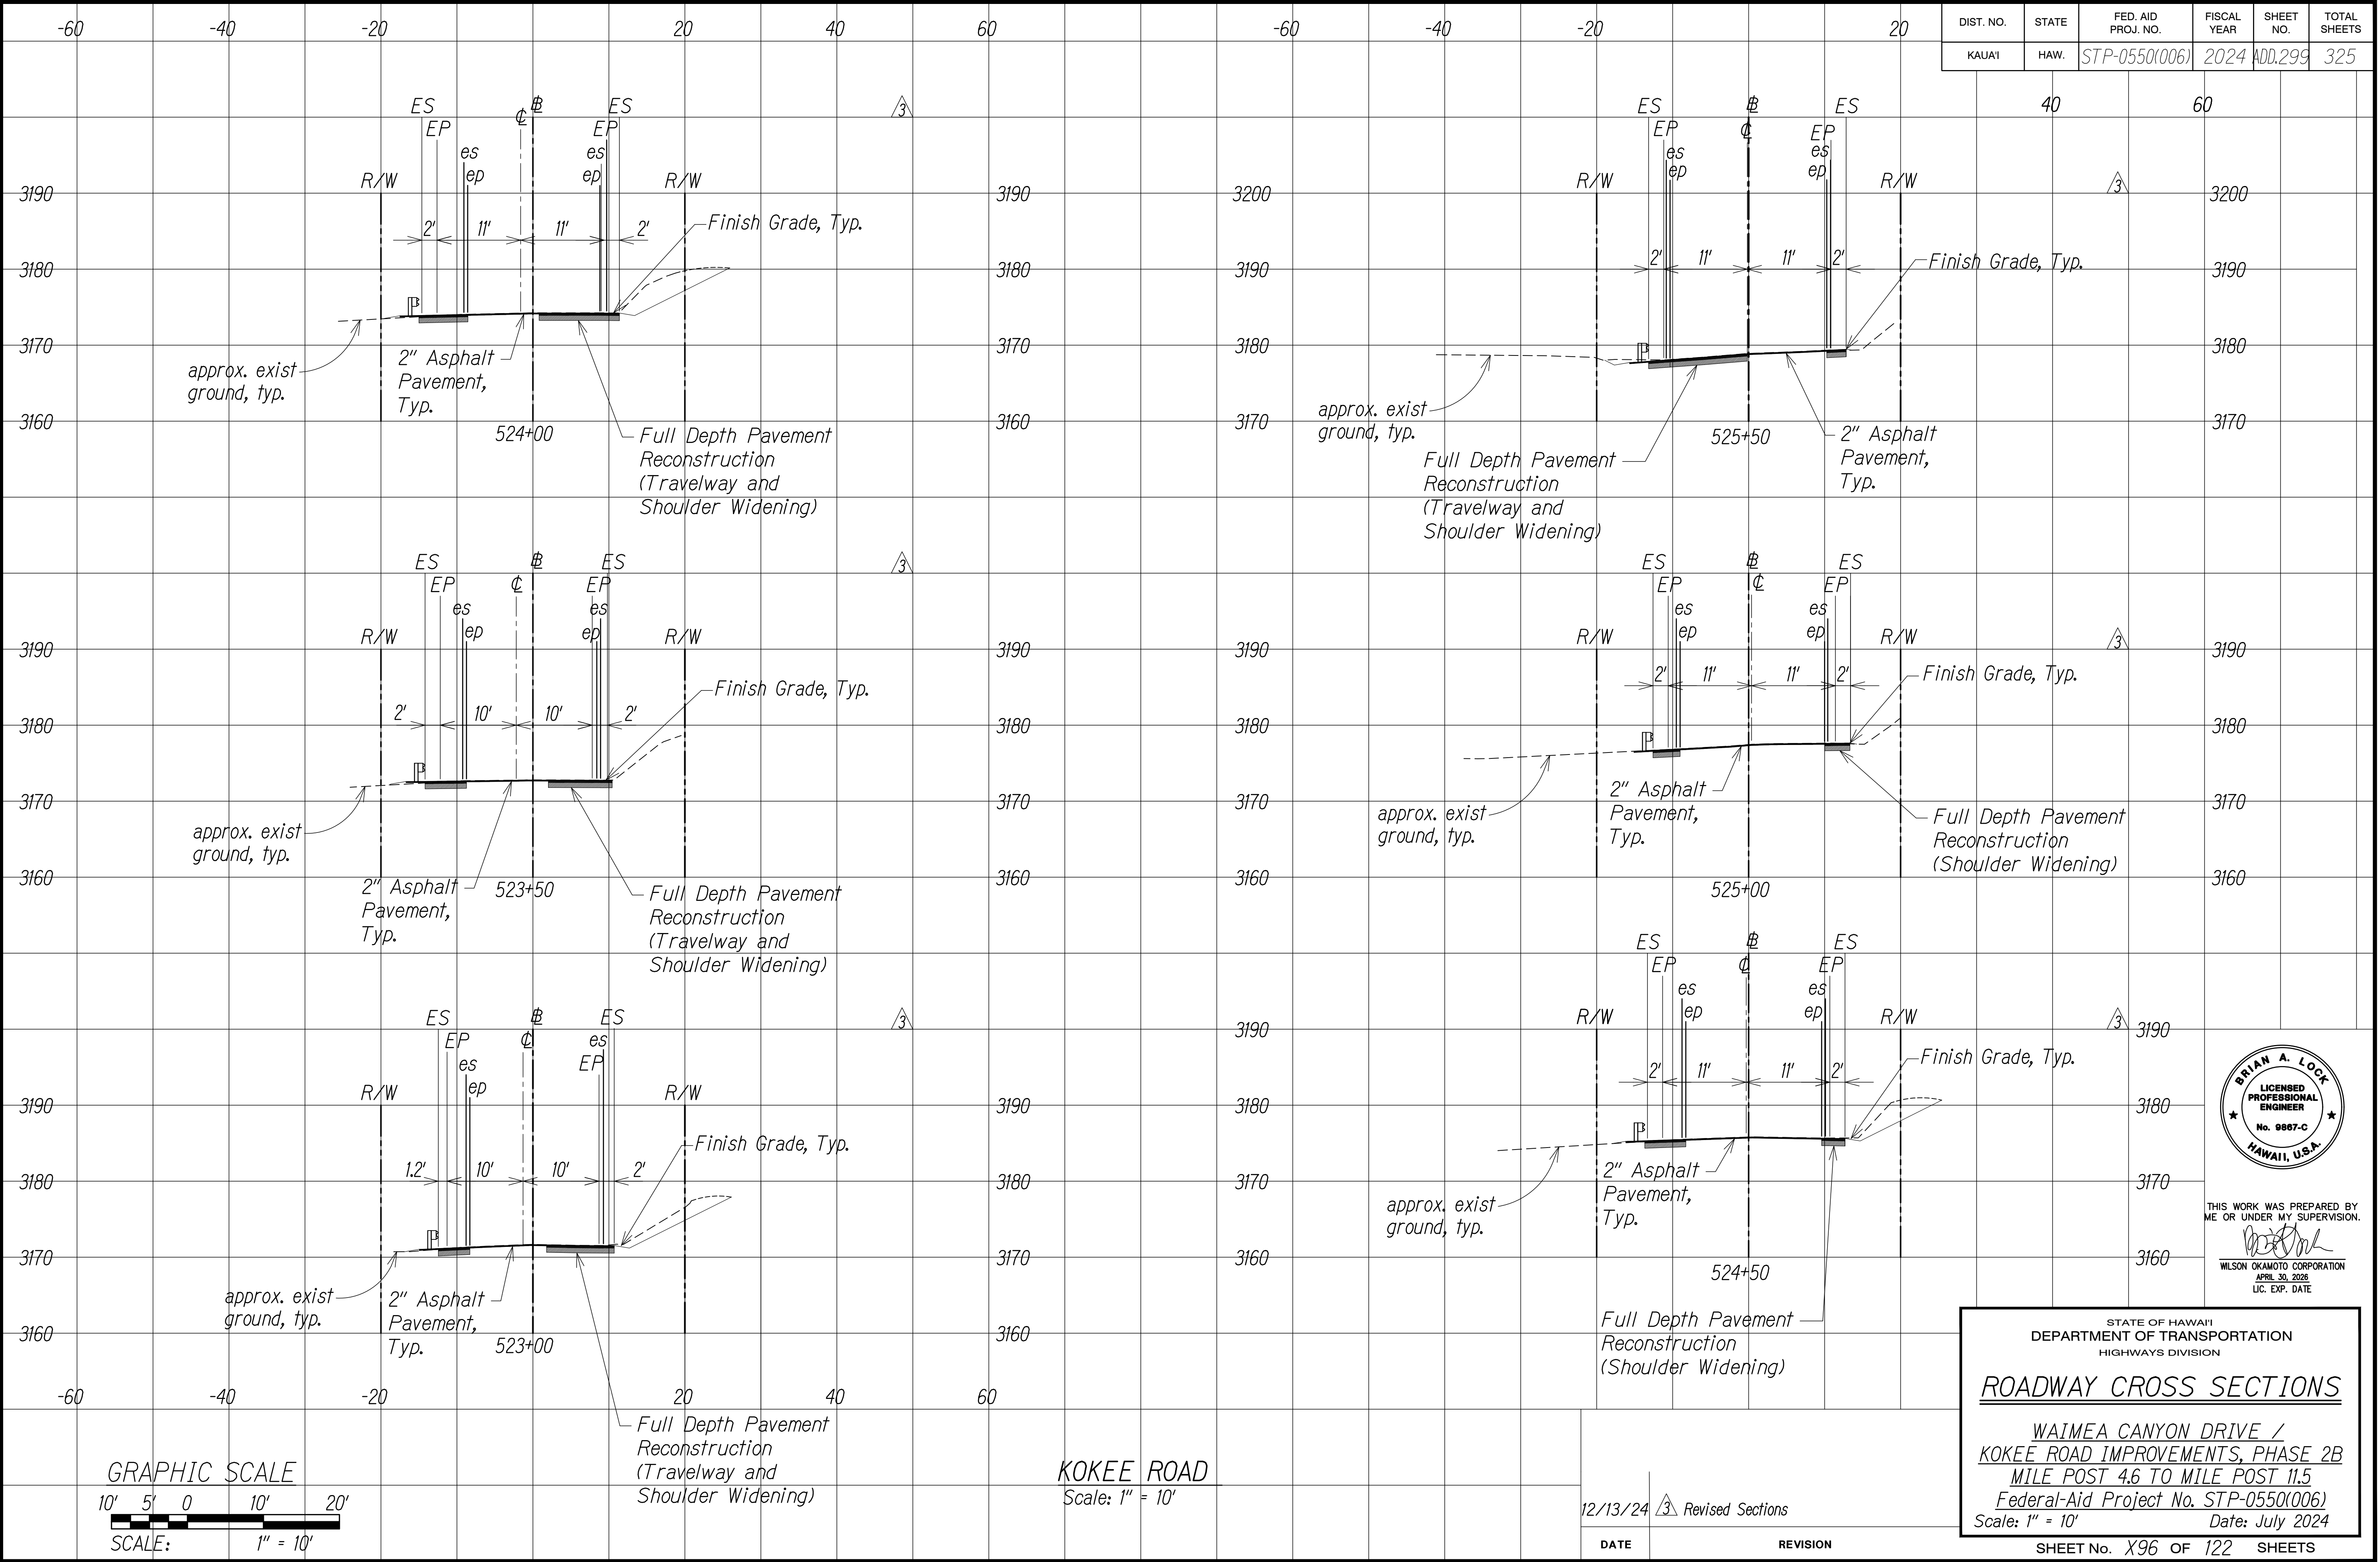

DIST. NO.	STATE	FED. AID PROJ. NO.	FISCAL YEAR	SHEET NO.	TOTAL SHEETS
KAUA'I	HAW.	STP-0550(006)	2024	ADD.299	325

SURVEY PLOTTED BY	DATE
DESIGNED BY	
TRACED BY	
NOTE BOOK	
QUANTITIES BY	
CHECKED BY	

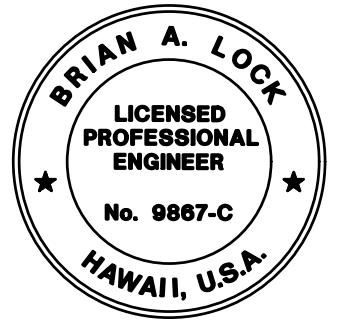


THIS WORK WAS PREPARED BY
ME OR UNDER MY SUPERVISION.
[Signature]
WILSON OKAMOTO CORPORATION
APRIL 30, 2026
LIC. EXP. DATE

STATE OF HAWAII
DEPARTMENT OF TRANSPORTATION
HIGHWAYS DIVISION
ROADWAY CROSS SECTIONS
WAIMEA CANYON DRIVE /
Kokee Road Improvements, Phase 2B
MILE POST 4.6 TO MILE POST 11.5
Federal-Aid Project No. STP-0550(006)
Scale: 1" = 10' Date: July 2024

12/13/24 3 Revised Sections


DATE REVISION

SHEET No. X96 OF 122 SHEETS

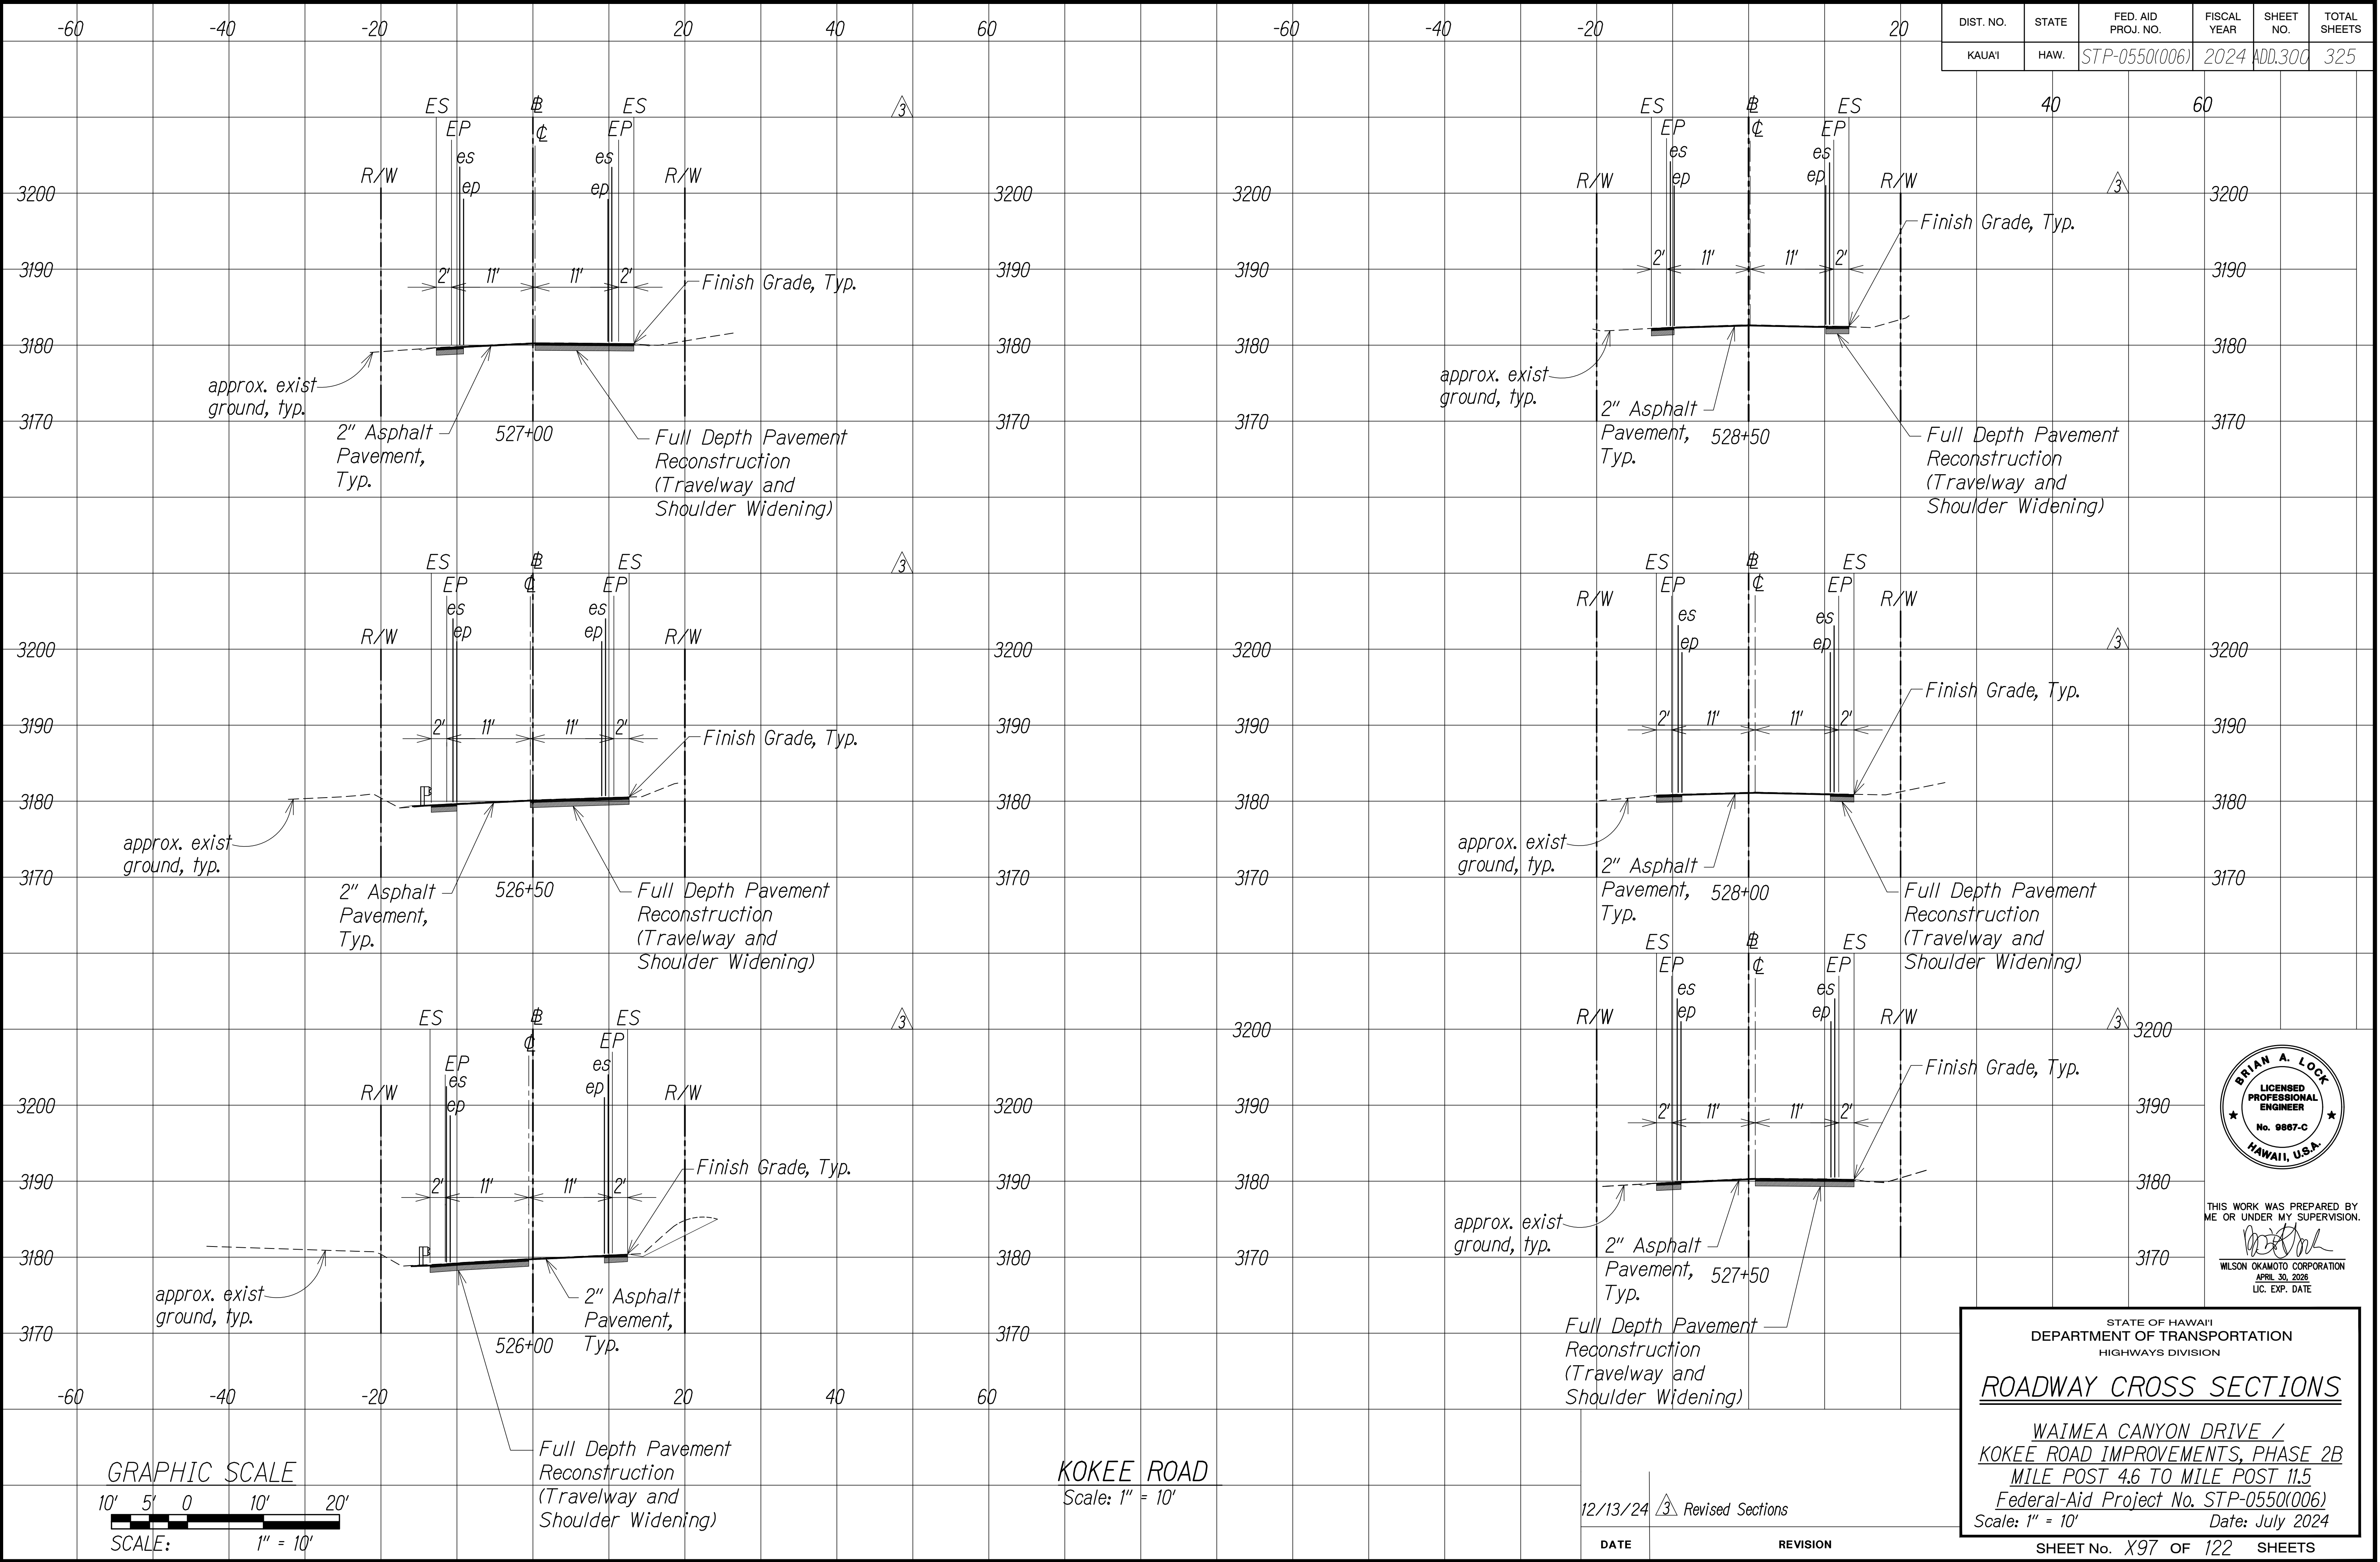


SURVEY PLOTTED BY	DATE
DESIGNED BY	
TRACED BY	
QUANTITIES BY	
CHECKED BY	

ORIGINAL PLAN	No.
NOTE BOOK	

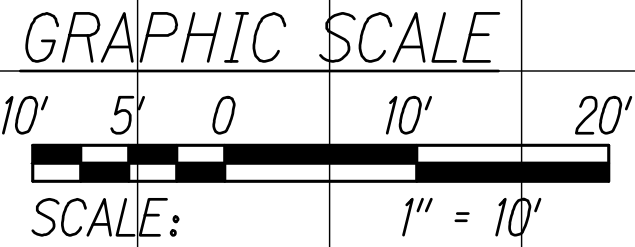

KOKEE ROAD

Scale: 1" = 10'

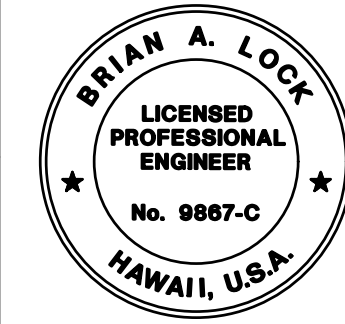

THIS WORK WAS PREPARED BY
ME OR UNDER MY SUPERVISION.

[Signature]

WILSON OKAMOTO CORPORATION
APRIL 30, 2026
LIC. EXP. DATE

STATE OF HAWAII
DEPARTMENT OF TRANSPORTATION
HIGHWAYS DIVISION

ROADWAY CROSS SECTIONS

WAIMEA CANYON DRIVE /
KOKEE ROAD IMPROVEMENTS, PHASE 2B
MILE POST 4.6 TO MILE POST 11.5
Federal-Aid Project No. STP-0550(006)
Scale: 1" = 10' Date: July 2024

12/13/24 3 Revised Sections


DATE REVISION

SHEET No. X97 OF 122 SHEETS

ADD300


DIST. NO.	STATE	FED. AID PROJ. NO.	FISCAL YEAR	SHEET NO.	TOTAL SHEETS
KAUAI	HAW.	STP-0550(006)	2024	ADD.300	325

DIST. NO.	STATE	FED. AID PROJ. NO.	FISCAL YEAR	SHEET NO.	TOTAL SHEETS
KAUAI	HAW.	STP-0550(006)	2024	ADD.301	325

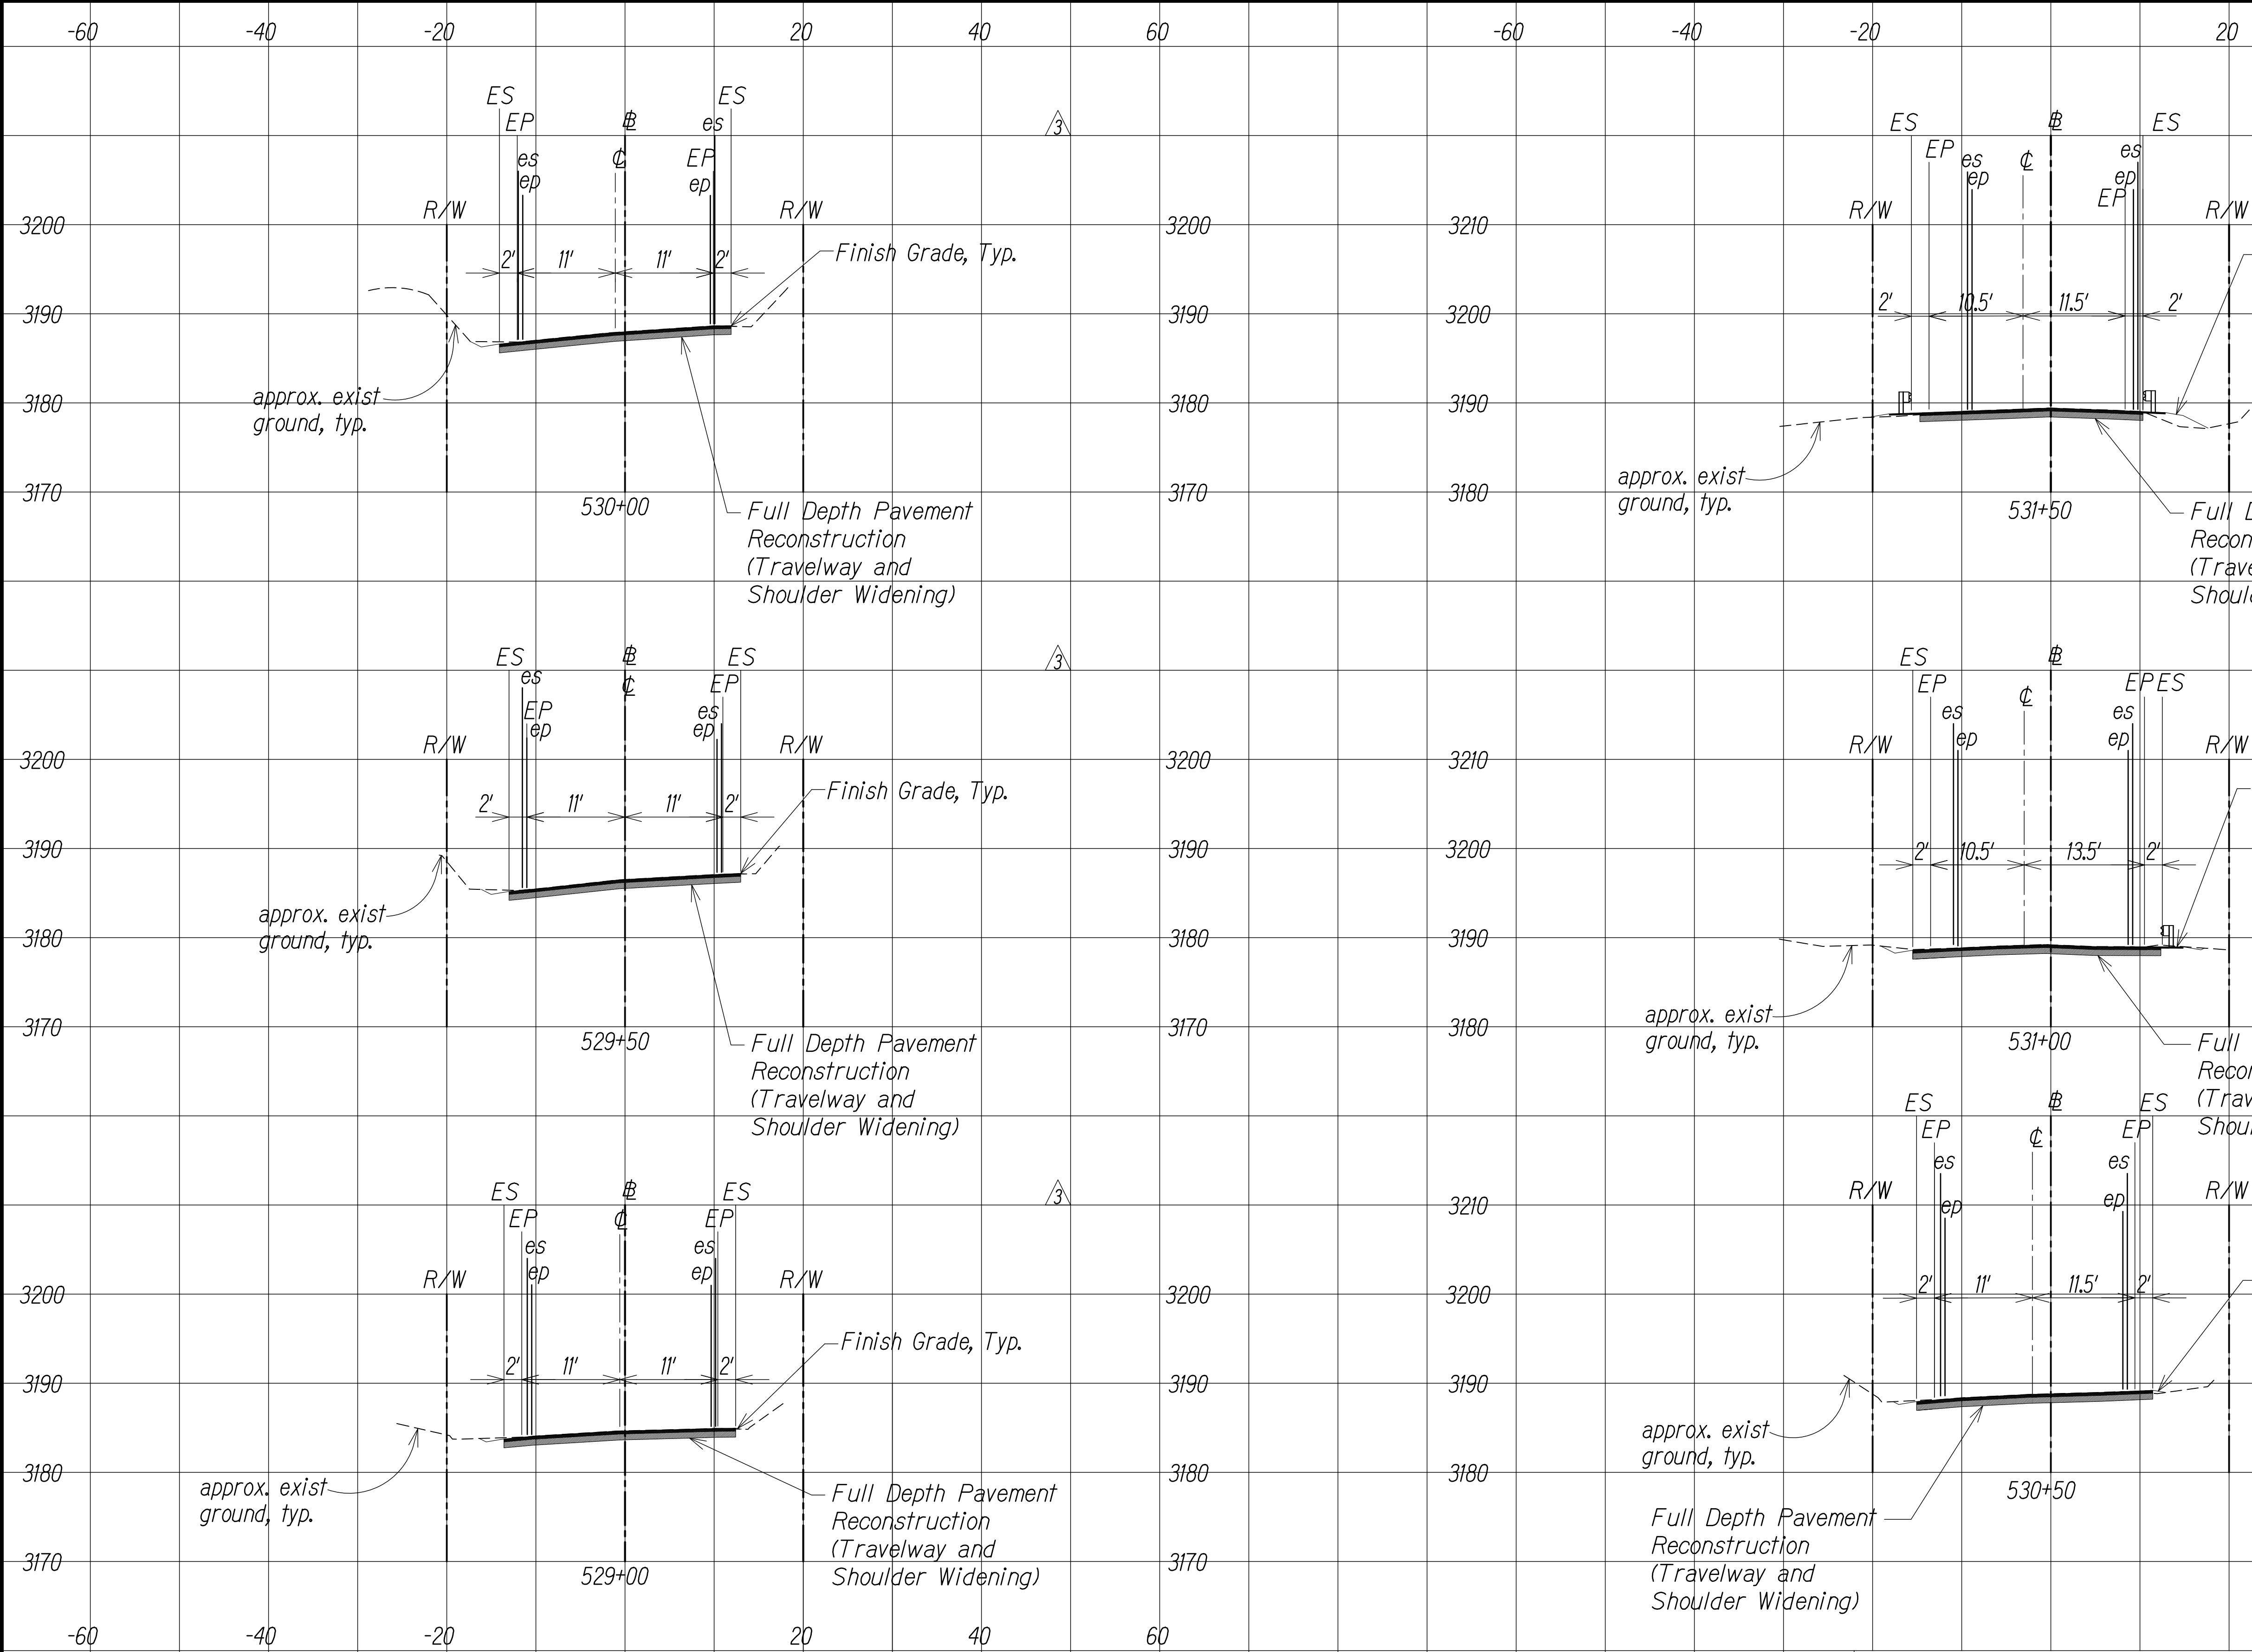

SURVEY PLOTTED BY	DATE
DESIGNED BY	
TRACED BY	
QUANTITIES BY	
CHECKED BY	


ORIGINAL PLAN	No.
NOTE BOOK	

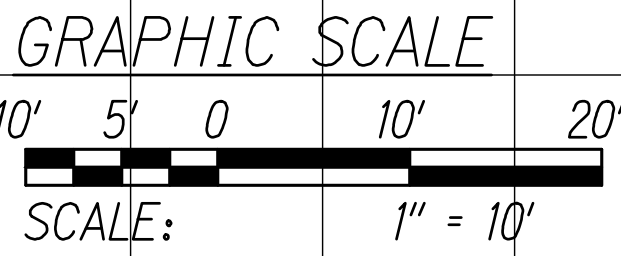

KOKEE ROAD
Scale: 1" = 10'

12/13/24 3 Revised Sections

DATE	REVISION
------	----------

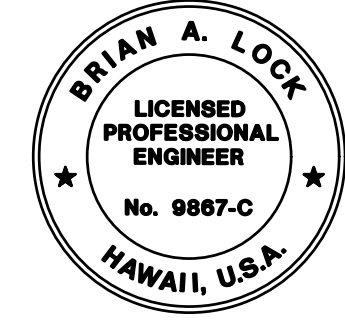



THIS WORK WAS PREPARED BY
ME OR UNDER MY SUPERVISION.
[Signature]
WILSON OKAMOTO CORPORATION
APRIL 30, 2026
LIC. EXP. DATE

STATE OF HAWAII
DEPARTMENT OF TRANSPORTATION
HIGHWAYS DIVISION
ROADWAY CROSS SECTIONS
WAIMEA CANYON DRIVE /
KOKEE ROAD IMPROVEMENTS, PHASE 2B
MILE POST 4.6 TO MILE POST 11.5
Federal-Aid Project No. STP-0550(006)
Scale: 1" = 10' Date: July 2024

SHEET No. X98 OF 122 SHEETS

ADD301

DIST. NO.	STATE	FED. AID PROJ. NO.	FISCAL YEAR	SHEET NO.	TOTAL SHEETS
KAUAI	HAW.	STP-0550(006)	2024	ADD.302	325

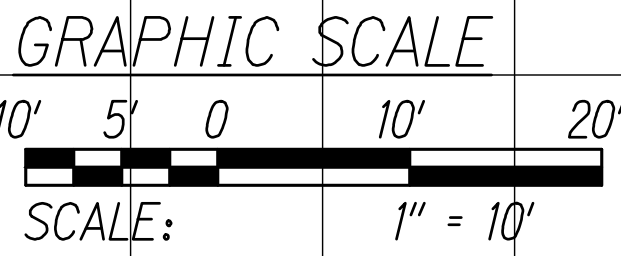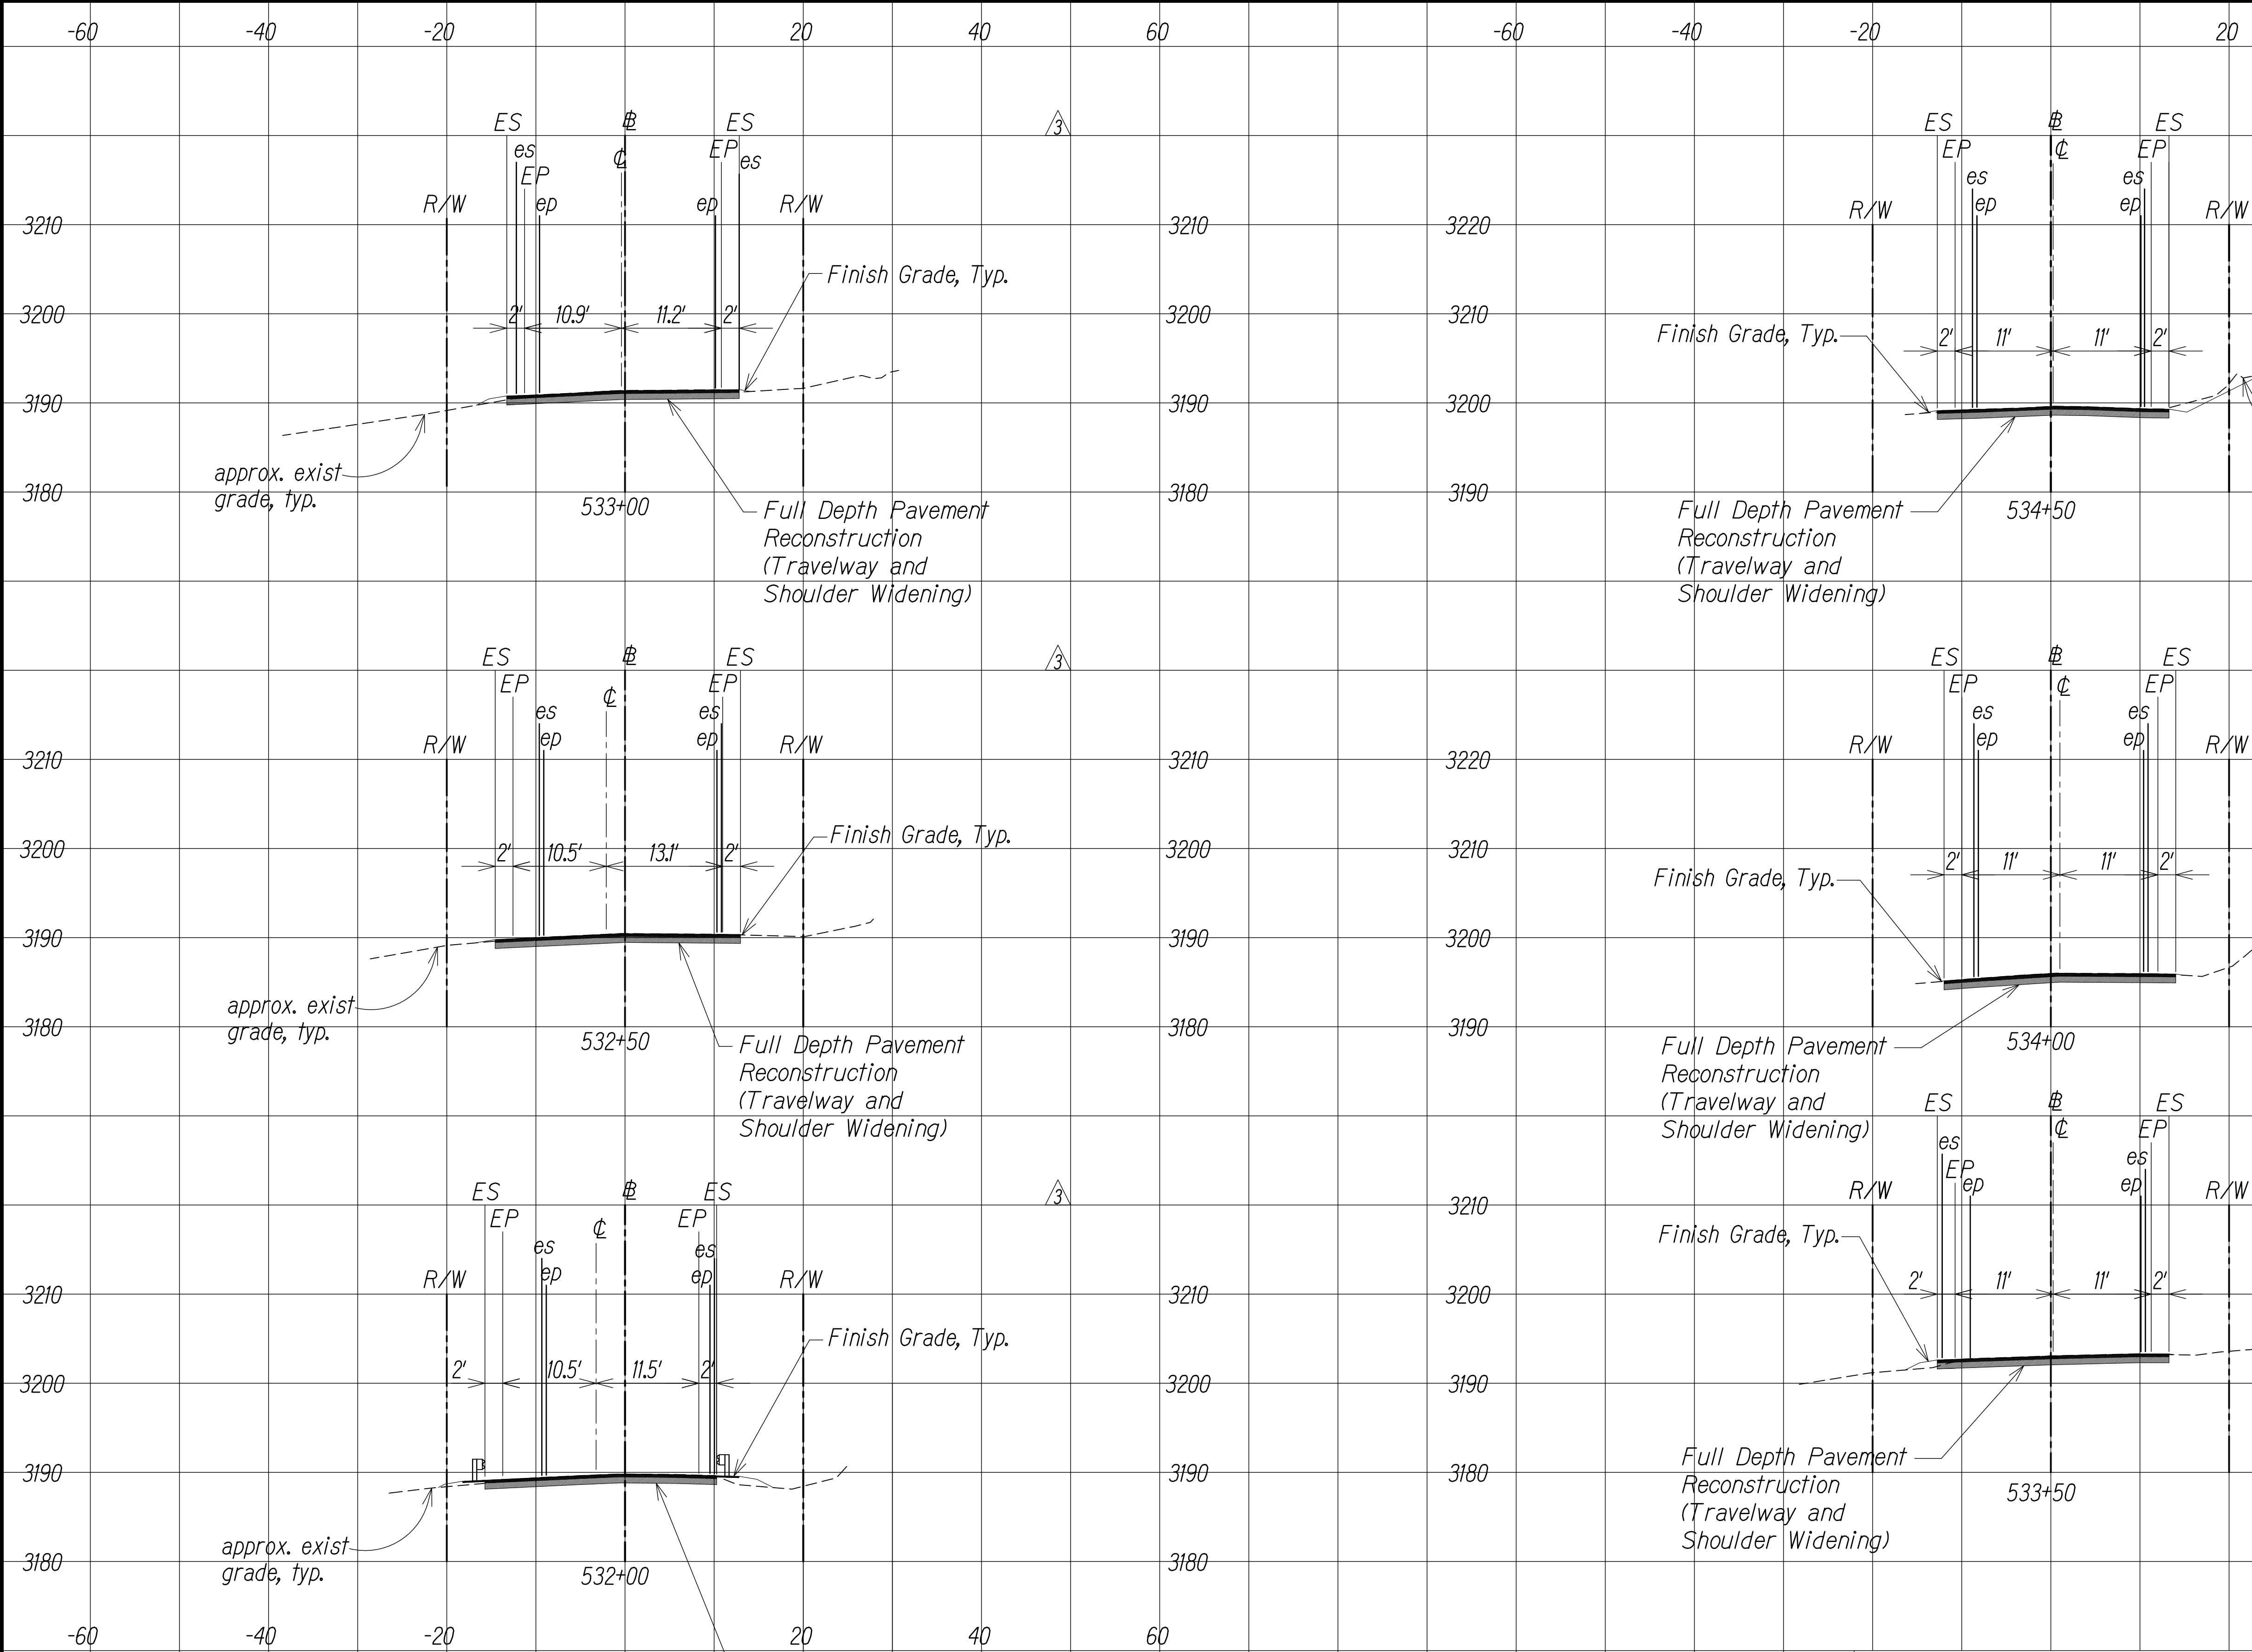


KOKEE ROAD
Scale: 1" = 10'

12/13/24 3 Revised Sections

DATE	REVISION
------	----------


STATE OF HAWAII
DEPARTMENT OF TRANSPORTATION
HIGHWAYS DIVISION
ROADWAY CROSS SECTIONS
WAIMEA CANYON DRIVE /
KOKEE ROAD IMPROVEMENTS, PHASE 2B
MILE POST 4.6 TO MILE POST 11.5
Federal-Aid Project No. STP-0550(006)
Scale: 1" = 10' Date: July 2024

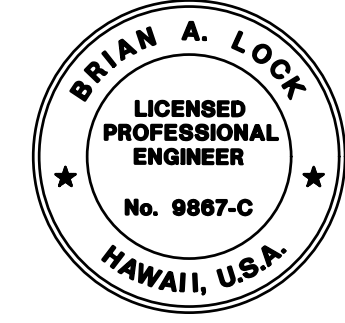

THIS WORK WAS PREPARED BY
ME OR UNDER MY SUPERVISION.
WILSON OKAMOTO CORPORATION
APRIL 30, 2026
LIC. EXP. DATE


SHEET No. X99 OF 122 SHEETS

ADD302

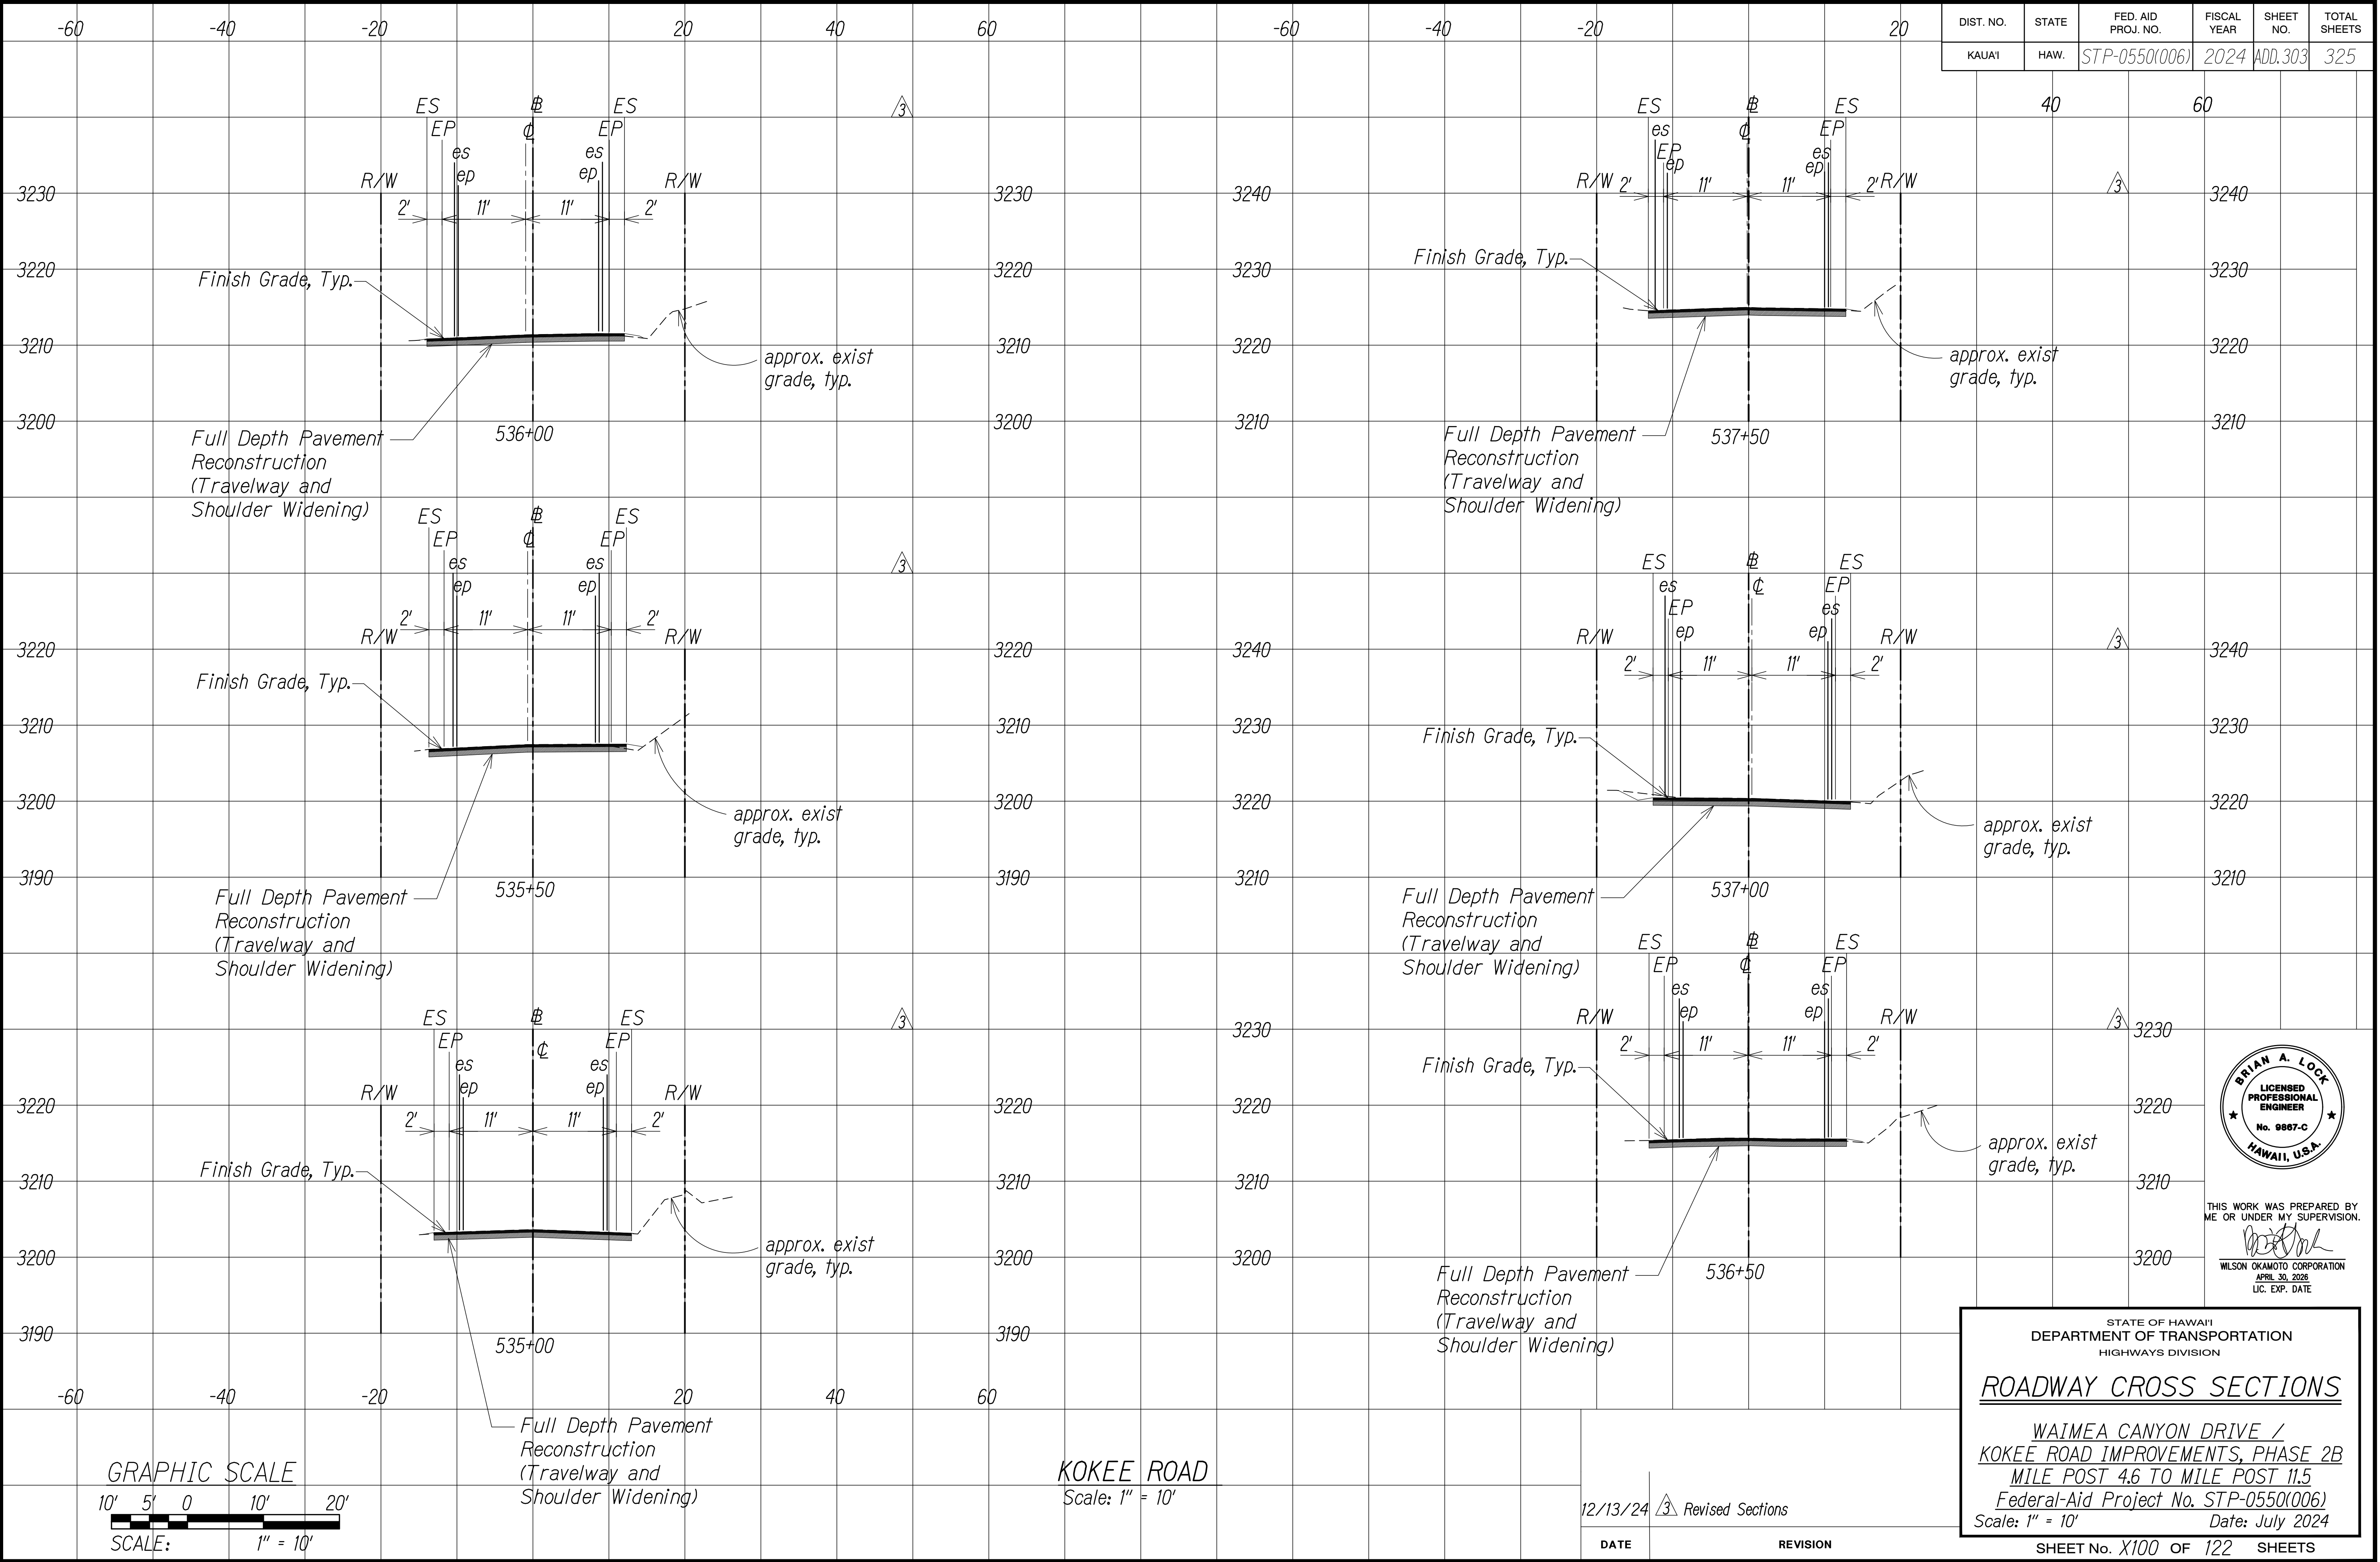

DIST. NO.	STATE	FED. AID PROJ. NO.	FISCAL YEAR	SHEET NO.	TOTAL SHEETS
KAUAI	HAW.	STP-0550(006)	2024	ADD.303	325

SURVEY PLOTTED BY	DATE
DESIGNED BY	
TRACED BY	
NOTE BOOK	
QUANTITIES BY	
CHECKED BY	

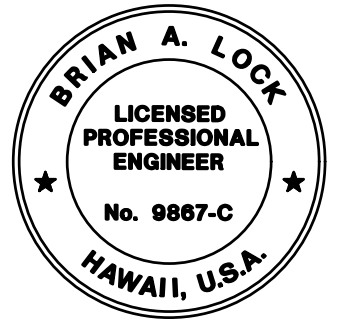


THIS WORK WAS PREPARED BY ME OR UNDER MY SUPERVISION.
WILSON OKAMOTO CORPORATION
APRIL 30, 2024
LIC. EXP. DATE

STATE OF HAWAII
DEPARTMENT OF TRANSPORTATION
HIGHWAYS DIVISION
ROADWAY CROSS SECTIONS
WAIMEA CANYON DRIVE /
KOKEE ROAD IMPROVEMENTS, PHASE 2B
MILE POST 4.6 TO MILE POST 11.5
Federal-Aid Project No. STP-0550(006)
Scale: 1" = 10' Date: July 2024


12/13/24 3 Revised Sections

DATE	REVISION
------	----------

SHEET No. X100 OF 122 SHEETS

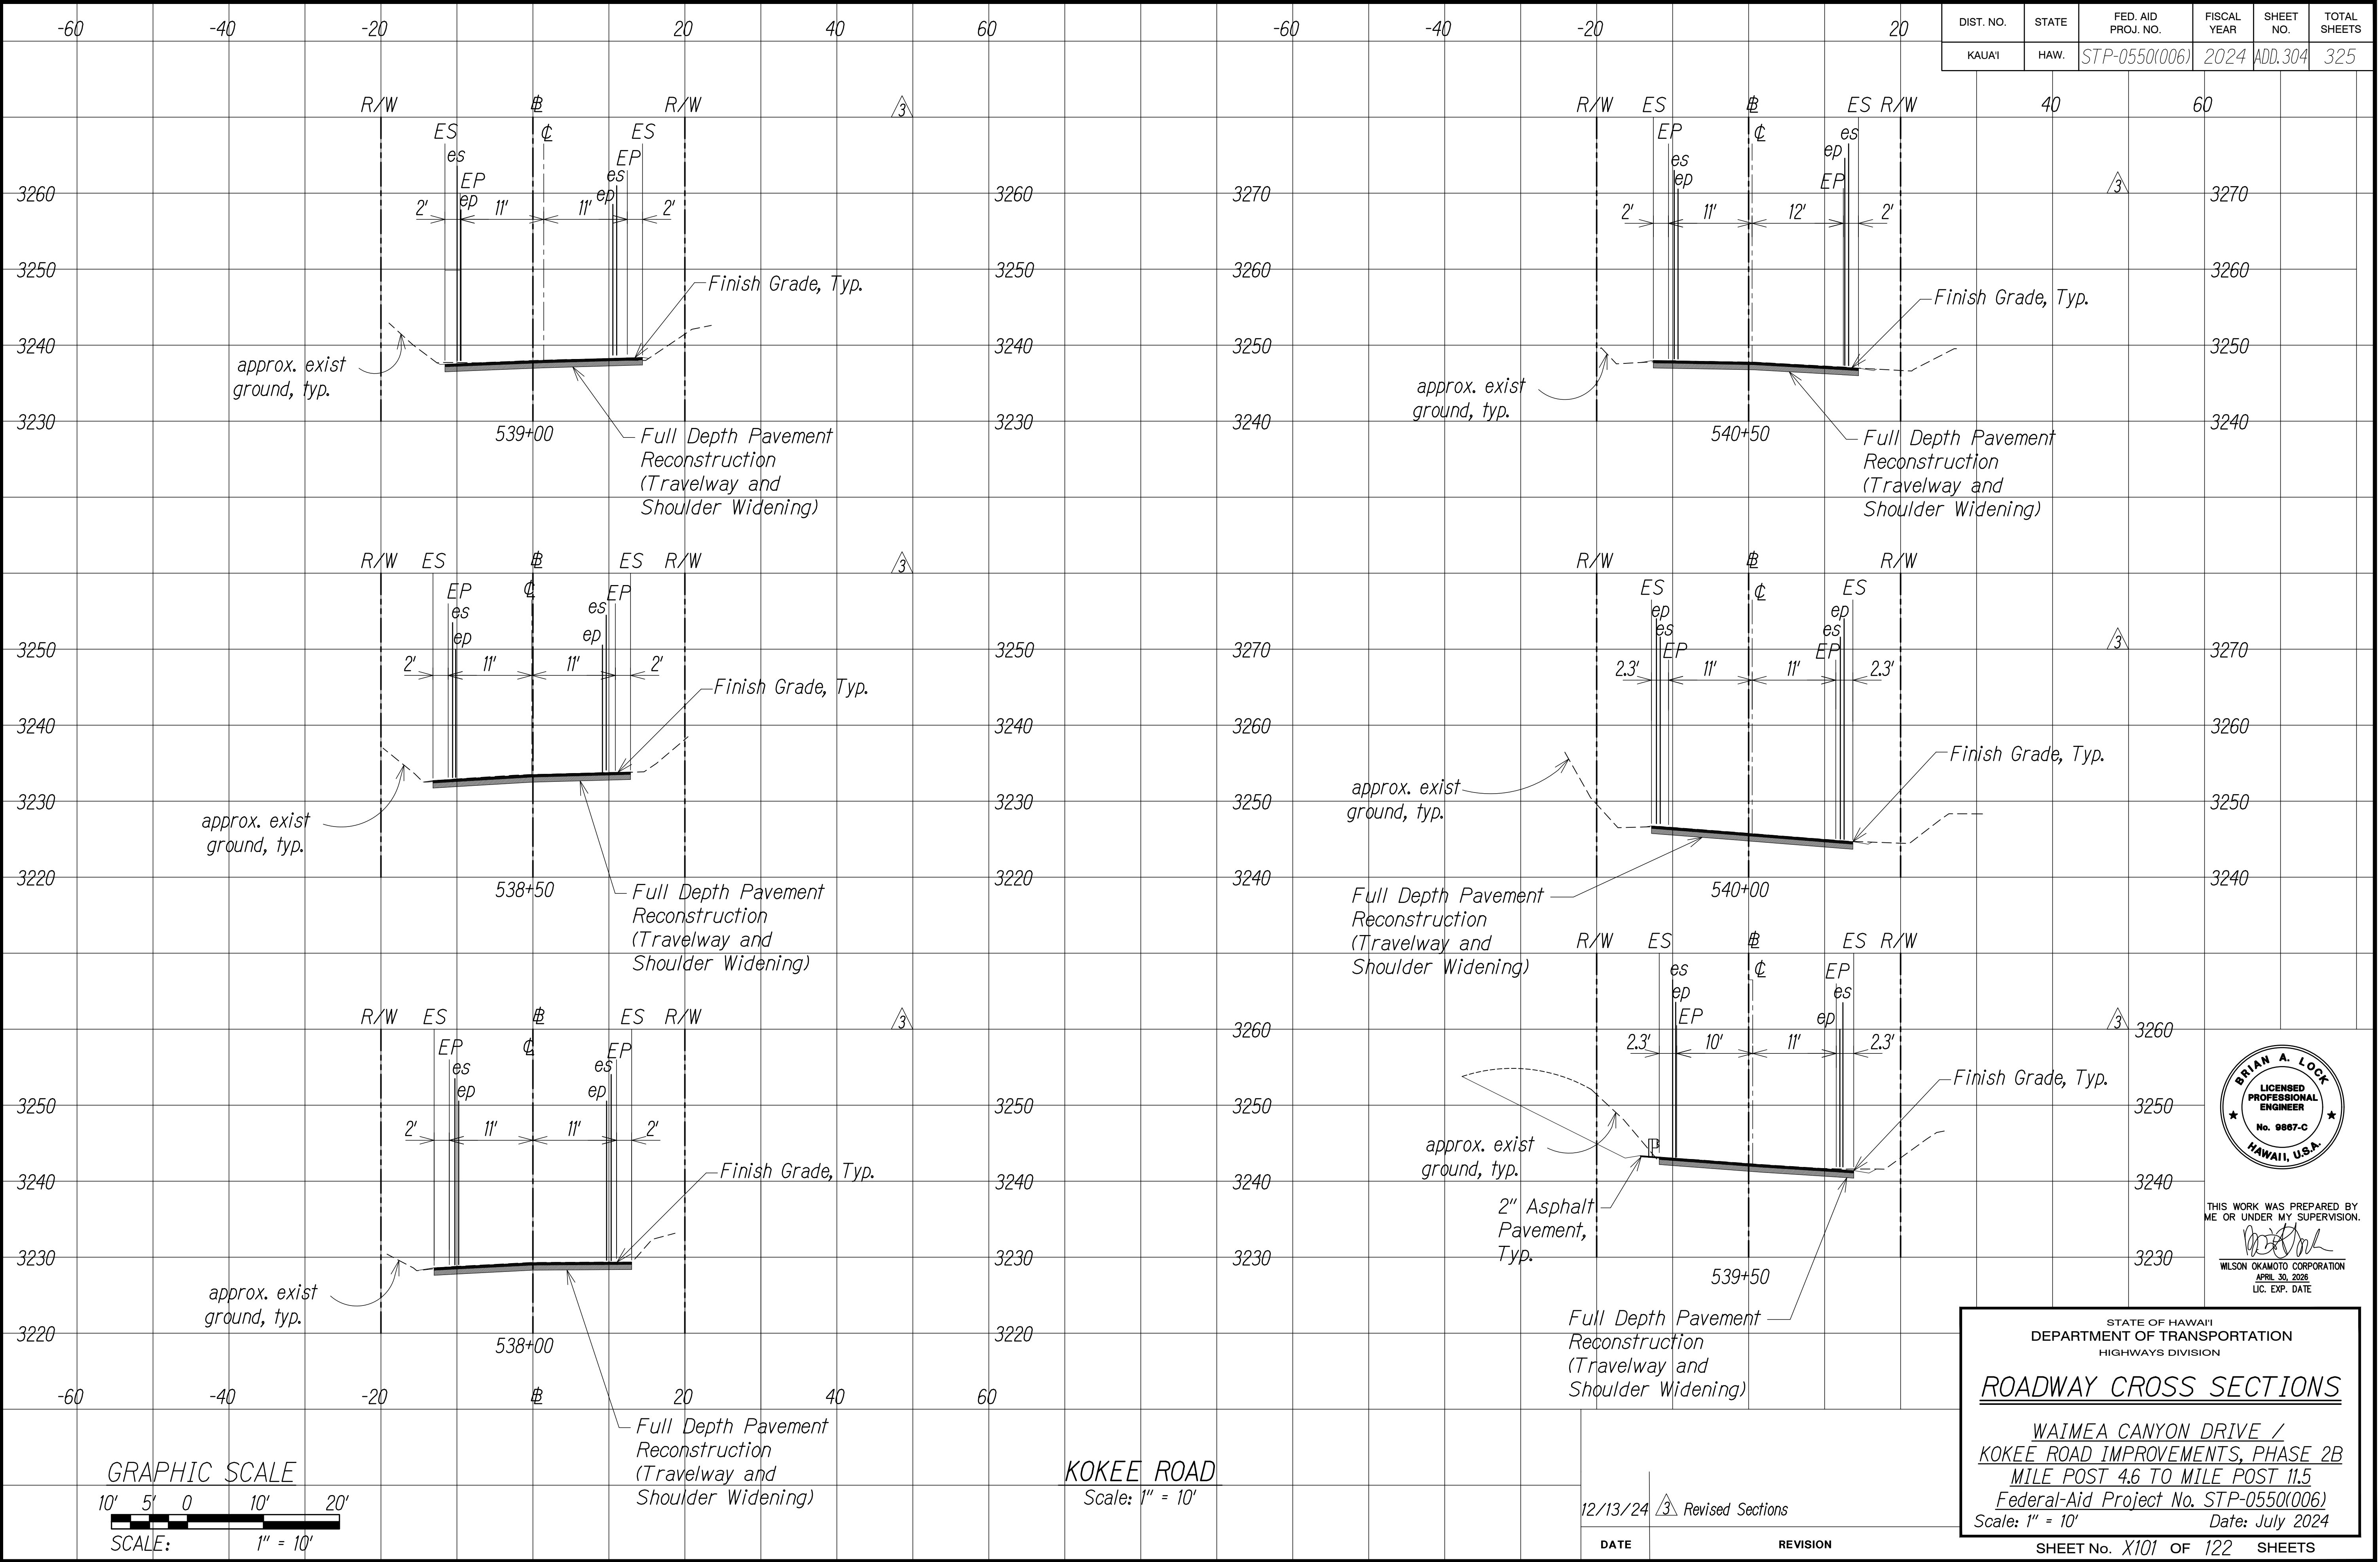


DIST. NO.	STATE	FED. AID PROJ. NO.	FISCAL YEAR	SHEET NO.	TOTAL SHEETS
KAUAI	HAW.	STP-0550(006)	2024	ADD.304	325

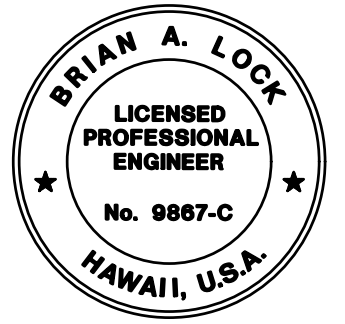


THIS WORK WAS PREPARED BY ME OR UNDER MY SUPERVISION.
WILSON OKAMOTO CORPORATION
APRIL 30, 2026
LIC. EXP. DATE

SURVEY PLOTTED BY	DATE
DESIGNED BY	
TRACED BY	
QUANTITIES BY	
CHECKED BY	
ORIGINAL PLAN	
NOTE BOOK	
No.	

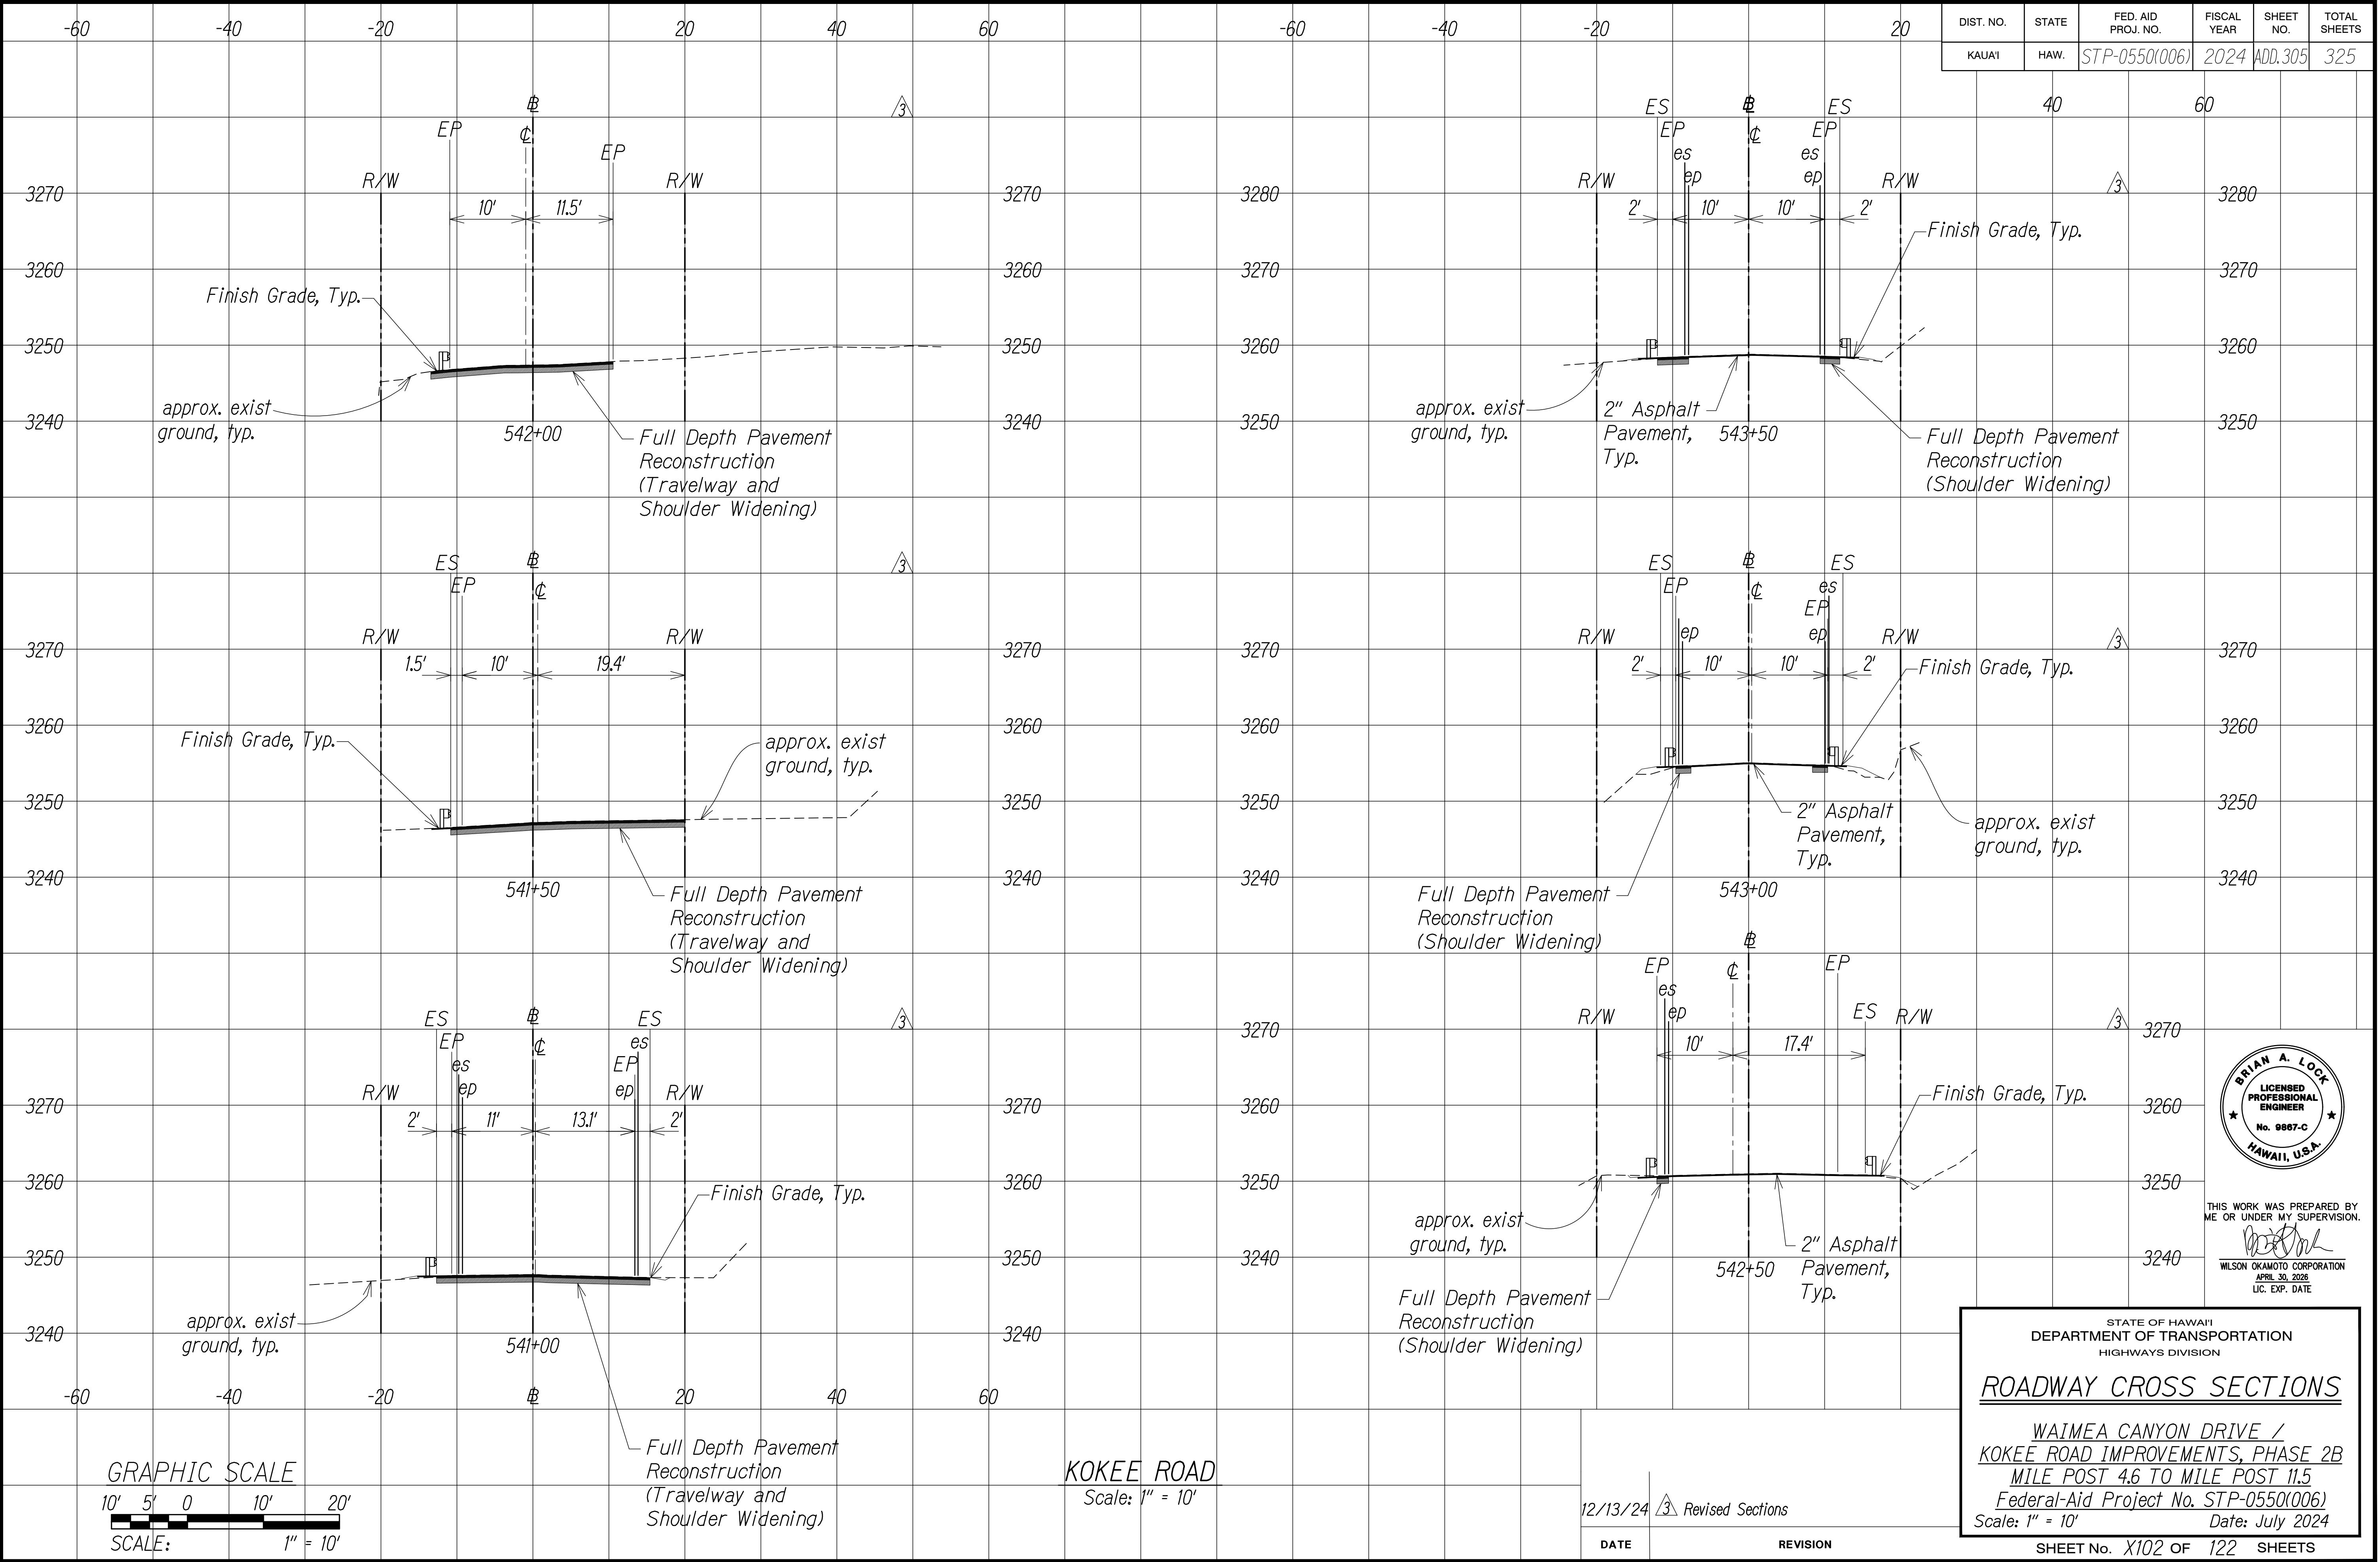

SURVEY PLOTTED BY	DATE
DESIGNED BY	
TRACED BY	
NOTED BY	
QUANTITIES BY	
CHECKED BY	

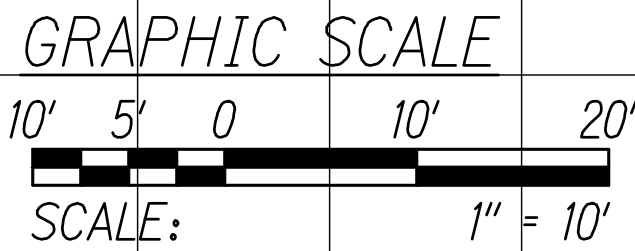


KOKEE ROAD
Scale: 1" = 10'

12/13/24 3 Revised Sections

DATE REVISION


STATE OF HAWAII
DEPARTMENT OF TRANSPORTATION
HIGHWAYS DIVISION
ROADWAY CROSS SECTIONS
WAIMEA CANYON DRIVE /
KOKEE ROAD IMPROVEMENTS, PHASE 2B
MILE POST 4.6 TO MILE POST 11.5
Federal-Aid Project No. STP-0550(006)
Scale: 1" = 10' Date: July 2024

SHEET No. X102 OF 122 SHEETS

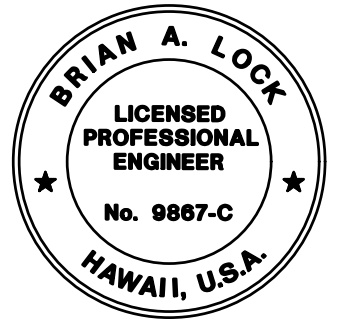


THIS WORK WAS PREPARED BY
ME OR UNDER MY SUPERVISION.
[Signature]
WILSON OKAMOTO CORPORATION
APRIL 30, 2026
LIC. EXP. DATE

DIST. NO.	STATE	FED. AID PROJ. NO.	FISCAL YEAR	SHEET NO.	TOTAL SHEETS
KAUAI	HAW.	STP-0550(006)	2024	ADD.306	325

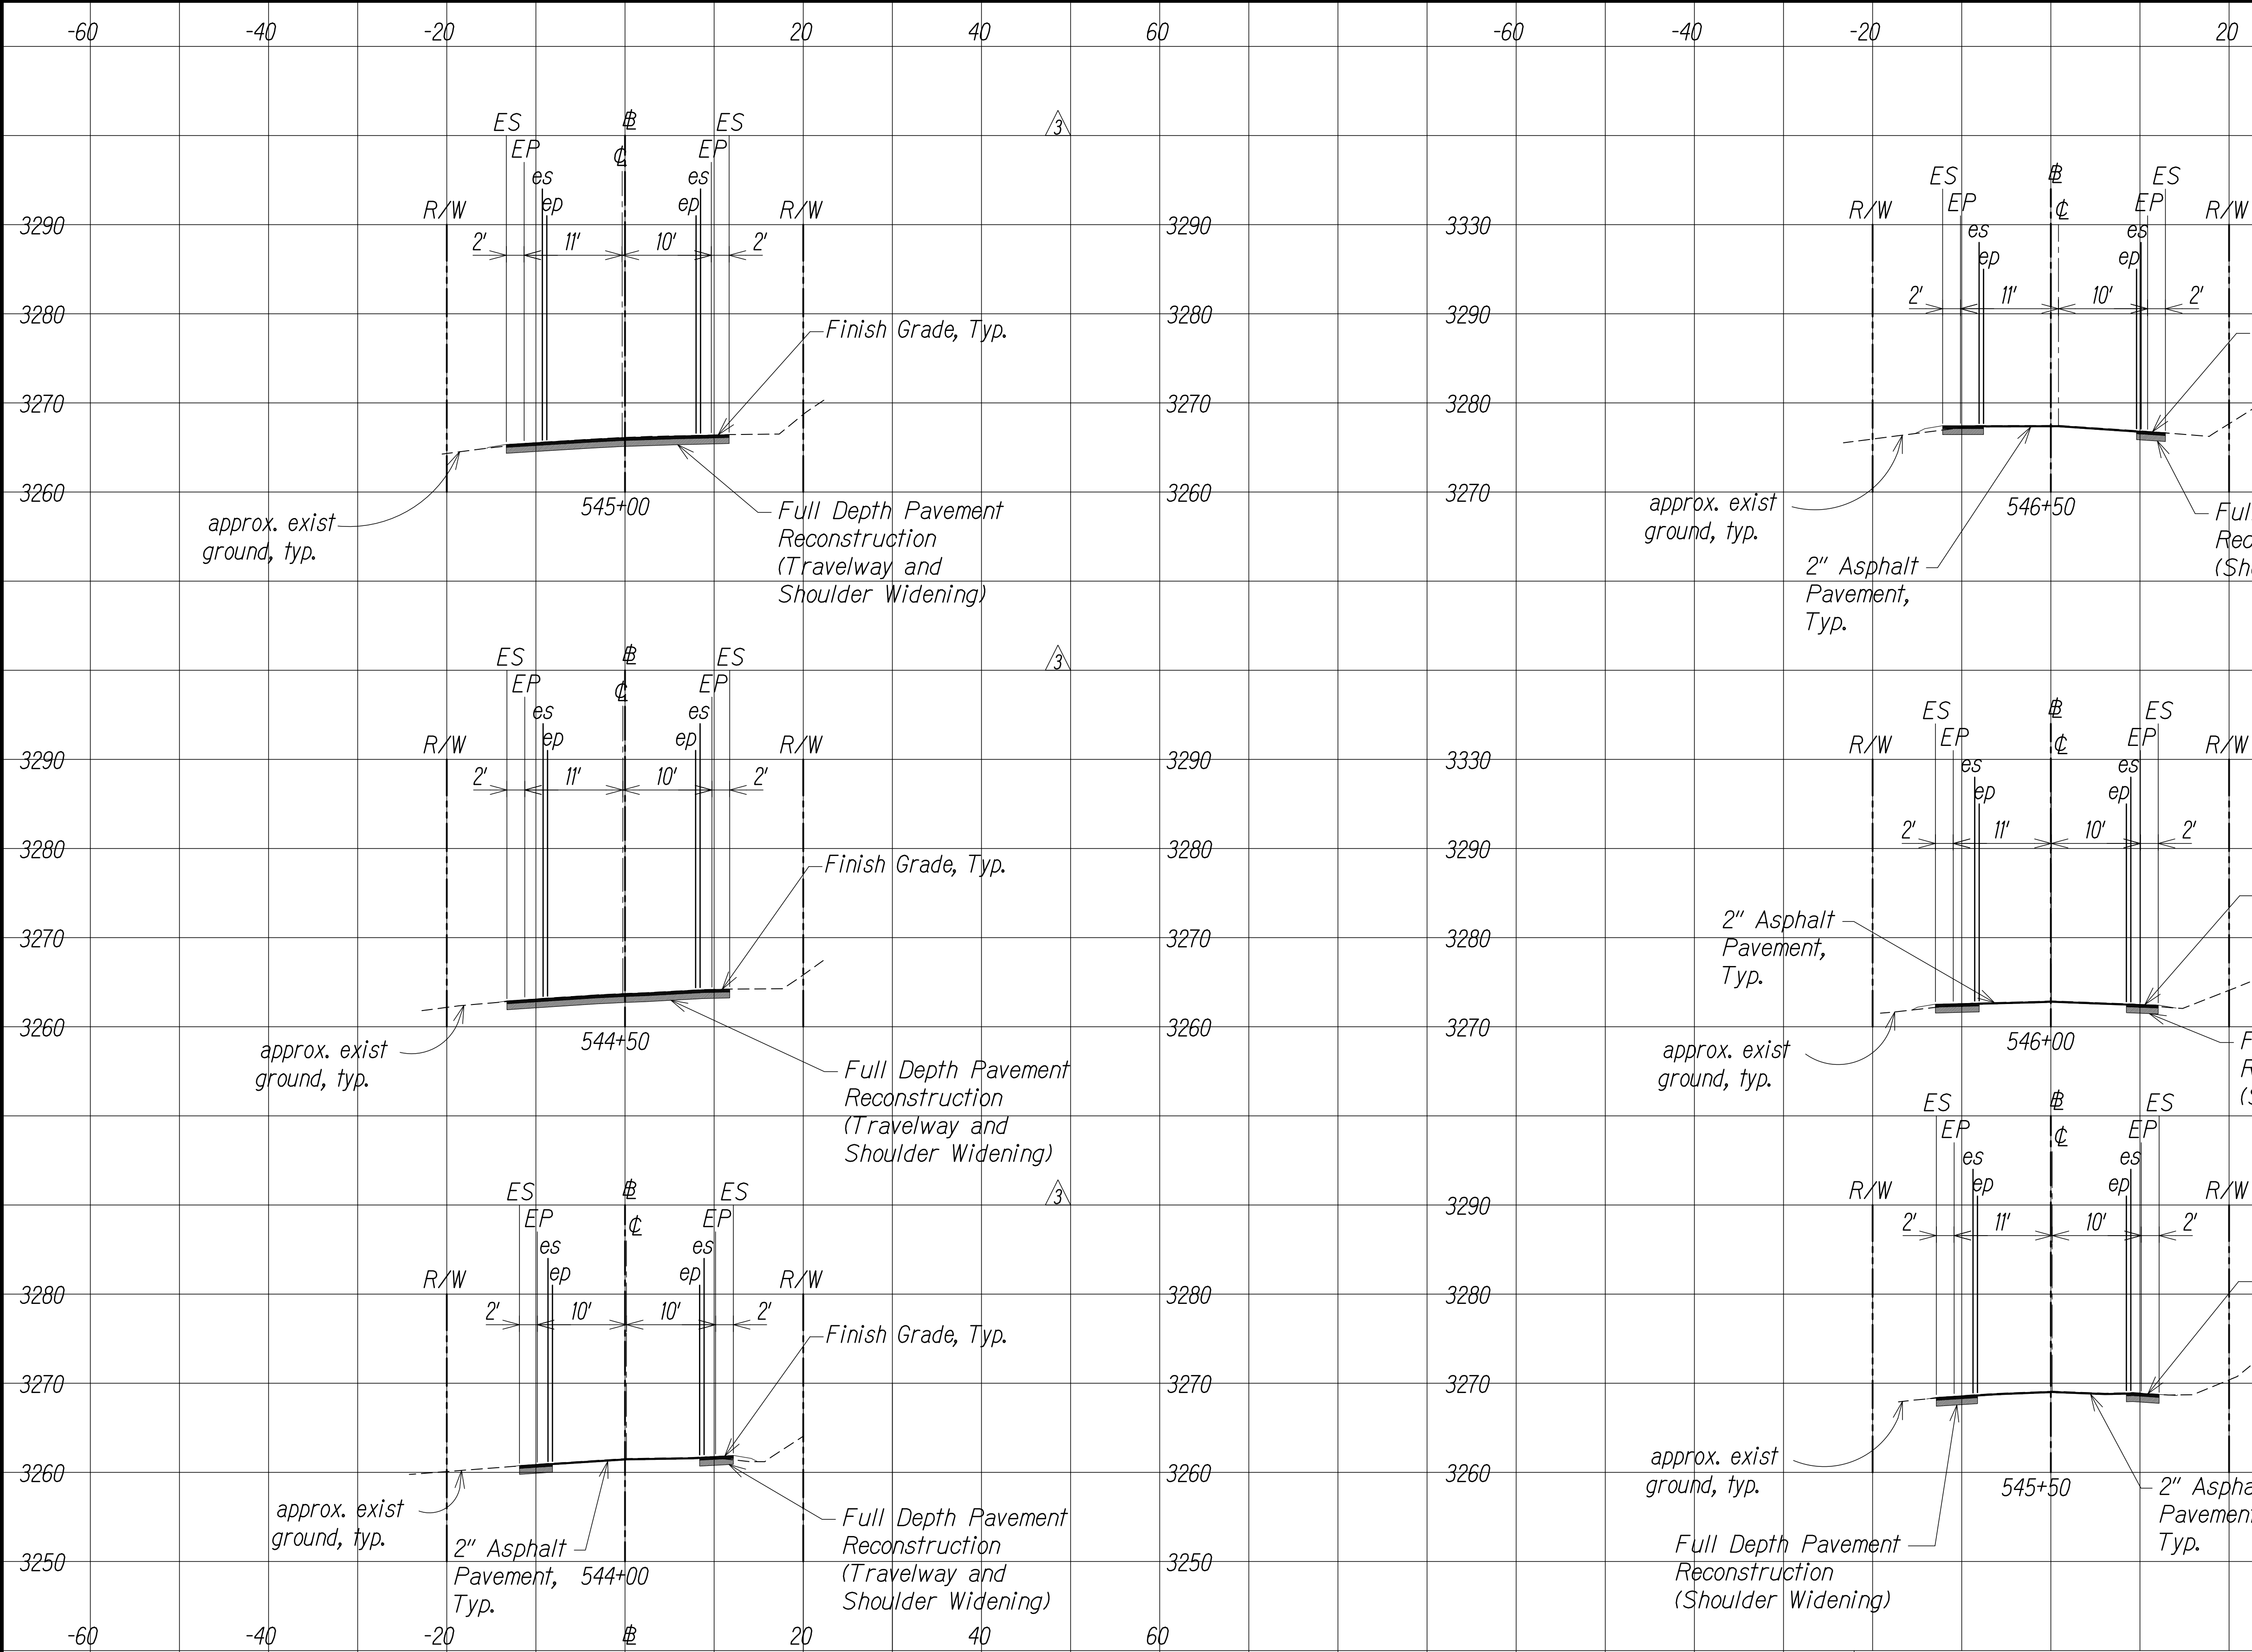

SURVEY PLOTTED BY	DATE
DESIGNED BY	
TRACED BY	
QUANTITIES BY	
CHECKED BY	


ORIGINAL PLAN	No.
NOTE BOOK	

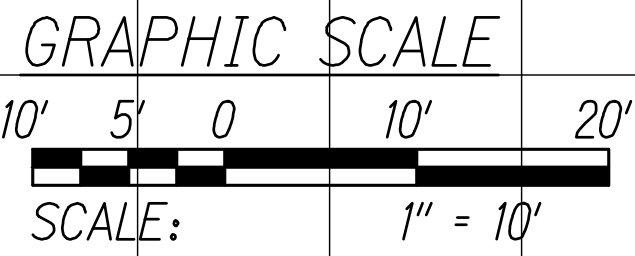

KOKEE ROAD
Scale: 1" = 10'

12/13/24 3 Revised Sections


DATE REVISION

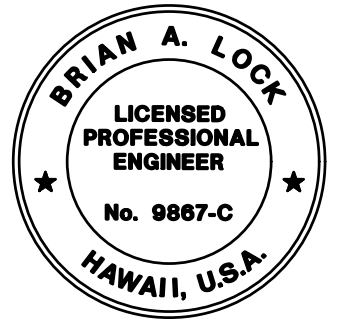

THIS WORK WAS PREPARED BY
ME OR UNDER MY SUPERVISION.
[Signature]
WILSON OKAMOTO CORPORATION
APRIL 30, 2026
LIC. EXP. DATE


STATE OF HAWAII
DEPARTMENT OF TRANSPORTATION
HIGHWAYS DIVISION
ROADWAY CROSS SECTIONS
WAIMEA CANYON DRIVE /
KOKEE ROAD IMPROVEMENTS, PHASE 2B
MILE POST 4.6 TO MILE POST 11.5
Federal-Aid Project No. STP-0550(006)
Scale: 1" = 10' Date: July 2024

SHEET No. X103 OF 122 SHEETS

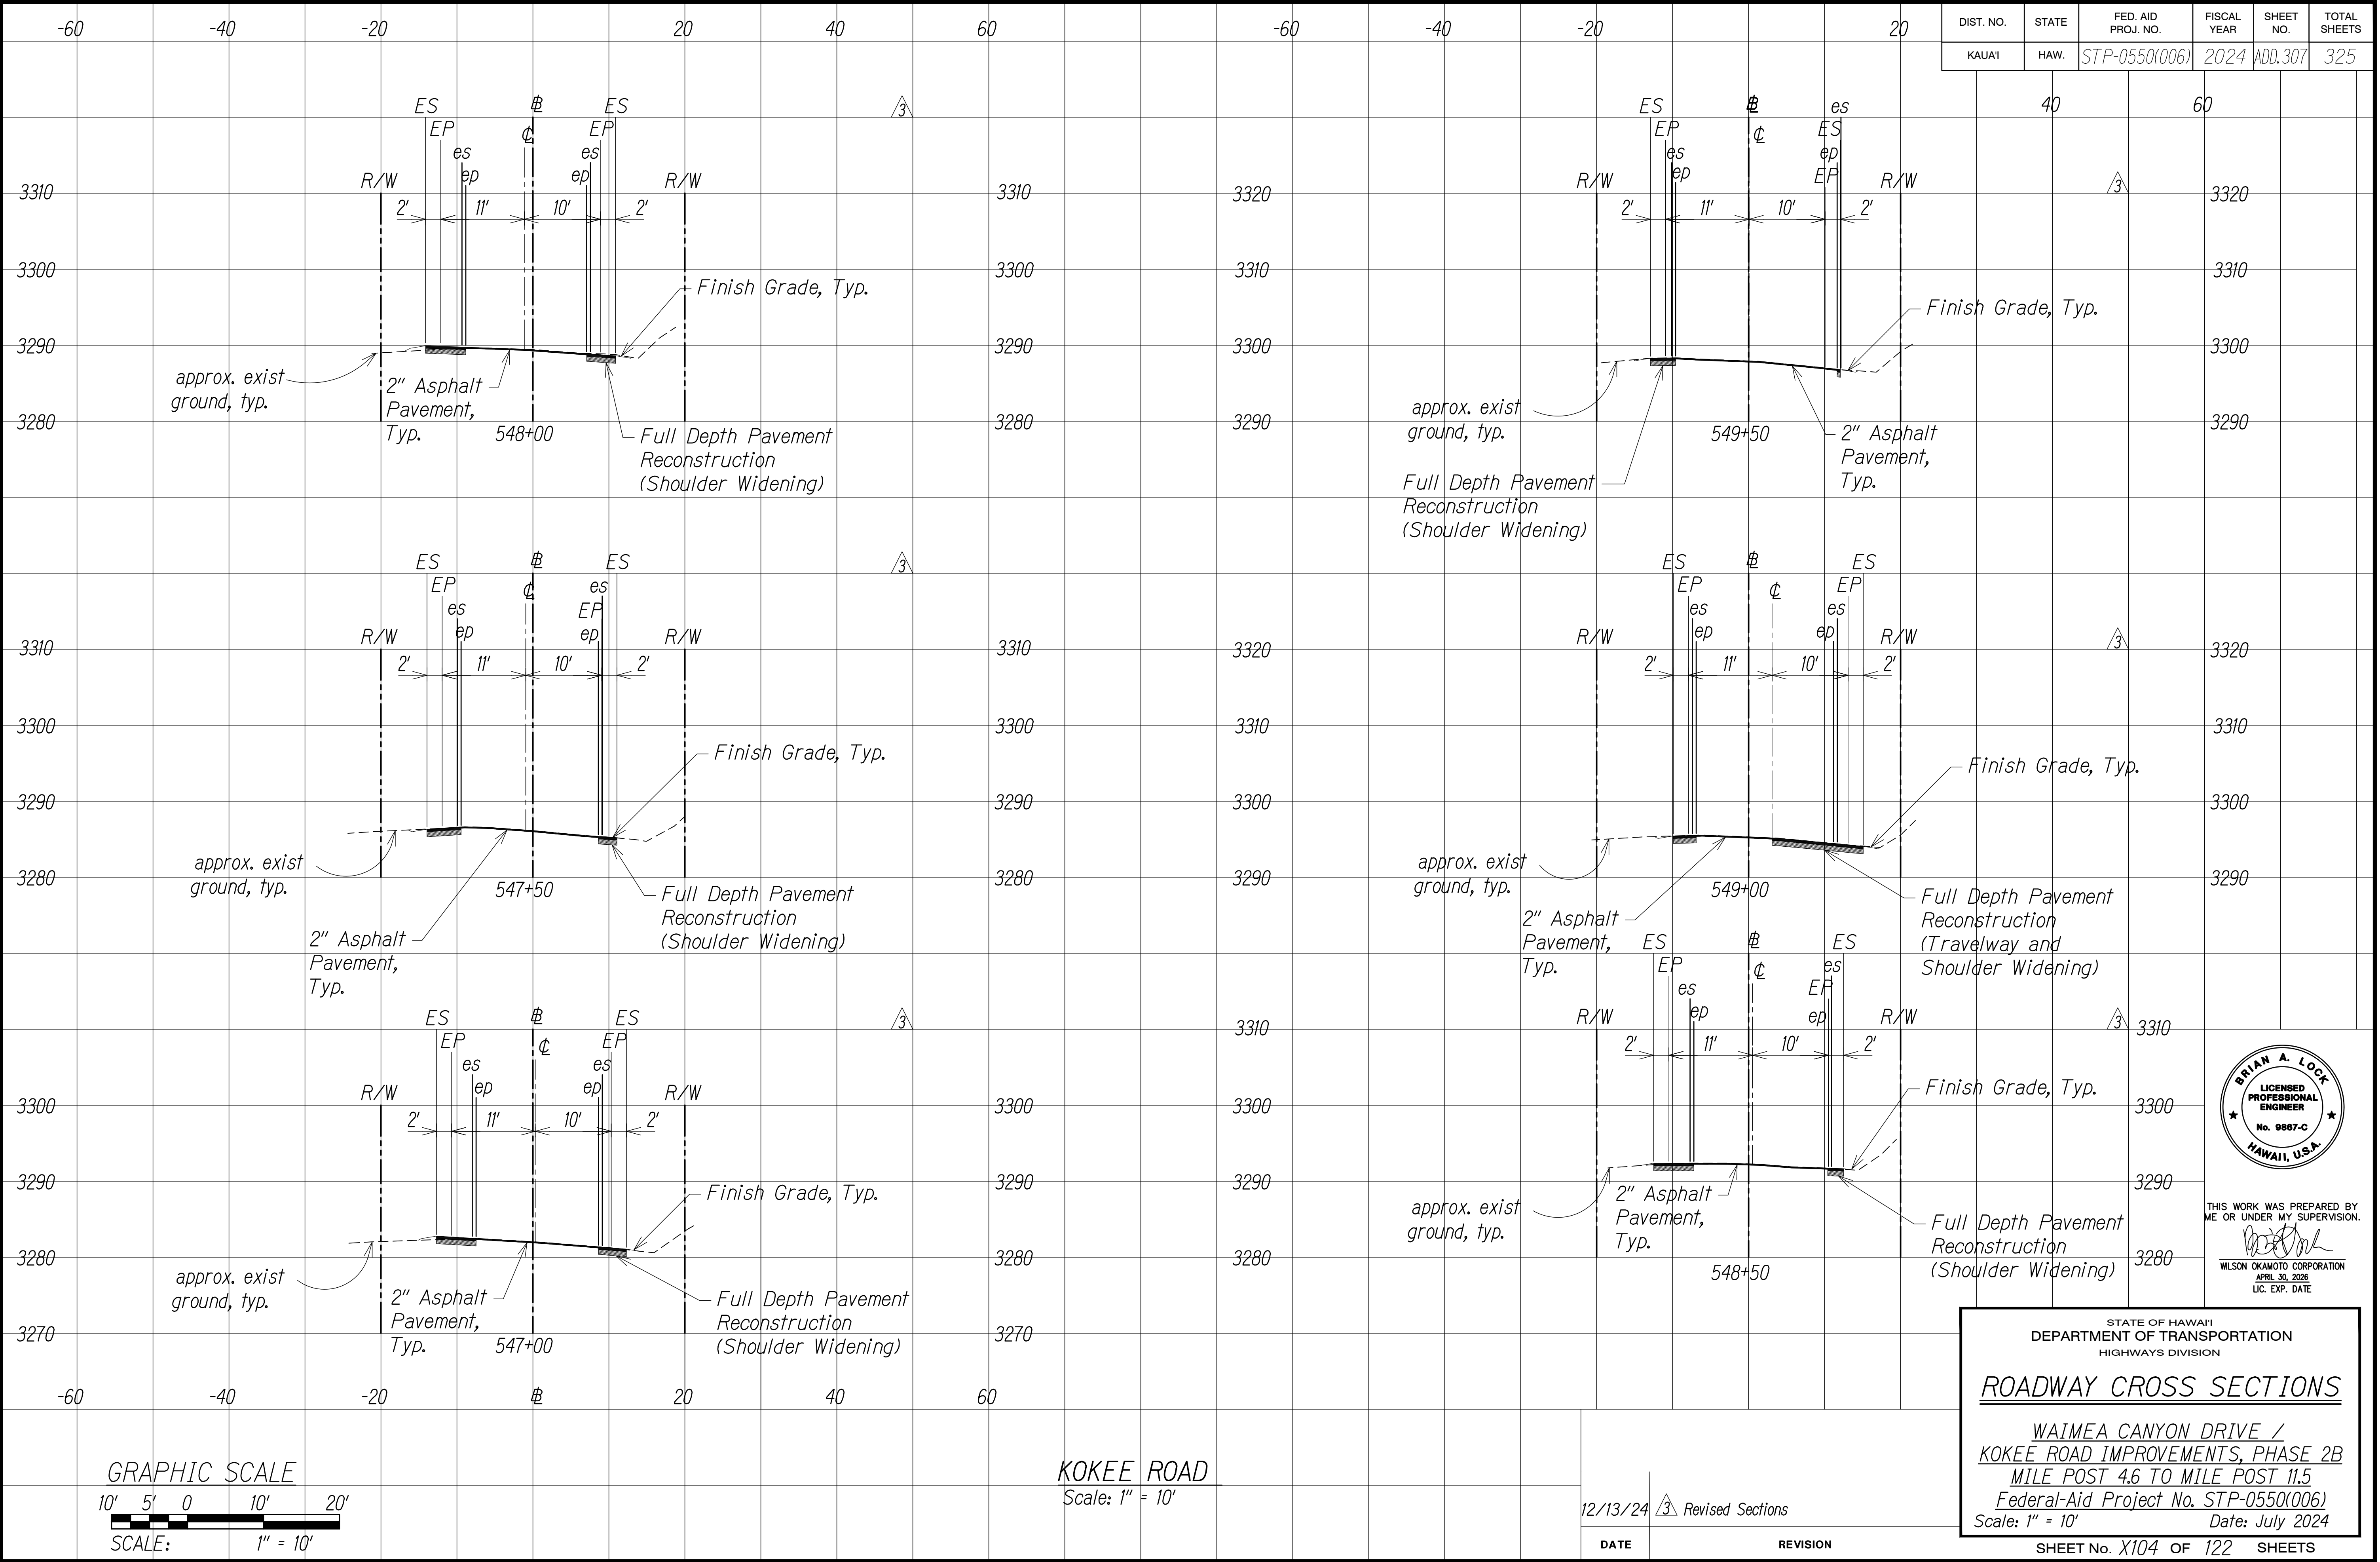

DIST. NO.	STATE	FED. AID PROJ. NO.	FISCAL YEAR	SHEET NO.	TOTAL SHEETS
KAUAI	HAW.	STP-0550(006)	2024	ADD.307	325

SURVEY PLOTTED BY	DATE
DESIGNED BY	
TRACED BY	
QUANTITIES BY	
CHECKED BY	
NOTE BOOK	
No.	

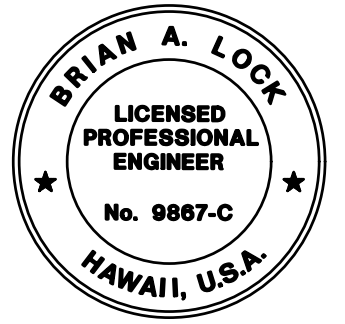

THIS WORK WAS PREPARED BY
ME OR UNDER MY SUPERVISION.
[Signature]
WILSON OKAMOTO CORPORATION
APRIL 30, 2026
LIC. EXP. DATE


STATE OF HAWAII
DEPARTMENT OF TRANSPORTATION
HIGHWAYS DIVISION
ROADWAY CROSS SECTIONS
WAIMEA CANYON DRIVE /
Kokee Road Improvements, Phase 2B
MILE POST 4.6 TO MILE POST 11.5
Federal-Aid Project No. STP-0550(006)
Scale: 1" = 10' Date: July 2024

12/13/24 3 Revised Sections


DATE REVISION

SHEET No. X104 OF 122 SHEETS

DIST. NO.	STATE	FED. AID PROJ. NO.	FISCAL YEAR	SHEET NO.	TOTAL SHEETS
KAUAI	HAW.	STP-0550(006)	2024	ADD.308	325

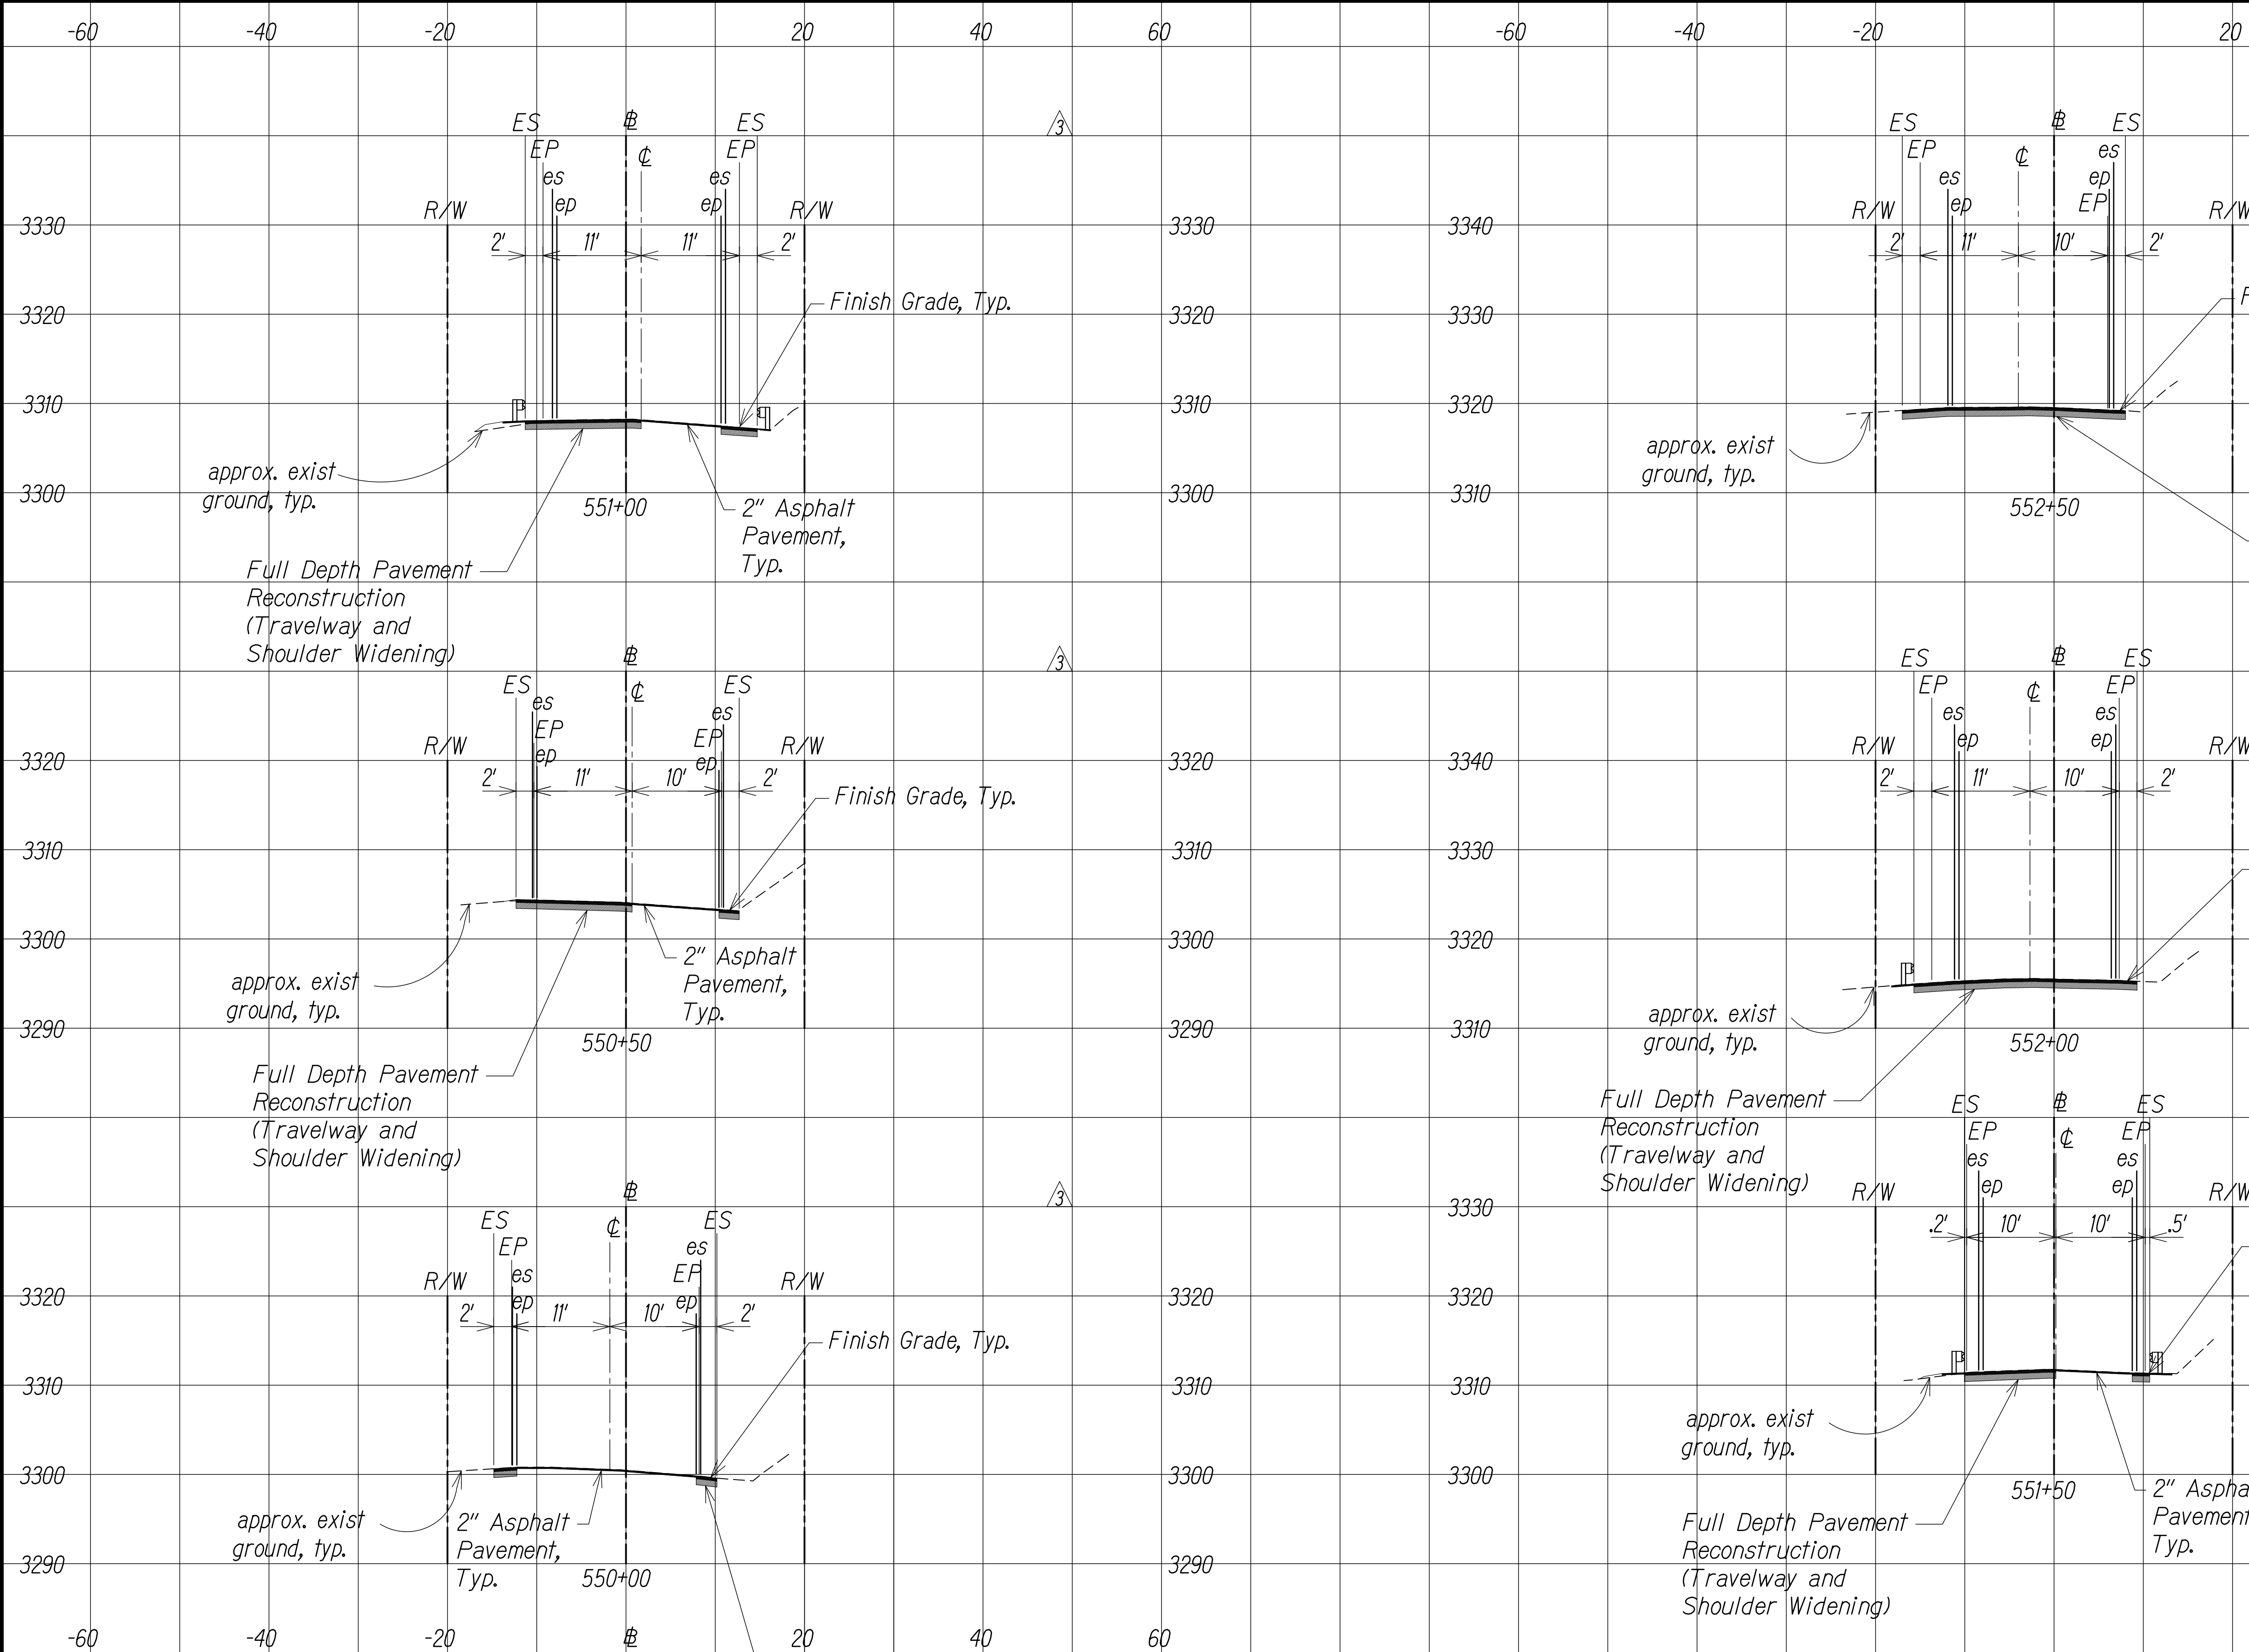


SURVEY PLOTTED BY	DATE
DESIGNED BY	
TRACED BY	
NOTED BY	
QUANTITIES BY	
CHECKED BY	

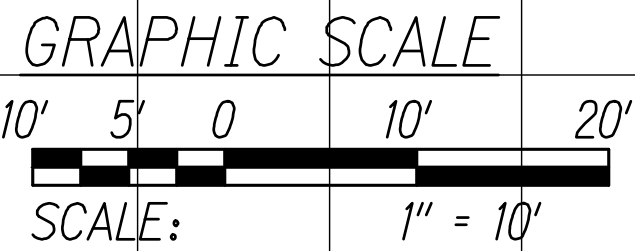

KOKEE ROAD
Scale: 1" = 10'

12/13/24 3 Revised Sections


DATE	REVISION
------	----------

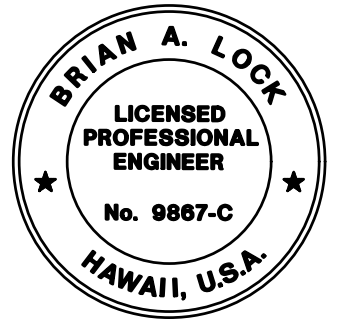

THIS WORK WAS PREPARED BY
ME OR UNDER MY SUPERVISION.
[Signature]
WILSON OKAMOTO CORPORATION
APRIL 30, 2026
LIC. EXP. DATE

STATE OF HAWAII
DEPARTMENT OF TRANSPORTATION
HIGHWAYS DIVISION
ROADWAY CROSS SECTIONS
WAIMEA CANYON DRIVE /
KOKEE ROAD IMPROVEMENTS, PHASE 2B
MILE POST 4.6 TO MILE POST 11.5
Federal-Aid Project No. STP-0550(006)
Scale: 1" = 10' Date: July 2024


SHEET No. X105 OF 122 SHEETS

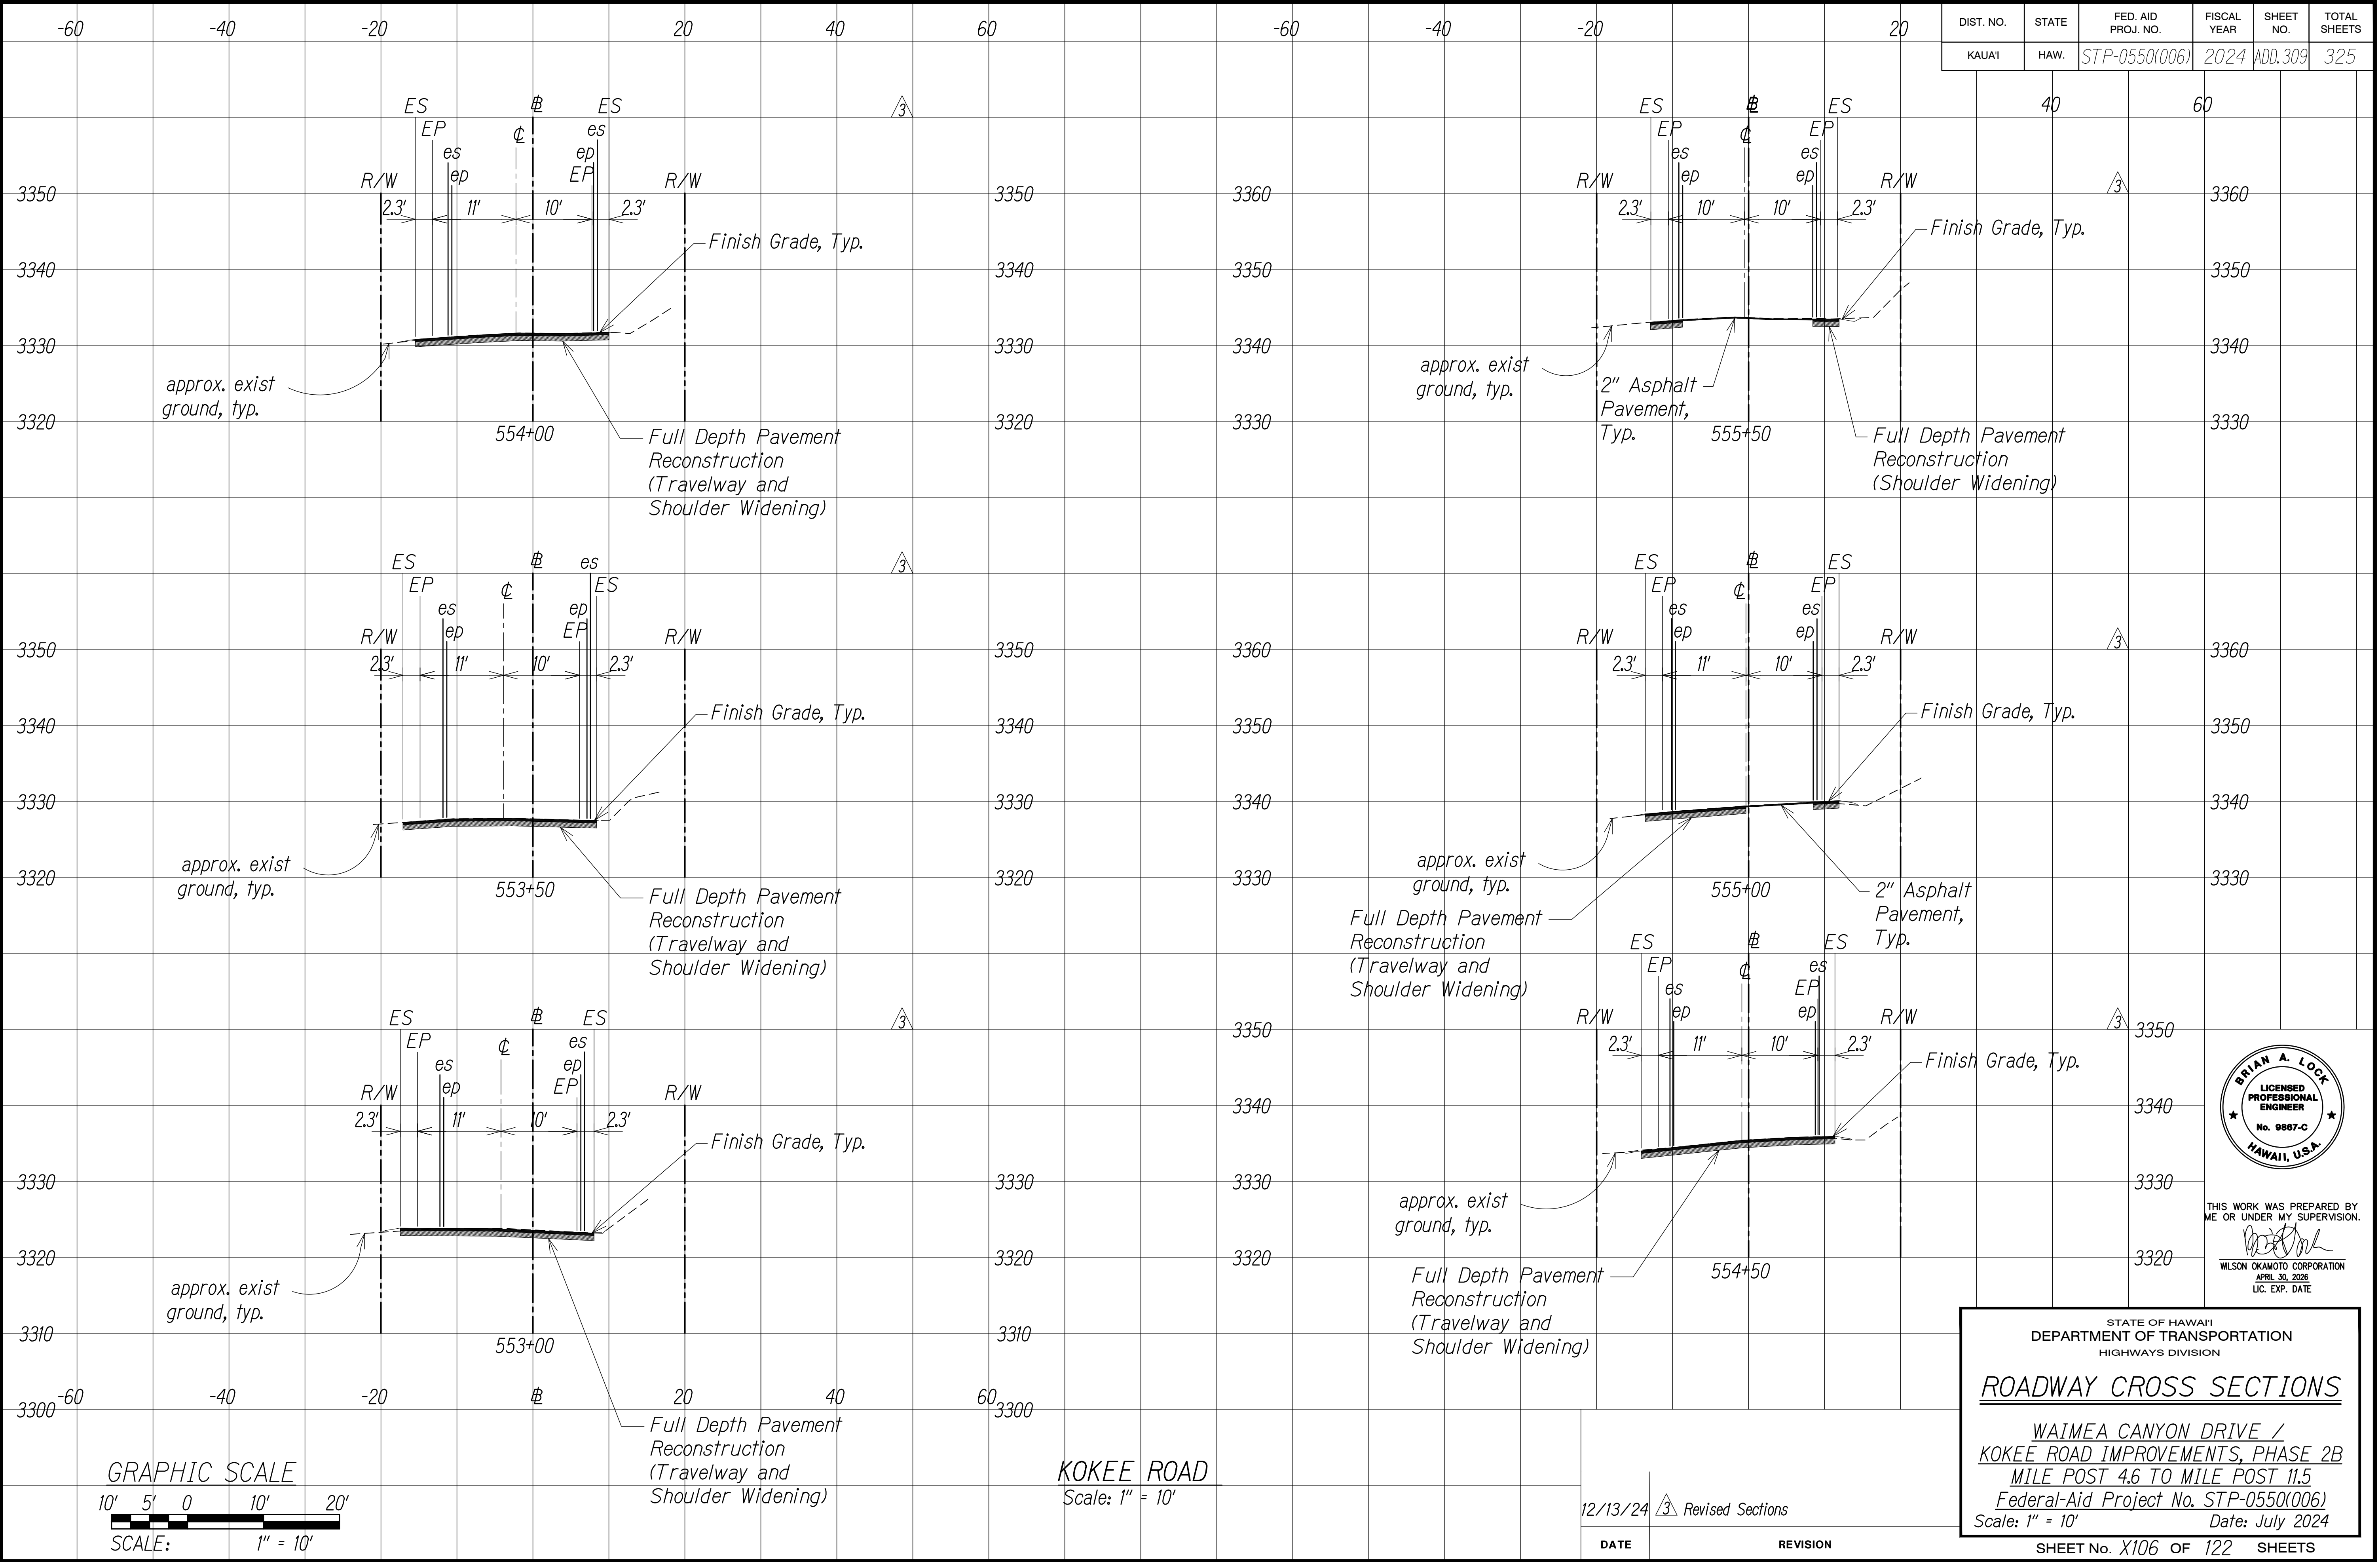

DIST. NO.	STATE	FED. AID PROJ. NO.	FISCAL YEAR	SHEET NO.	TOTAL SHEETS
KAUAI	HAW.	STP-0550(006)	2024	ADD.309	325

SURVEY PLOTTED BY	DATE
DESIGNED BY	
TRACED BY	
QUANTITIES BY	
CHECKED BY	

ORIGINAL PLAN	No.
NOTE BOOK	

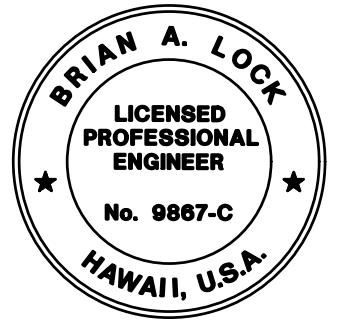


THIS WORK WAS PREPARED BY ME OR UNDER MY SUPERVISION.
[Signature]
WILSON OKAMOTO CORPORATION
APRIL 30, 2026
LIC. EXP. DATE

STATE OF HAWAII
DEPARTMENT OF TRANSPORTATION
HIGHWAYS DIVISION
ROADWAY CROSS SECTIONS
WAIMEA CANYON DRIVE /
KOKEE ROAD IMPROVEMENTS, PHASE 2B
MILE POST 4.6 TO MILE POST 11.5
Federal-Aid Project No. STP-0550(006)
Scale: 1" = 10' Date: July 2024


12/13/24 3 Revised Sections

DATE	REVISION
------	----------

SHEET No. X106 OF 122 SHEETS

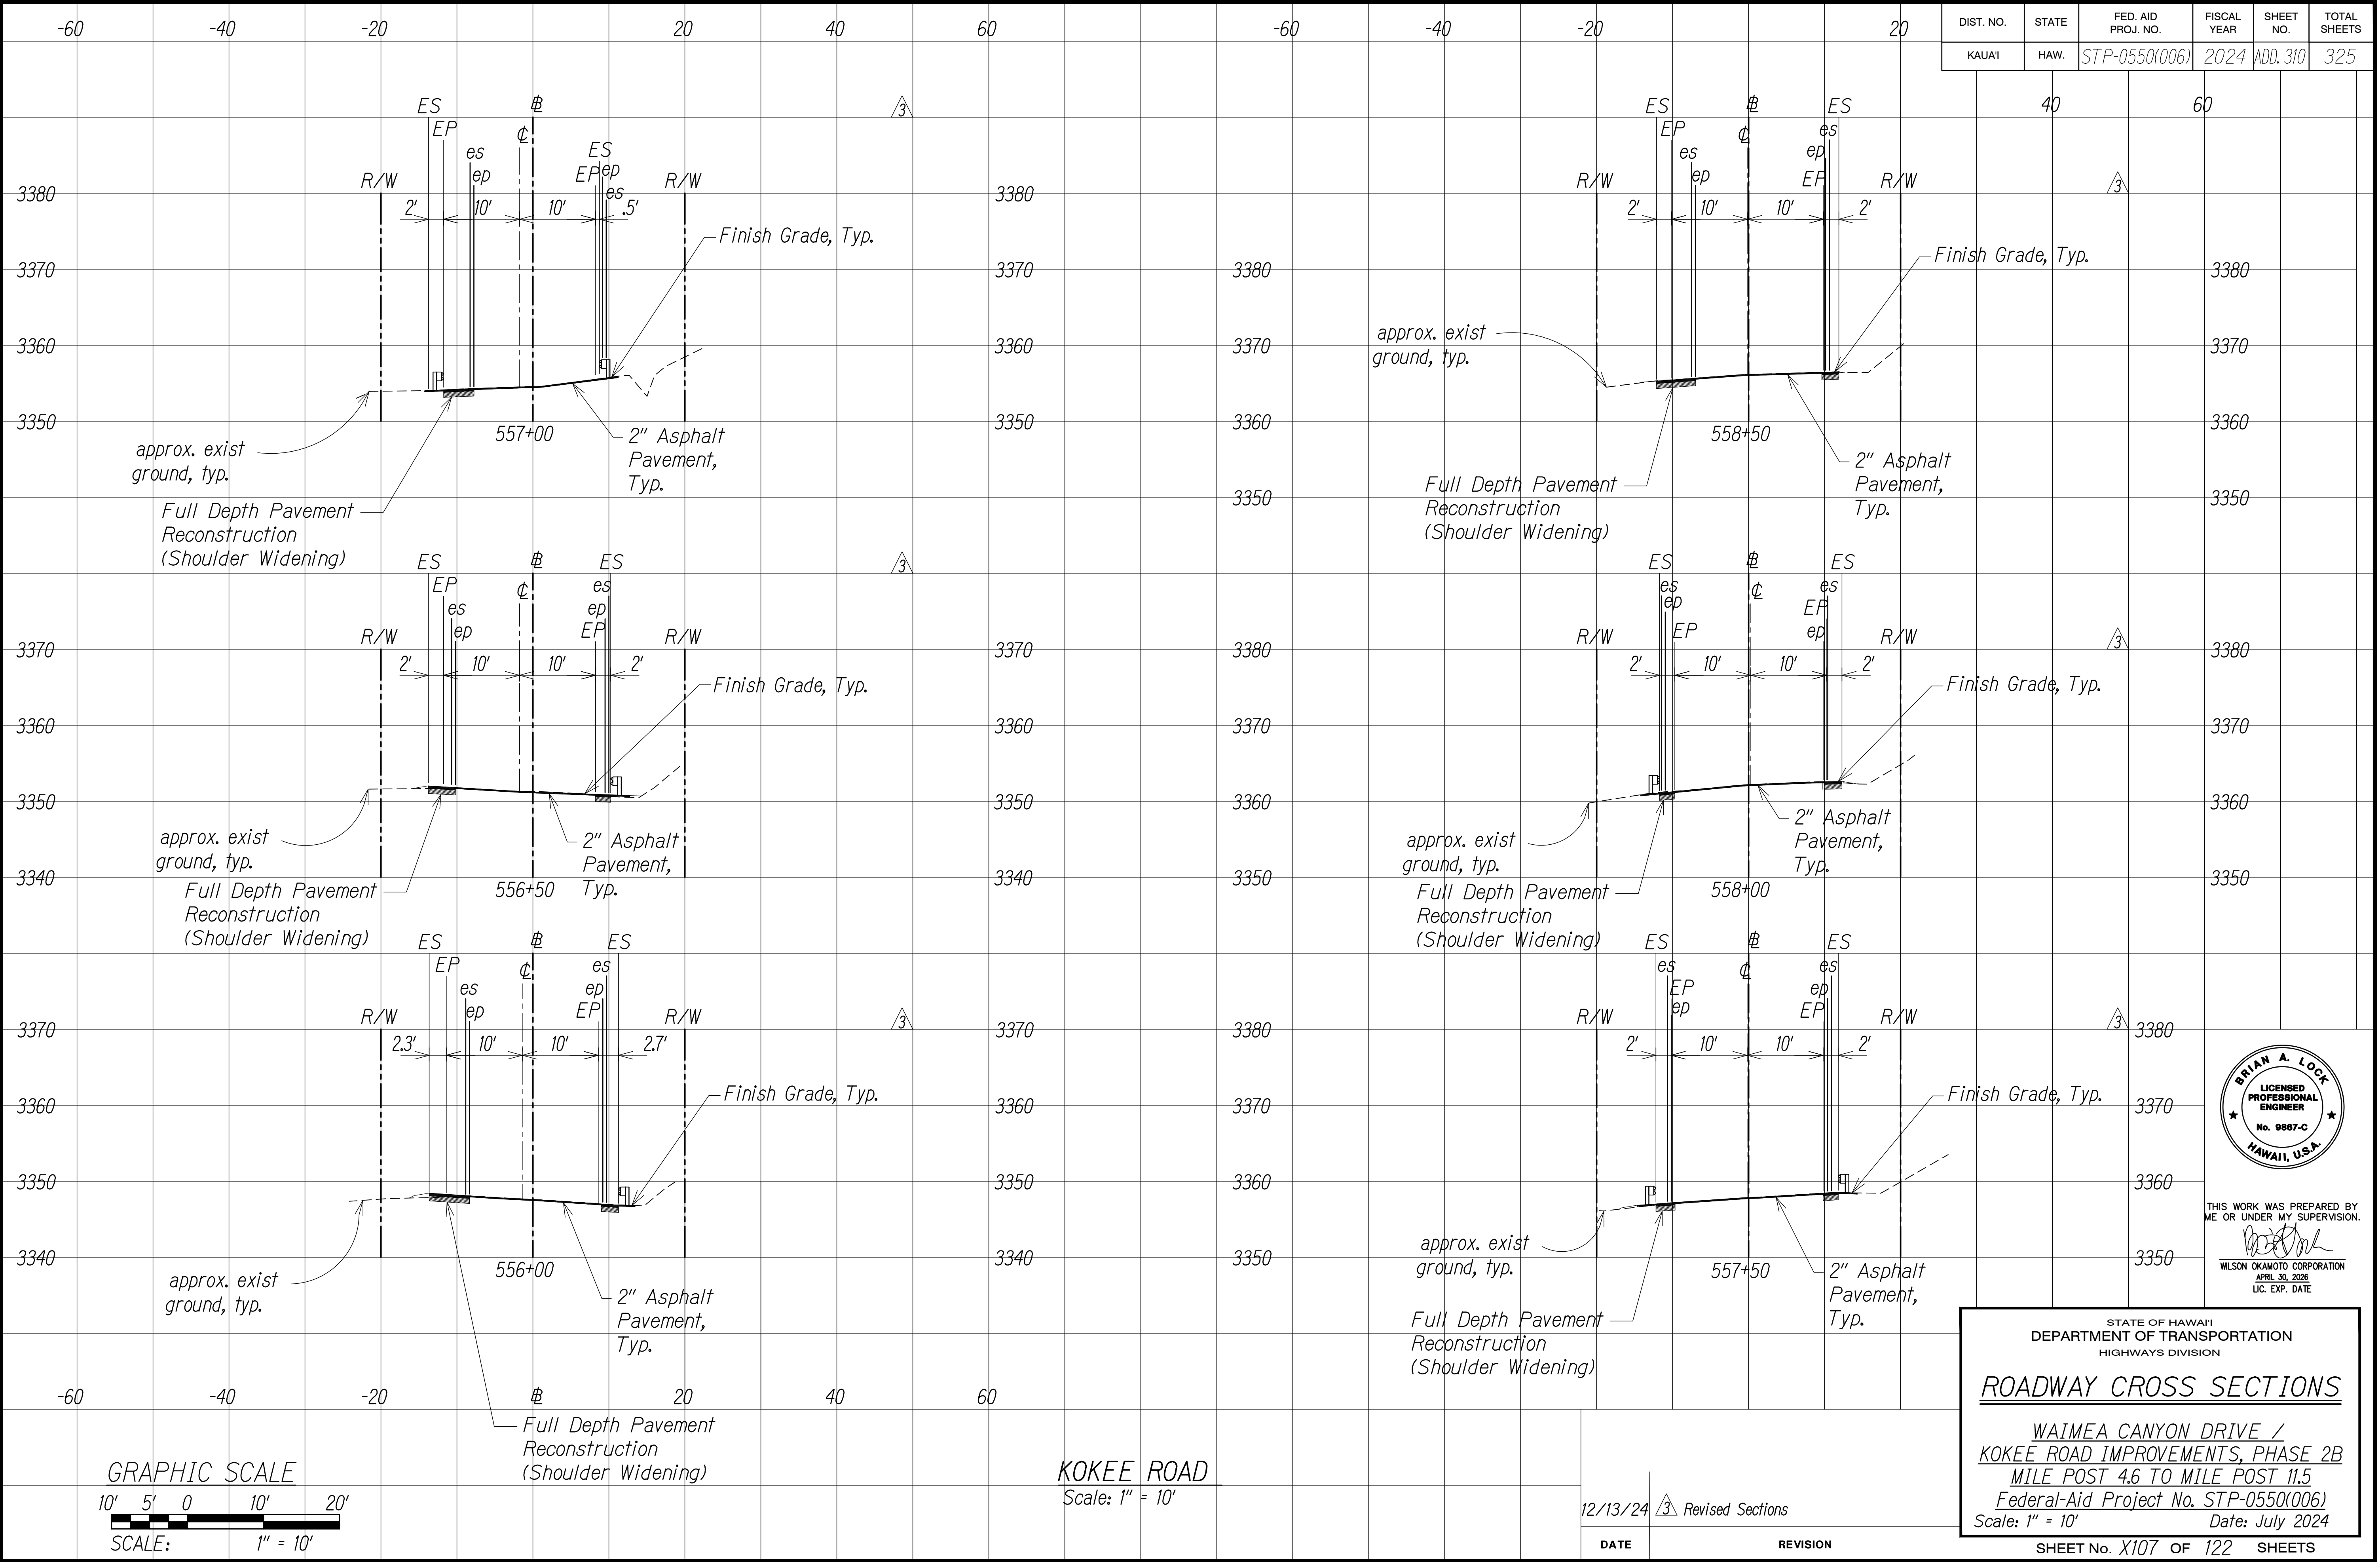

SURVEY PLOTTED BY	DATE
DESIGNED BY	
TRACED BY	
QUANTITIES BY	
CHECKED BY	
ORIGINAL PLAN	
NOTE BOOK	
No.	

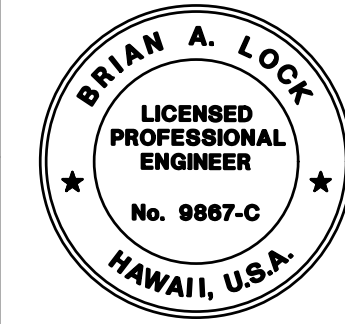

THIS WORK WAS PREPARED BY
ME OR UNDER MY SUPERVISION.
[Signature]
WILSON OKAMOTO CORPORATION
APRIL 30, 2026
LIC. EXP. DATE

STATE OF HAWAII
DEPARTMENT OF TRANSPORTATION
HIGHWAYS DIVISION
ROADWAY CROSS SECTIONS
WAIMEA CANYON DRIVE /
Kokee Road Improvements, Phase 2B
MILE POST 4.6 TO MILE POST 11.5
Federal-Aid Project No. STP-0550(006)
Scale: 1" = 10" Date: July 2024


12/13/24 3 Revised Sections

DATE REVISION

SHEET No. X107 OF 122 SHEETS


ADD310

DIST. NO.	STATE	FED. AID PROJ. NO.	FISCAL YEAR	SHEET NO.	TOTAL SHEETS
KAUAI	HAW.	STP-0550(006)	2024	ADD. 311	325

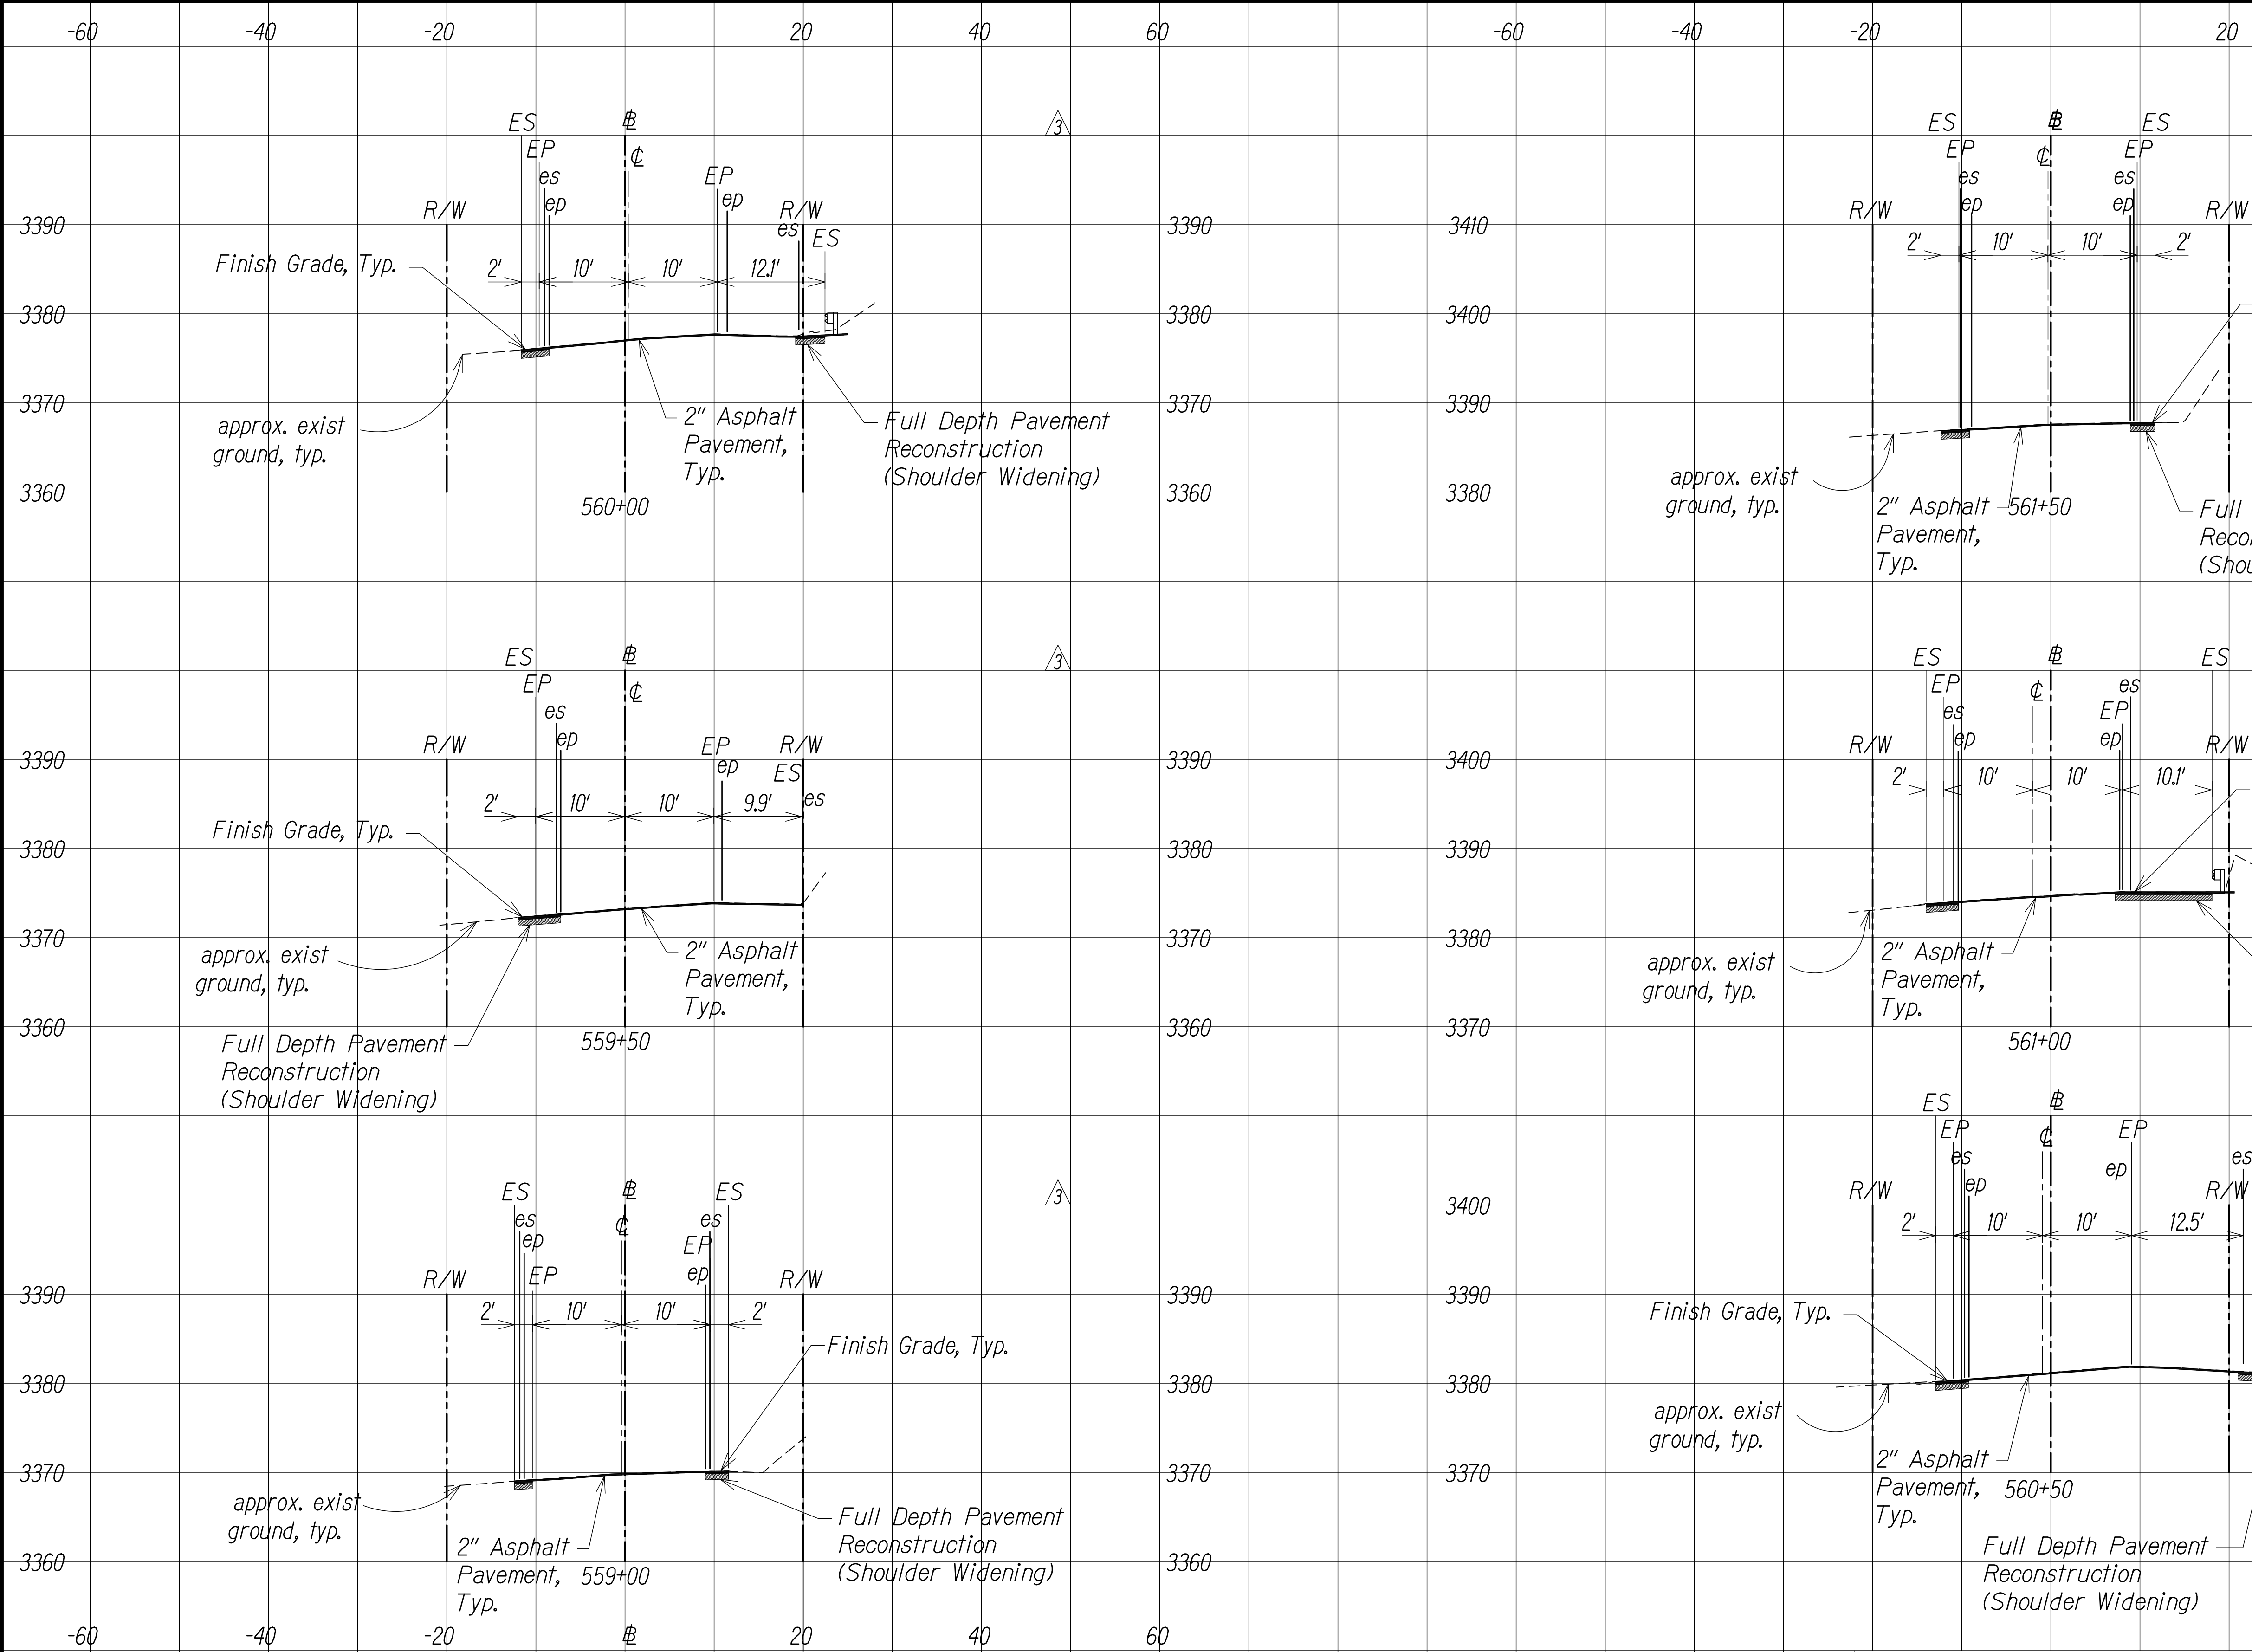


SURVEY PLOTTED BY	DATE
DESIGNED BY	
TRACED BY	
QUANTITIES BY	
CHECKED BY	

ORIGINAL PLAN	No.
NOTE BOOK	

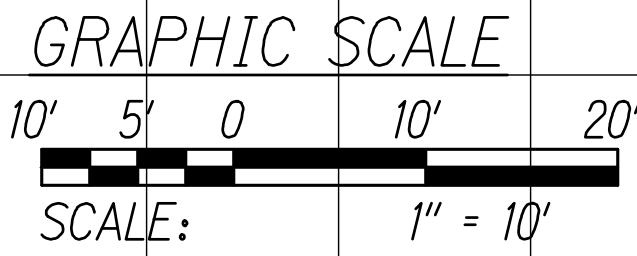

KOKEE ROAD
Scale: 1" = 10'

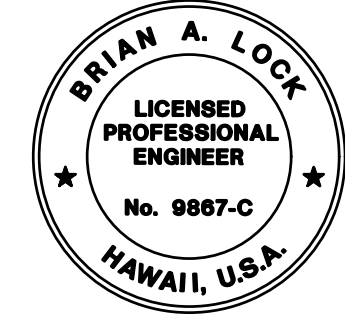


THIS WORK WAS PREPARED BY ME OR UNDER MY SUPERVISION.
[Signature]
WILSON OKAMOTO CORPORATION
APRIL 30, 2026
LIC. EXP. DATE

STATE OF HAWAII
DEPARTMENT OF TRANSPORTATION
HIGHWAYS DIVISION
ROADWAY CROSS SECTIONS
WAIMEA CANYON DRIVE /
KOKEE ROAD IMPROVEMENTS, PHASE 2B
MILE POST 4.6 TO MILE POST 11.5
Federal-Aid Project No. STP-0550(006)
Scale: 1" = 10' Date: July 2024

12/13/24 3 Revised Sections


DATE	REVISION
------	----------

SHEET No. X108 OF 122 SHEETS

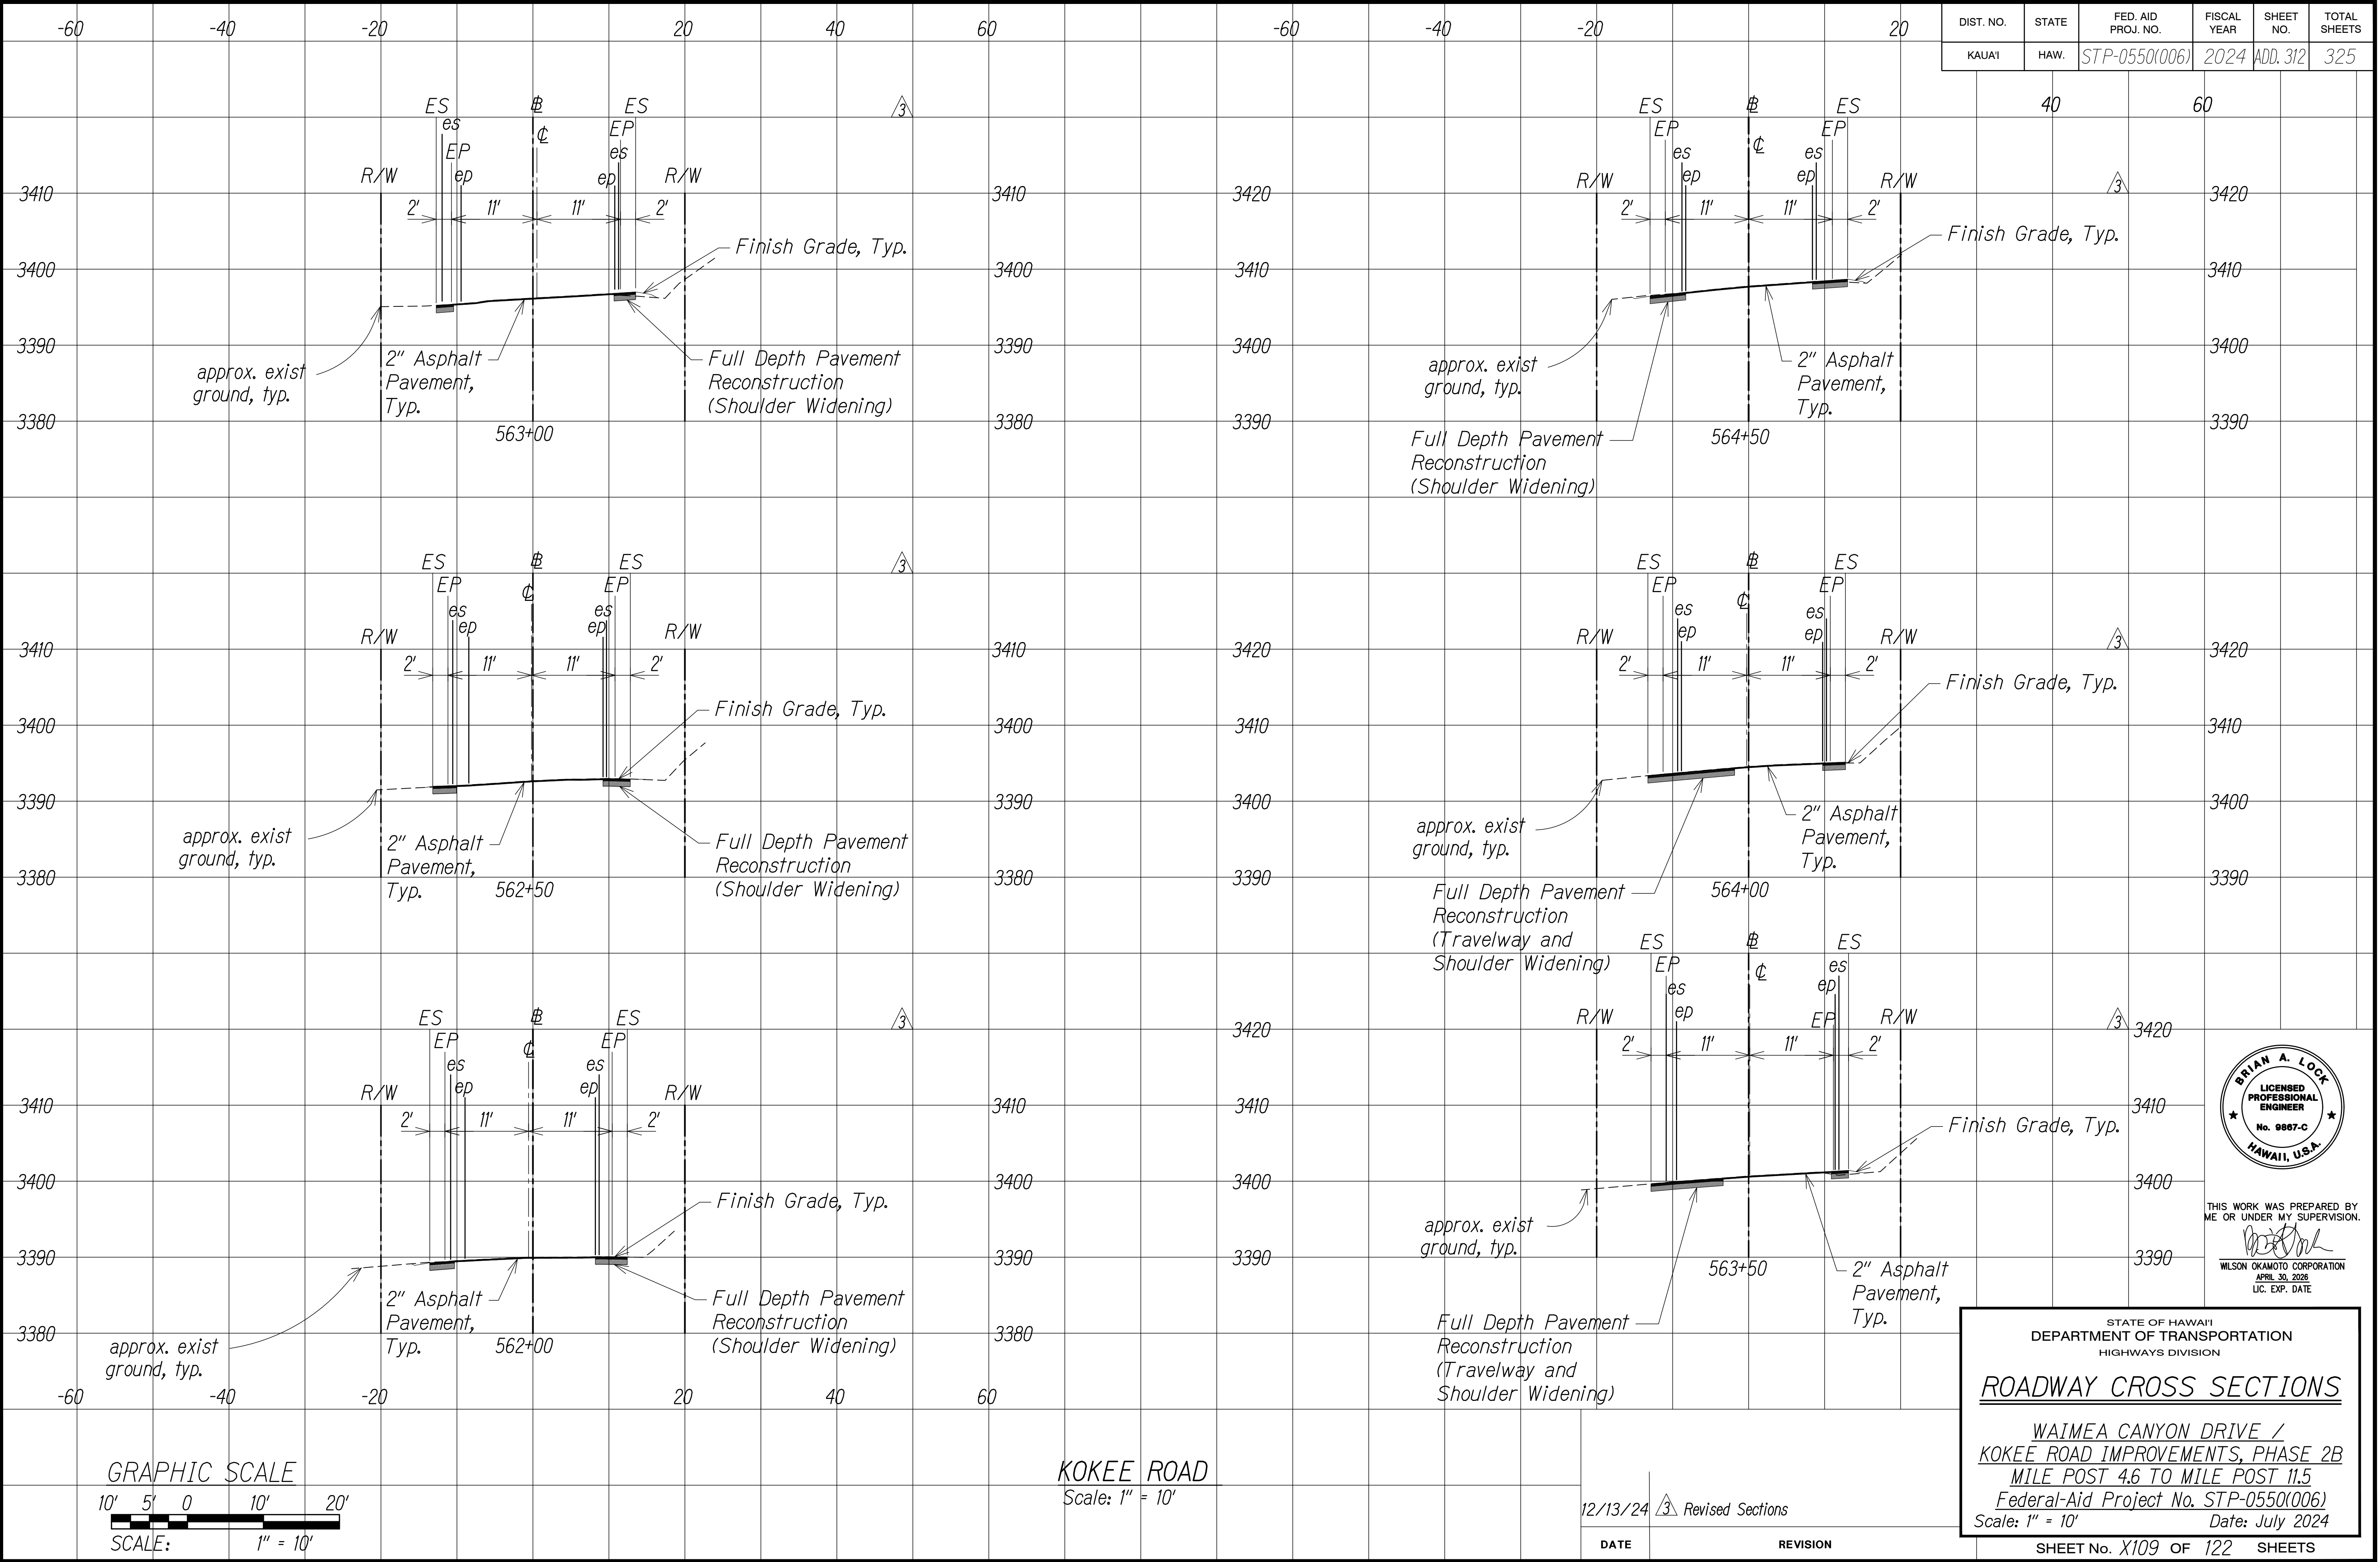

DIST. NO.	STATE	FED. AID PROJ. NO.	FISCAL YEAR	SHEET NO.	TOTAL SHEETS
KAUAI	HAW.	STP-0550(006)	2024	ADD. 312	325

SURVEY PLOTTED BY	DATE
DESIGNED BY	
TRACED BY	
QUANTITIES BY	
CHECKED BY	
ORIGINAL PLAN	
NOTE BOOK	
No.	

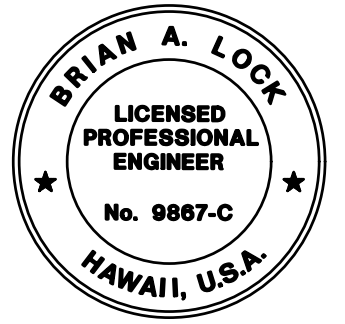

THIS WORK WAS PREPARED BY
ME OR UNDER MY SUPERVISION.
[Signature]
WILSON OKAMOTO CORPORATION
APRIL 30, 2026
LIC. EXP. DATE

STATE OF HAWAII
DEPARTMENT OF TRANSPORTATION
HIGHWAYS DIVISION

ROADWAY CROSS SECTIONS


WAIMEA CANYON DRIVE /
Kokee Road Improvements, Phase 2B
MILE POST 4.6 TO MILE POST 11.5
Federal-Aid Project No. STP-0550(006)
Scale: 1" = 10' Date: July 2024

12/13/24 3 Revised Sections


DATE	REVISION
------	----------

SHEET No. X109 OF 122 SHEETS


DIST. NO.	STATE	FED. AID PROJ. NO.	FISCAL YEAR	SHEET NO.	TOTAL SHEETS
KAUAI	HAW.	STP-0550(006)	2024	ADD. 313	325

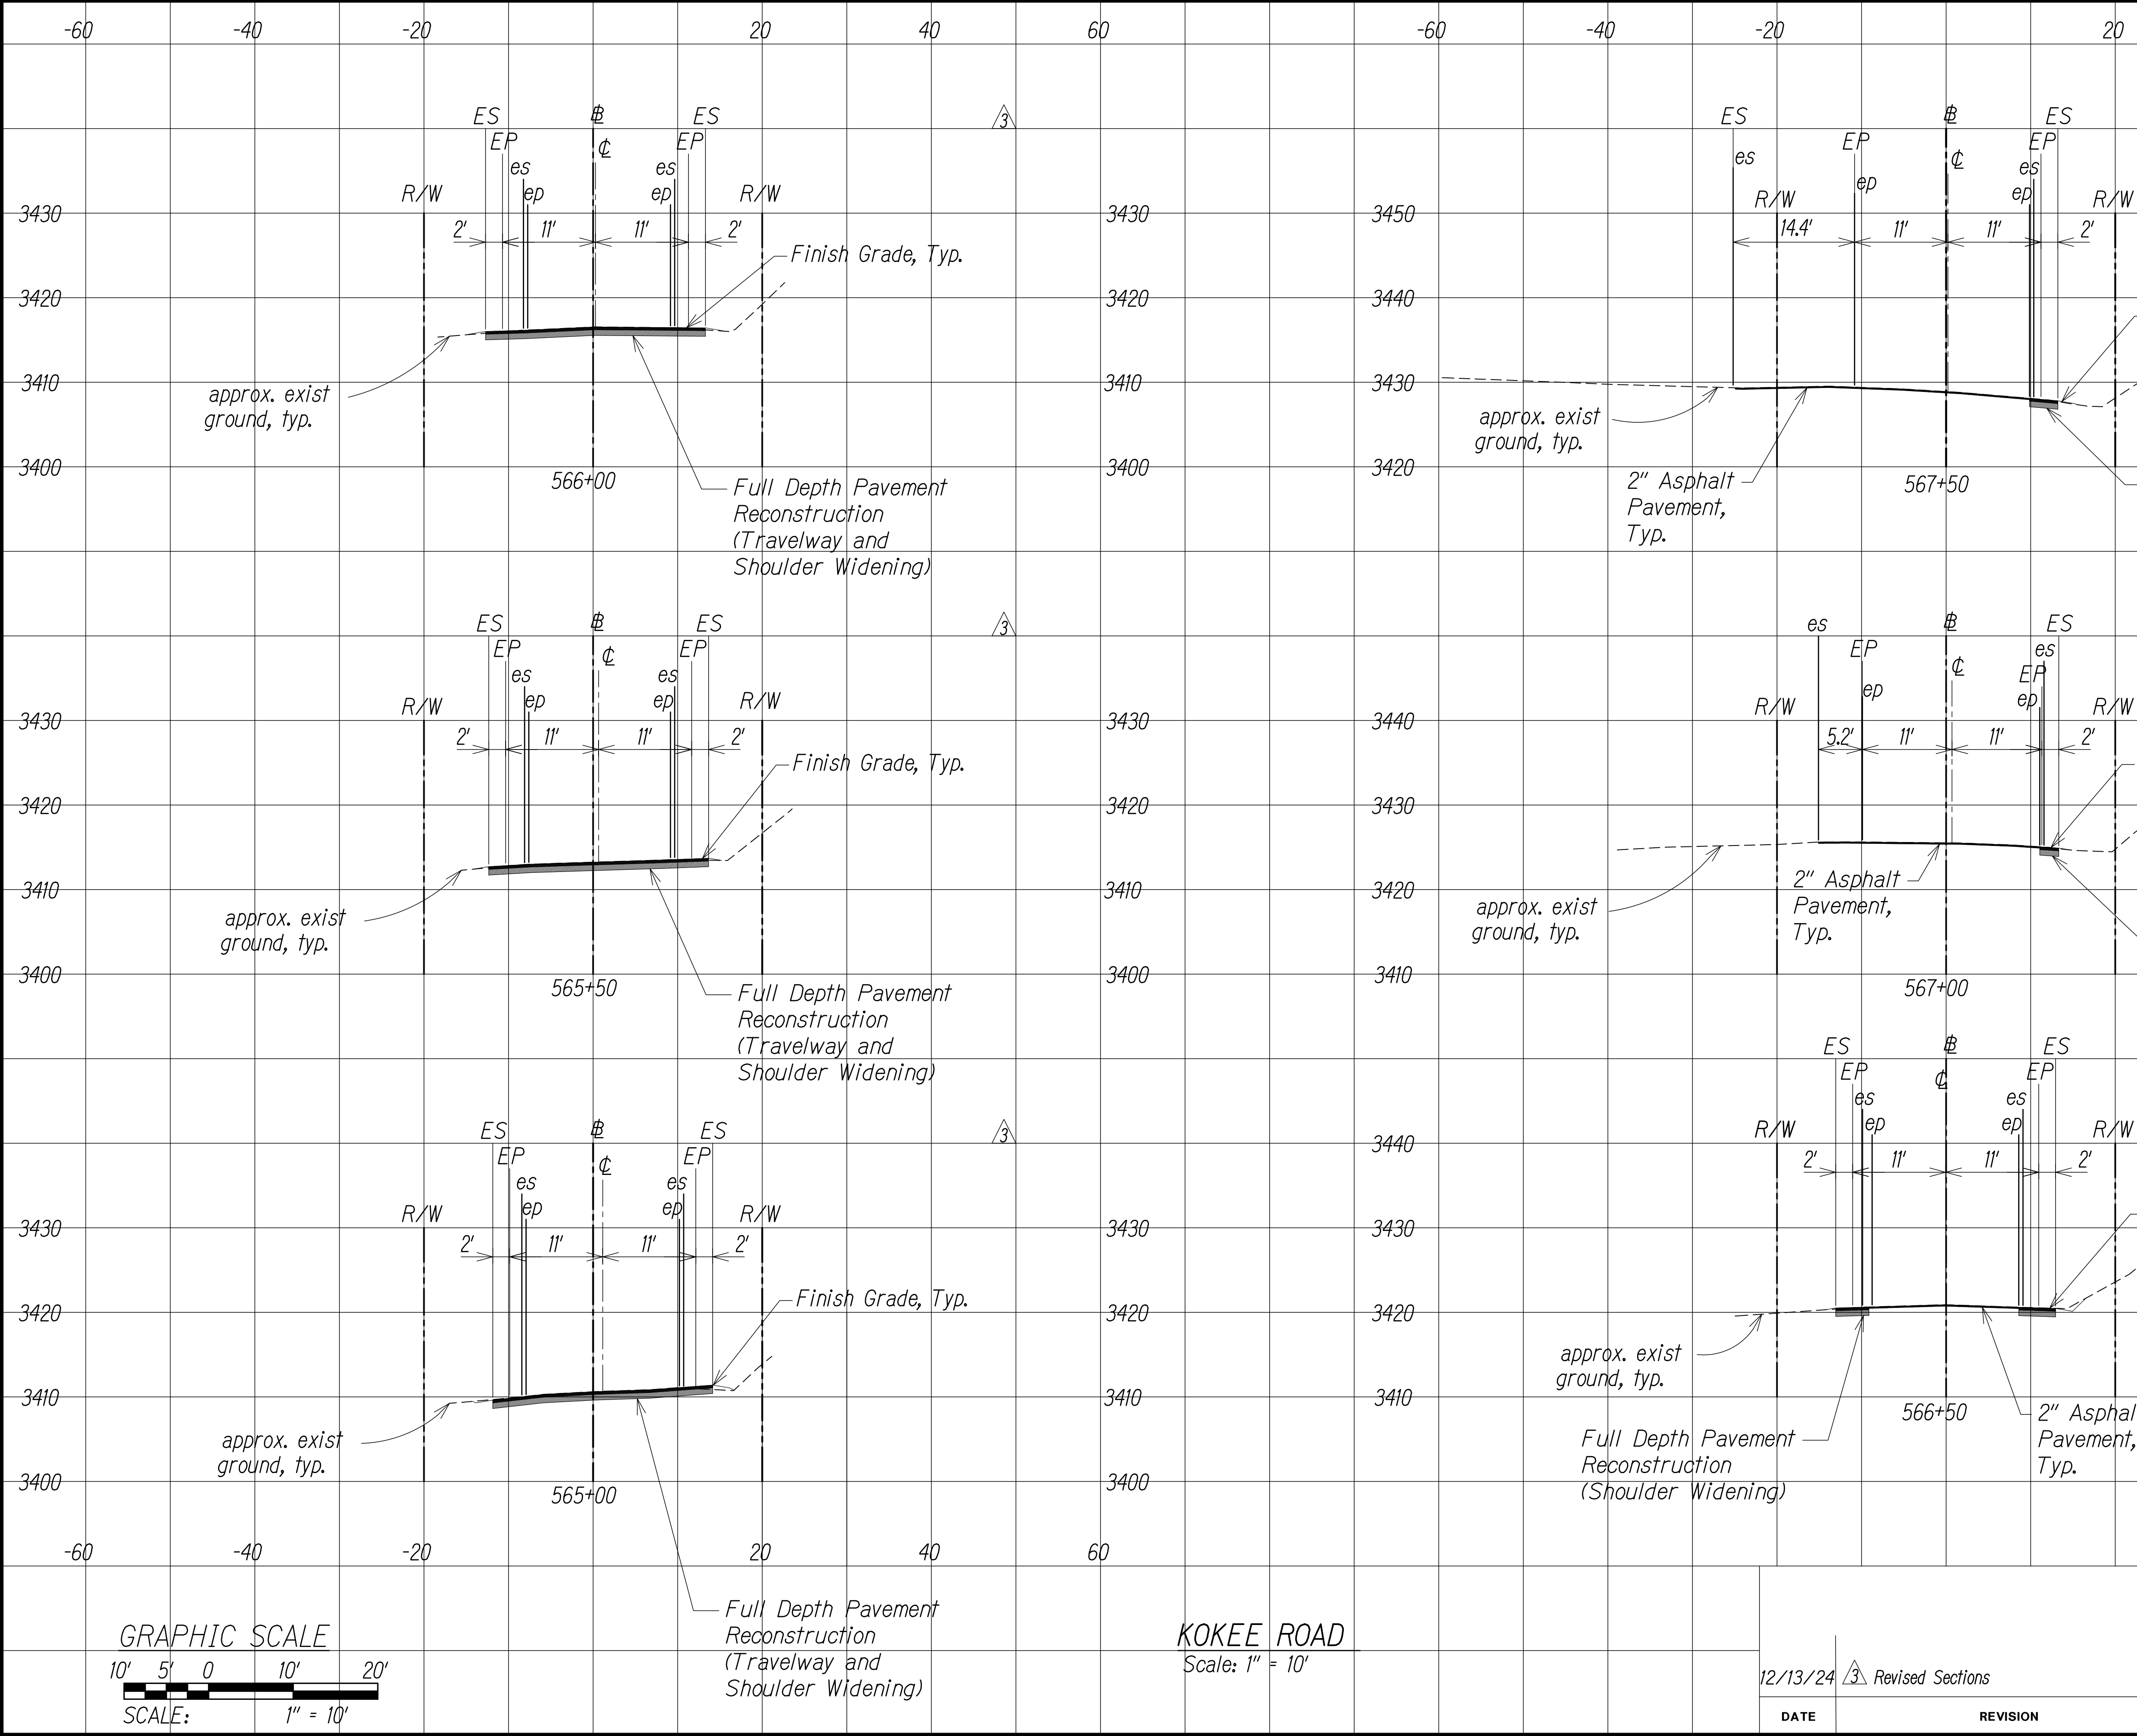

SURVEY PLOTTED BY	DATE
DESIGNED BY	
TRACED BY	
NOTED BY	
CHECKED BY	

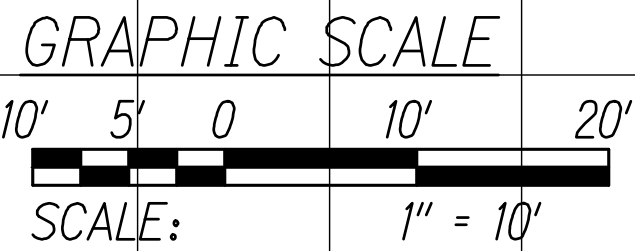

KOKEE ROAD
Scale: 1" = 10'

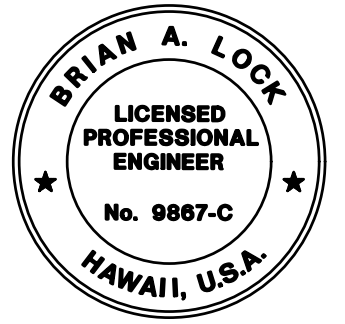


THIS WORK WAS PREPARED BY
ME OR UNDER MY SUPERVISION.
[Signature]
WILSON OKAMOTO CORPORATION
APRIL 30, 2026
LIC. EXP. DATE

STATE OF HAWAII
DEPARTMENT OF TRANSPORTATION
HIGHWAYS DIVISION
ROADWAY CROSS SECTIONS
WAIMEA CANYON DRIVE /
KOKEE ROAD IMPROVEMENTS, PHASE 2B
MILE POST 4.6 TO MILE POST 11.5
Federal-Aid Project No. STP-0550(006)
Scale: 1" = 10' Date: July 2024

12/13/24 3 Revised Sections


DATE REVISION

SHEET No. X110 OF 122 SHEETS

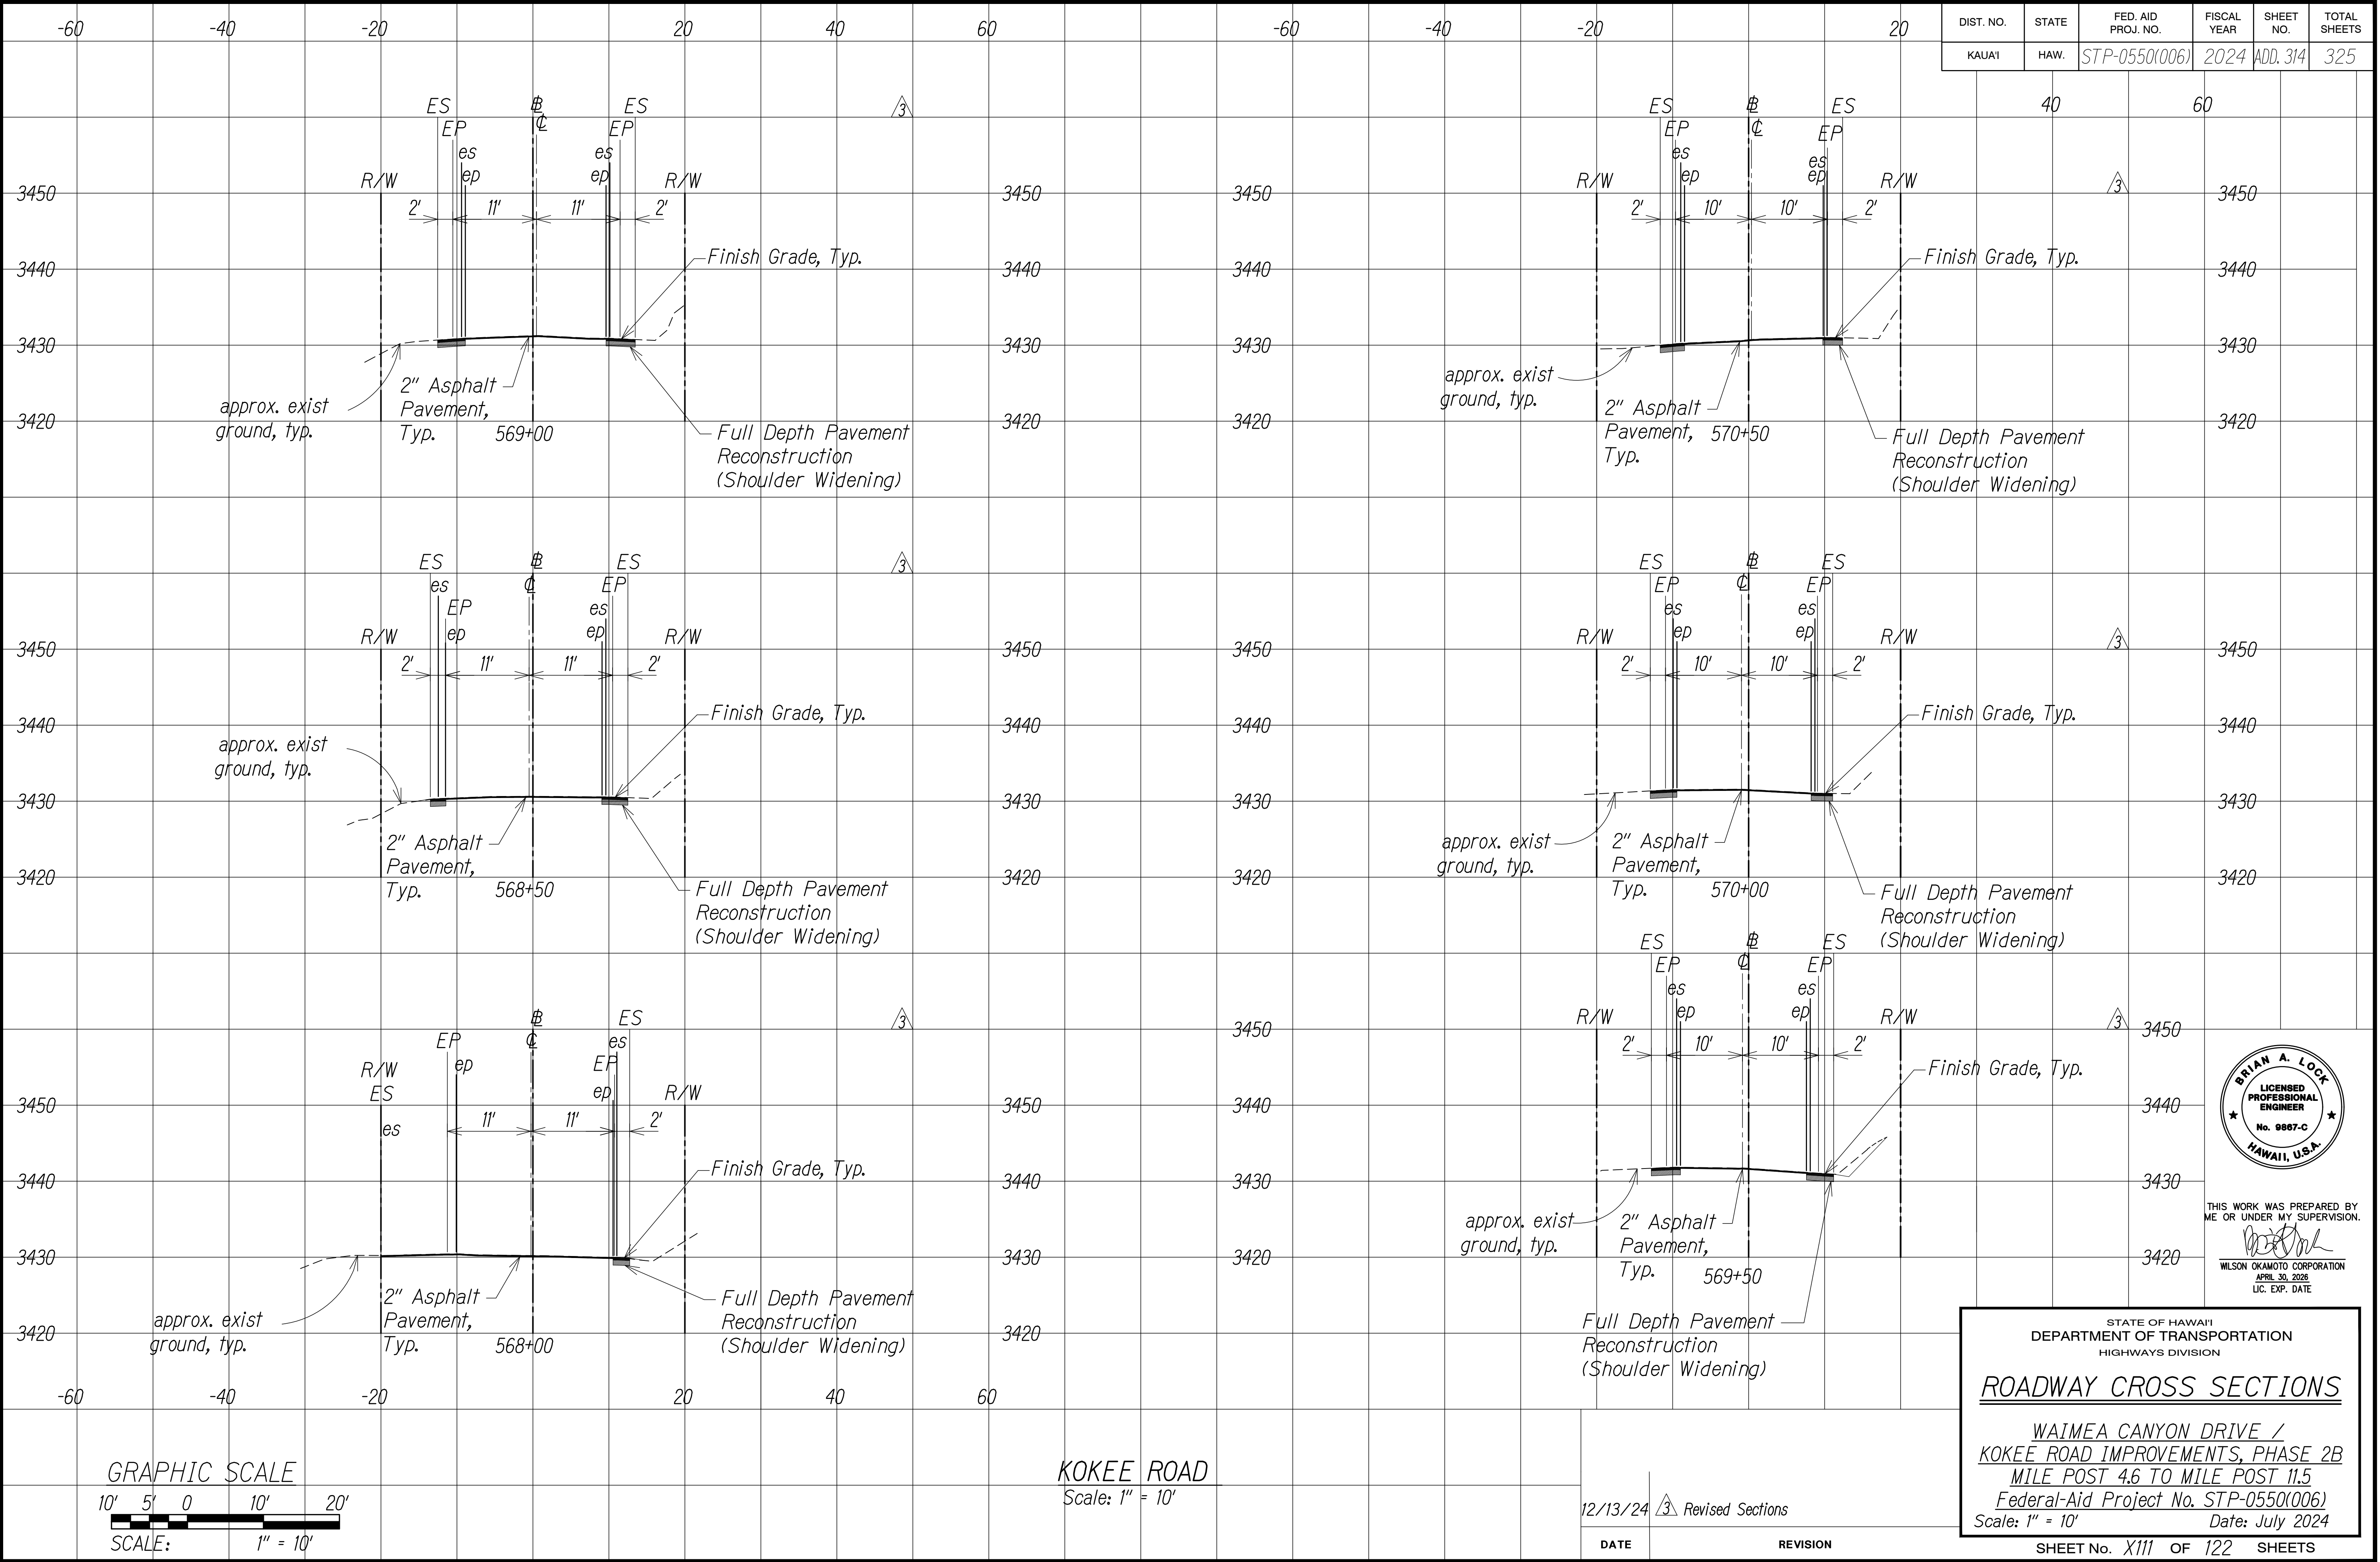

DIST. NO.	STATE	FED. AID PROJ. NO.	FISCAL YEAR	SHEET NO.	TOTAL SHEETS
KAUAI	HAW.	STP-0550(006)	2024	ADD. 314	325

SURVEY PLOTTED BY	DATE
DESIGNED BY	
TRACED BY	
QUANTITIES BY	
CHECKED BY	
ORIGINAL PLAN	
NOTE BOOK	
No.	

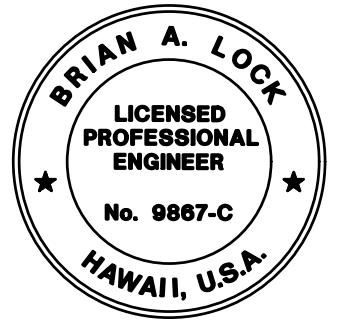

THIS WORK WAS PREPARED BY ME OR UNDER MY SUPERVISION.
[Signature]
WILSON OKAMOTO CORPORATION
APRIL 30, 2026
LIC. EXP. DATE

STATE OF HAWAII
DEPARTMENT OF TRANSPORTATION
HIGHWAYS DIVISION


ROADWAY CROSS SECTIONS

WAIMEA CANYON DRIVE /
Kokee Road Improvements, Phase 2B
MILE POST 4.6 TO MILE POST 11.5
Federal-Aid Project No. STP-0550(006)
Scale: 1" = 10' Date: July 2024

12/13/24 3 Revised Sections


DATE	REVISION
------	----------

SHEET No. X111 OF 122 SHEETS

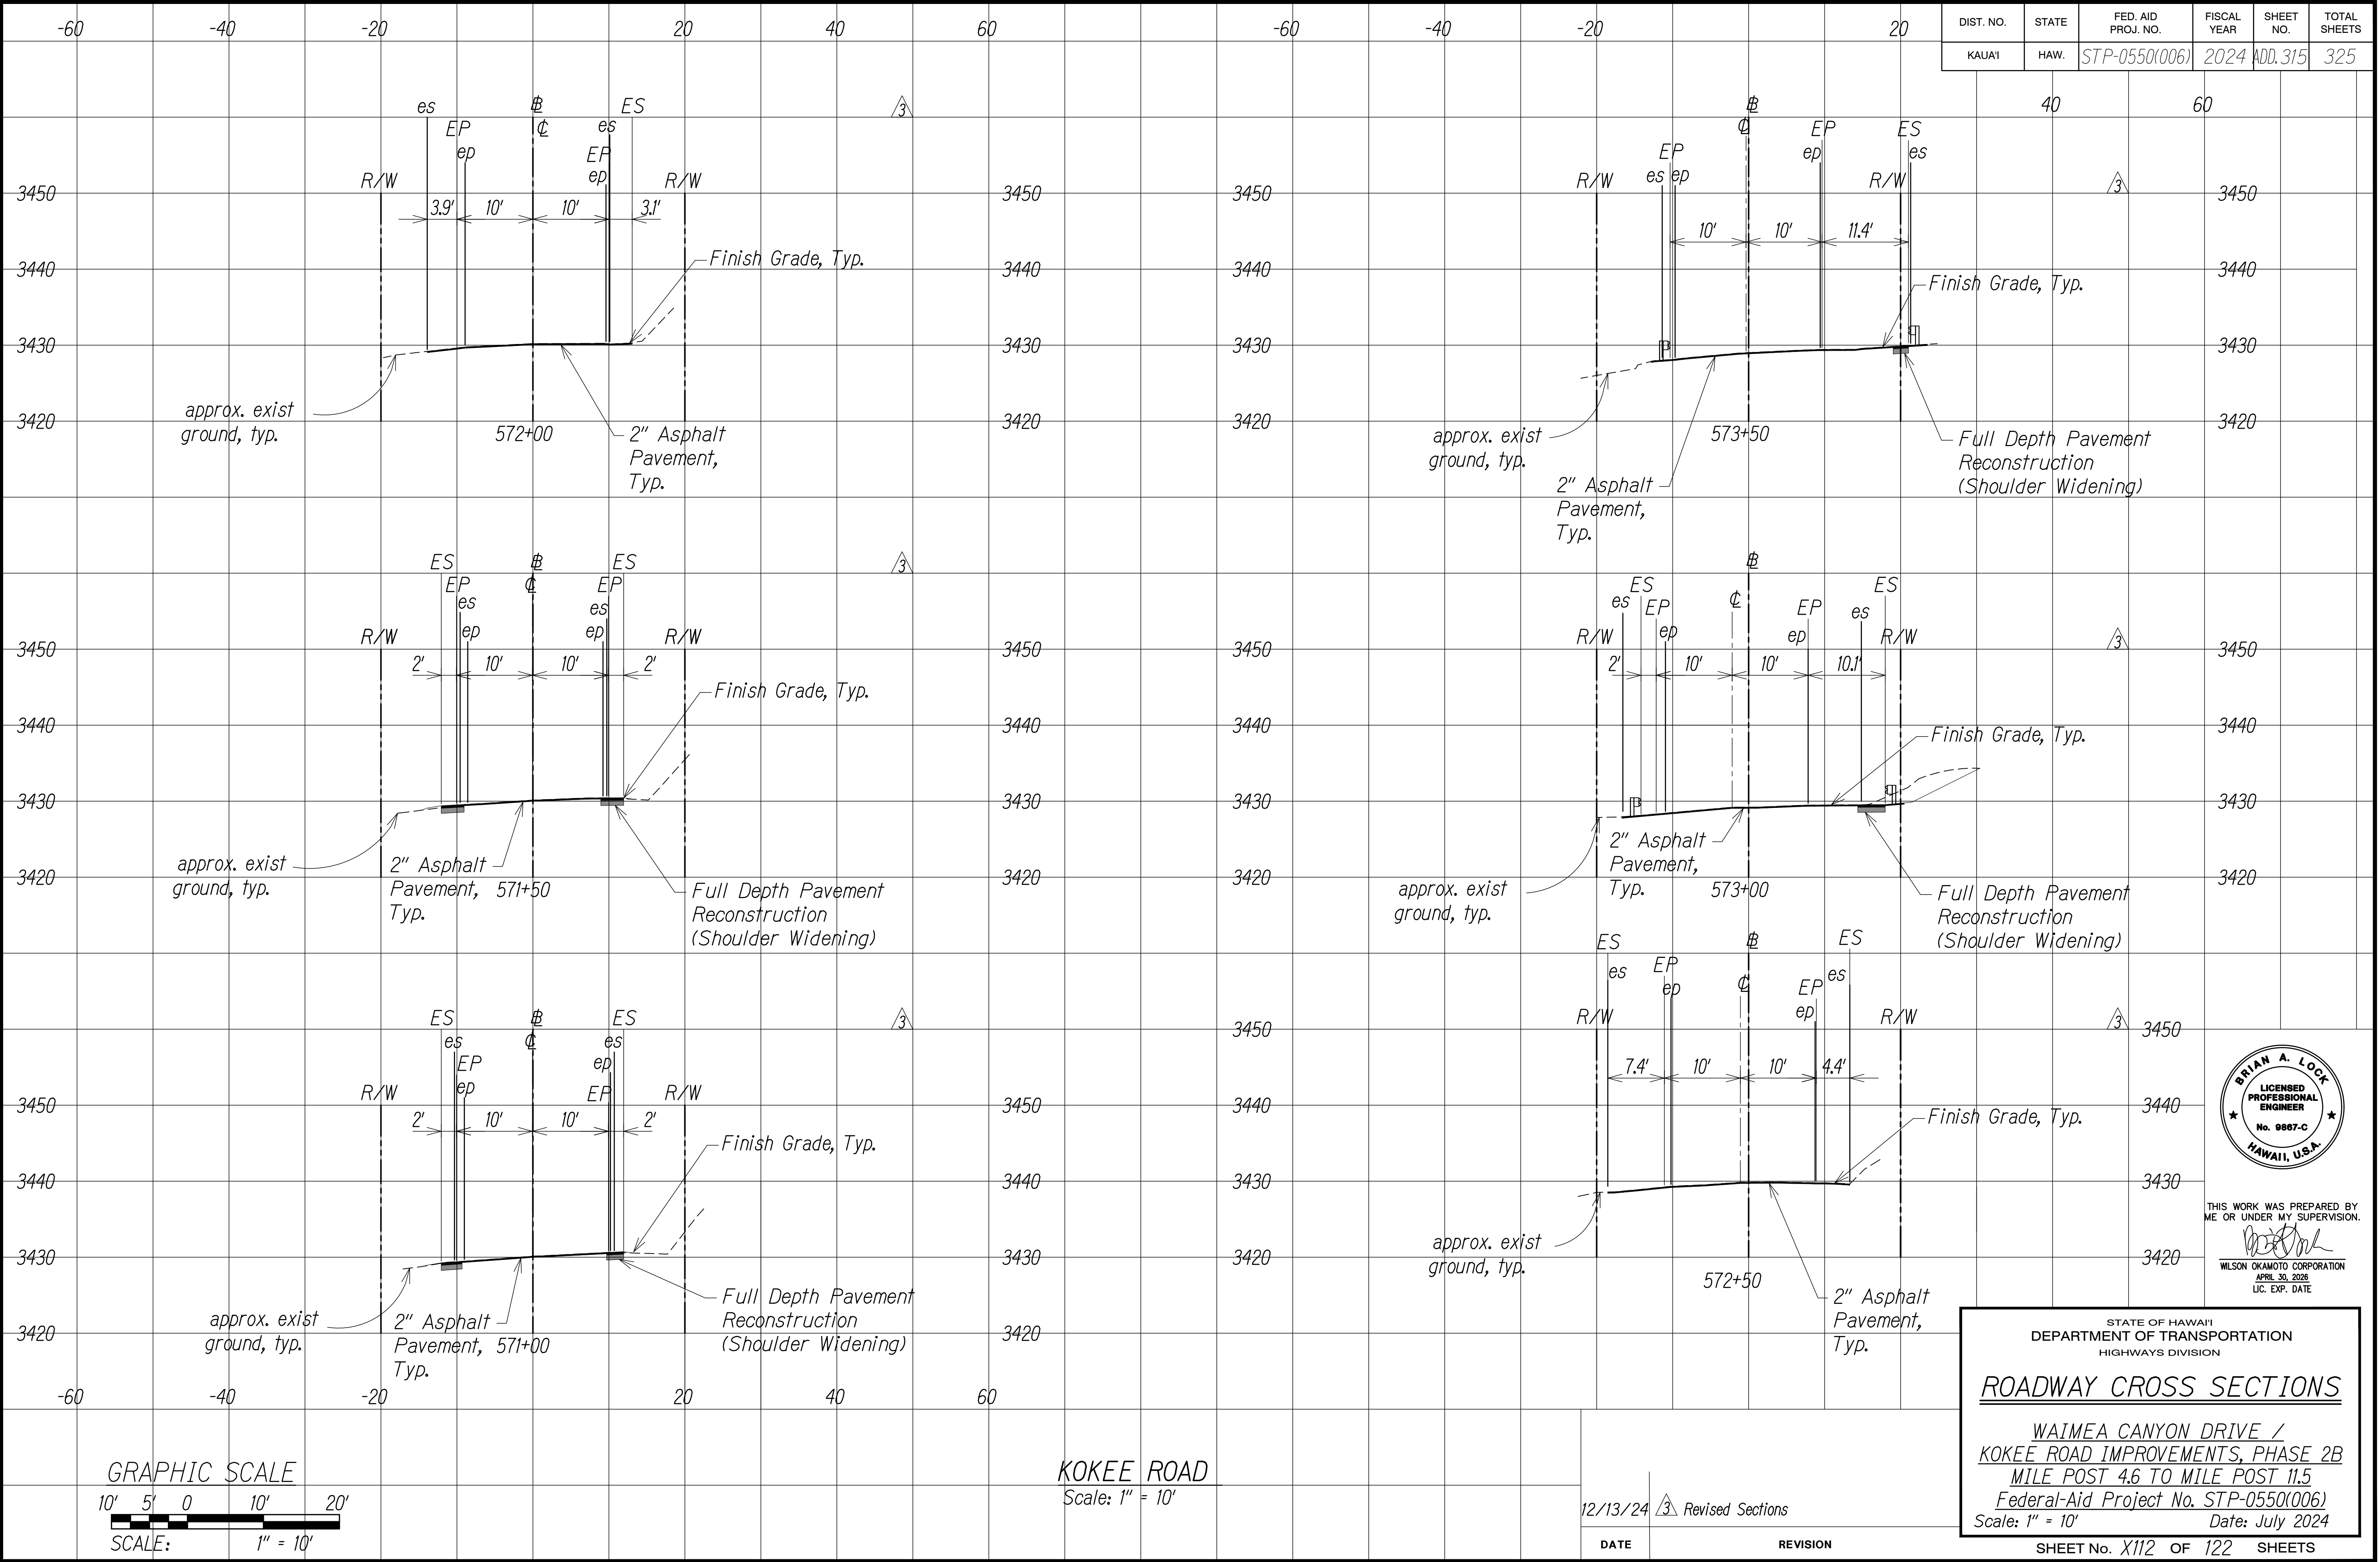

DIST. NO.	STATE	FED. AID PROJ. NO.	FISCAL YEAR	SHEET NO.	TOTAL SHEETS
KAUA'I	HAW.	STP-0550(006)	2024	ADD.315	325

SURVEY PLOTTED BY	DATE
DESIGNED BY	
TRACED BY	
QUANTITIES BY	
CHECKED BY	
NOTE BOOK	
No.	

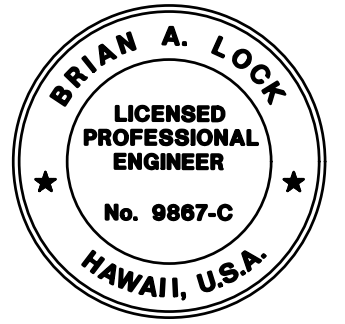

THIS WORK WAS PREPARED BY
ME OR UNDER MY SUPERVISION.
[Signature]
WILSON OKAMOTO CORPORATION
APRIL 30, 2026
LIC. EXP. DATE

STATE OF HAWAII
DEPARTMENT OF TRANSPORTATION
HIGHWAYS DIVISION


ROADWAY CROSS SECTIONS

WAIMEA CANYON DRIVE /
KOEKE ROAD IMPROVEMENTS, PHASE 2B
MILE POST 4.6 TO MILE POST 11.5
Federal-Aid Project No. STP-0550(006)
Scale: 1" = 10' Date: July 2024


12/13/24 3 Revised Sections

DATE	REVISION
------	----------

SHEET No. X112 OF 122 SHEETS

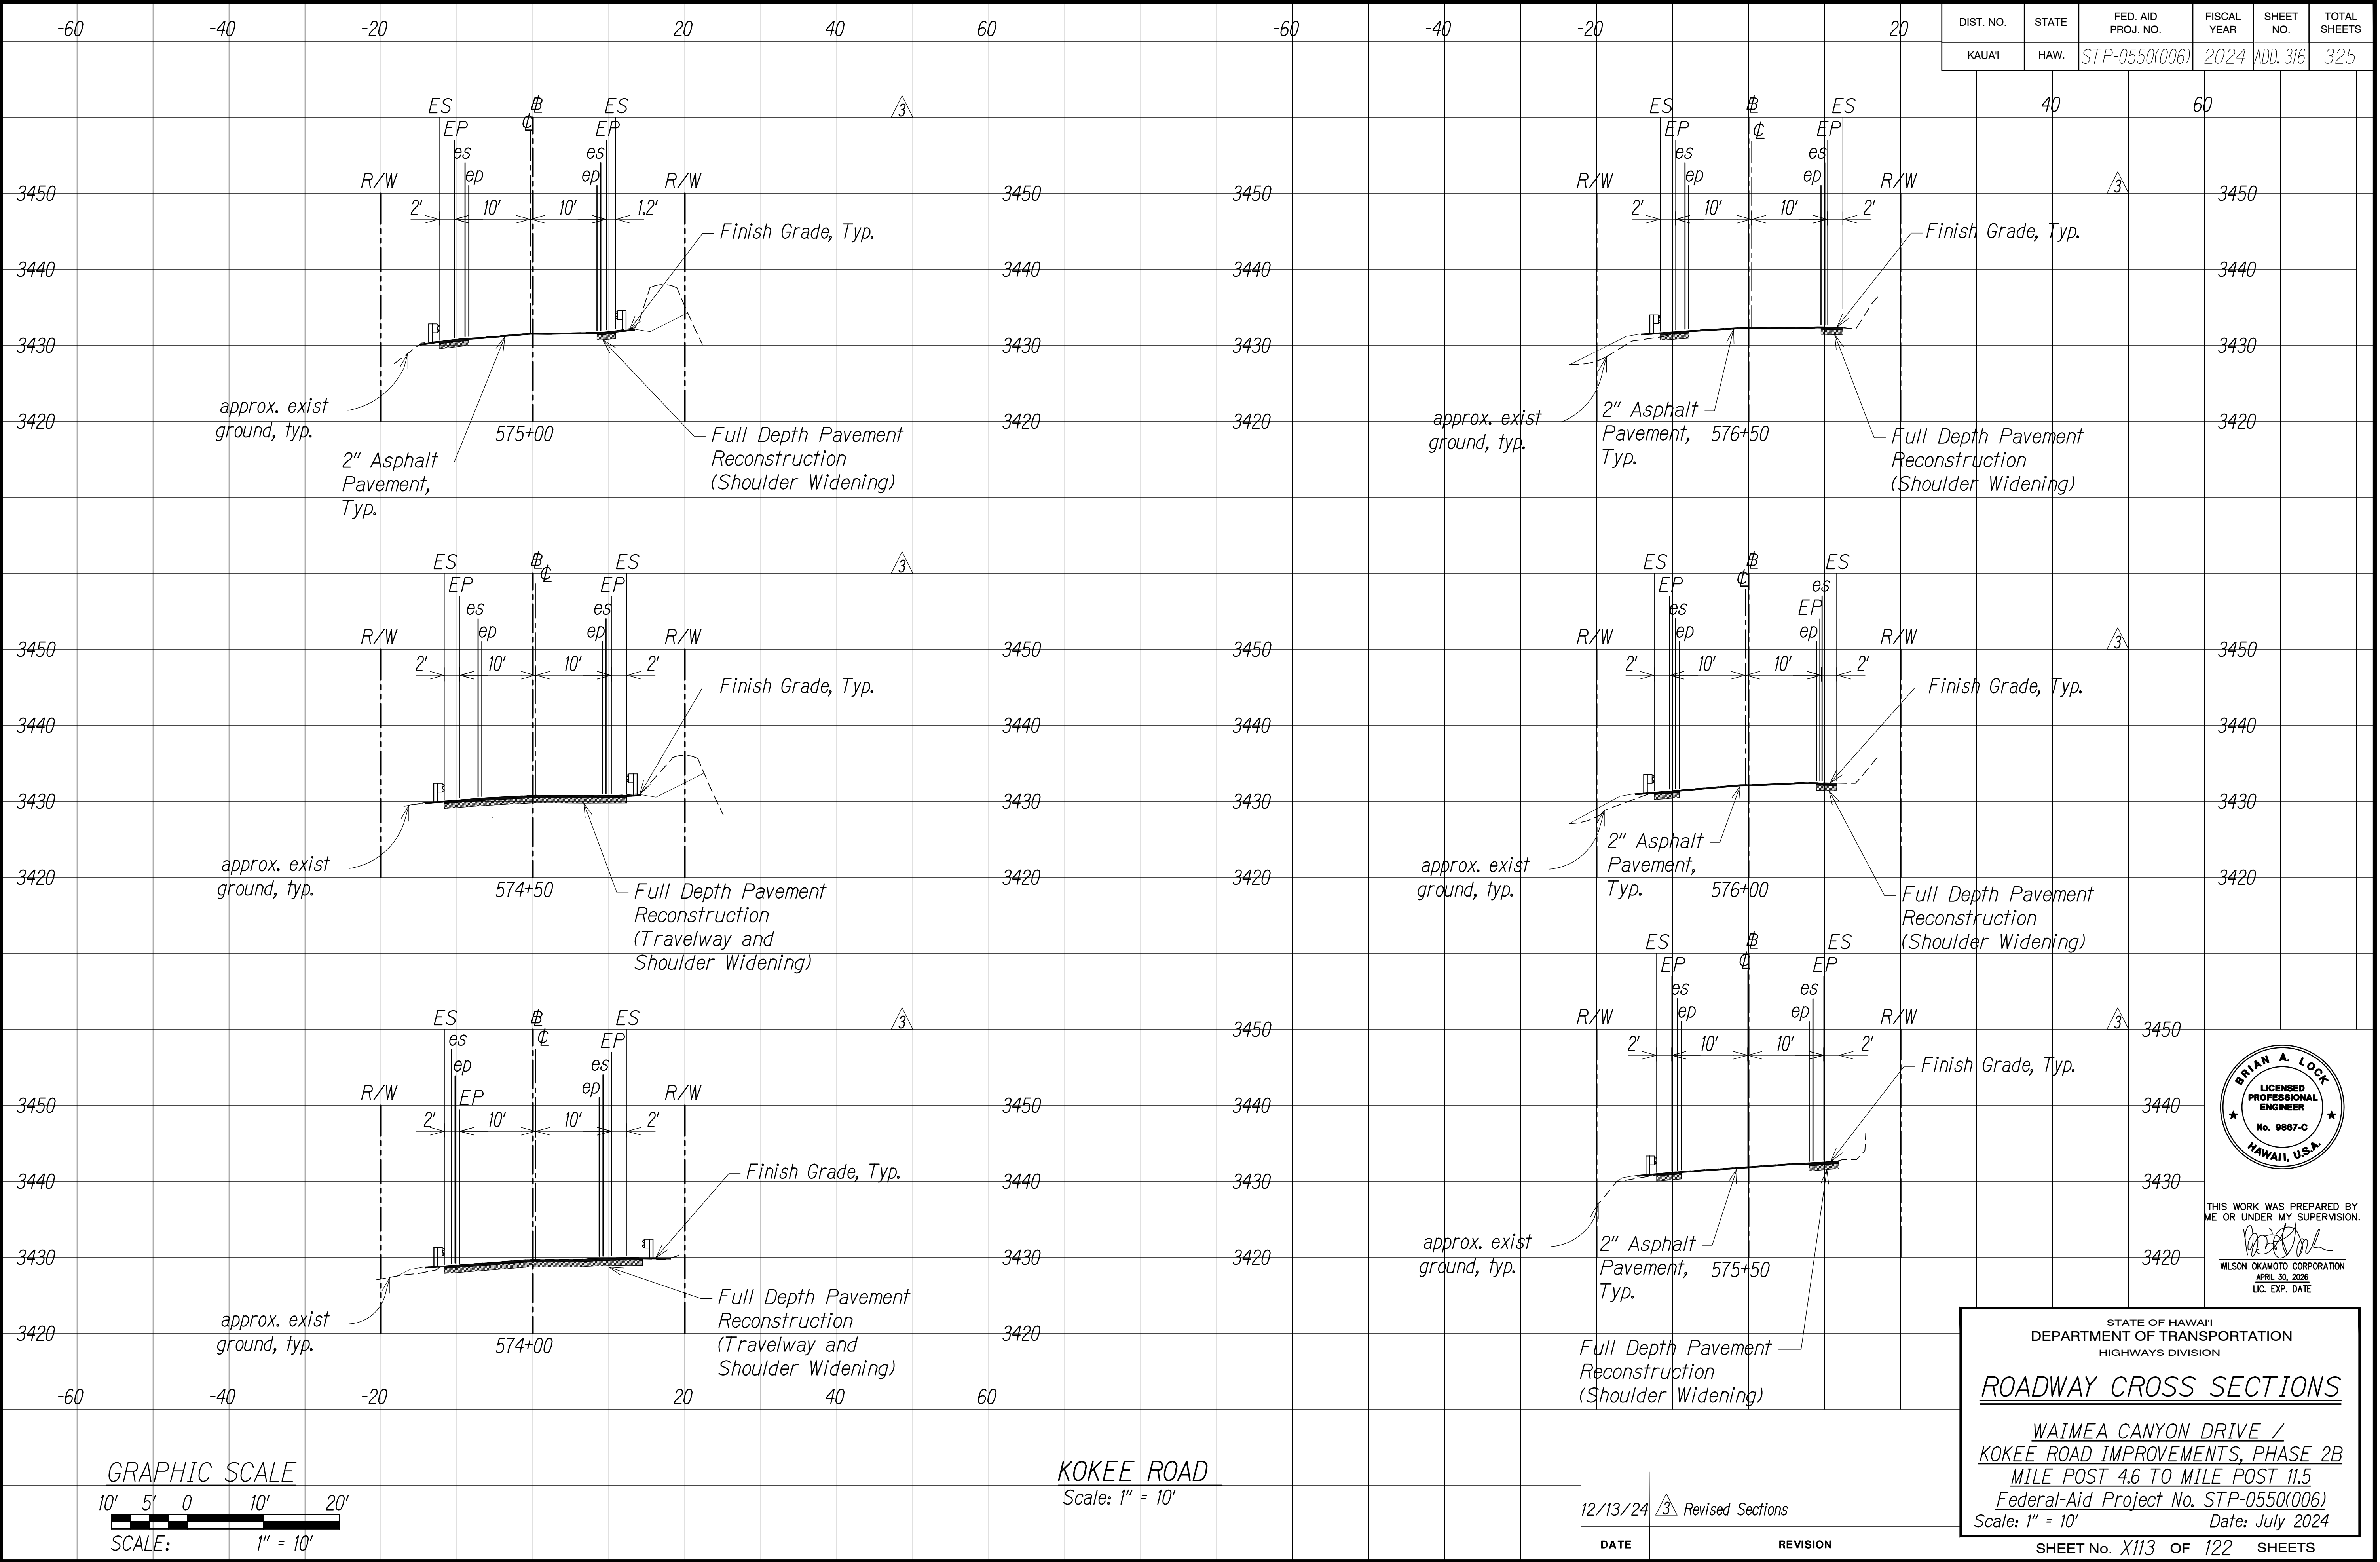

SURVEY PLOTTED BY	DATE
DESIGNED BY	
TRACED BY	
DESIGNED BY	
QUANTITIES BY	
CHECKED BY	
ORIGINAL PLAN	
NOTE BOOK	
No.	

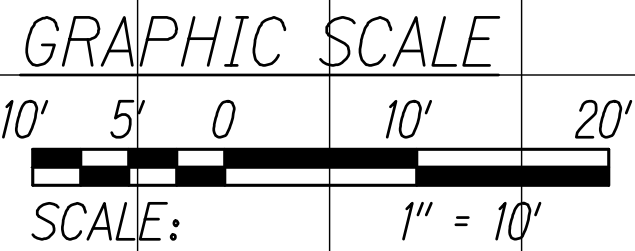

KOKEE ROAD

Scale: 1" = 10'


12/13/24 3 Revised Sections

DATE REVISION

STATE OF HAWAII
DEPARTMENT OF TRANSPORTATION
HIGHWAYS DIVISION

ROADWAY CROSS SECTIONS

WAIMEA CANYON DRIVE /
KOKEE ROAD IMPROVEMENTS, PHASE 2B
MILE POST 4.6 TO MILE POST 11.5
Federal-Aid Project No. STP-0550(006)
Scale: 1" = 10' Date: July 2024

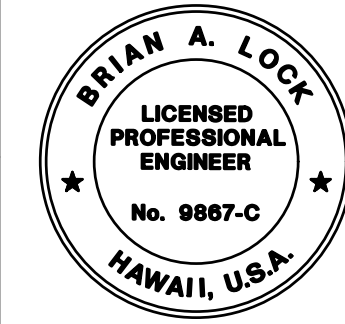


THIS WORK WAS PREPARED BY
ME OR UNDER MY SUPERVISION.

[Signature]

WILSON OKAMOTO CORPORATION
APRIL 30, 2026
LIC. EXP. DATE


SHEET No. X113 OF 122 SHEETS

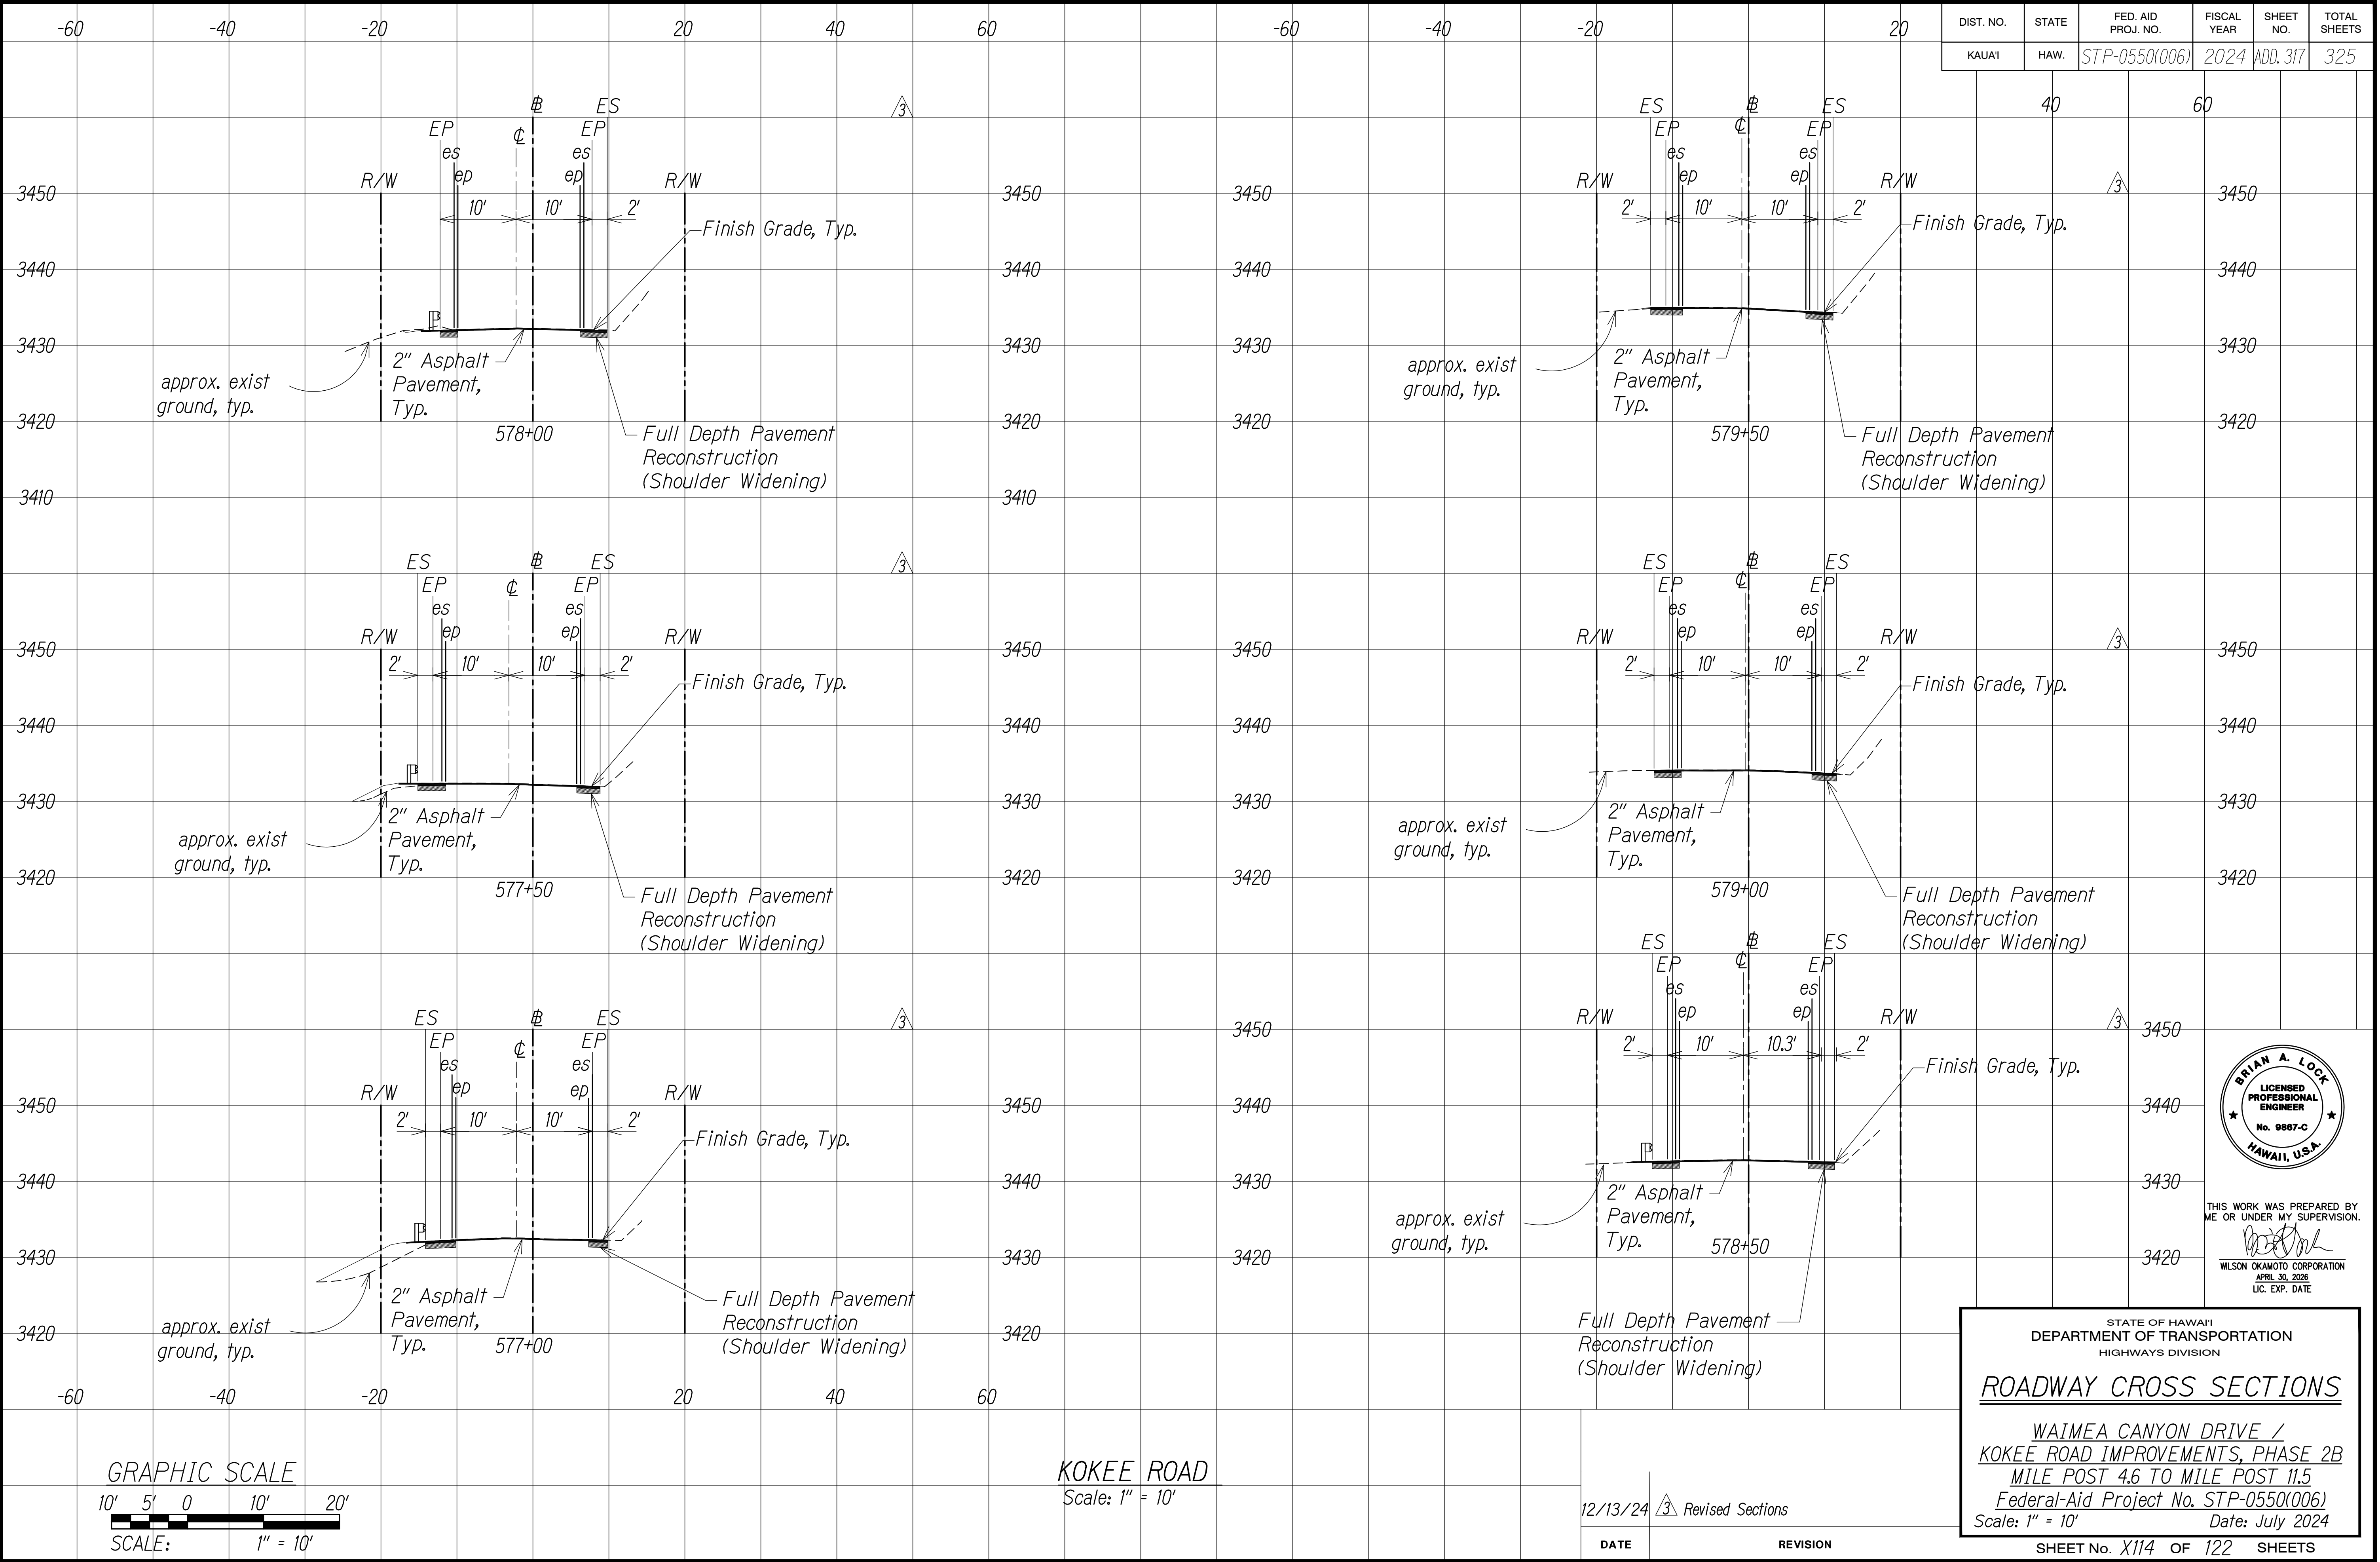

DIST. NO.	STATE	FED. AID PROJ. NO.	FISCAL YEAR	SHEET NO.	TOTAL SHEETS
KAUAI	HAW.	STP-0550(006)	2024	ADD. 317	325

SURVEY PLOTTED BY	DATE
DESIGNED BY	
TRACED BY	
QUANTITIES BY	
CHECKED BY	

ORIGINAL PLAN	NOTE BOOK
No.	

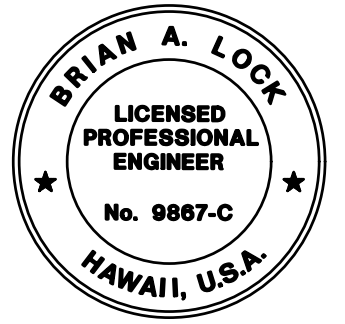

THIS WORK WAS PREPARED BY ME OR UNDER MY SUPERVISION.
[Signature]
WILSON OKAMOTO CORPORATION
APRIL 30, 2026
LIC. EXP. DATE


STATE OF HAWAII
DEPARTMENT OF TRANSPORTATION
HIGHWAYS DIVISION
ROADWAY CROSS SECTIONS
WAIMEA CANYON DRIVE /
KOKEE ROAD IMPROVEMENTS, PHASE 2B
MILE POST 4.6 TO MILE POST 11.5
Federal-Aid Project No. STP-0550(006)
Scale: 1" = 10' Date: July 2024

12/13/24 3 Revised Sections


DATE	REVISION
------	----------

SHEET No. X114 OF 122 SHEETS

ADD317

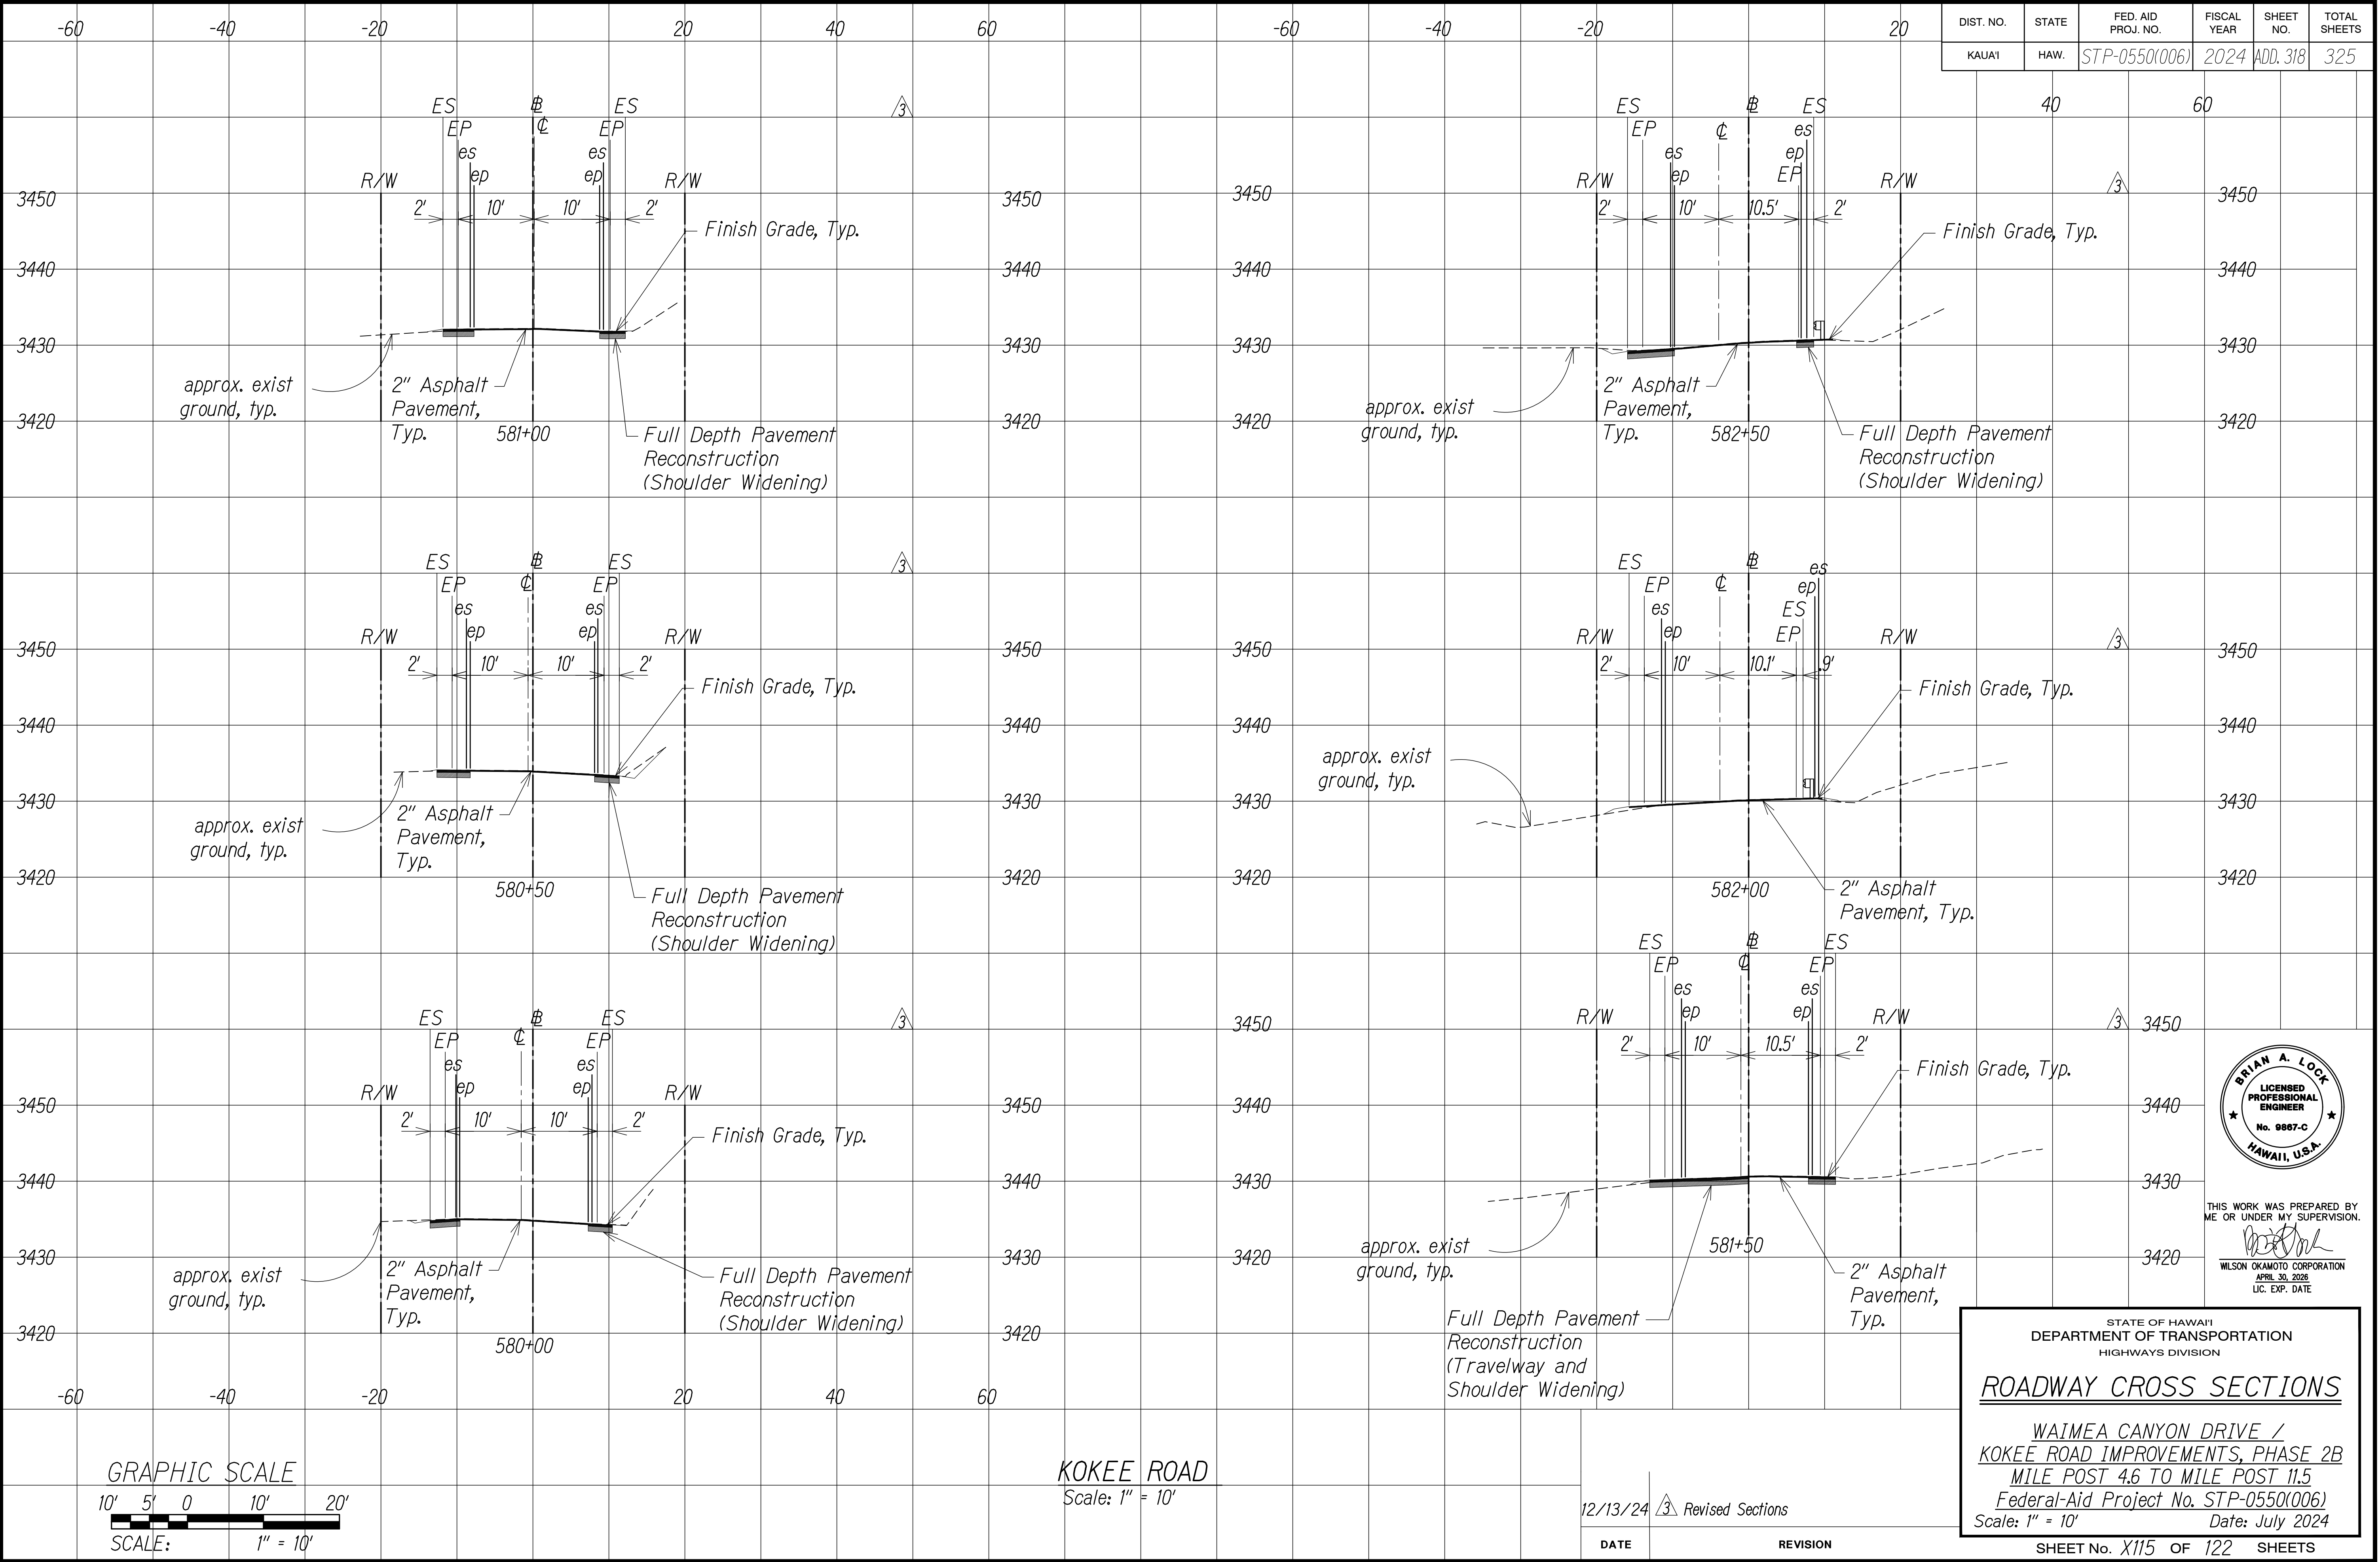

SURVEY PLOTTED BY	DATE
DESIGNED BY	
TRACED BY	
NOTE BOOK	
QUANTITIES BY	
CHECKED BY	

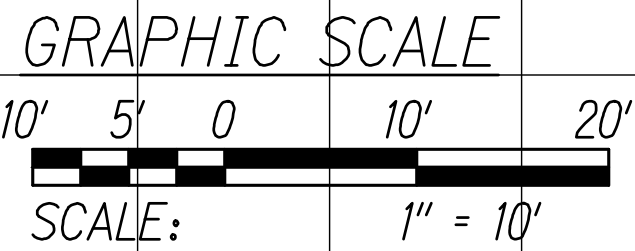

KOKEE ROAD
Scale: 1" = 10'


12/13/24 3 Revised Sections

DATE REVISION

STATE OF HAWAII
DEPARTMENT OF TRANSPORTATION
HIGHWAYS DIVISION

ROADWAY CROSS SECTIONS


WAIMEA CANYON DRIVE /
KOKEE ROAD IMPROVEMENTS, PHASE 2B
MILE POST 4.6 TO MILE POST 11.5
Federal-Aid Project No. STP-0550(006)
Scale: 1" = 10' Date: July 2024

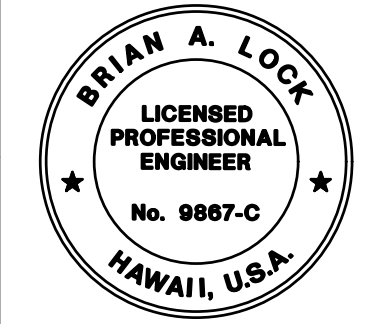

THIS WORK WAS PREPARED BY
ME OR UNDER MY SUPERVISION.

[Signature]
WILSON OKAMOTO CORPORATION
APRIL 30, 2026
LIC. EXP. DATE


SHEET No. X115 OF 122 SHEETS

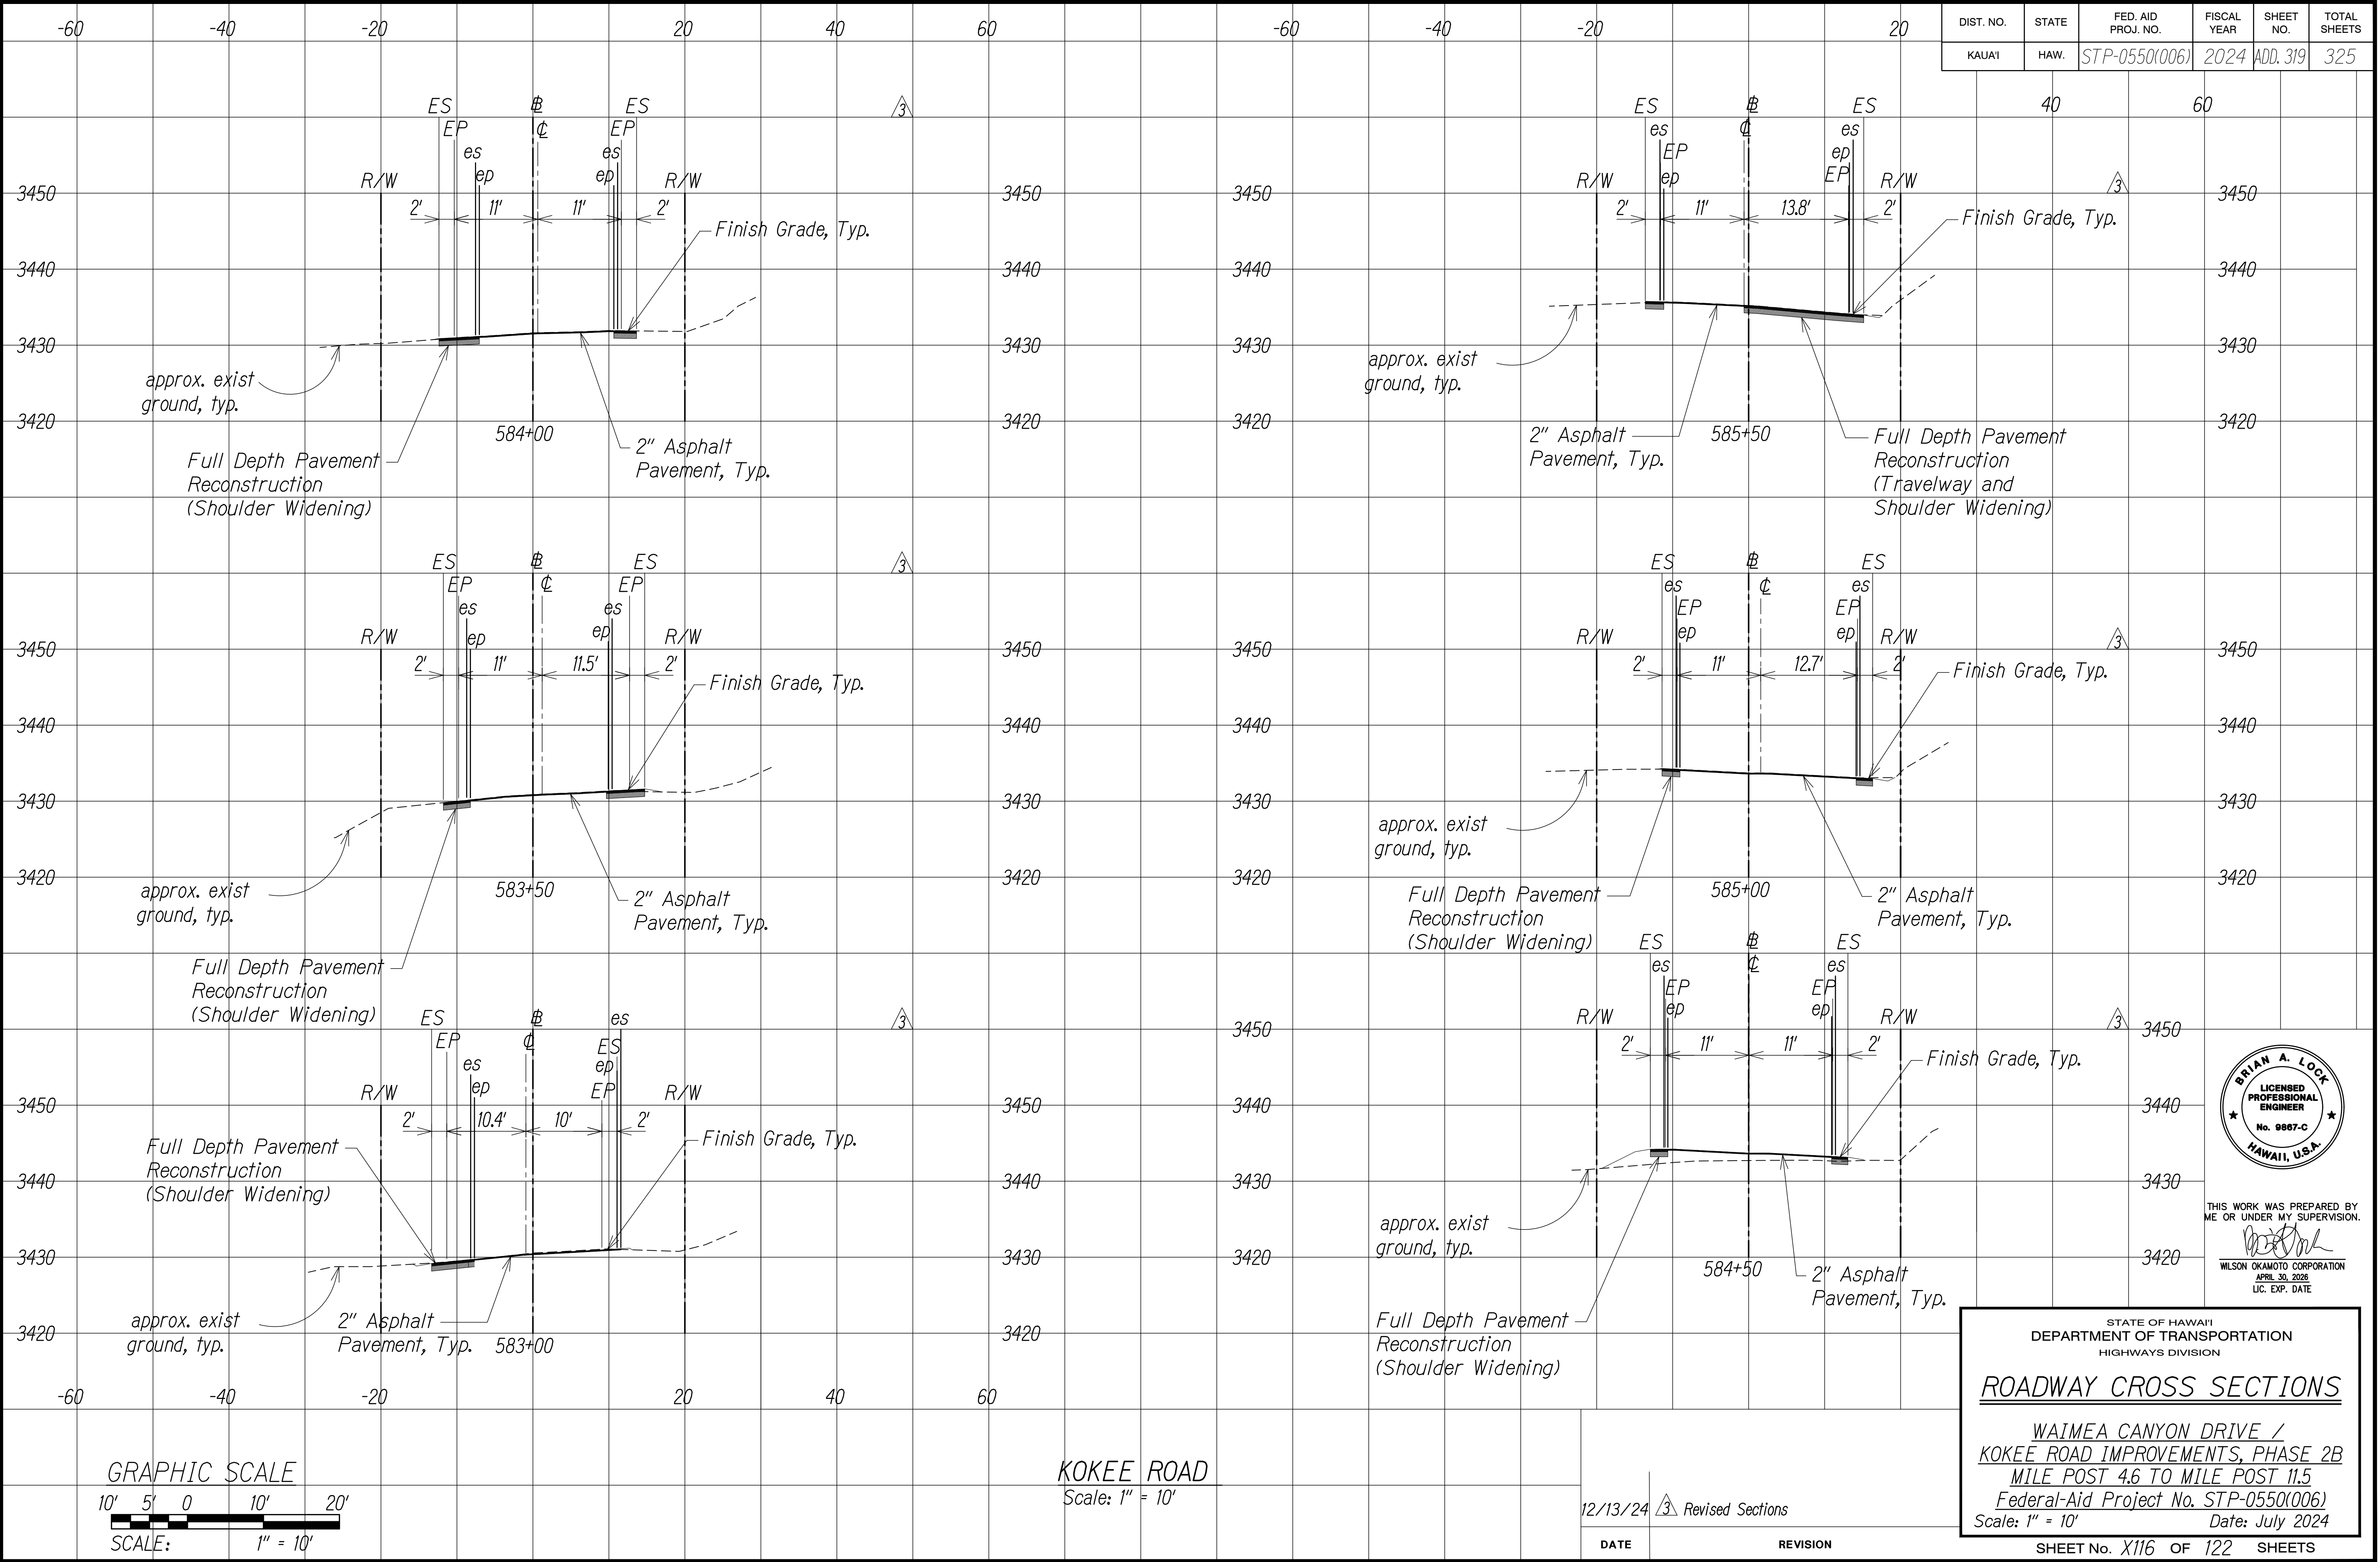


DIST. NO.	STATE	FED. AID PROJ. NO.	FISCAL YEAR	SHEET NO.	TOTAL SHEETS
KAUAI	HAW.	STP-0550(006)	2024	ADD. 319	325

SURVEY PLOTTED BY	DATE
DESIGNED BY	
TRACED BY	
QUANTITIES BY	
CHECKED BY	

ORIGINAL PLAN	NOTE BOOK
No.	

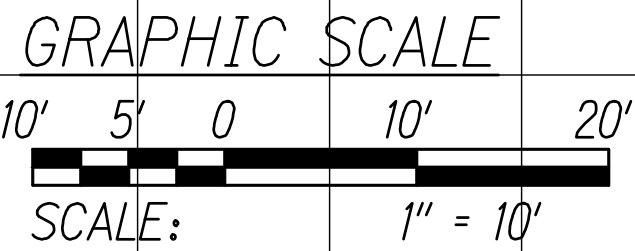

KOKEE ROAD
Scale: 1" = 10'

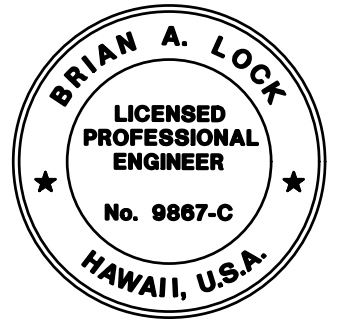


THIS WORK WAS PREPARED BY ME OR UNDER MY SUPERVISION.
WILSON OKAMOTO CORPORATION
APRIL 30, 2026
LIC. EXP. DATE

STATE OF HAWAII
DEPARTMENT OF TRANSPORTATION
HIGHWAYS DIVISION
ROADWAY CROSS SECTIONS
WAIMEA CANYON DRIVE /
KOKEE ROAD IMPROVEMENTS, PHASE 2B
MILE POST 4.6 TO MILE POST 11.5
Federal-Aid Project No. STP-0550(006)
Scale: 1" = 10' Date: July 2024

12/13/24 3 Revised Sections

DATE REVISION


SHEET No. X116 OF 122 SHEETS

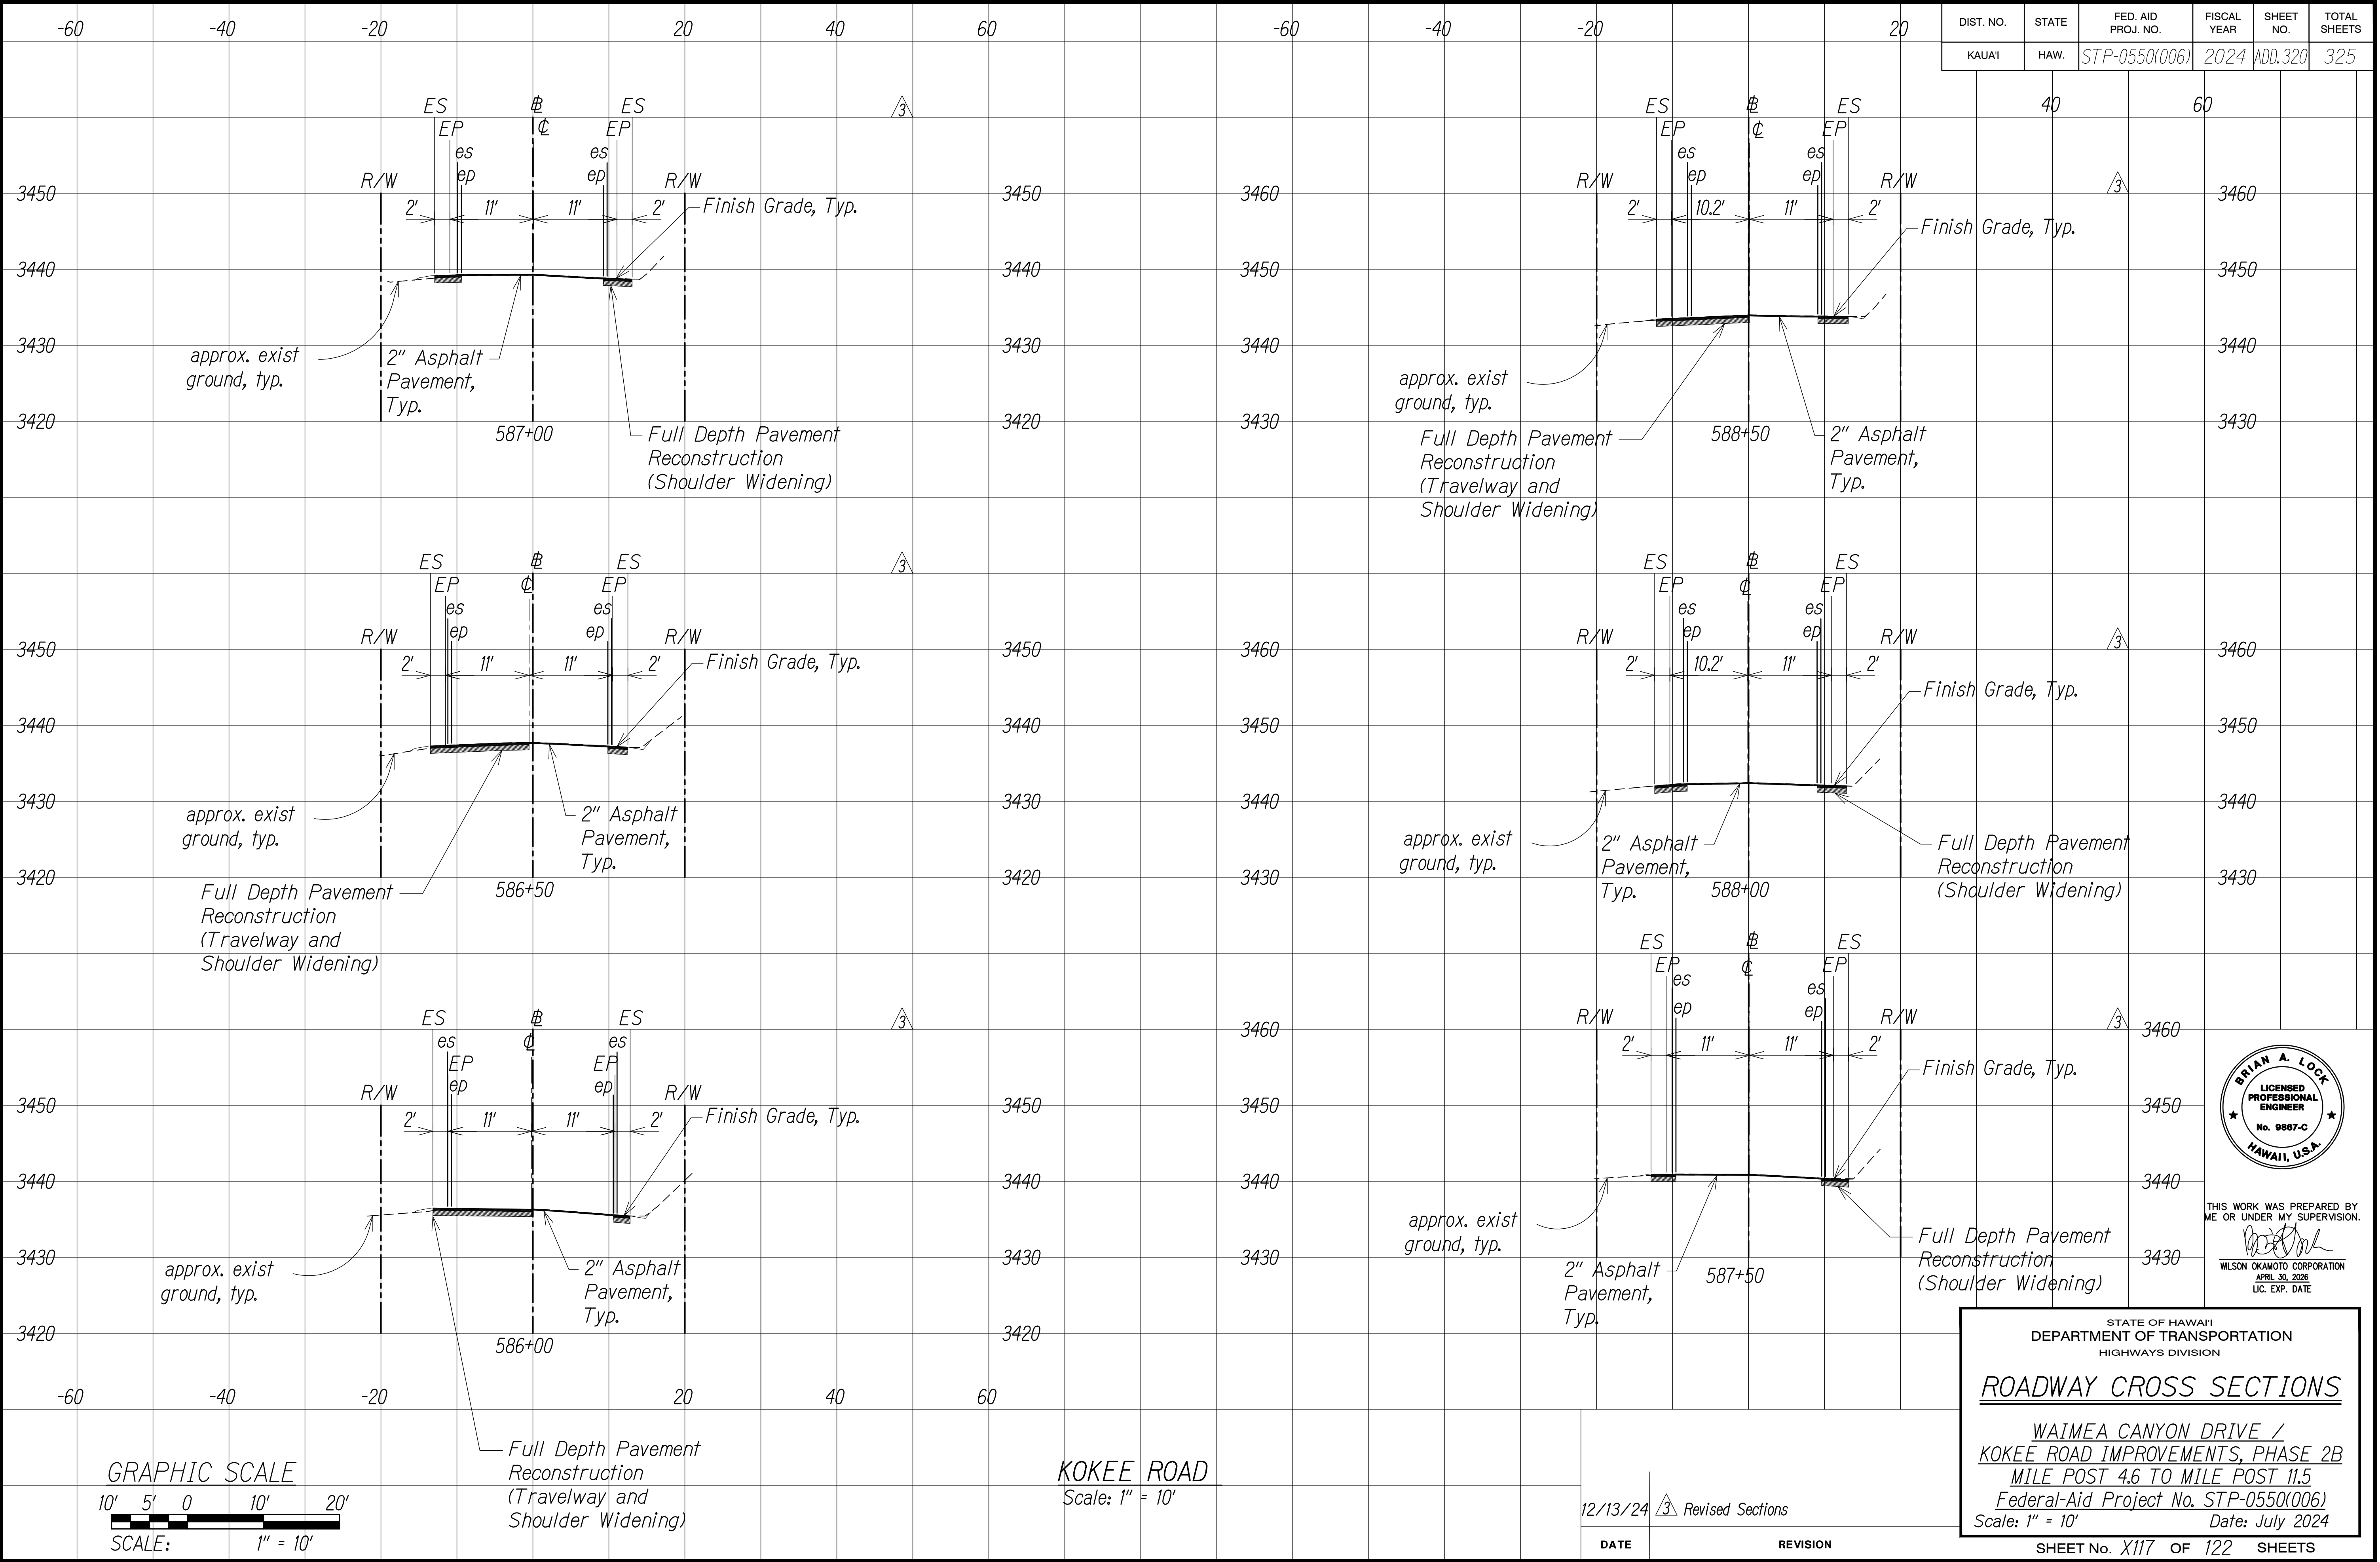

DIST. NO.	STATE	FED. AID PROJ. NO.	FISCAL YEAR	SHEET NO.	TOTAL SHEETS
KAUAI	HAW.	STP-0550(006)	2024	ADD.320	325

SURVEY PLOTTED BY	DATE
DESIGNED BY	
TRACED BY	
QUANTITIES BY	
CHECKED BY	

ORIGINAL PLAN	No.
NOTE BOOK	

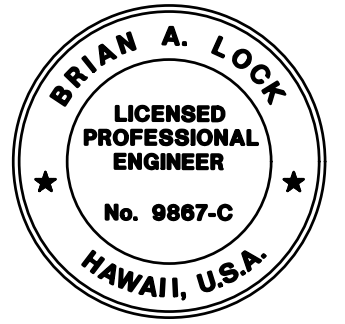

THIS WORK WAS PREPARED BY ME OR UNDER MY SUPERVISION.
[Signature]
WILSON OKAMOTO CORPORATION
APRIL 30, 2026
LIC. EXP. DATE


STATE OF HAWAII
DEPARTMENT OF TRANSPORTATION
HIGHWAYS DIVISION
ROADWAY CROSS SECTIONS
WAIMEA CANYON DRIVE /
KOEKE ROAD IMPROVEMENTS, PHASE 2B
MILE POST 4.6 TO MILE POST 11.5
Federal-Aid Project No. STP-0550(006)
Scale: 1" = 10' Date: July 2024

12/13/24 3 Revised Sections

DATE REVISION


SHEET No. X117 OF 122 SHEETS

ADD320

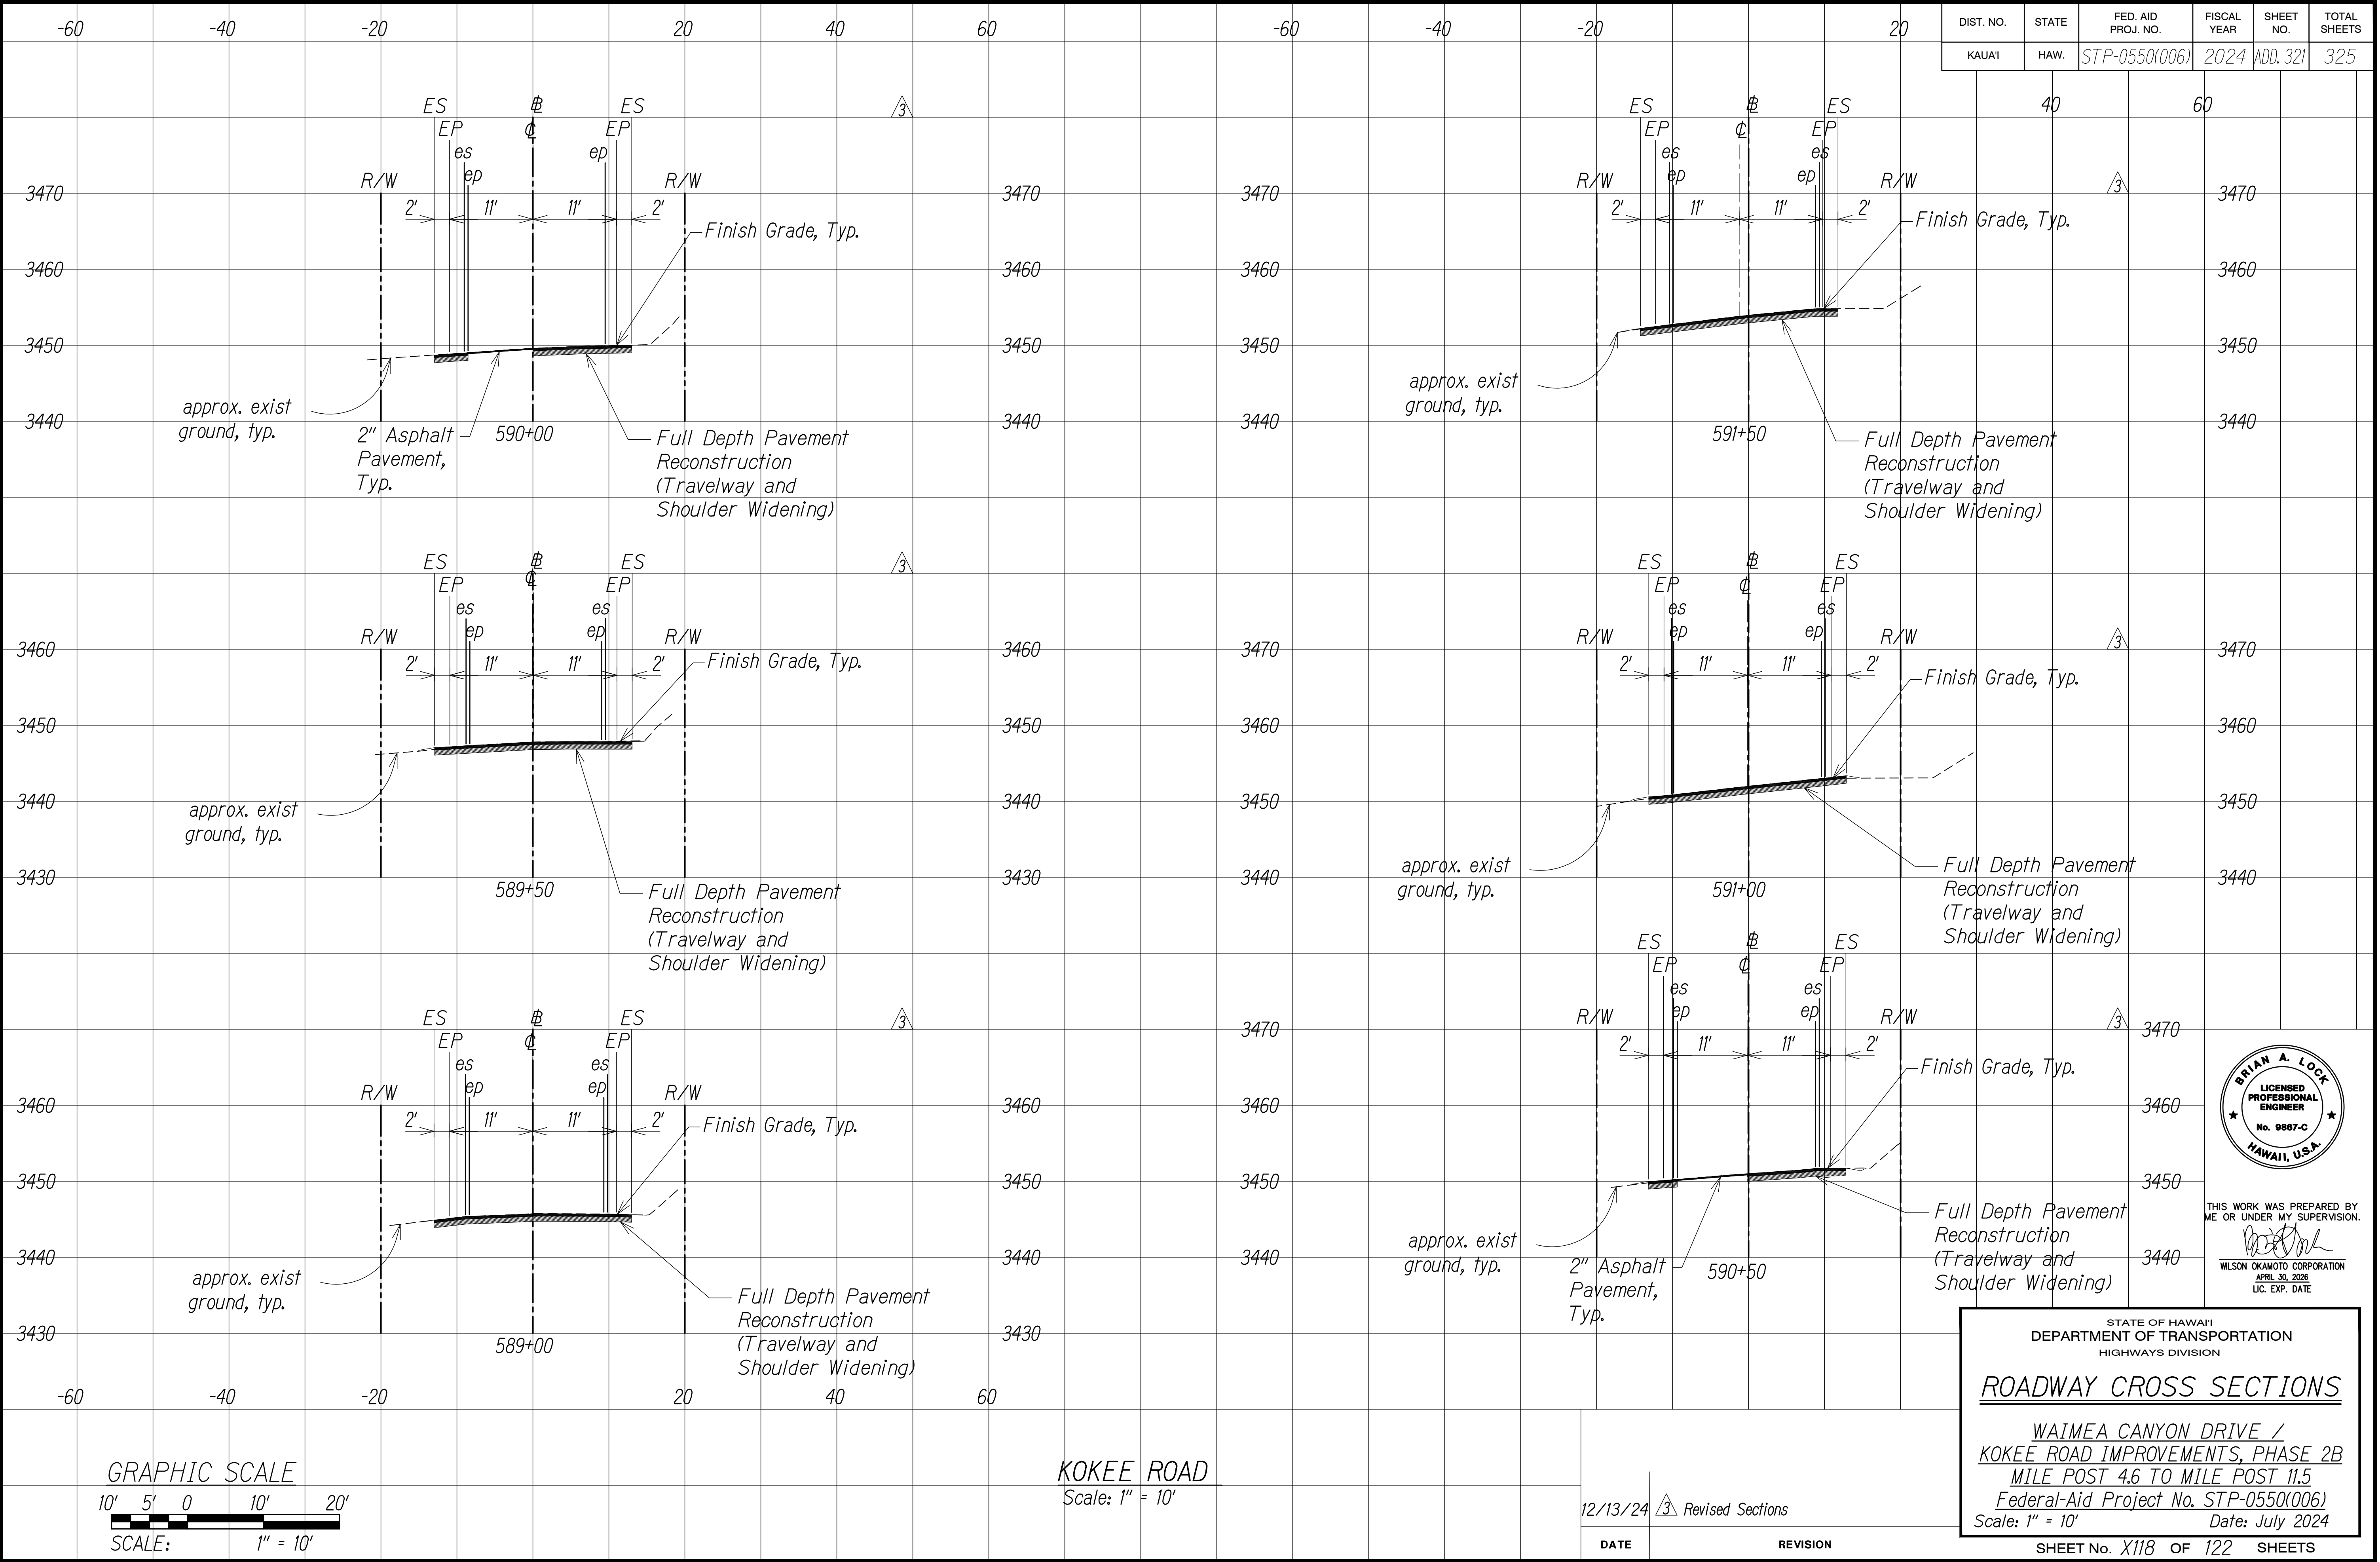

SURVEY PLOTTED BY	DATE
DESIGNED BY	
TRACED BY	
QUANTITIES BY	
CHECKED BY	

ORIGINAL PLAN	No.
NOTE BOOK	

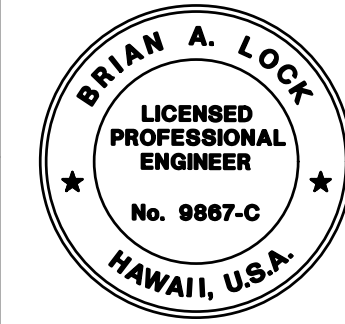


THIS WORK WAS PREPARED BY
ME OR UNDER MY SUPERVISION.
[Signature]
WILSON OKAMOTO CORPORATION
APRIL 30, 2024
LIC. EXP. DATE

STATE OF HAWAII
DEPARTMENT OF TRANSPORTATION
HIGHWAYS DIVISION
ROADWAY CROSS SECTIONS
WAIMEA CANYON DRIVE /
KOKEE ROAD IMPROVEMENTS, PHASE 2B
MILE POST 4.6 TO MILE POST 11.5
Federal-Aid Project No. STP-0550(006)
Scale: 1" = 10' Date: July 2024

12/13/24 3 Revised Sections

DATE REVISION


SHEET No. X118 OF 122 SHEETS

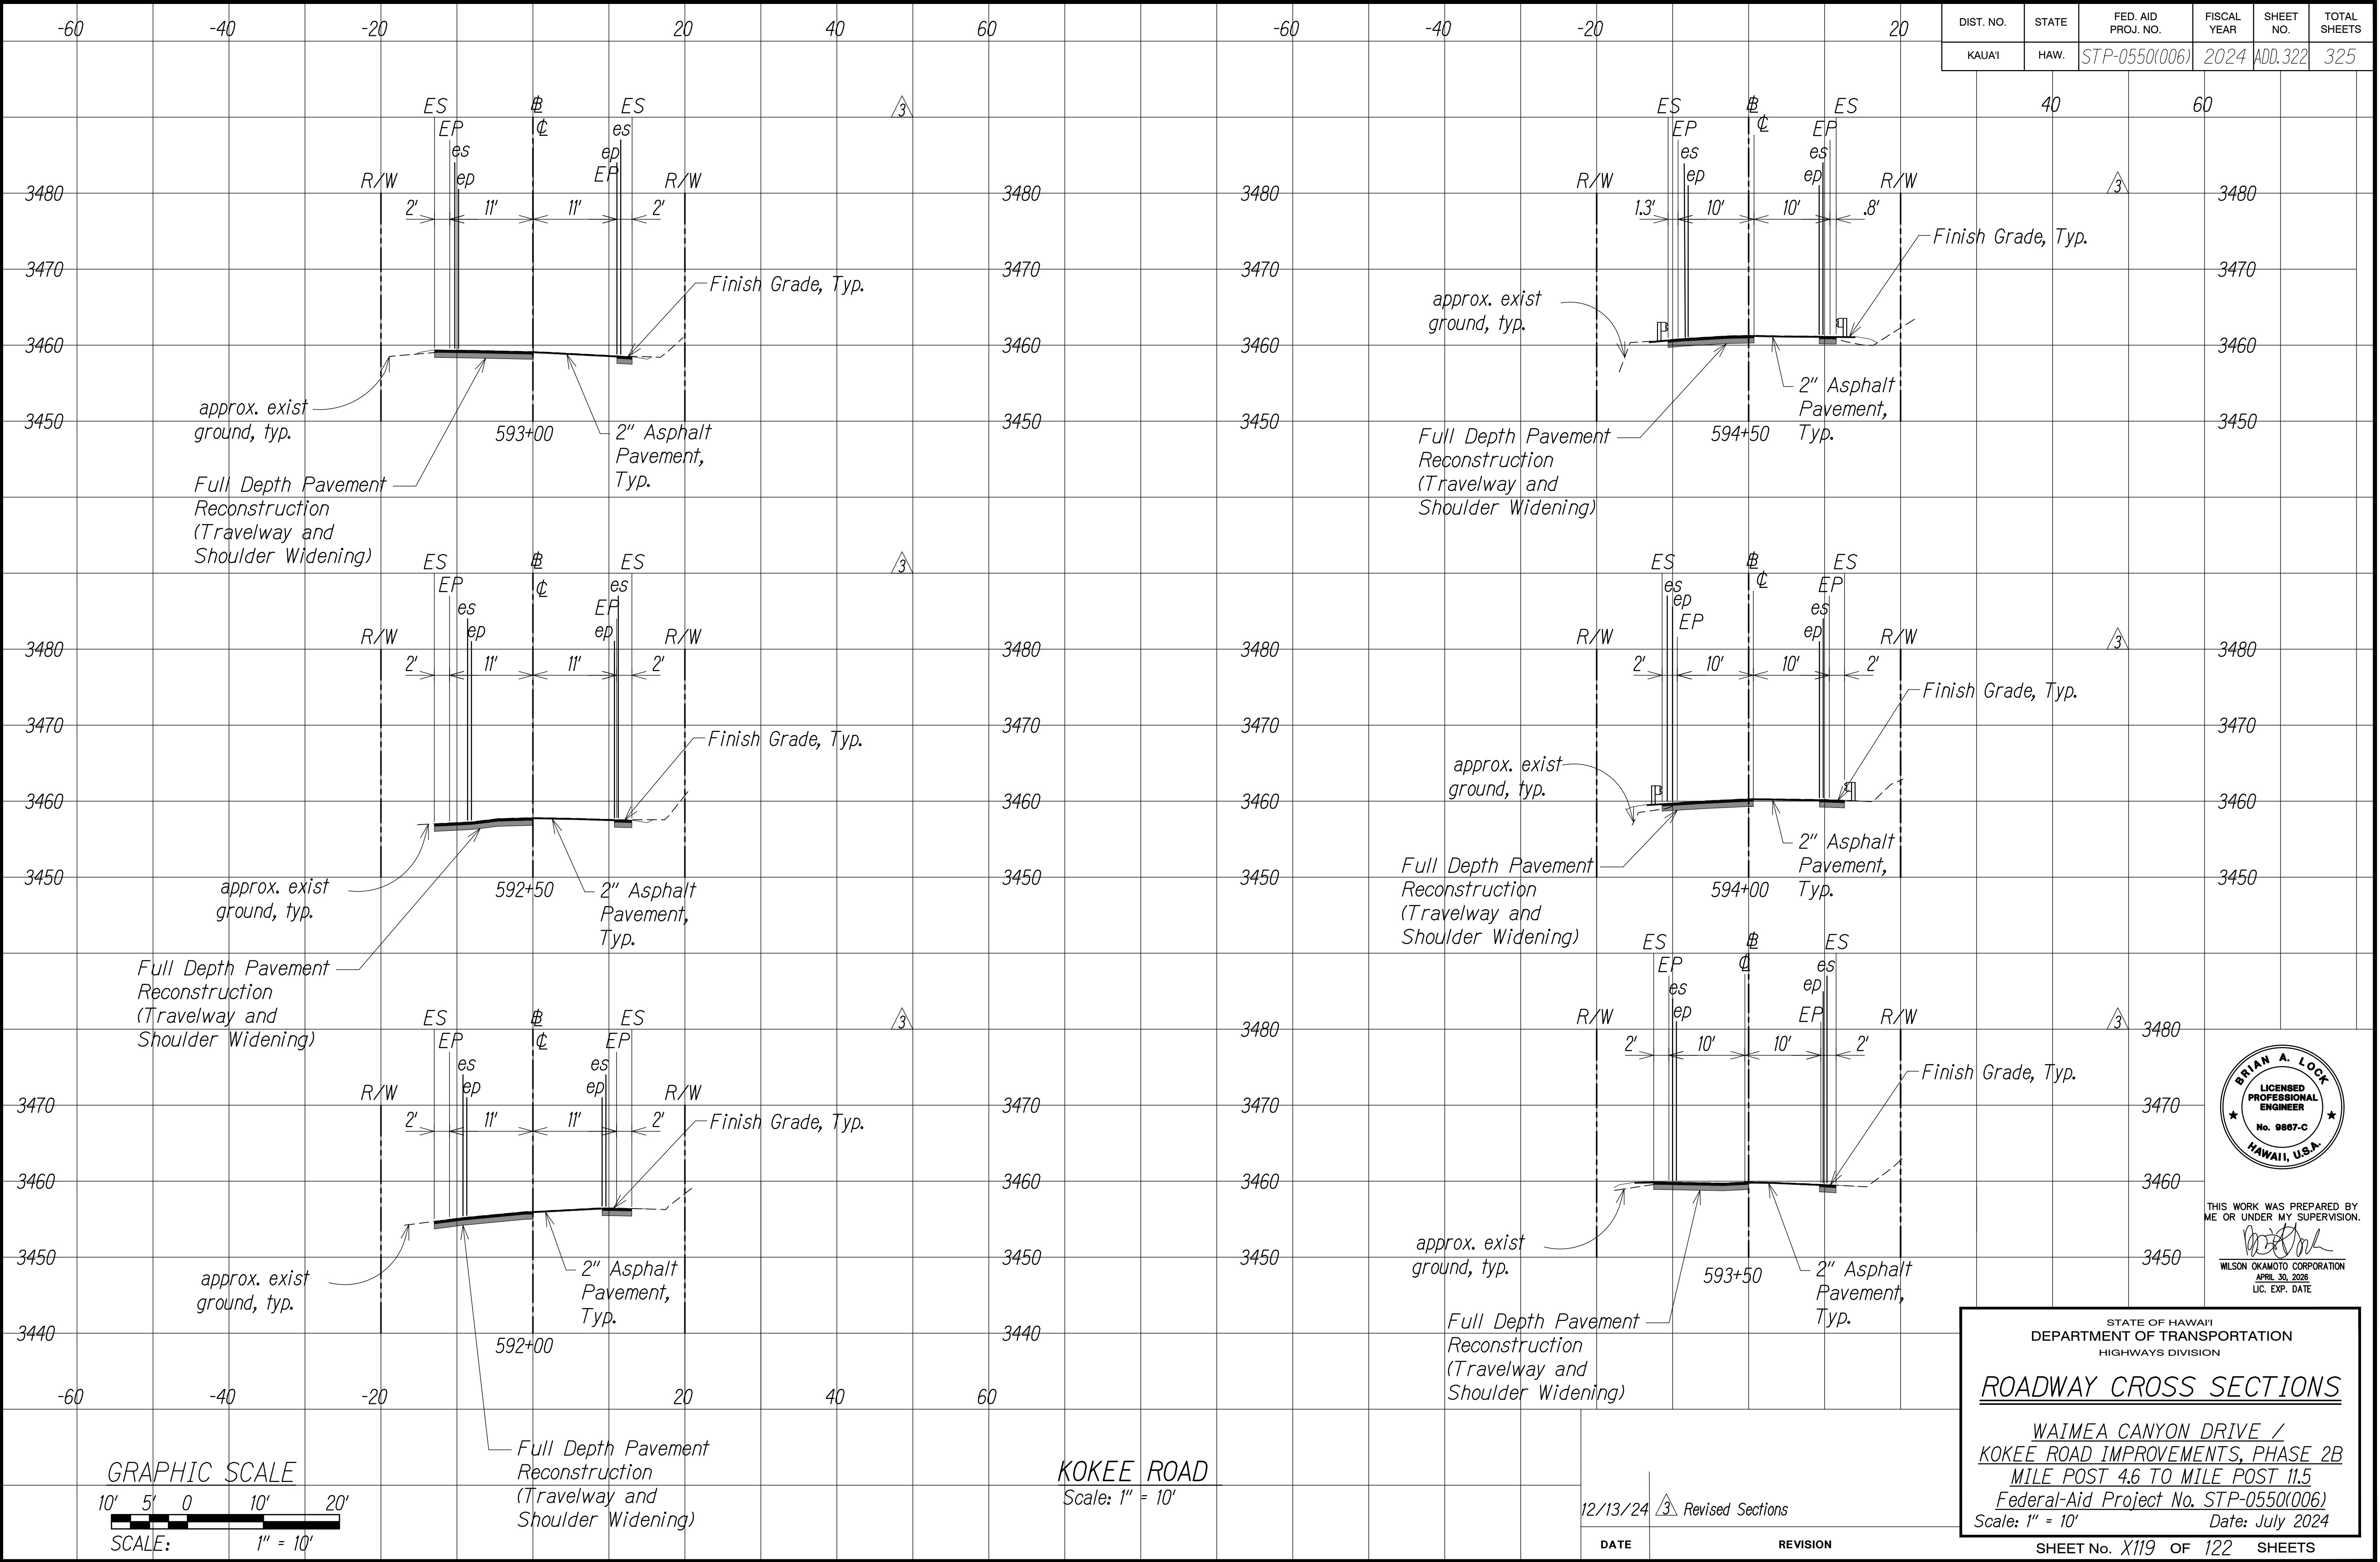

DIST. NO.	STATE	FED. AID PROJ. NO.	FISCAL YEAR	SHEET NO.	TOTAL SHEETS
KAUAI	HAW.	STP-0550(006)	2024	ADD.322	325


SURVEY PLOTTED BY	DATE
DESIGNED BY	
TRACED BY	
QUANTITIES BY	
CHECKED BY	

ORIGINAL PLAN	No.
NOTE BOOK	

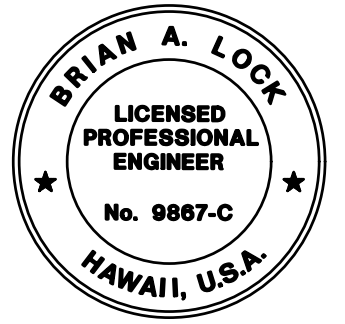


THIS WORK WAS PREPARED BY ME OR UNDER MY SUPERVISION.
WILSON OKAMOTO CORPORATION
APRIL 30, 2026
LIC. EXP. DATE

STATE OF HAWAII
DEPARTMENT OF TRANSPORTATION
HIGHWAYS DIVISION
ROADWAY CROSS SECTIONS
WAIMEA CANYON DRIVE /
KOKEE ROAD IMPROVEMENTS, PHASE 2B
MILE POST 4.6 TO MILE POST 11.5
Federal-Aid Project No. STP-0550(006)
Scale: 1" = 10' Date: July 2024

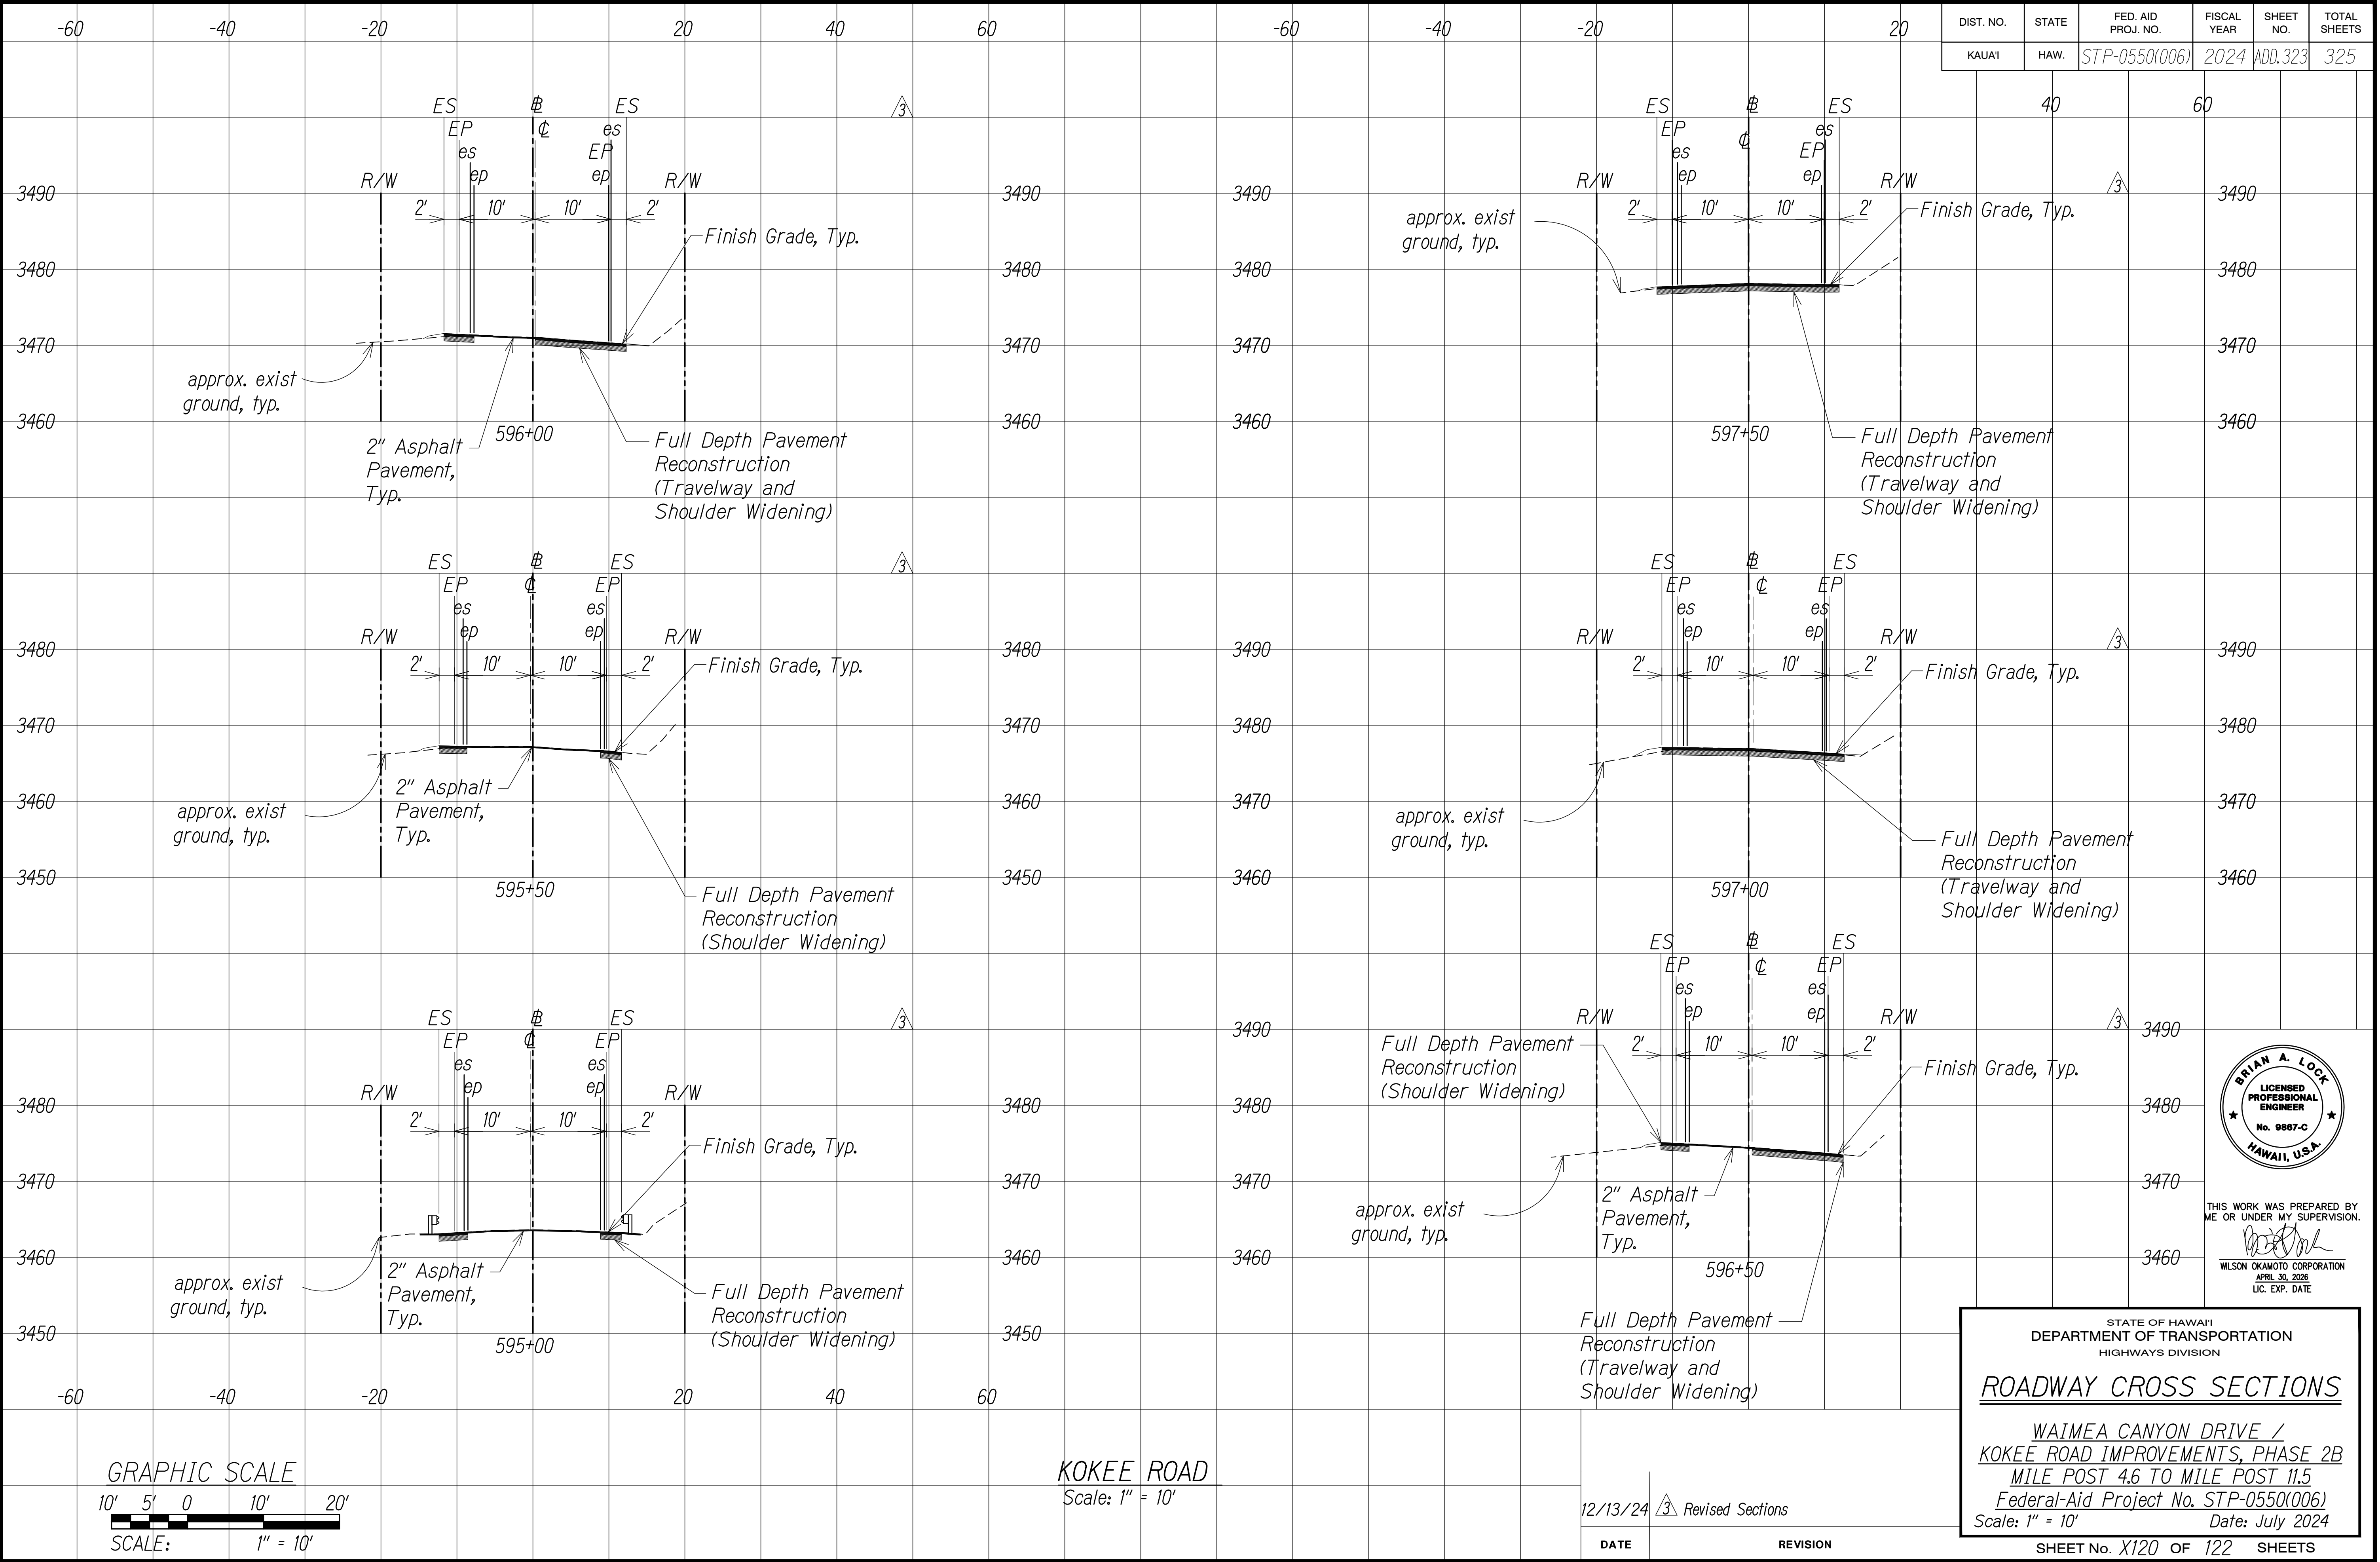

SURVEY PLOTTED BY	DATE
DESIGNED BY	
TRACED BY	
QUANTITIES BY	
CHECKED BY	

ORIGINAL PLAN	NOTE BOOK
No.	No.

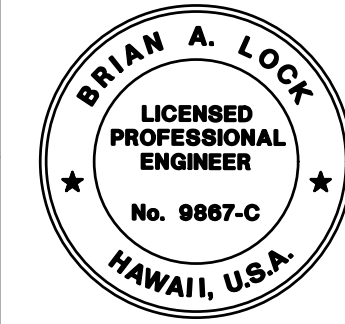

THIS WORK WAS PREPARED BY
ME OR UNDER MY SUPERVISION.
[Signature]
WILSON OKAMOTO CORPORATION
APRIL 30, 2026
LIC. EXP. DATE


STATE OF HAWAII
DEPARTMENT OF TRANSPORTATION
HIGHWAYS DIVISION
ROADWAY CROSS SECTIONS
WAIMEA CANYON DRIVE /
KOKEE ROAD IMPROVEMENTS, PHASE 2B
MILE POST 4.6 TO MILE POST 11.5
Federal-Aid Project No. STP-0550(006)
Scale: 1" = 10" Date: July 2024

12/13/24 3 Revised Sections

DATE REVISION

SHEET No. X120 OF 122 SHEETS


ADD323

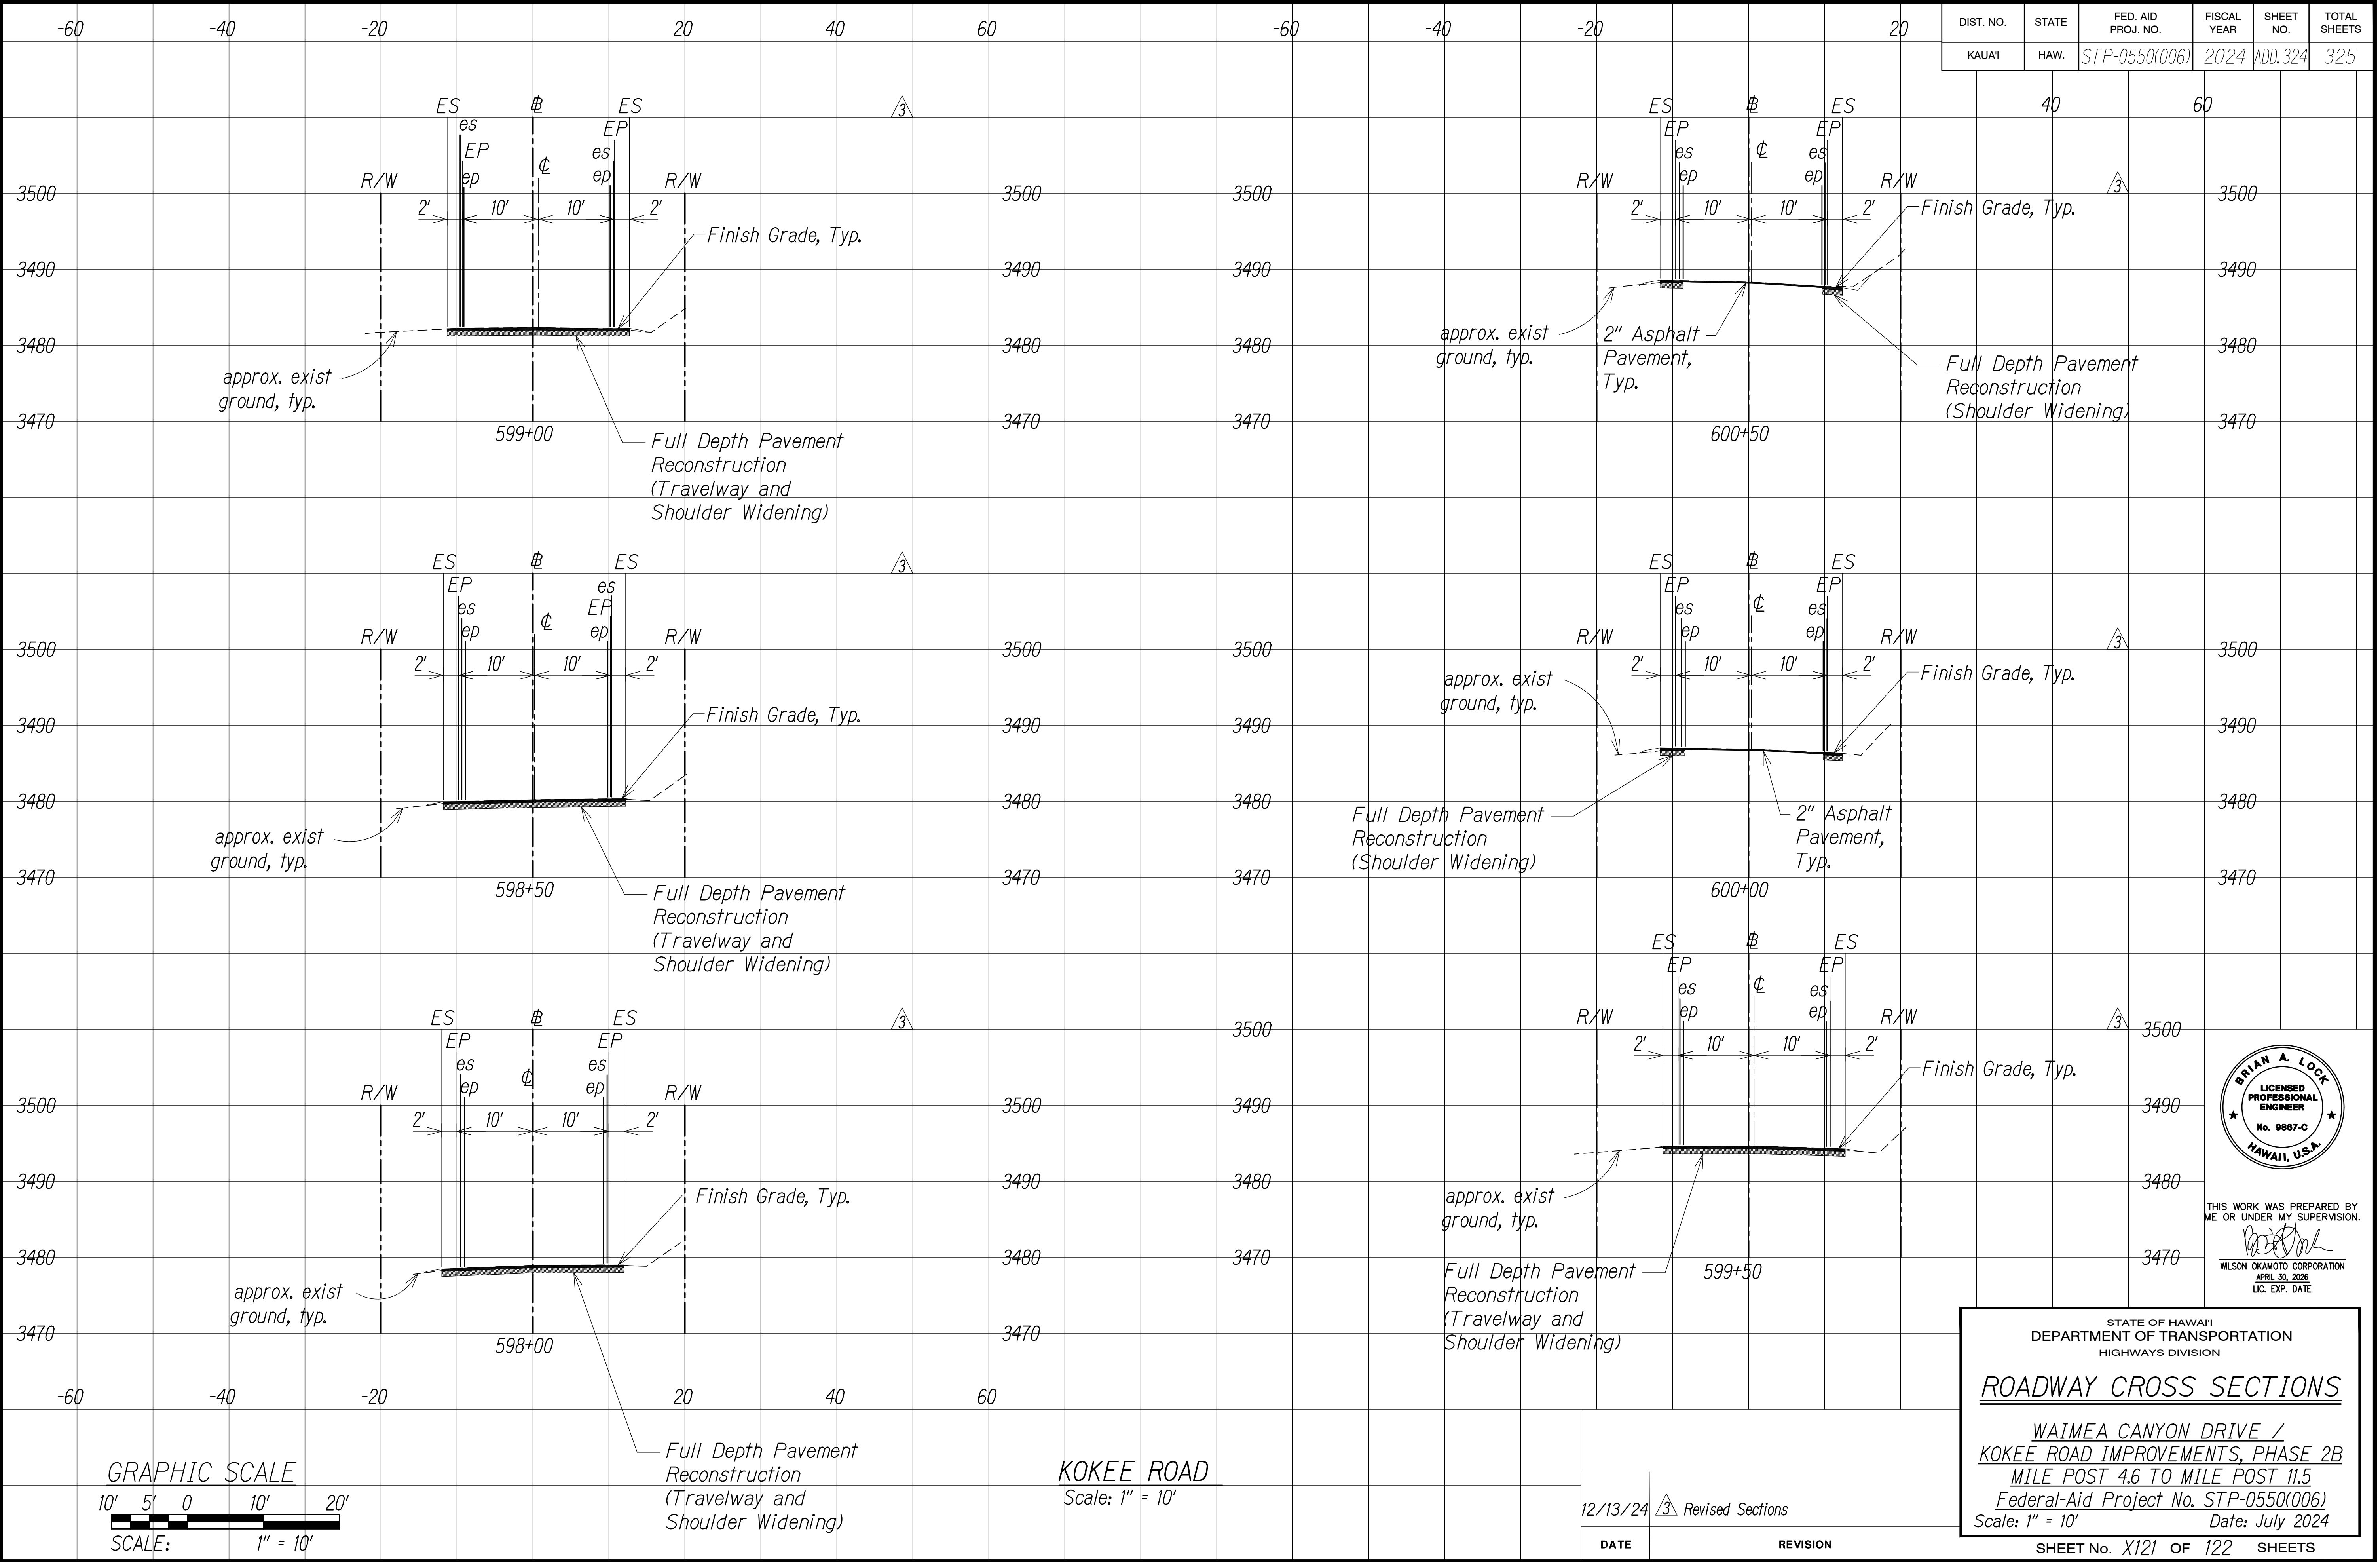

DIST. NO.	STATE	FED. AID PROJ. NO.	FISCAL YEAR	SHEET NO.	TOTAL SHEETS
KAUA'I	HAW.	STP-0550(006)	2024	ADD.324	325

SURVEY PLOTTED BY	DATE
DESIGNED BY	
TRACED BY	
QUANTITIES BY	
CHECKED BY	

ORIGINAL PLAN	No.
NOTE BOOK	

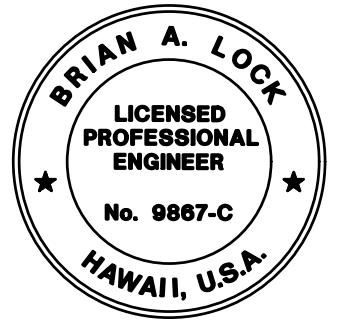

THIS WORK WAS PREPARED BY ME OR UNDER MY SUPERVISION.
[Signature]
WILSON OKAMOTO CORPORATION
APRIL 30, 2026
LIC. EXP. DATE

STATE OF HAWAII
DEPARTMENT OF TRANSPORTATION
HIGHWAYS DIVISION

ROADWAY CROSS SECTIONS



WAIMEA CANYON DRIVE /
Kokee Road Improvements, Phase 2B
MILE POST 4.6 TO MILE POST 11.5
Federal-Aid Project No. STP-0550(006)
Scale: 1" = 10' Date: July 2024

12/13/24 3 Revised Sections


DATE	REVISION
------	----------

SHEET No. X121 OF 122 SHEETS

DIST. NO.	STATE	FED. AID PROJ. NO.	FISCAL YEAR	SHEET NO.	TOTAL SHEETS
KAUA'I	HAW.	STP-0550(006)	2024	ADD.325	325

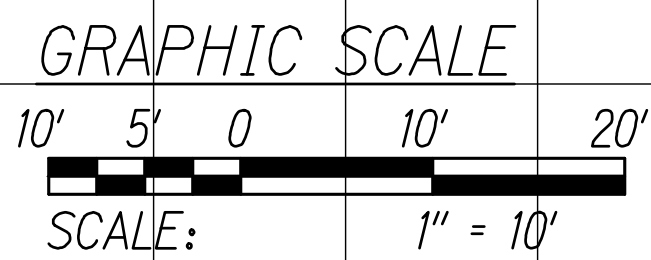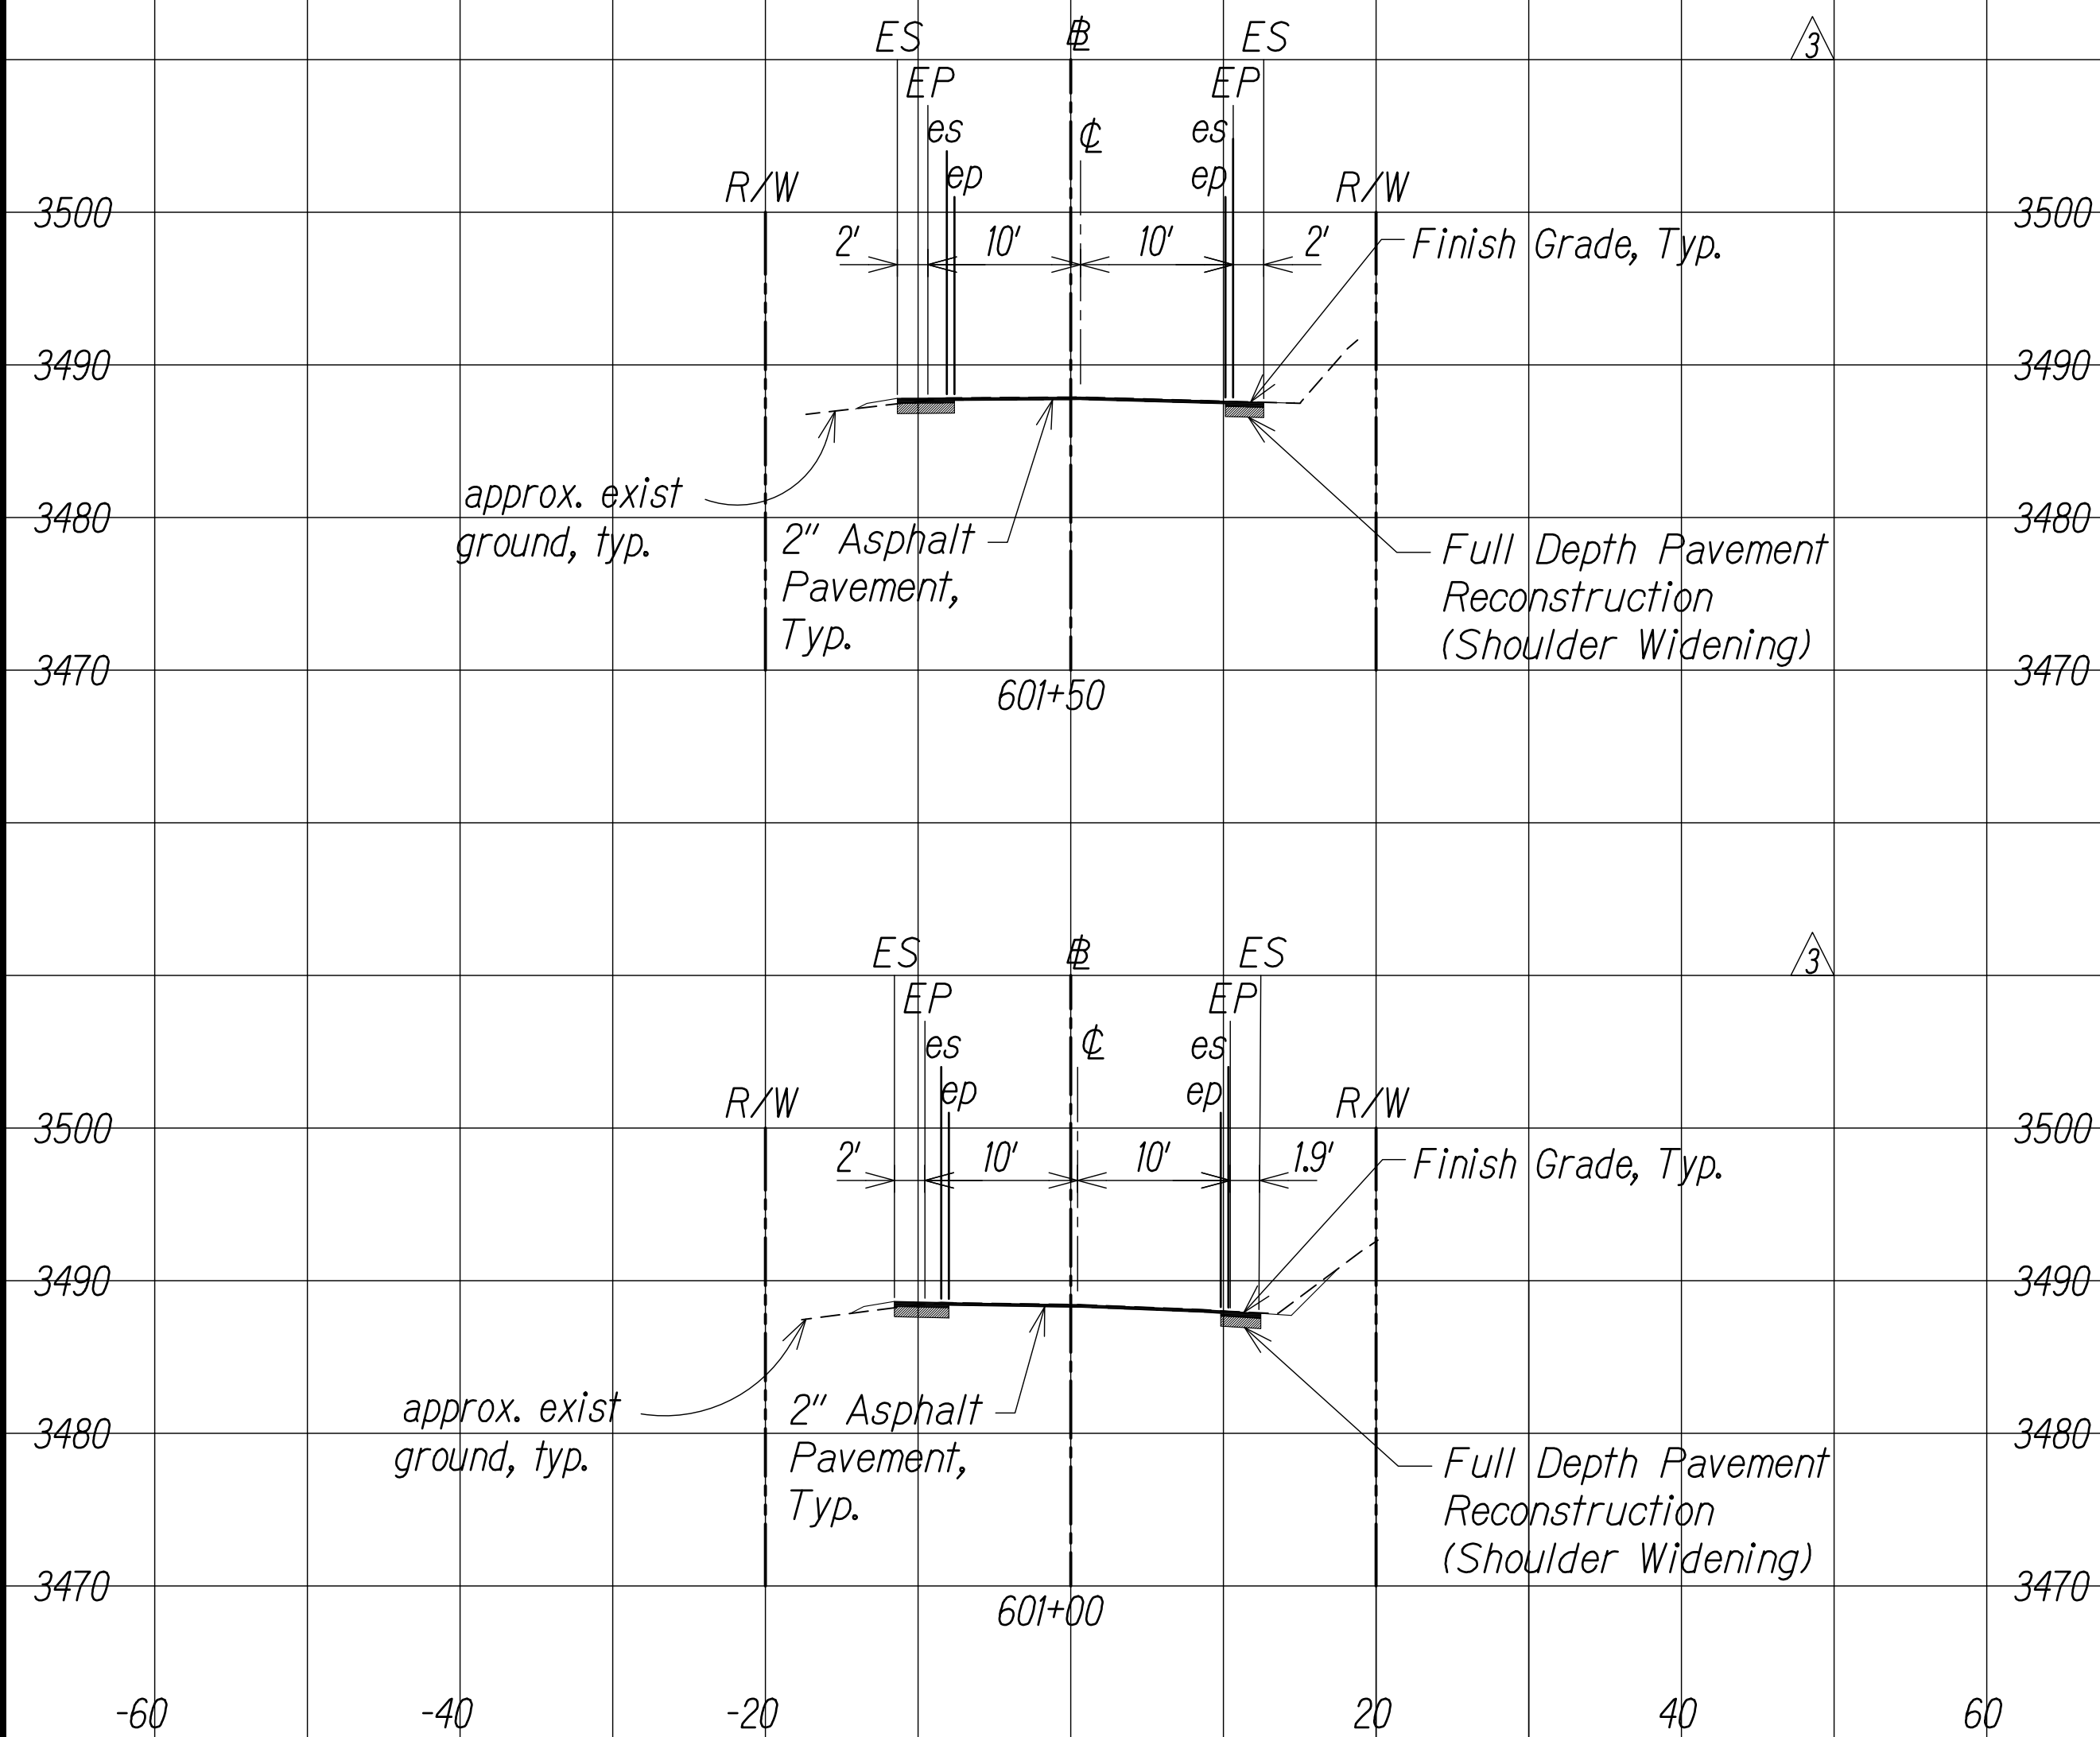

KOKEE ROAD
Scale: 1" = 10'

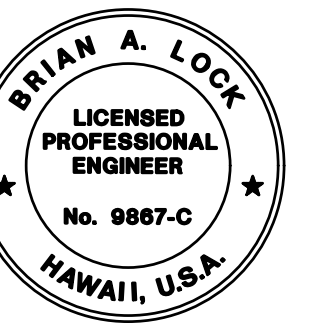

THIS WORK WAS PREPARED BY
ME OR UNDER MY SUPERVISION.
[Signature]
WILSON OKAMOTO CORPORATION
APRIL 30, 2026
LIC. EXP. DATE

STATE OF HAWAII
DEPARTMENT OF TRANSPORTATION
HIGHWAYS DIVISION
ROADWAY CROSS SECTIONS
WAIMEA CANYON DRIVE /
KOKEE ROAD IMPROVEMENTS, PHASE 2B
MILE POST 4.6 TO MILE POST 11.5
Federal-Aid Project No. STP-0550(006)
Scale: 1" = 10' Date: July 2024

SURVEY PLOTTED BY	DATE
DESIGNED BY	
TRACED BY	
QUANTITIES BY	
CHECKED BY	

ORIGINAL PLAN	No.
NOTE BOOK	

12/13/24 *[Signature]* Revised Sections

DATE

REVISION

SHEET No. X122 OF 122 SHEETS

ADD325