



| FED. ROAD DIST. NO. | STATE | FEDERAL AID PROJ. NO. | FISCAL YEAR | SHEET NO. | TOTAL SHEETS |
|---------------------|-------|-----------------------|-------------|-----------|--------------|
| HAWAII | HAW. | ER-19(001) | 2018 | 23 | 30 |

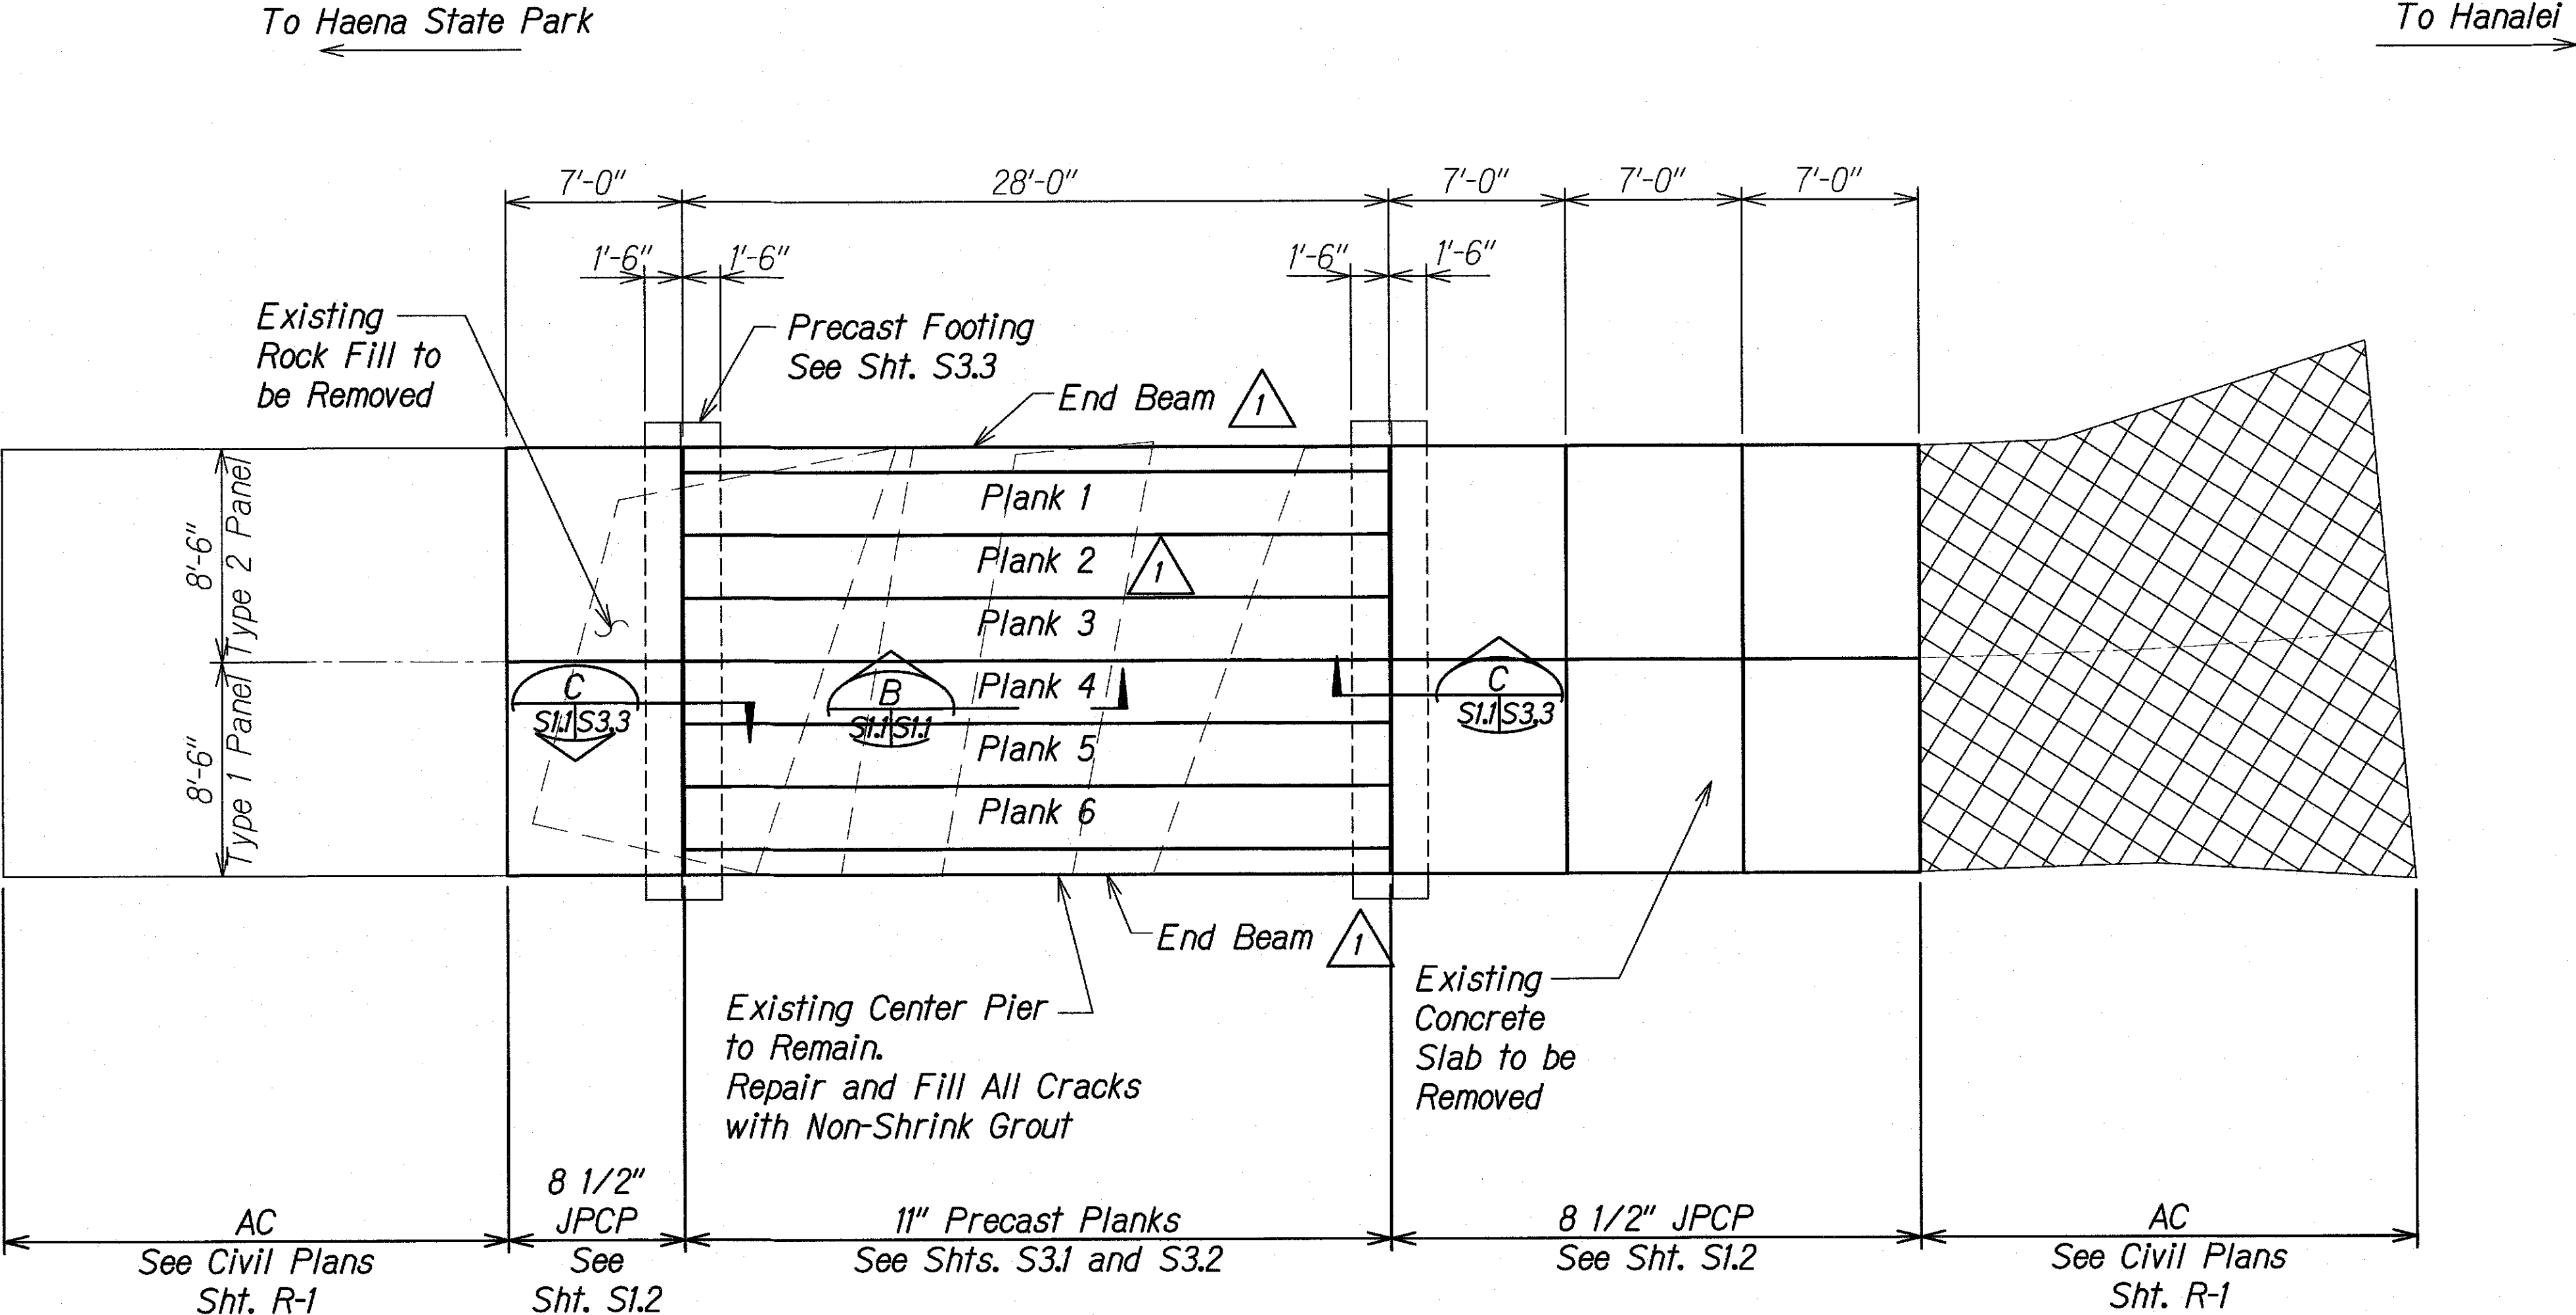

JPCP LAYOUT PLAN A
 Scale: 1" = 5'-0"

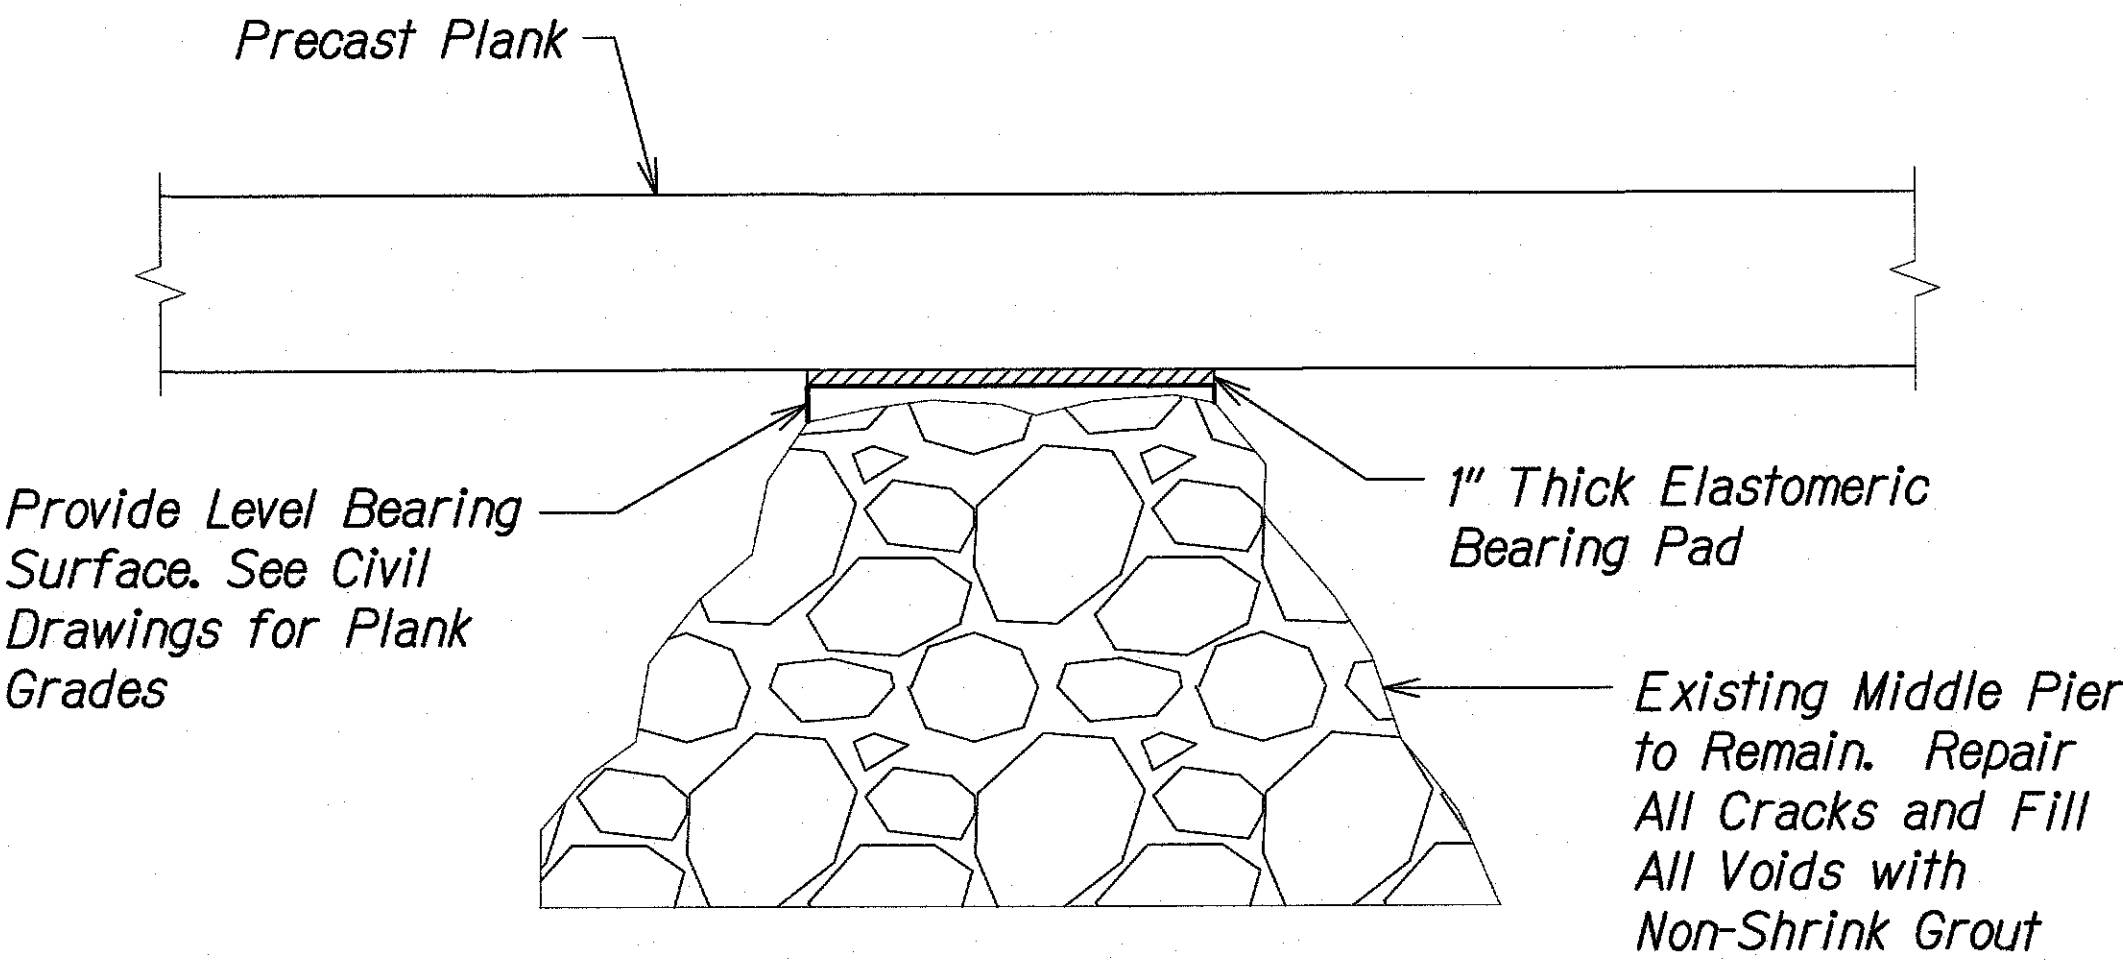

SECTION AT CENTER PIER B
 Scale: 1/2" = 1'-0"

| | |
|-------------------|------|
| SURVEY PLOTTED BY | DATE |
| DRAWN BY | |
| TRACED BY | |
| CHECKED BY | |
| REVIEWED BY | |
| APPROVED BY | |
| DATE | |

| | | |
|---------|---|-------------|
| 3/28/19 | 1 | Added Notes |
| DATE | | REVISION |

STATE OF HAWAII
DEPARTMENT OF TRANSPORTATION
HIGHWAYS DIVISION

JPCP LAYOUT PLAN

KAUAI EMERGENCY FLOOD REPAIRS & CLEANUP
 At Various Locations April 2018, Rte. 560
 Proj. No. ER-19(001)

Scale: As Noted Date: Mar. 2019

SHEET No. **SI/** OF **4** SHEETS