




FED. ROAD DIST. NO.	STATE	FEDERAL AID PROJ. NO.	FISCAL YEAR	SHEET NO.	TOTAL SHEETS
HAWAII	HAW.	ER-19(001)	2018	30	30

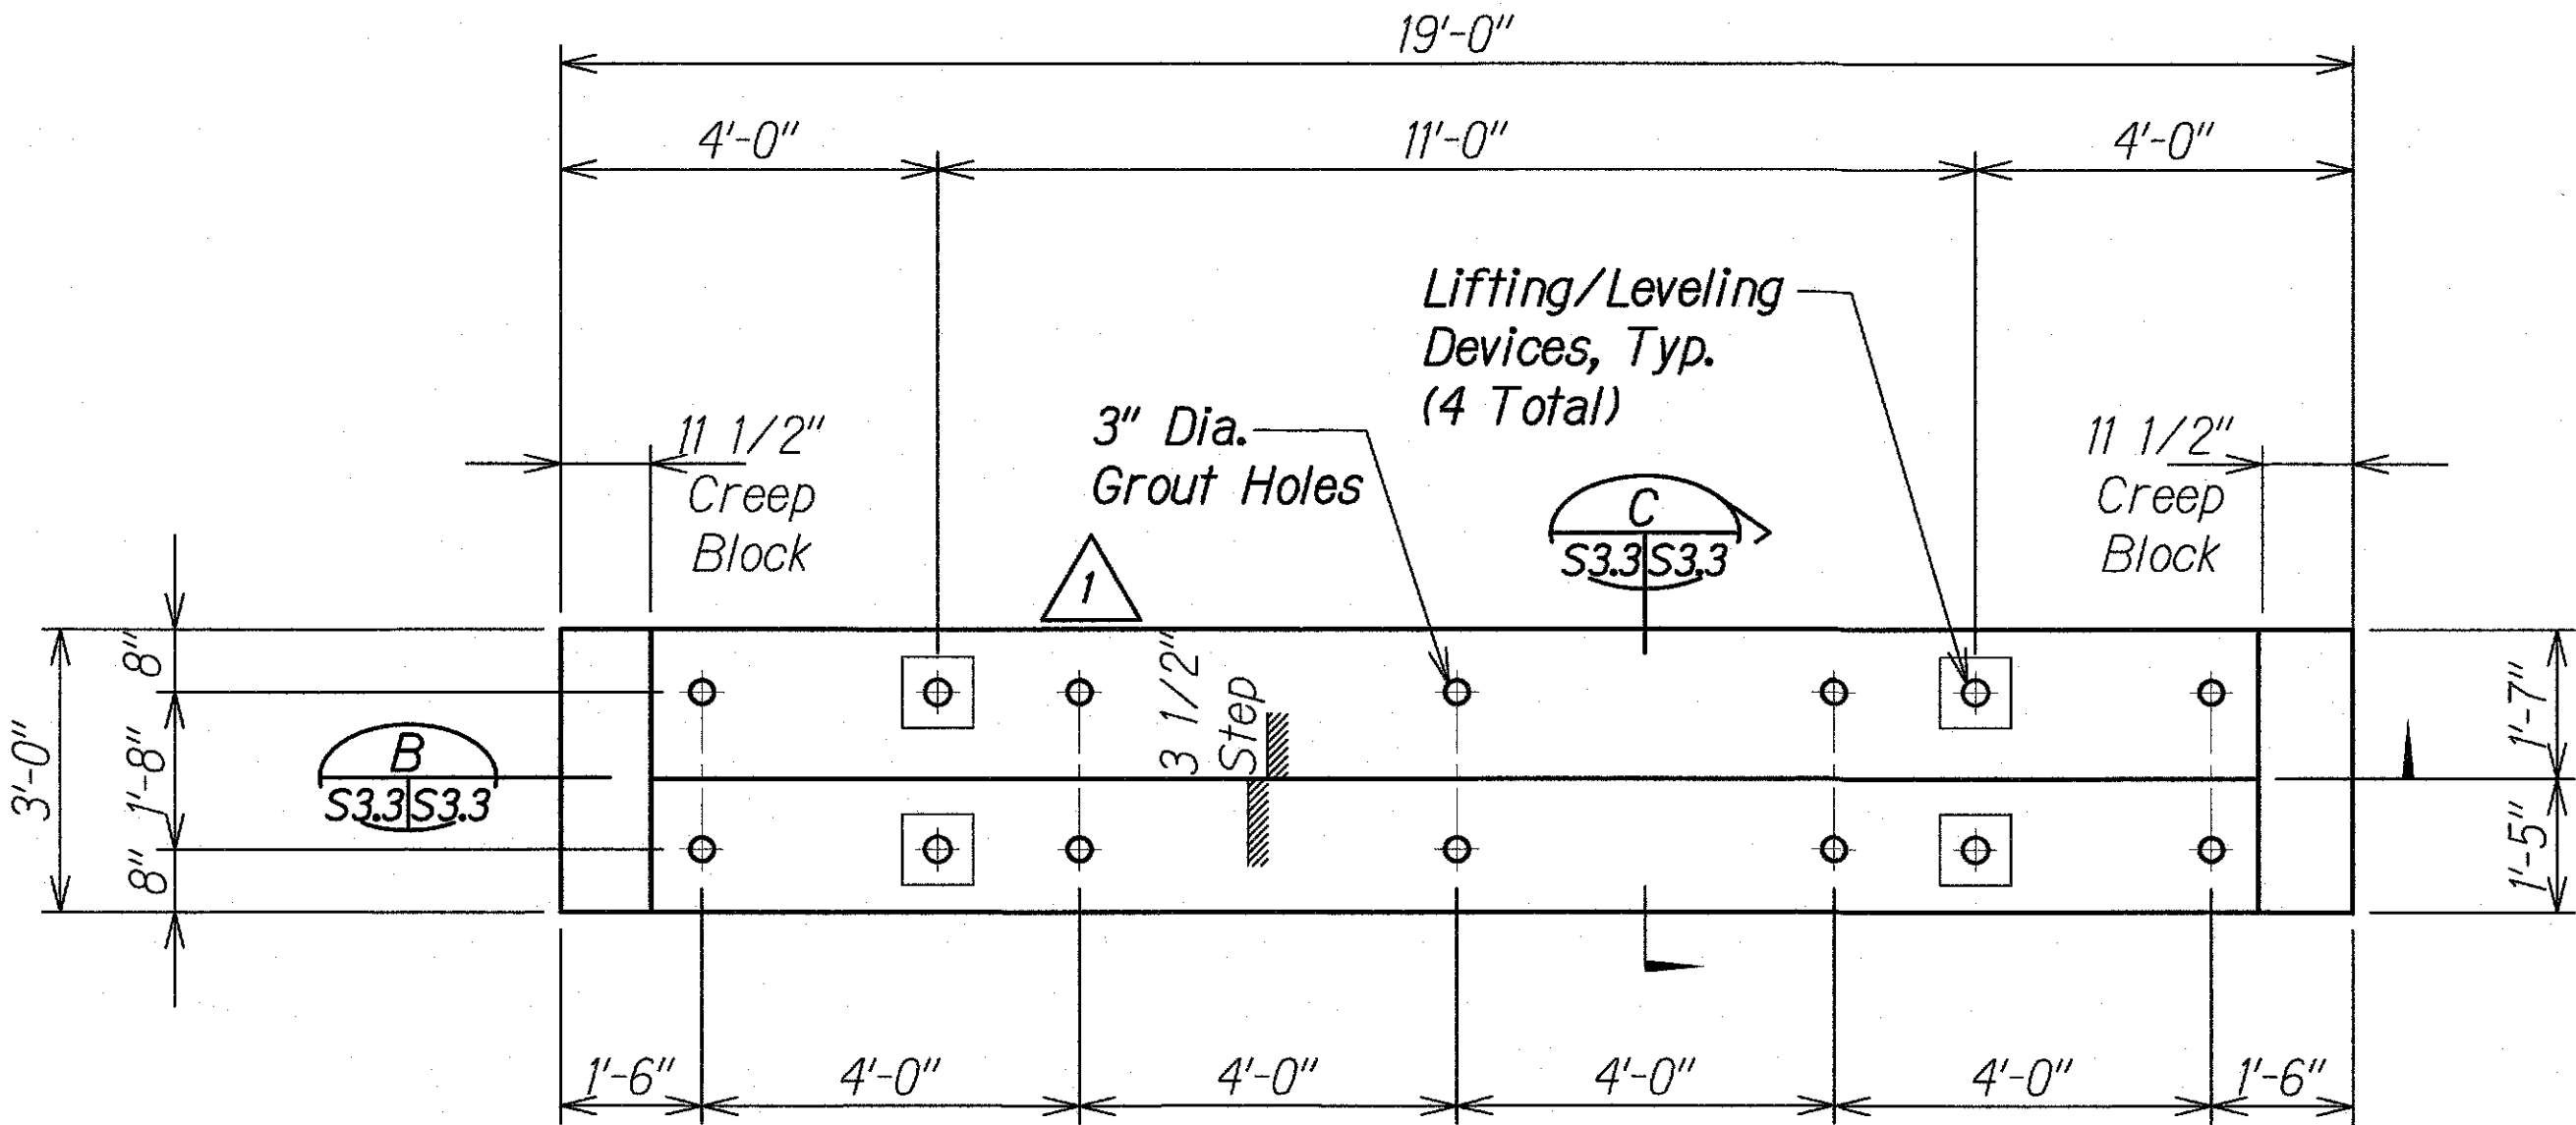

FOOTING PLAN A
Scale: 1/2" = 1'-0"

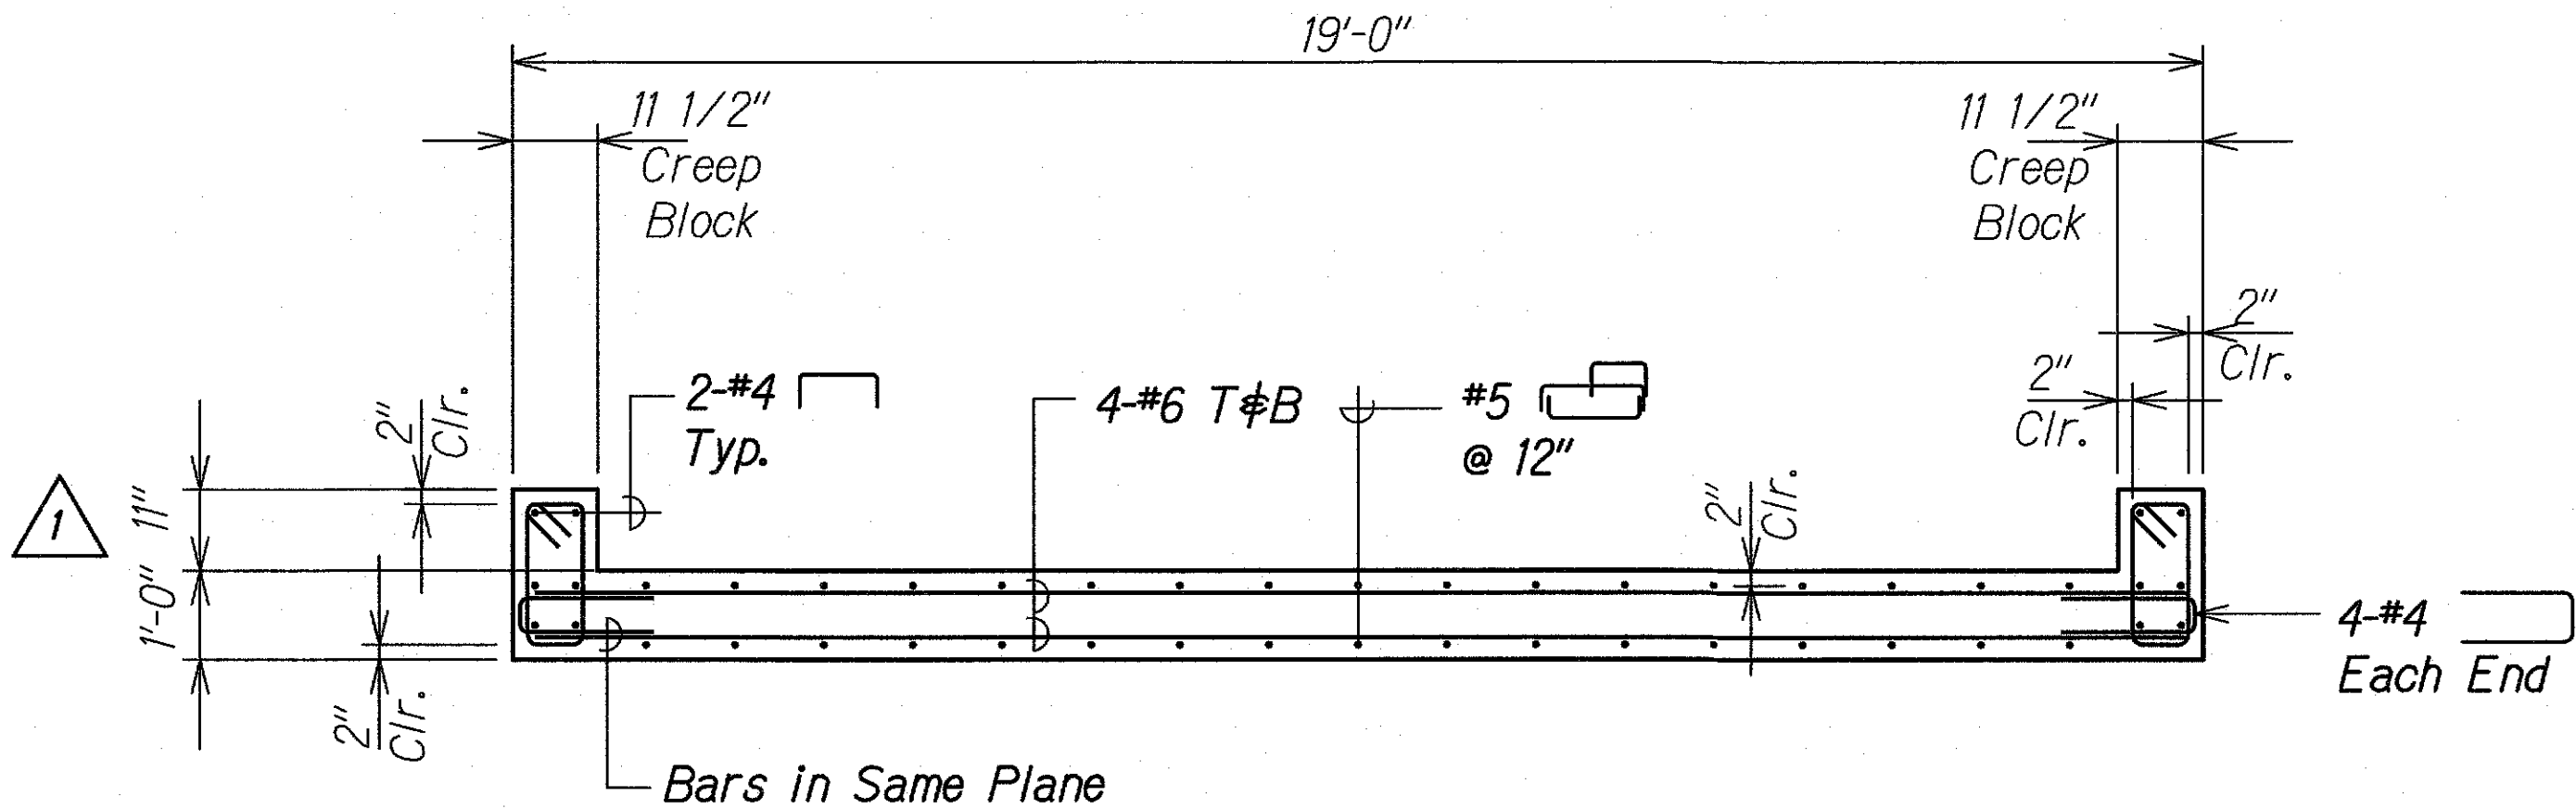

FOOTING SECTION B
Scale: 1/2" = 1'-0"

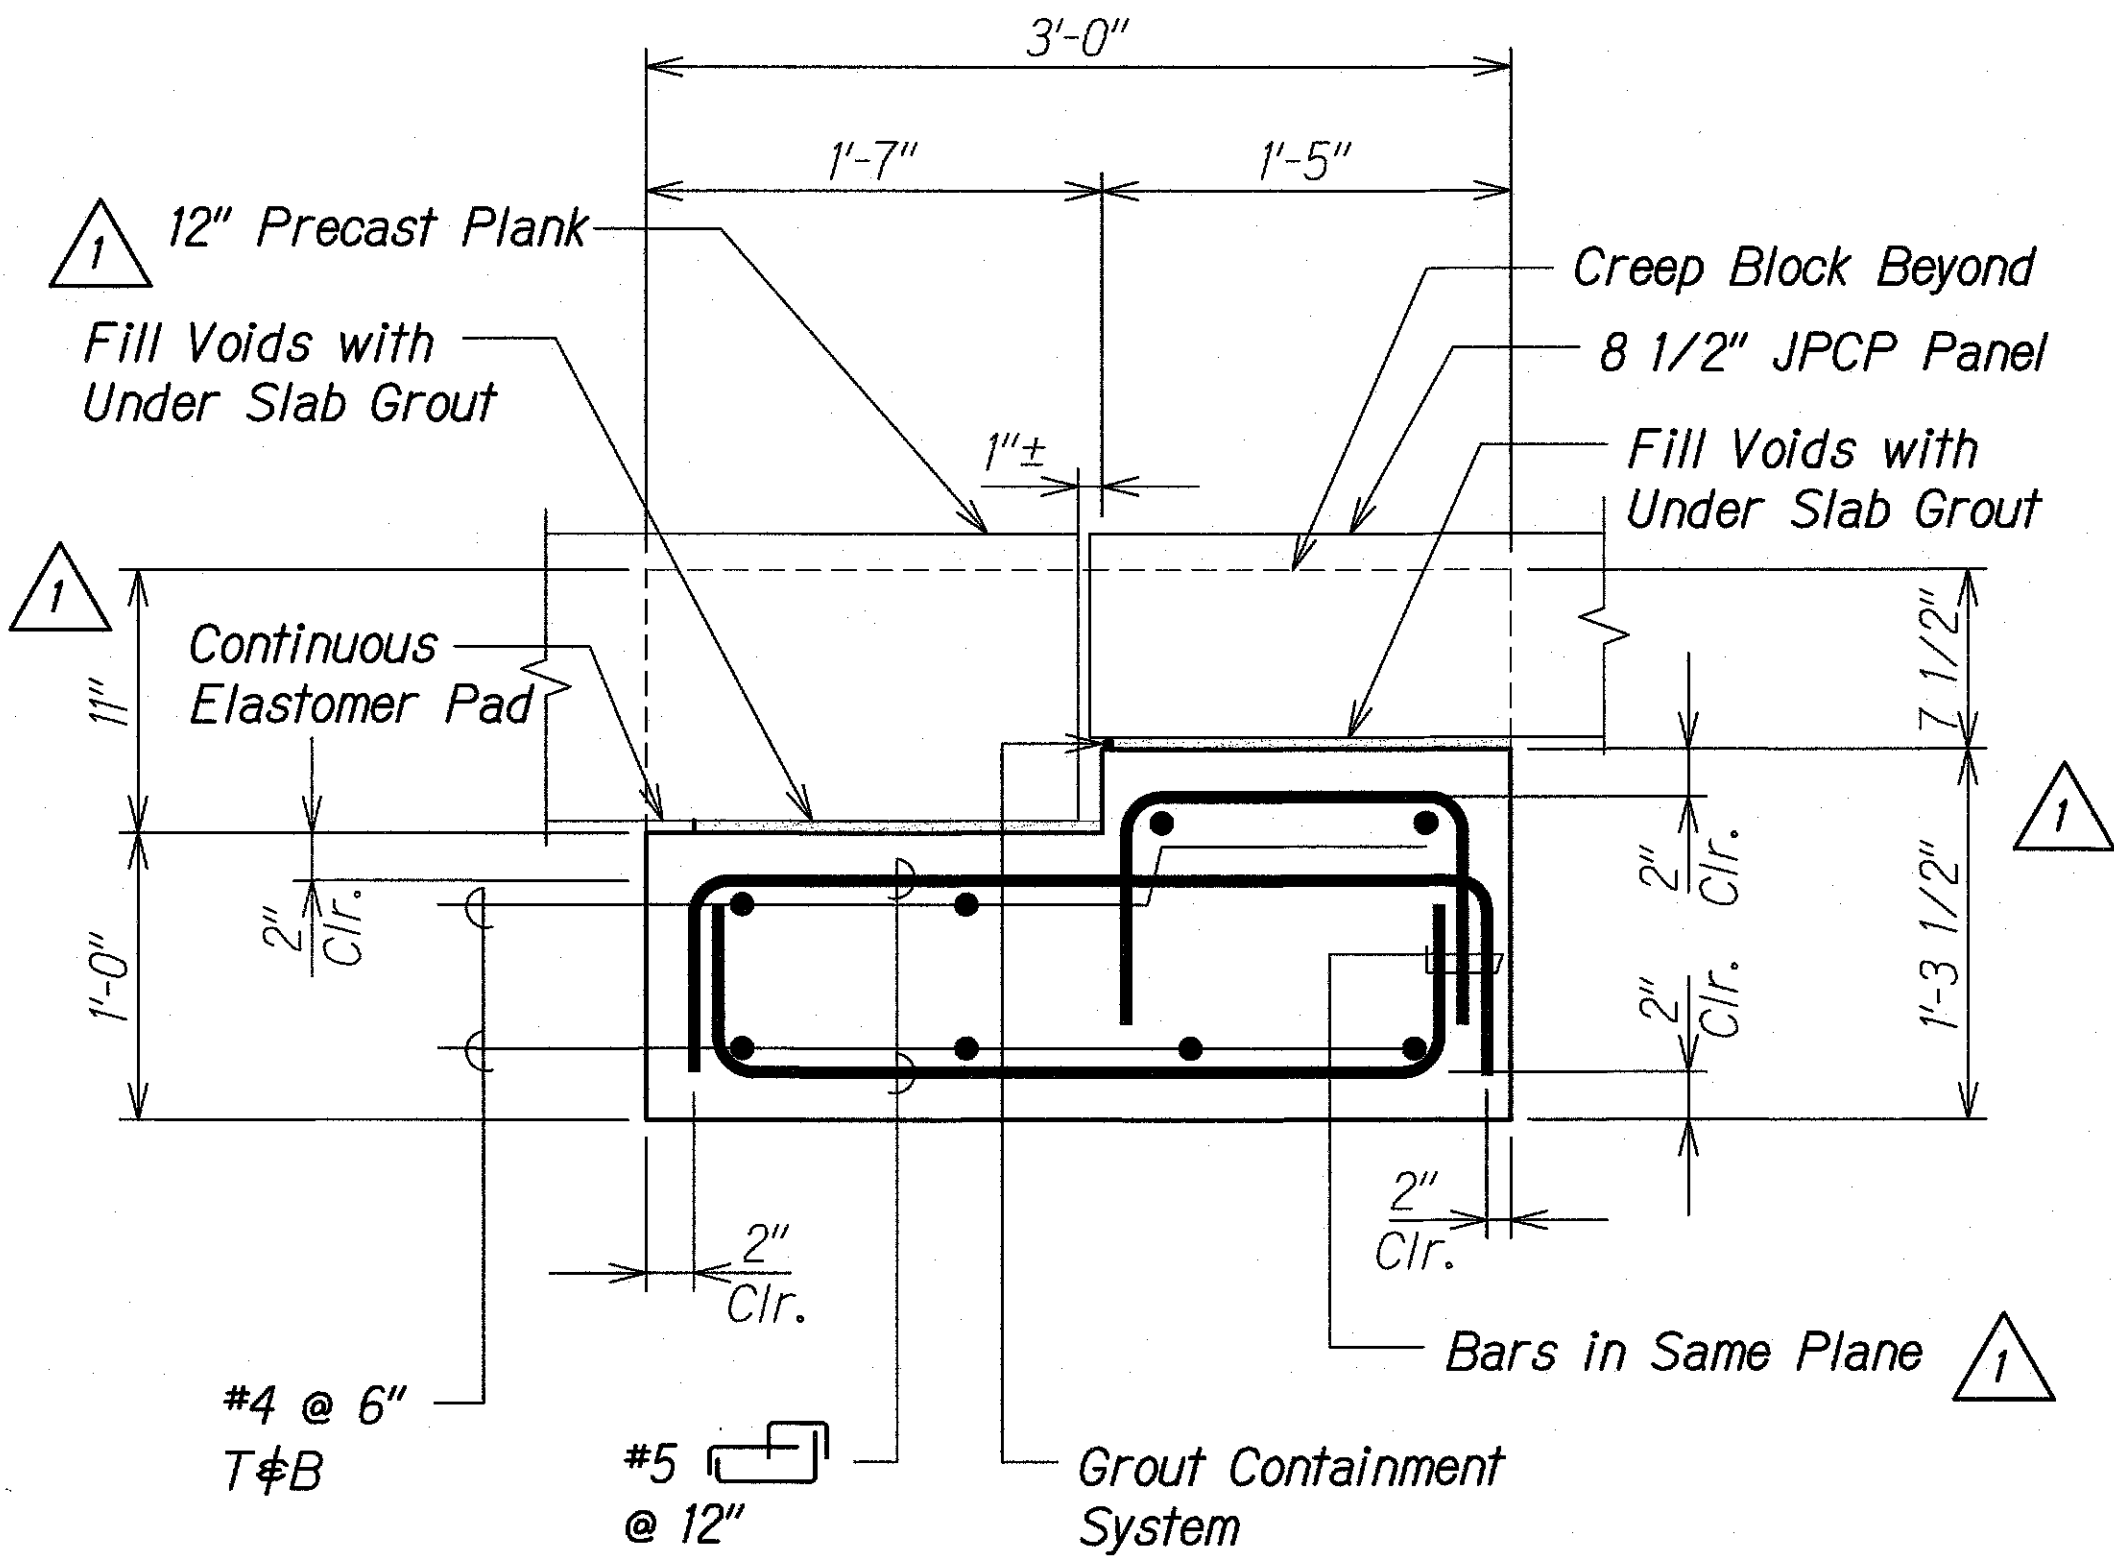

FOOTING SECTION C
Scale: 1 1/2" = 1'-0"

ORIGINAL PLAN	SURVEY PLOTTED BY	DATE
NOTE BOOK	DRAWN BY	
	DESIGNED BY	
	QUANTITIES BY	
	CHECKED BY	

DRAWING NAME: Z:\00 ONGOING\18-005.5-KUHIO HWY STREAM PDC\01 CAD\10-05-20 UNAHU\AS-BUILT\LSP-50303 FOOTING.DWG PLOT TIME: 10-06-20 4:33 PM

3/28/19	1	Revised Dimensions and Notes
DATE	REVISION	

STATE OF HAWAII
DEPARTMENT OF TRANSPORTATION
HIGHWAYS DIVISION

PRECAST FOOTING SECTIONS

KAUAI EMERGENCY FLOOD REPAIRS & CLEANUP
At Various Locations April 2018, Rte. 560
Proj. No. ER-19(001)

Scale: As Noted Date: Mar. 2019

SHEET No. S33 OF 3 SHEETS