



FED. ROAD DIST. NO.	STATE	FEDERAL AID PROJ. NO.	FISCAL YEAR	SHEET NO.	TOTAL SHEETS
HAWAII	HAW.	ER-19(001)	2018	28	30

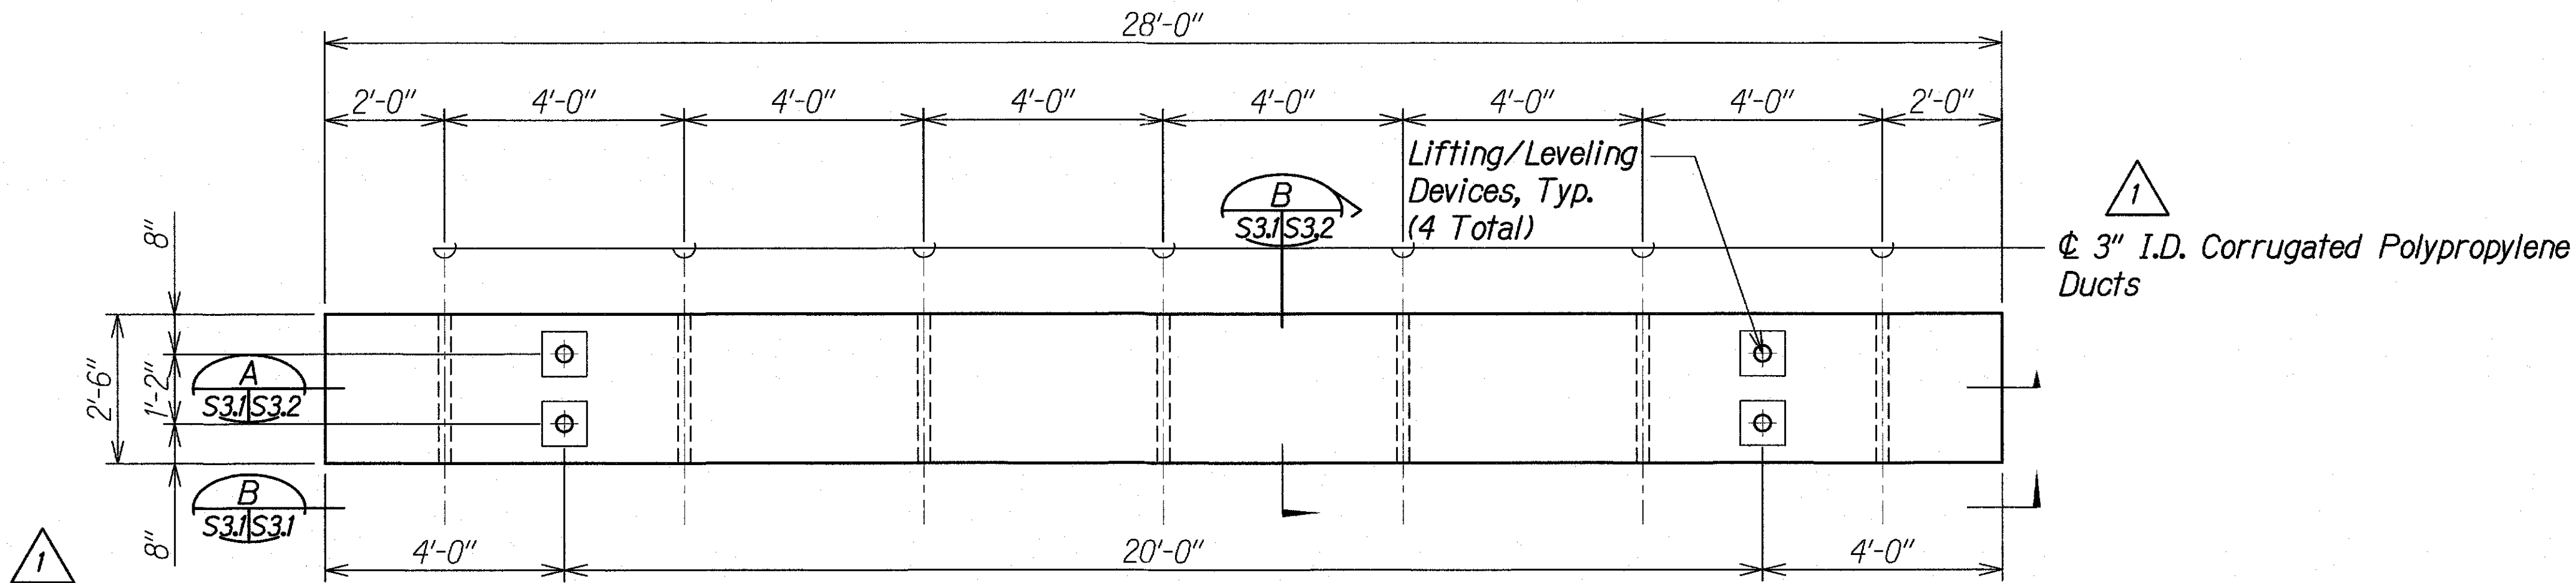


PLANK PLAN
Scale: 1/2" = 1'-0"

NOTE:
All riding surfaces to be textured and grooved. See Specifications.

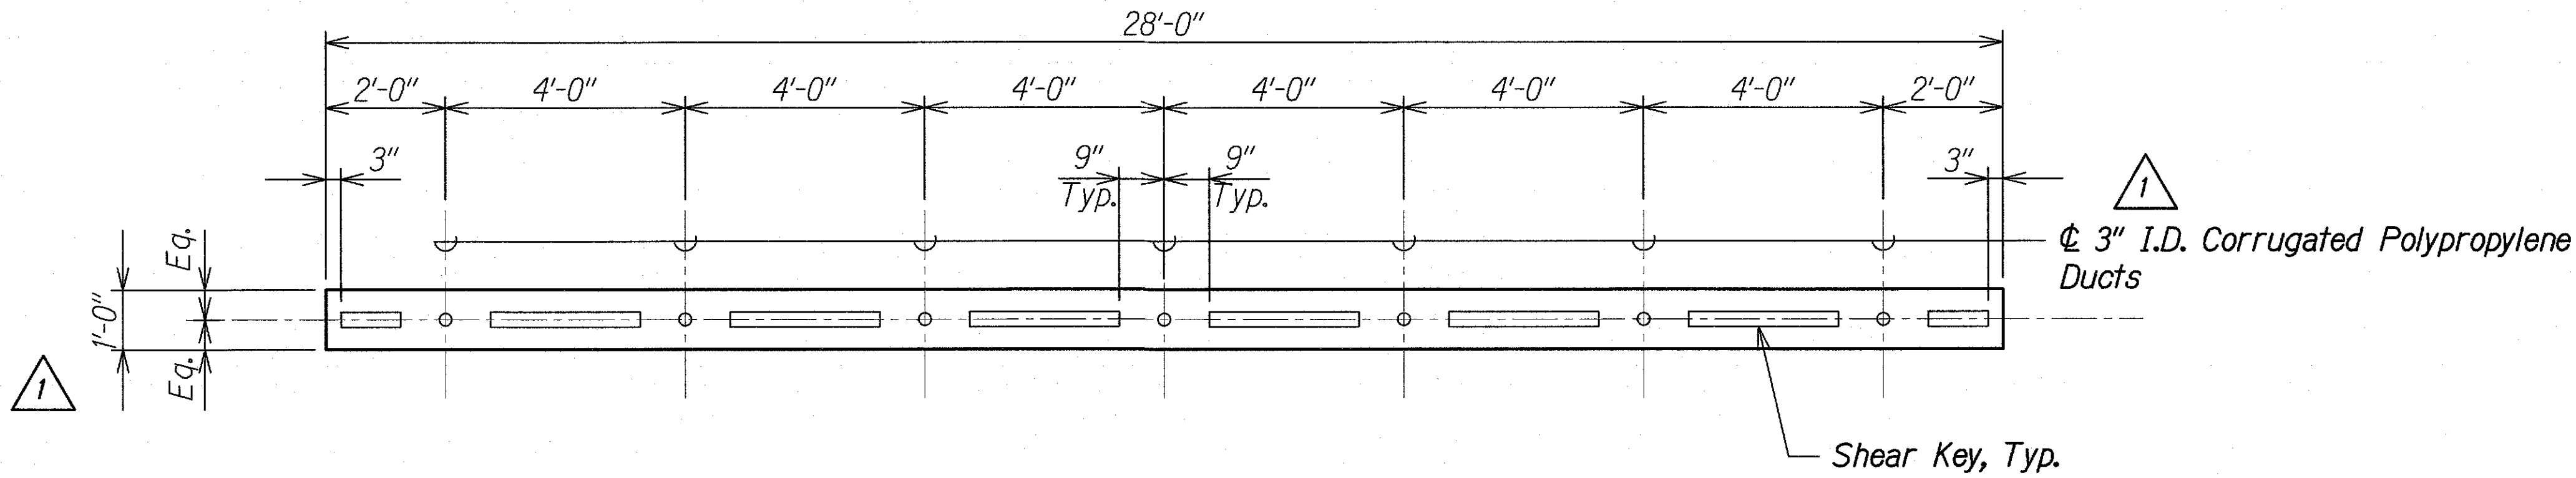

PLANK ELEVATION
Scale: 1/2" = 1'-0"

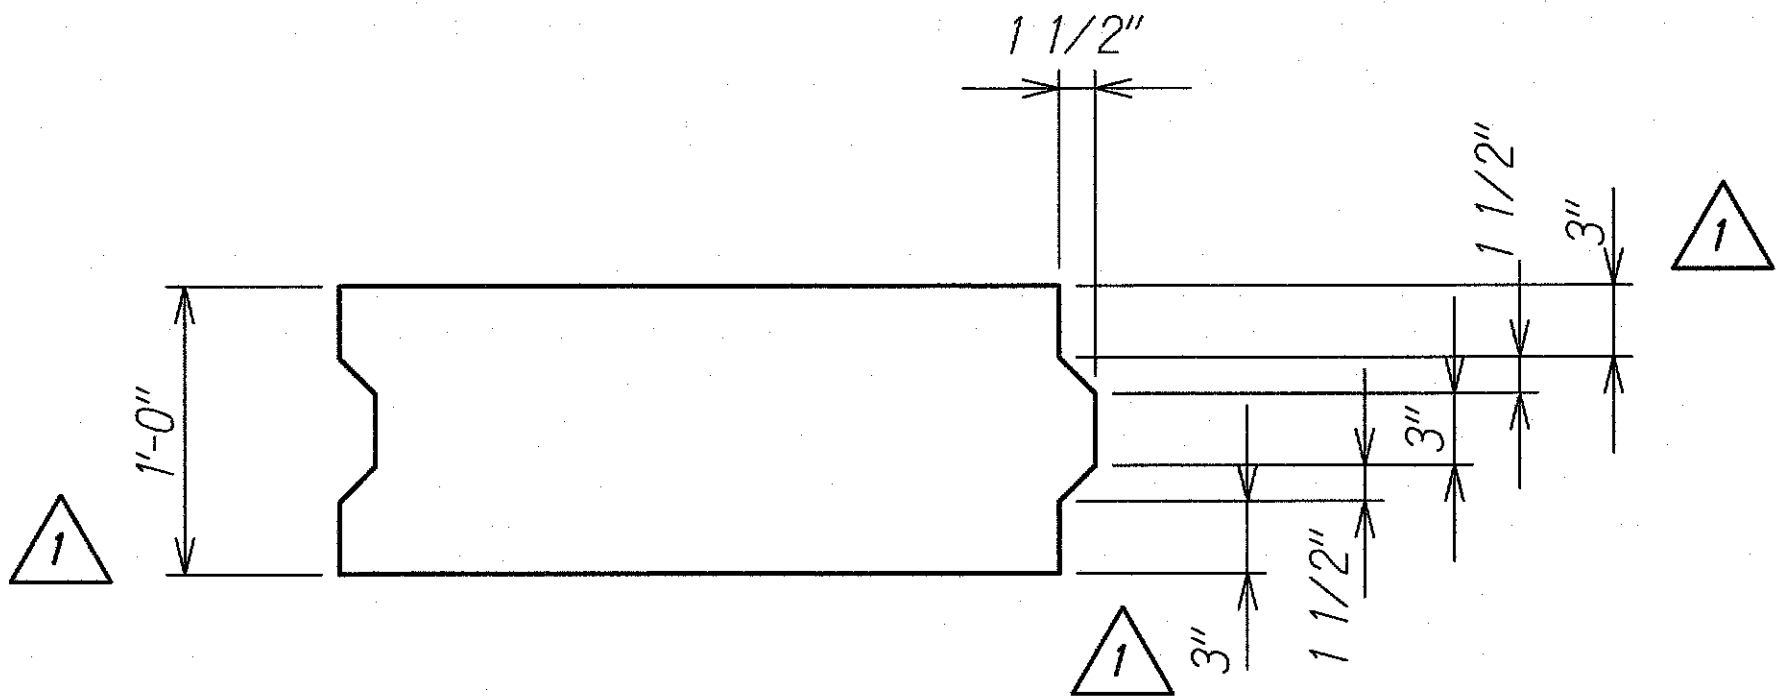

SHEAR KEY
Scale: 1 1/2" = 1'-0"

SURVEY PLOTTED BY	DATE
DRAWN BY	
NOTE BOOK	
QUANTITIES BY	
CHECKED BY	

DRAWING NAME: 21-00 ONGOING 18-006.5-KUHO HWY STREAM POCV01 CAD 10-05-20 LIMAHLI AS-BUILT LSP-S0301 PLANK.DWG PLOT TIME: 10-09-20 3:54 PM

3/28/19	1 Revised Dimensions
DATE	REVISION

STATE OF HAWAII
DEPARTMENT OF TRANSPORTATION
HIGHWAYS DIVISION

**PRECAST PLANK PLAN,
ELEVATION AND DETAIL**
KAUAI EMERGENCY FLOOD REPAIRS & CLEANUP
At Various Locations April 2018, Rte. 560
Proj. No. ER-19(001)

Scale: As Noted
Date: Mar. 2019

SHEET No. S3.1 OF 3 SHEETS