


FED. ROAD DIST. NO.	STATE	FEDERAL AID PROJ. NO.	FISCAL YEAR	SHEET NO.	TOTAL SHEETS
HAWAII	HAW.	ER-19(001)	2018	15	30

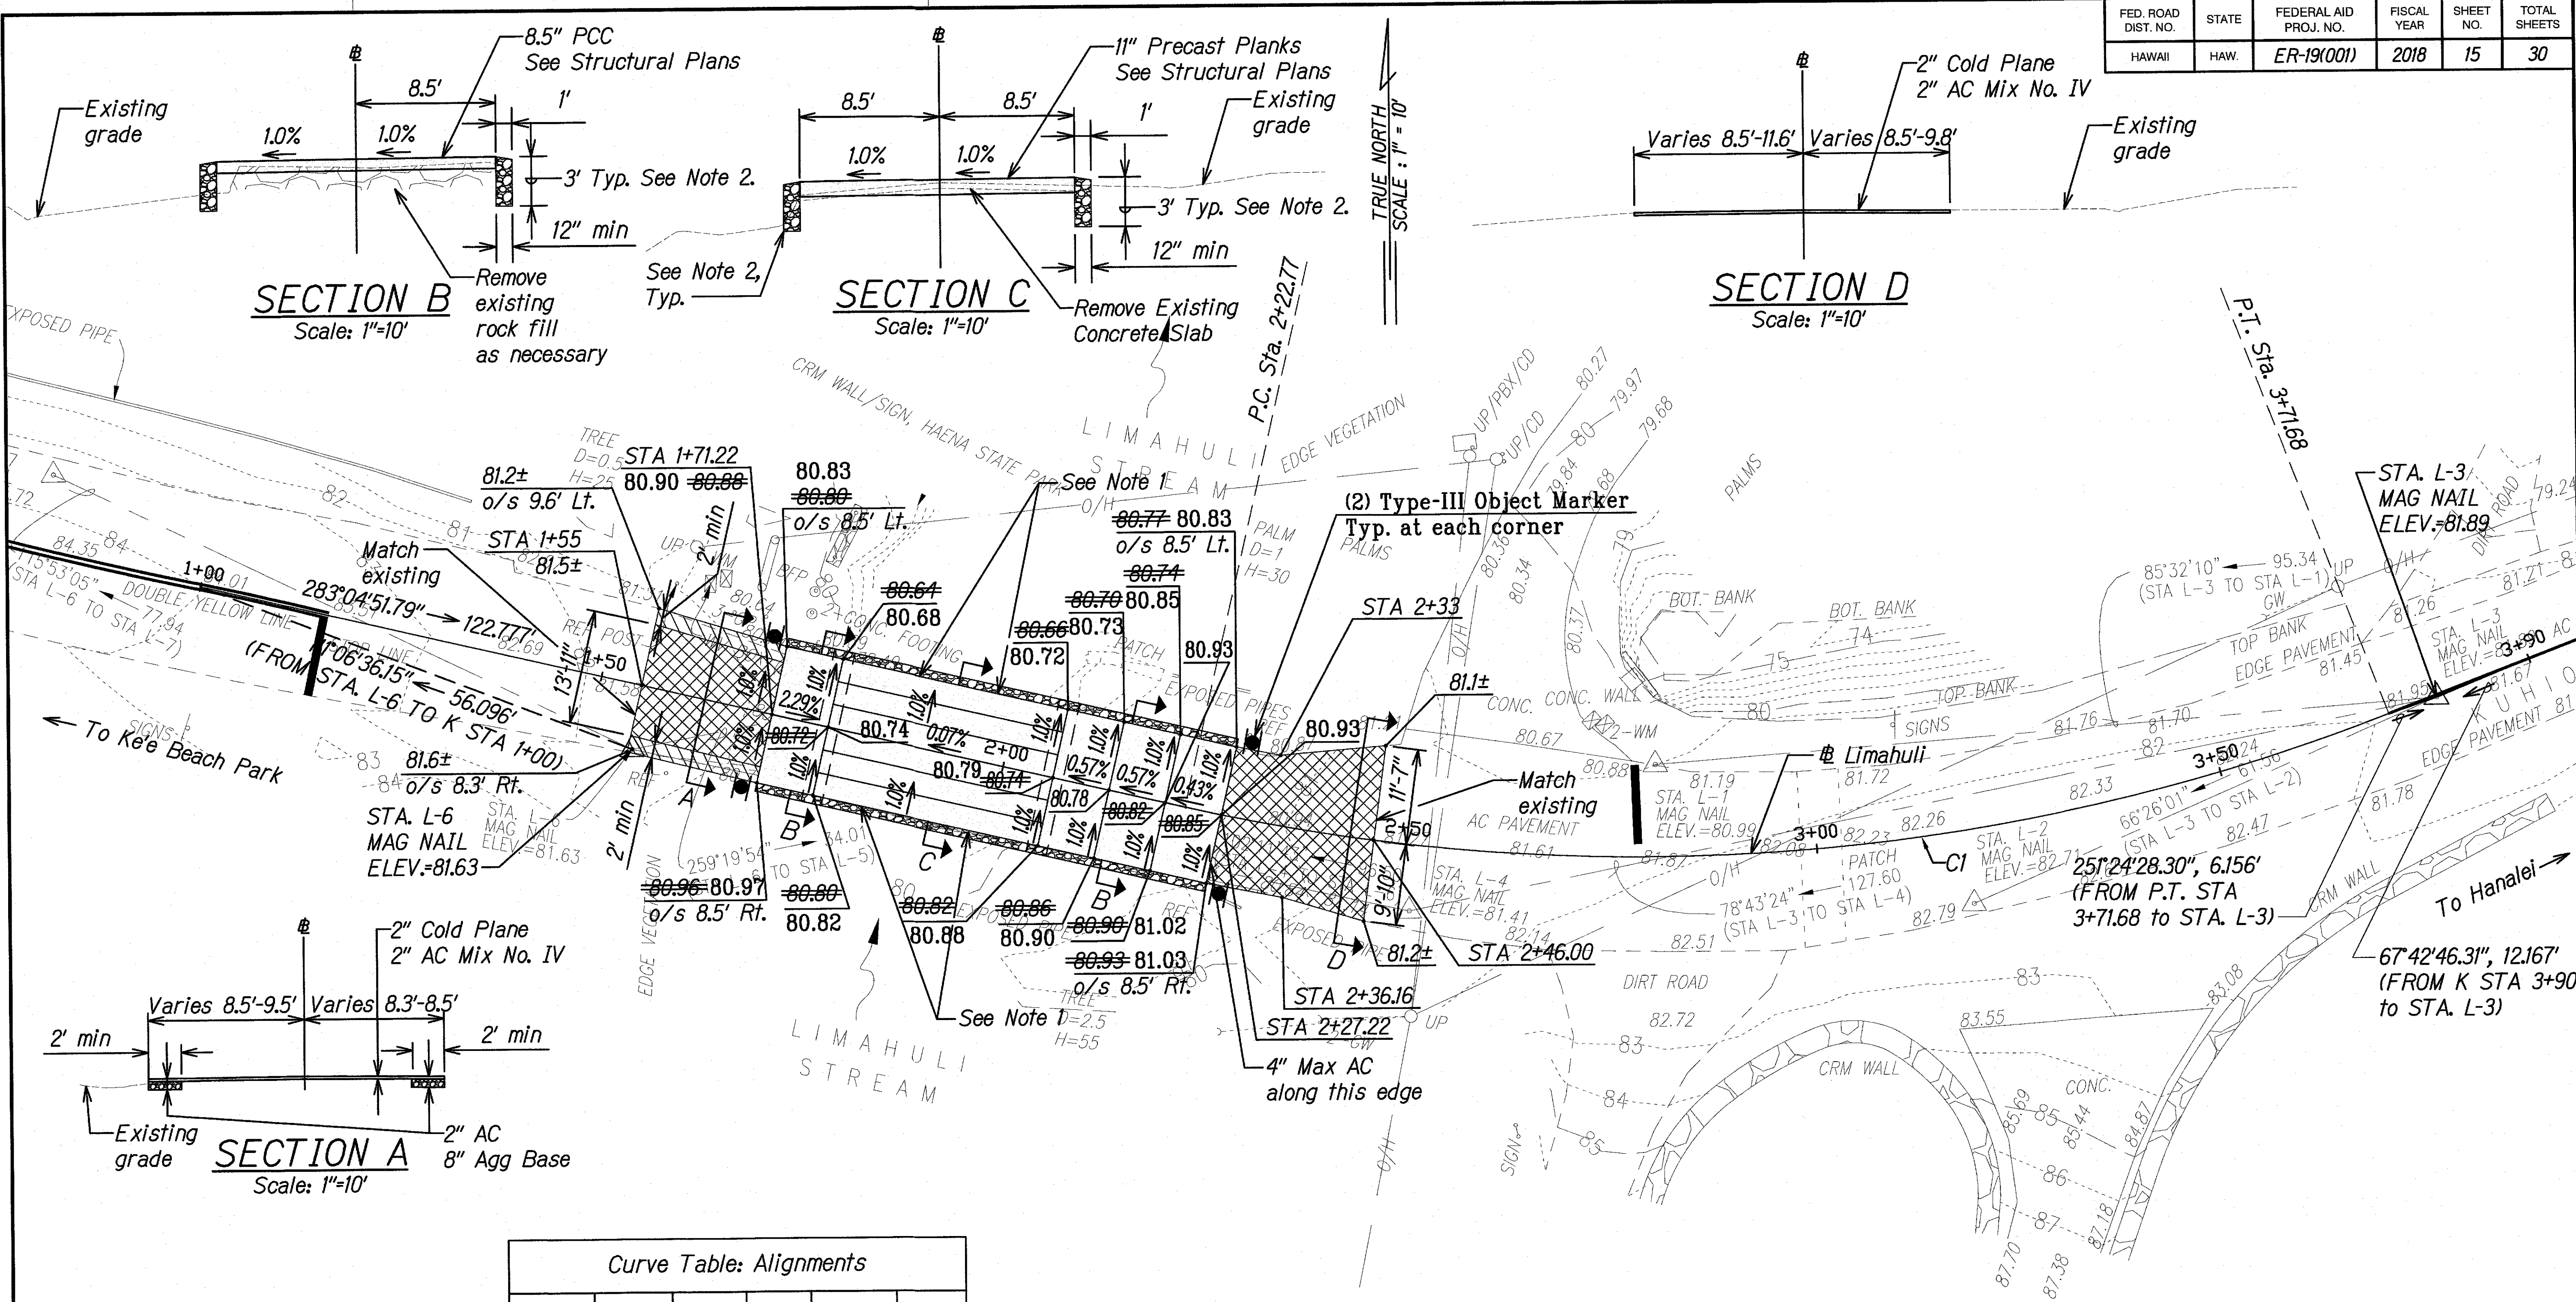

- NOTES:**
- Construct GRP around drainage openings without restricting flow.
 - Excavate a minimum 3 feet or until basalt rock formation is encountered.

Curve Table: Alignments					
Curve #	Radius	Length	Delta	Tangent	Chord
C1	250.00	148.91	34°10'	76.74	146.72

LEGEND FOR AS-BUILT POSTINGS	
	Squiggly line for as-built deletion
	Double line for as-built deletion
Roadway	Text for as-built posting

- LEGEND**
- 2" Cold Plane
2" to 4" AC Max.
 - 8 1/2" Precast Panels
or 11" Precast Planks
See Sht. S1.1
 - GRP
 - 2" AC Mix No. IV
8" Agg Base

PLAN
Scale: 1"=10'

STATE OF HAWAII
DEPARTMENT OF TRANSPORTATION
HIGHWAYS DIVISION

ROADWAY CONSTRUCTION

 KAUAI EMERGENCY FLOOD REPAIRS & CLEANUP
 AT VARIOUS LOCATIONS APRIL 2018, RTE 560
 Proj. No. ER-19(001)

Scale: 1"=10'
Date: Mar. 2019

SHEET No. R-1 OF 1 SHEETS

"AS-BUILT"