


FED. ROAD DIST. NO.	STATE	FEDERAL AID PROJ. NO.	FISCAL YEAR	SHEET NO.	TOTAL SHEETS
HAWAII	HAW.	ER-19(001)	2018	1	30

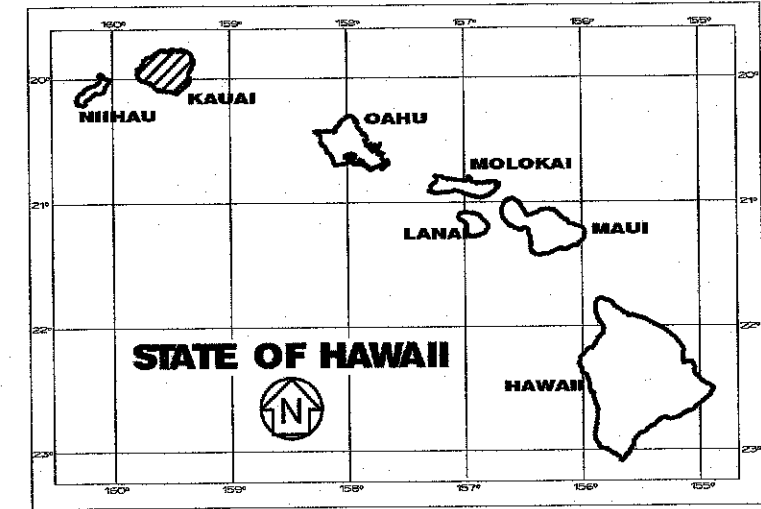

SHT. NO.	DESCRIPTION
1	TITLE SHEET
2	STANDARD PLANS SUMMARY
3	GENERAL NOTES & ABBREVIATIONS
4-6	GENERAL NOTES
7-8	WATERLINE NOTES
9-11	WATER POLLUTION AND EROSION CONTROL NOTES
12	EROSION CONTROL DETAILS
13-14	CONSTRUCTION PHASING & EROSION CONTROL
15	ROADWAY CONSTRUCTION
16	LIMAHULI WATERLINE PLAN AND PROFILE
17	TRAFFIC CONTROL NOTES
18	TRAFFIC CONTROL PLAN
19	INDEX TO STRUCTURAL DRAWINGS
20-21	STRUCTURAL GENERAL NOTES
22	SYMBOLS AND ABBREVIATIONS
23	JPCP LAYOUT PLAN
24	TYPICAL JPCP PRECAST PANEL DETAILS
25-26	TYPICAL JPCP PRECAST SLAB DETAILS
27	WATERLINE JACKET
28	PRECAST PLANK PLAN, ELEVATION AND DETAIL
29	PRECAST PLANK REINFORCING SECTIONS
30	PRECAST FOOTING SECTIONS

ADDENDUM SHEET

29S-1 PRECAST PLANK NOTES

TOTAL SHEET COUNT after "AS BUILT" postings.
31 Sheets.

LEGEND FOR AS-BUILT POSTINGS	
	Squiggly line for as-built deletion
	Double line for as-built deletion
Roadway	Text for as-built posting

CHANGES MADE DURING CONSTRUCTION HAVE BEEN INCORPORATED ON THESE PLANS EXCEPT CHANGES IN THE ORIGINAL THEORETICAL QUANTITIES. FOR ACTUAL QUANTITIES, REFER TO PROJECT LEDGER AND/OR COMPUTATION BOOK.

RESIDENT ENGINEER

1/11/21
DATE

1 0 1 2 3
SCALE IN THOUSAND FEET

LAYOUT PLAN

GROSS LENGTH OF PROJECT.....0.1 MILES
NET LENGTH OF PROJECT.....0.1 MILES

STATE OF HAWAII

DEPARTMENT OF TRANSPORTATION HIGHWAYS DIVISION HONOLULU, HAWAII "AS-BUILT" PLANS FOR KUHIO HIGHWAY (ROUTE 560) KAUAI EMERGENCY FLOOD REPAIR AND CLEANUP AT VARIOUS LOCATIONS APRIL 2018 IN THE VICINITY OF MILEPOST 9.5 TO 9.6 F. A. P. NO. ER-19(001)

DISTRICT OF HANAIEI
ISLAND OF KAUAI


LIMITS OF PROJECT

BEGIN PROJECT
STA. 1+00
END PROJECT
STA. 3+00

HAENA

Haena Beach Park

To Hanalei

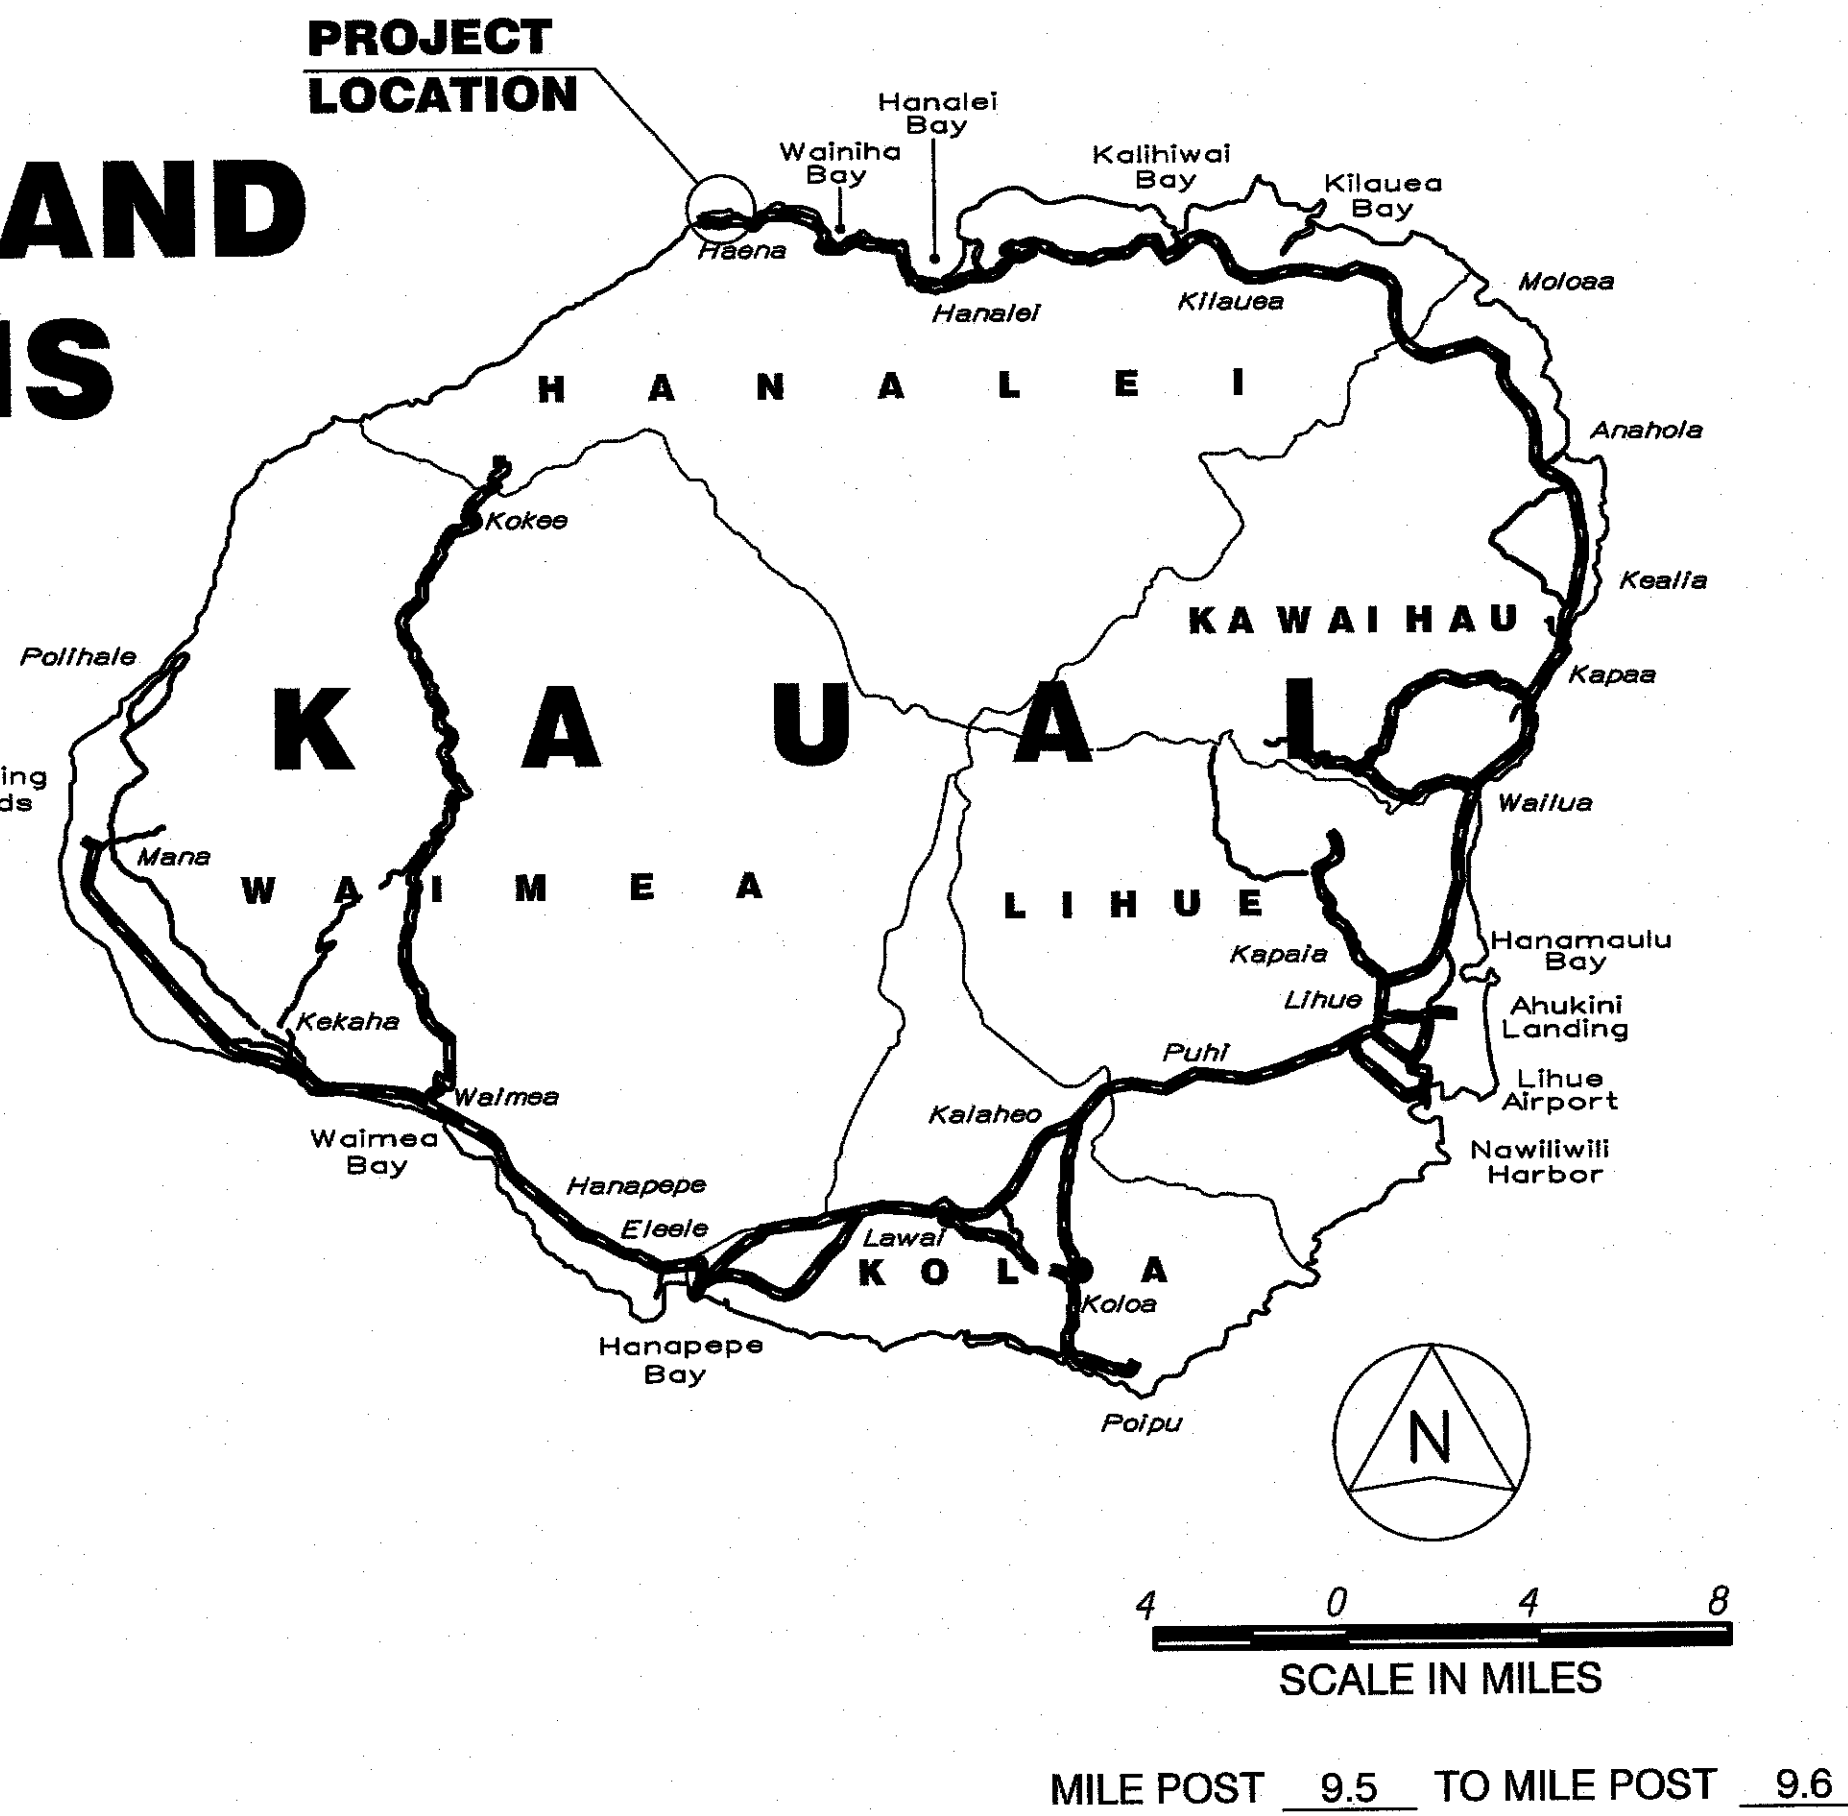

MILE POST 9.5 TO MILE POST 9.6

APPROVED:

MANAGER AND CHIEF ENGINEER
DEPARTMENT OF WATER
COUNTY OF KAUAI

1/3/19
DATE

DEPARTMENT OF TRANSPORTATION
STATE OF HAWAII

APPROVED:

DIR. OF TRANSPORTATION

1/3/19
DATE