


FED. ROAD DIST. NO.	STATE	FEDERAL AID PROJ. NO.	FISCAL YEAR	SHEET NO.	TOTAL SHEETS
HAWAII	HAW.	ER-19(001)	2018	27	30

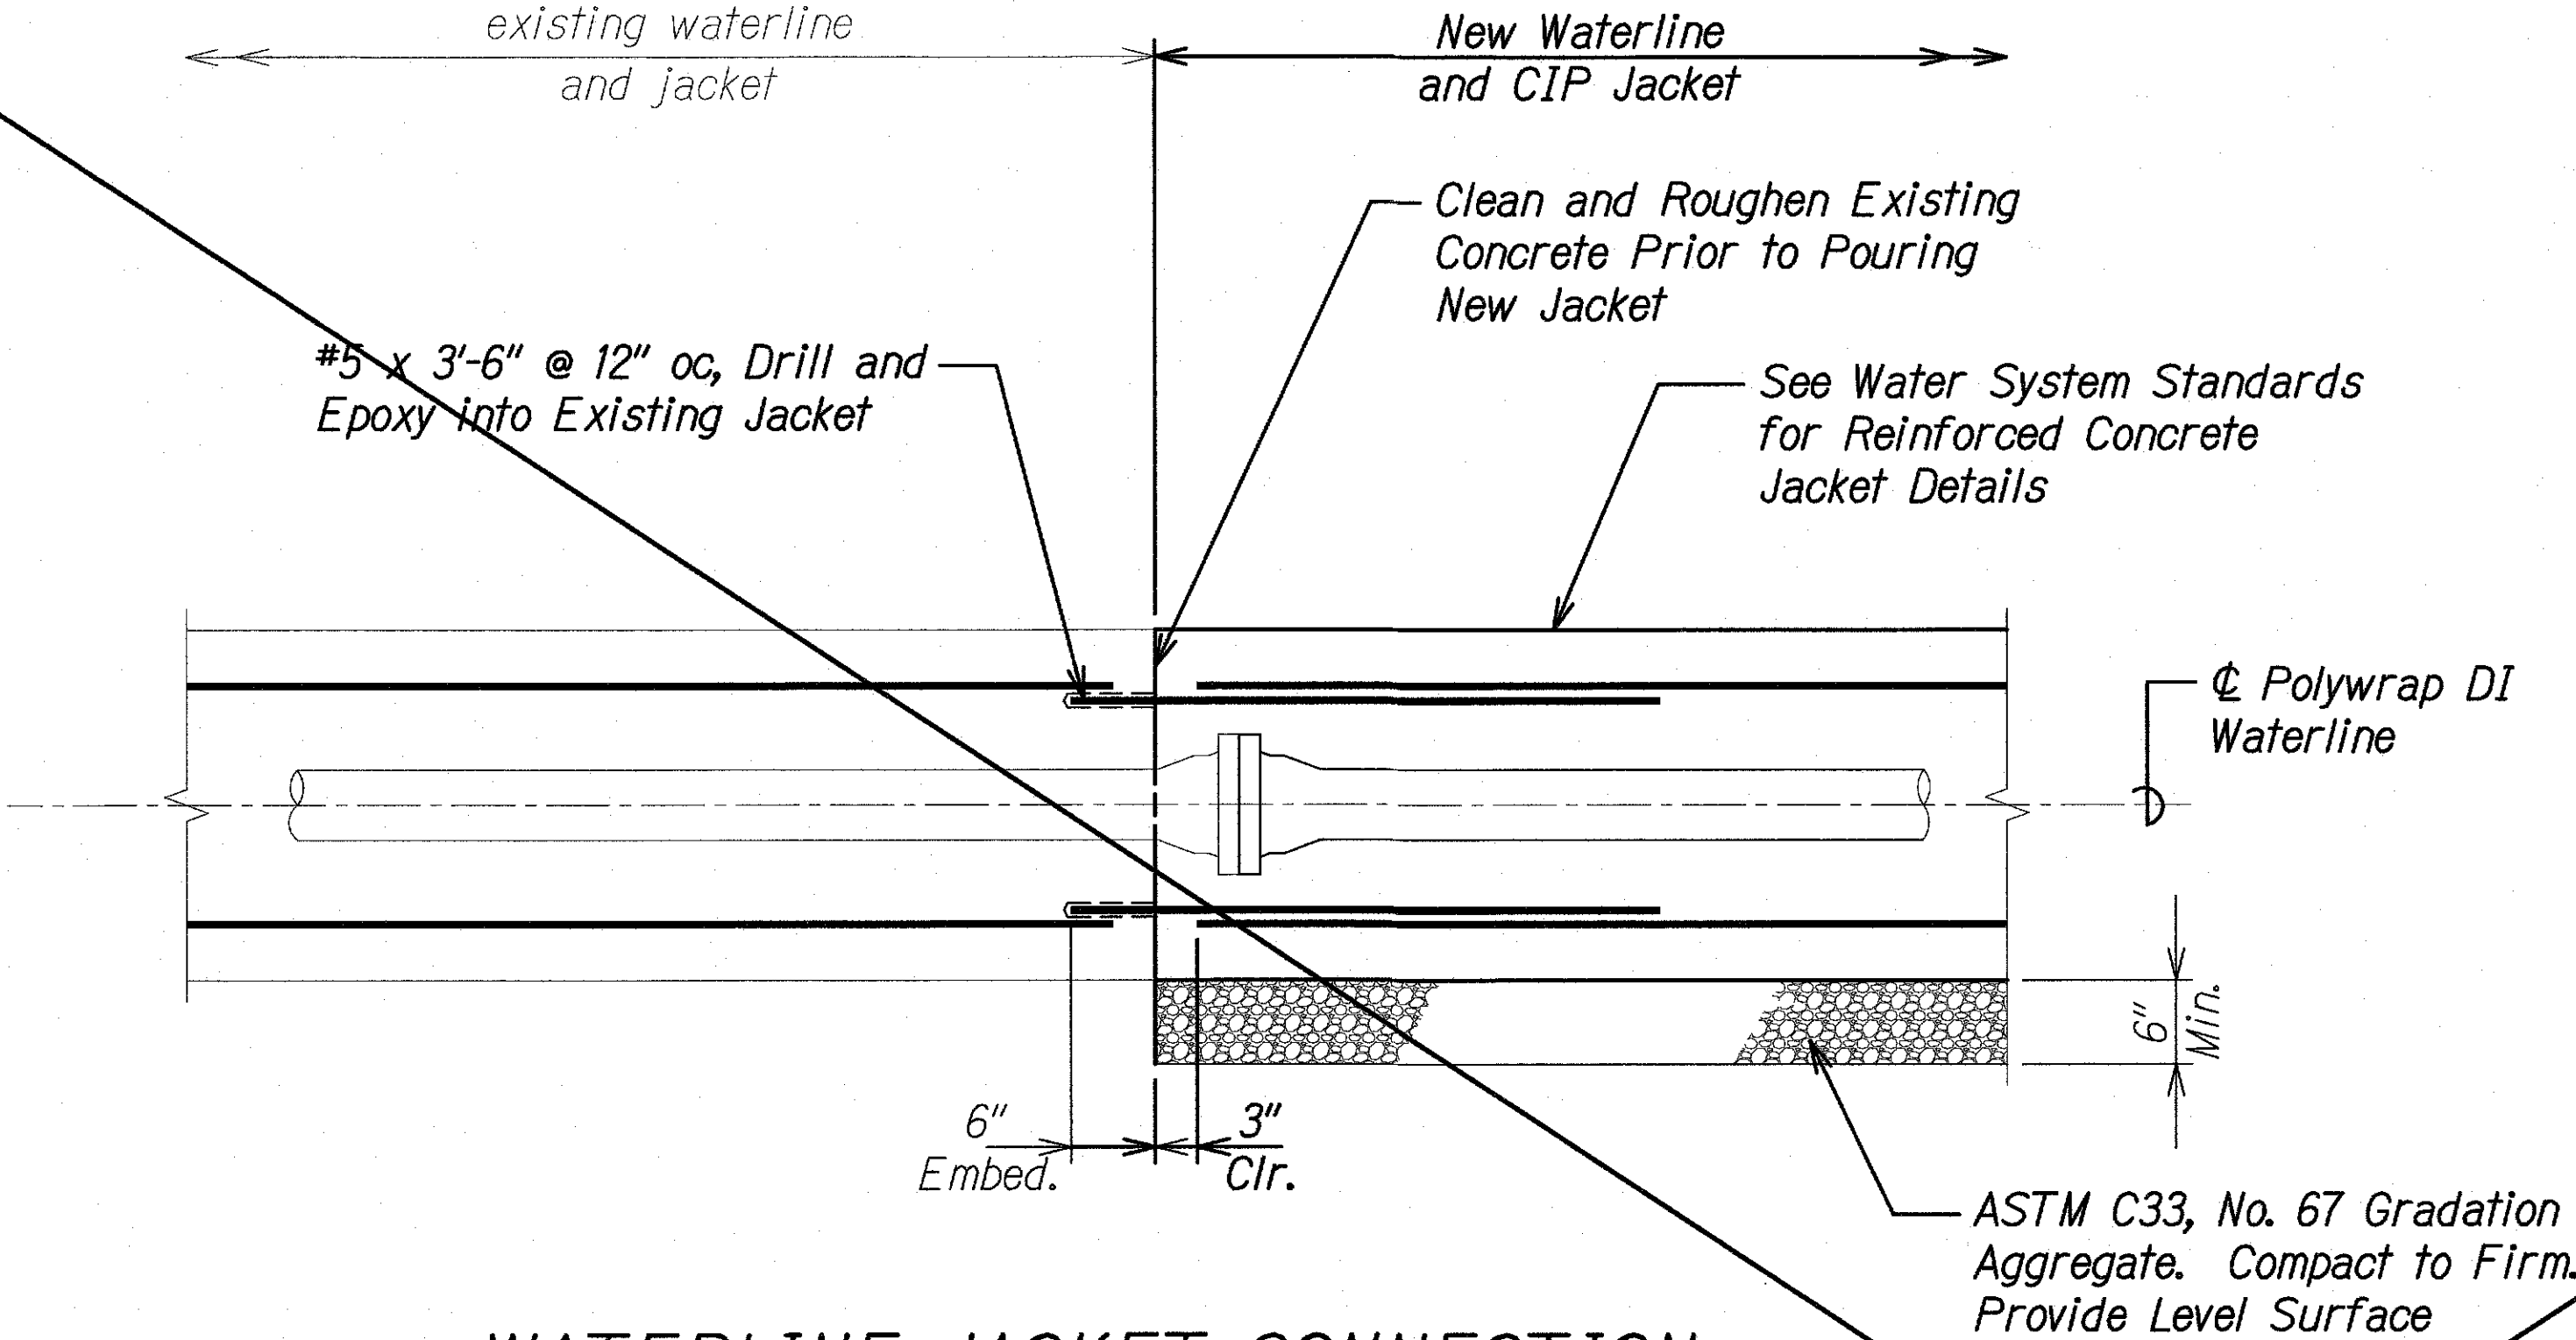

WATERLINE JACKET CONNECTION
TO EXISTING JACKET
Scale: 1" = 1'-0"

A
S21 S2

N.I.C.

ORIGINAL PLAN	SURVEY PLOTTED BY	DATE
NOTE BOOK	DRAWN BY	
No.	TRACED BY	
	QUANTITIES BY	
	CHECKED BY	


DRAWING NAME: Z:\00 ONGOING\18-008.5-KUHO HWY STREAM PCC\01 CAD\10-12-20 UHAWHUI AS-BUILT S0201\LSP-S201 H20LINE JACKET.DWG PLOT TIME: 10-10-20, 2:27 PM

APPROVED:

[Signature]
MANAGER AND CHIEF ENGINEER
DEPARTMENT OF WATER
COUNTY OF KAUAI

1/3/19
DATE

LEGEND FOR AS-BUILT POSTINGS	
	Squiggly line for as-built deletion
	Double line for as-built deletion
Roadway	Text for as-built posting

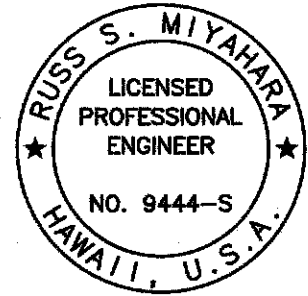

THIS WORK WAS PREPARED BY
ME OR UNDER MY SUPERVISION.

[Signature]
SIGNATURE EXPIRATION DATE OF THE LICENSE 4-30-20

STATE OF HAWAII
DEPARTMENT OF TRANSPORTATION
HIGHWAYS DIVISION

WATERLINE JACKET

KAUAI EMERGENCY FLOOD REPAIRS & CLEANUP
At Various Locations April 2018, Rte. 560
Proj. No. ER-19(001)

Scale: As Noted Date: Mar. 2019

SHEET No. S21 OF 1 SHEETS

"AS-BUILT"