



| FED. ROAD DIST. NO. | STATE | FEDERAL AID PROJ. NO. | FISCAL YEAR | SHEET NO. | TOTAL SHEETS |
|---------------------|-------|-----------------------|-------------|-----------|--------------|
| HAWAII              | HAW.  | ER-19(001)            | 2018        | 26        | 28           |

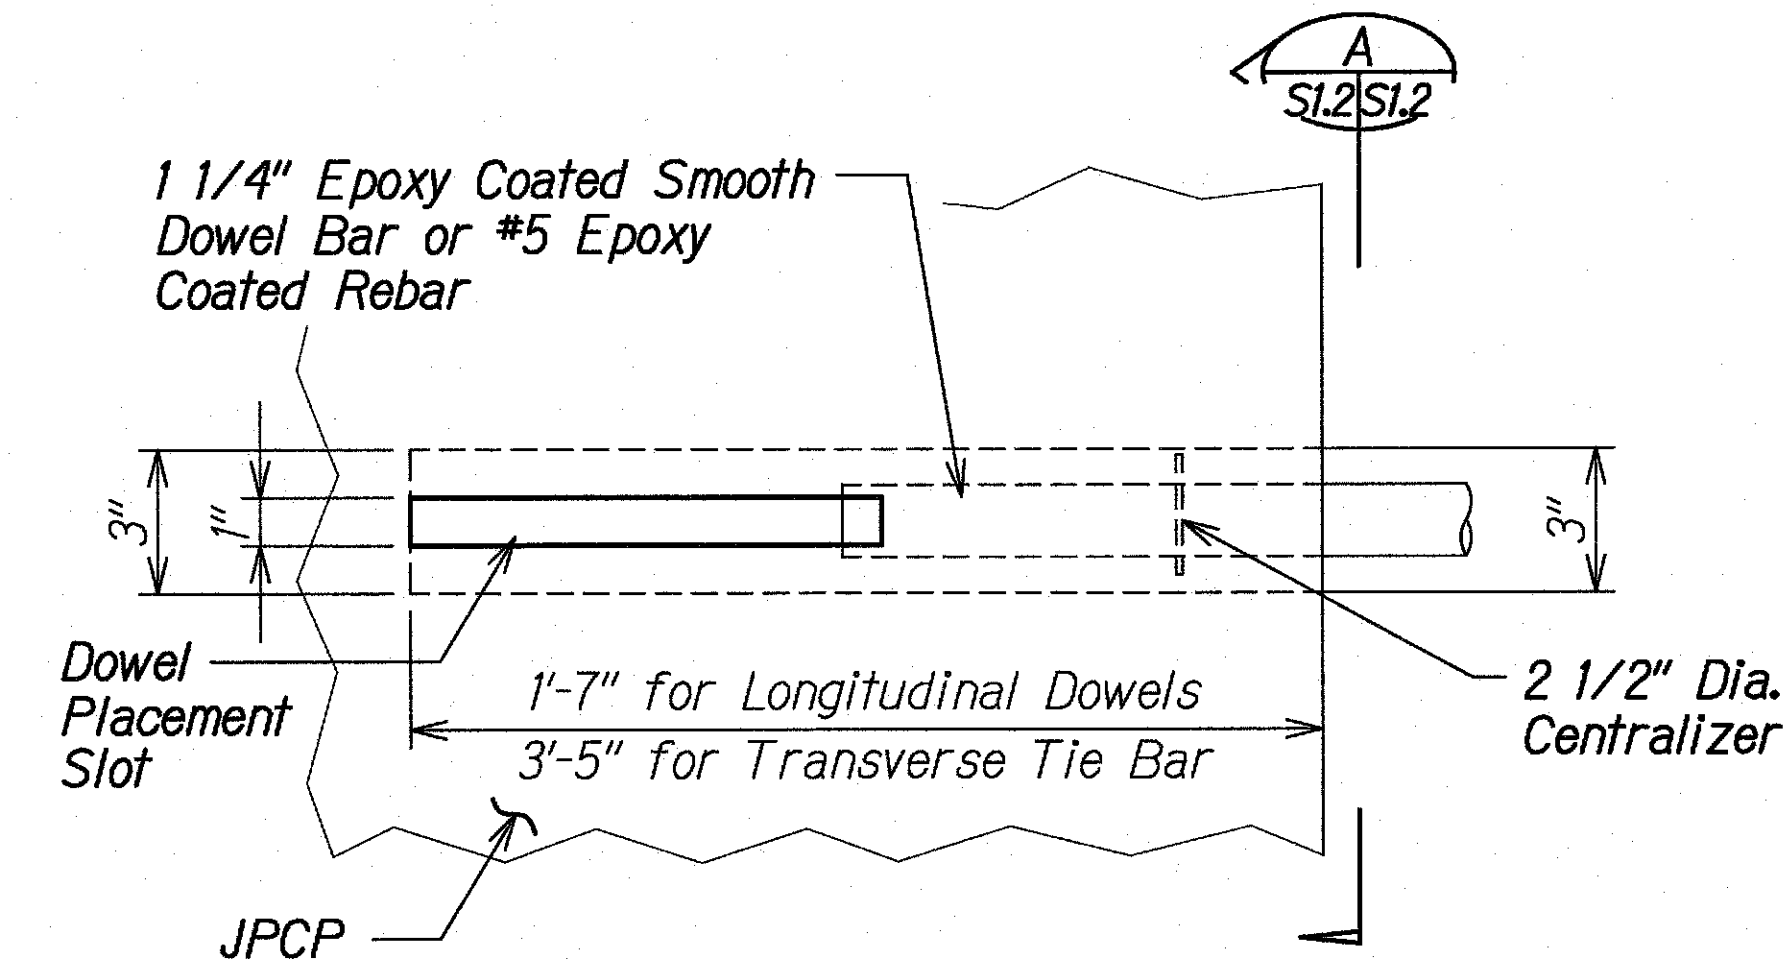


**PARTIAL PLAN LOAD TRANSFER DEVICE** 1  
Scale: 3" = 1'-0" SI.2 SI.2

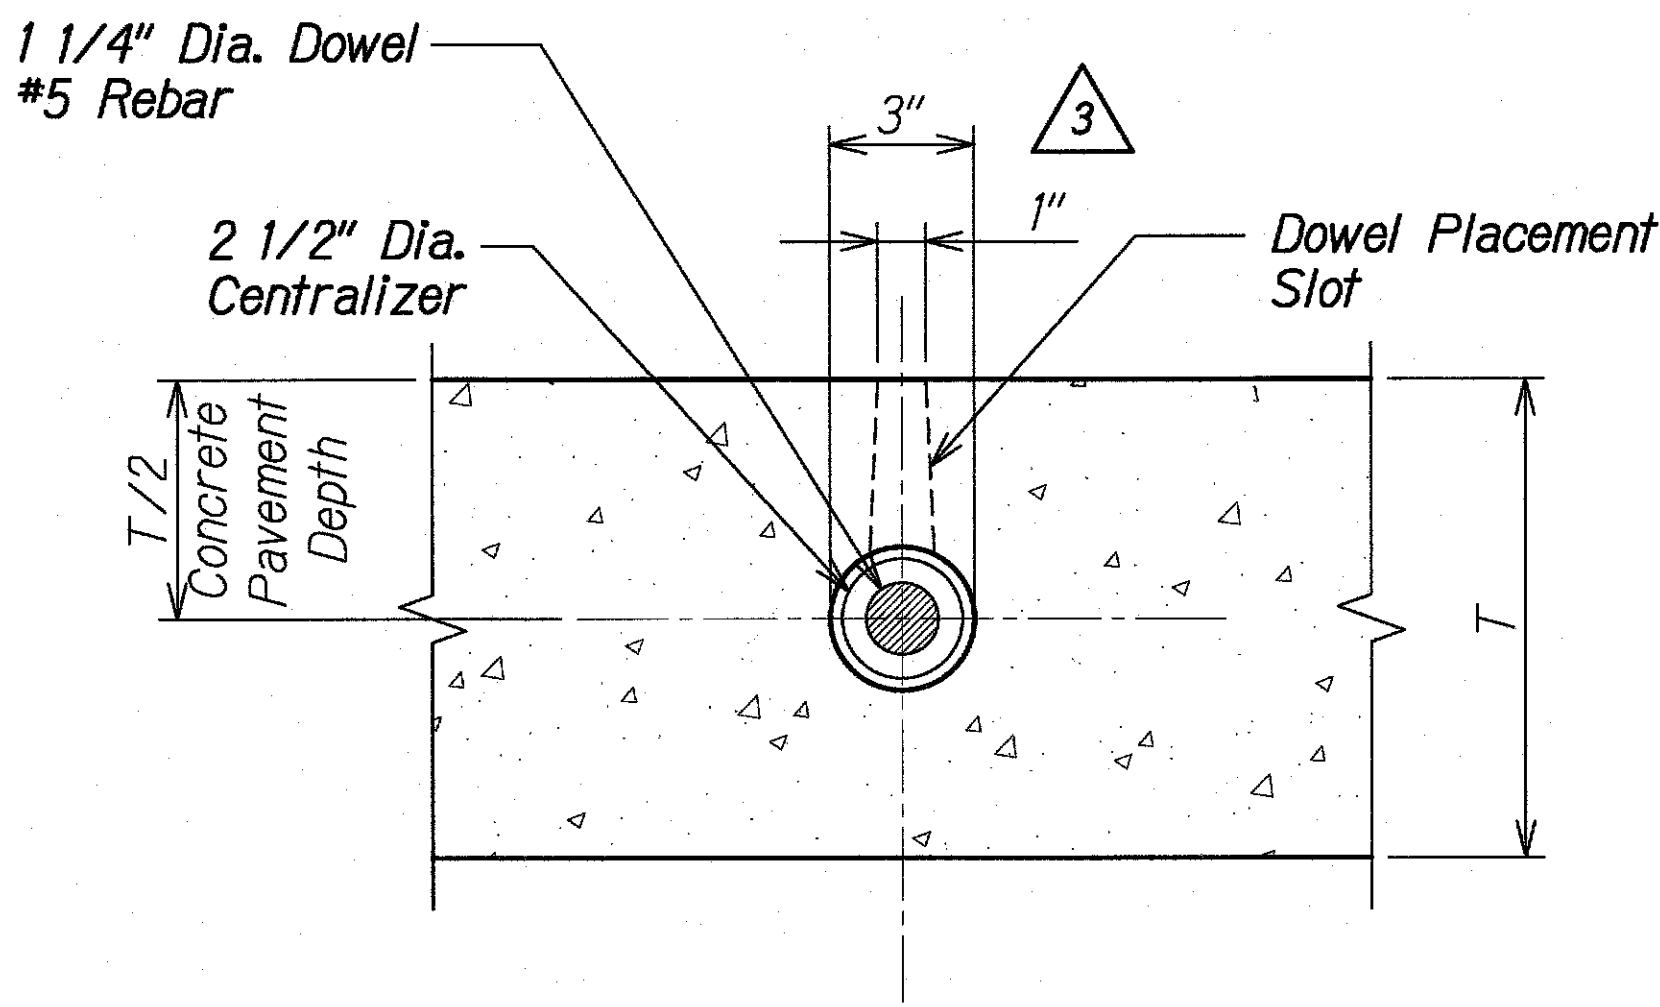


**SECTION A**  
Scale: 3" = 1'-0" SI.2 SI.2

Note:  
Surface slot system shown, the Contractor may request substitution of load transfer system for approval by the Engineer.

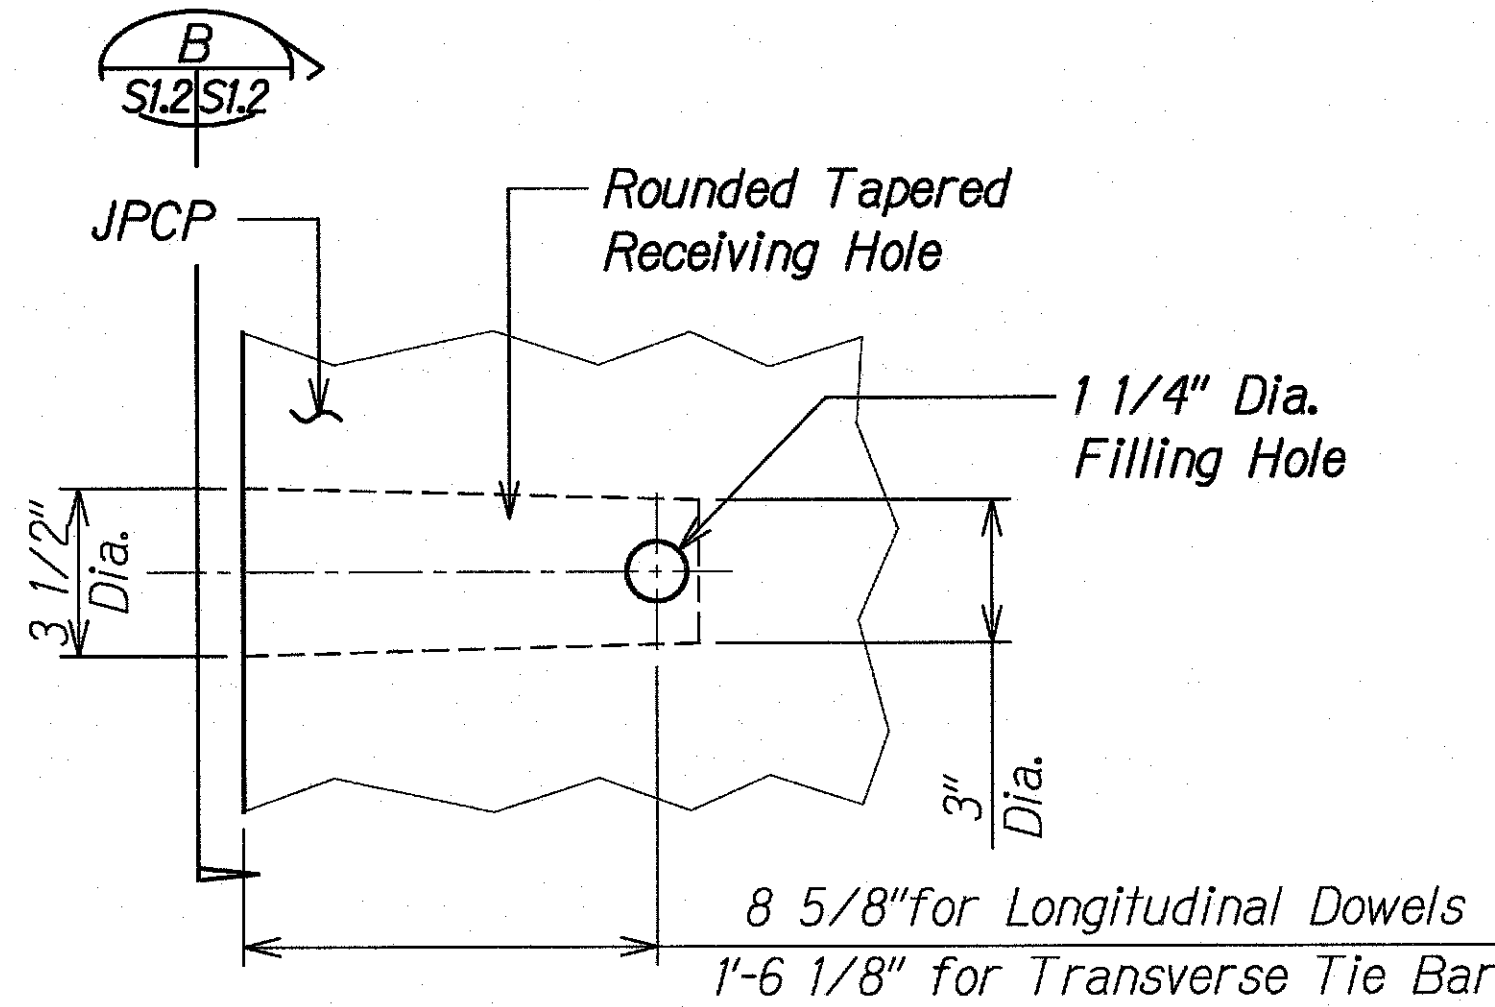

**RECEIVING END LOAD TRANSFER DEVICE** 2  
Scale: 3" = 1'-0" SI.2 SI.2

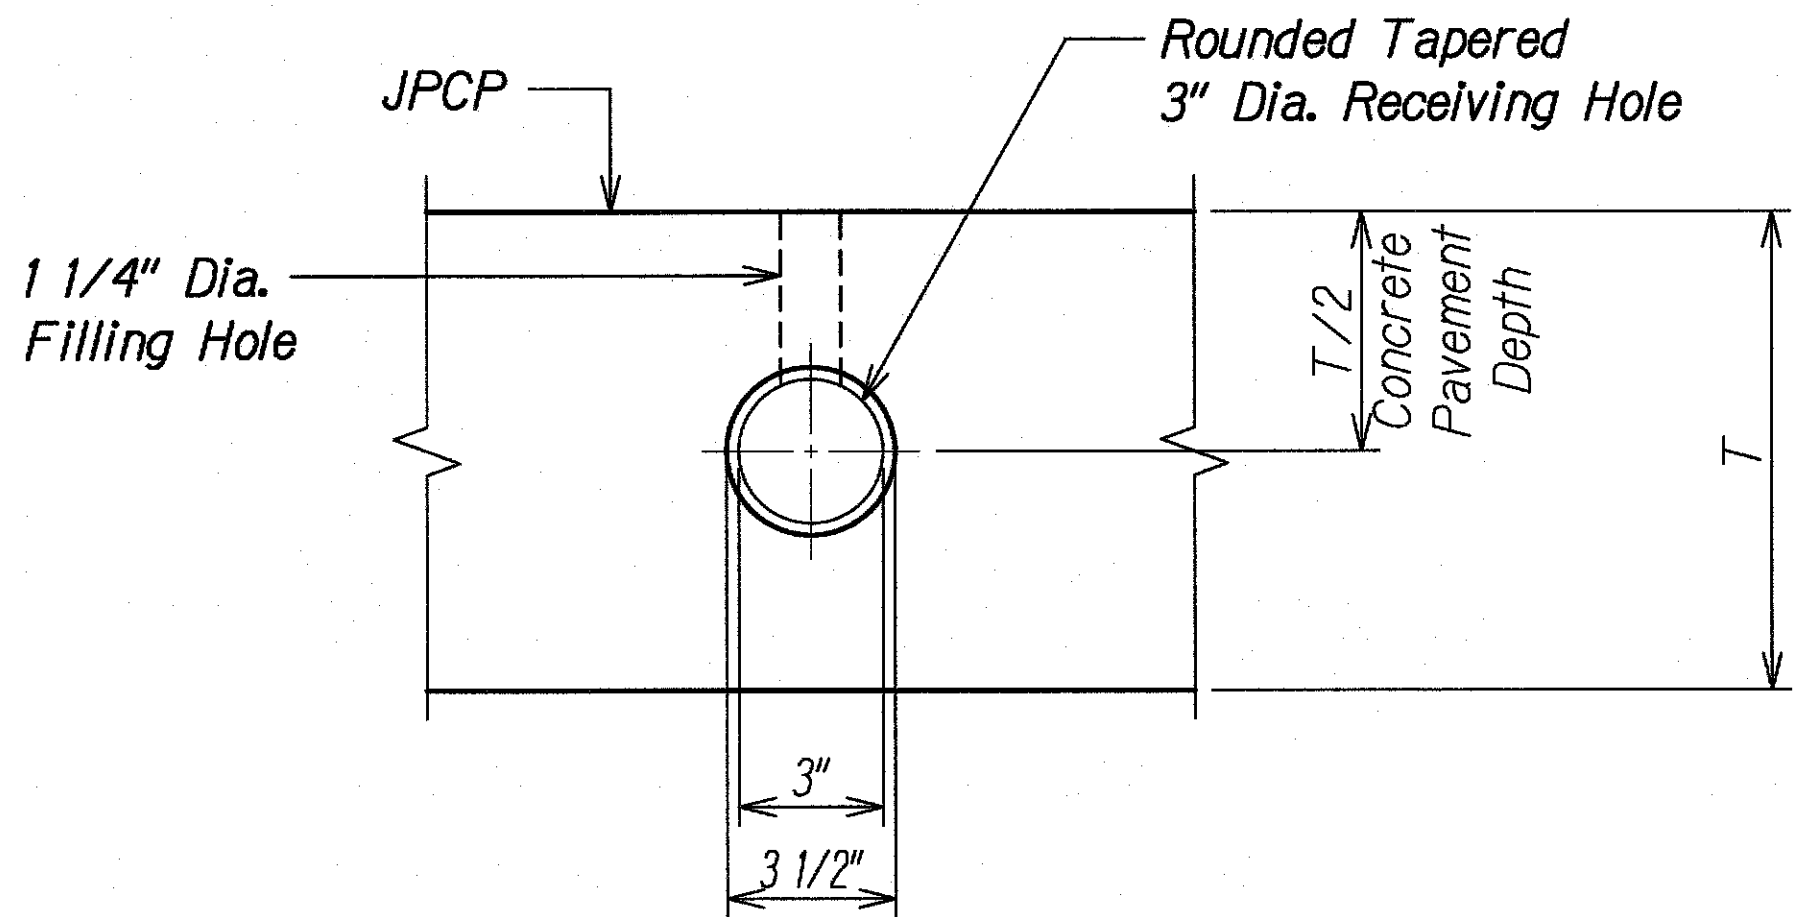


**SECTION B**  
Scale: 3" = 1'-0" SI.2 SI.2

3

|                                                                                                                                                                                                                                                                                                                                 |                                                                                                                            |
|---------------------------------------------------------------------------------------------------------------------------------------------------------------------------------------------------------------------------------------------------------------------------------------------------------------------------------|----------------------------------------------------------------------------------------------------------------------------|
| 11/22/17                                                                                                                                                                                                                                                                                                                        | <span style="border: 1px solid black; border-radius: 50%; padding: 2px;">3</span> Dowel Slot Revised; Extra Detail Removed |
| DATE                                                                                                                                                                                                                                                                                                                            | REVISION                                                                                                                   |
| STATE OF HAWAII<br>DEPARTMENT OF TRANSPORTATION<br>HIGHWAYS DIVISION<br><b>TYPICAL PRECAST SLAB</b><br><b>DETAILS</b><br><b>KAUAI EMERGENCY FLOOD REPAIRS &amp; CLEANUP</b><br><b>At Various Locations April 2018, Rte. 560</b><br><b>Proj. No. ER-19(001)</b><br>Scale: As Noted Date: Oct. 2018<br>SHEET No. SI.2 OF 3 SHEETS |                                                                                                                            |


| FED. ROAD DIST. NO. | STATE | FEDERAL AID PROJ. NO. | FISCAL YEAR | SHEET NO. | TOTAL SHEETS |
|---------------------|-------|-----------------------|-------------|-----------|--------------|
| HAWAII              | HAW.  | ER-19(001)            | 2018        | 27        | 28           |

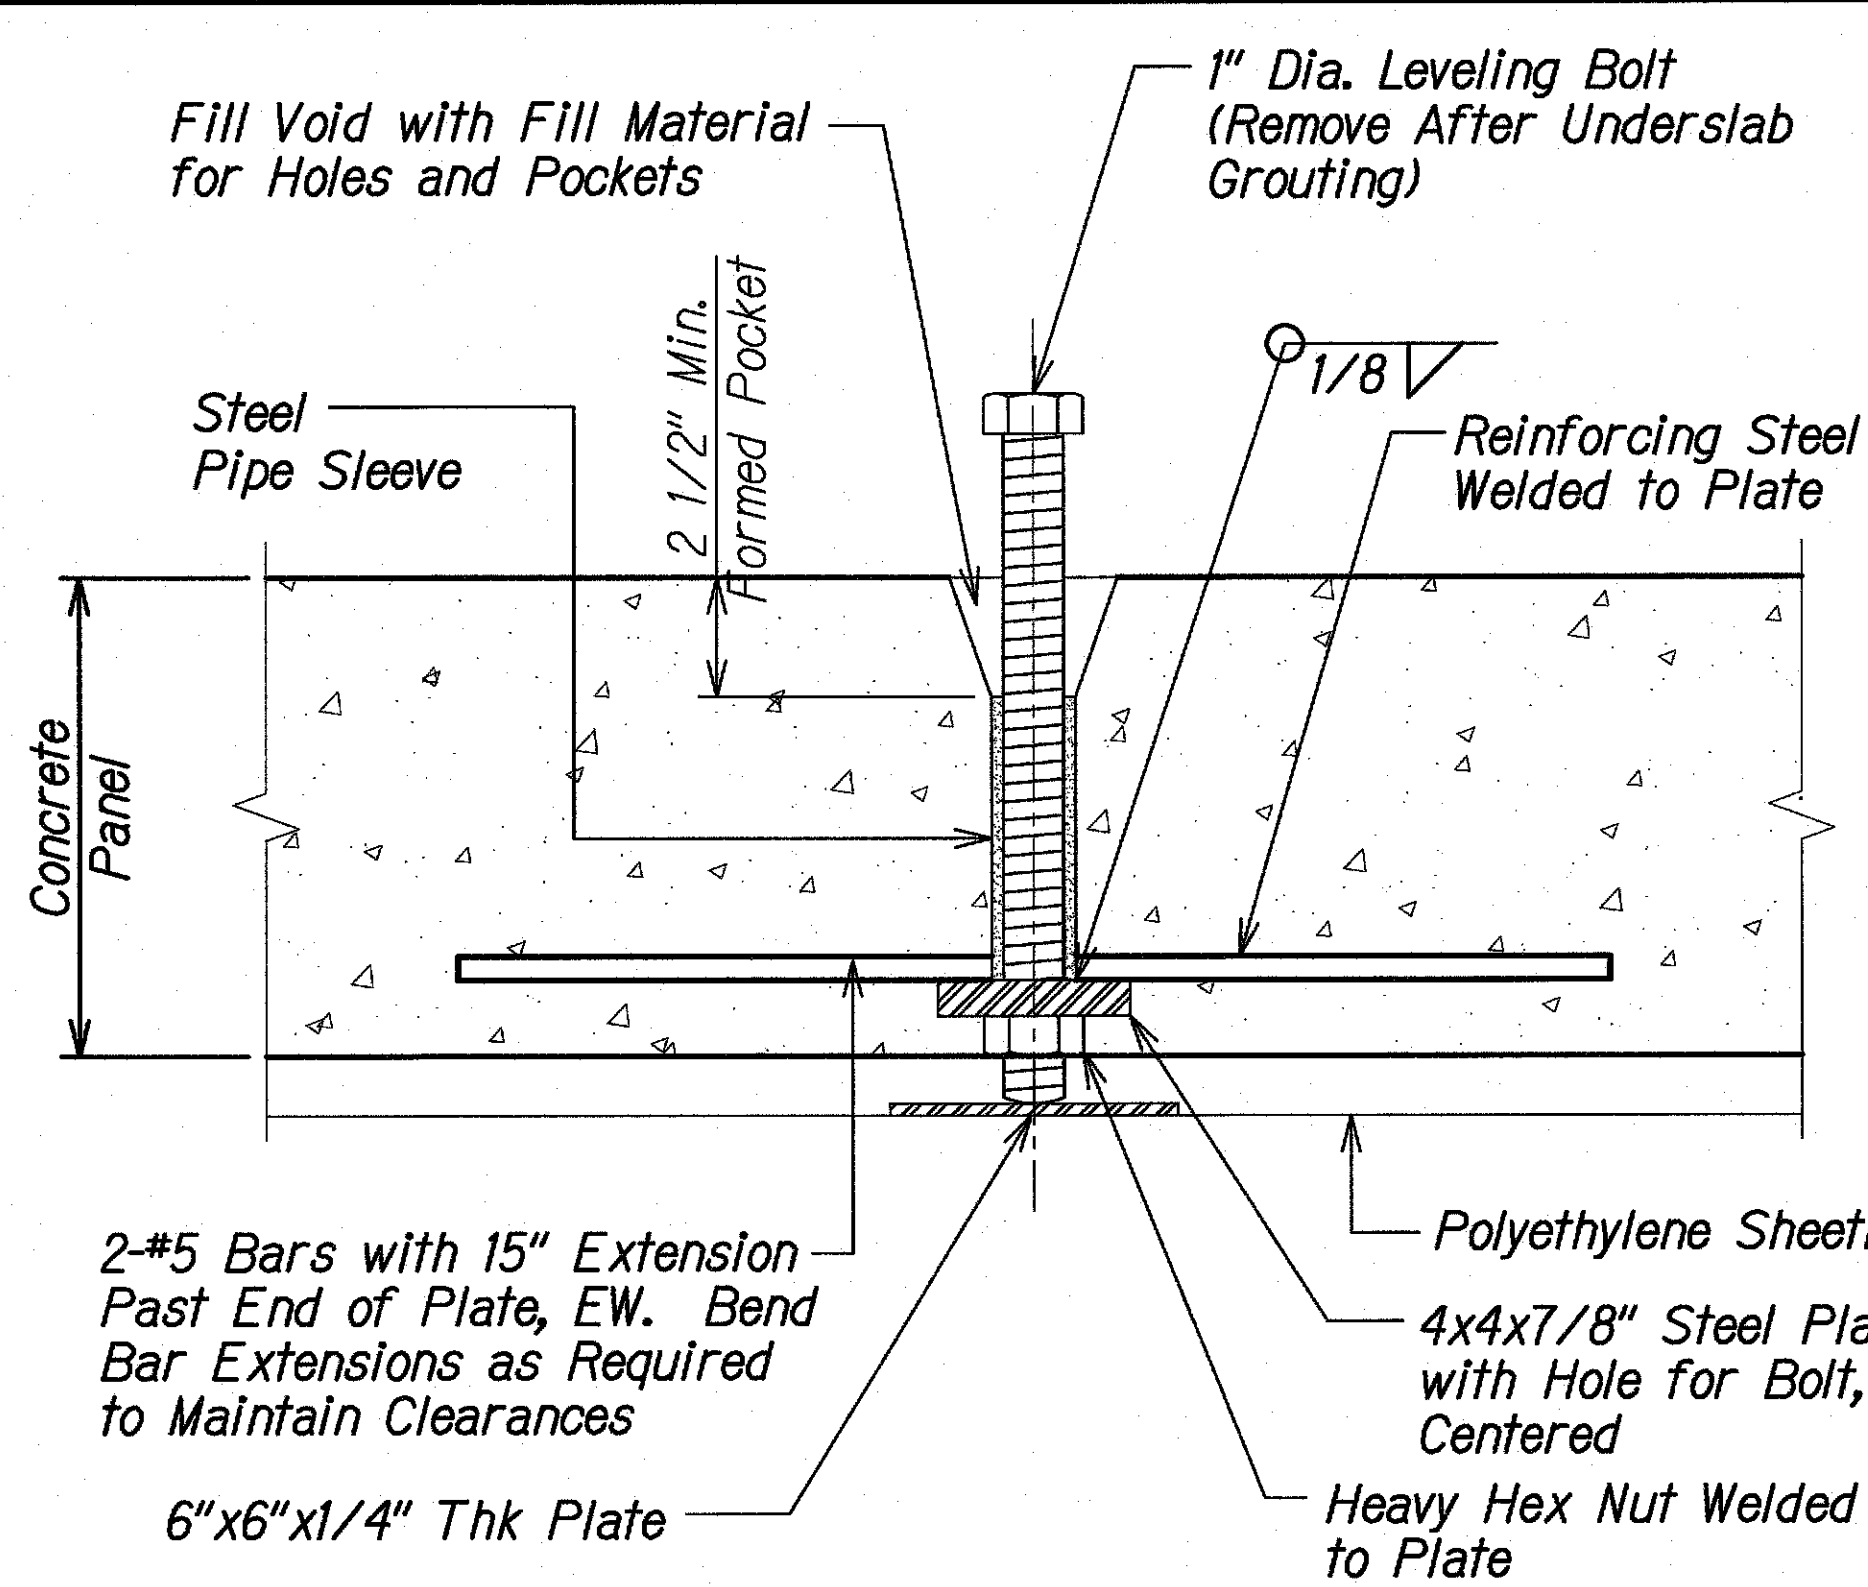

**Note:**

Structural Steel ASTM A36 and Reinforcing Steel ASTM A 615 Grade 60 to be Hot-Dip Galvanized ASTM A123 for Lifting/Leveling Device.

**LIFTING/LEVELING DEVICE DETAIL** 1  
 Scale: 3" = 1'-0" SL3 SL3

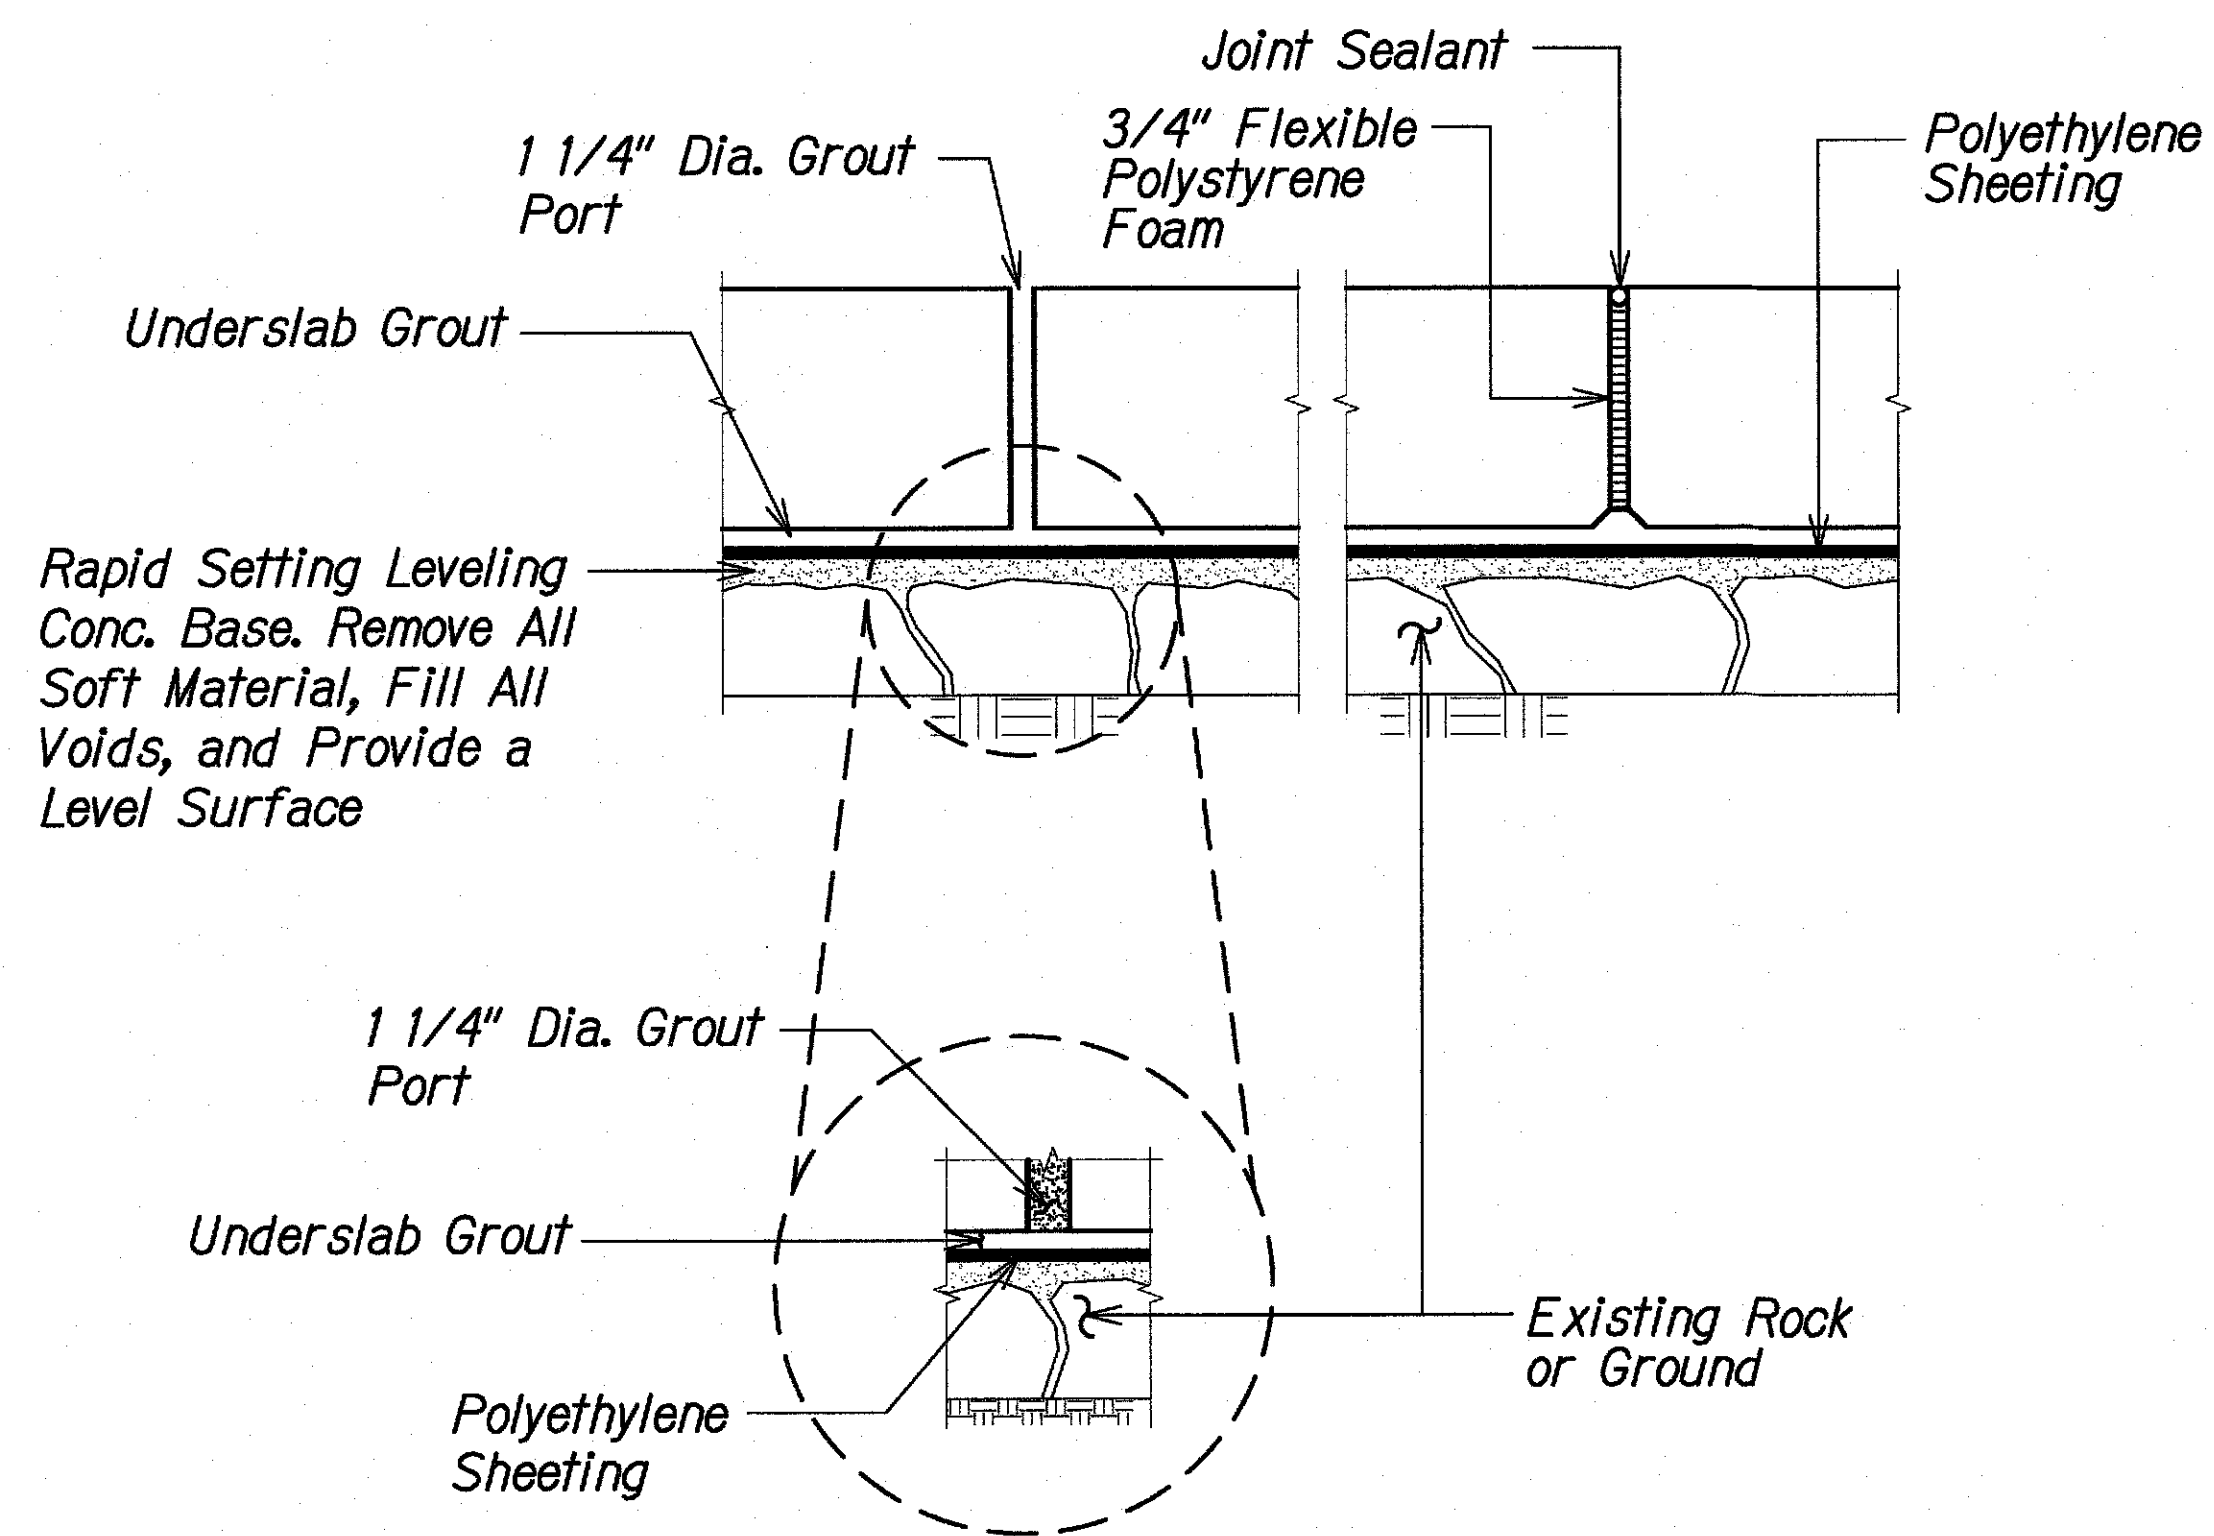

**GROUT PORT UNDERSLAB VOID, POLYETHYLENE SHEETING AND CTB** 2  
 Not to Scale SL3 SL3

|               |      |
|---------------|------|
| DESIGNED BY   | DATE |
| TRACED BY     | "    |
| DESIGNED BY   | "    |
| QUANTITIES BY | "    |
| CHECKED BY    | "    |
| ORIGINAL PLAN | No.  |

DRAWING NAME: 2A-00 ONCONING 18-008.5-KUHO HWY STREAM POC\01 CAD\10-12-20 MANOA AS-BUILT AC201\KHS-S0103 PCOP DETAILS.DWG PLOT TIME: 11-11-20, 9:45 AM

STATE OF HAWAII  
DEPARTMENT OF TRANSPORTATION  
HIGHWAYS DIVISION

**TYPICAL PRECAST SLAB**  
**DETAILS**

**KAUAI EMERGENCY FLOOD REPAIRS & CLEANUP**  
**At Various Locations April 2018, Rte. 560**  
**Proj. No. ER-19(001)**

Scale: As Noted Date: Oct. 2018

SHEET No. **SL3** OF **3** SHEETS