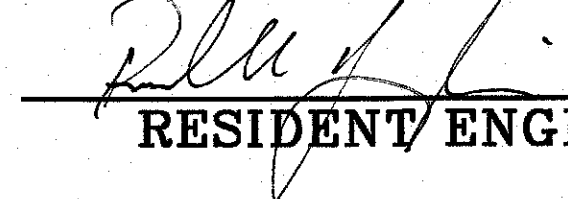


INDEX TO DRAWINGS	
SHT. NO.	DESCRIPTION
1	TITLE SHEET
2	STANDARD PLANS SUMMARY
3	GENERAL NOTES & ABBREVIATIONS
4 - 6	GENERAL NOTES
7 - 8	WATERLINE NOTES
9 - 11	WATER POLLUTION AND EROSION CONTROL NOTES
12	EROSION CONTROL DETAILS
13 - 15	CONSTRUCTION PHASING AND EROSION CONTROL
16	ROADWAY CONSTRUCTION
17	ROADWAY PROFILE N.I.C.
18	WATERLINE PLAN AND PROFILE
19	TRAFFIC CONTROL NOTES
20	TRAFFIC CONTROL PLAN
21	INDEX TO STRUCTURAL DRAWINGS
22 - 23	STRUCTURAL GENERAL NOTES
24	SYMBOLS AND ABBREVIATIONS
25	TYPICAL JPCP PANEL DETAILS
26 - 27	PRECAST SLAB DETAILS
28	PRECAST WATERLINE JACKET


TOTAL SHEET COUNT after "AS BUILT" postings.
27 Sheets.

LEGEND FOR AS-BUILT POSTINGS	
	Squiggly line for as-built deletion
	Double line for as-built deletion
Roadway	Text for as-built posting

CHANGES MADE DURING CONSTRUCTION HAVE BEEN INCORPORATED ON THESE PLANS EXCEPT CHANGES IN THE ORIGINAL THEORETICAL QUANTITIES. FOR ACTUAL QUANTITIES, REFER TO PROJECT LEDGER AND/OR COMPUTATION BOOK.


RESIDENT ENGINEER



1/11/21
DATE

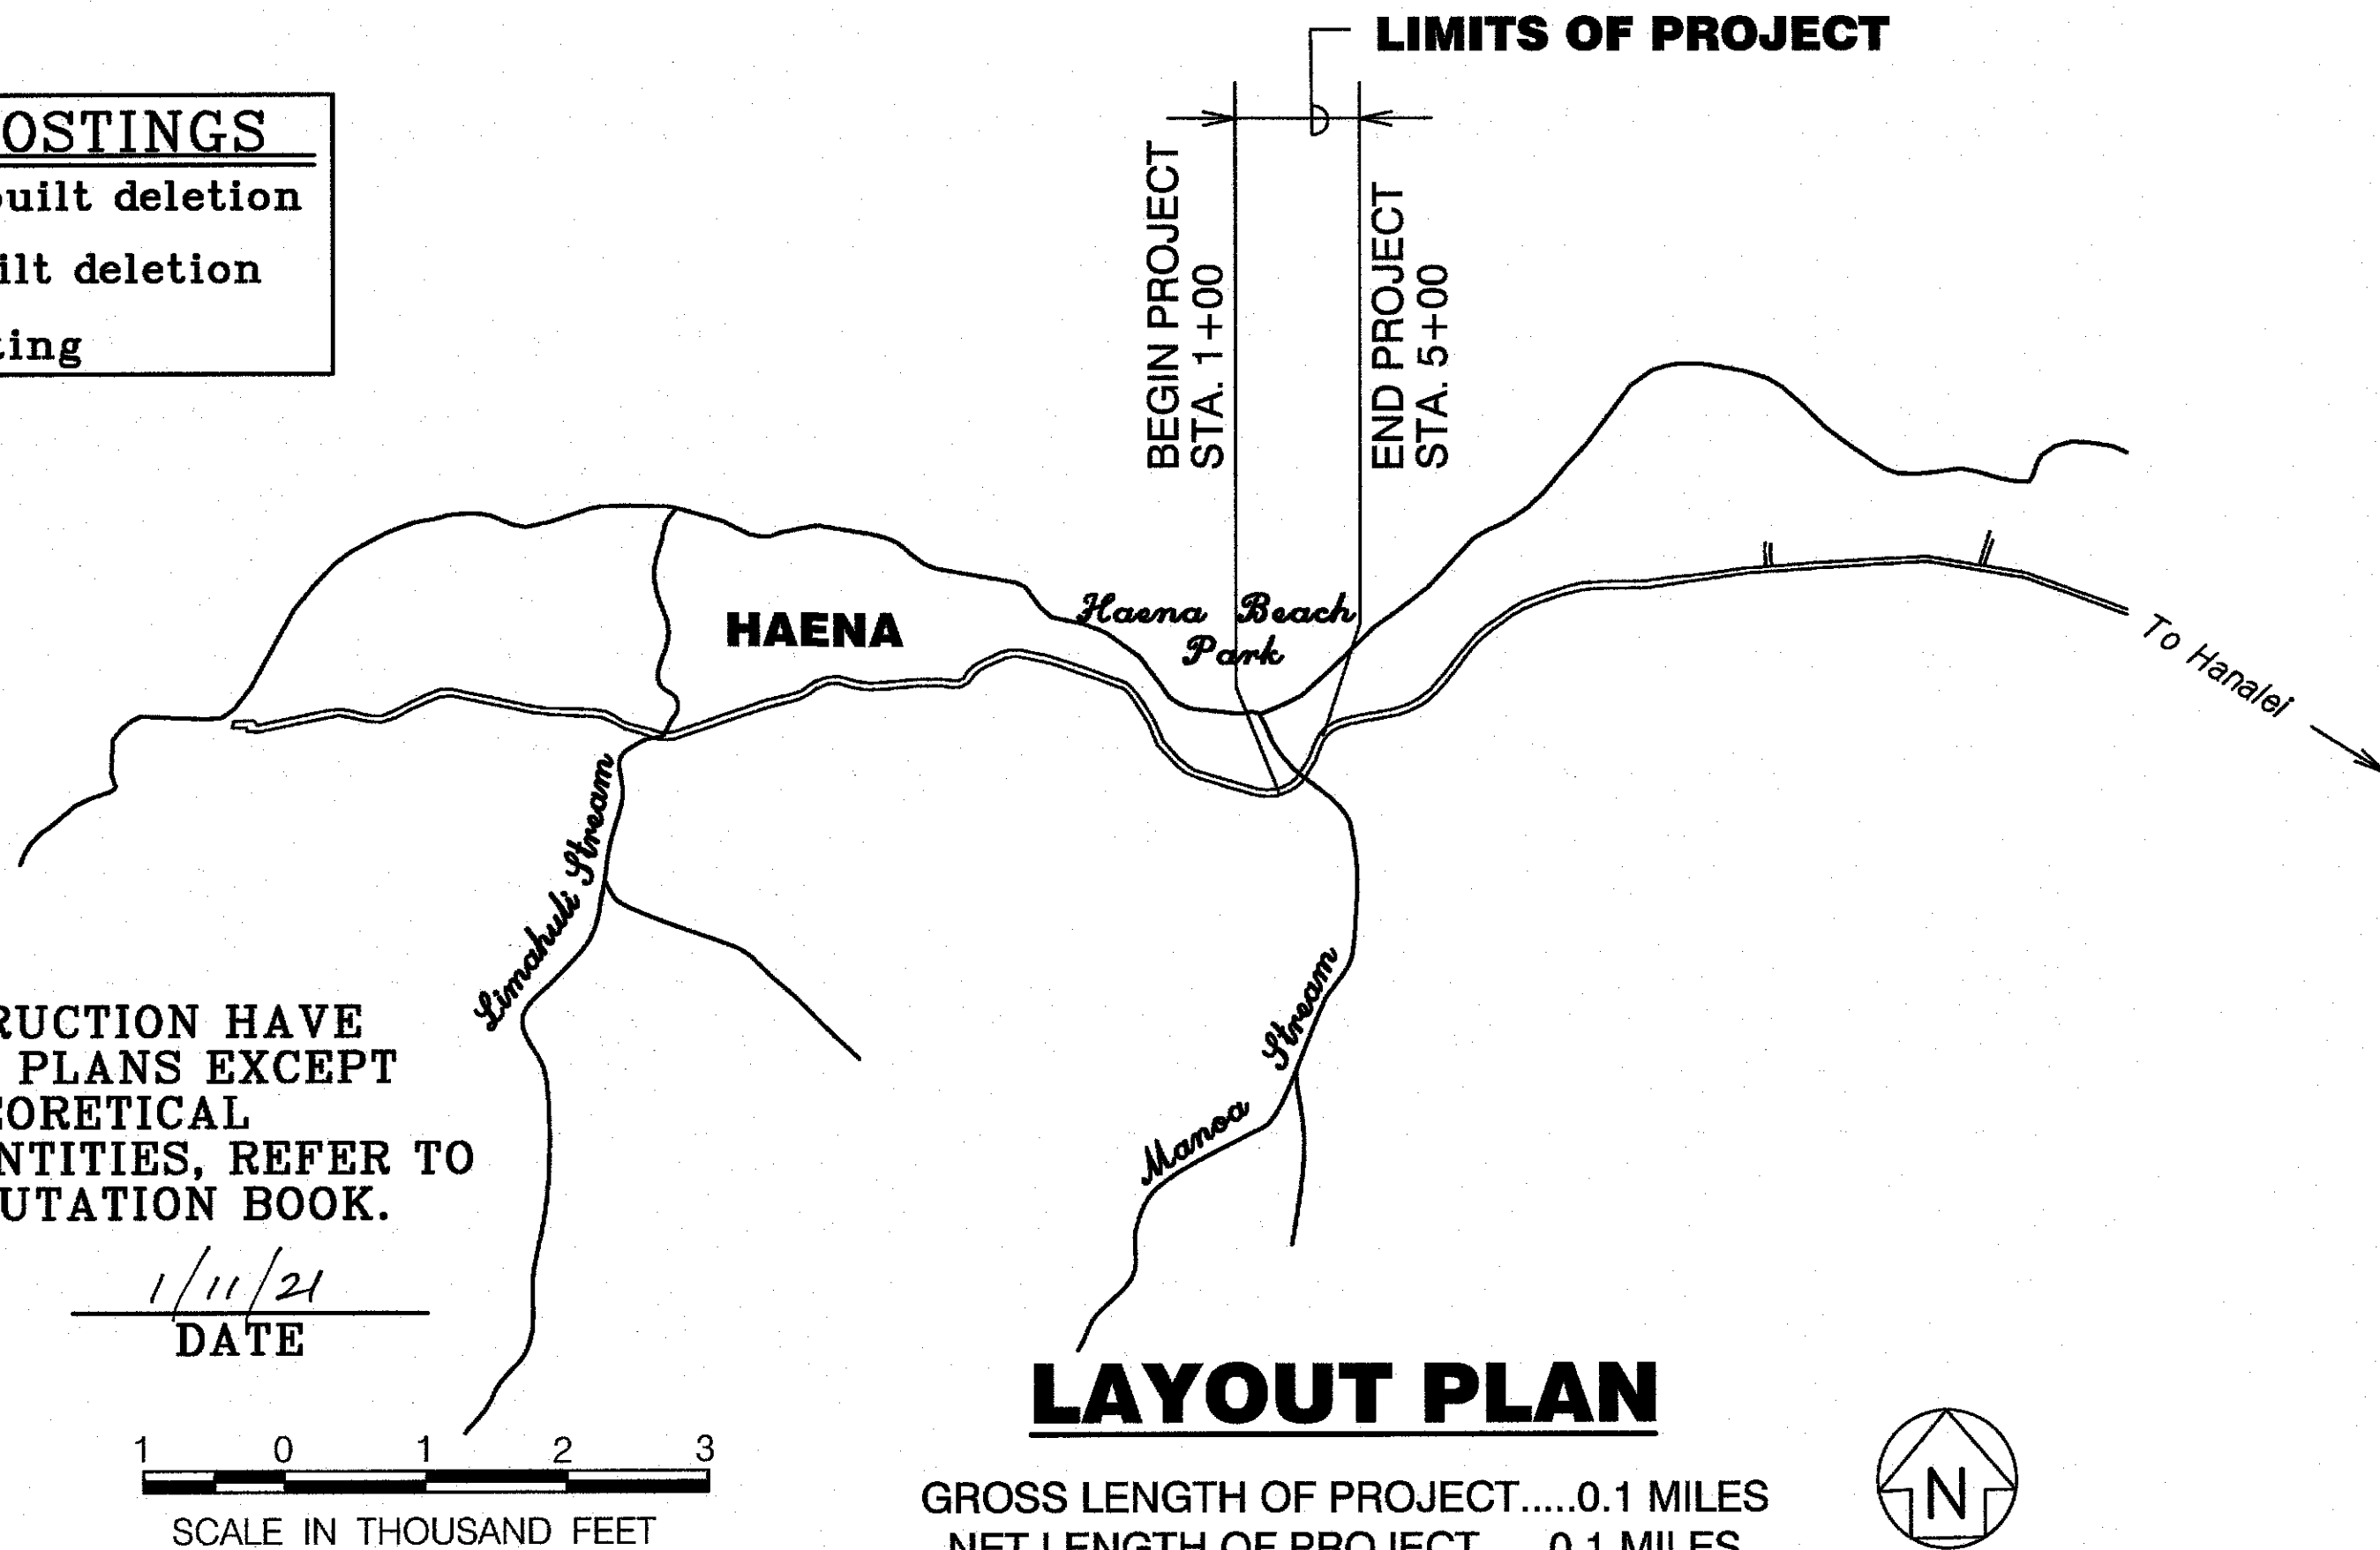

GROSS LENGTH OF PROJECT.....0.1 MILES
NET LENGTH OF PROJECT.....0.1 MILES

STATE OF HAWAII
DEPARTMENT OF TRANSPORTATION
HIGHWAYS DIVISION
HONOLULU, HAWAII
"AS-BUILT"
PLANS FOR
KUHIO HIGHWAY (ROUTE 560)
KAUAI EMERGENCY FLOOD REPAIR AND
CLEANUP AT VARIOUS LOCATIONS
APRIL 2018
IN THE VICINITY OF MILEPOST 8.7 TO 8.8
F. A. P. NO. ER-19(001)

FED. ROAD DIST. NO.	STATE	FEDERAL AID PROJ. NO.	FISCAL YEAR	SHEET NO.	TOTAL SHEETS
HAWAII	HAW.	ER-19(001)	2018	1	28

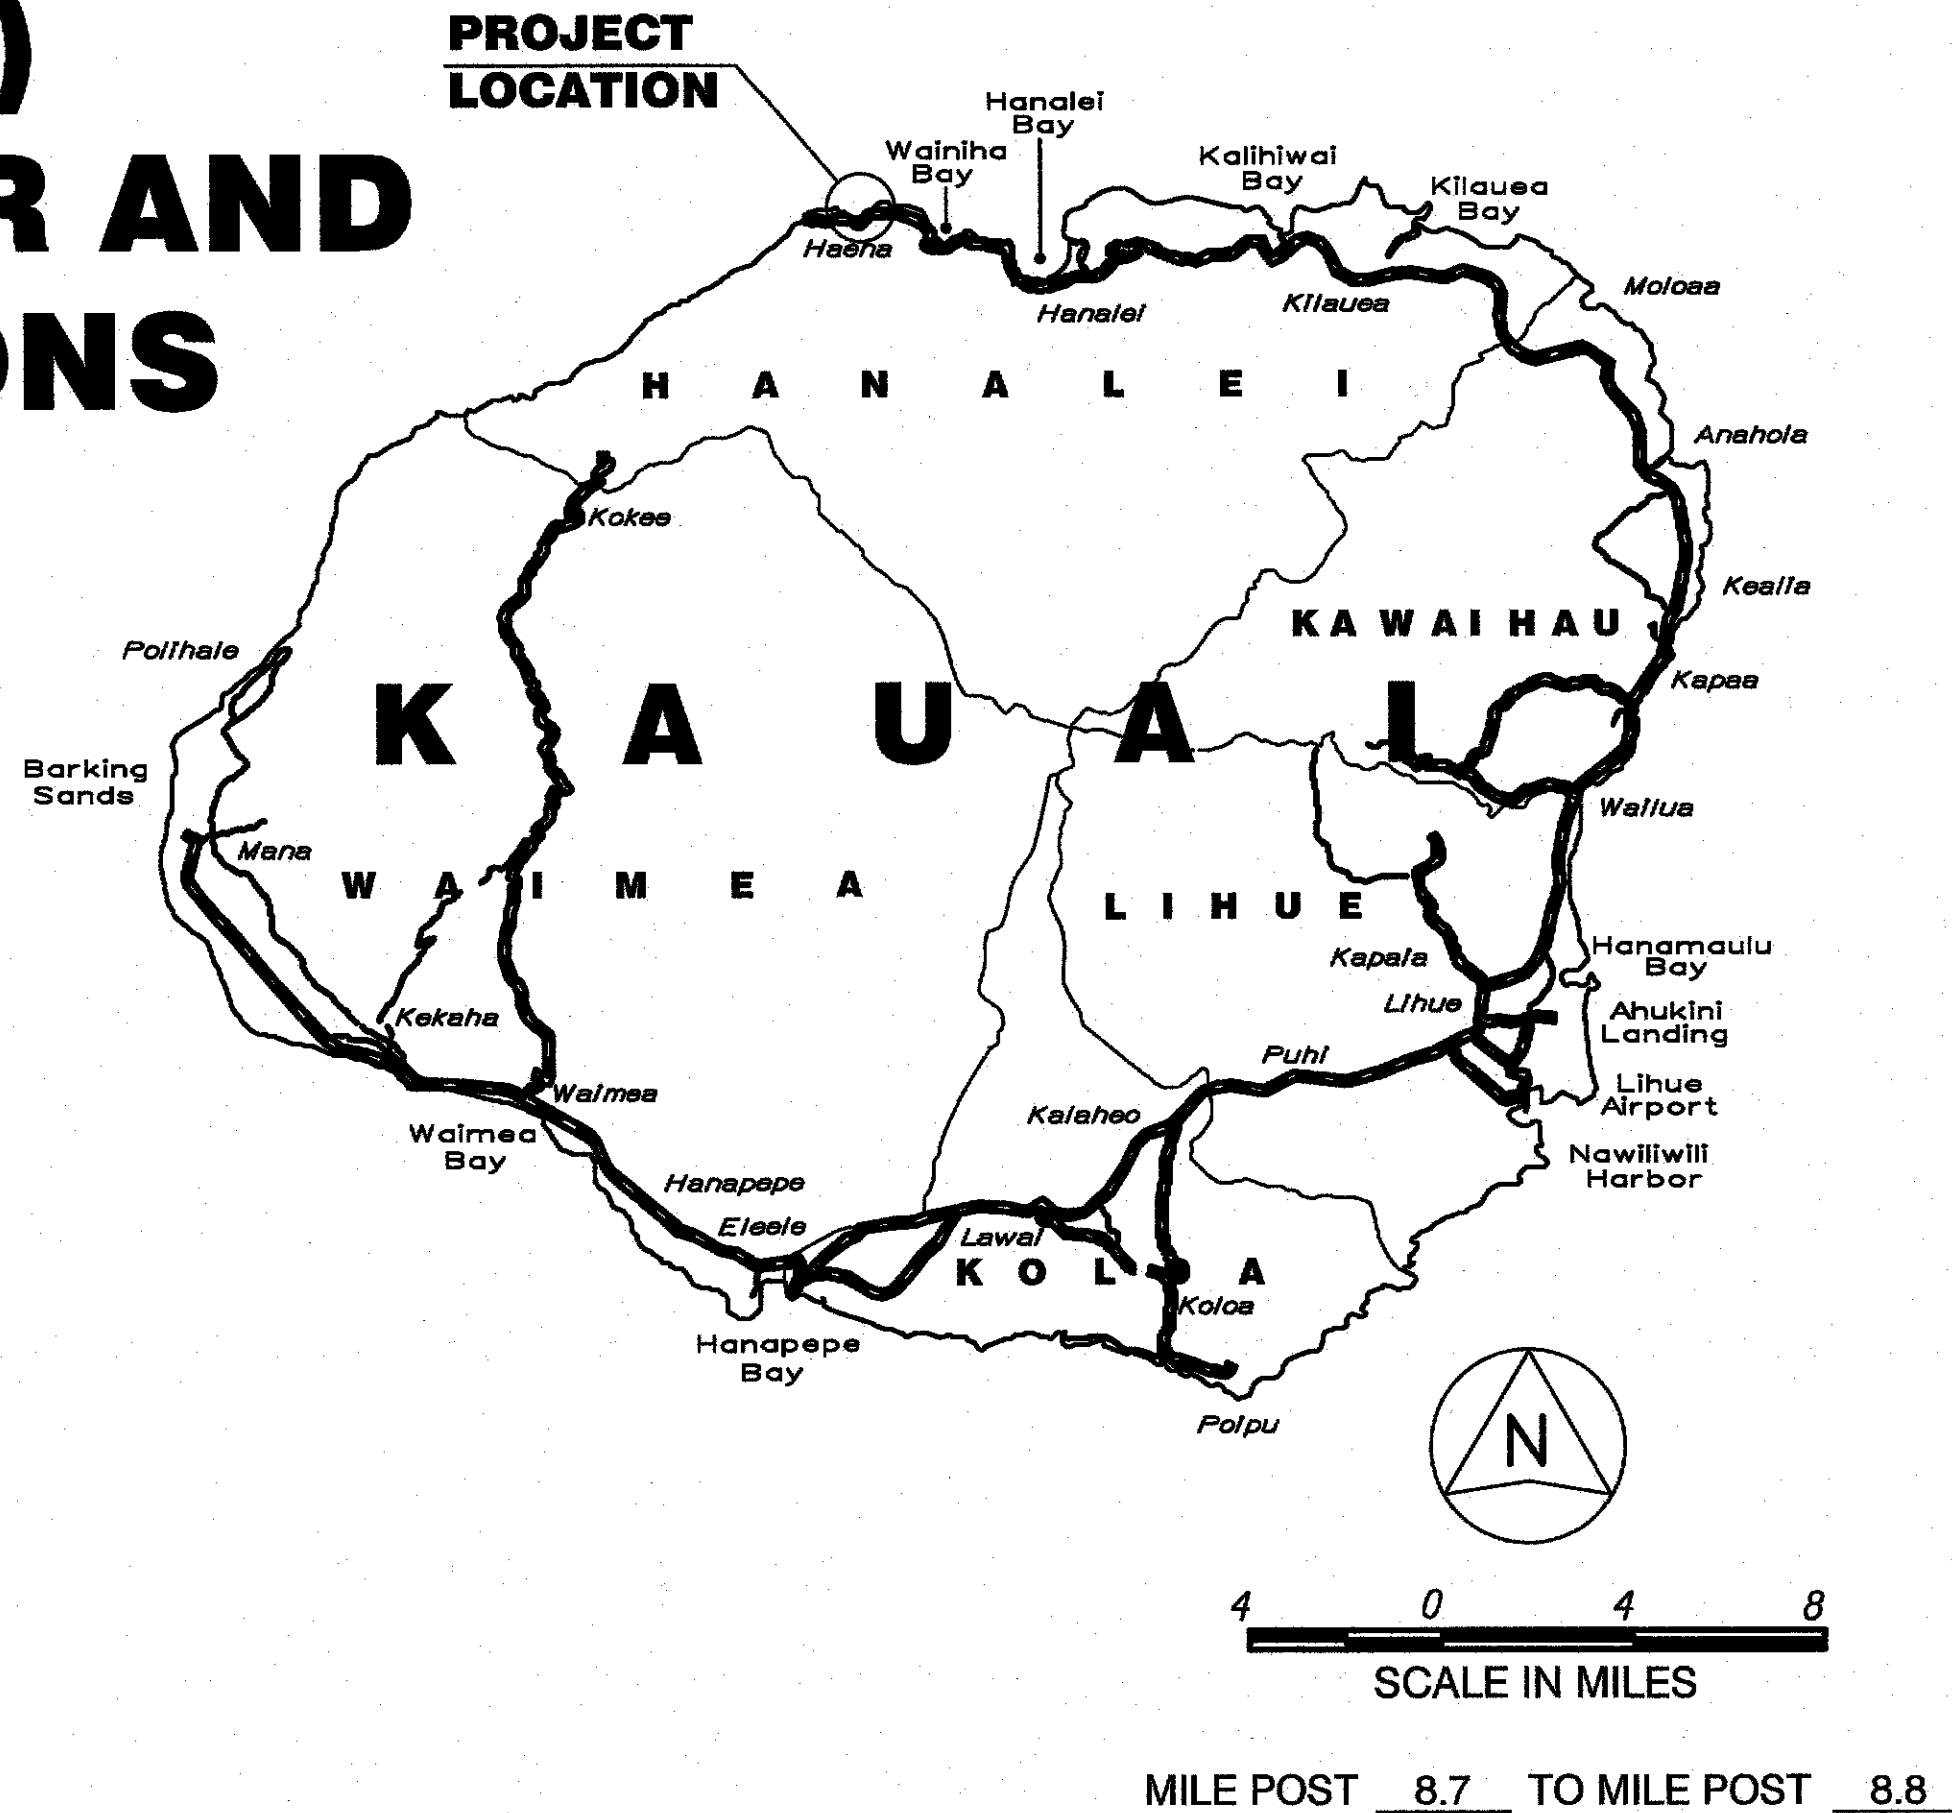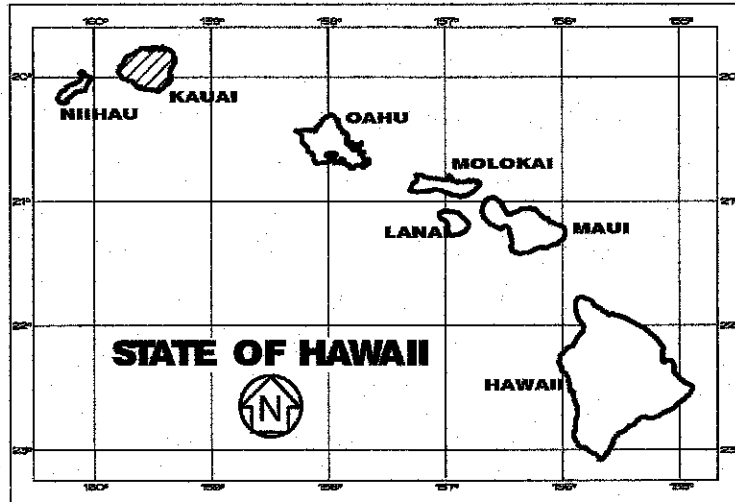

APPROVED:

MANAGER AND CHIEF ENGINEER
DEPARTMENT OF WATER
COUNTY OF KAUAI

DATE

DEPARTMENT OF TRANSPORTATION STATE OF HAWAII	
APPROVED:	
DIR. OF TRANSPORTATION	DATE

DESIGNED BY	DATE
DRAWN BY	
CHECKED BY	
NOTED BY	
DATE	

WSP USA INC. DESIGNED BY
HWY-K MANAGED BY
241-3000 PHONE
SEPT 2018 DATE