


FED. ROAD DIST. NO.	STATE	FED. AID PROJ. NO.	FISCAL YEAR	SHEET NO.	TOTAL SHEETS
HAWAII	HAW.	5-0500(1) UNIT 2	1966	39	43

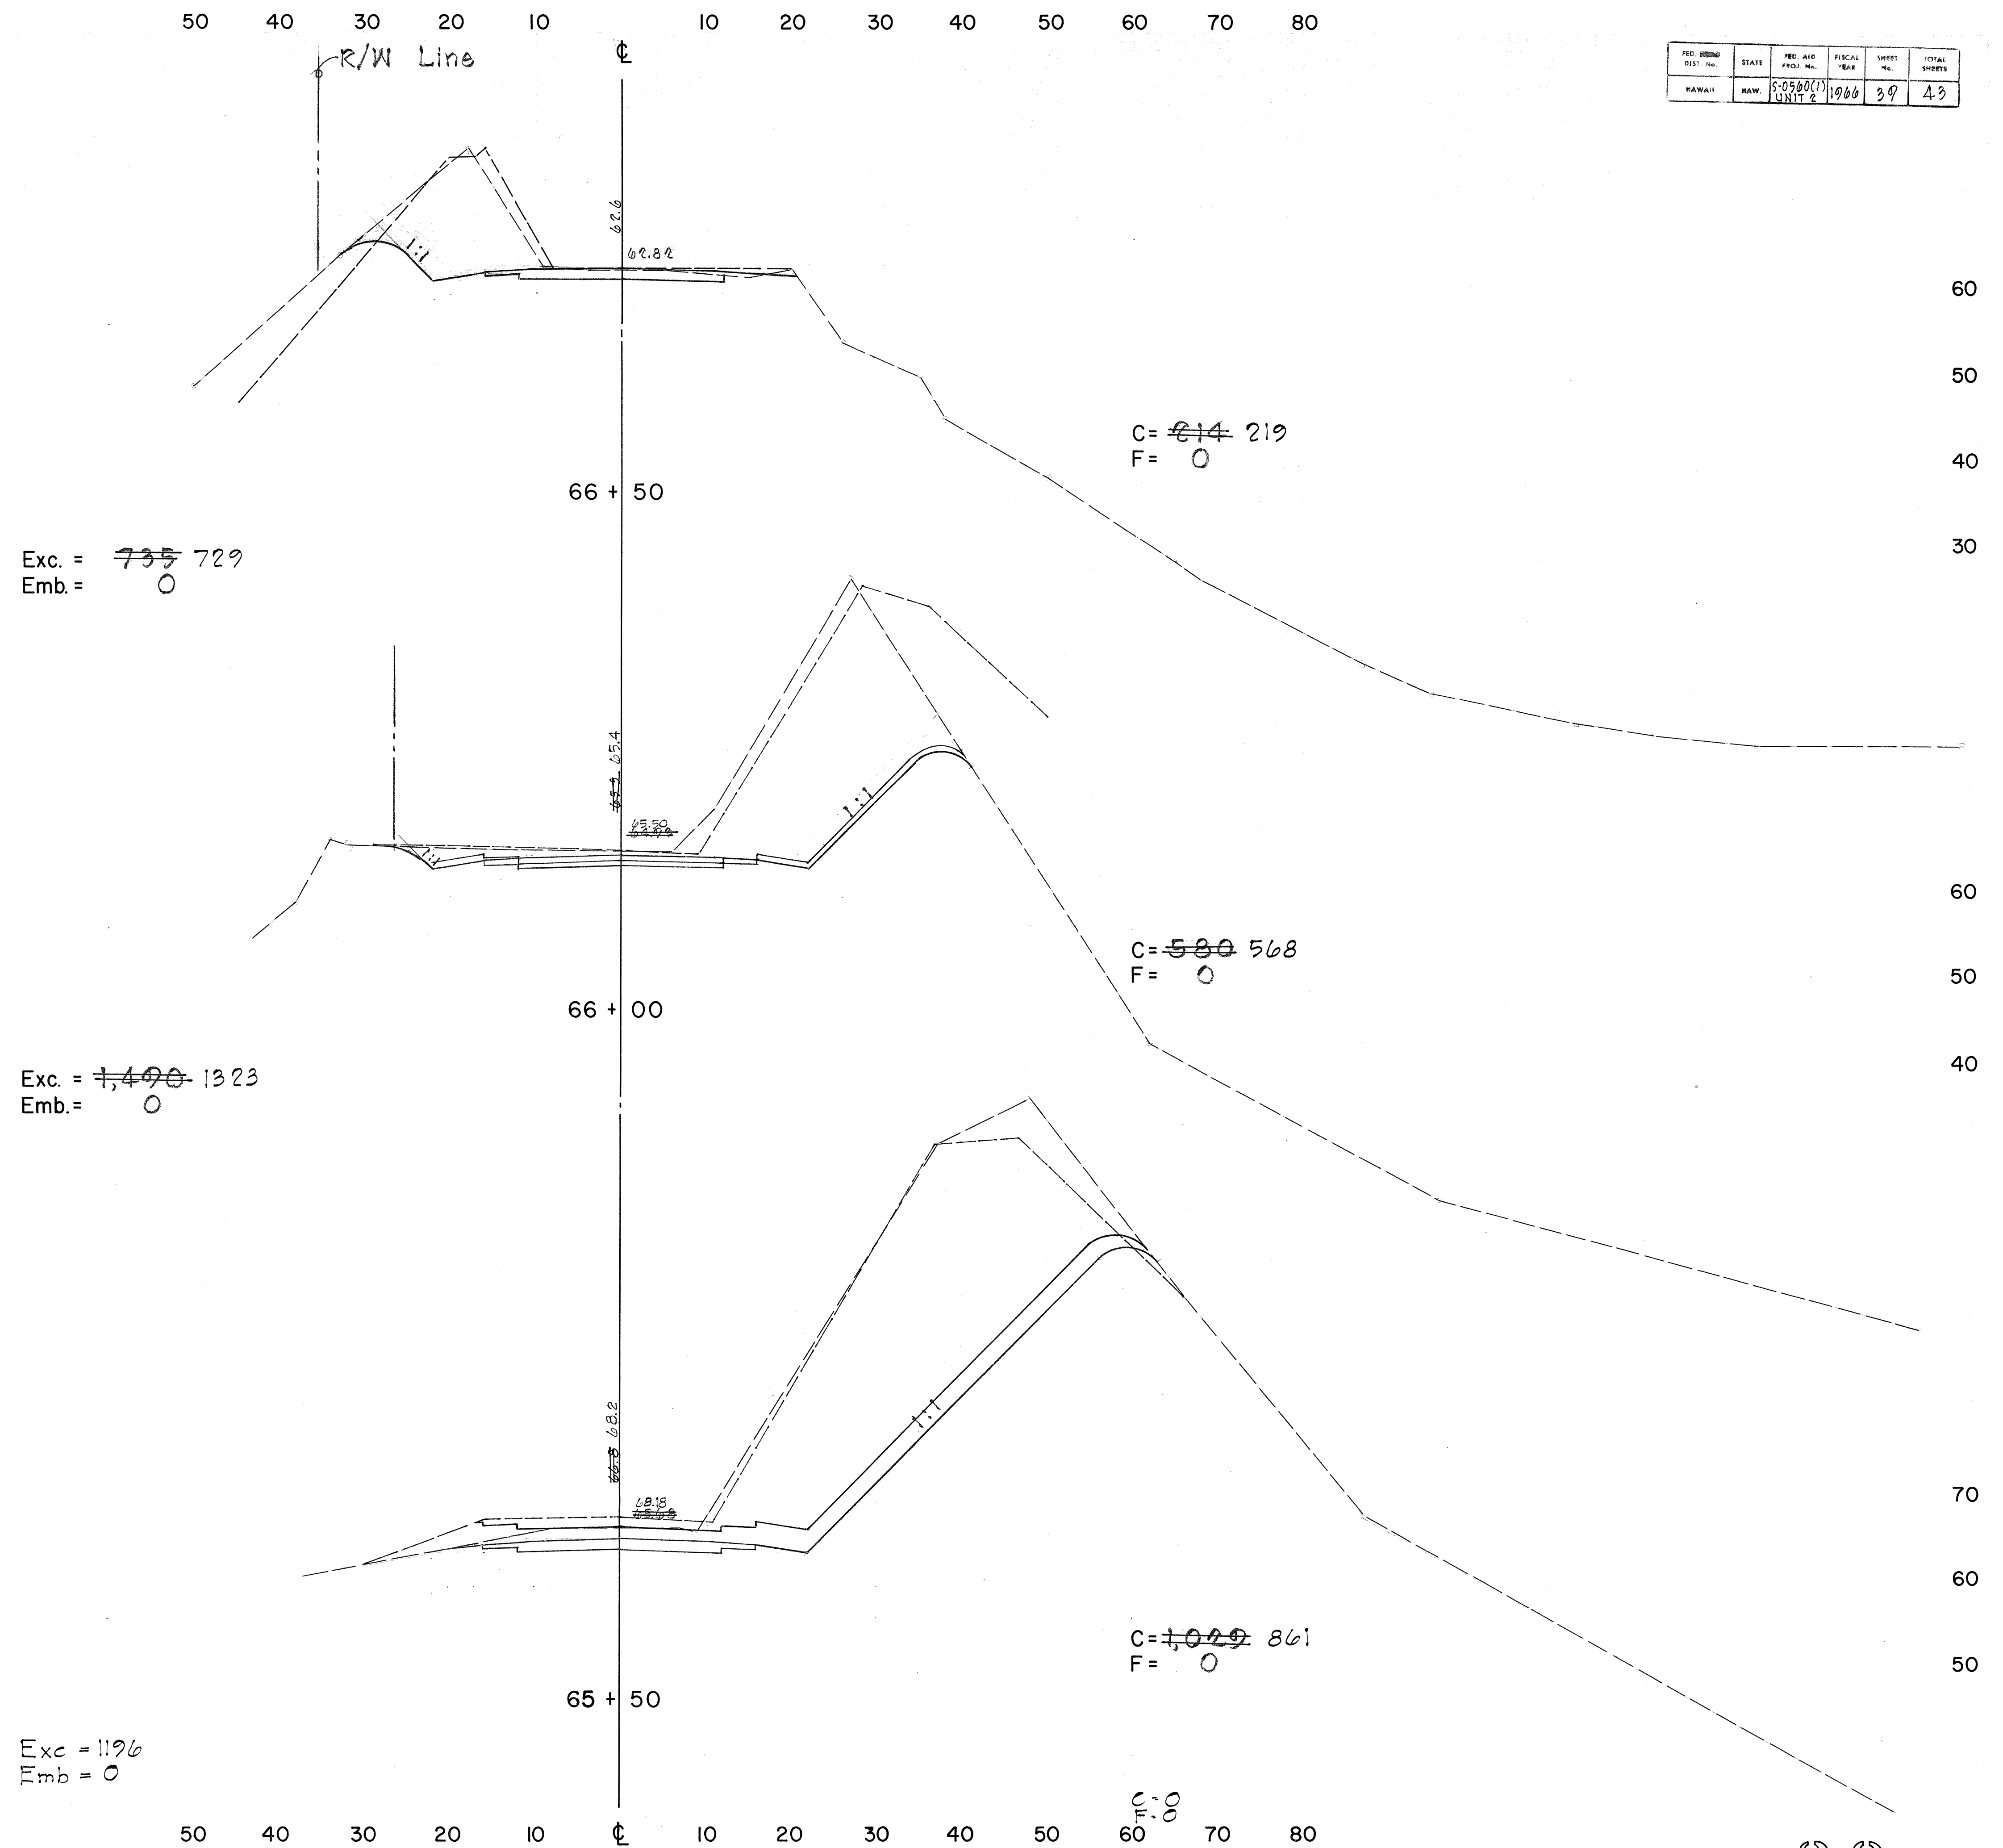

FED. ROAD DIST. NO.	STATE	FED. AID PROJ. NO.	FISCAL YEAR	SHEET NO.	TOTAL SHEETS
HAWAII	HAW.	5-0500(1)	1966	40	49
UNIT 2					

Exc. = ~~2,501~~ 2,507
Emb. = 0

Exc. = ~~1,105~~ 1,201
Emb. = 0

Exc. = ~~632~~ 656
Emb. = 0


C = ~~801~~ 807
F = 0


Exc. = ~~4,558~~ 4,638
Emb. = 0

C = ~~460~~ 490
F = 0

C = ~~3,042~~ 3,108
F = 0

C = ~~1,880~~ 1,901
F = 0

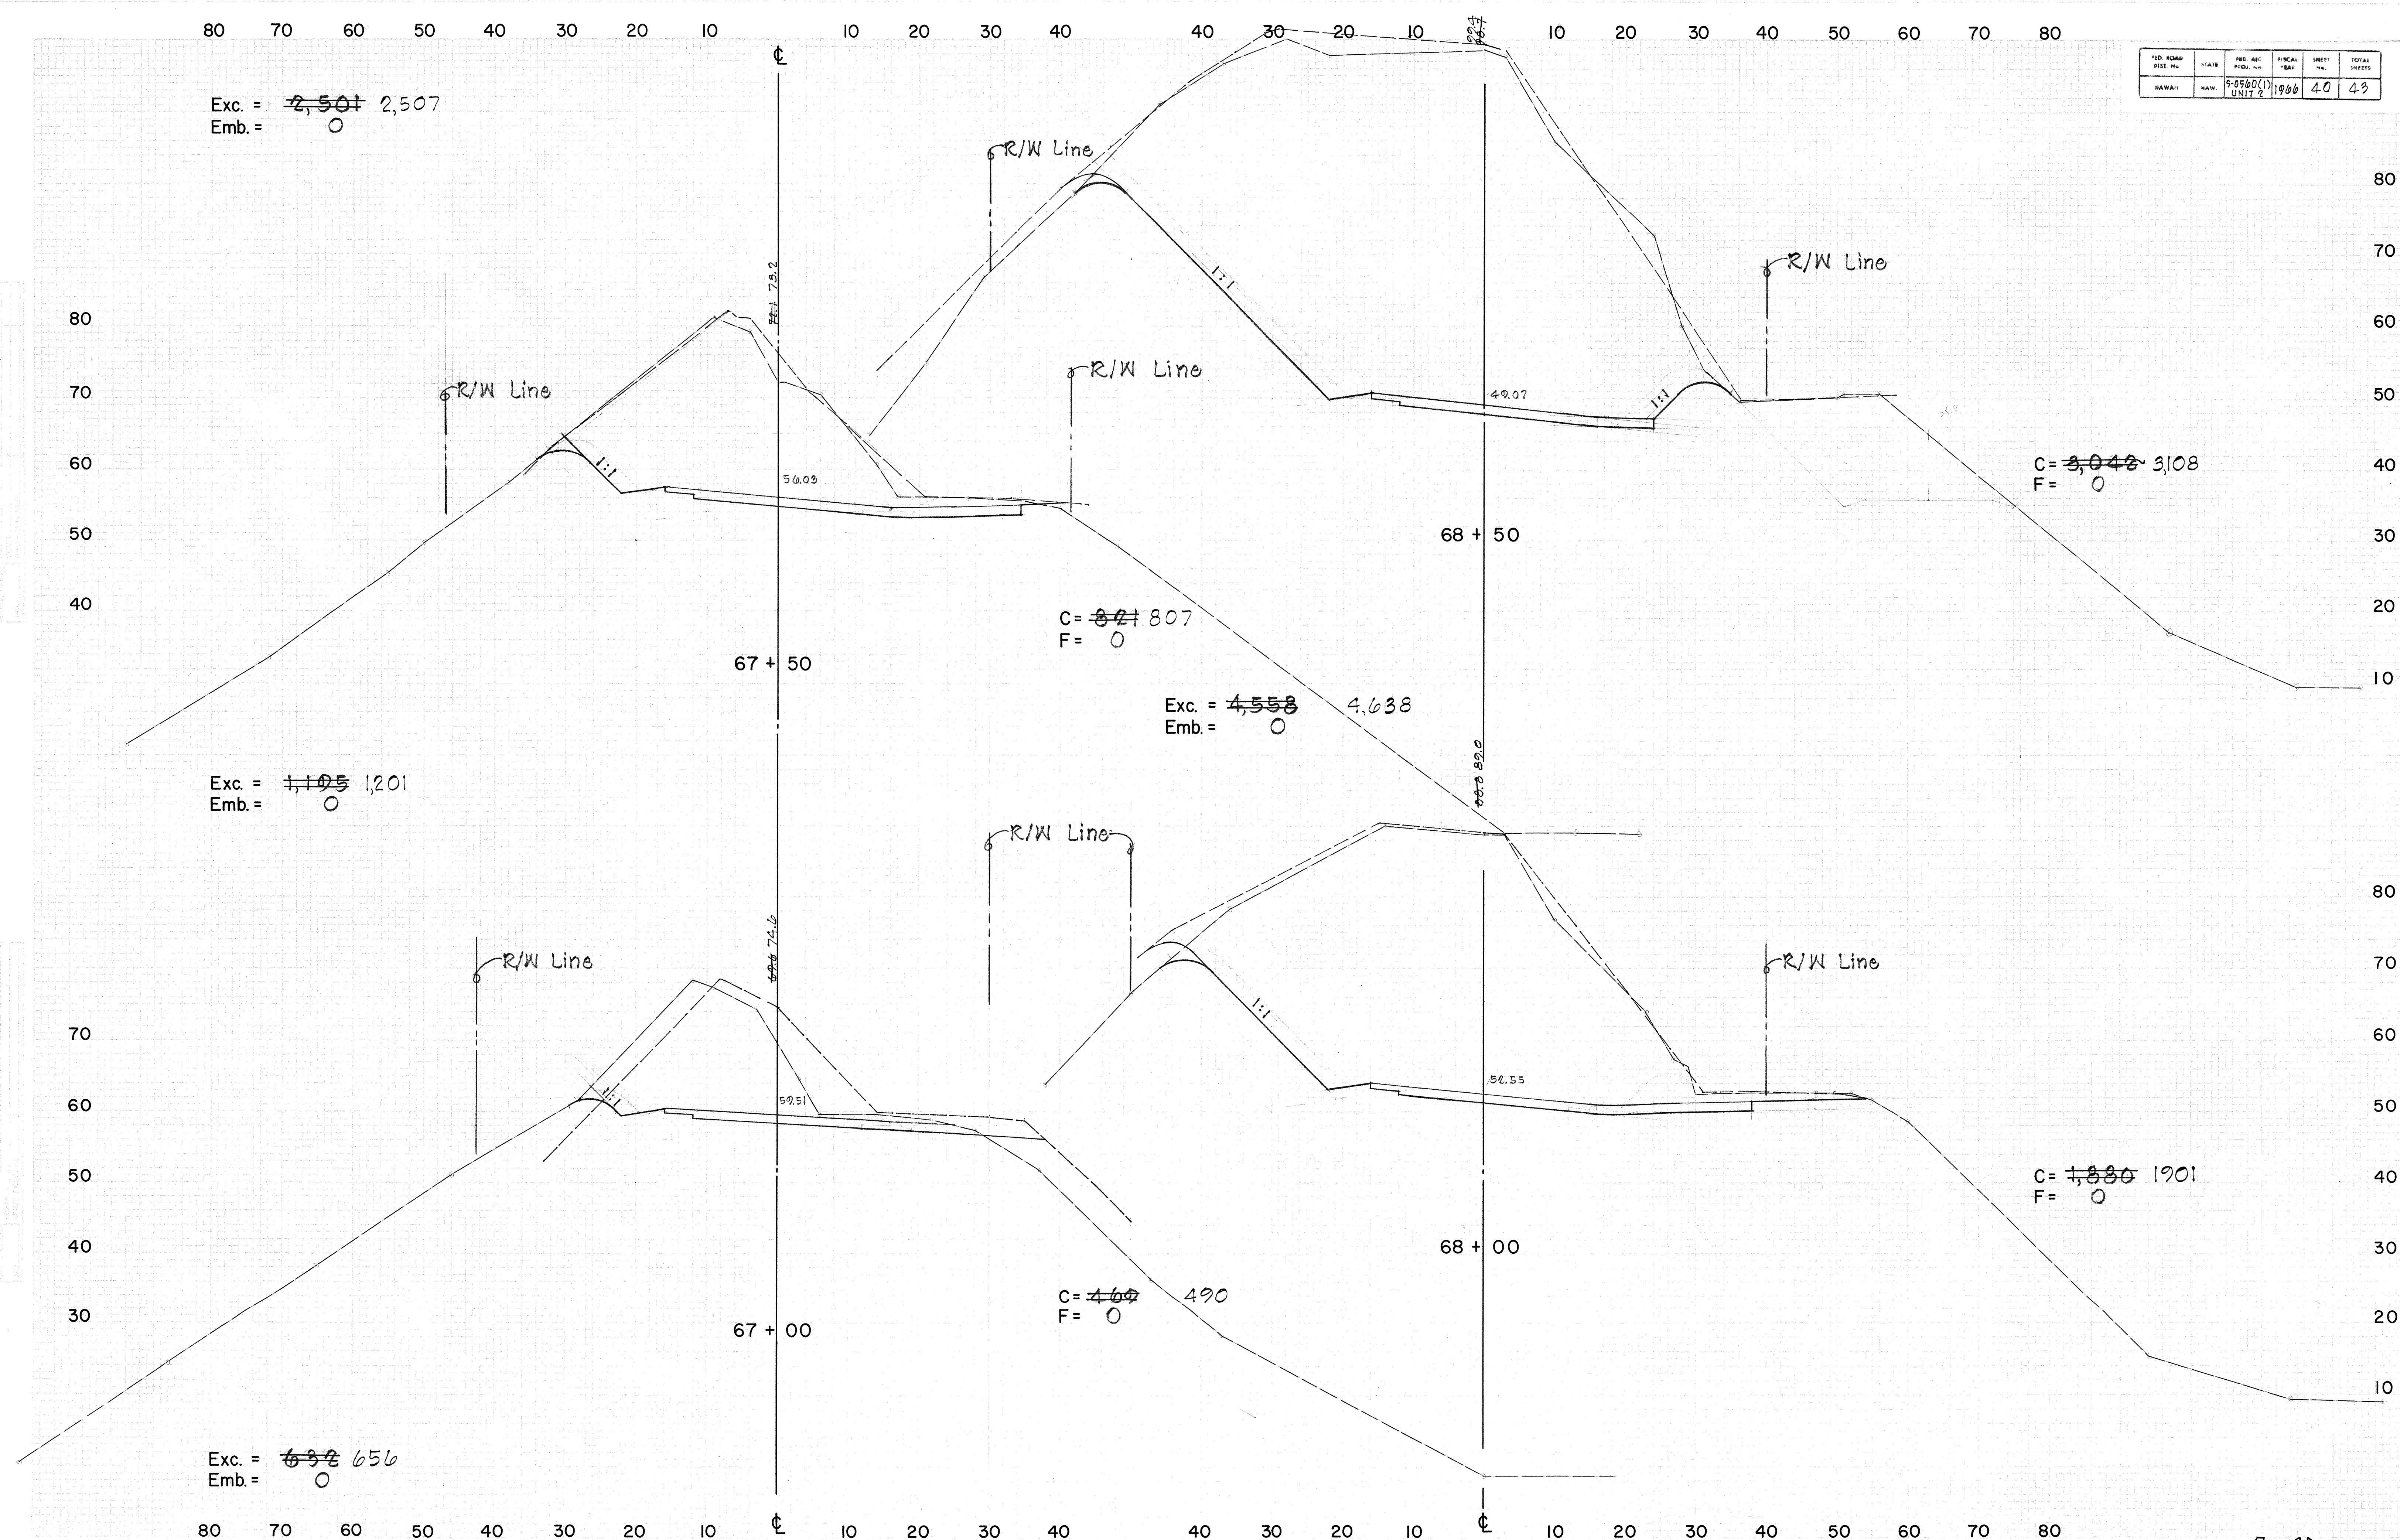

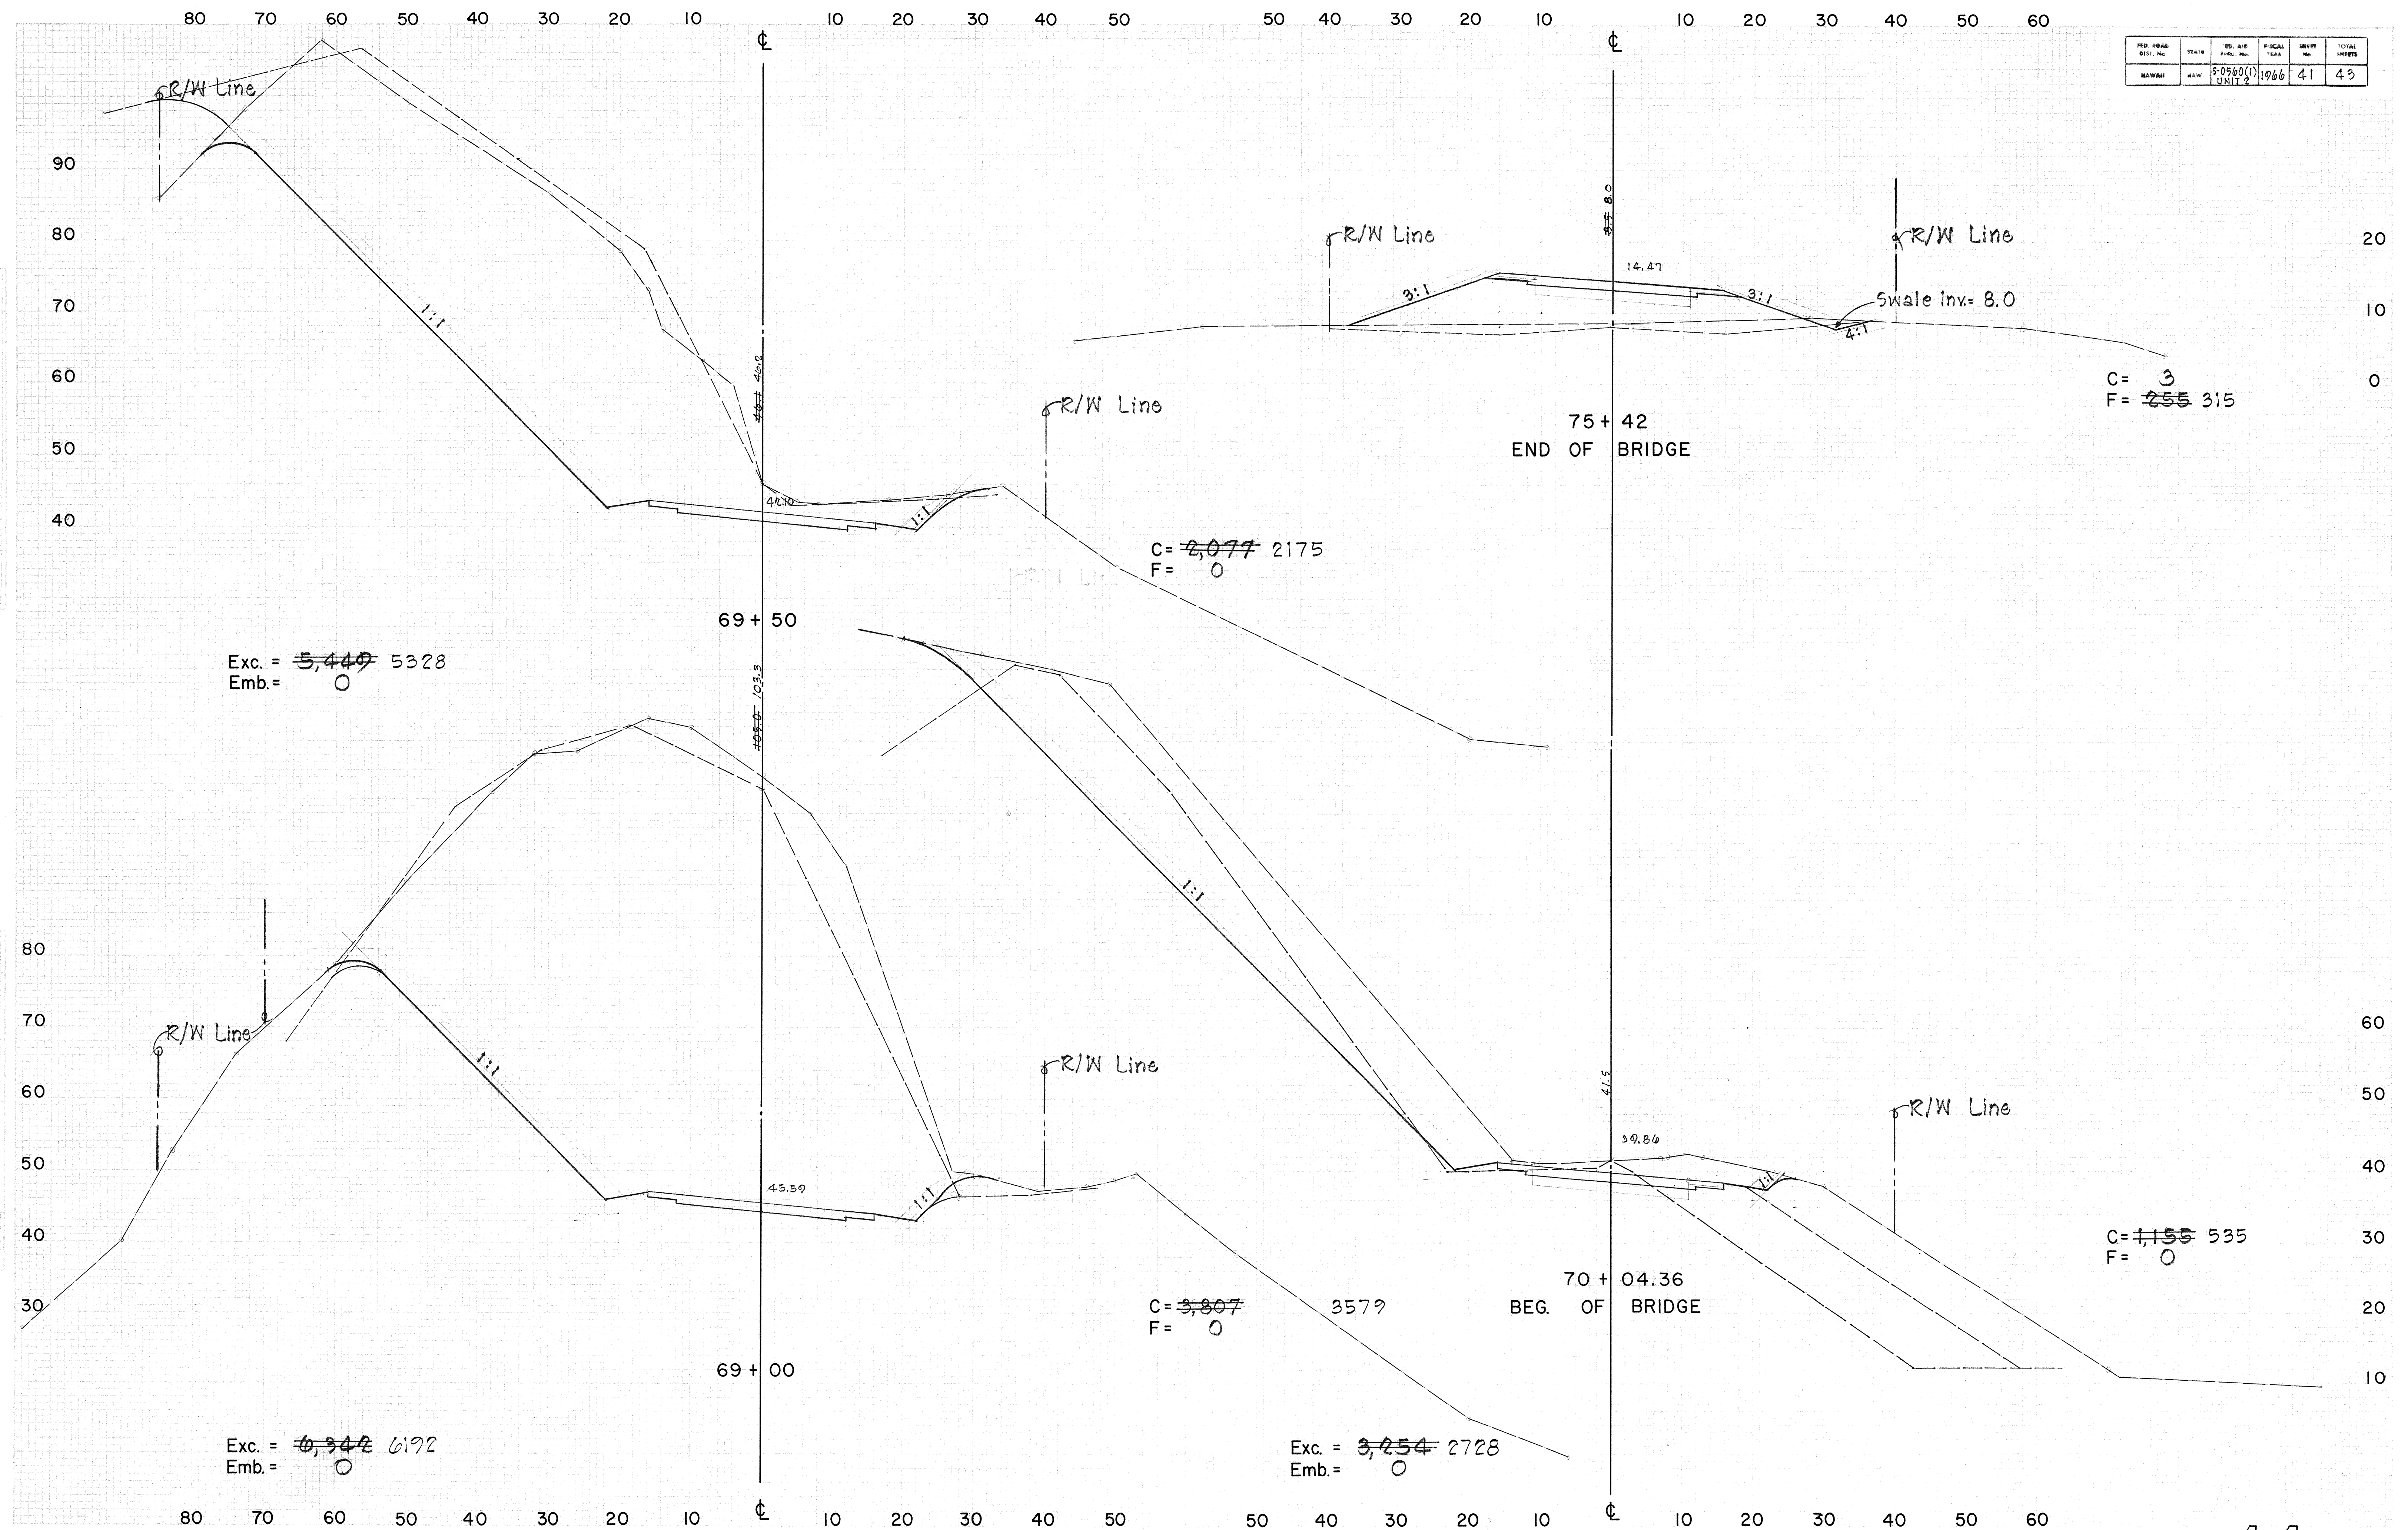

FED. ROAD DIST. NO.	STATE	FISCAL YEAR	PROJECT NO.	SHEET NO.	TOTAL SHEETS
HAWAII	HAW.	5-0560(1)	UNIT 2	42	43

NO.	AREA	AREA	AREA	AREA	AREA
1	1	1	1	1	1
2	2	2	2	2	2
3	3	3	3	3	3
4	4	4	4	4	4
5	5	5	5	5	5
6	6	6	6	6	6
7	7	7	7	7	7
8	8	8	8	8	8
9	9	9	9	9	9
10	10	10	10	10	10

NO.	AREA	AREA	AREA	AREA	AREA
1	1	1	1	1	1
2	2	2	2	2	2
3	3	3	3	3	3
4	4	4	4	4	4
5	5	5	5	5	5
6	6	6	6	6	6
7	7	7	7	7	7
8	8	8	8	8	8
9	9	9	9	9	9
10	10	10	10	10	10

