

GENERAL NOTES:

- All azimuths are referred to "Pooku" Δ
- Monuments shall be installed according to R/W data.
- All existing pavement over which embankments are to be constructed shall be scarified. (Incidental to Roadway Excavation)
- It is intended to only show the general alignment of the Side Rd. at Station 69+25 Rt. The exact alignment and grades to be determined by the Engineer in the field. (Worksheet filed at Dept. of Transportation, Highways Division and Kauai District Office)

Sta. 64+75 (Temporary Connection)

Construct smooth and easy riding connection to existing pavement.

Sta. 69+25 Rt.

Construct Side Road and Approaches as shown

Estimated Quantities

Exc. = 1,903 c.y.
Emb. = 1,903 c.y.
A.C. Area = 42 s.y.
B.C. Area = 52 s.y.
Select Borrow = 128.5 Ton

Sta. 70+04.36 to 75+42

Construct Lumahai River Bridge. For Details, see Sht. Nos. 13 to 38 inclusive.

UTILITY NOTES:

- Asterisk (*) indicates work to be done by the Contractor. Materials to be furnished by the Utility Company (H.T.Co.), unless otherwise noted on the Plans and/or Specifications.
- All work on removal of existing poles and installation of new poles to be done by the Hawaiian Telephone Company.

SYMBOLS:

- New Pole
- New Pole and Anchor
- ✕ Existing Pole to be removed


Reset existing Route Markers to Sta. 70+00 Lt. and Rt. 2-Each

APPROVED:

12-8-66
OUTSIDE PLANT ENGINEER, HTCO. LTD. DATE

CURVE DATA					
CIRC.	10	20	SPIRAL	15	25
Δ	36° 06' 00"	38° 58' 42"	0°	8° 57' 11"	5° 58' 07"
R	800	1200	Ls	250	250
T	240.71	424.69	Lc	249.73	249.88
C	495.75	800.71	Xc	249.39	249.73
L	504.01	816.36	Yc	13.00	8.68
			Lt	166.88	160.76
			St	83.53	83.42
			K	124.90	124.96
			P	3.25	2.17

SECTION "A-A" (DIRECT BURIAL) Scale: 1"=1'-0"


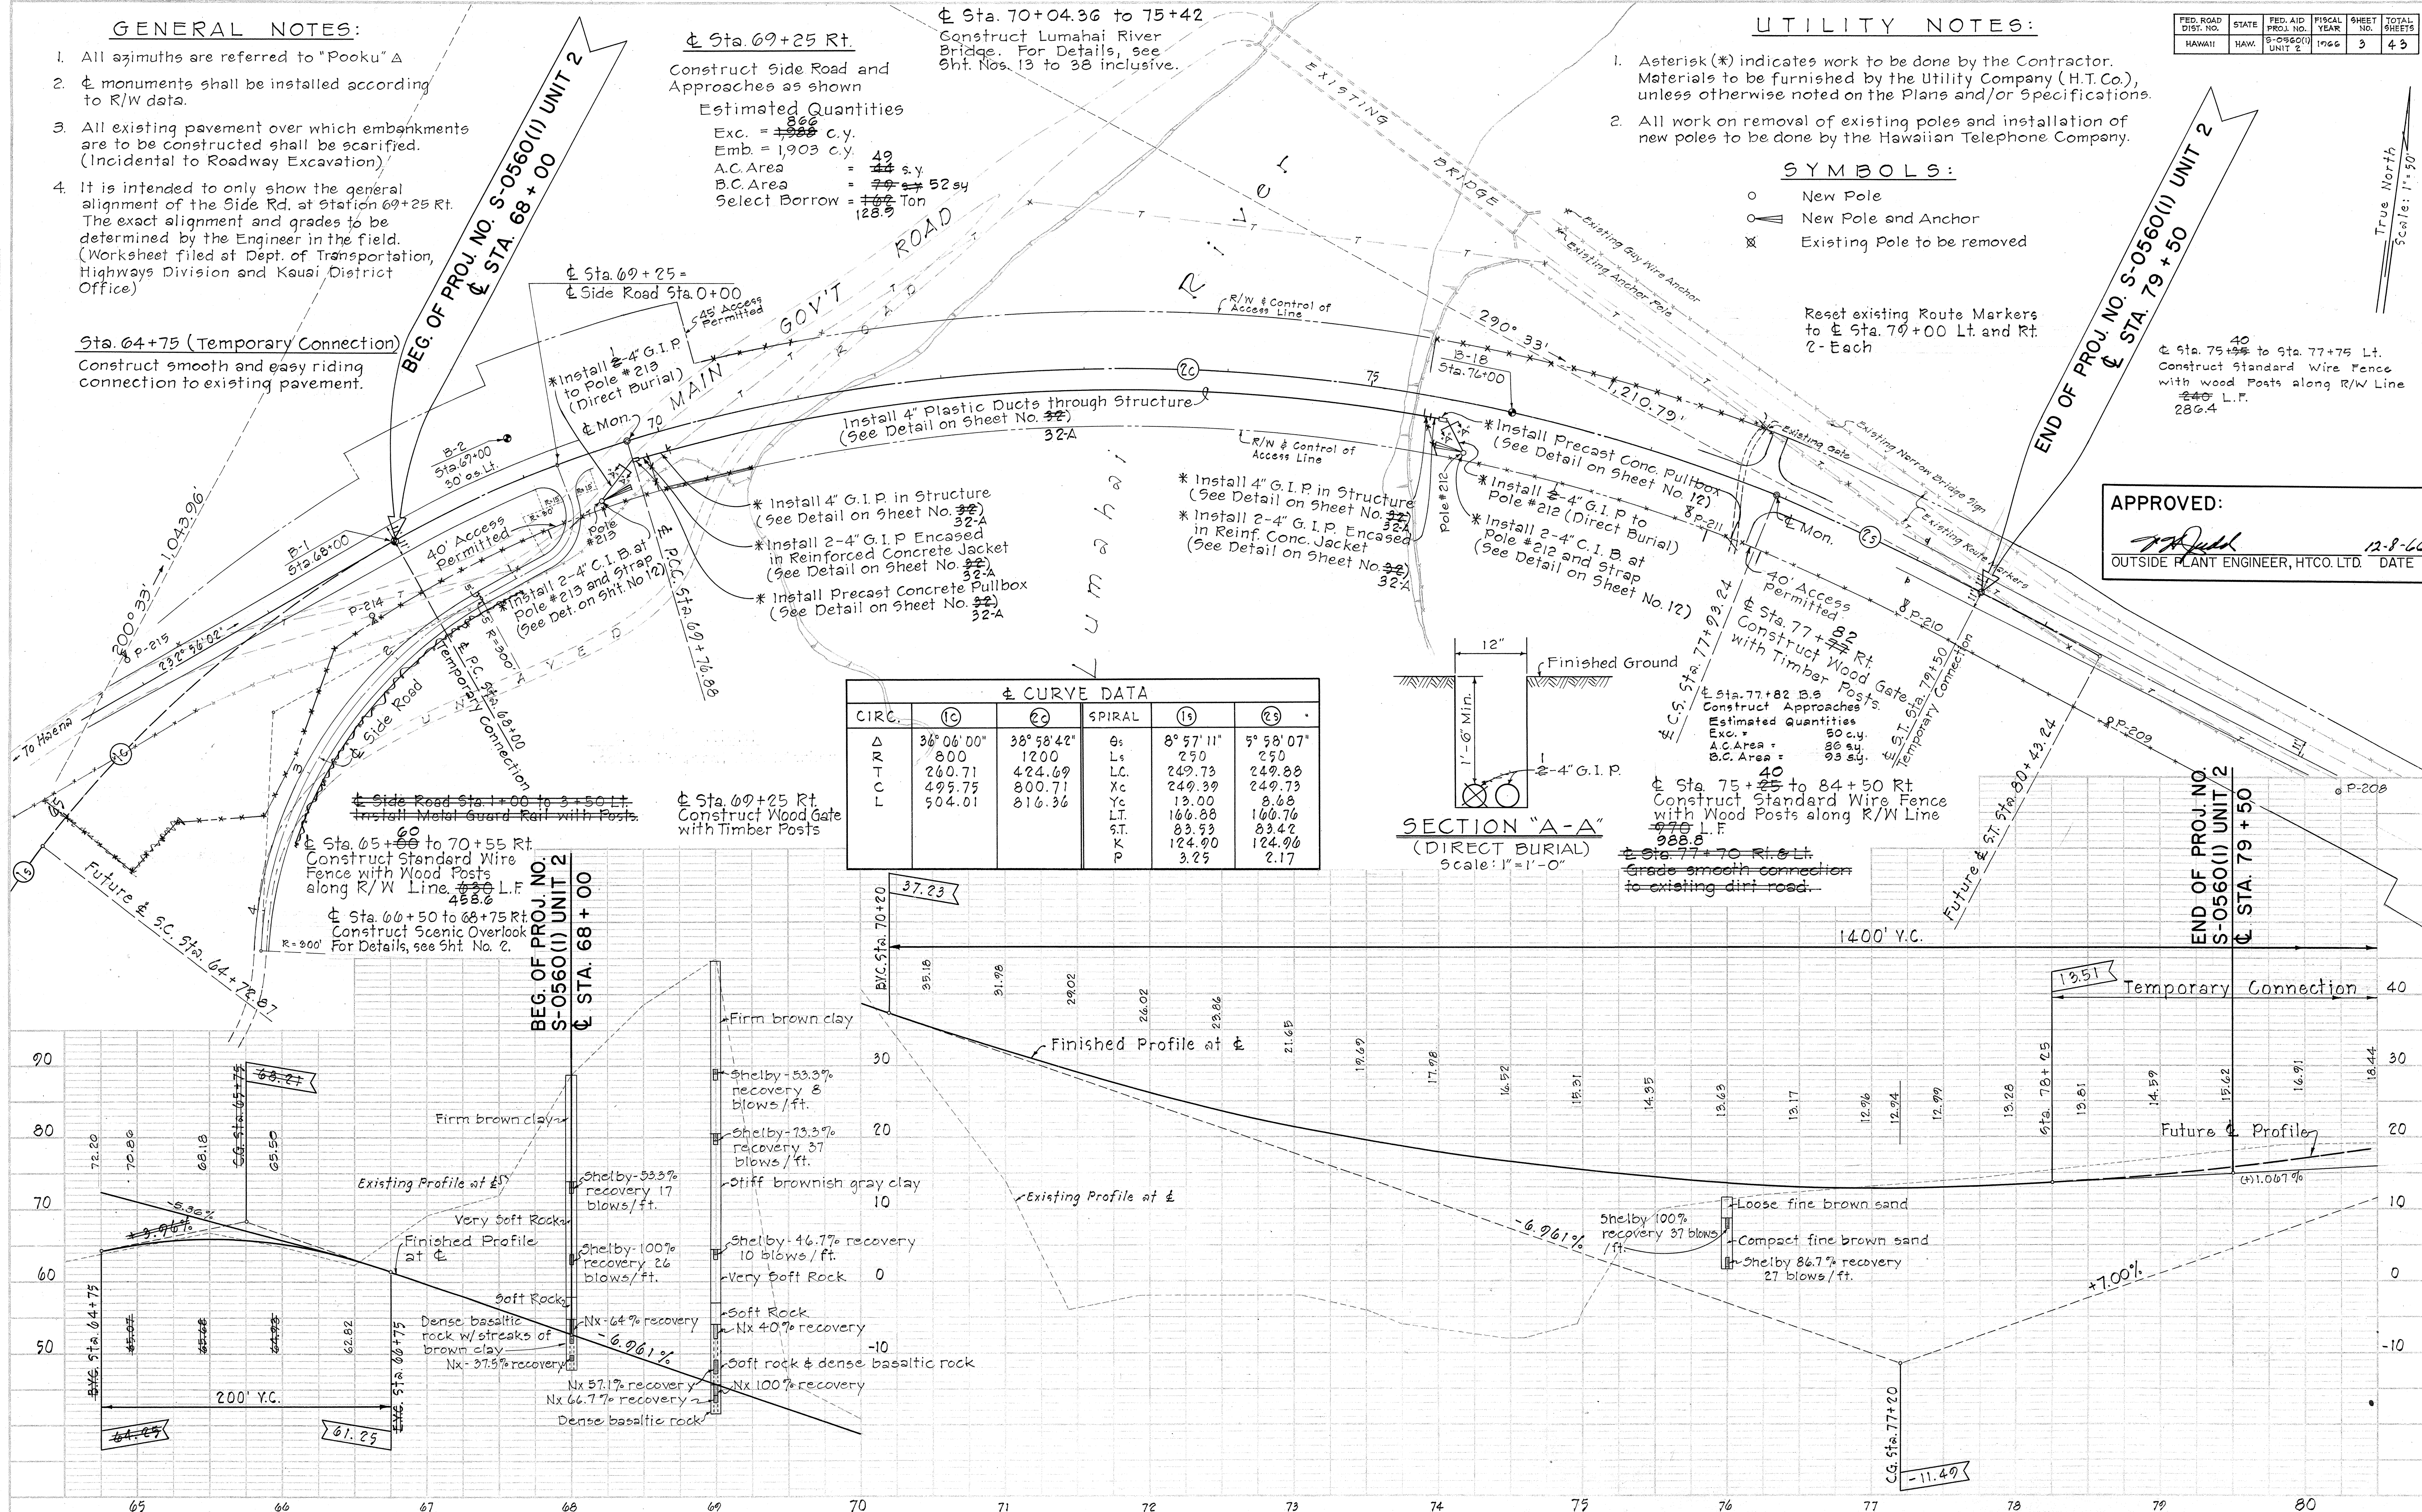


DATE	BY	REVIEWED	DATE

DATE	BY	REVIEWED	DATE

PLAN	DATE	BY	CHKD.
SURVEYED			
NOTED			
NOTE BOOK			
ALIGNED			
CHECKED			
RT. OF WAY			
CHECKED			
NO.			

PROFILE	DATE	BY	CHKD.
SURVEYED			
NOTED			
NOTE BOOK			
GRADES			
CHECKED			
3. M.F. NOTED			
STRUCTURE			
NOTARY			
CHECKED			
NO.			

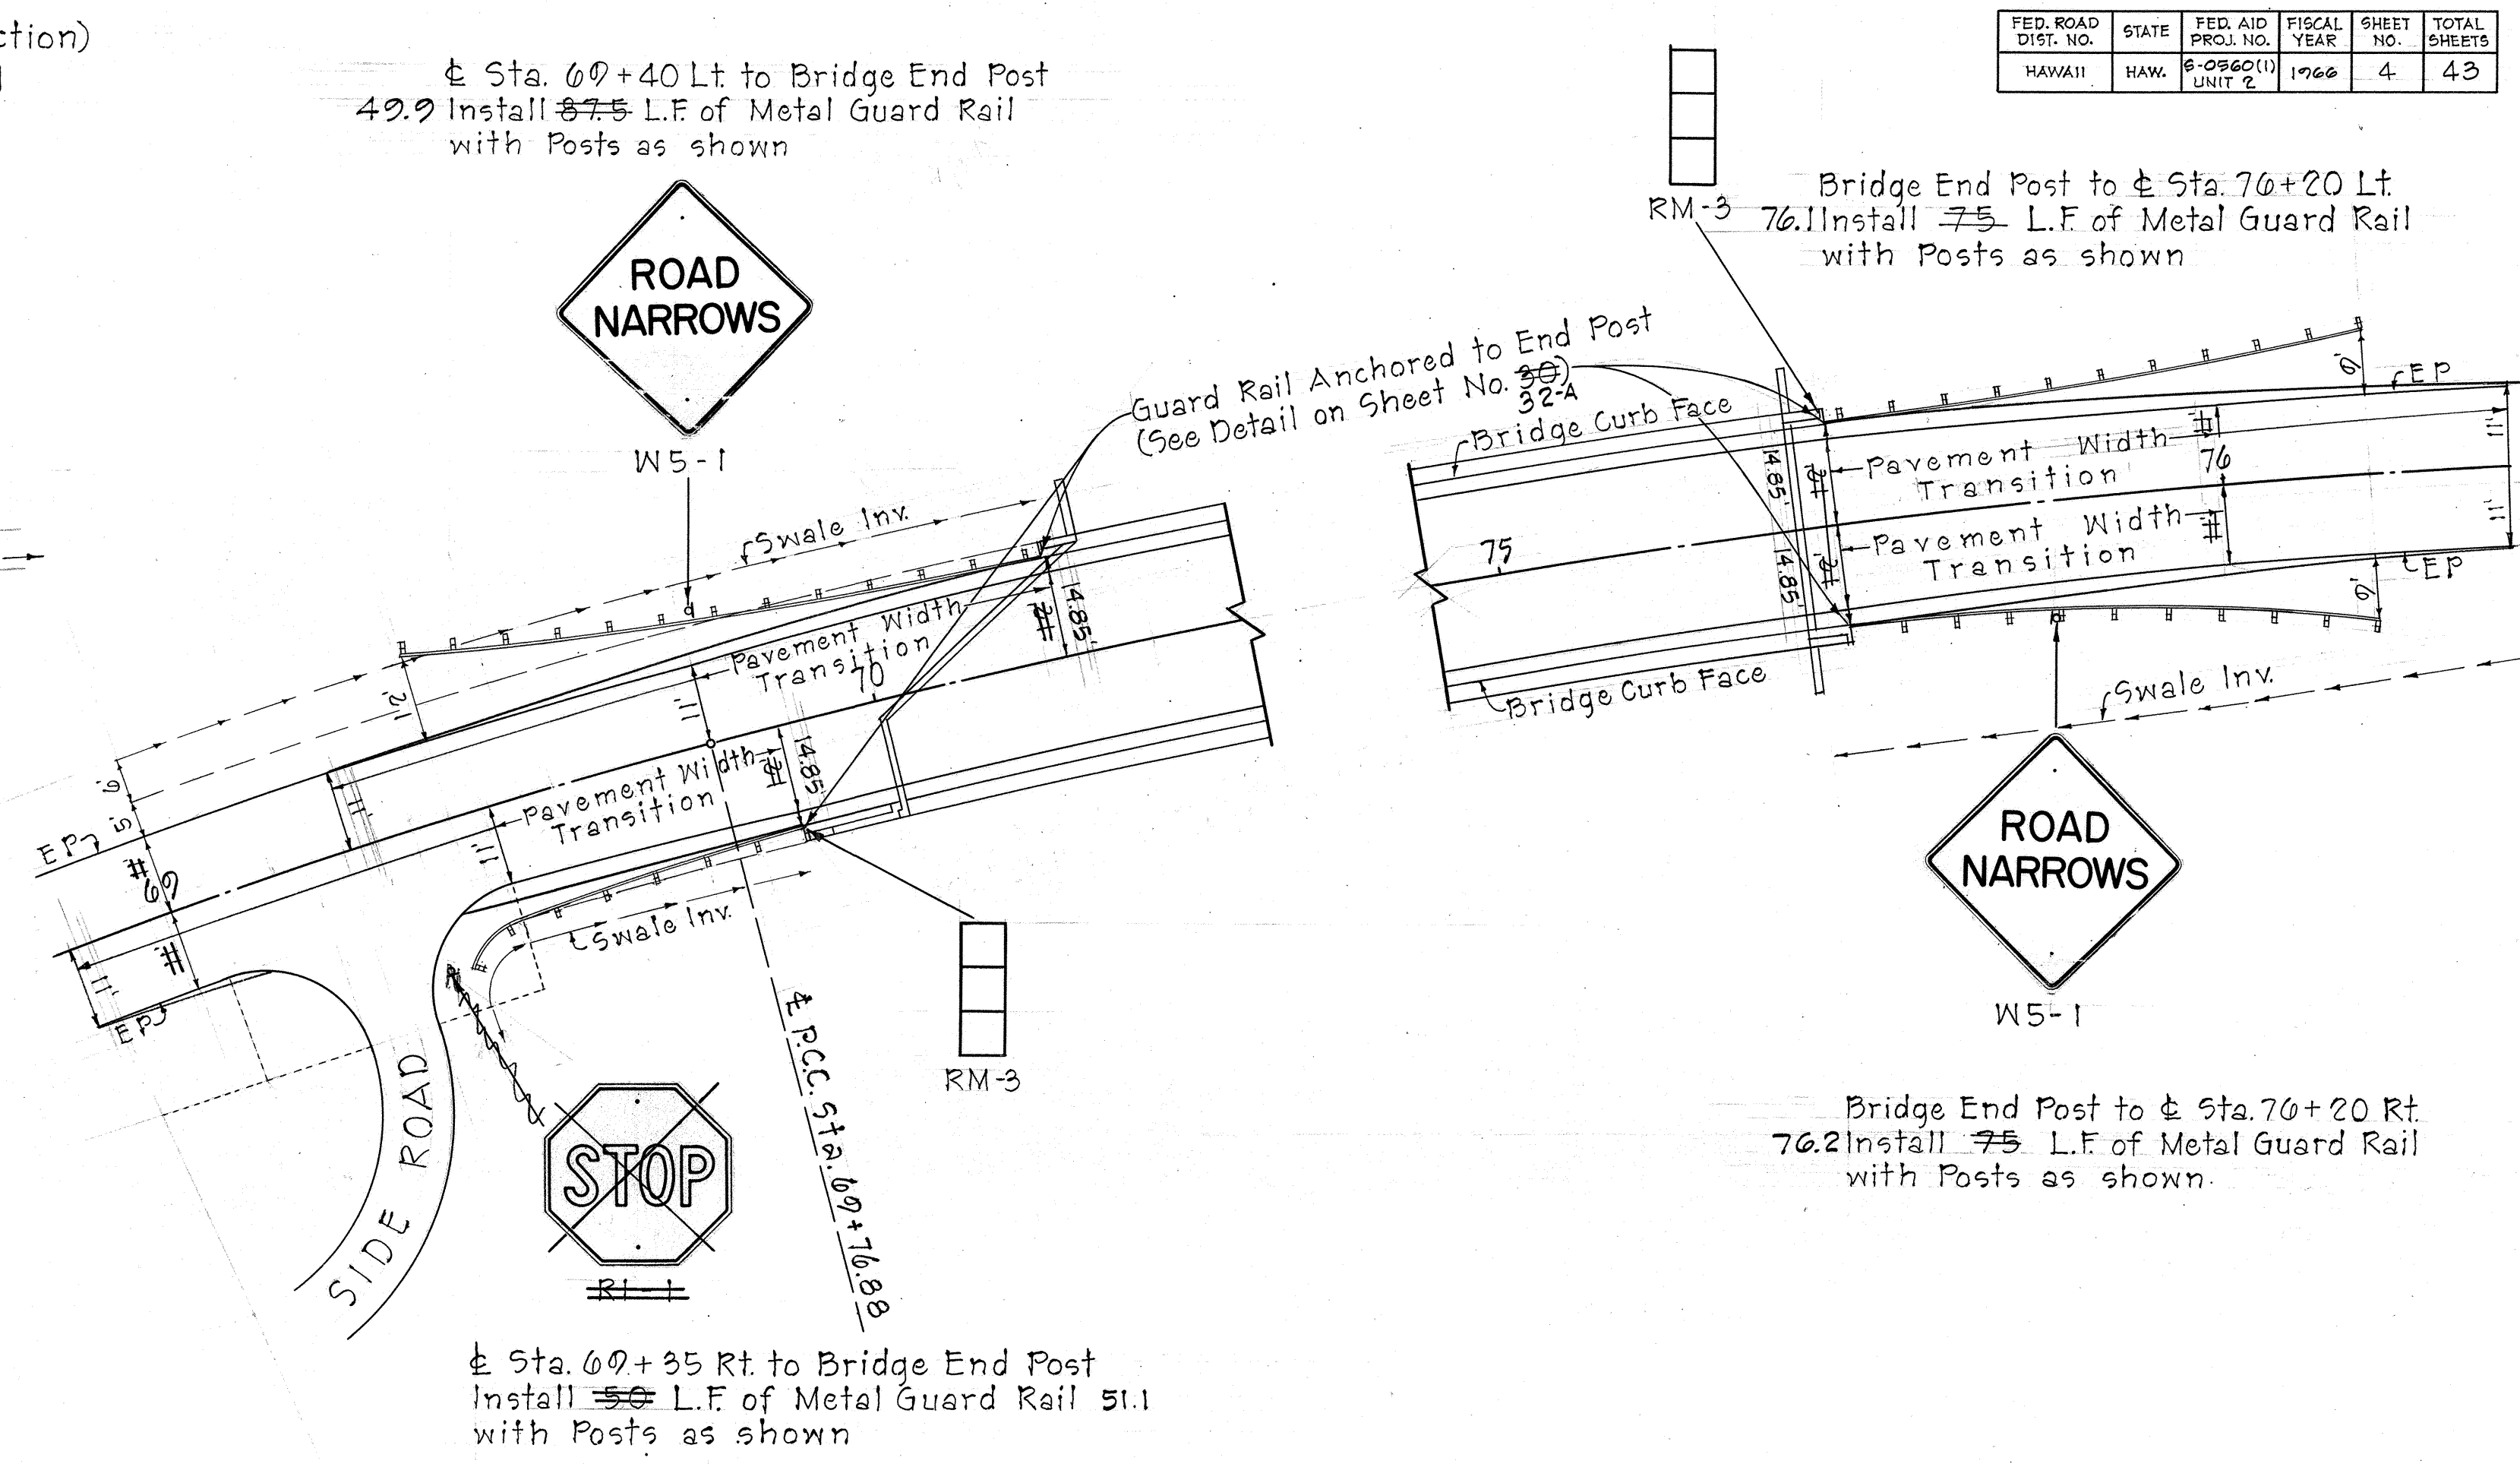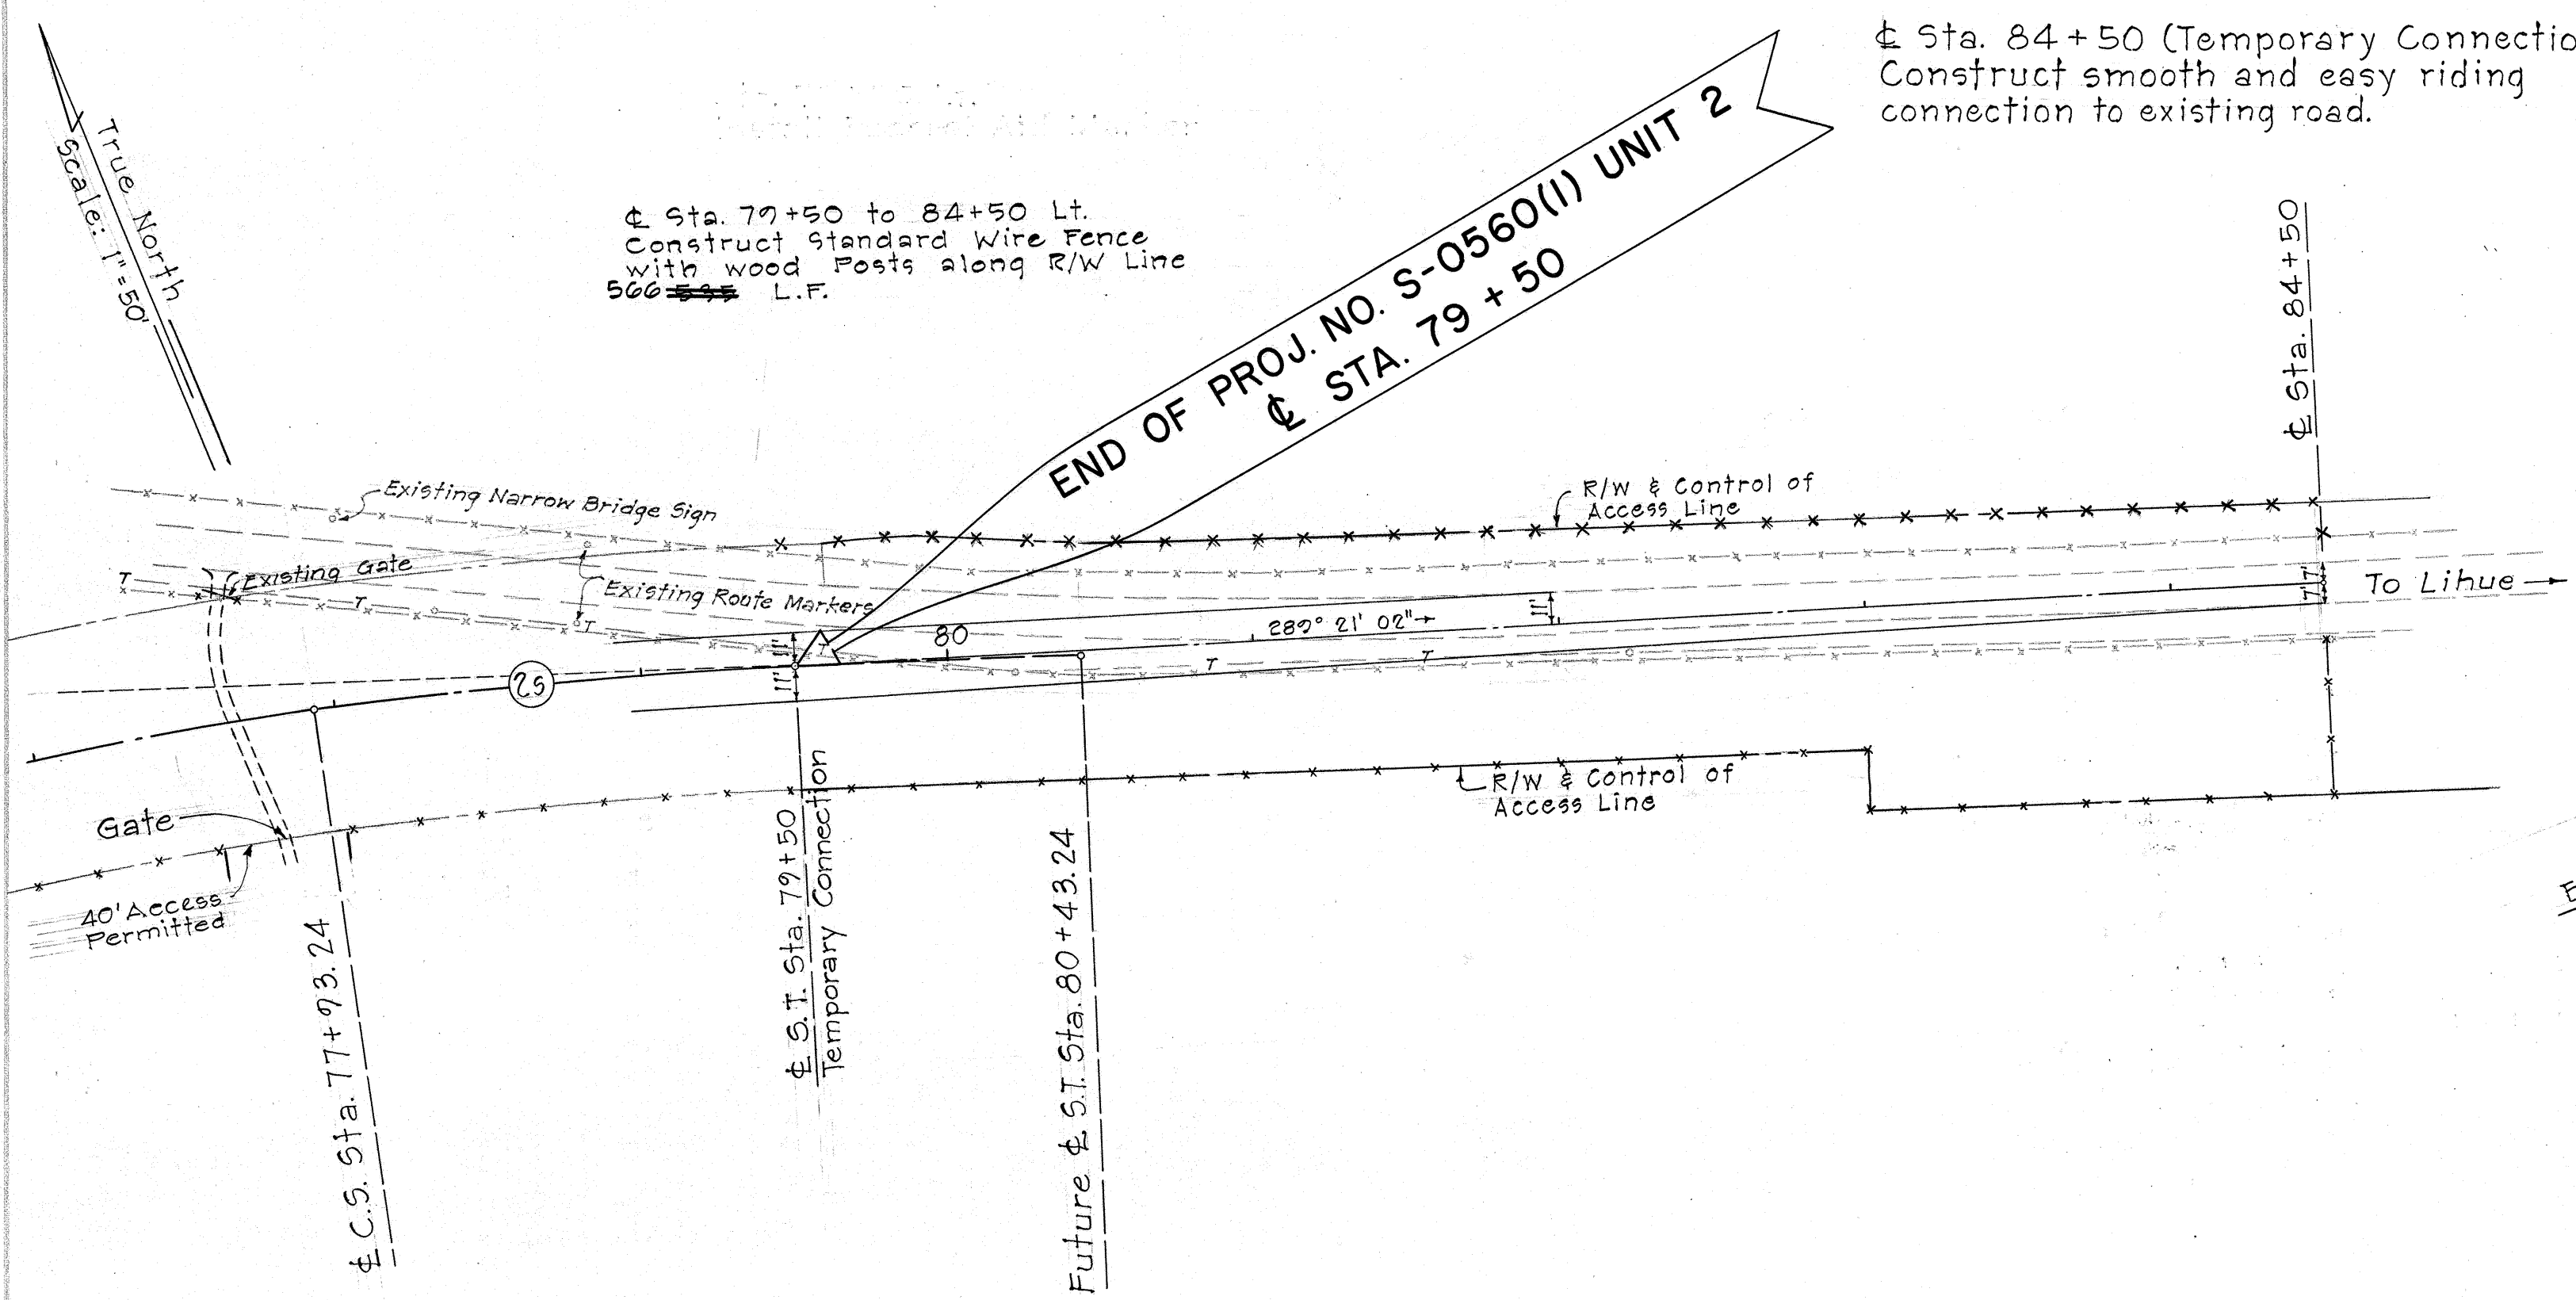

FED. ROAD DIST. NO.	STATE	FED. AID PROJ. NO.	FISCAL YEAR	SHEET NO.	TOTAL SHEETS
HAWAII	HAW.	S-0560(1) UNIT 2	1966	4	43

