

INDEX TO DRAWINGS	
SHEET	DESCRIPTION
1	TITLE SHEET
2	TYPICAL SECTIONS
3-4	PLAN AND PROFILE
5-11	MISC. AND STANDARD DETAILS
12	MISC. DETAILS - TELEPHONE
13-32A	LUMAHAI RIVER BRIDGE
33-38	STANDARD BRIDGE DETAILS
39-43	CROSS SECTIONS

FED. ROAD DIST. NO.	STATE	FED. AID PROJ. NO.	FISCAL YEAR	SHEET NO.	TOTAL SHEETS
HAWAII	HAW	S-0560(1) UNIT 2	1966	1	43

STATE OF HAWAII

DEPARTMENT OF TRANSPORTATION

HIGHWAYS DIVISION

"AS BUILT" PLANS FOR


KAUAI BELT ROAD

LUMAHAI BRIDGE AND APPROACHES


FEDERAL AID SECONDARY PROJ. NO. S-0560(1) UNIT 2

DISTRICT OF HANAIEI

ISLAND OF KAUAI

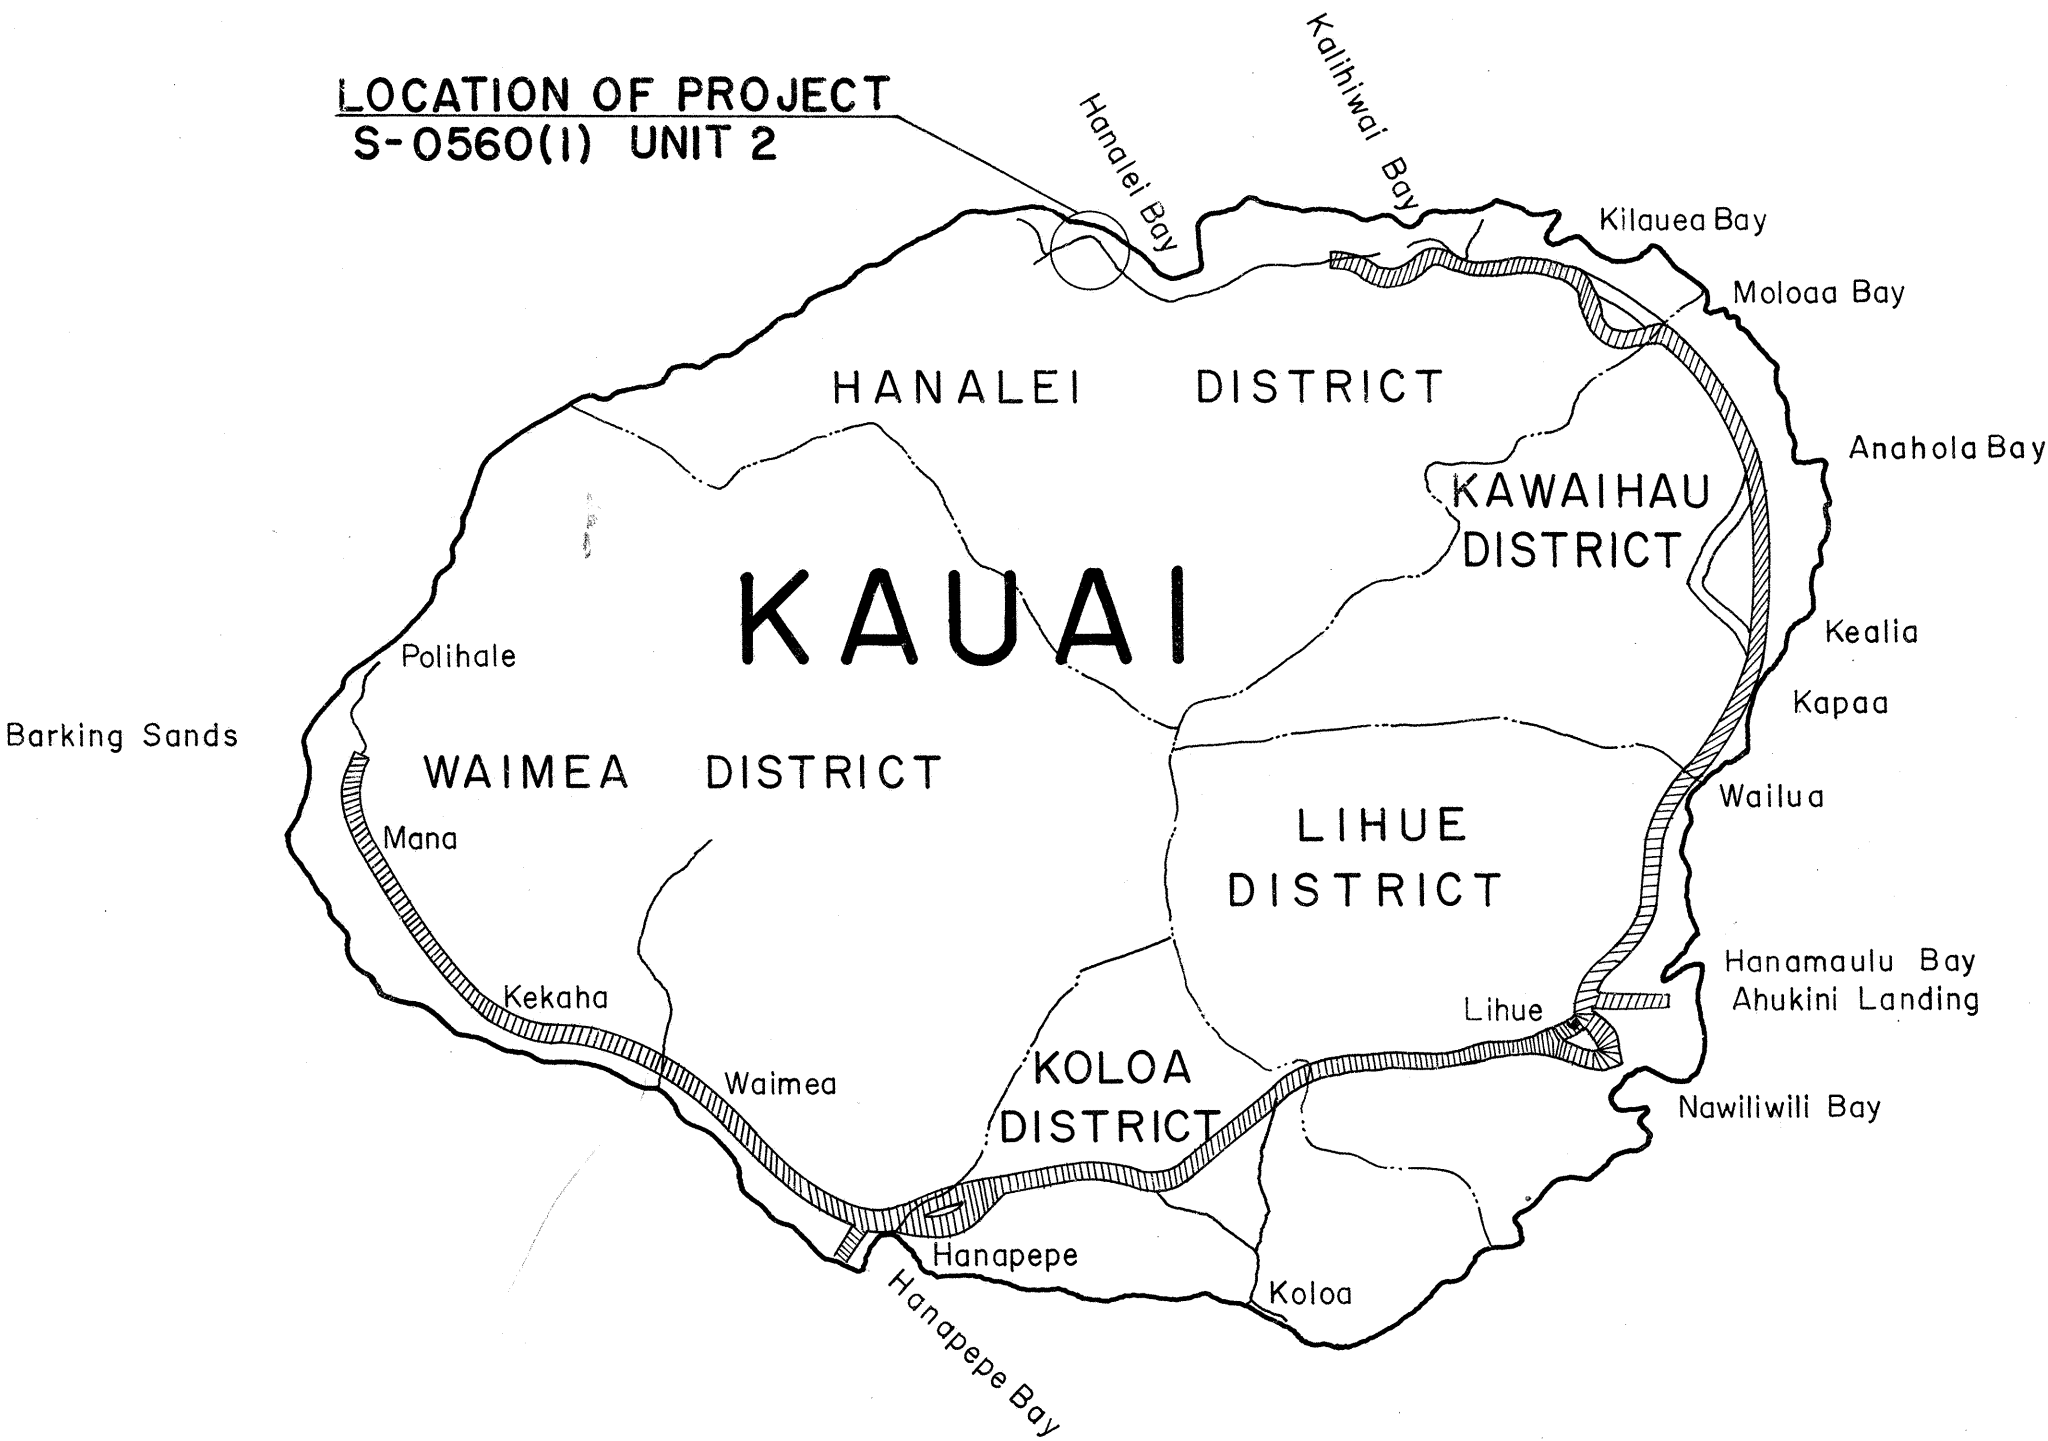

FEDERAL AID. PROJECTS PREVIOUSLY CONSTRUCTED OR UNDER CONSTRUCTION

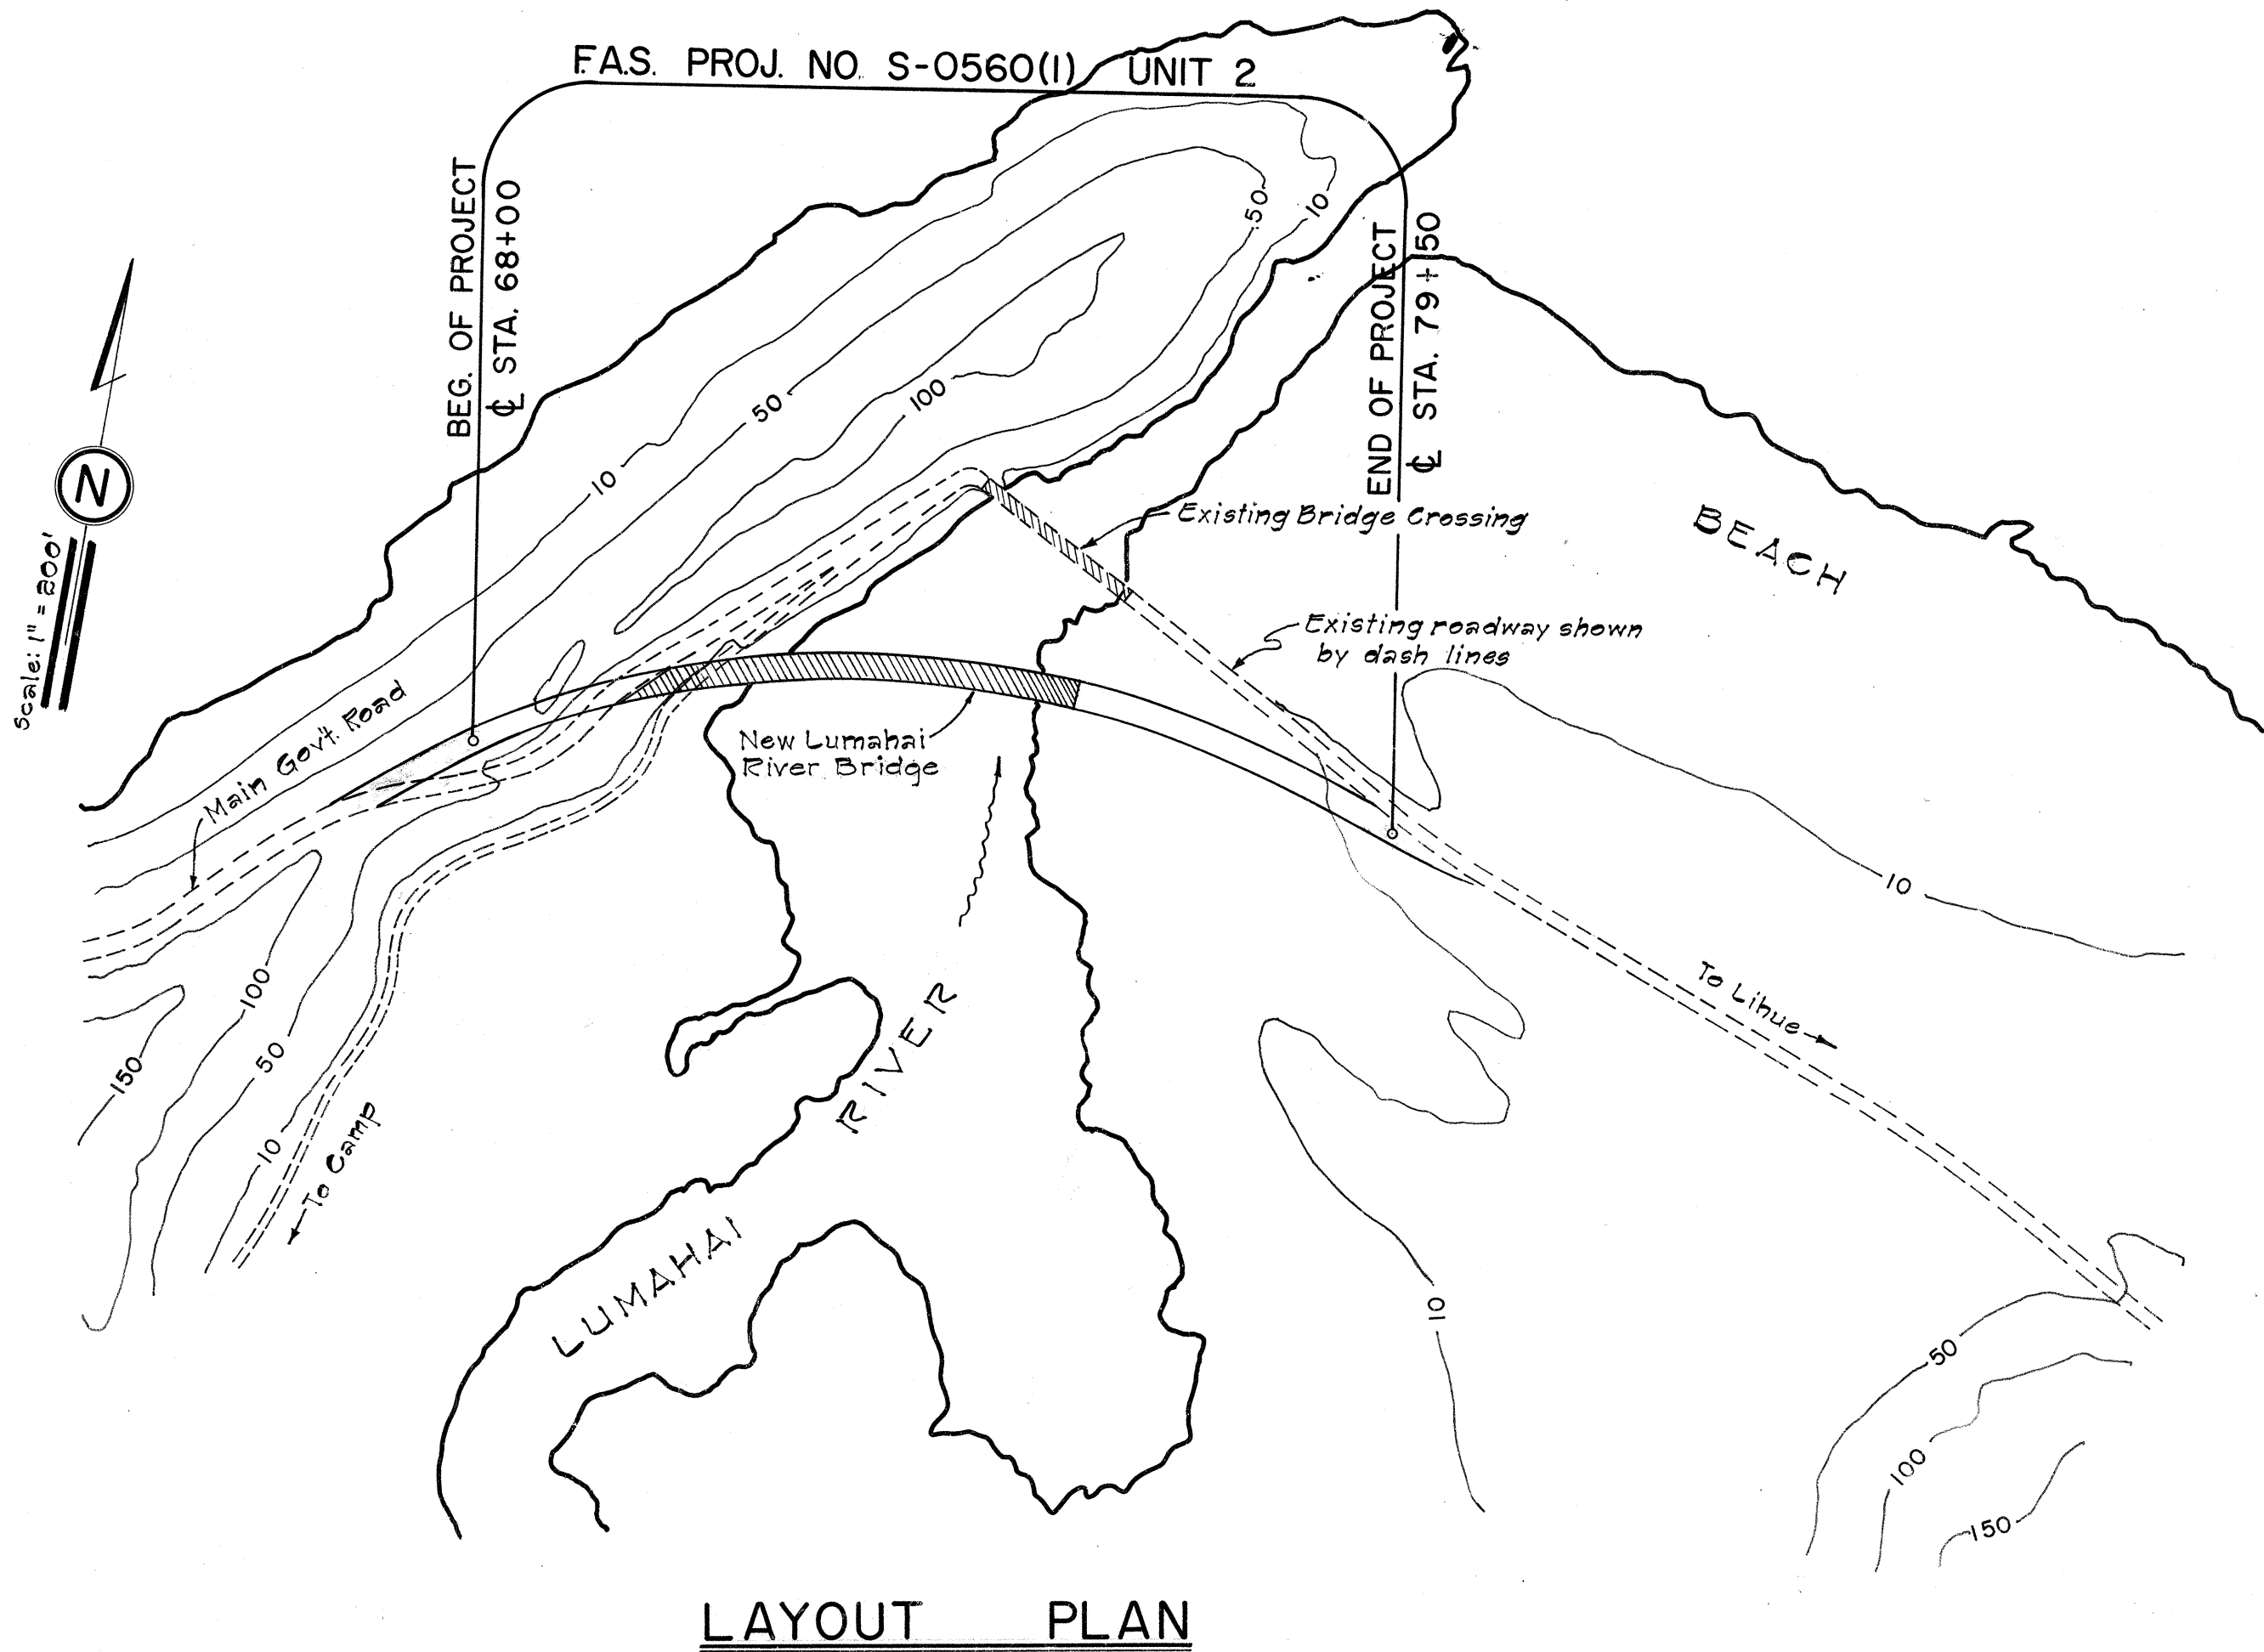

NOTE:
All changes made during construction have been noted on these tracings in red and checked by:

Shigeto Yamaguchi
PROJECT ENGINEER
Dec. 18, 1968
DATE

DESIGN CLASSIFICATION

ADT 280
DESIGN ADT(1985).....570
DHV..... 70
D..... 55 / 45
T..... 10 %
T₂₄..... 11 %
V..... 50 MPH

GROSS LENGTH OF PROJECT 0.218 Mi.
BRIDGE LENGTH..... 0.102 Mi.
NET LENGTH OF PROJECT 0.116 Mi.

APPROVED: *John Paul Sun* DATE: *1-11-67*
For: DIRECTOR OF TRANSPORTATION

DEPARTMENT OF COMMERCE
BUREAU OF PUBLIC ROADS
APPROVED: *John B. Dalton* *3/16/67*
DIVISION ENGINEER DATE

LAYOUT PLAN