




FED. ROAD DIST. NO.	STATE	FED. AID PROJ. NO.	FISCAL YEAR	SHEET NO.	TOTAL SHEETS
HAWAII	HAW.	5-0500(1) UNIT 2	1960	2	43

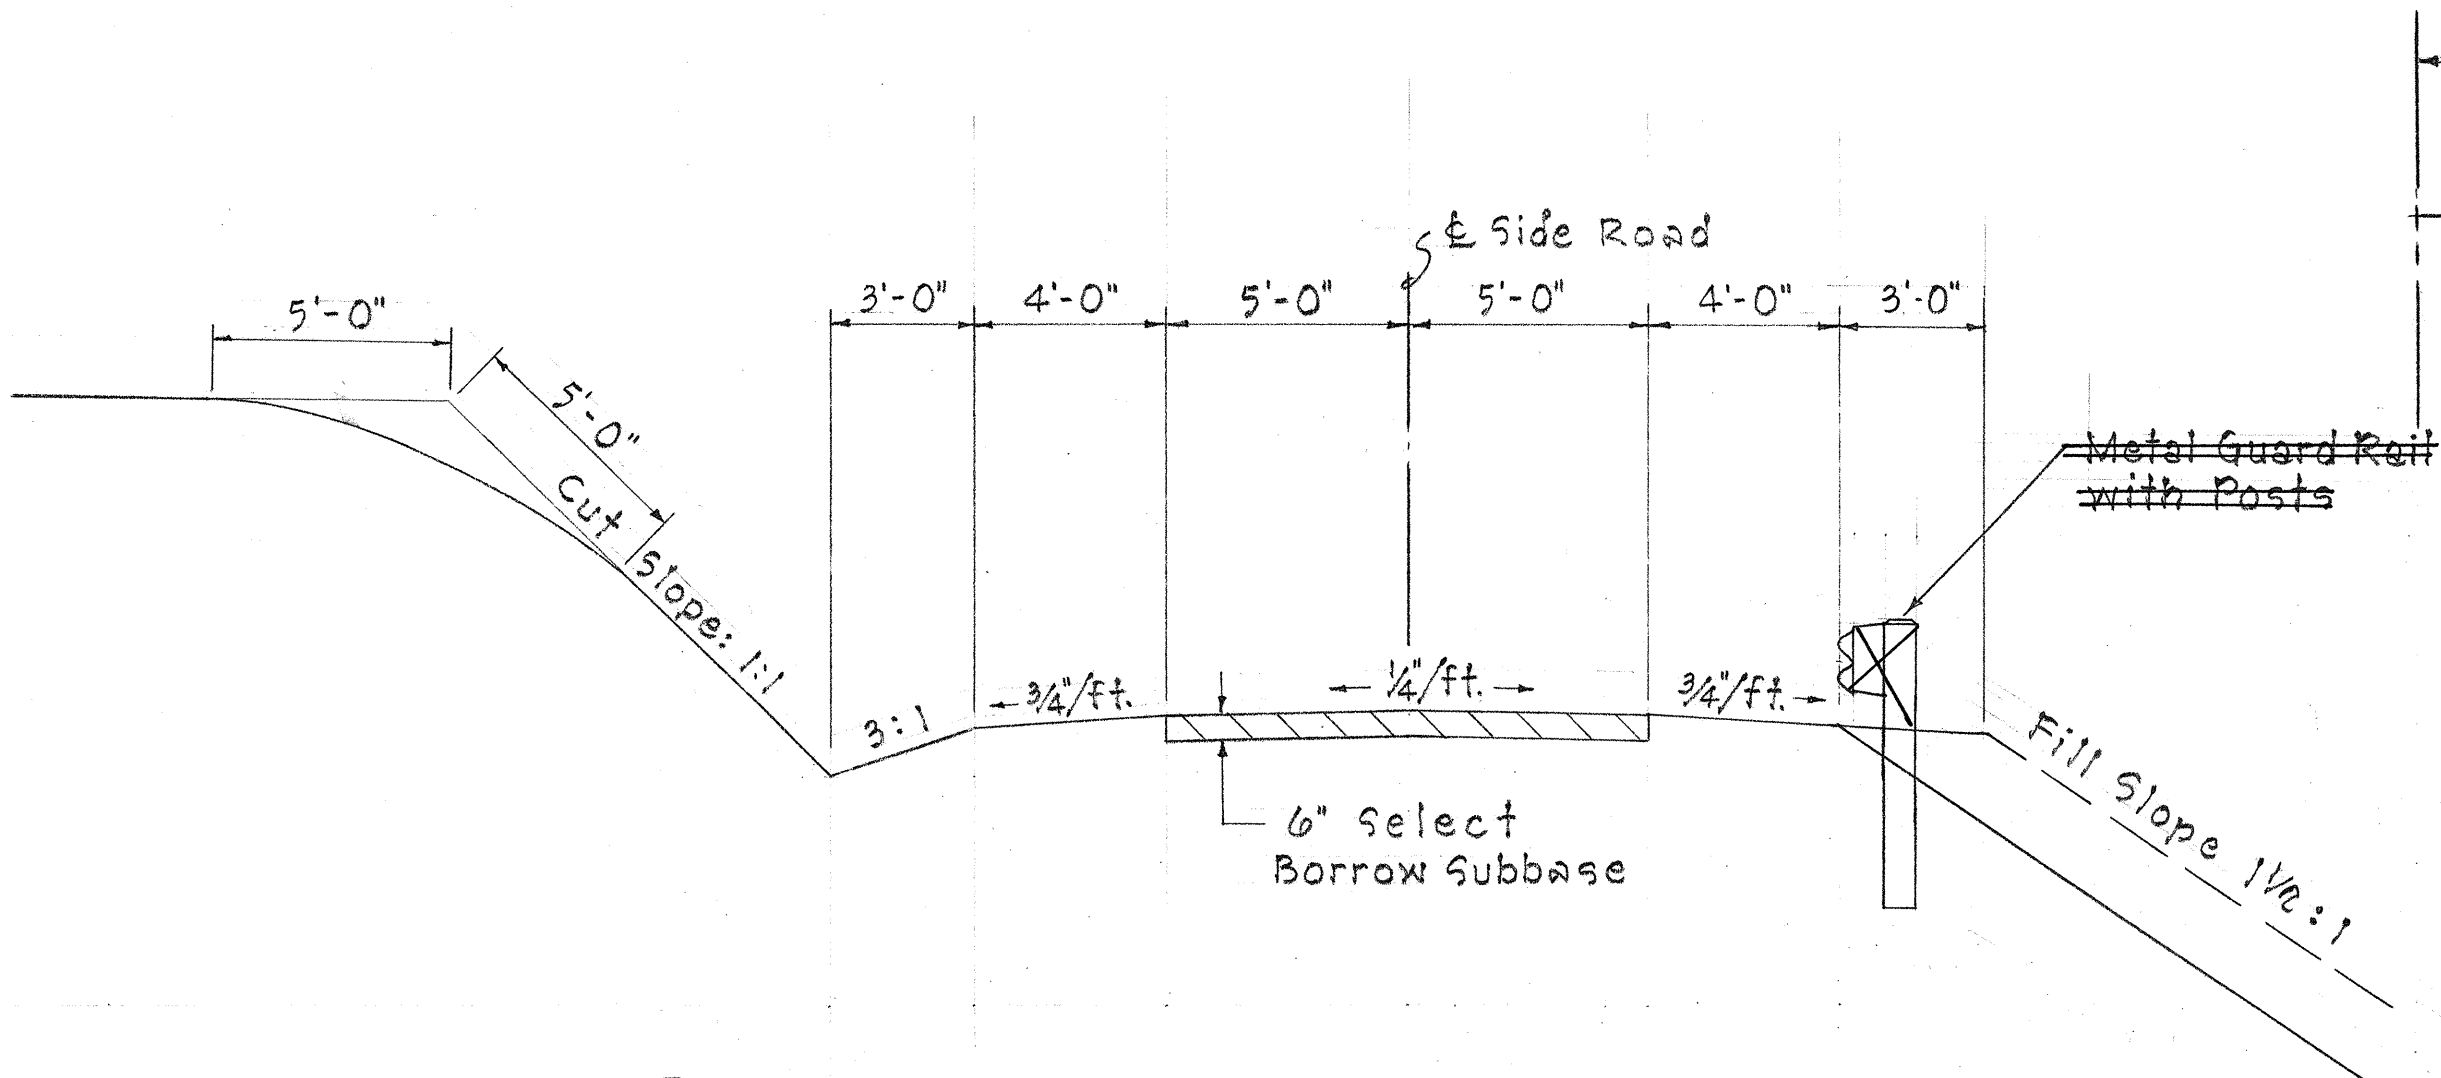


TYPICAL SECTION OF SIDE ROAD
Scale: 1/4" = 1'-0"

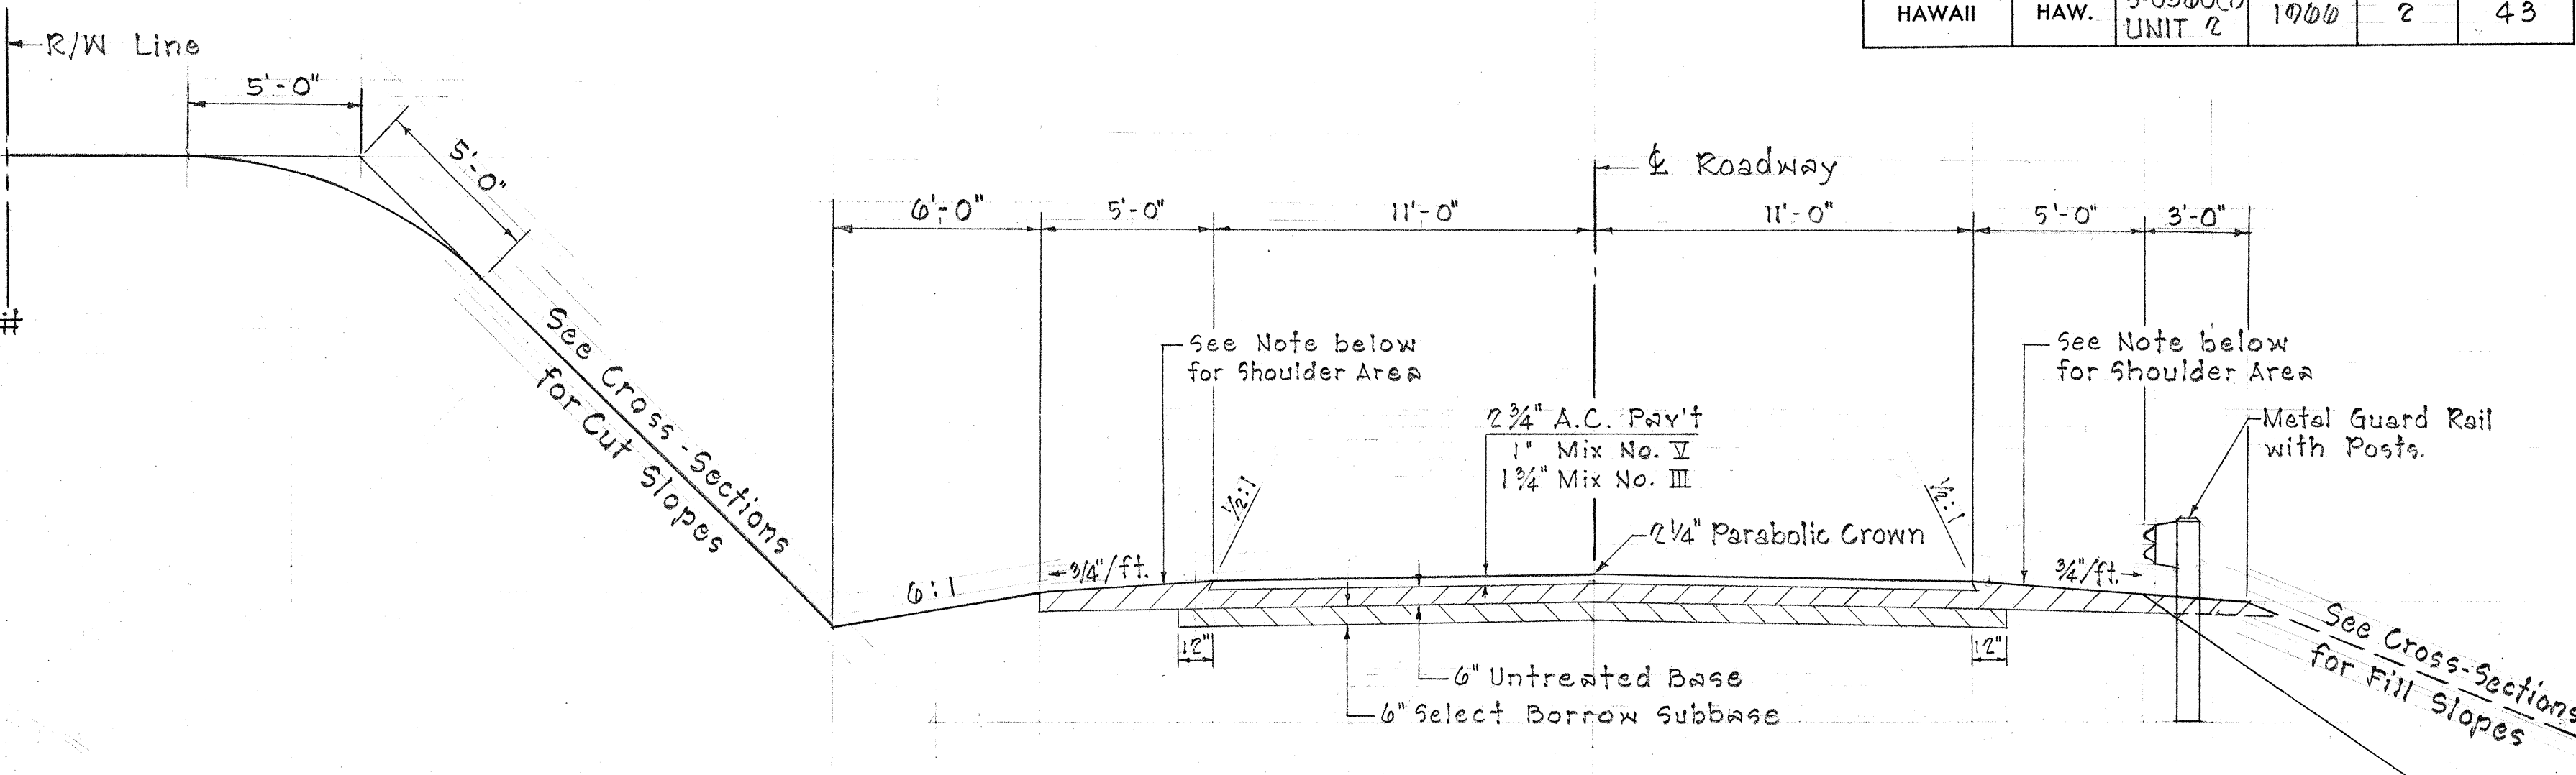

TYPICAL SECTION ON TANGENT
Scale: 1/4" = 1'-0"

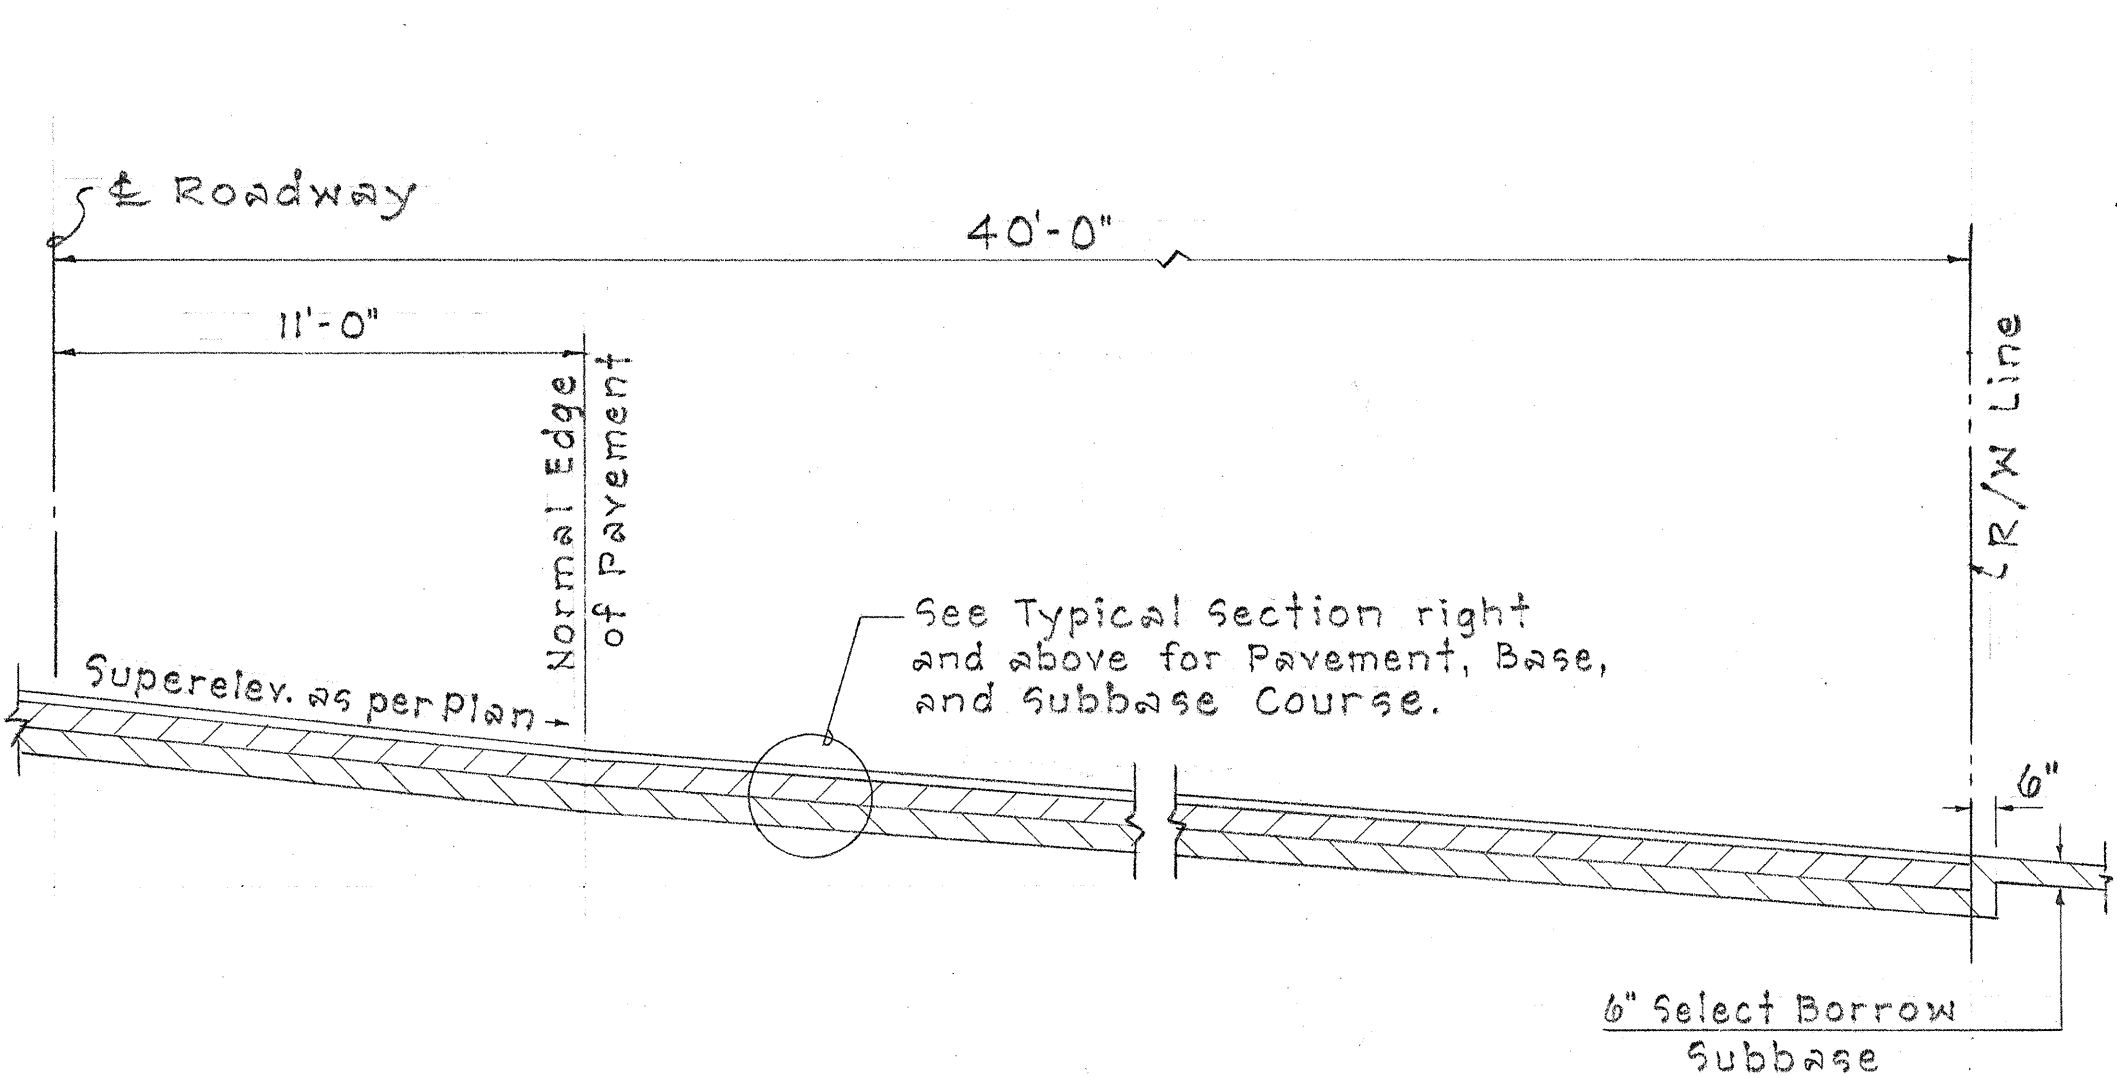


SECTION AT SIDE ROAD CONNECTION
Scale: 1/4" = 1'-0"

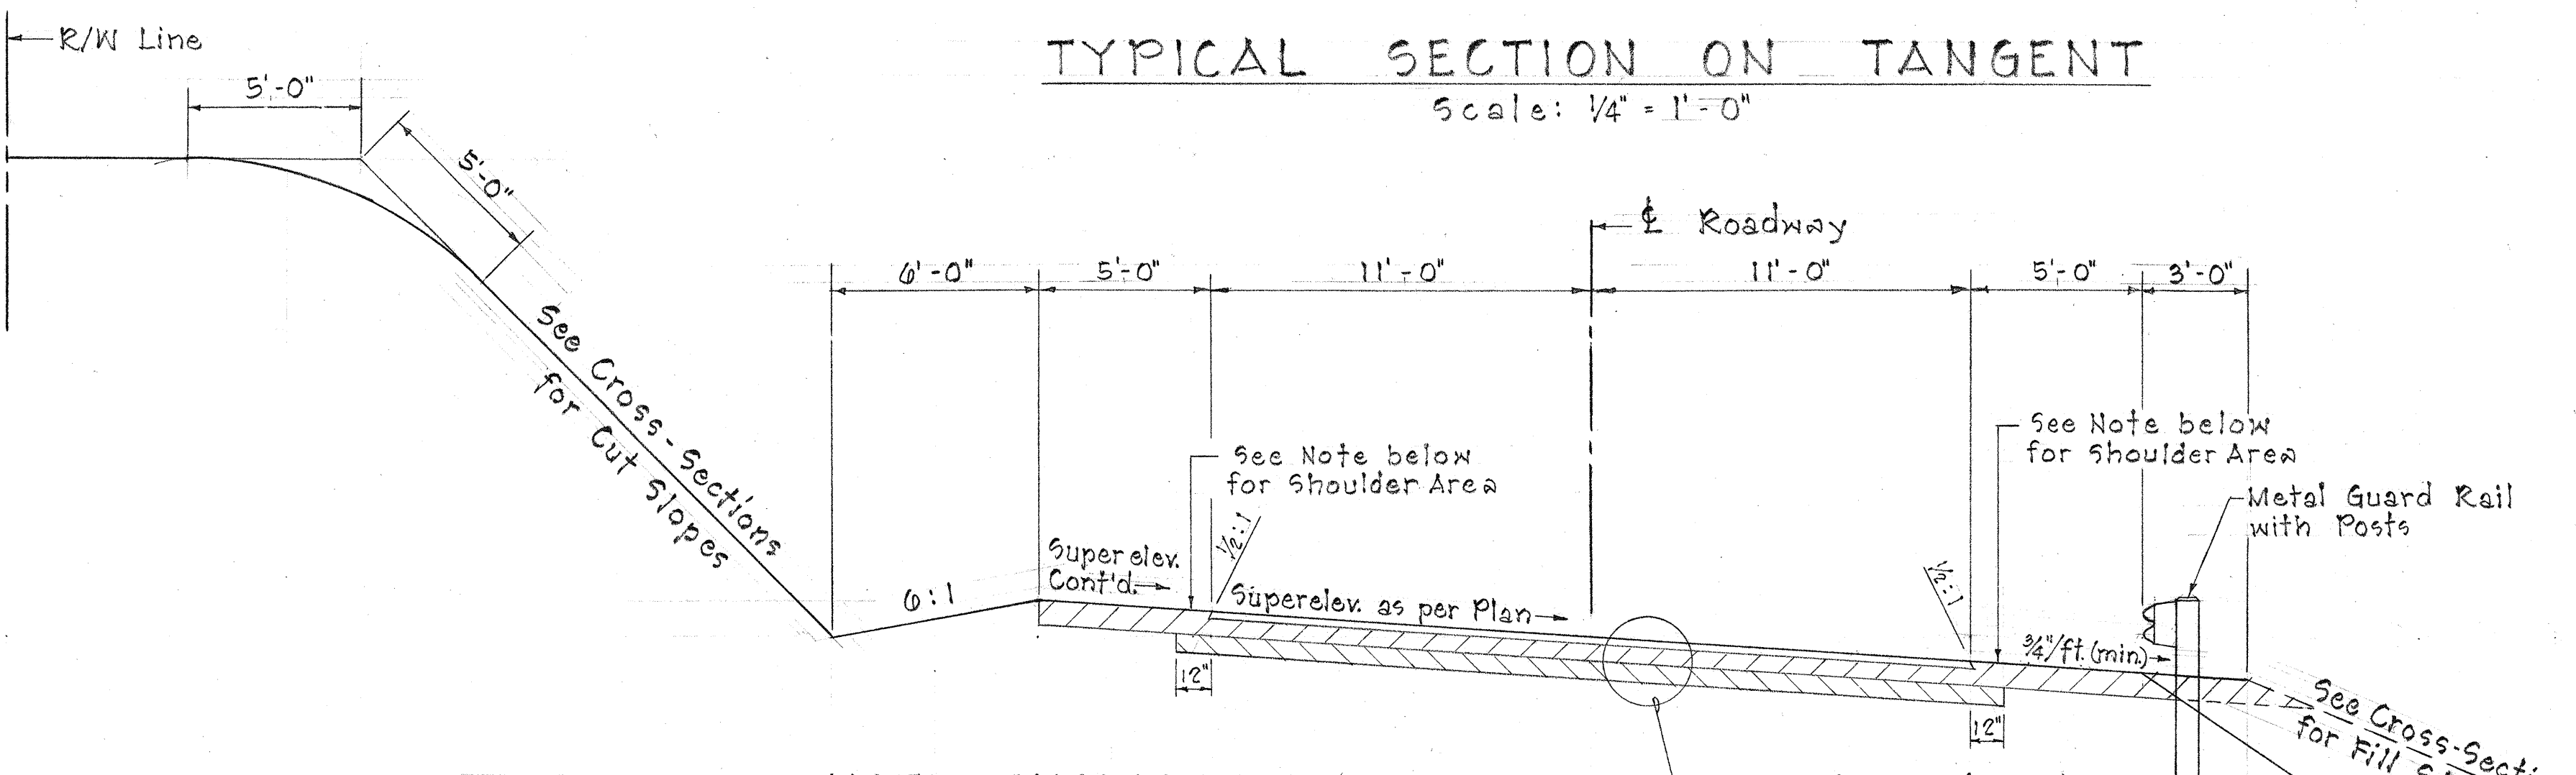

NOTE - SHOULDER AREA
Medium Curing Liquid Asphalt (MC-0) over Untreated Base.
Rate of Application: 0.35 Gal./S.Y.


TYPICAL SECTION ON CURVE
Scale: 1/4" = 1'-0"

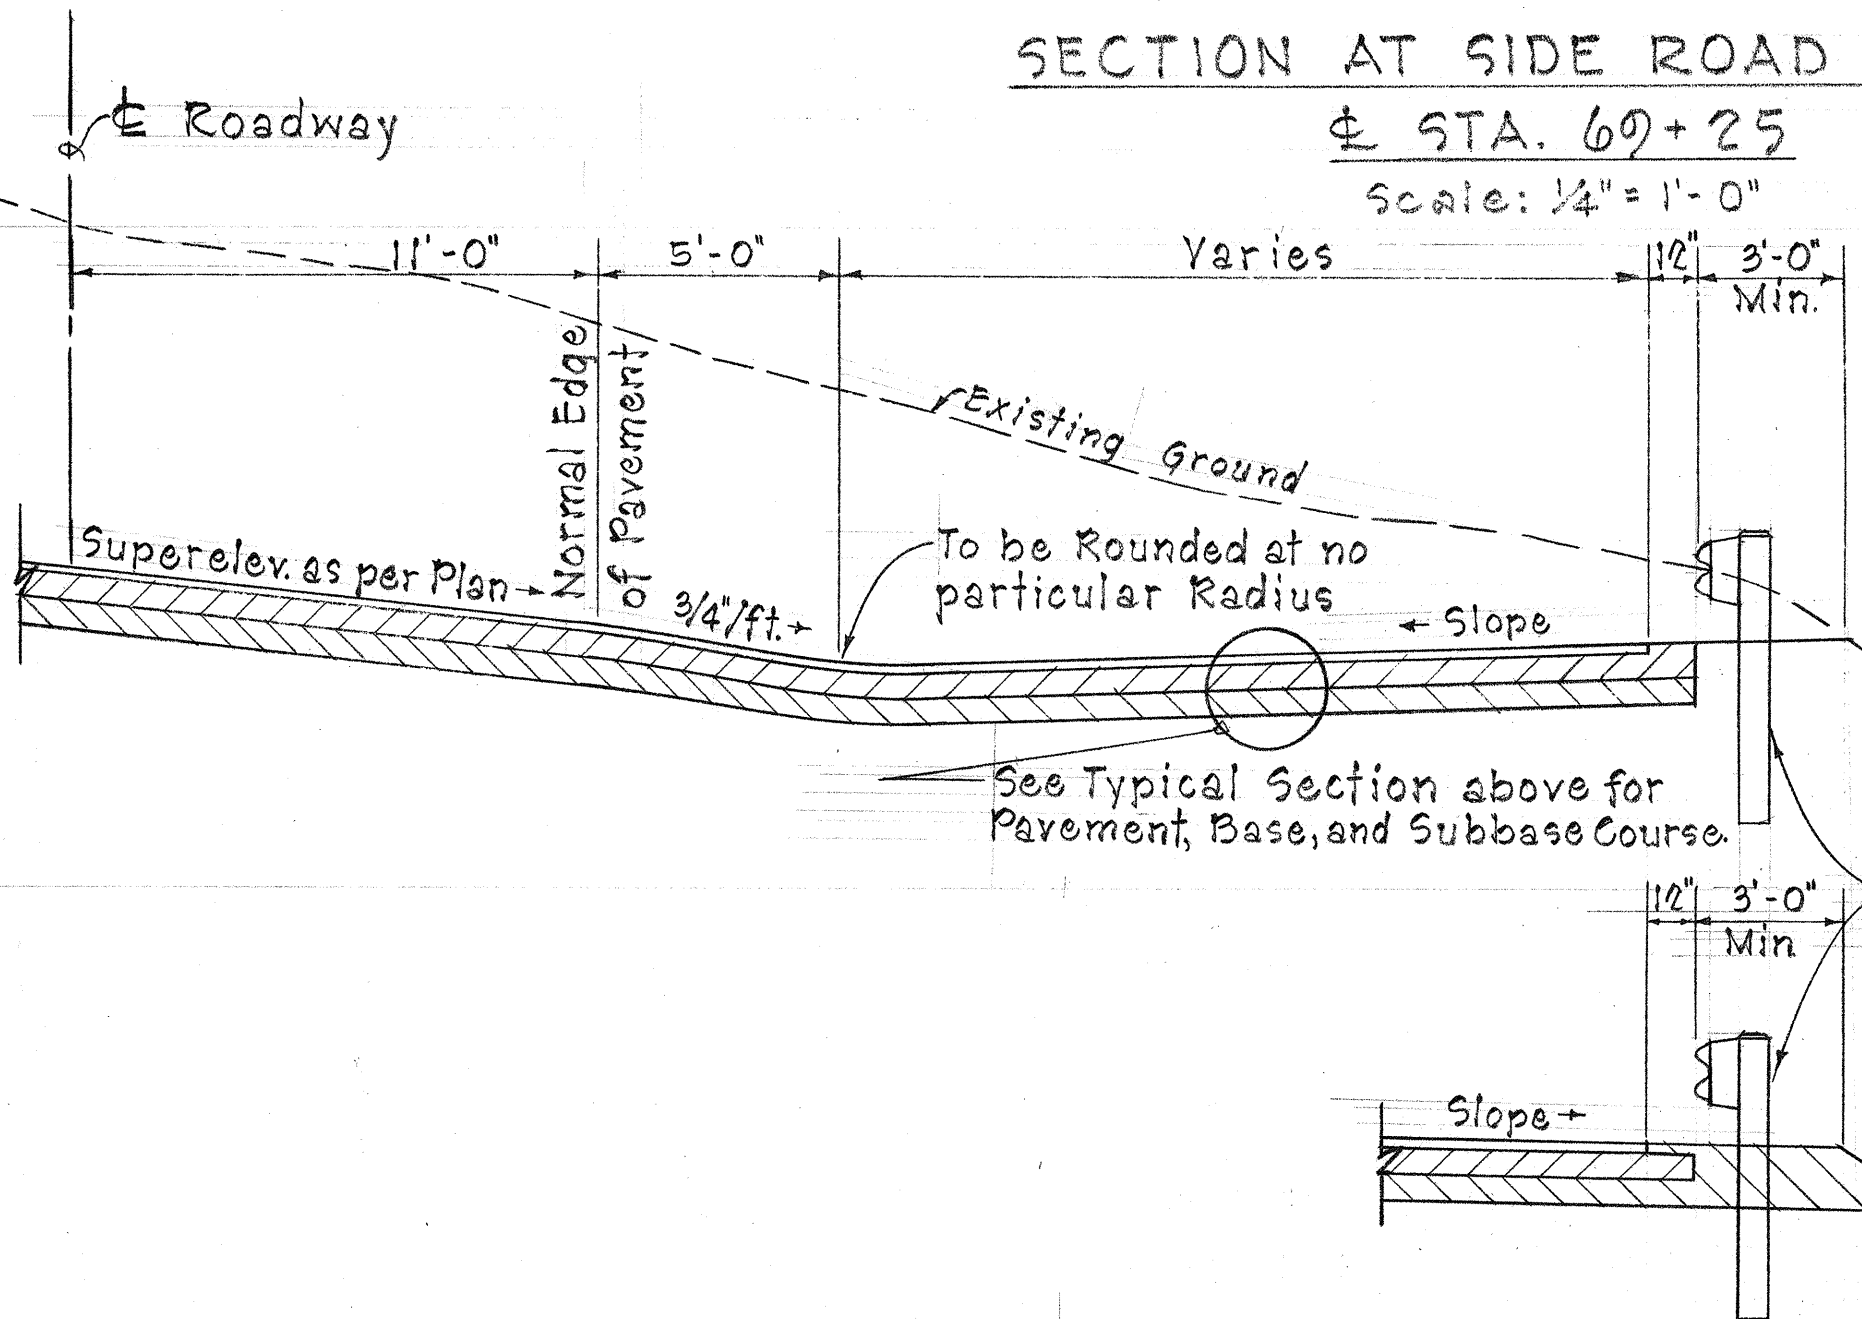

TYPICAL SECTIONS OF SCENIC OVERLOOK
Scale: 1/4" = 1'-0"

P.I. CURVE DATA

Δ	= 34° 12' 11"
$\Delta/2$	= 17° 06' 05.5"
R	= 150'
T	= 40.15
C	= 88.22
L	= 89.54

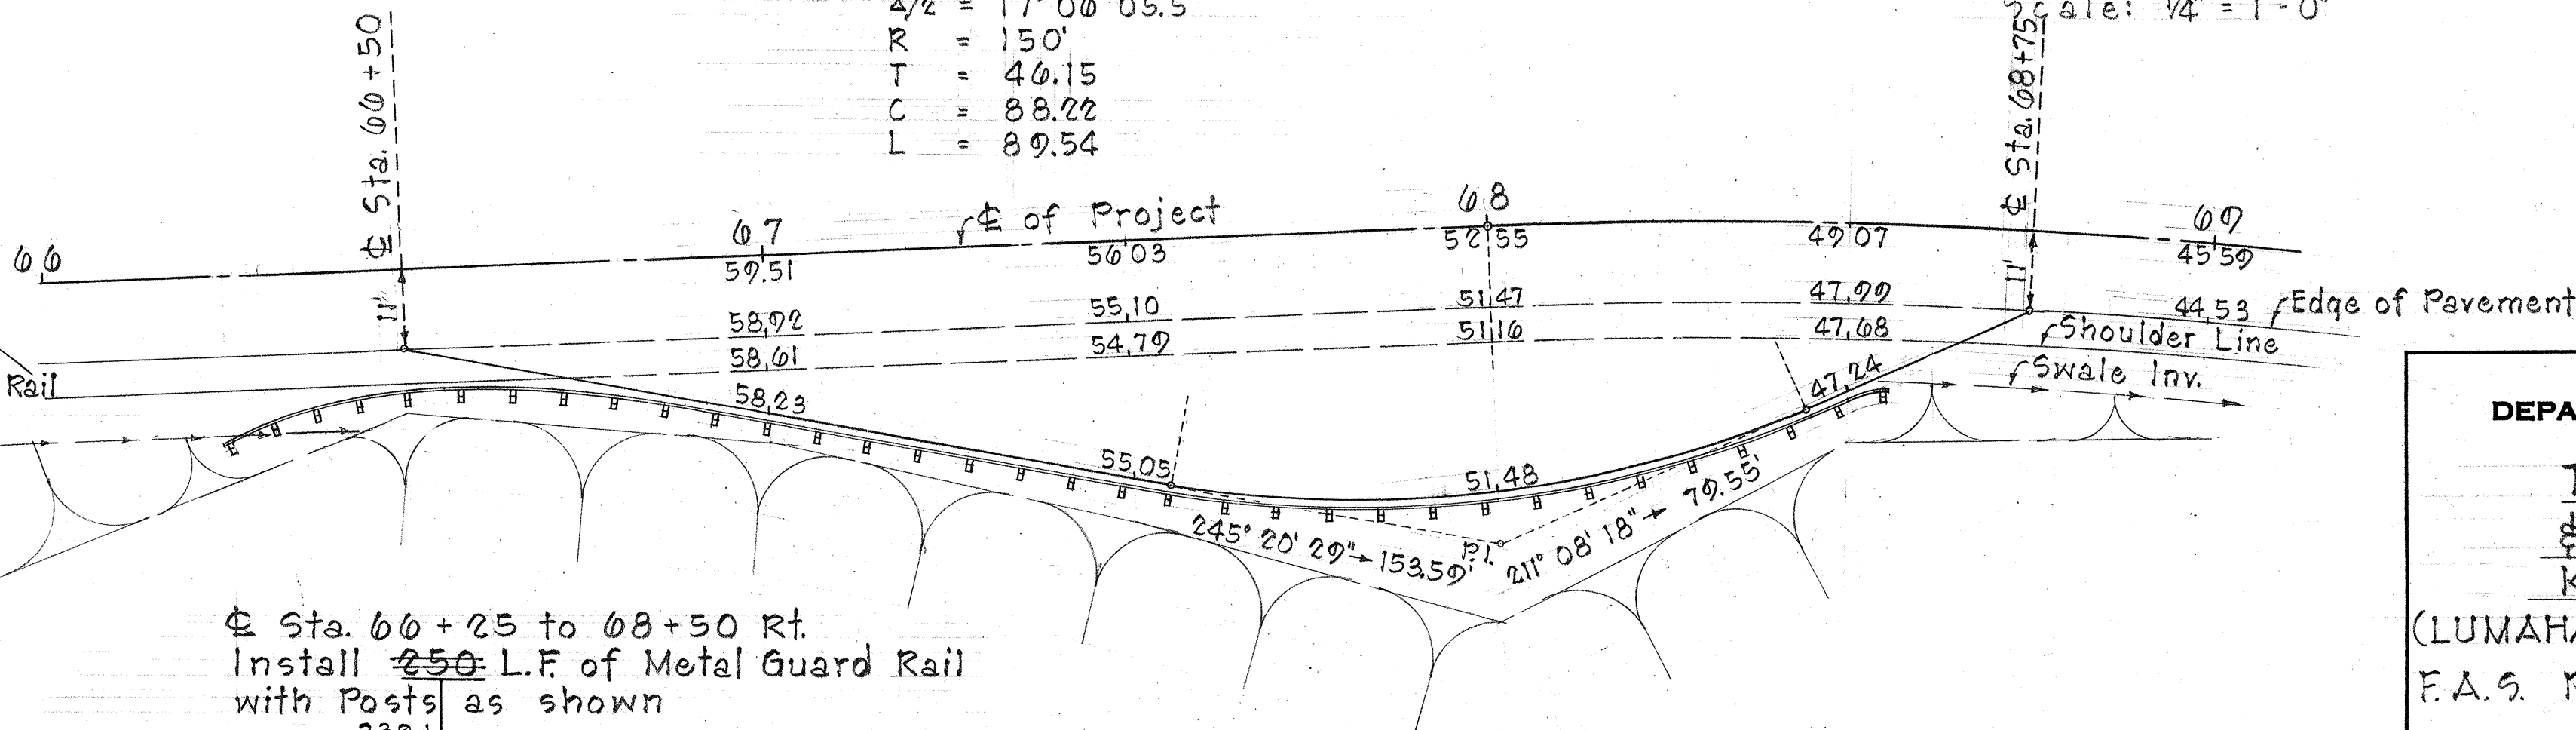

SCENIC OVERLOOK
Scale: 1" = 20'

STATE OF HAWAII
DEPARTMENT OF TRANSPORTATION
HIGHWAYS DIVISION
TYPICAL SECTIONS
& SCENIC OVERLOOK
KAUAI BELT ROAD
(LUMAHAI BRIDGE AND APPROACHES)
E.A.S. PROJECT NO. 5-0500(1) UNIT 2
Scale: As Noted Date: Nov. 1960
SHEET No. 1 OF 1 SHEETS

DATE	_____
DESIGNED BY	_____
CHECKED BY	_____
NOTED BY	_____
ORIGINAL PLAN	_____
NOTE BOOK	_____