
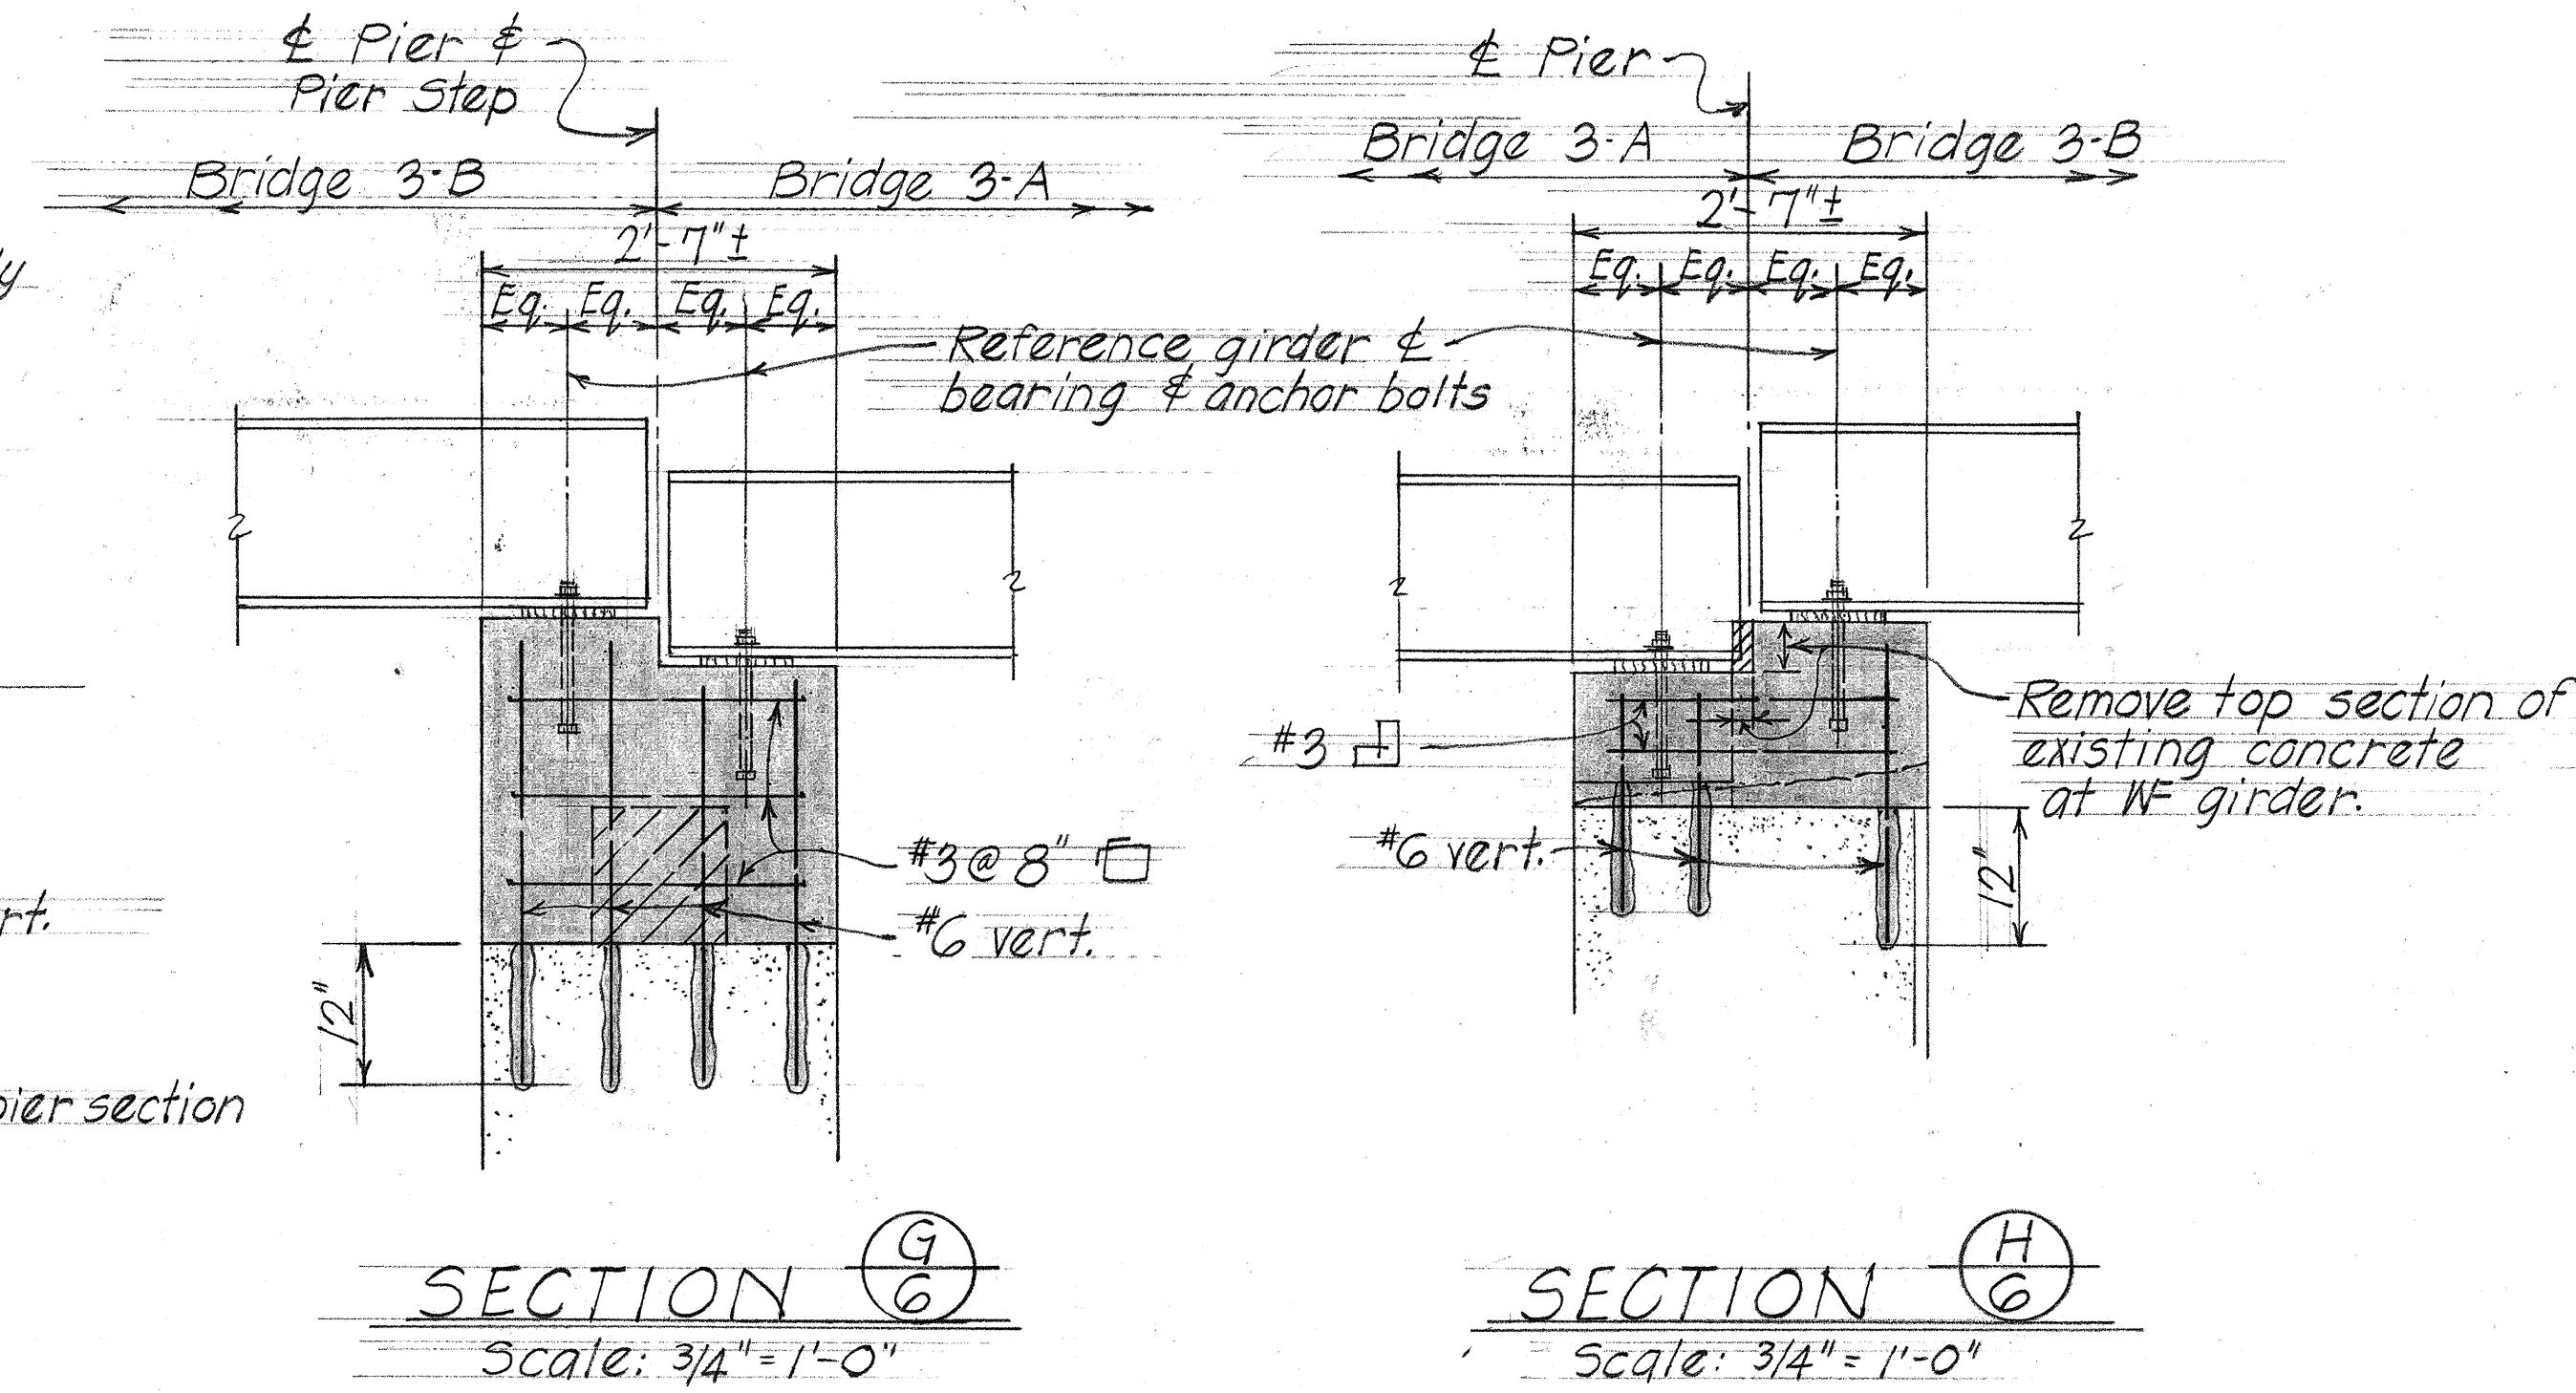
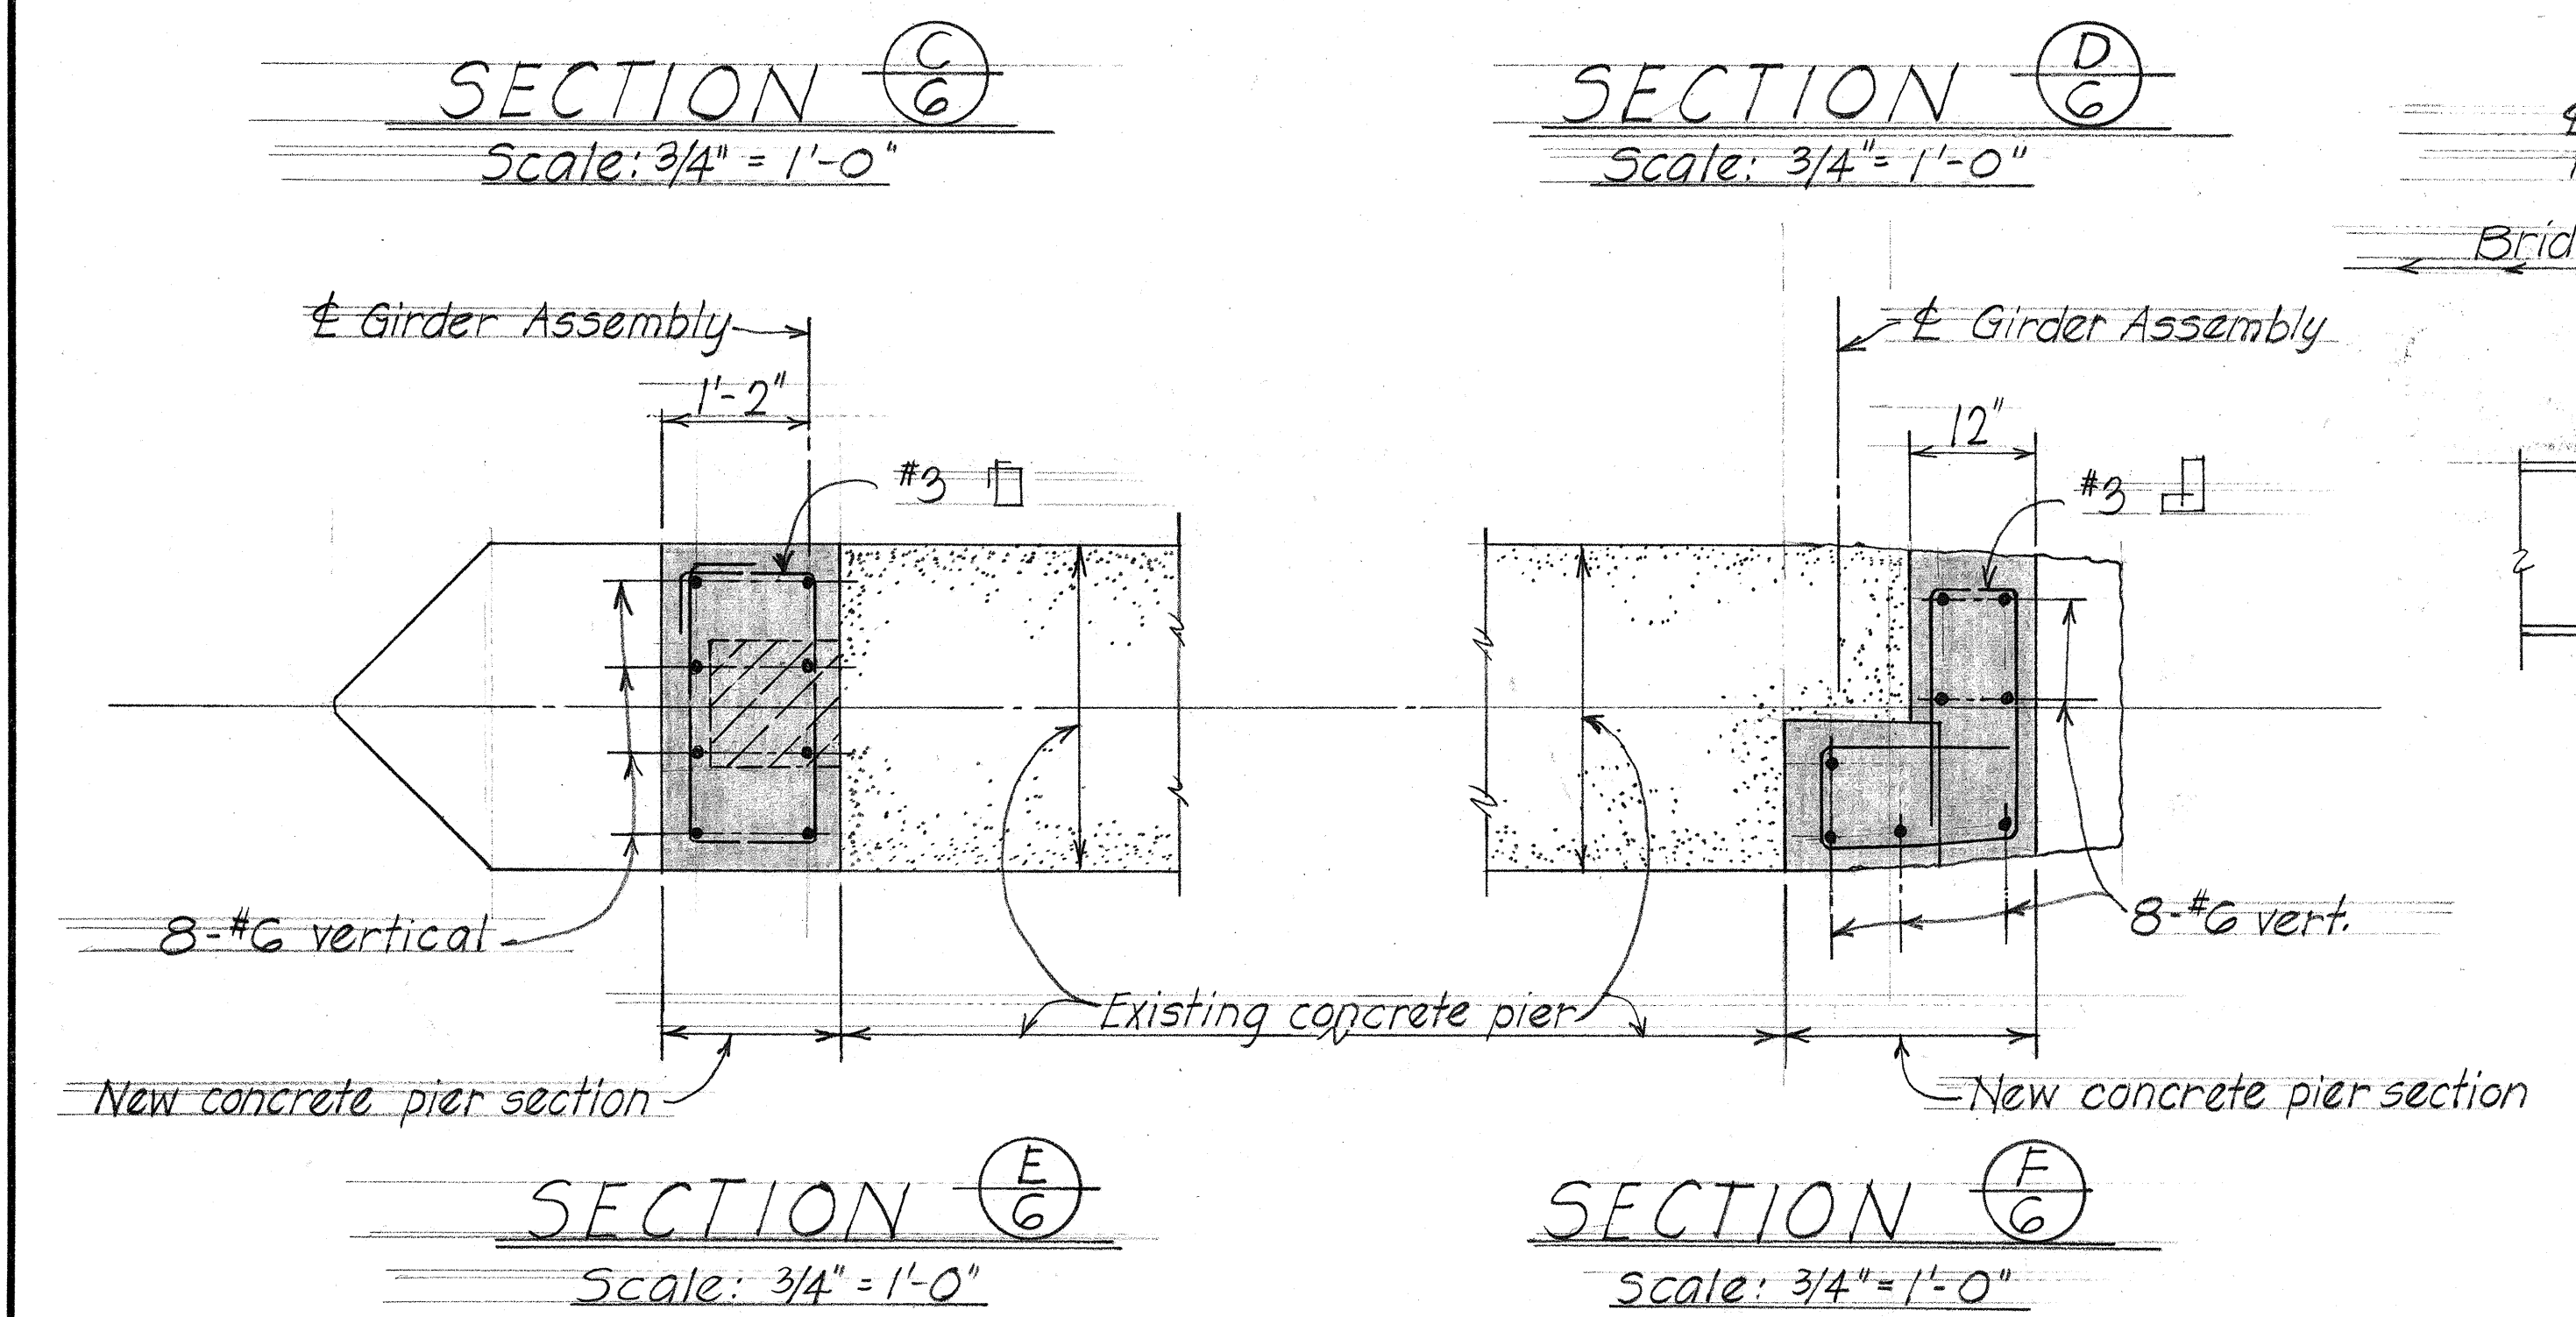
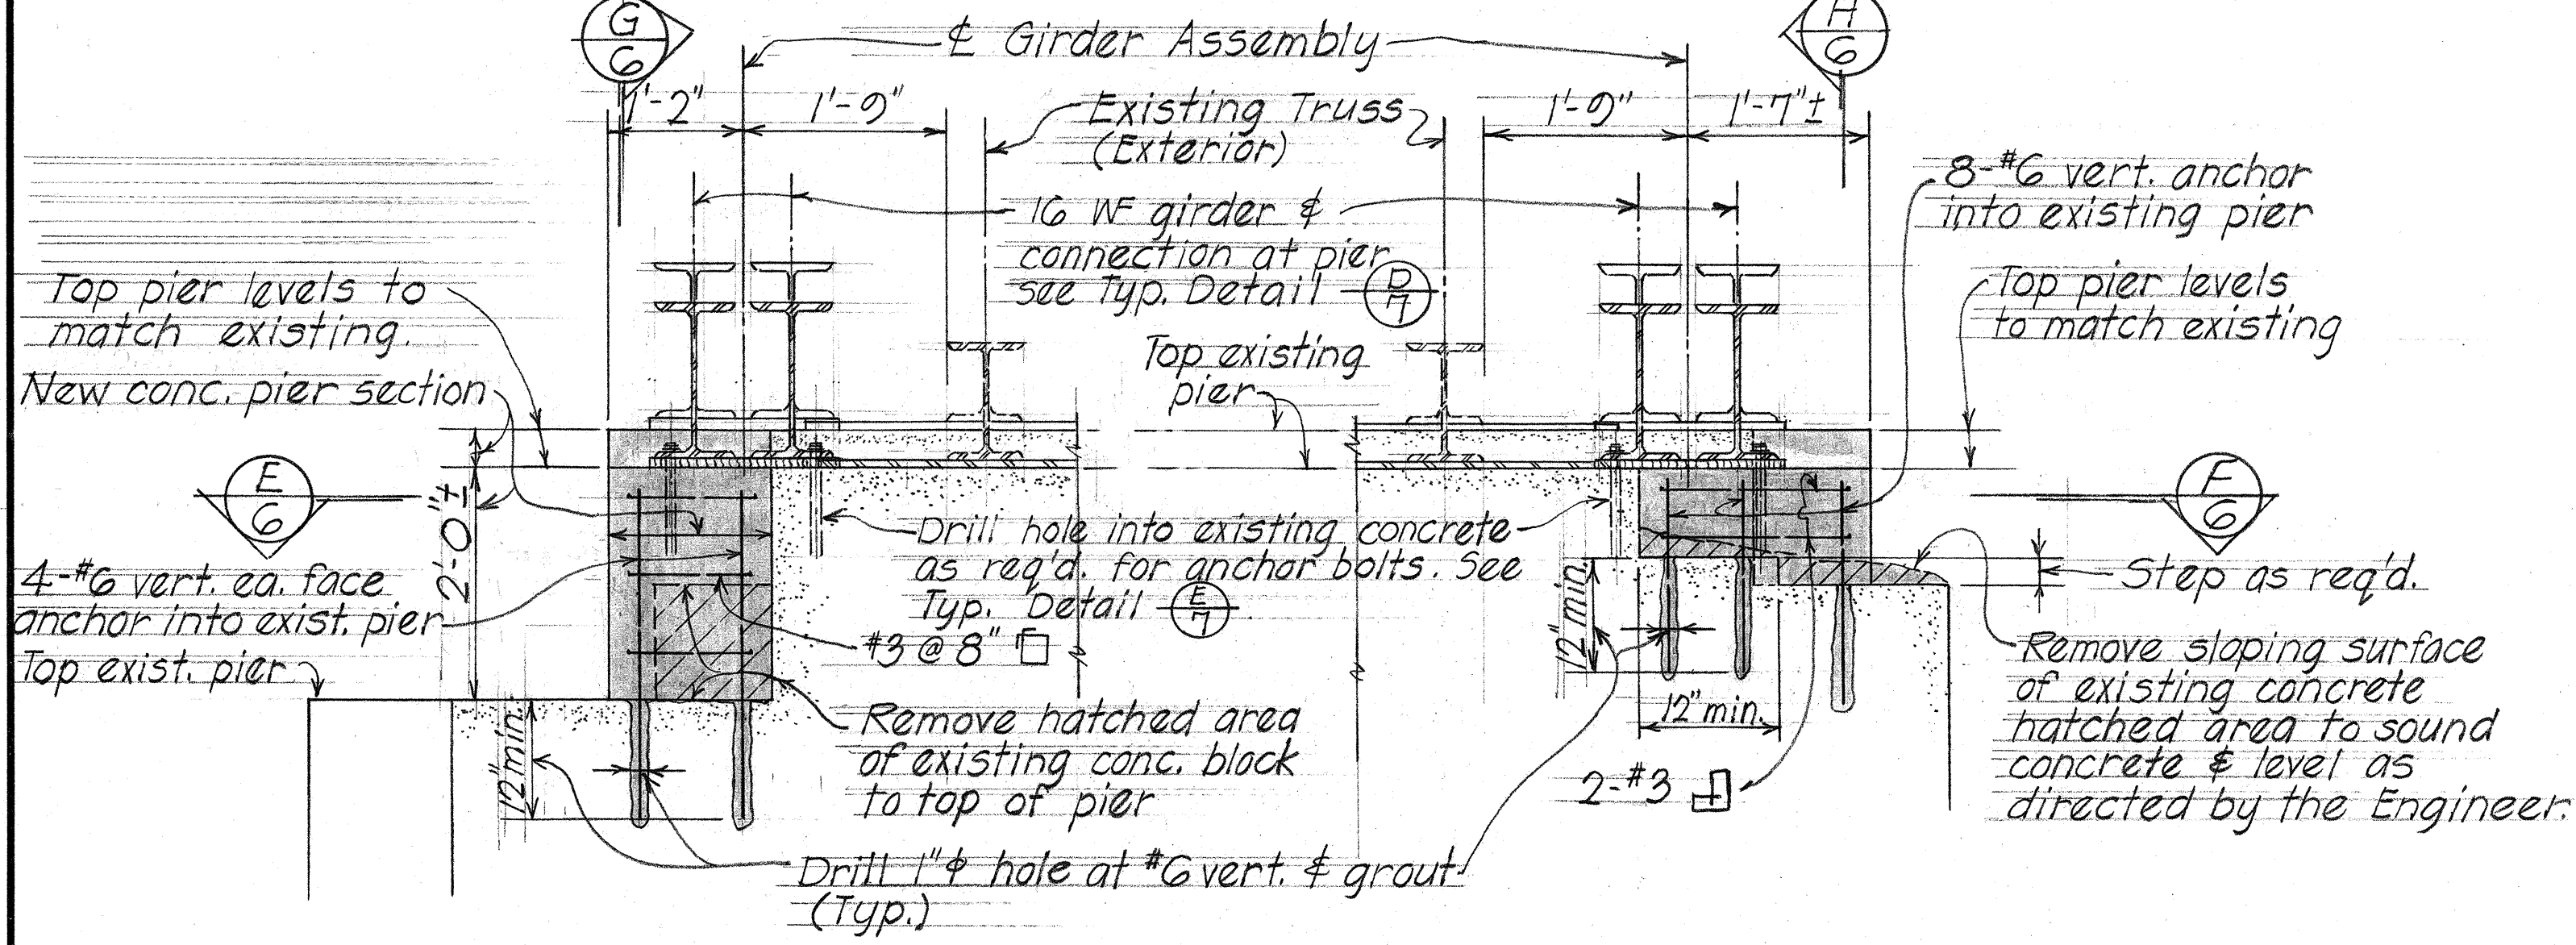


FED. ROAD DIST. NO.	STATE	PROJ. NO.	FISCAL YEAR	SHEET NO.	TOTAL SHEETS
	HAWAII	BD-63-381	1969	6	8
Unit 1					

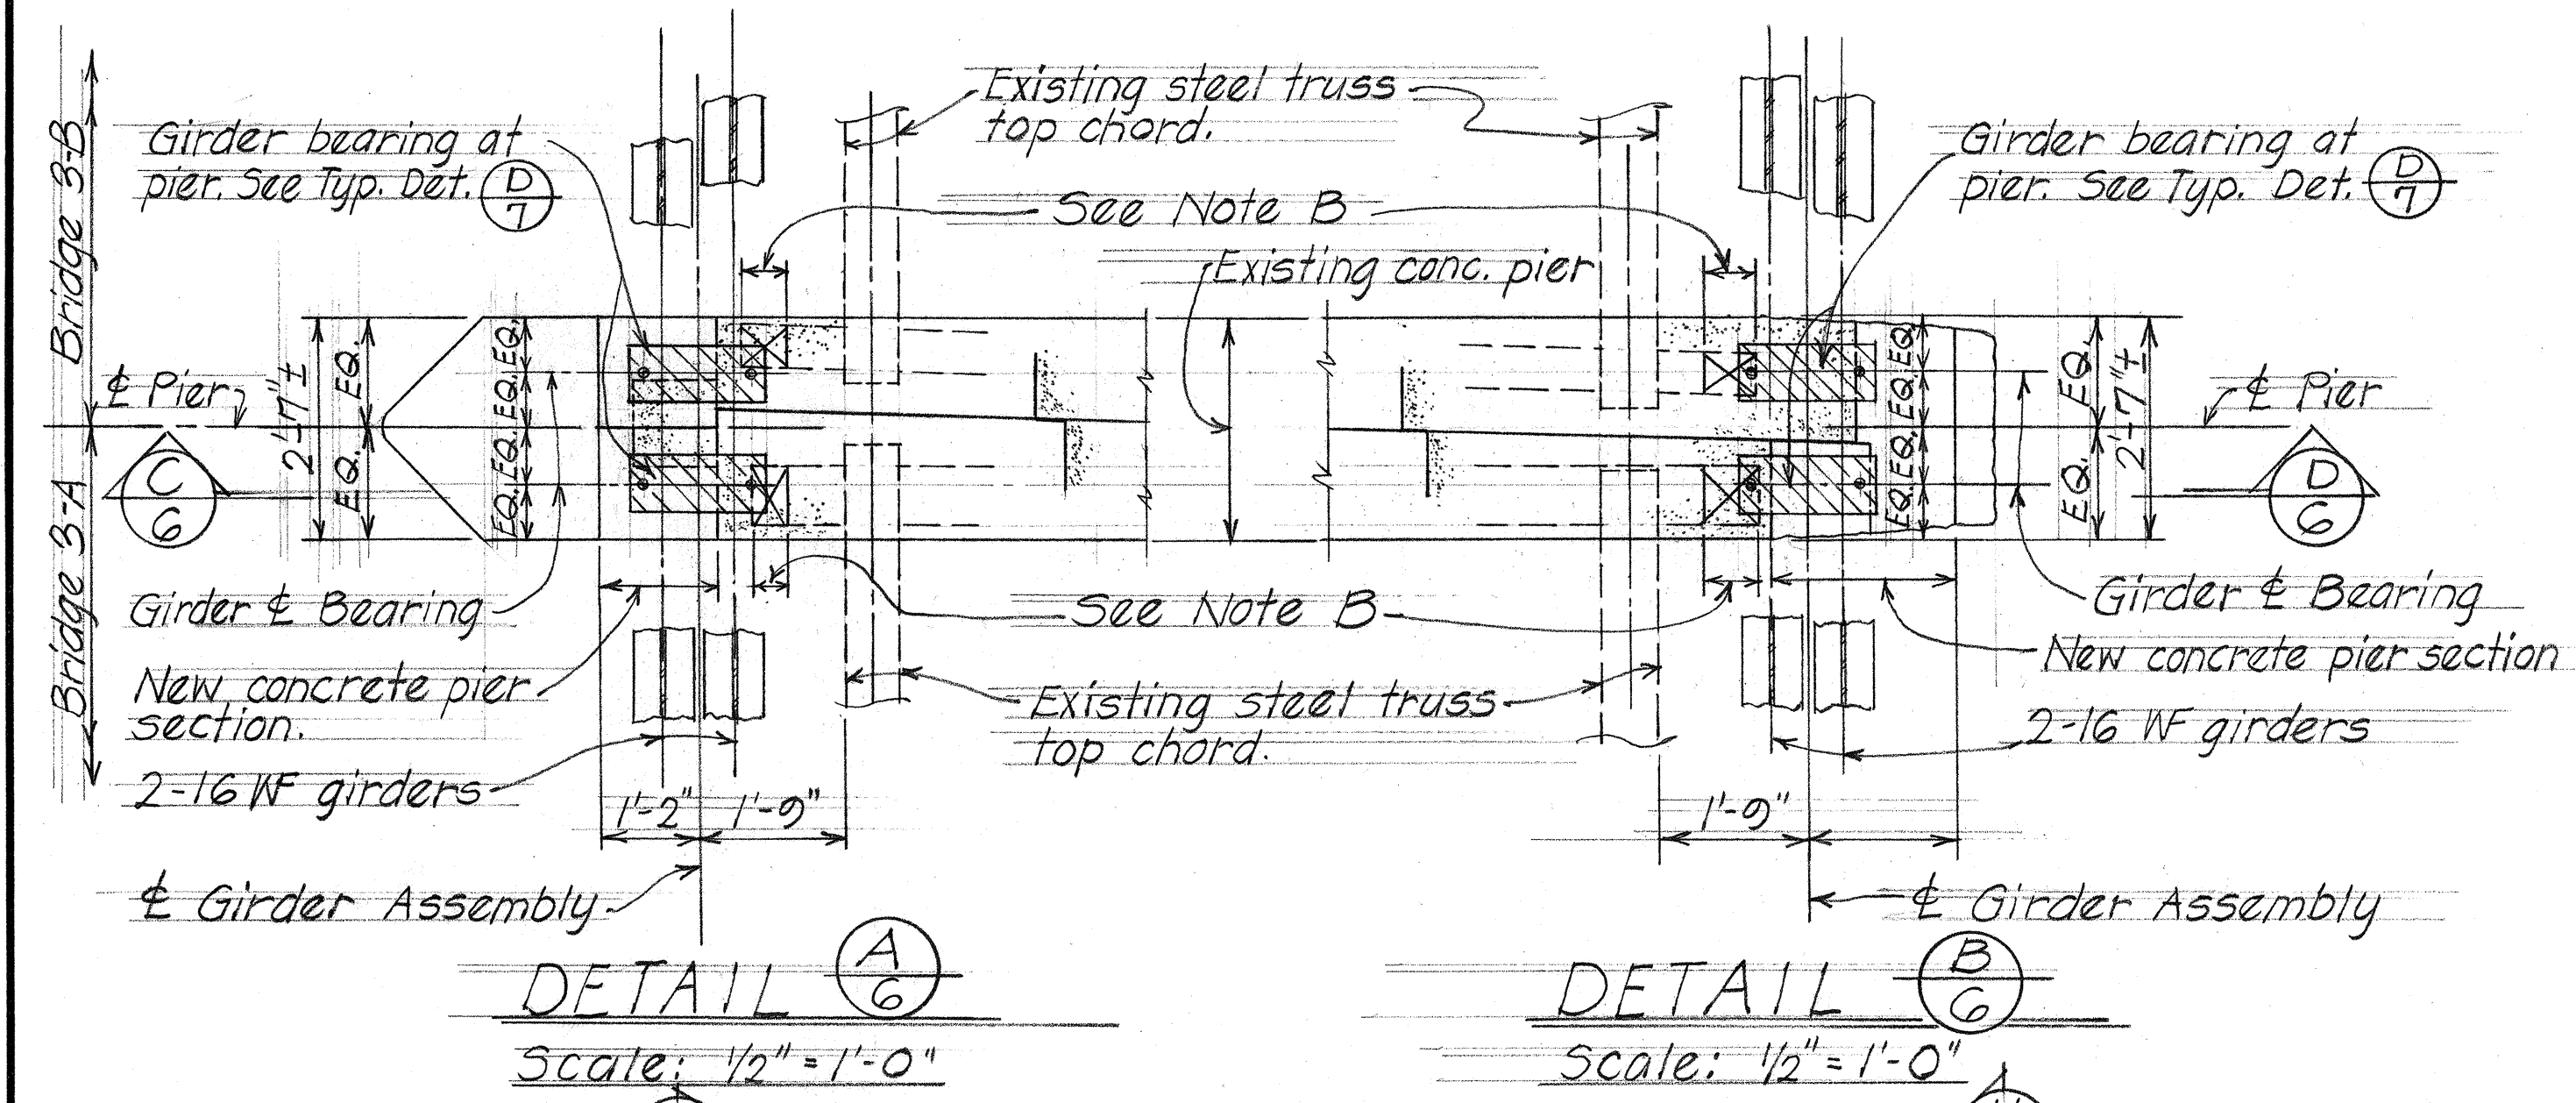

STATE OF HAWAII
DEPARTMENT OF TRANSPORTATION
HIGHWAYS DIVISION

BRIDGE IMPROVEMENT

WAINIHA BRIDGES No 3-A, 3-B

Proj. No. BD-63-381, U-1 Oct. 1968

SHEET No. 6 OF 8 SHEETS

DATE	10/1/68
SURVEY PLOTTED BY	JK
PLAN	NY
DESIGNED BY	NY
QUANTITIES BY	NY
CHECKED BY	NY
NOTE BOOK	NY
No.	NY