




| FED. ROAD DIST. NO. | STATE | PROJ. NO. | FISCAL YEAR | SHEET NO. | TOTAL SHEETS |
|---------------------|-------|-----------|-------------|-----------|--------------|
| HAWAII | HAW. | 56D-02-72 | 1973 | 4 | 4 |

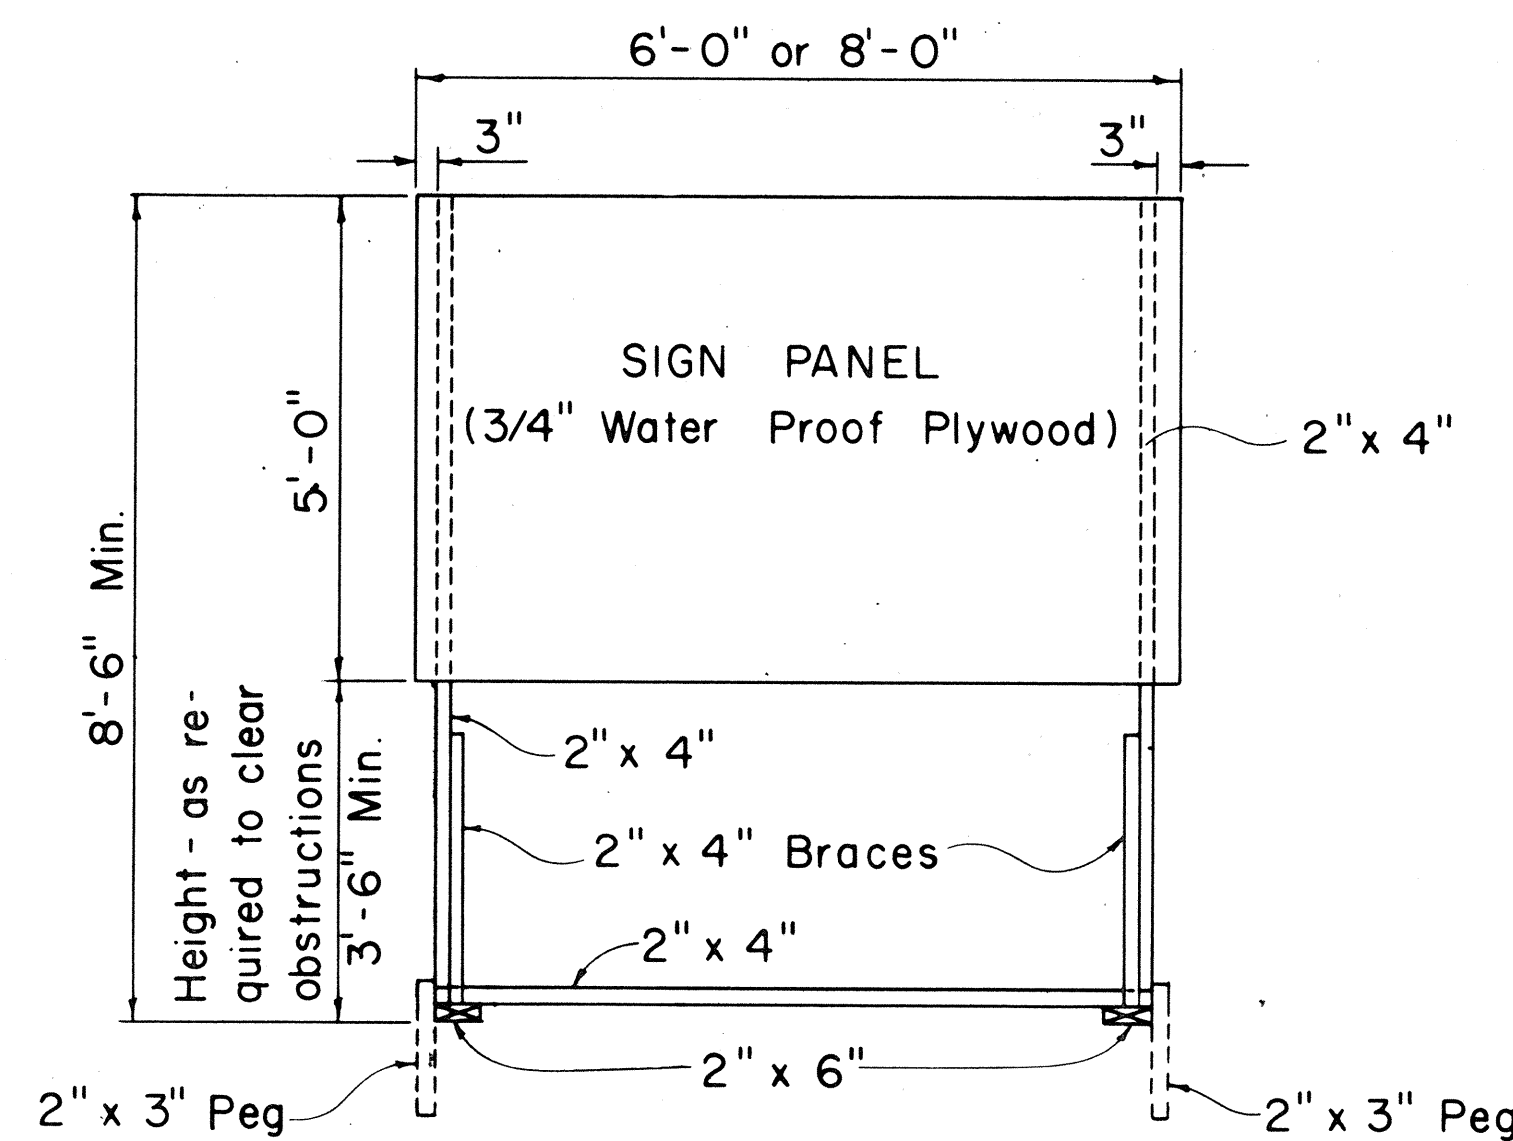

FRONT VIEW
Scale: 1/2" = 1'-0"

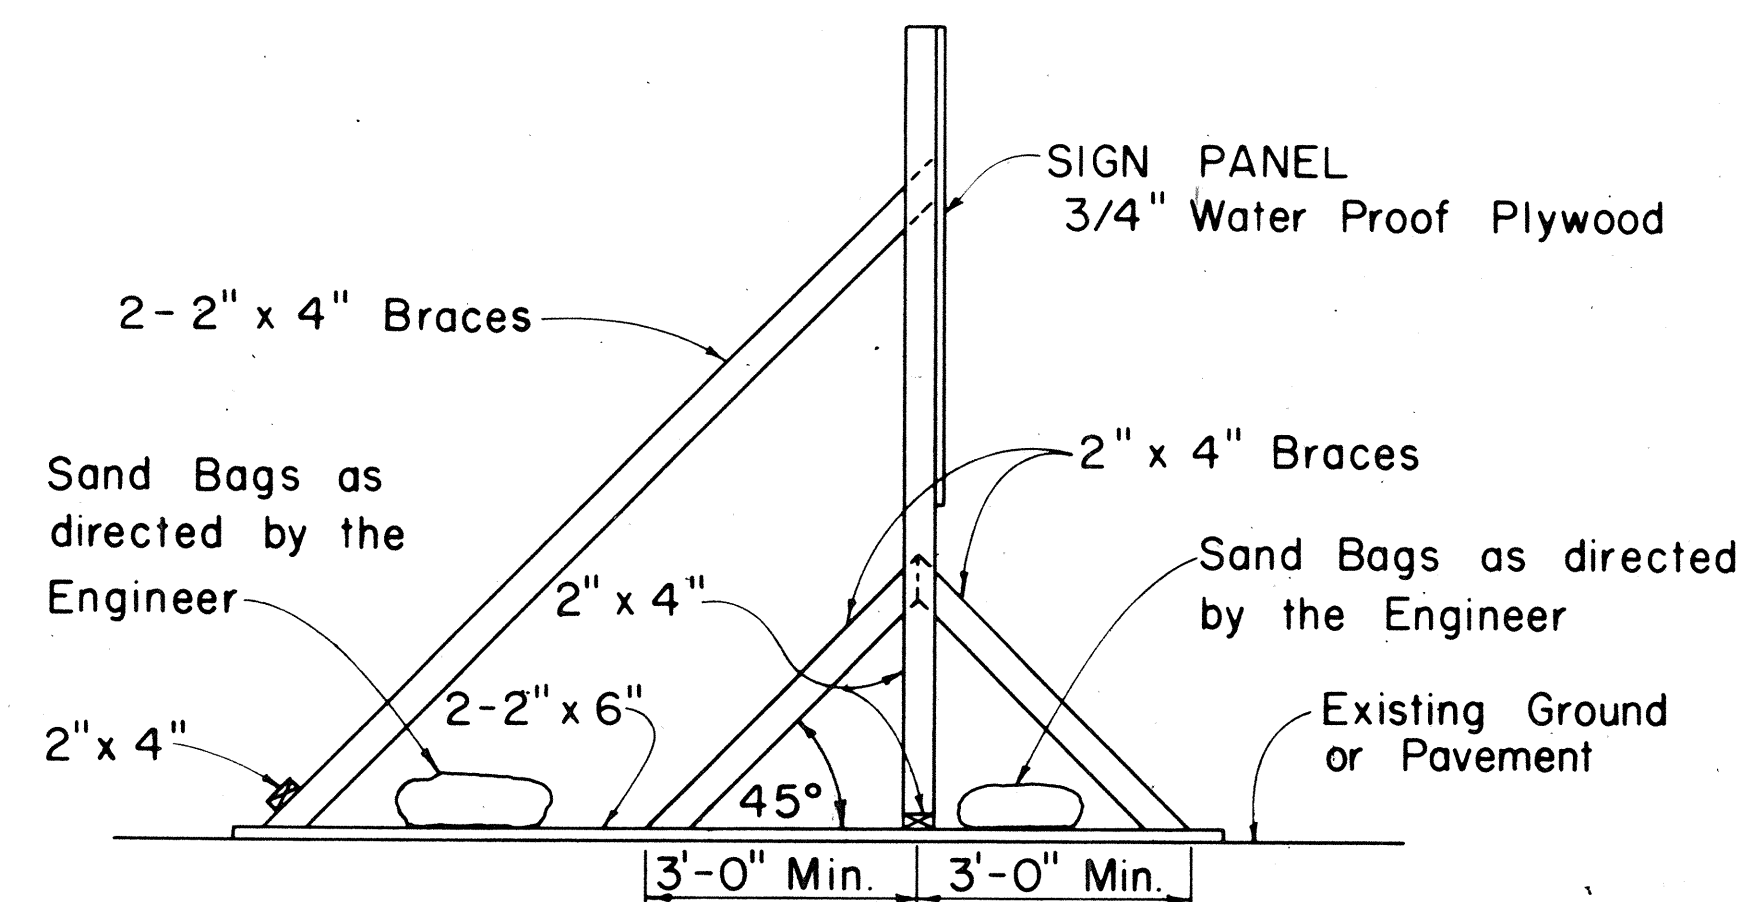


SIDE VIEW
(SIGN SUPPORT AND FRAME WEIGHTED DOWN)
Scale: 1/2" = 1'-0"

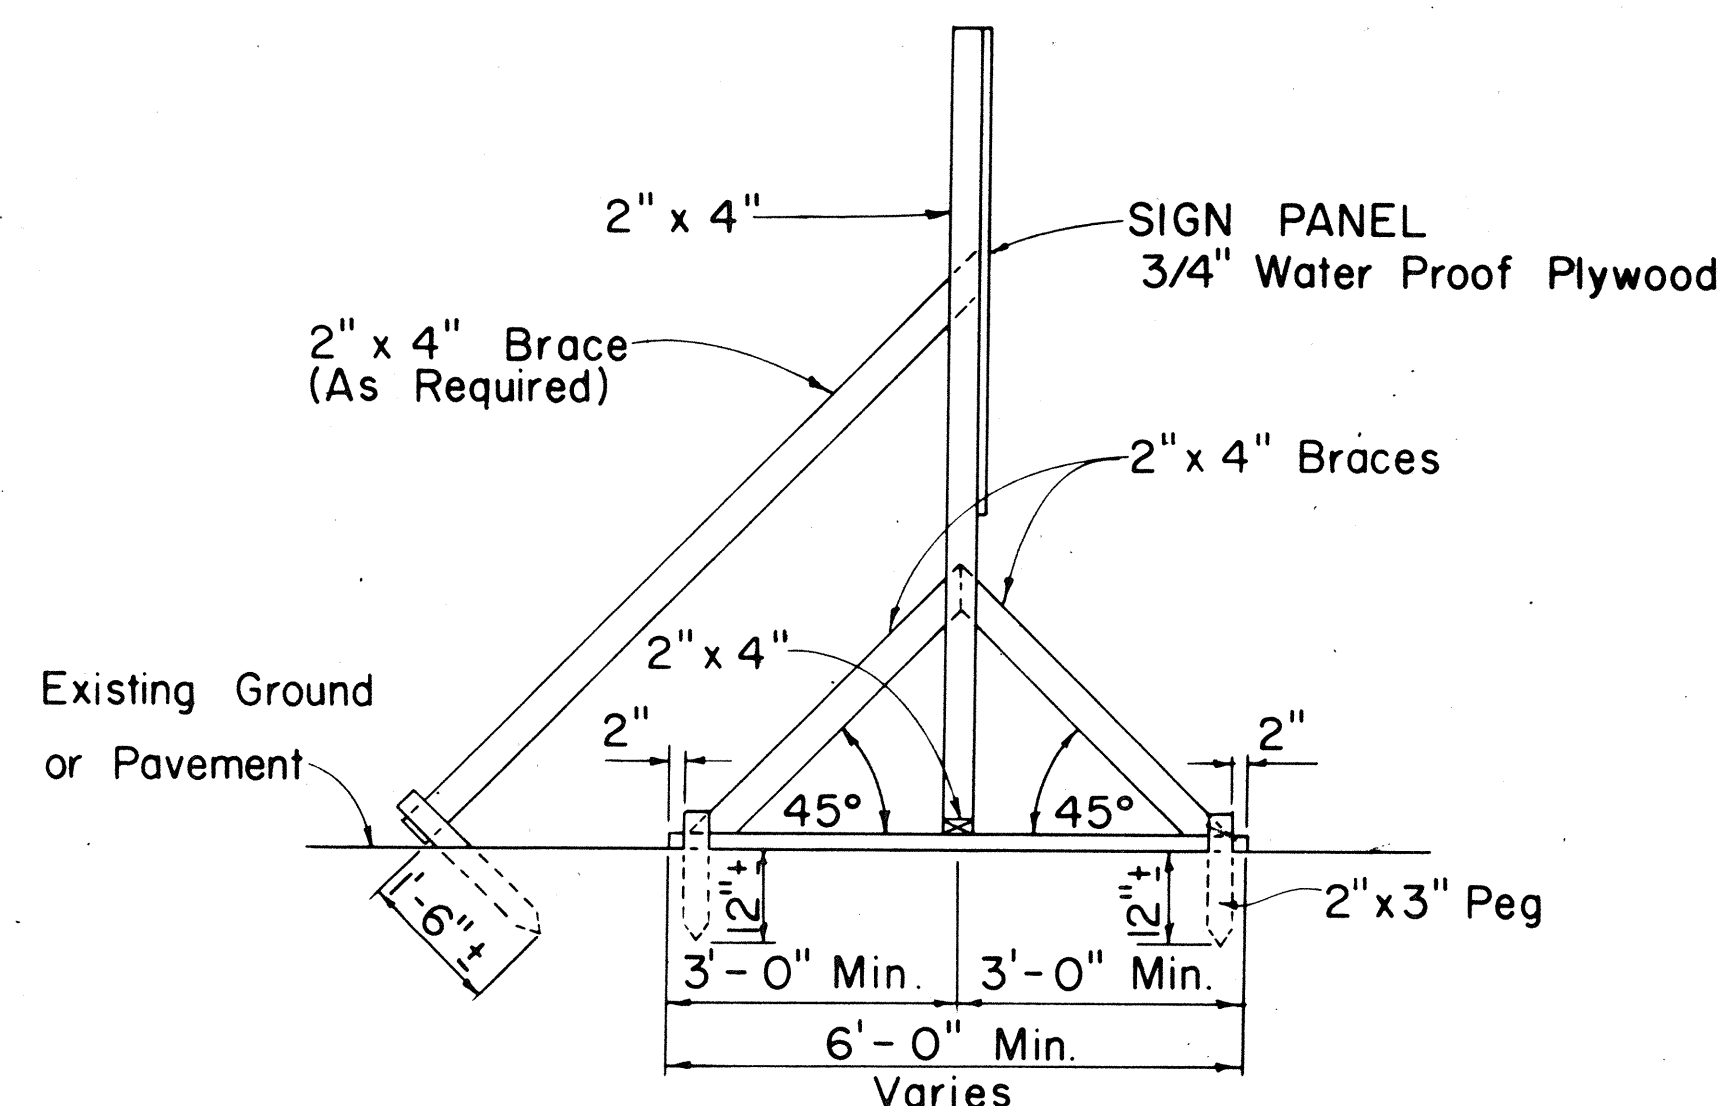

SIDE VIEW
(SIGN SUPPORT AND FRAME ANCHORED IN GROUND)
Scale: 1/2" = 1'-0"

SIGN SUPPORT AND FRAME
Scale: As Shown

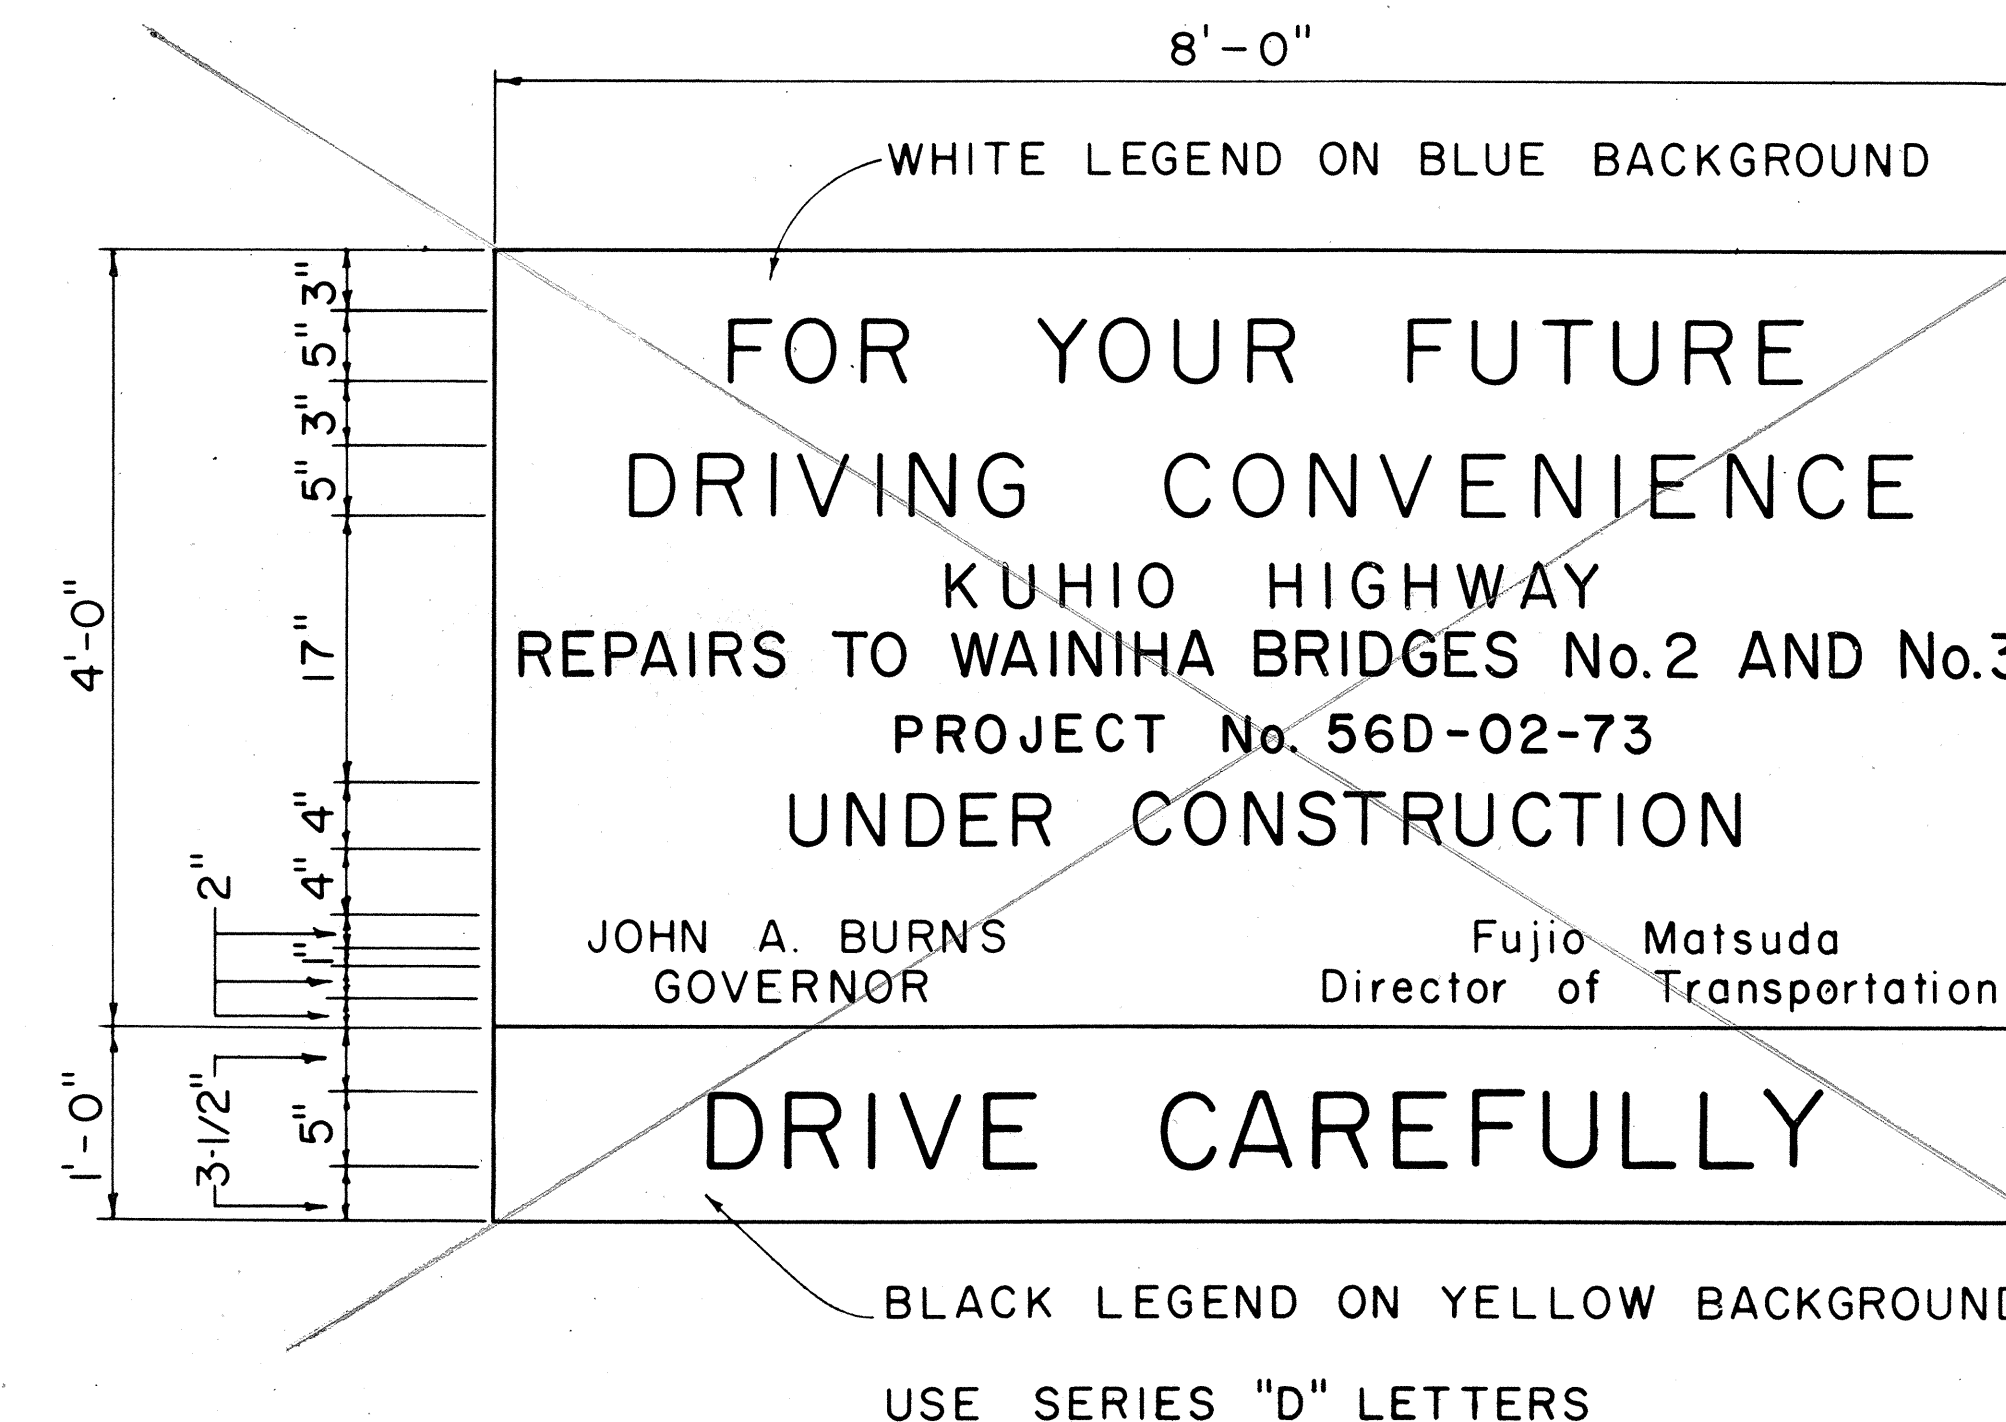

DELETED BY C.O. #1

STATE OF HAWAII
DEPARTMENT OF TRANSPORTATION
HIGHWAYS DIVISION
TYPICAL DETAILS

PROJECT INFORMATION SIGN

Scale: As Shown
SHEET No. 1 OF 1 SHEETS

| | | |
|---------------|-------------------|------|
| ORIGINAL PLAN | SURVEY PLOTTED BY | DATE |
| NO. 1 | DRAWN BY | |
| NO. 2 | TRACED BY | |
| NO. 3 | CHECKED BY | |
| NO. 4 | CHECKED BY | |
| NO. 5 | CHECKED BY | |
| NO. 6 | CHECKED BY | |
| NO. 7 | CHECKED BY | |
| NO. 8 | CHECKED BY | |
| NO. 9 | CHECKED BY | |
| NO. 10 | CHECKED BY | |