

INDEX TO DRAWINGS	
SHEET NO.	DESCRIPTION
1	TITLE SHEET
2	PLAN AND SECTIONS BRIDGE NO. 2
3	PLAN AND SECTIONS BRIDGE NO. 3
4	PROJECT INFORMATION SIGN

May 1973

Date

548-1537

Phone-Loc

D. Devier

PS&E By

Kauai District

Designed By

SURVEY PLOTTED BY	DATE
DESIGNED BY	
DRAWN BY	
CHECKED BY	
NOTE BOOK	
QUANTITIES CHECKED BY	
QUANTITIES CHECKED BY	
ORIGINAL	
PLAN	
NO.	

STATE OF HAWAII

DEPARTMENT OF TRANSPORTATION

HIGHWAYS DIVISION

"AS BUILT"

PLANS FOR



KUHIO HIGHWAY, REPAIRS TO WAINIHA

BRIDGES NO. 2 AND NO. 3, KAUAI

PROJECT NO. 56D-02-73

DISTRICT OF HANAIEI

ISLAND OF KAUAI

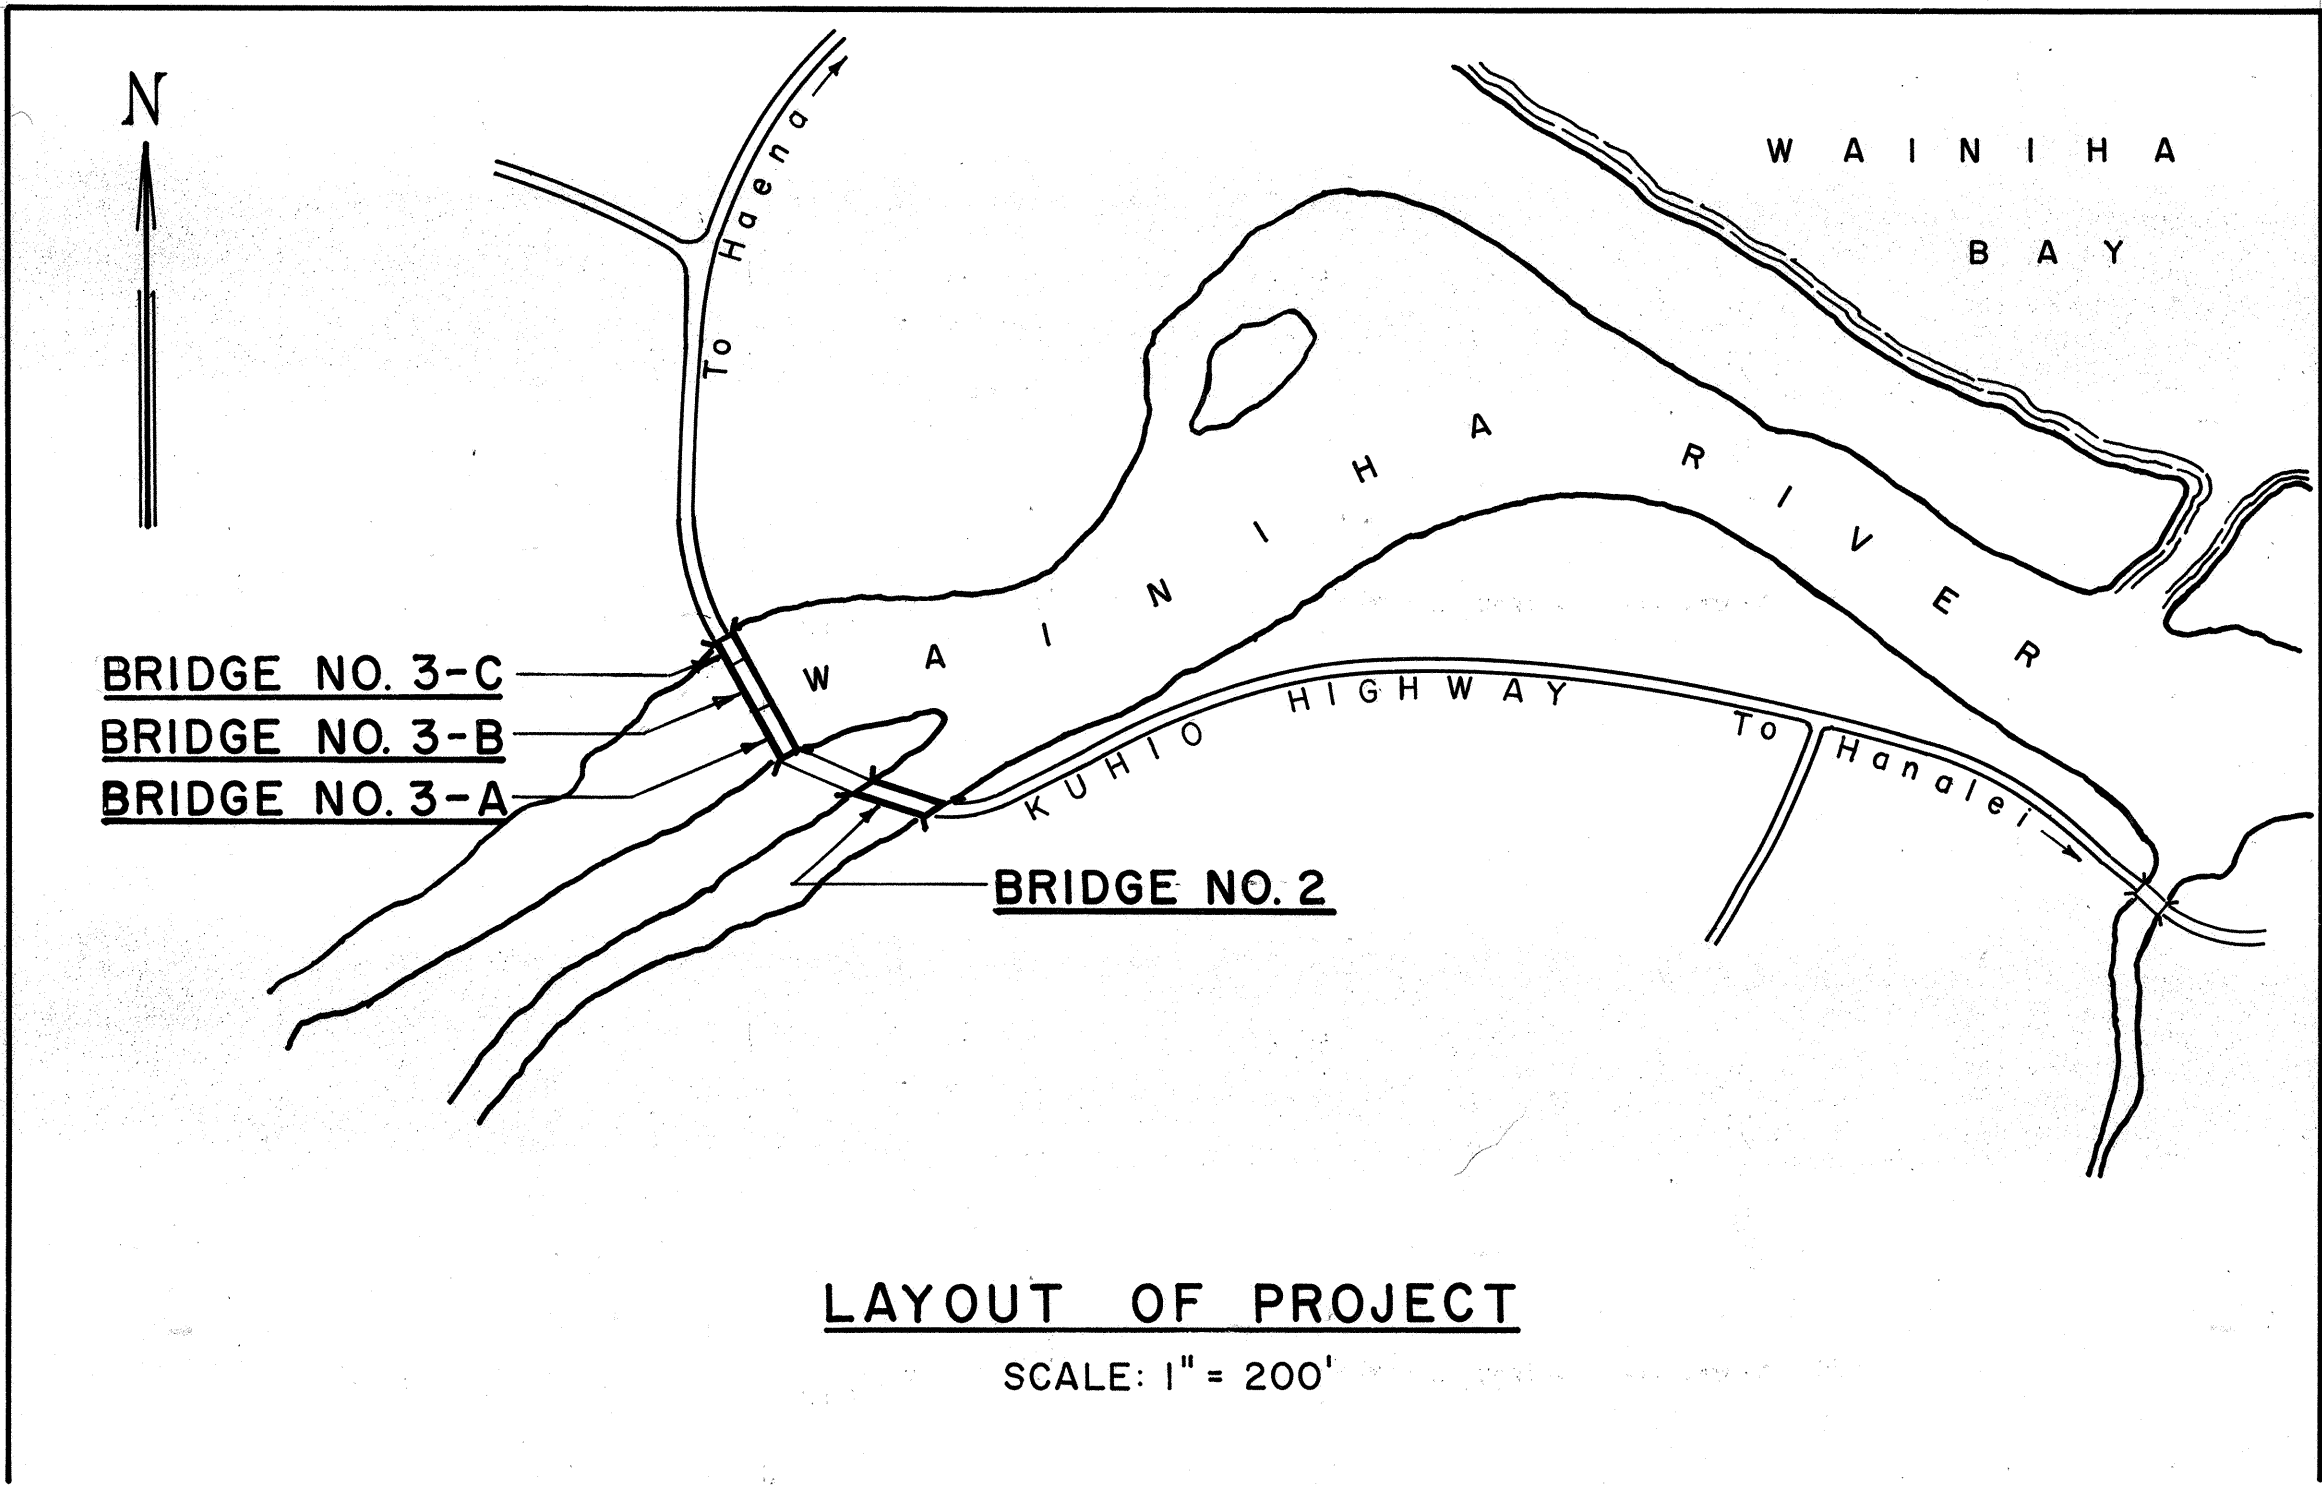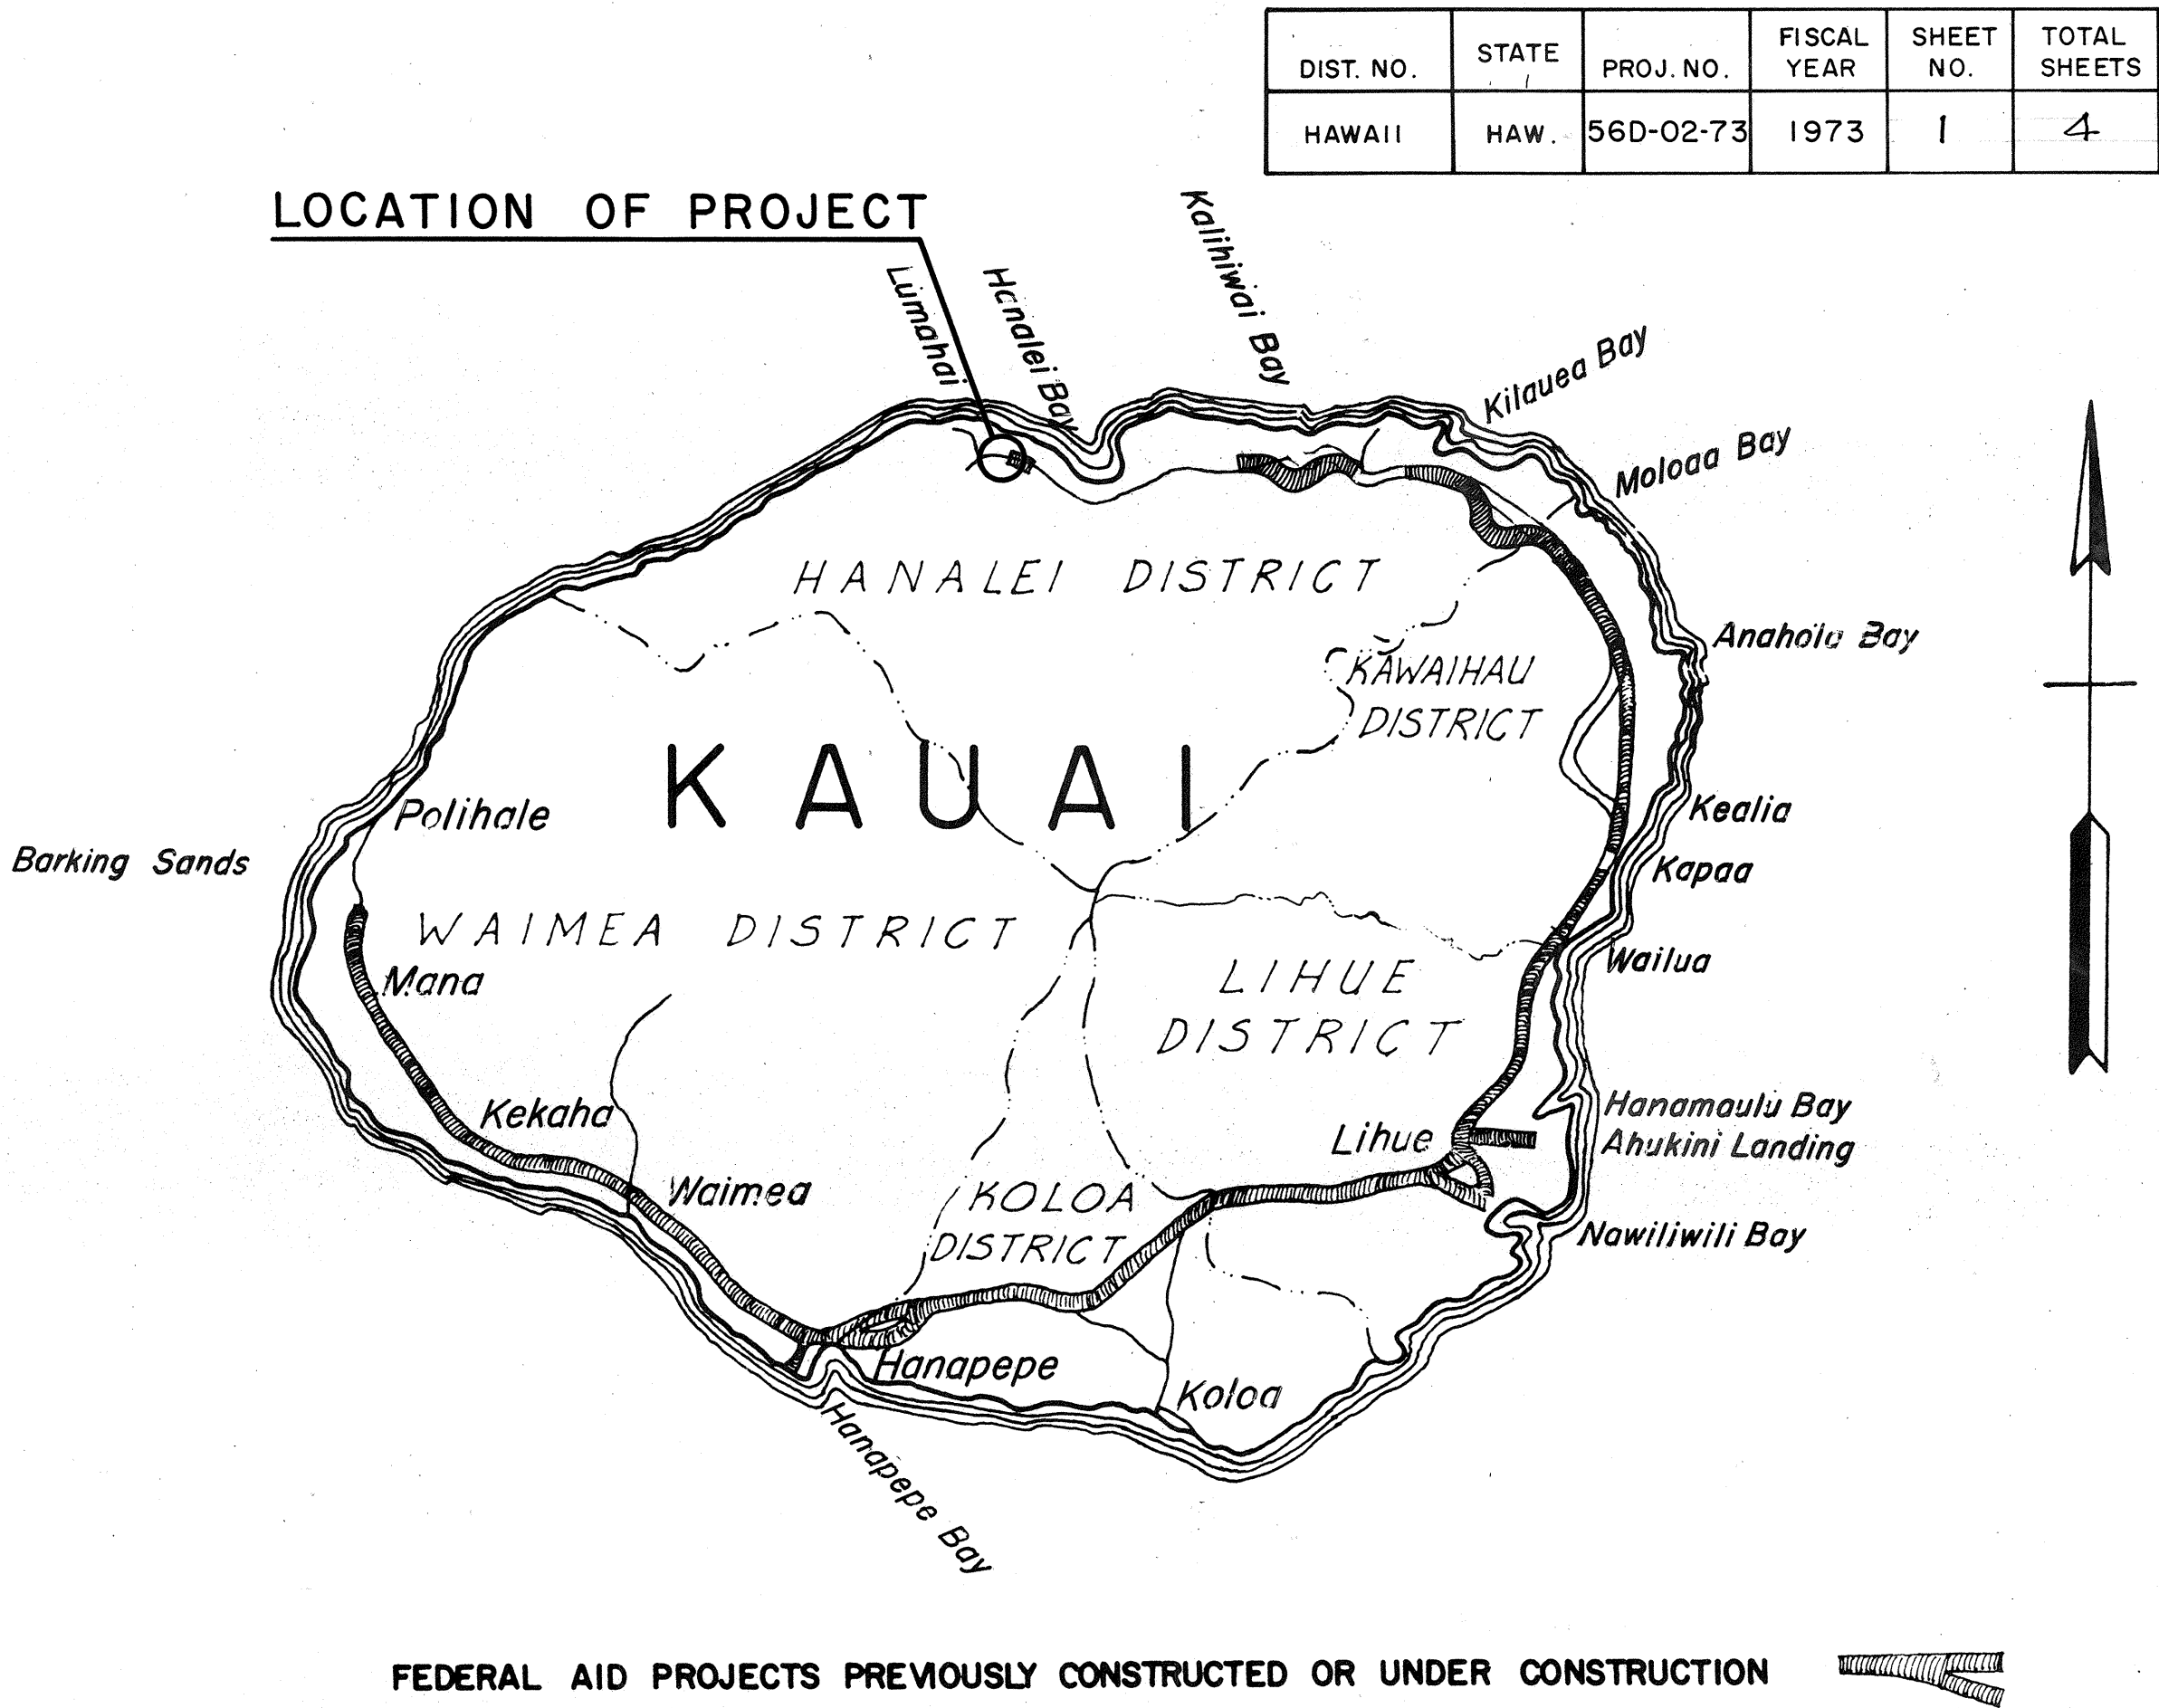

ALL CHANGES MADE DURING CONSTRUCTION

HAVE BEEN INCORPORATED ON THESE PLANS

EXCEPT CHANGES IN THE ORIGINAL THEORETICAL

QUANTITIES

[Signature]

1-22-81

PROJECT ENGINEER

DATE

DEPARTMENT OF TRANSPORTATION

STATE OF HAWAII

APPROVED:

[Signature]

5/7/73

FOR DIR. OF TRANSPORTATION

DATE