

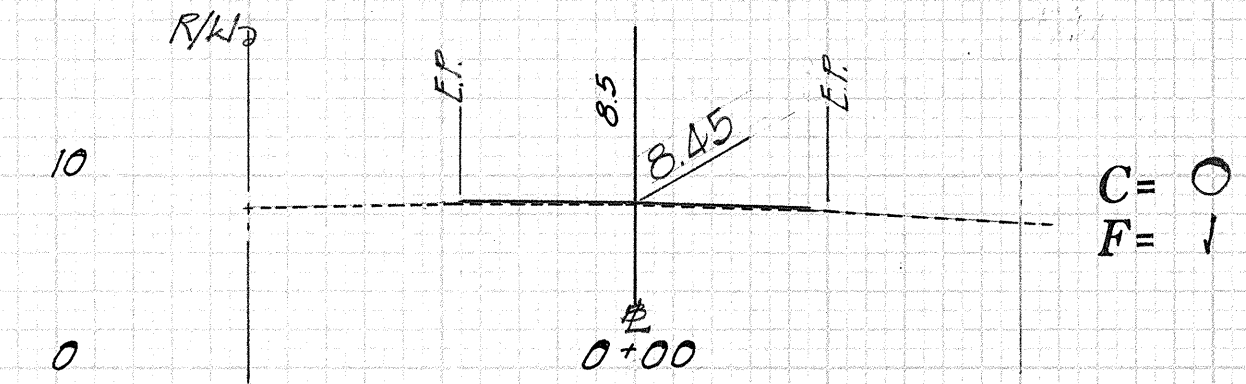
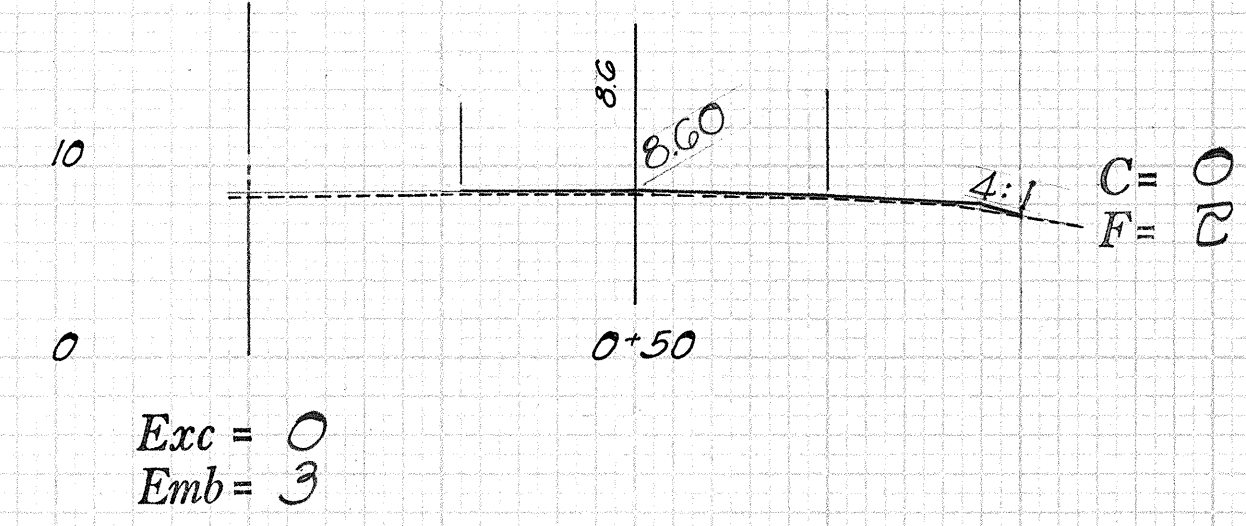
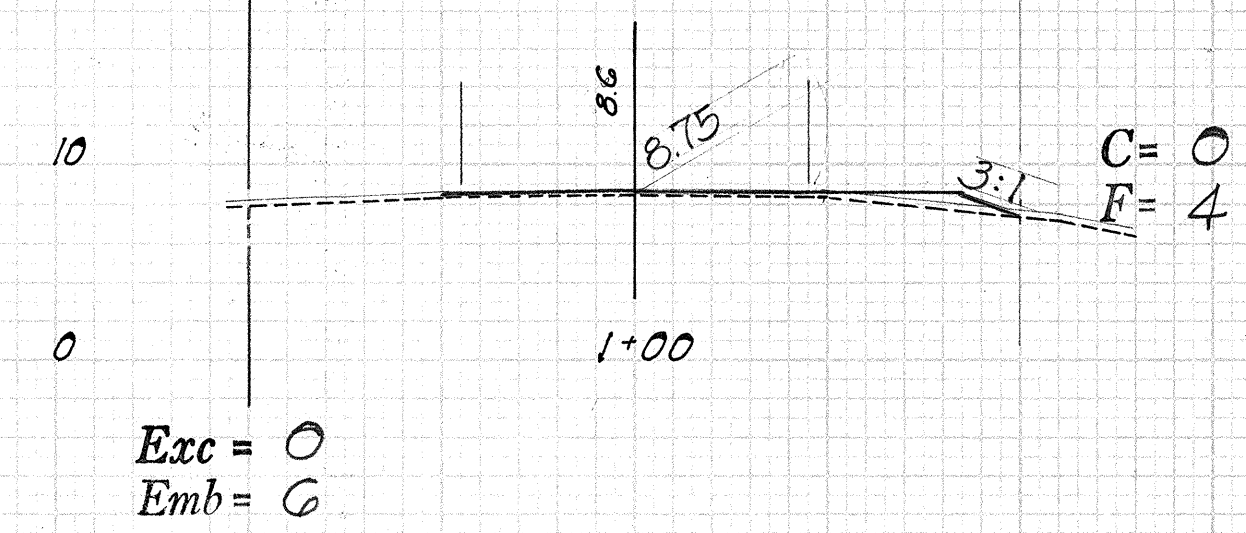
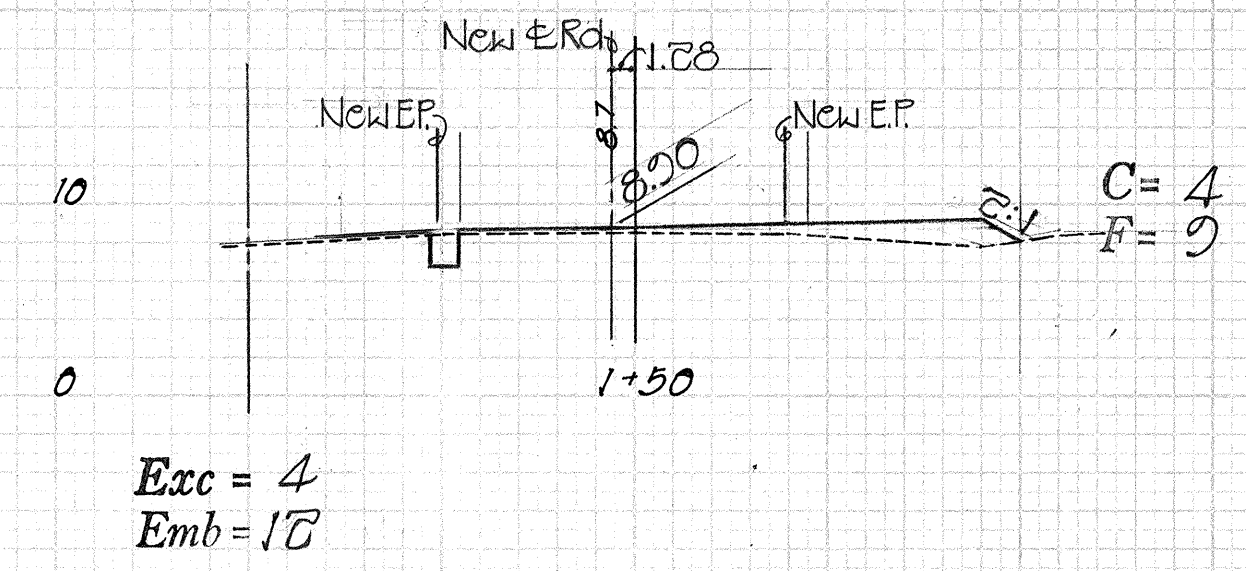
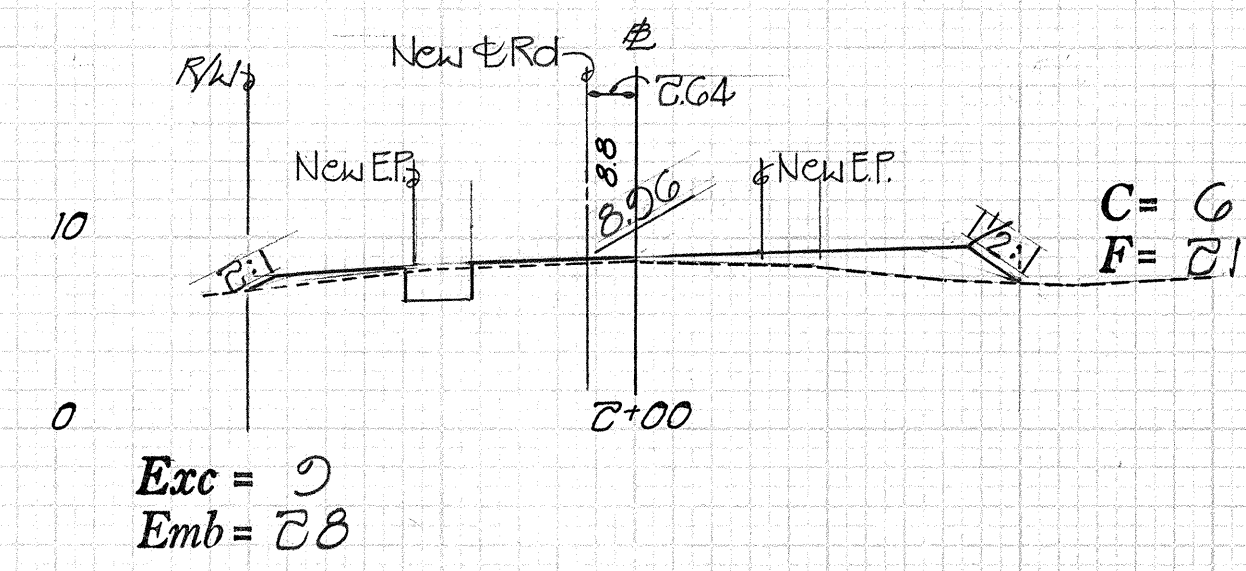
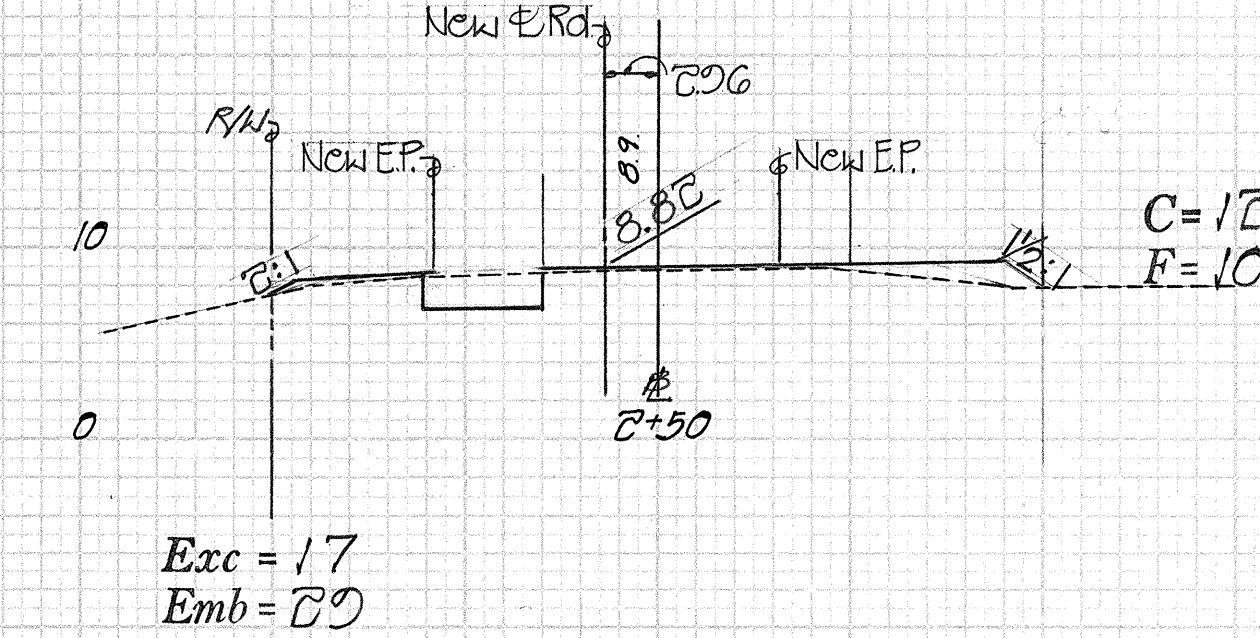
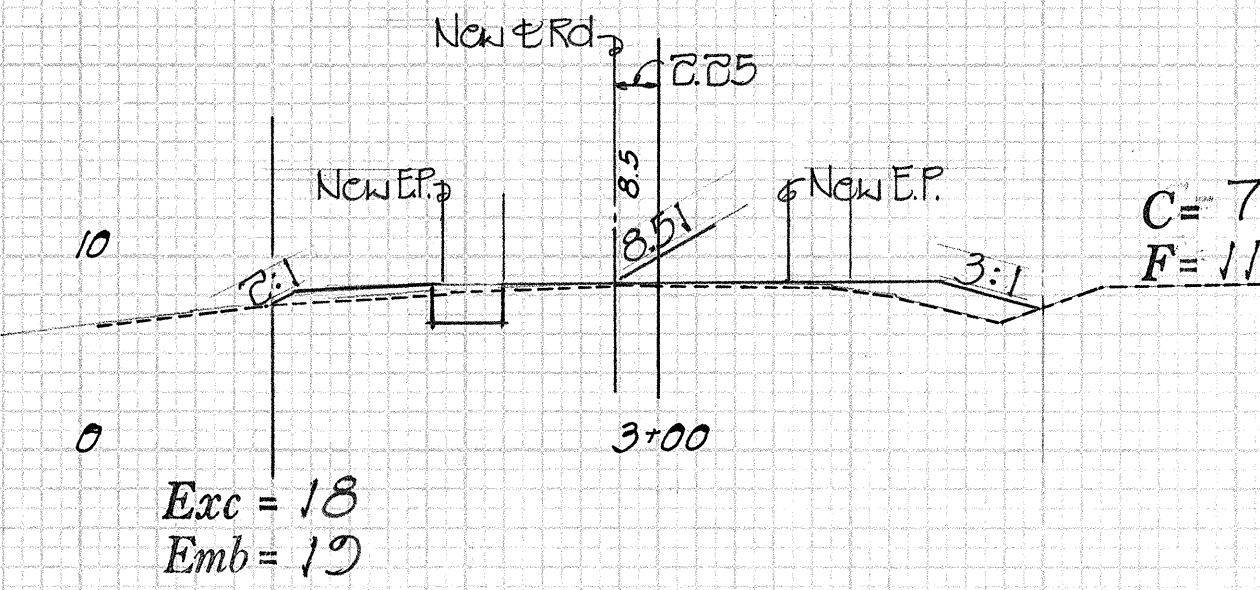
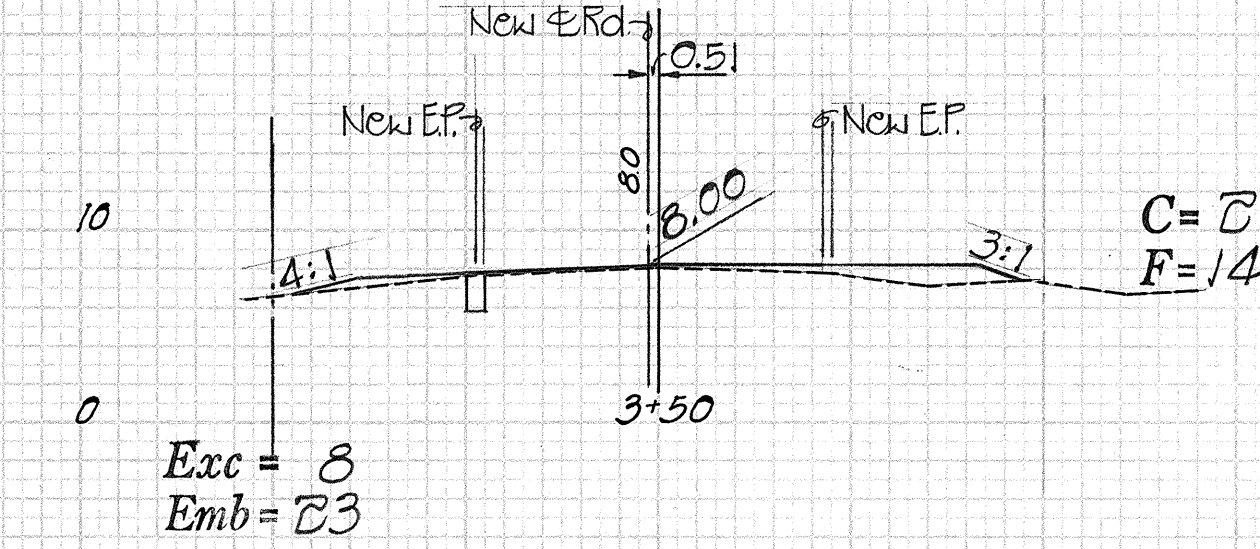


DIST. NO.	STATE	PROJ. NO.	FISCAL YEAR	SHEET NO.	TOTAL SHEETS
HAWAII	HAW.	56D-01-80	1980	18	18

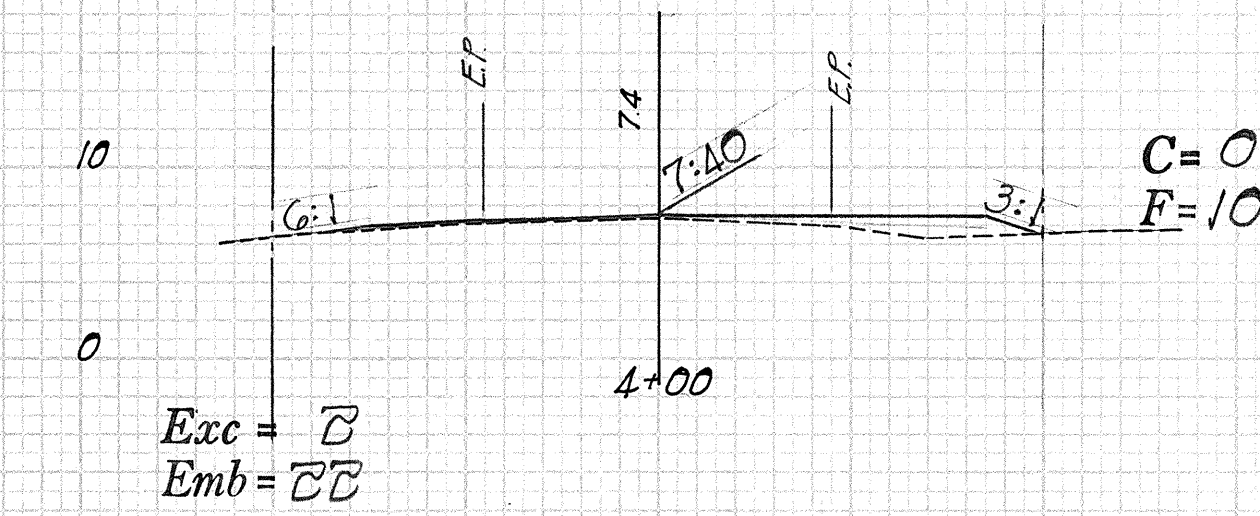

30 20 10 0 10 20 30

Scale: 1" = 10' Bothways

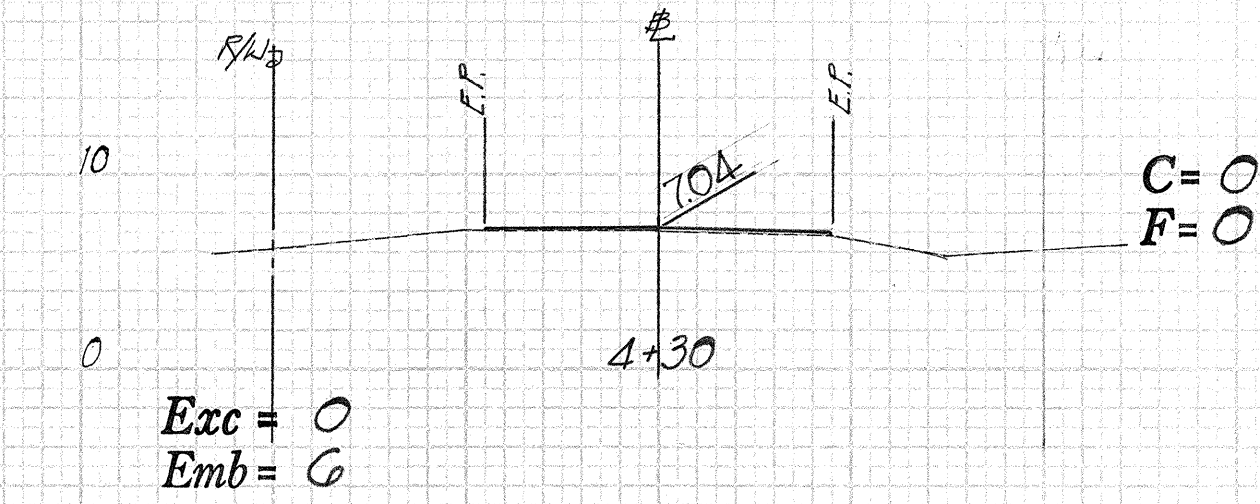

30 20 10 0 10 20 30