
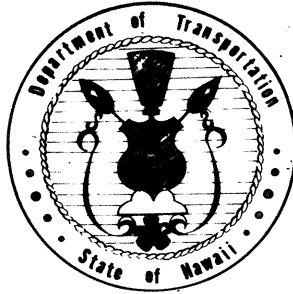


INDEX TO DRAWINGS	
SHEET NO.	DESCRIPTION
1	TITLE SHEET
2	PLAN - PRATT TRUSS
3	PLAN - WARREN TRUSS
4	STANDARD DETAILS

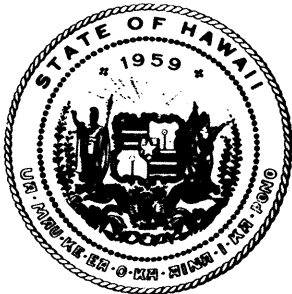



STATE OF HAWAII
 DEPARTMENT OF TRANSPORTATION
 HIGHWAYS DIVISION

HONOLULU, HAWAII

"AS BUILT"
 PLANS FOR
 KUHIO HIGHWAY
 PAINTING OF HANAIEI BRIDGE
 PROJECT NO. 56D-02-82M




DISTRICT OF HANAIEI
 ISLAND OF KAUAI

PACIFIC OCEAN

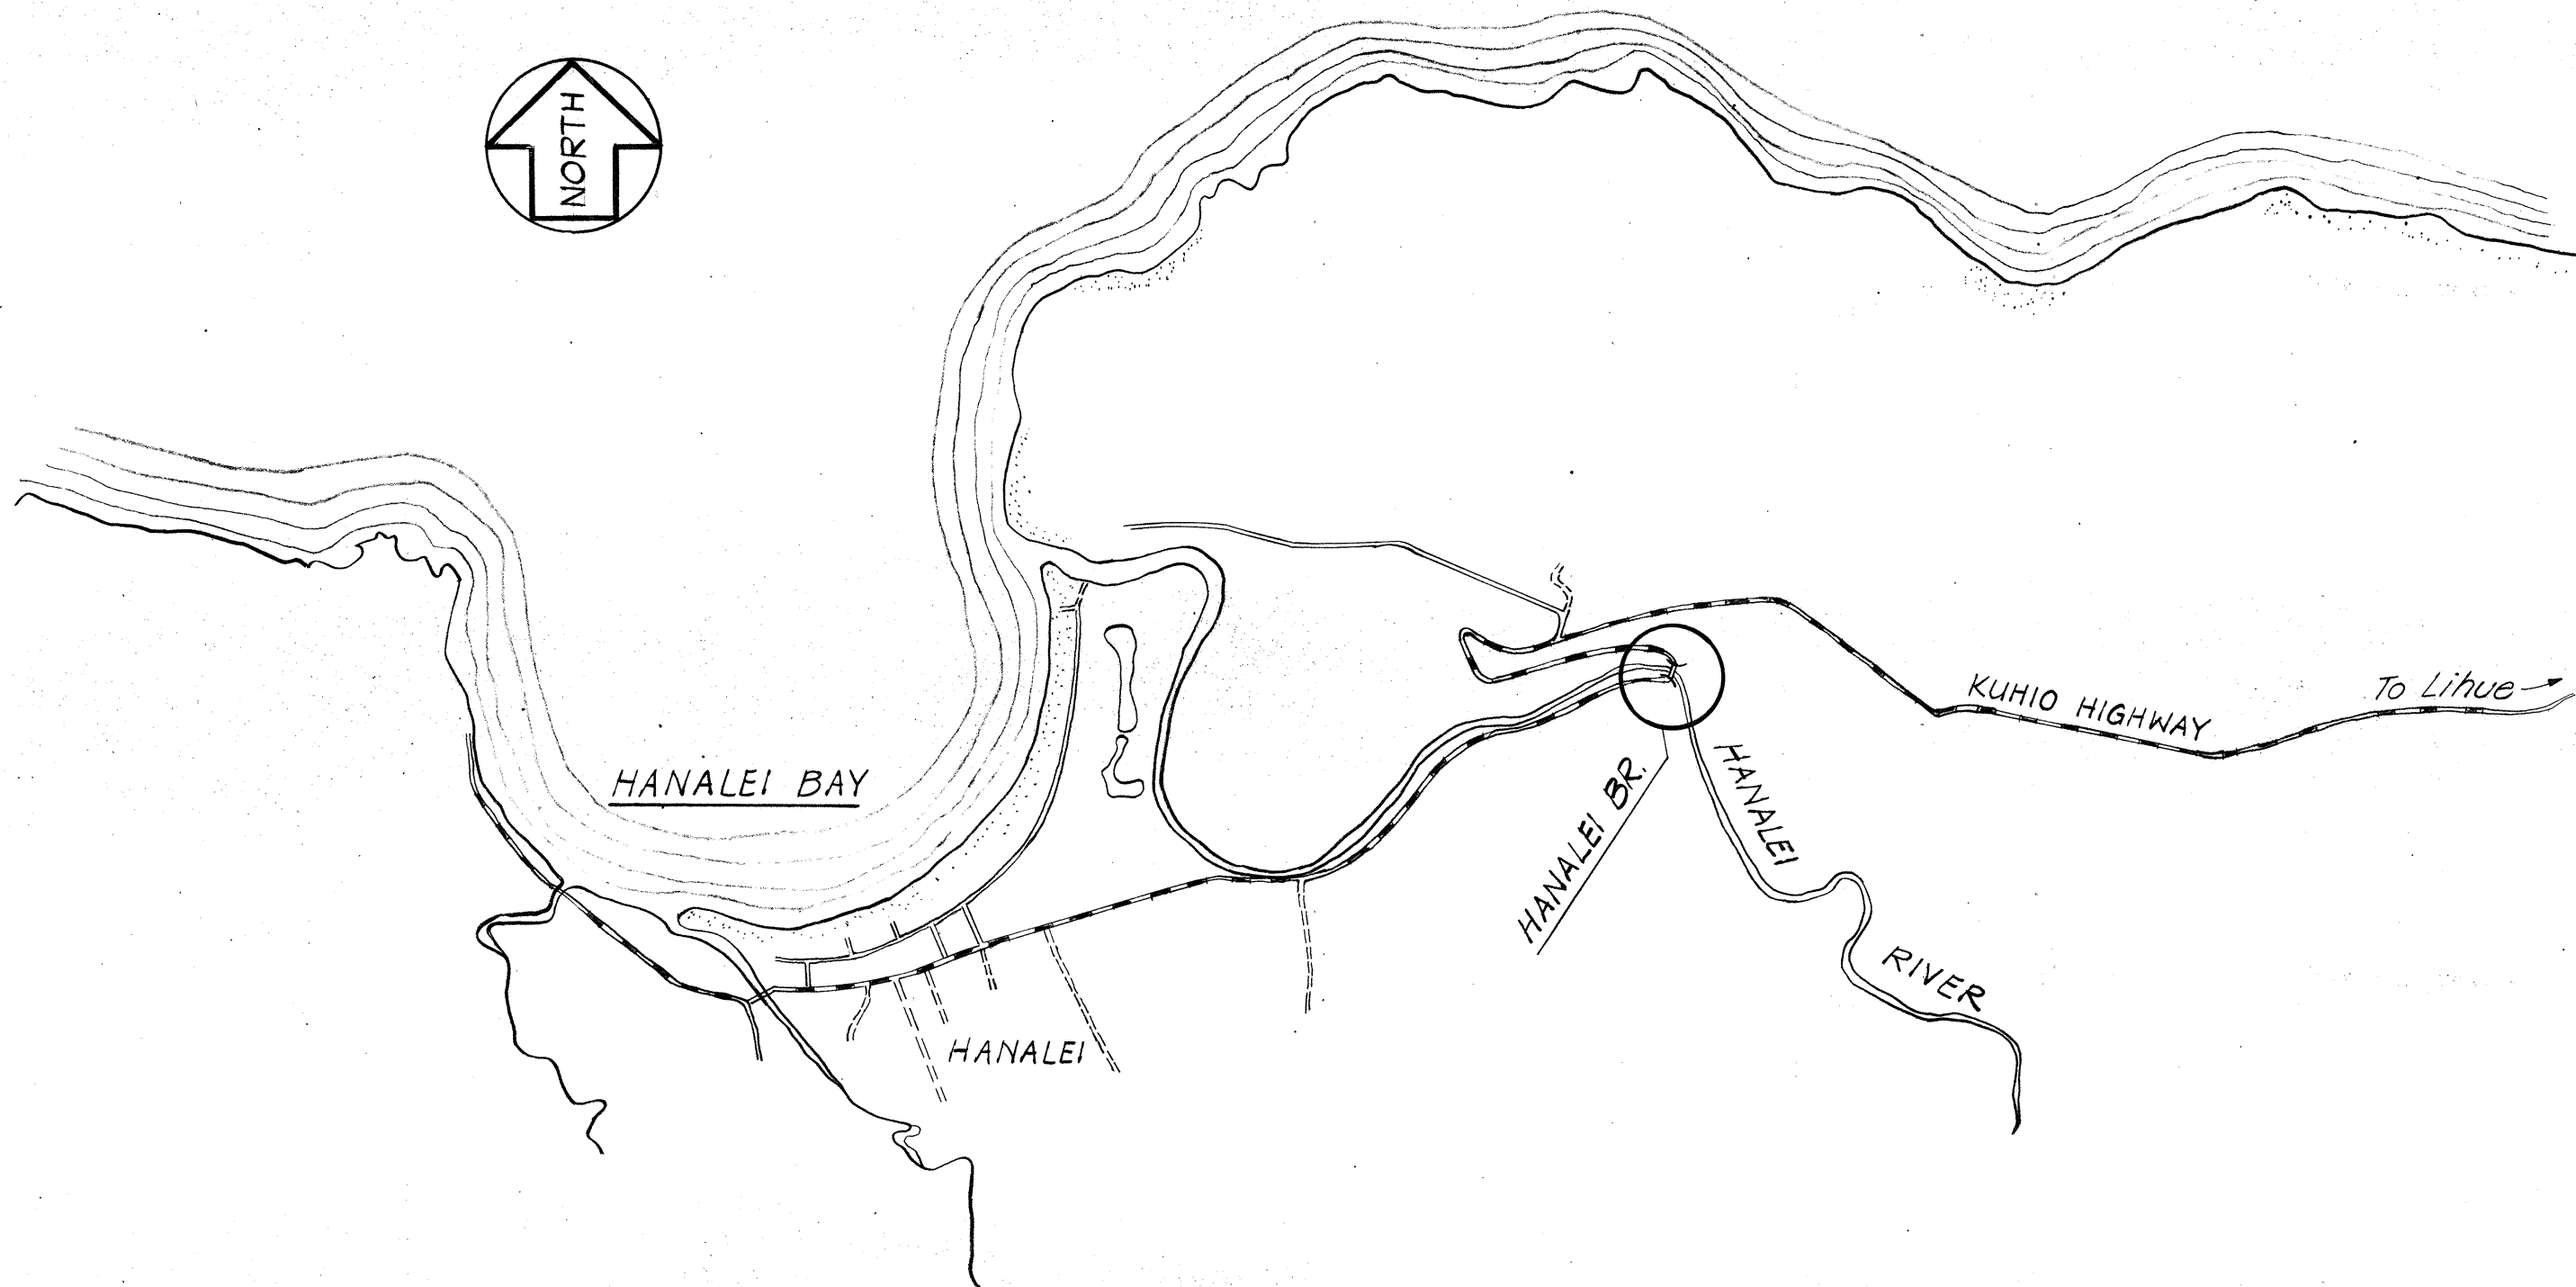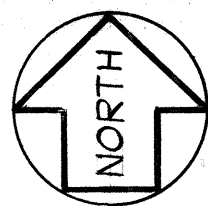

LOCATION PLAN
 Not To Scale

FED. ROAD DIST. NO.	STATE	PROJ. NO.	FISCAL YEAR	SHEET NO.	TOTAL SHEETS
HAWAII	HAW.	56D-02-82M	1982	I	4

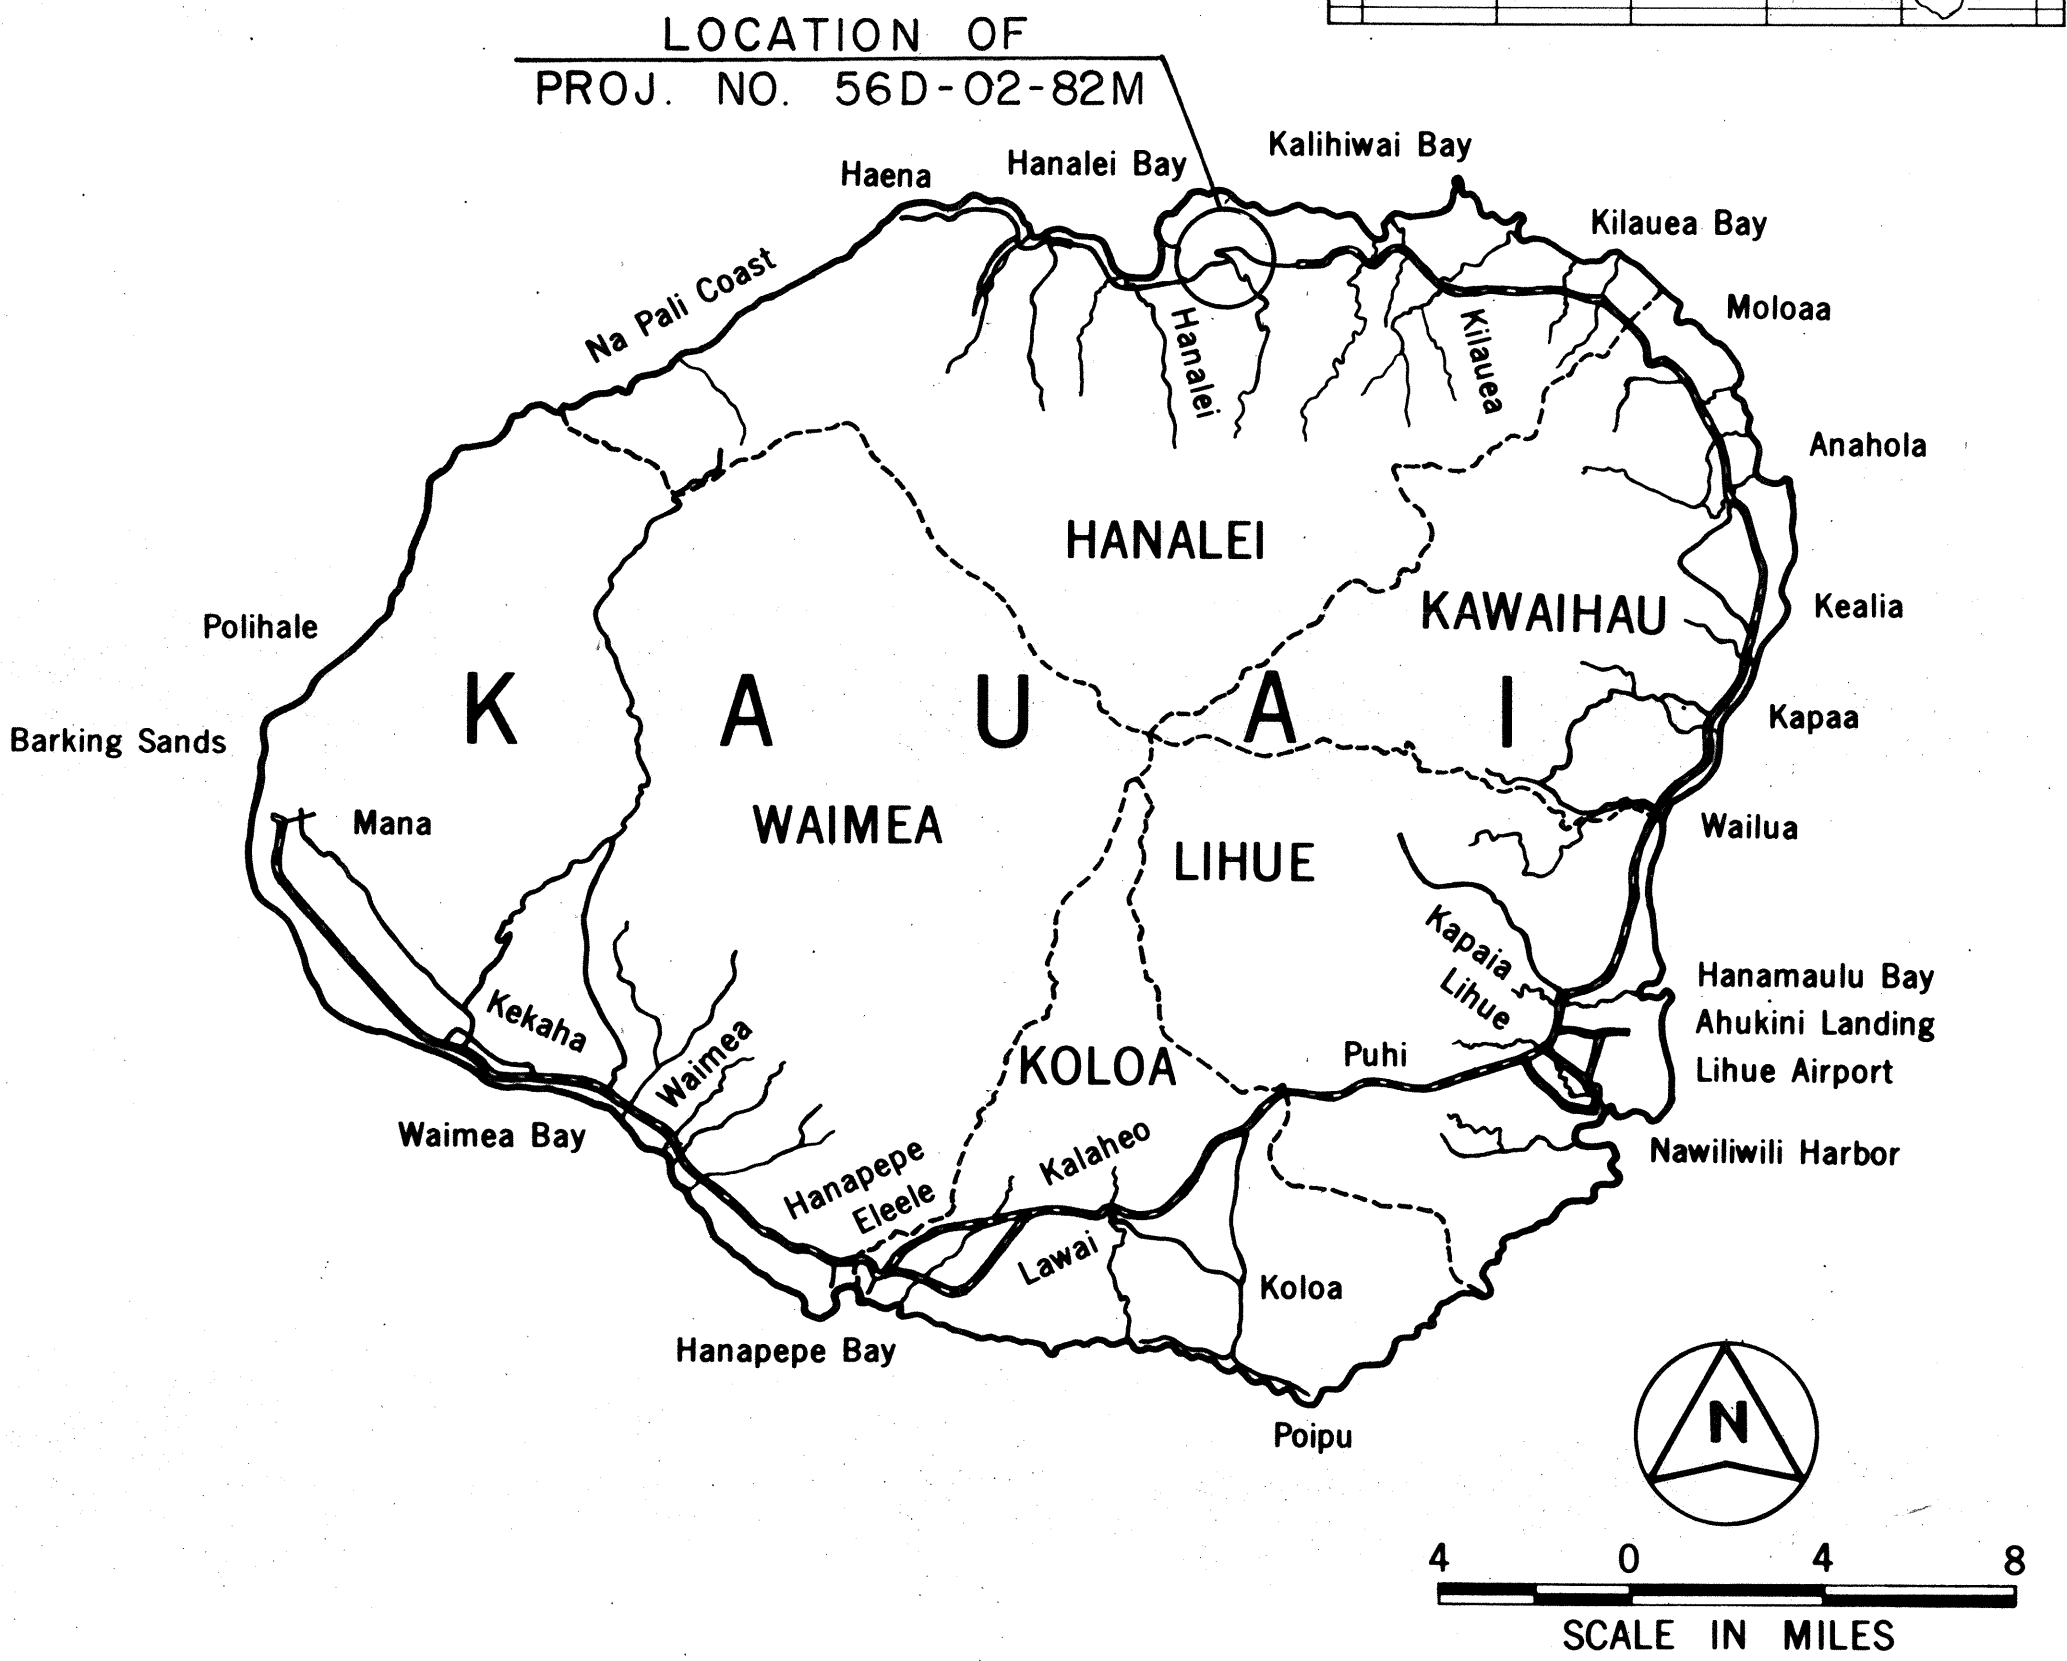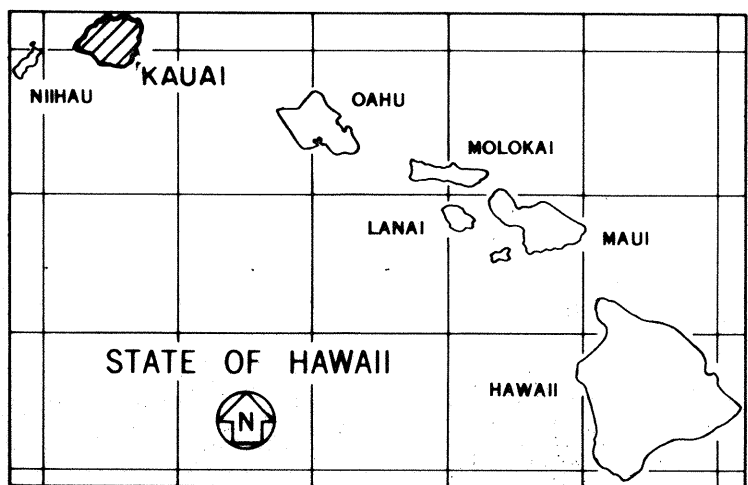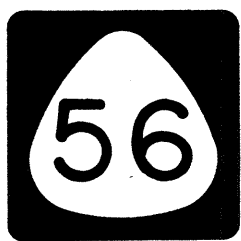

— FEDERAL AID PROJECTS PREVIOUSLY CONSTRUCTED OR UNDER CONSTRUCTION

NO CHANGES WERE MADE DURING CONSTRUCTION ON THESE PLANS EXCEPT CHANGES IN THE ORIGINAL THEORETICAL QUANTITIES. FOR ACTUAL QUANTITIES, REFER TO PROJECT LEDGER AND/OR COMPUTATION BOOK.

Donald Nagamine
 RESIDENT ENGINEER

9/22/82
 DATE

DEPARTMENT OF TRANSPORTATION
 STATE OF HAWAII
 APPROVED:
James R. Carras 9/28/82
 DIR. OF TRANSPORTATION DATE

HWY - DB
 DESIGNED BY
 R. MIKAMI
 P. S. & E. BY
 548-7534
 PHONE
 DATE