




| FED. ROAD DIST. NO. | STATE | PROJ. NO.  | FISCAL YEAR | SHEET NO. | TOTAL SHEETS |
|---------------------|-------|------------|-------------|-----------|--------------|
| HAWAII              | HAW.  | 56D-01-82M | 1982        | 6         | 11           |

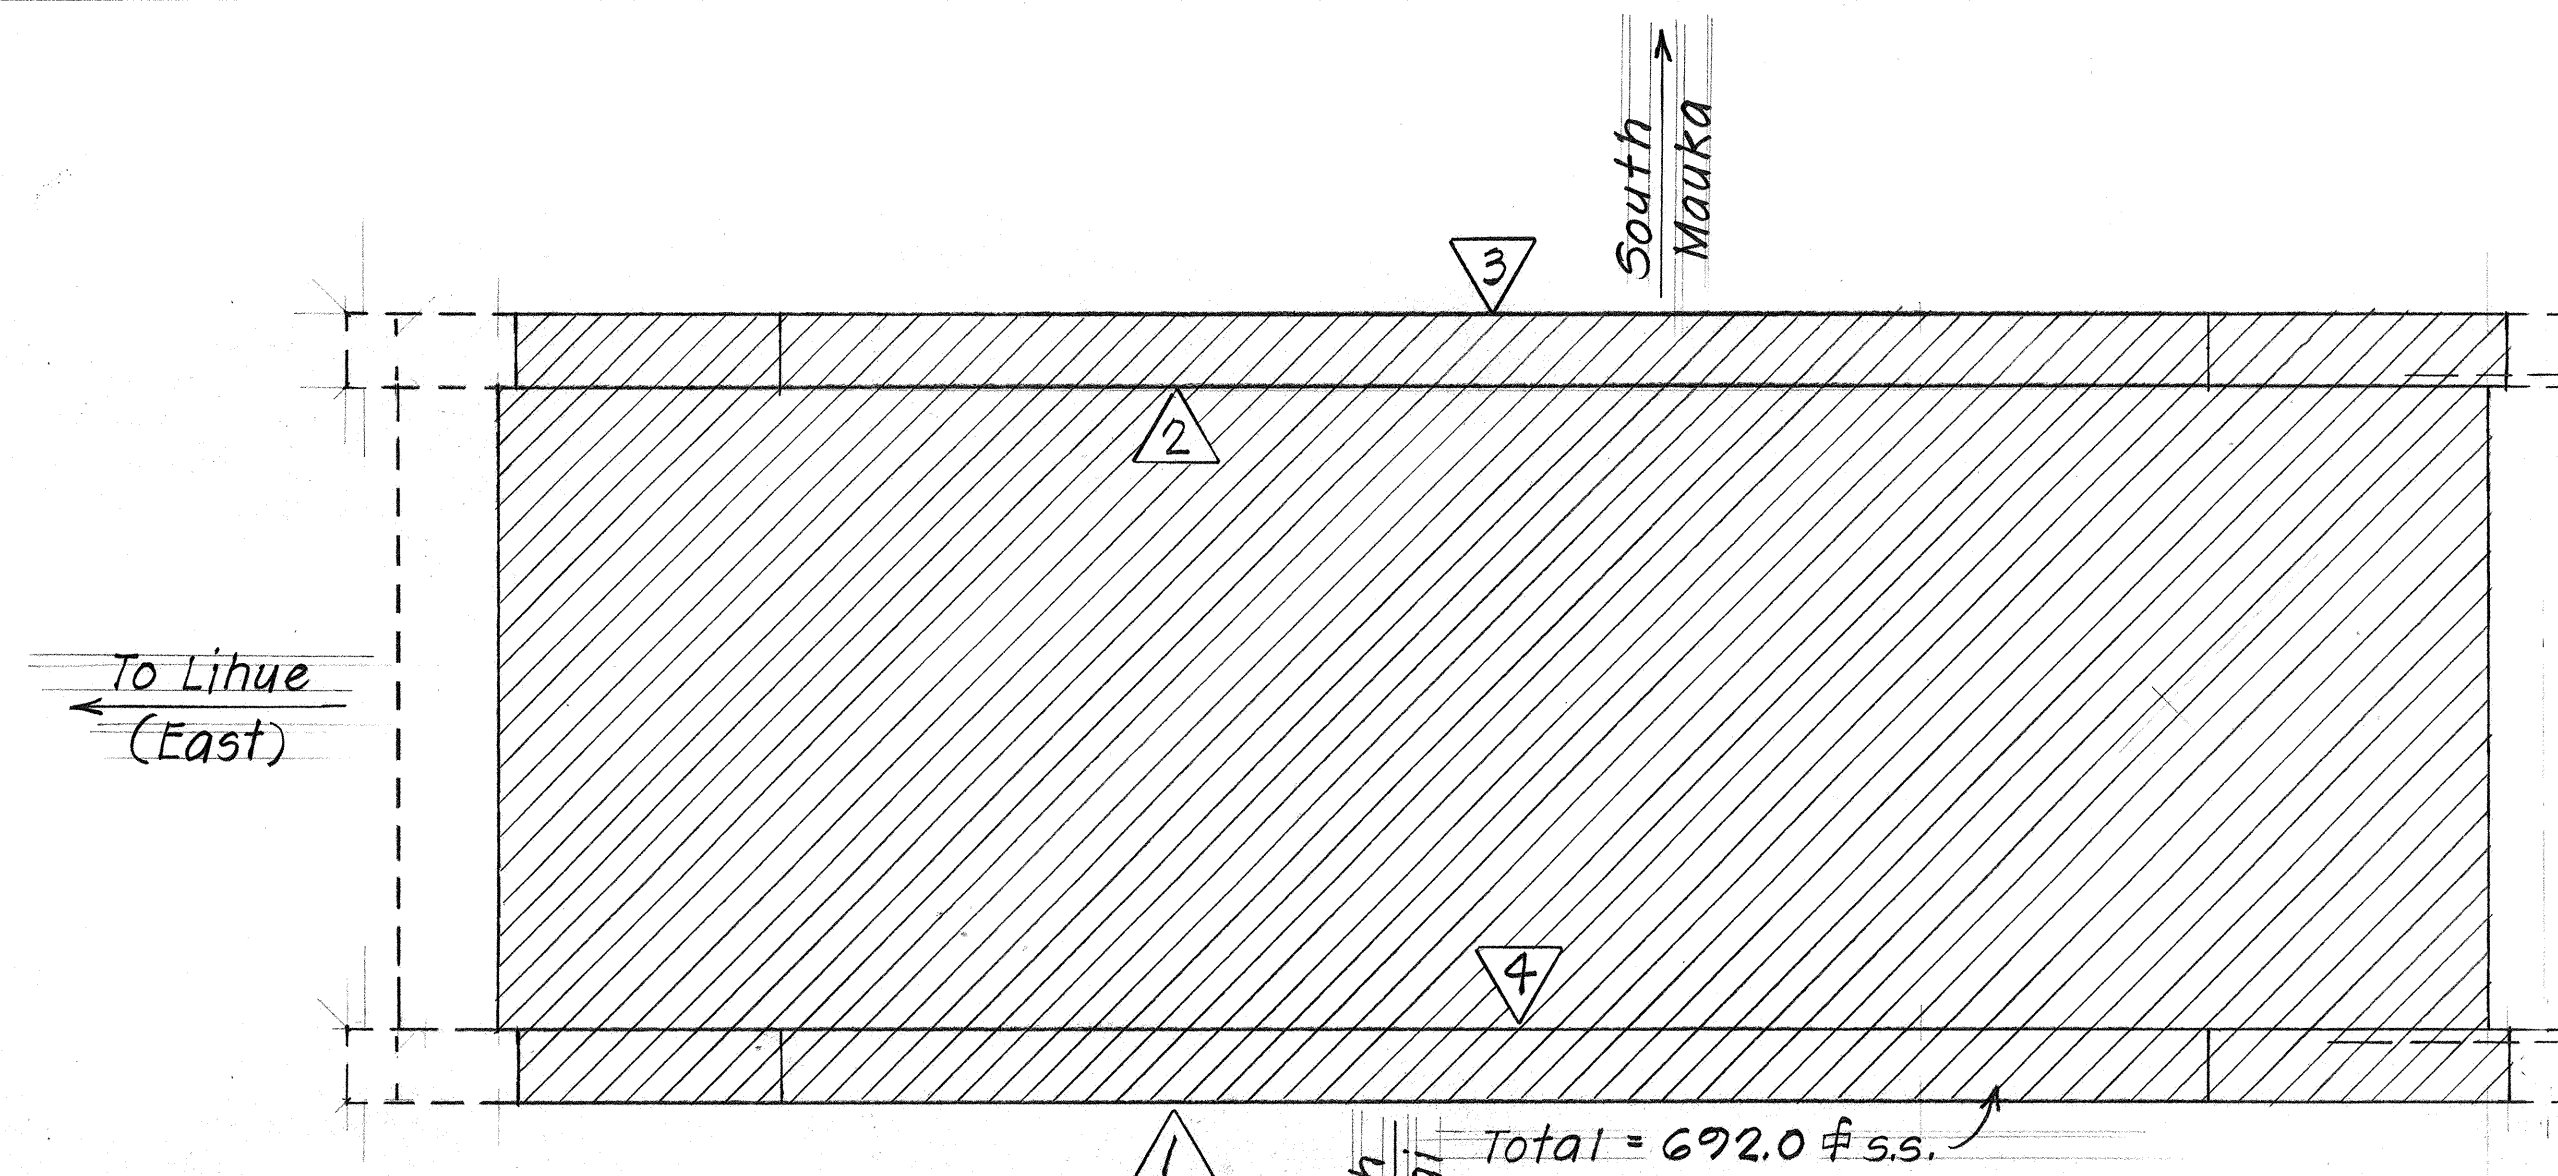


REFLECTED CEILING PLAN - SLAB SOFFIT  
Scale: 1/4" = 1'-0"

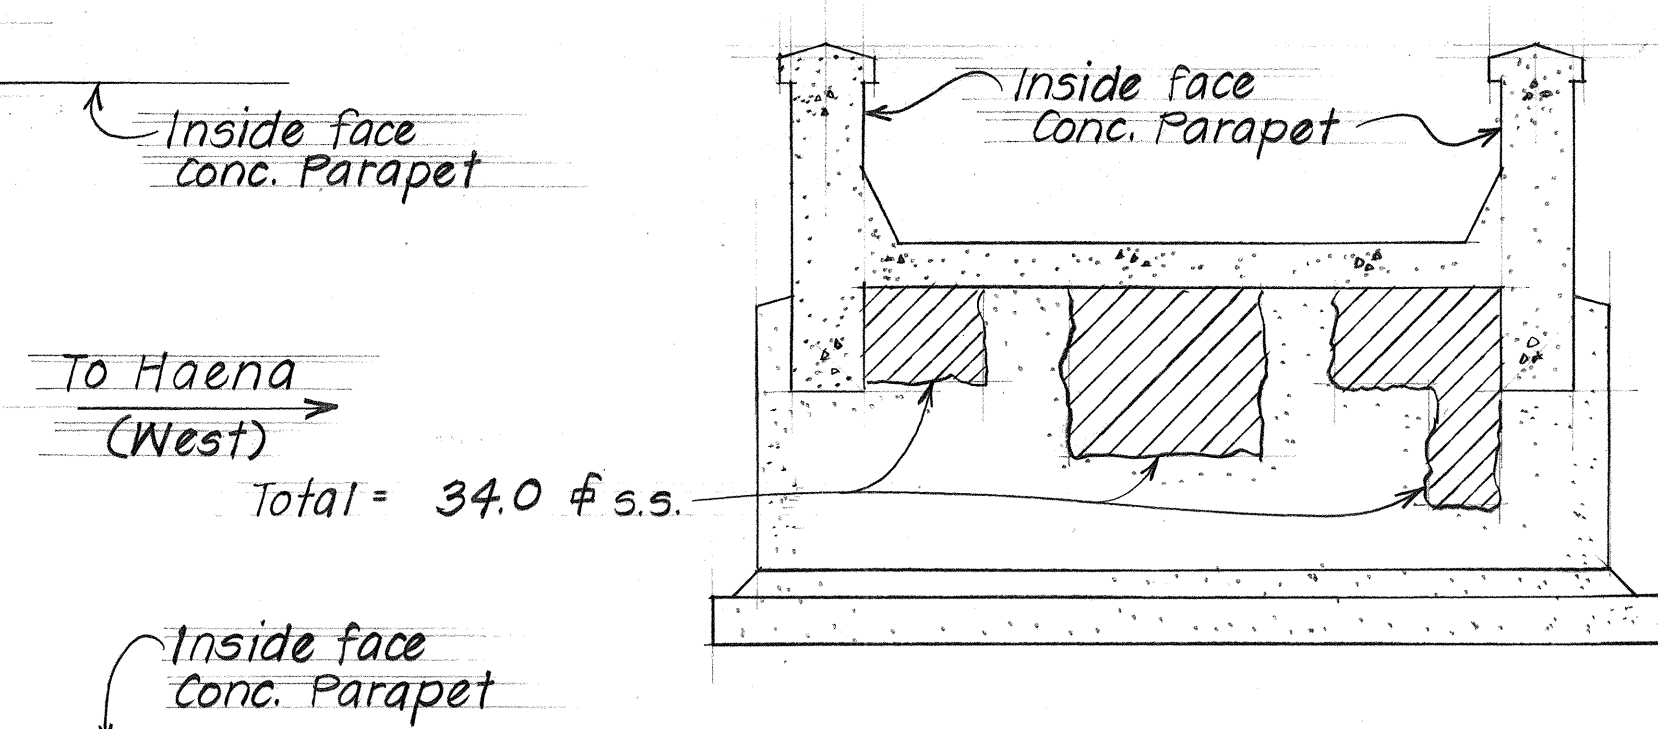


HAENA ABUTMENT - EAST FACE  
Scale: 1/4" = 1'-0"

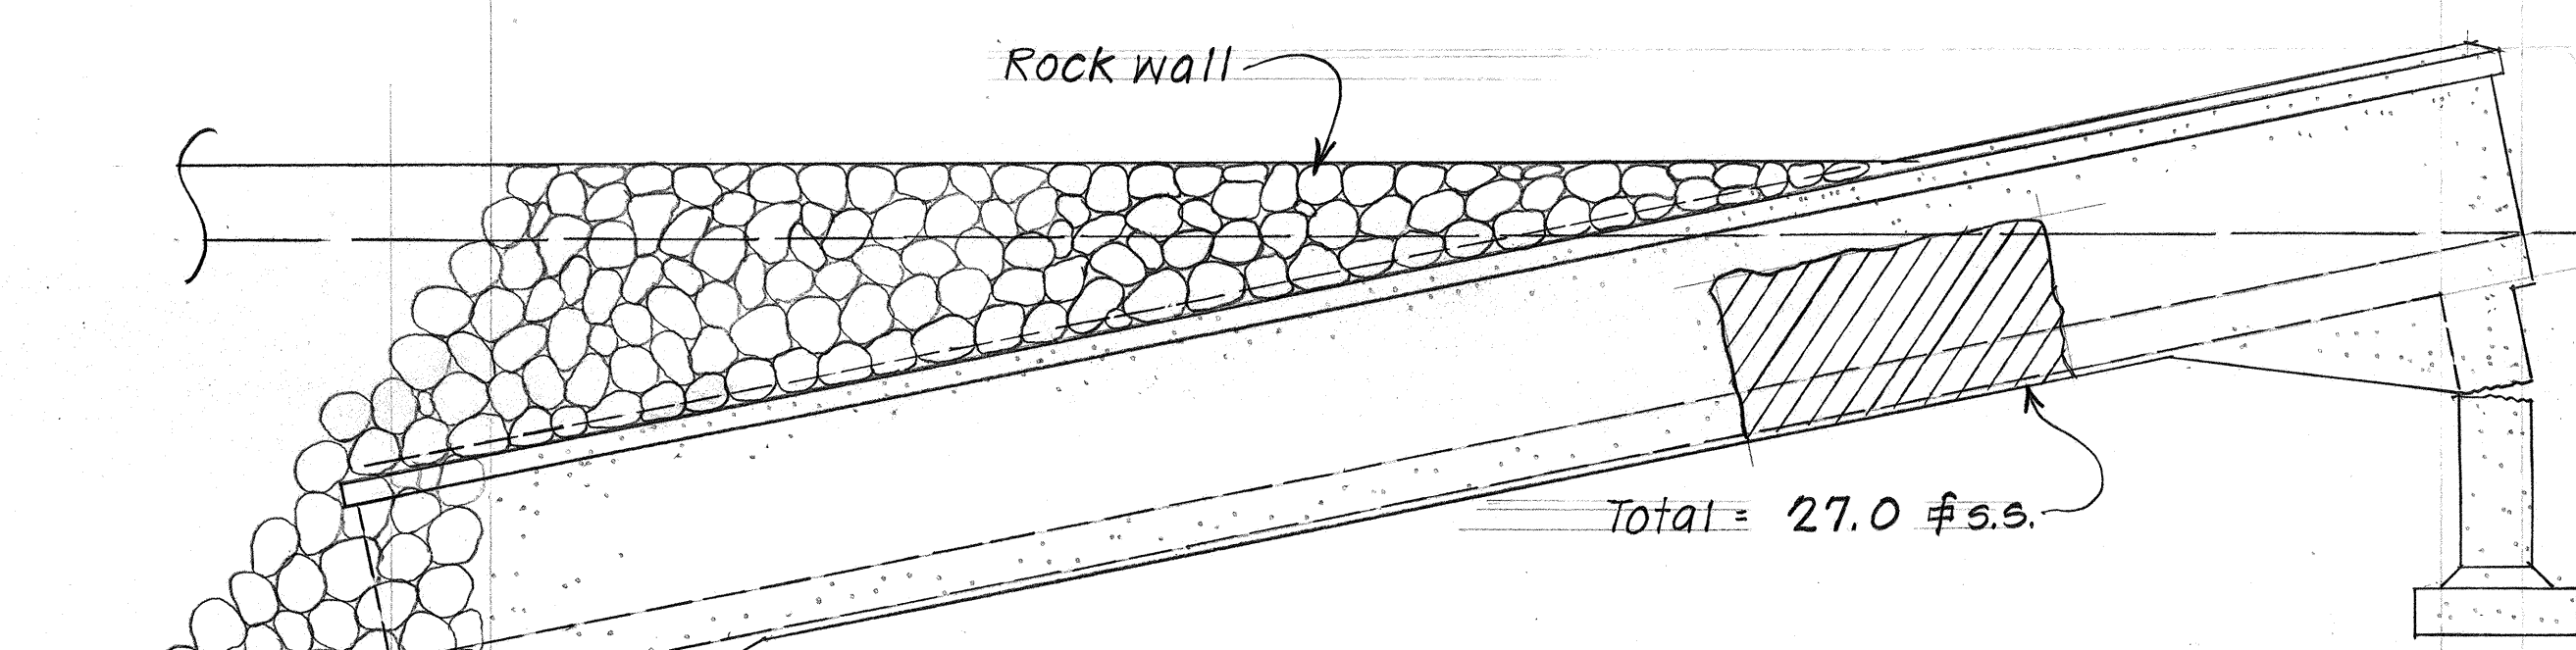


1 ELEVATION NORTH PARAPET BEAM - NORTH FACE  
Scale: 1/4" = 1'-0"

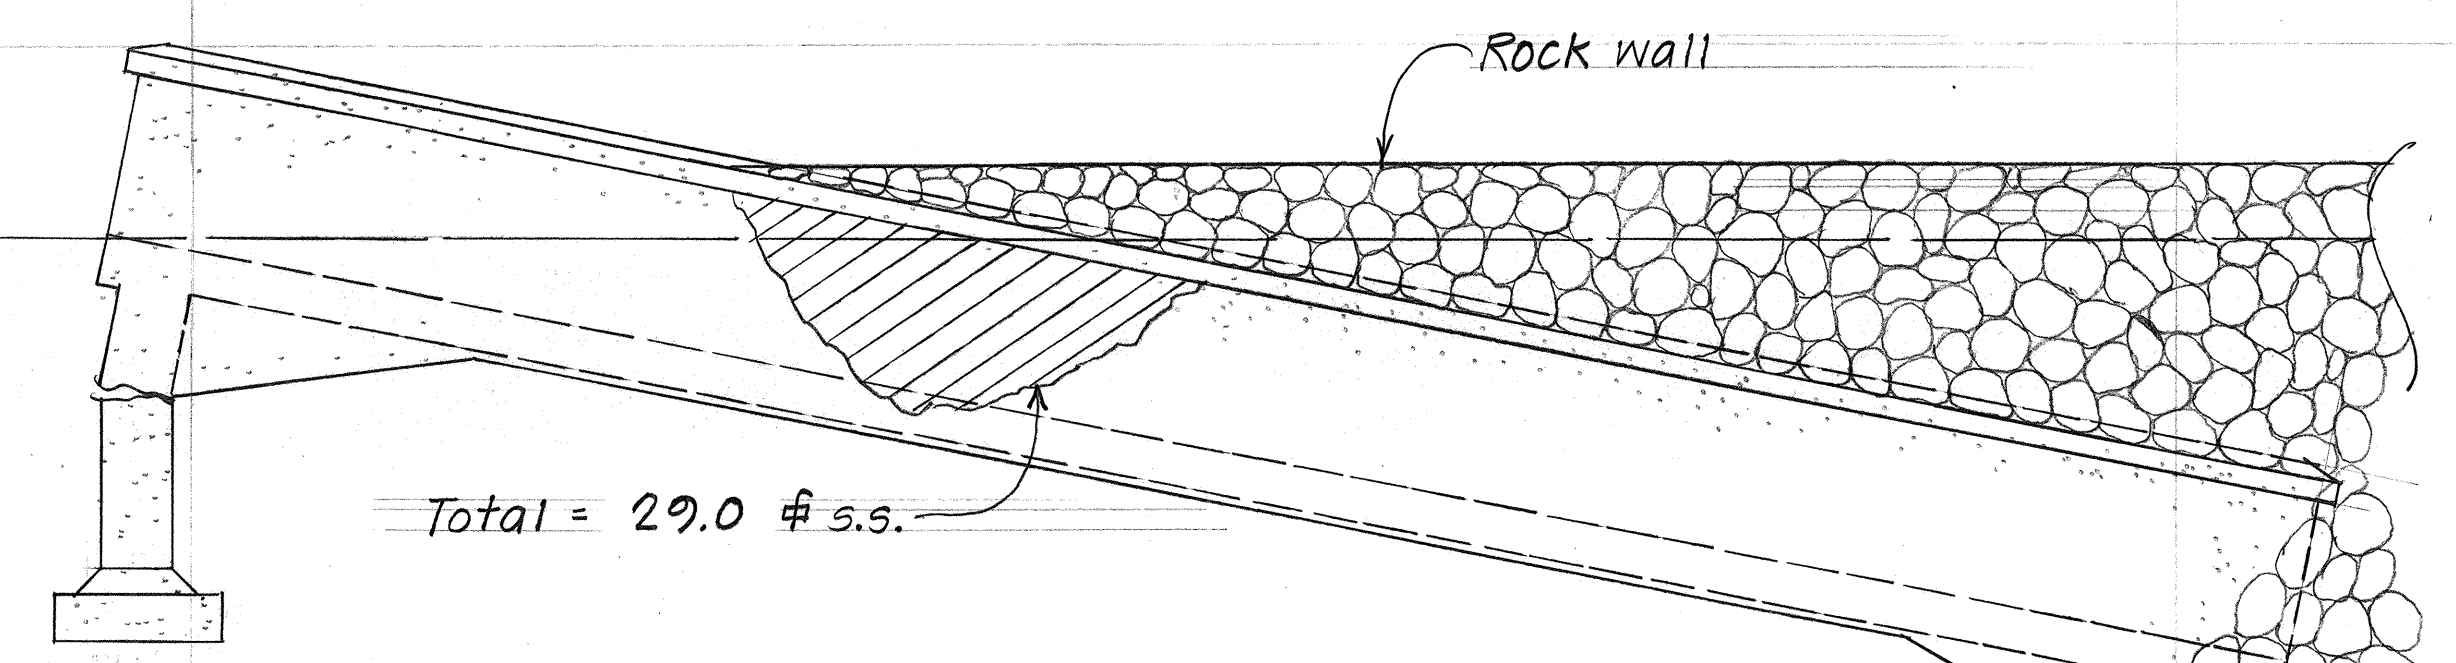

3 ELEVATION SOUTH PARAPET BEAM - SOUTH FACE  
Scale: 1/4" = 1'-0"

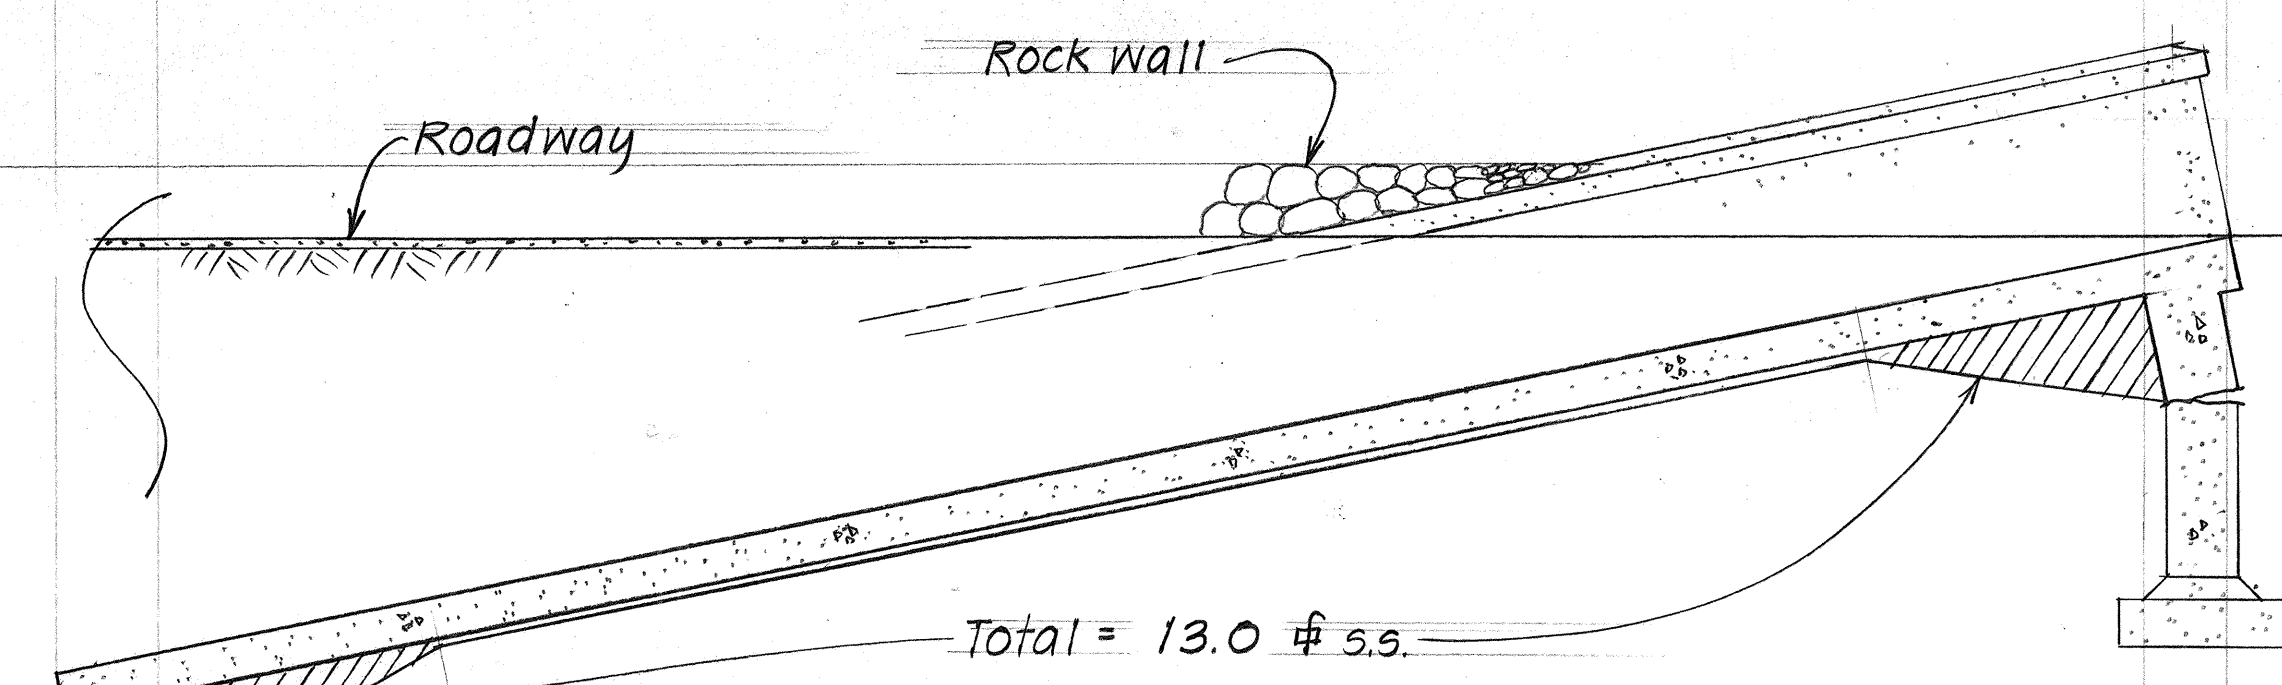

2 ELEVATION SOUTH PARAPET BEAM - NORTH FACE  
Scale: 1/4" = 1'-0"

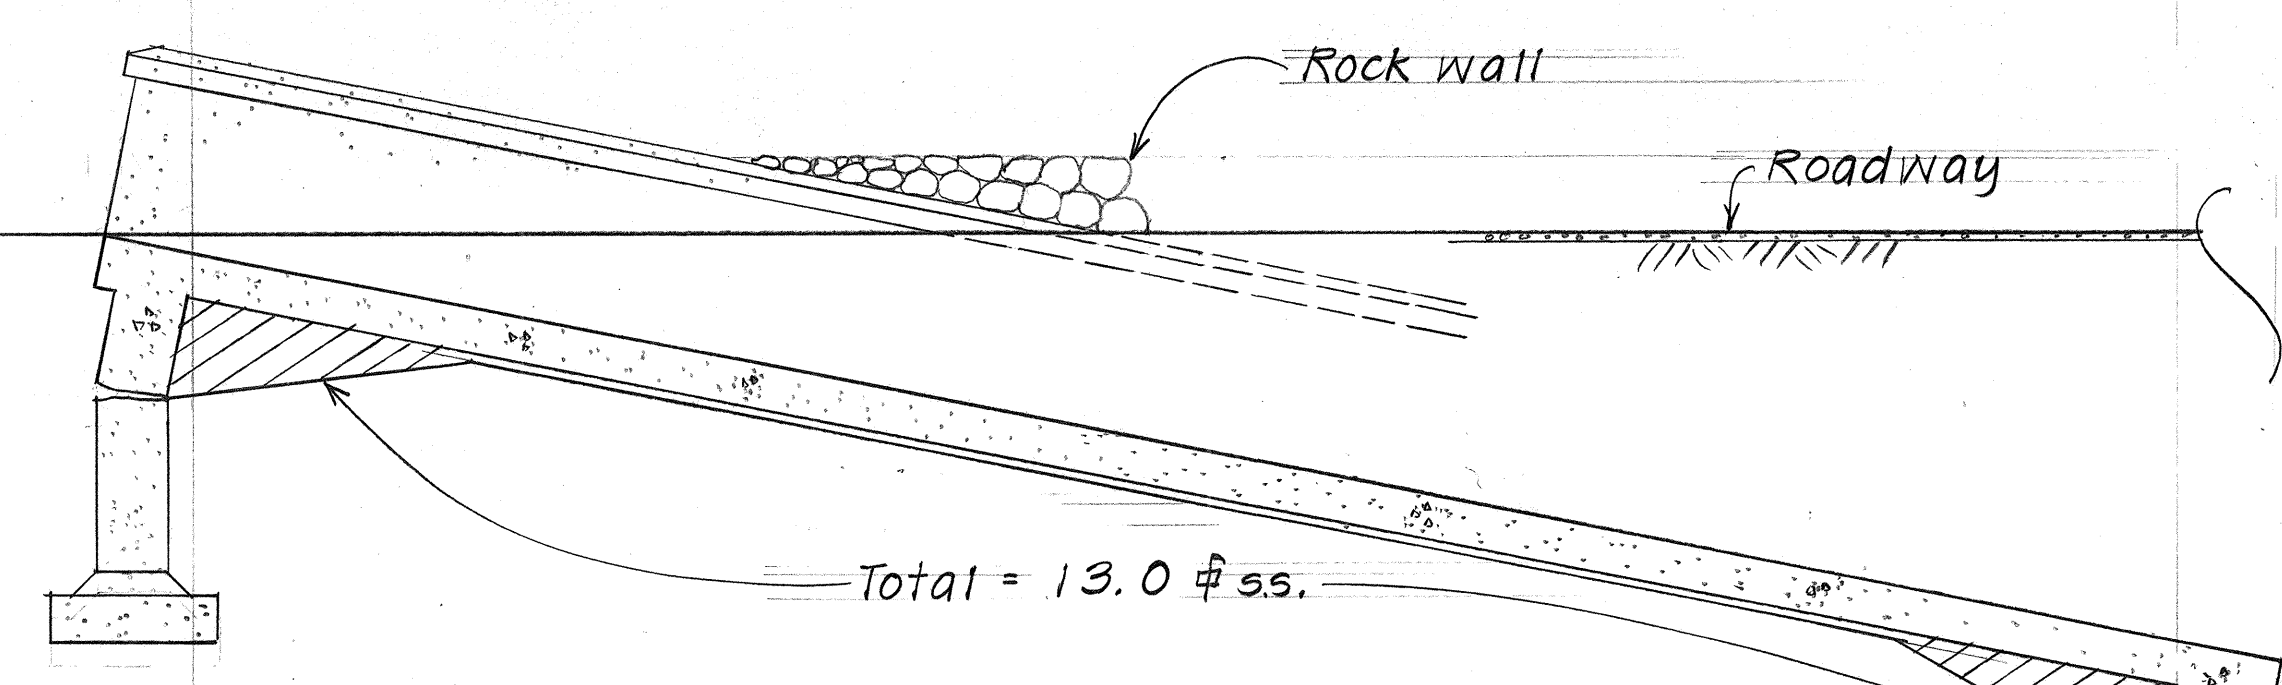

4 ELEVATION NORTH PARAPET BEAM - SOUTH FACE  
Scale: 1/4" = 1'-0"

|               |                   |      |
|---------------|-------------------|------|
| ORIGINAL PLAN | SURVEY PLOTTED BY | DATE |
| NO.           | MA/GT             | 5/80 |
|               | DESIGNED BY       | 5/80 |
|               | QUANTITIES BY     | 5/80 |
|               | CHECKED BY        | 5/80 |

STATE OF HAWAII  
DEPARTMENT OF TRANSPORTATION  
HIGHWAYS DIVISION  
**REHABILITATION & REPAIRS**  
**TO WAIKOKO BRIDGE**  
PROJ. NO. 56D-01-82M  
DATE: JUNE 1981  
SHEET No. 1 OF 1 SHEETS