	INDEX TO DRAWINGS
SHEET NO.	DESCRIPTION
	TITLE SHEET
2	DETAILS & GENERAL NOTES
3-4	PLAN & PROFILE
5	STANDARD DETAILS

AUAI DISTRICTO DESIGNED BY



STATE OF HAWAII

## DEPARTMENT OF TRANSPORTATION

HIGHWAYS DIVISION


"AS BUILT"

PLANS FOR

## KUHIO HIGHWAY, SAFETY AND DRAINAGE IMPROVEMENTS AT HANALEI TOWN-PHASE II

PROJECT NO. 56D-03-82


DISTRICT OF HANALEI
ISLAND OF KAUAI

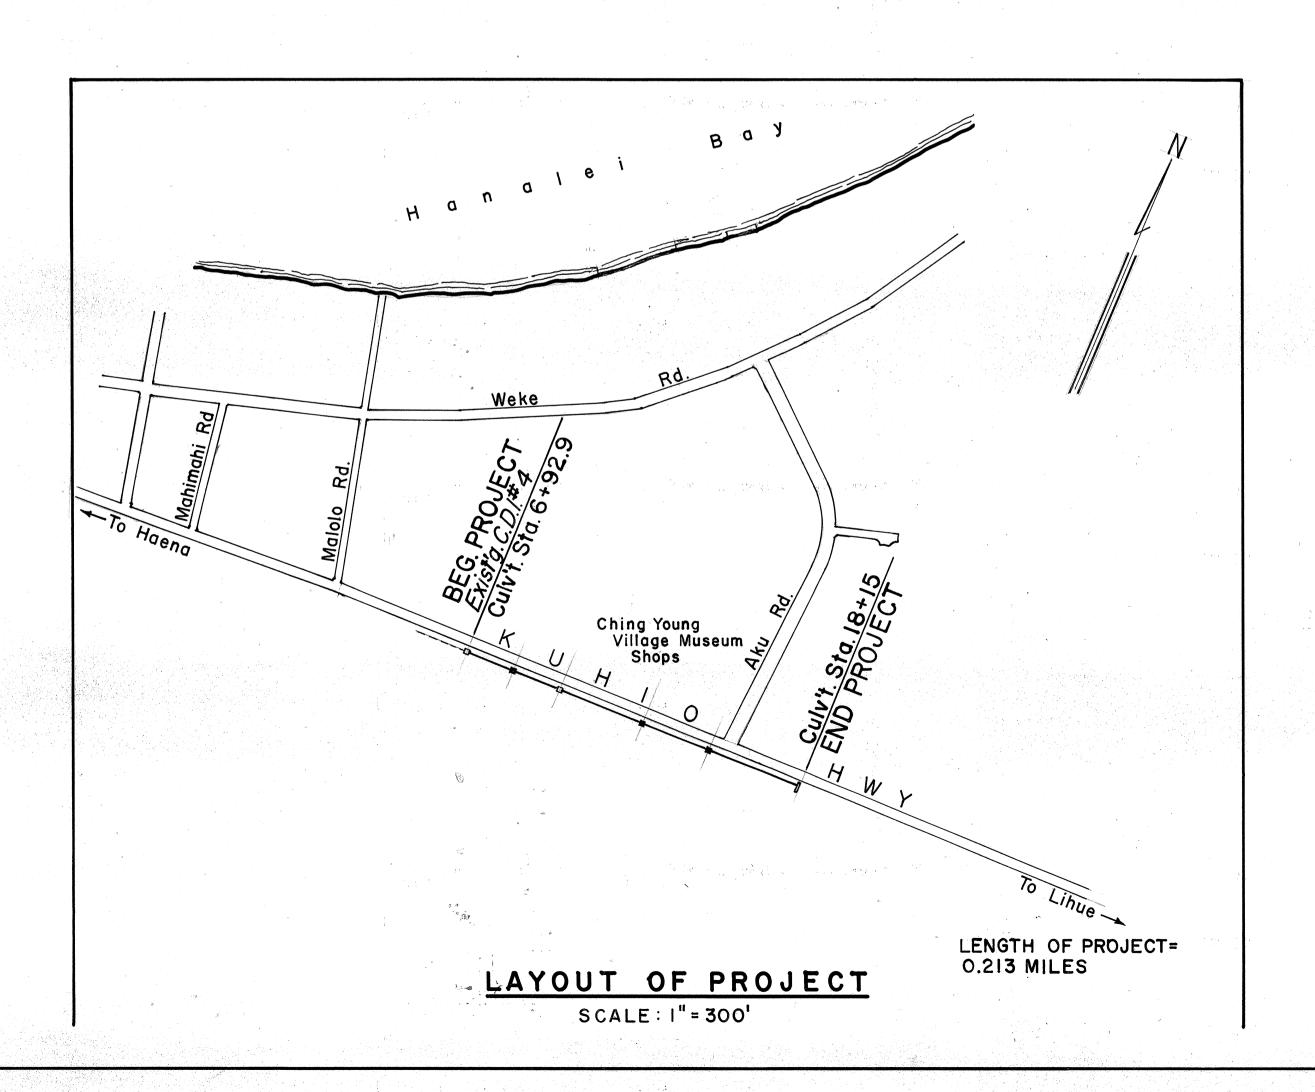

FED. ROAD DIST. NO. STATE FED. AID PROJ. NO. FISCAL SHEET TOTAL SHEETS

HAWAII HAW. 56D-03-82 1982 1 5



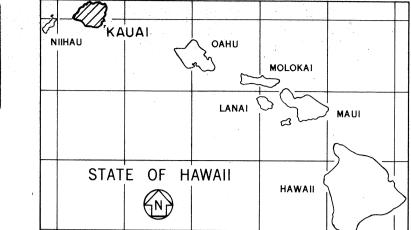

SCALE IN MILES

Haena Hanalel Bay Kalihiwai Bay

Kilauea Bay

Moloaa

Anahola

HANALEI

KAWAIHAU

Kapaa

Wailua

Kapaa

Kalihiwai Bay

Moloaa

Anahola

Kapaa

Kalihiwai Bay

Moloaa

Anahola

Kapaa

Ka

FEDERAL AID PROJECTS PREVIOUSLY CONSTRUCTED OR UNDER CONSTRUCTION

ALL CHANGES MADE DURING CONSTRUCTION HAVE
BEEN INCORPORATED ON THESE PLANS IN RED
EXCEPT CHANGES IN THE ORIGINAL THEORETICAL
QUANTITIES. FOR ACTUAL QUANTITIES, REFER TO
PROJECT LEDGER AND/OR COMPUTATION BOOK.

LOCATION OF PROJECT

RESIDENT ENGINEER

4-5-88 DATE

DEPARTMENT OF TRANSPORTATION
STATE OF HAWAII

APPROVED:

DIR OF TRANSPORTATION DATE