
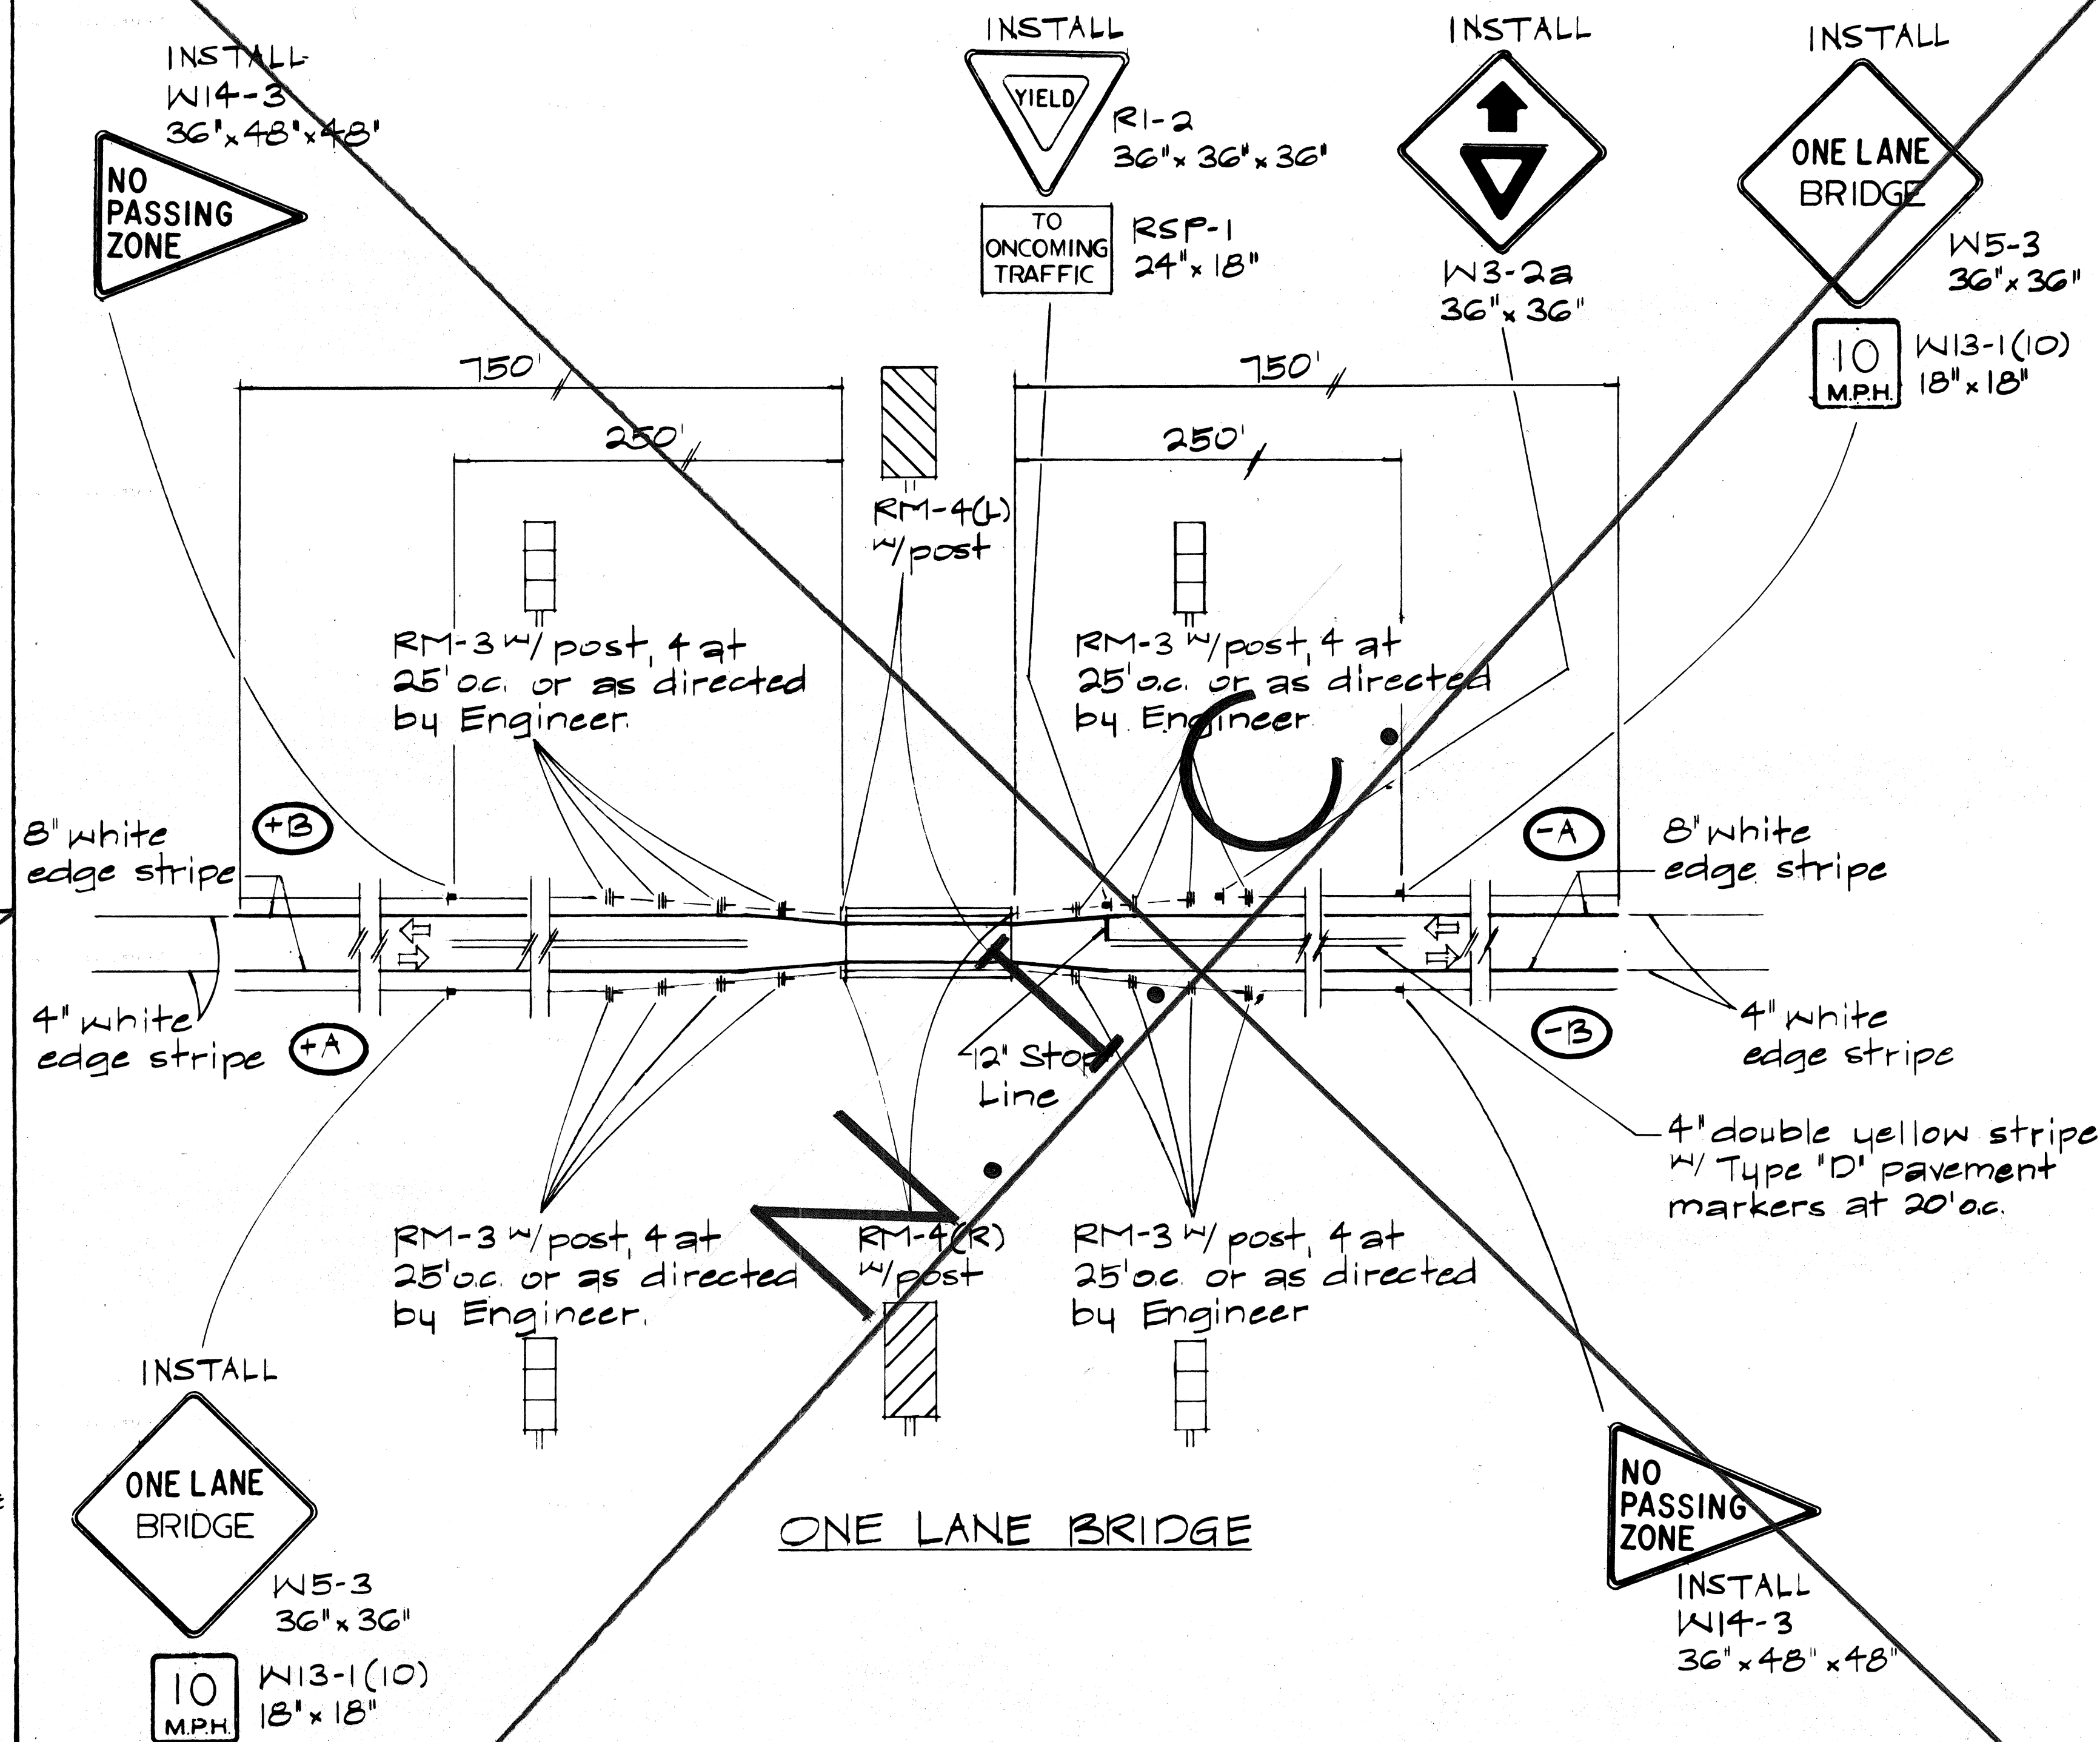
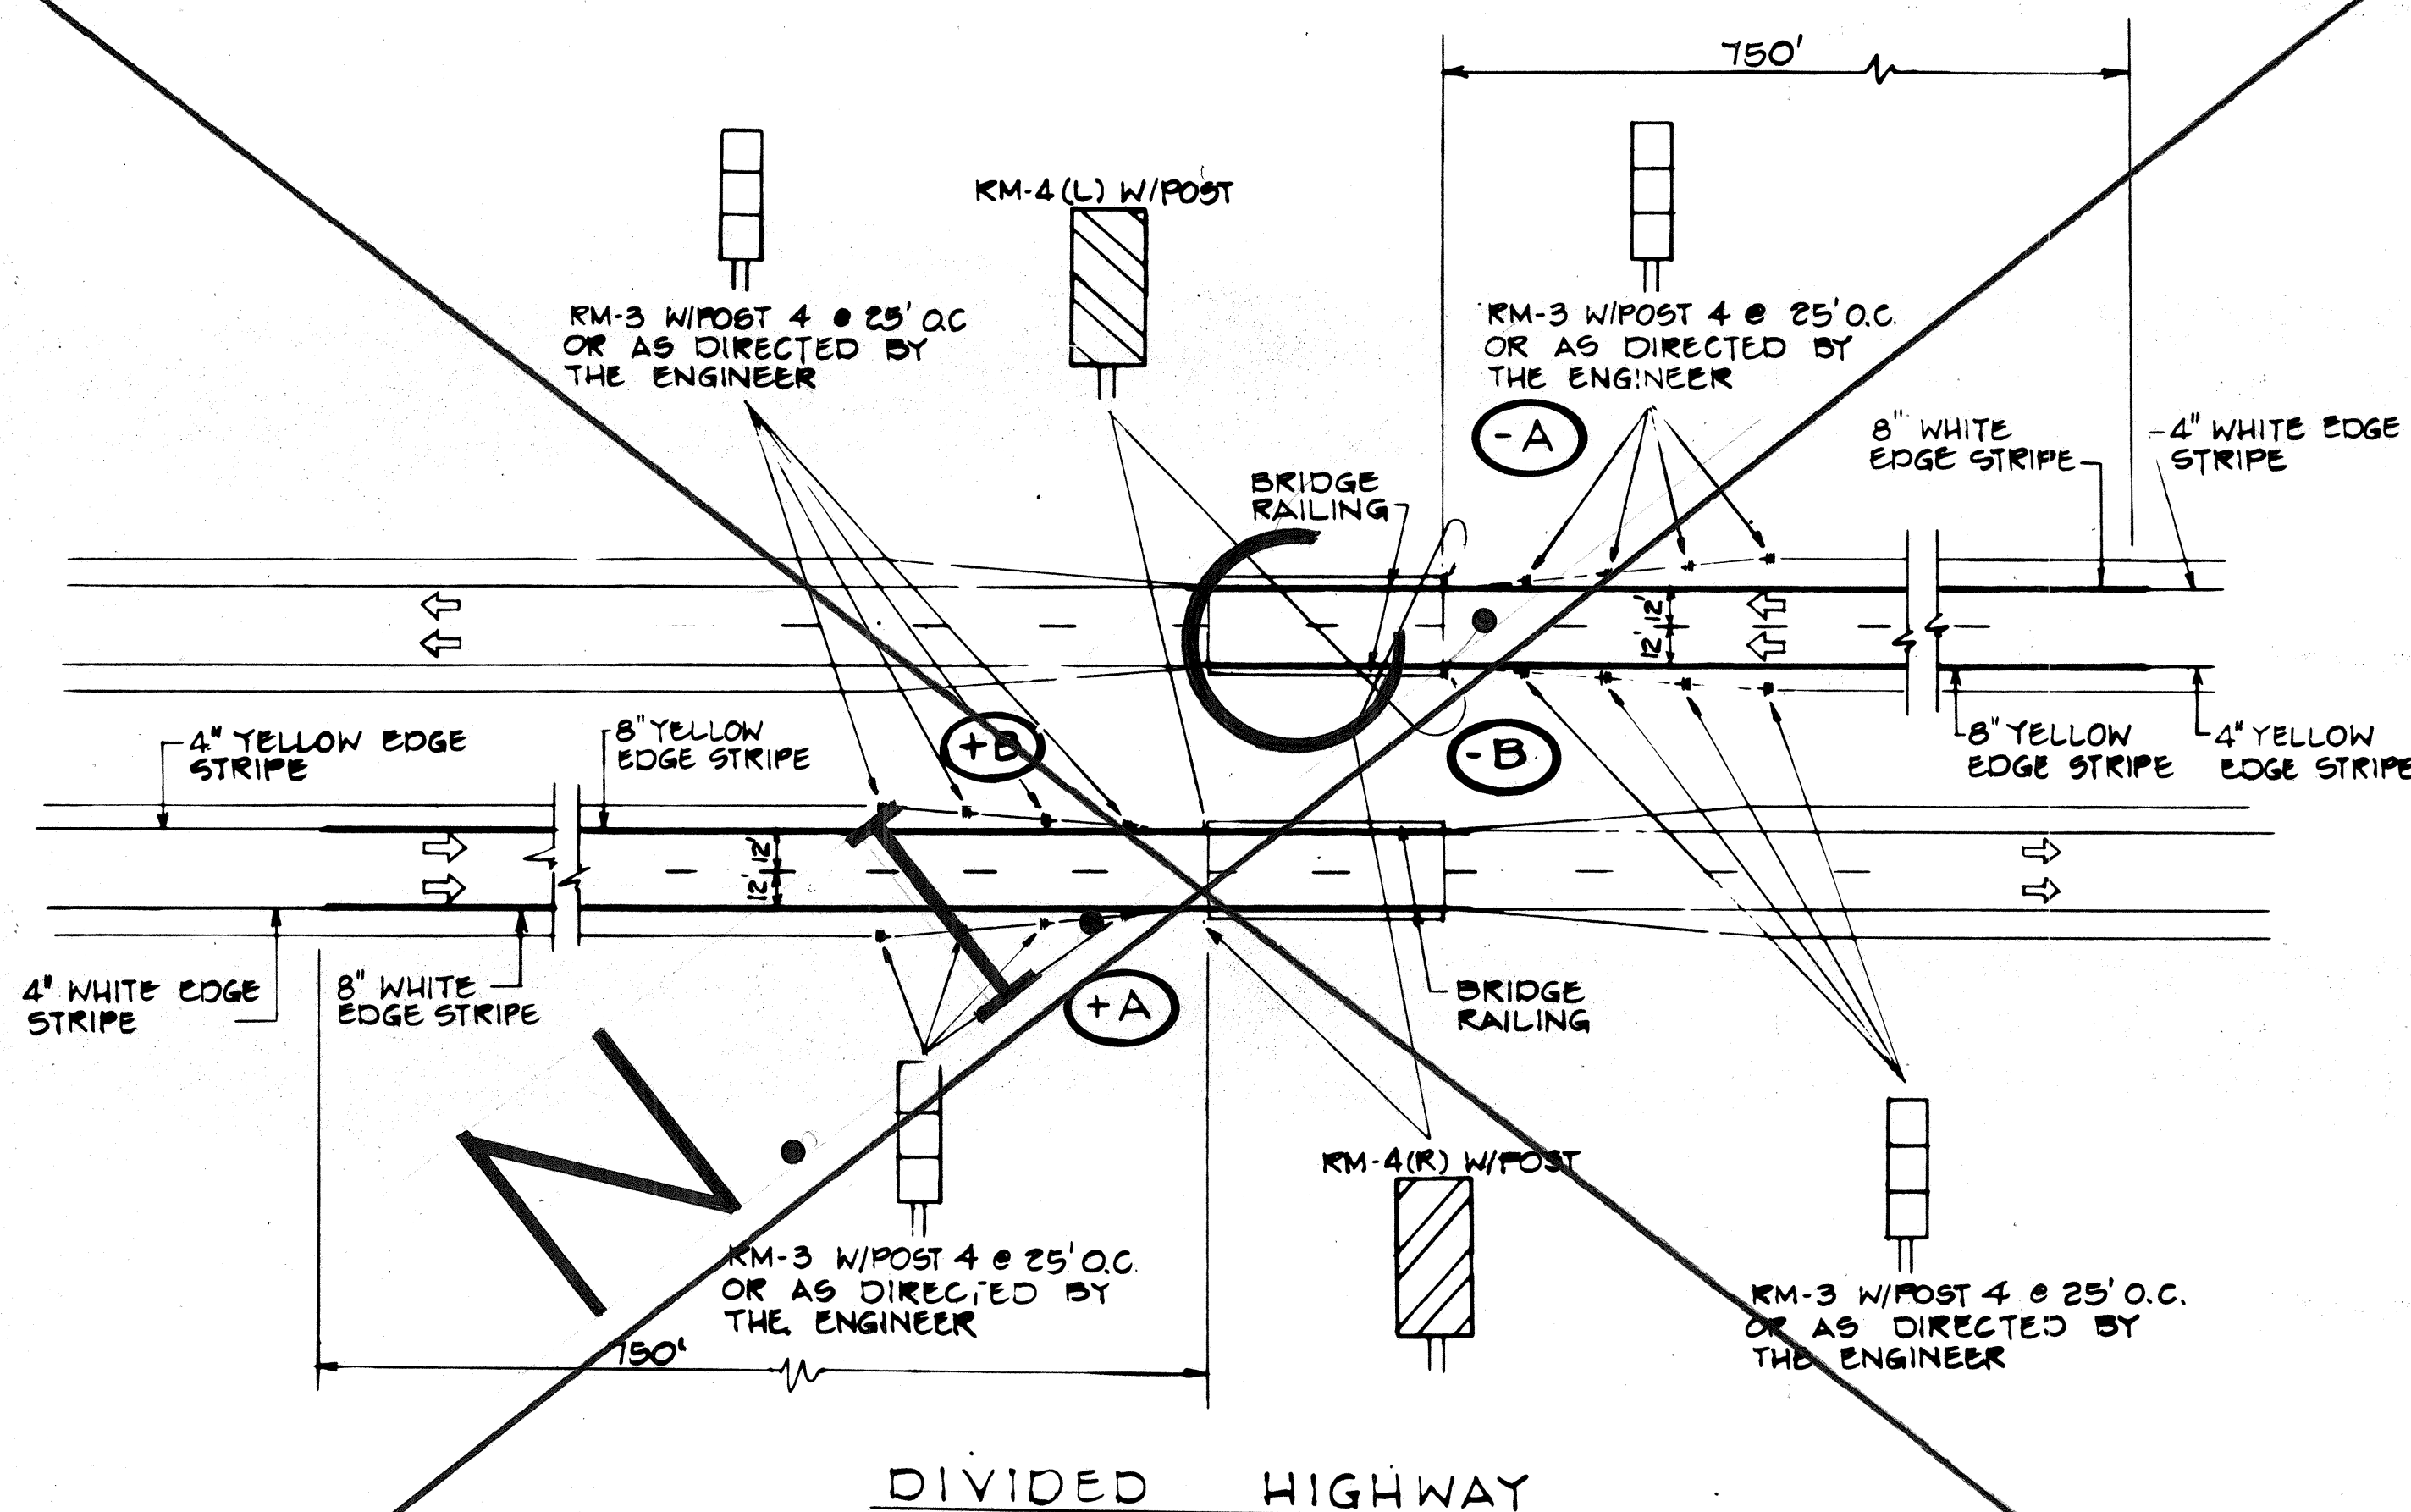


FED. ROAD DIST. NO.	STATE	PROJ. NO.	FISCAL YEAR	SHEET NO.	TOTAL SHEETS
HAWAII	HAW.	56D0183M	1983	8	22

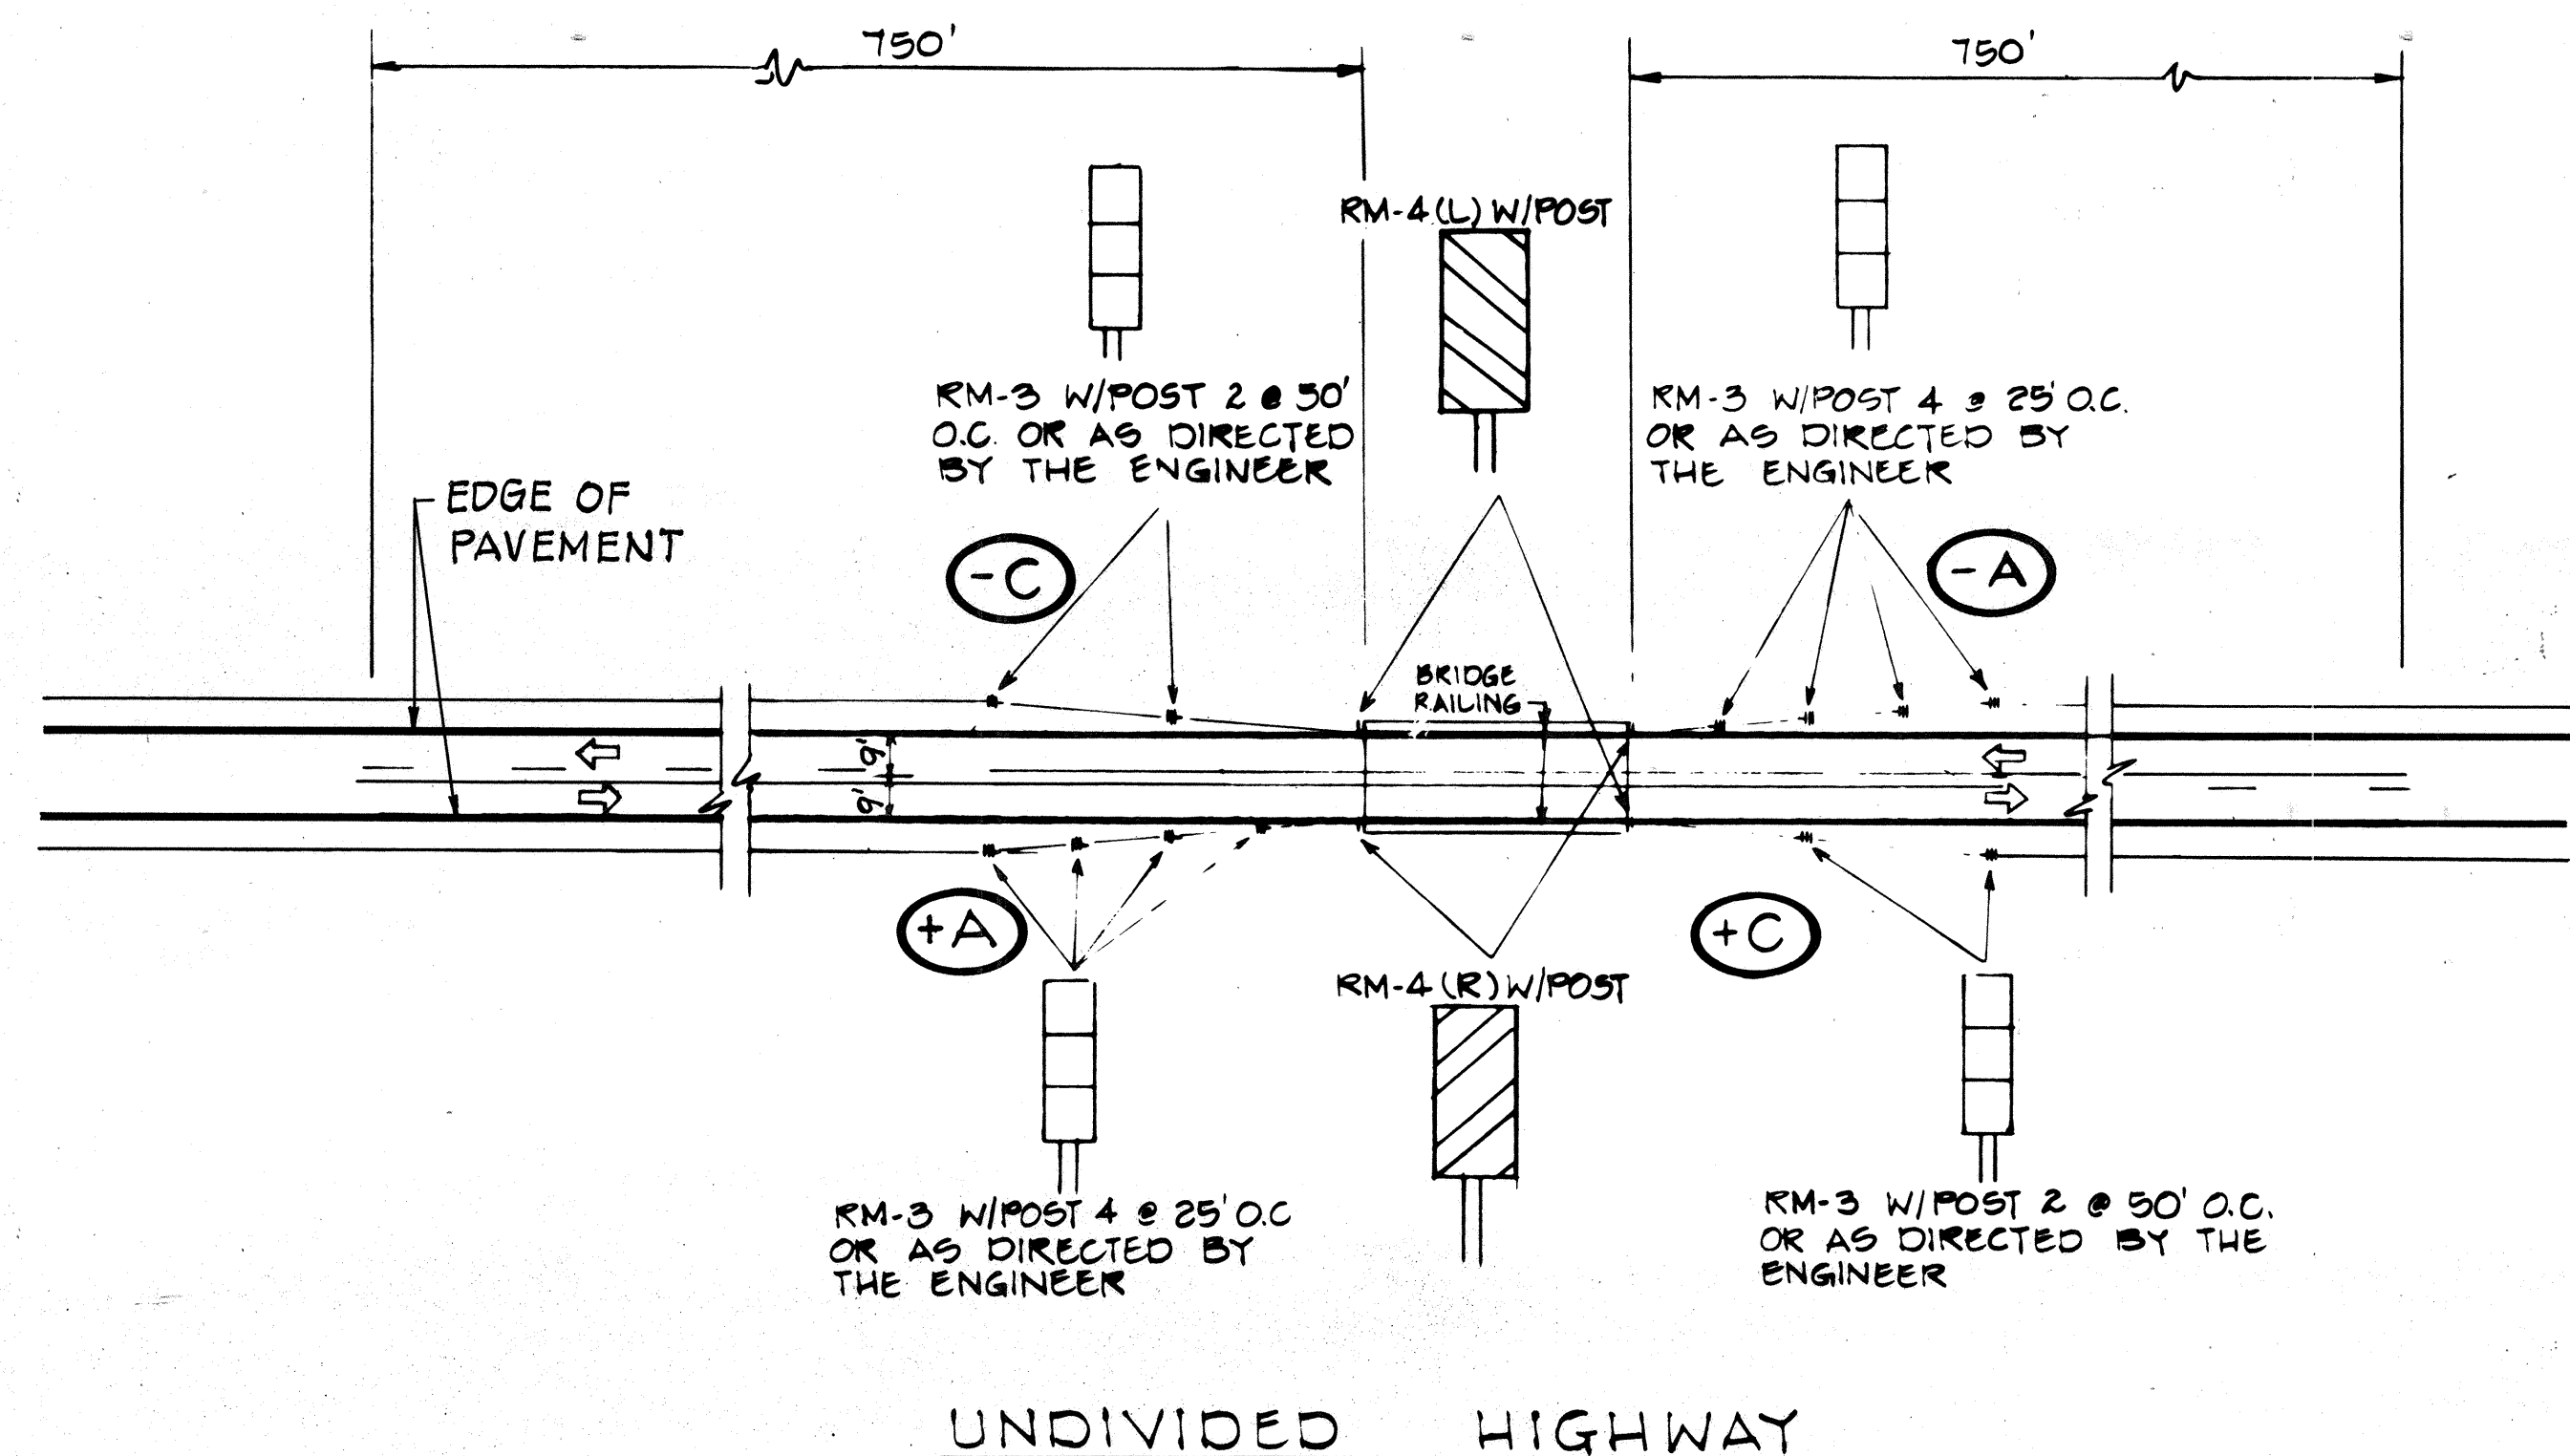

LEGEND

- ➔ Increasing Log Miles (+)
- ➔ Decreasing Log Miles (-)
- (+A) Type of treatment

STATE OF HAWAII
DEPARTMENT OF TRANSPORTATION
LAND TRANSPORTATION FACILITIES DIVISION

TYPICAL DELINEATION AND PAVEMENT MARKINGS AT BRIDGES

Scale: As Shown

SHEET No. / OF / SHEETS

TYPICAL BRIDGE APPROACH DELINEATION CRITERIA
Scale: 1" = 50'

SURVEY PLOTTED BY	DATE
DRAWN BY	
TRACED BY	
NOTED BY	
CHECKED BY	
ORIGINAL PLAN	
NOTE BOOK	
No.	