
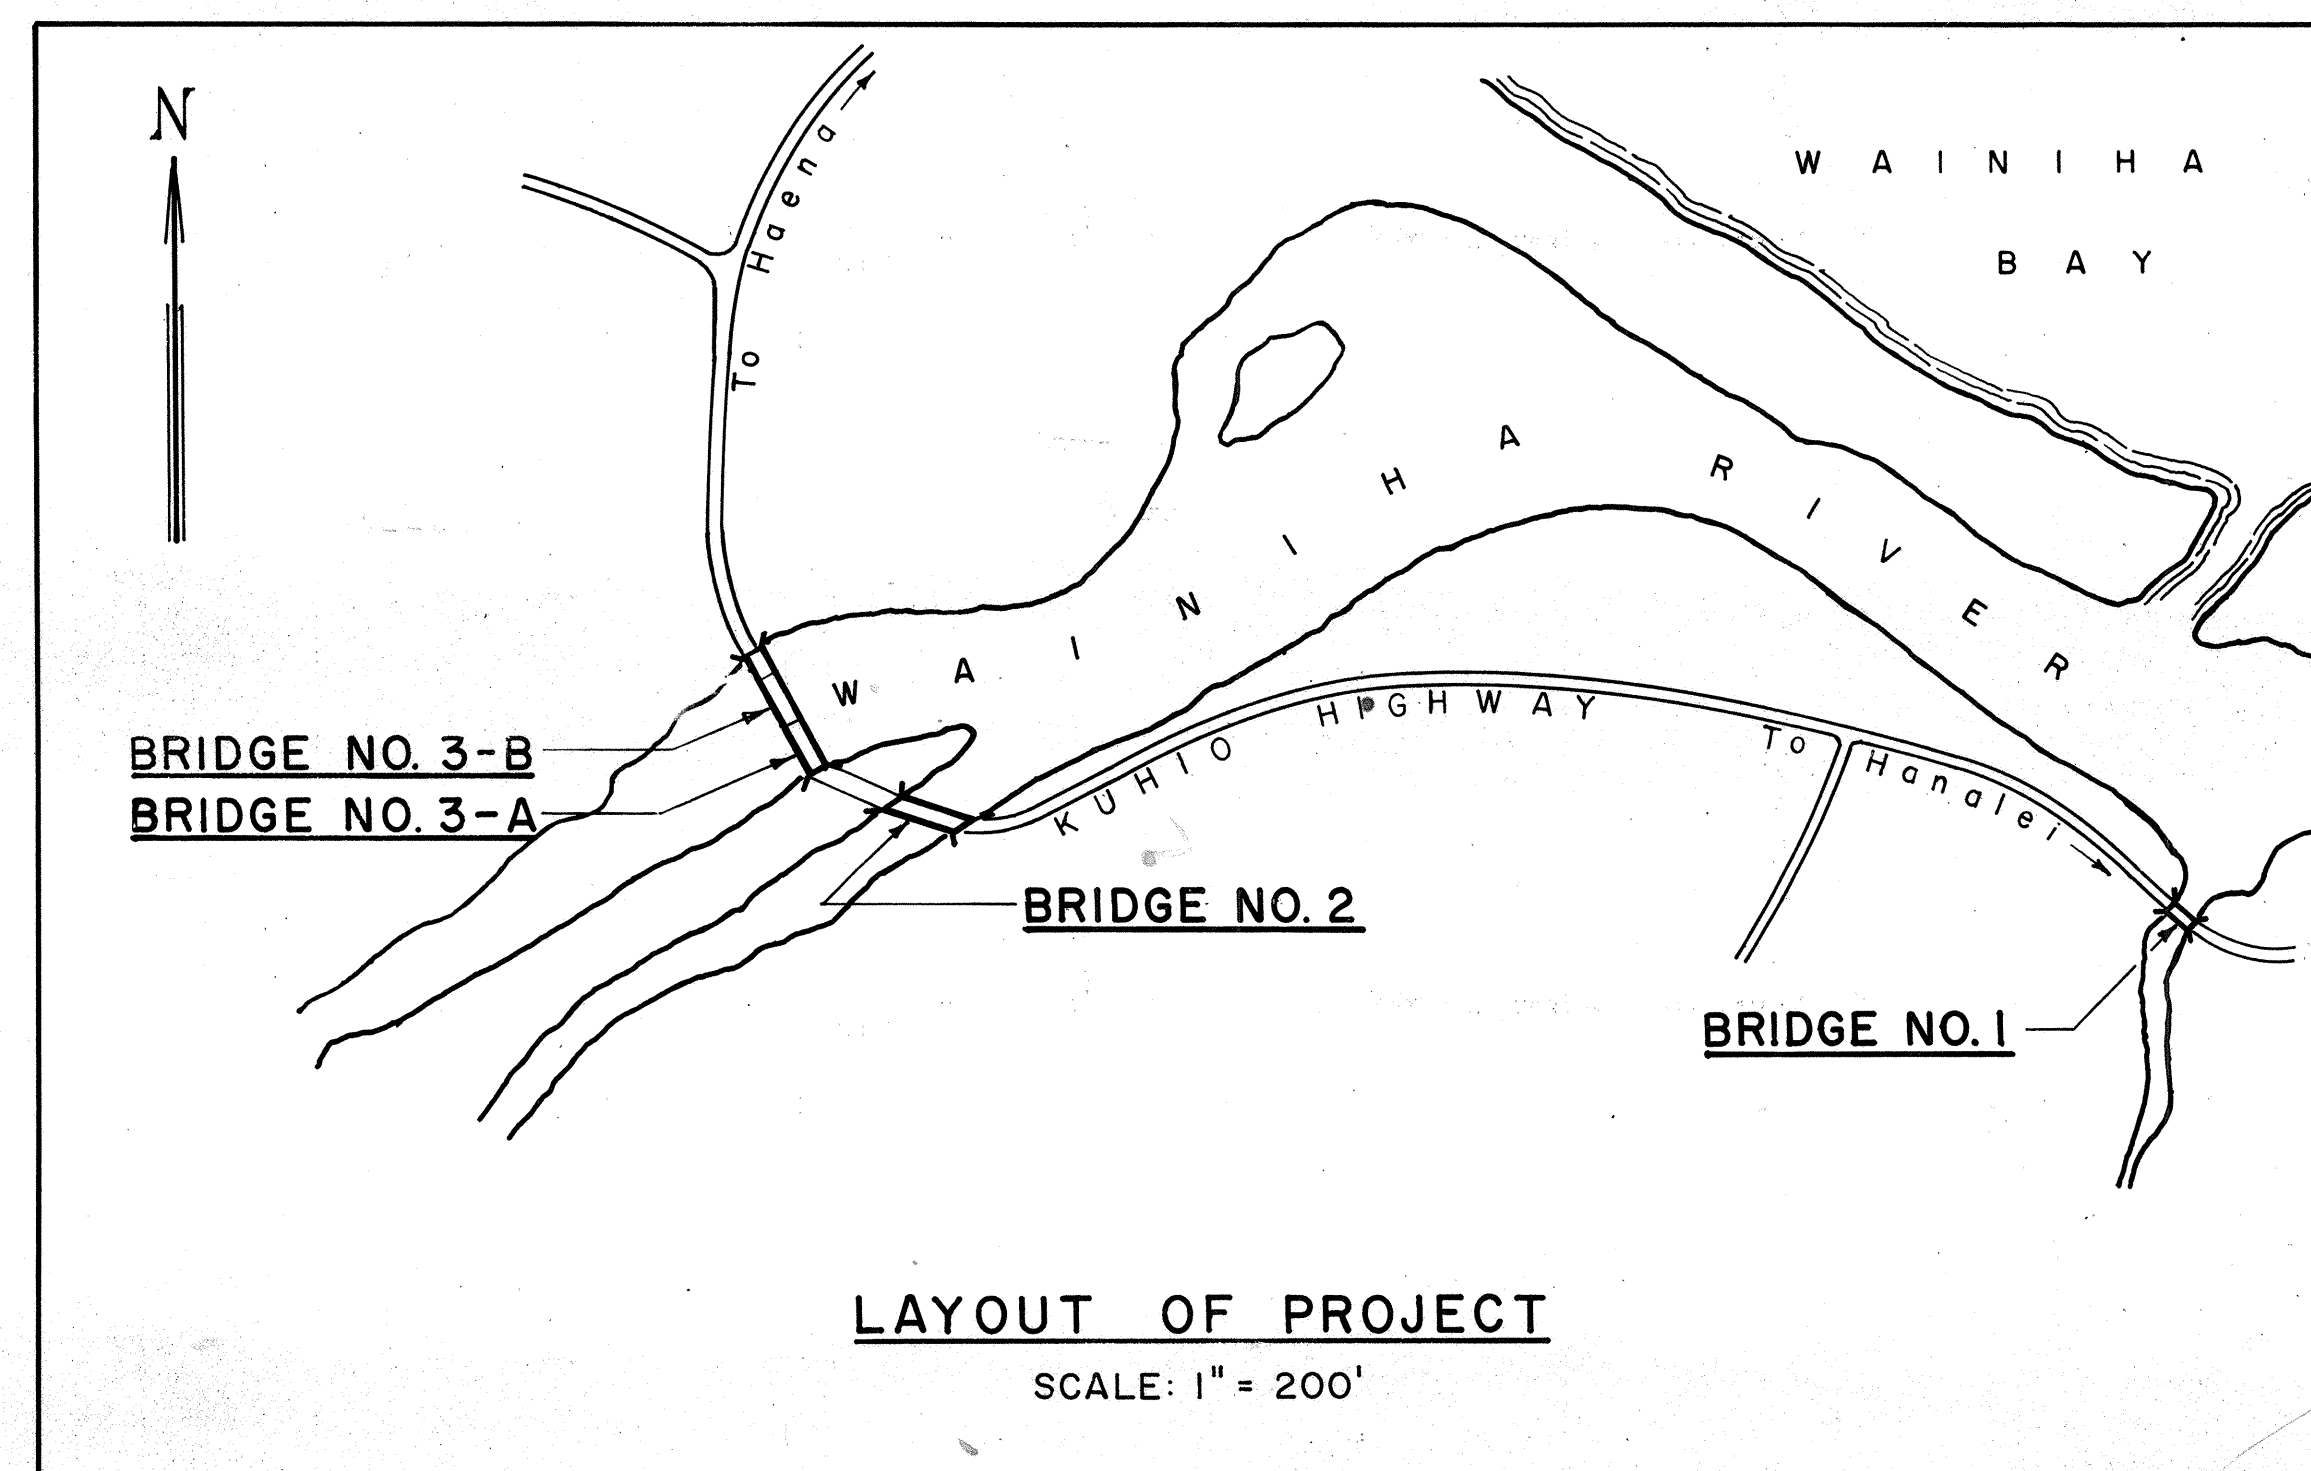


DIST. NO.	STATE	PROJ. NO.	FISCAL YEAR	SHEET NO.	TOTAL SHEETS
HAWAII	HAW.	56D-02-83M	1983	1	8

INDEX TO DRAWINGS	
SHEET NO.	DESCRIPTION
1	TITLE SHEET
2	PLAN AND SECTIONS BRIDGE NO. 2
3	PLAN AND SECTIONS BRIDGE NO. 3
4	PLAN AND SECTIONS BRIDGE, NO. 1
5	TRAFFIC CONTROL PLAN
6 - 8	STANDARD DETAILS

STATE OF HAWAII
DEPARTMENT OF TRANSPORTATION
HIGHWAYS DIVISION
"AS-BUILT"
PLANS FOR
KUHIO HIGHWAY, REPLACE TIMBER
DECKING, WAINIHA BRIDGES NO. 1, 2 AND 3
PROJECT NO. 56D-02-83M
DISTRICT OF HANAIEI
ISLAND OF KAUAI

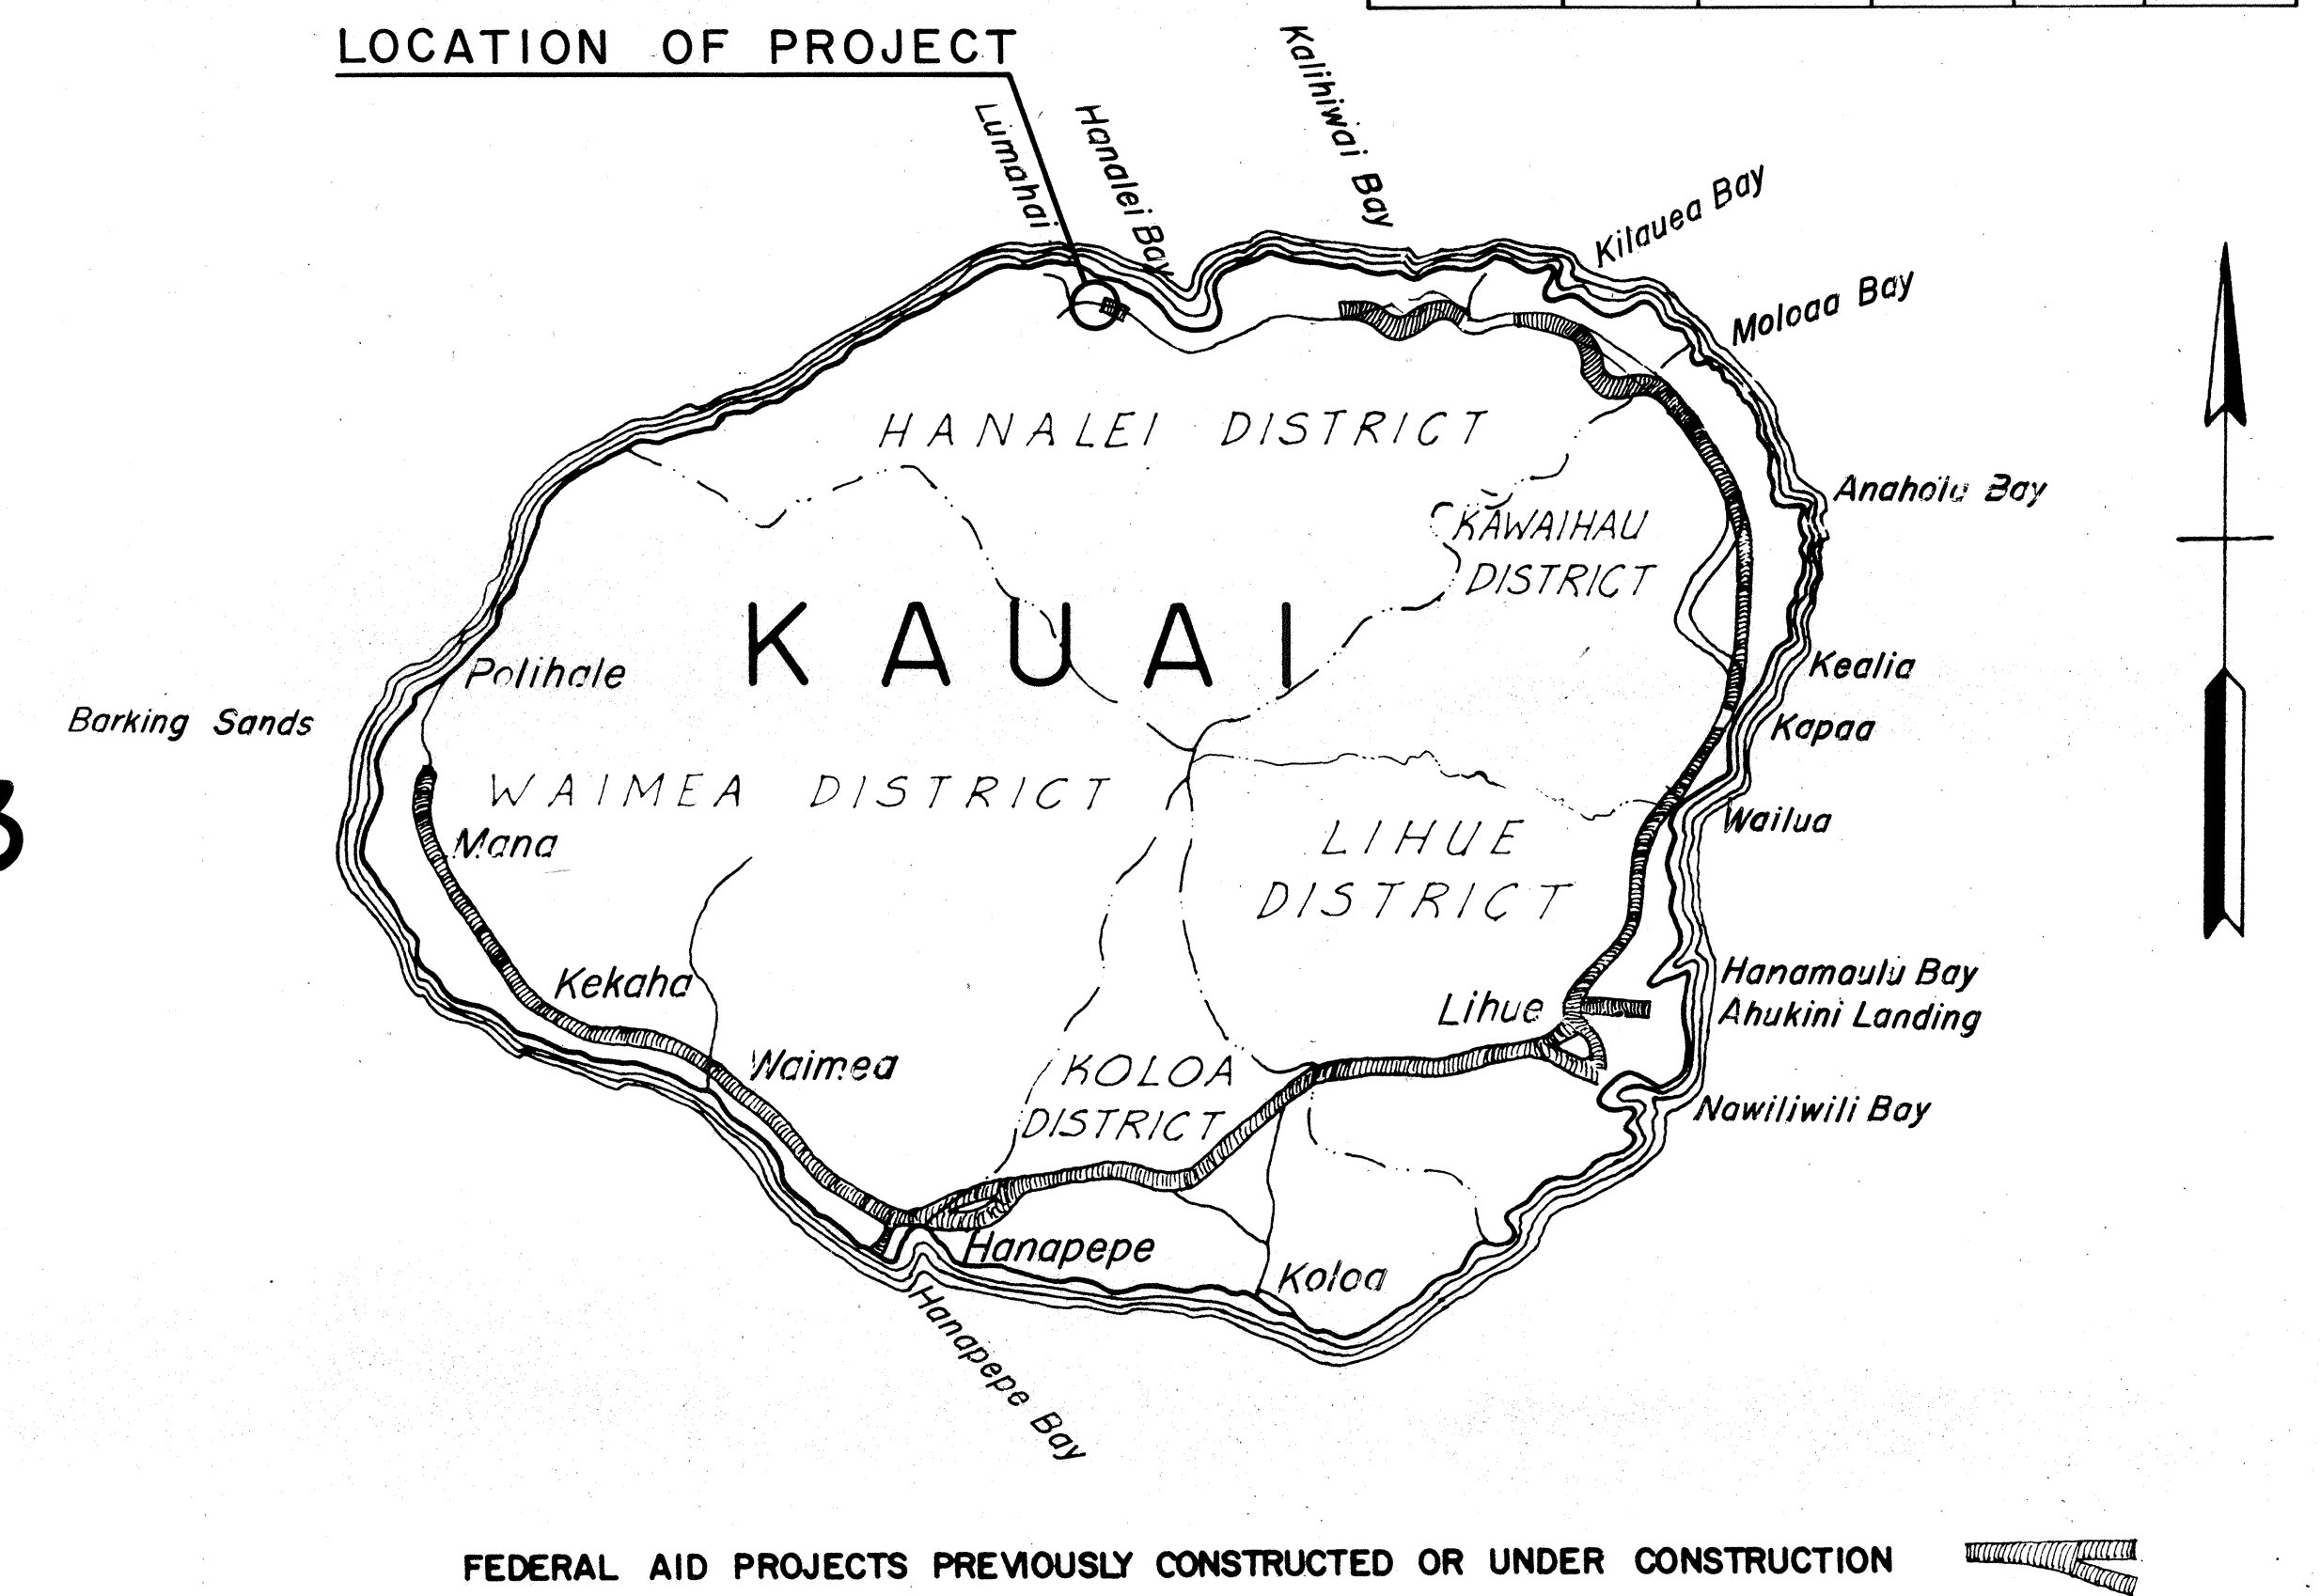

CHANGES MADE DURING CONSTRUCTION
HAVE BEEN NOTED ON THESE PLANS AND
CHECKED BY:

Donald Nagamine 3-6-84
RESIDENT ENGINEER DATE

DEPARTMENT OF TRANSPORTATION STATE OF HAWAII	
APPROVED: <i>R. Higashimura</i>	<i>May 9, 83</i>
DIR. OF TRANSPORTATION	DATE

ORIGINAL PLAN	SURVEY PLOTTED BY _____ DATE _____
NOTE BOOK	DESIGNED BY _____
	DRAWN BY _____
	TRACED BY _____
	QUANTITIES BY _____
	QUANTITIES CHECKED BY _____
	CHECKED BY _____
	N ₀ _____