


FED. ROAD DIST. NO.	STATE	PROJ. NO.	FISCAL YEAR	SHEET NO.	TOTAL SHEETS
HAWAII	HAW.	56D-01-85M	1985	3	9

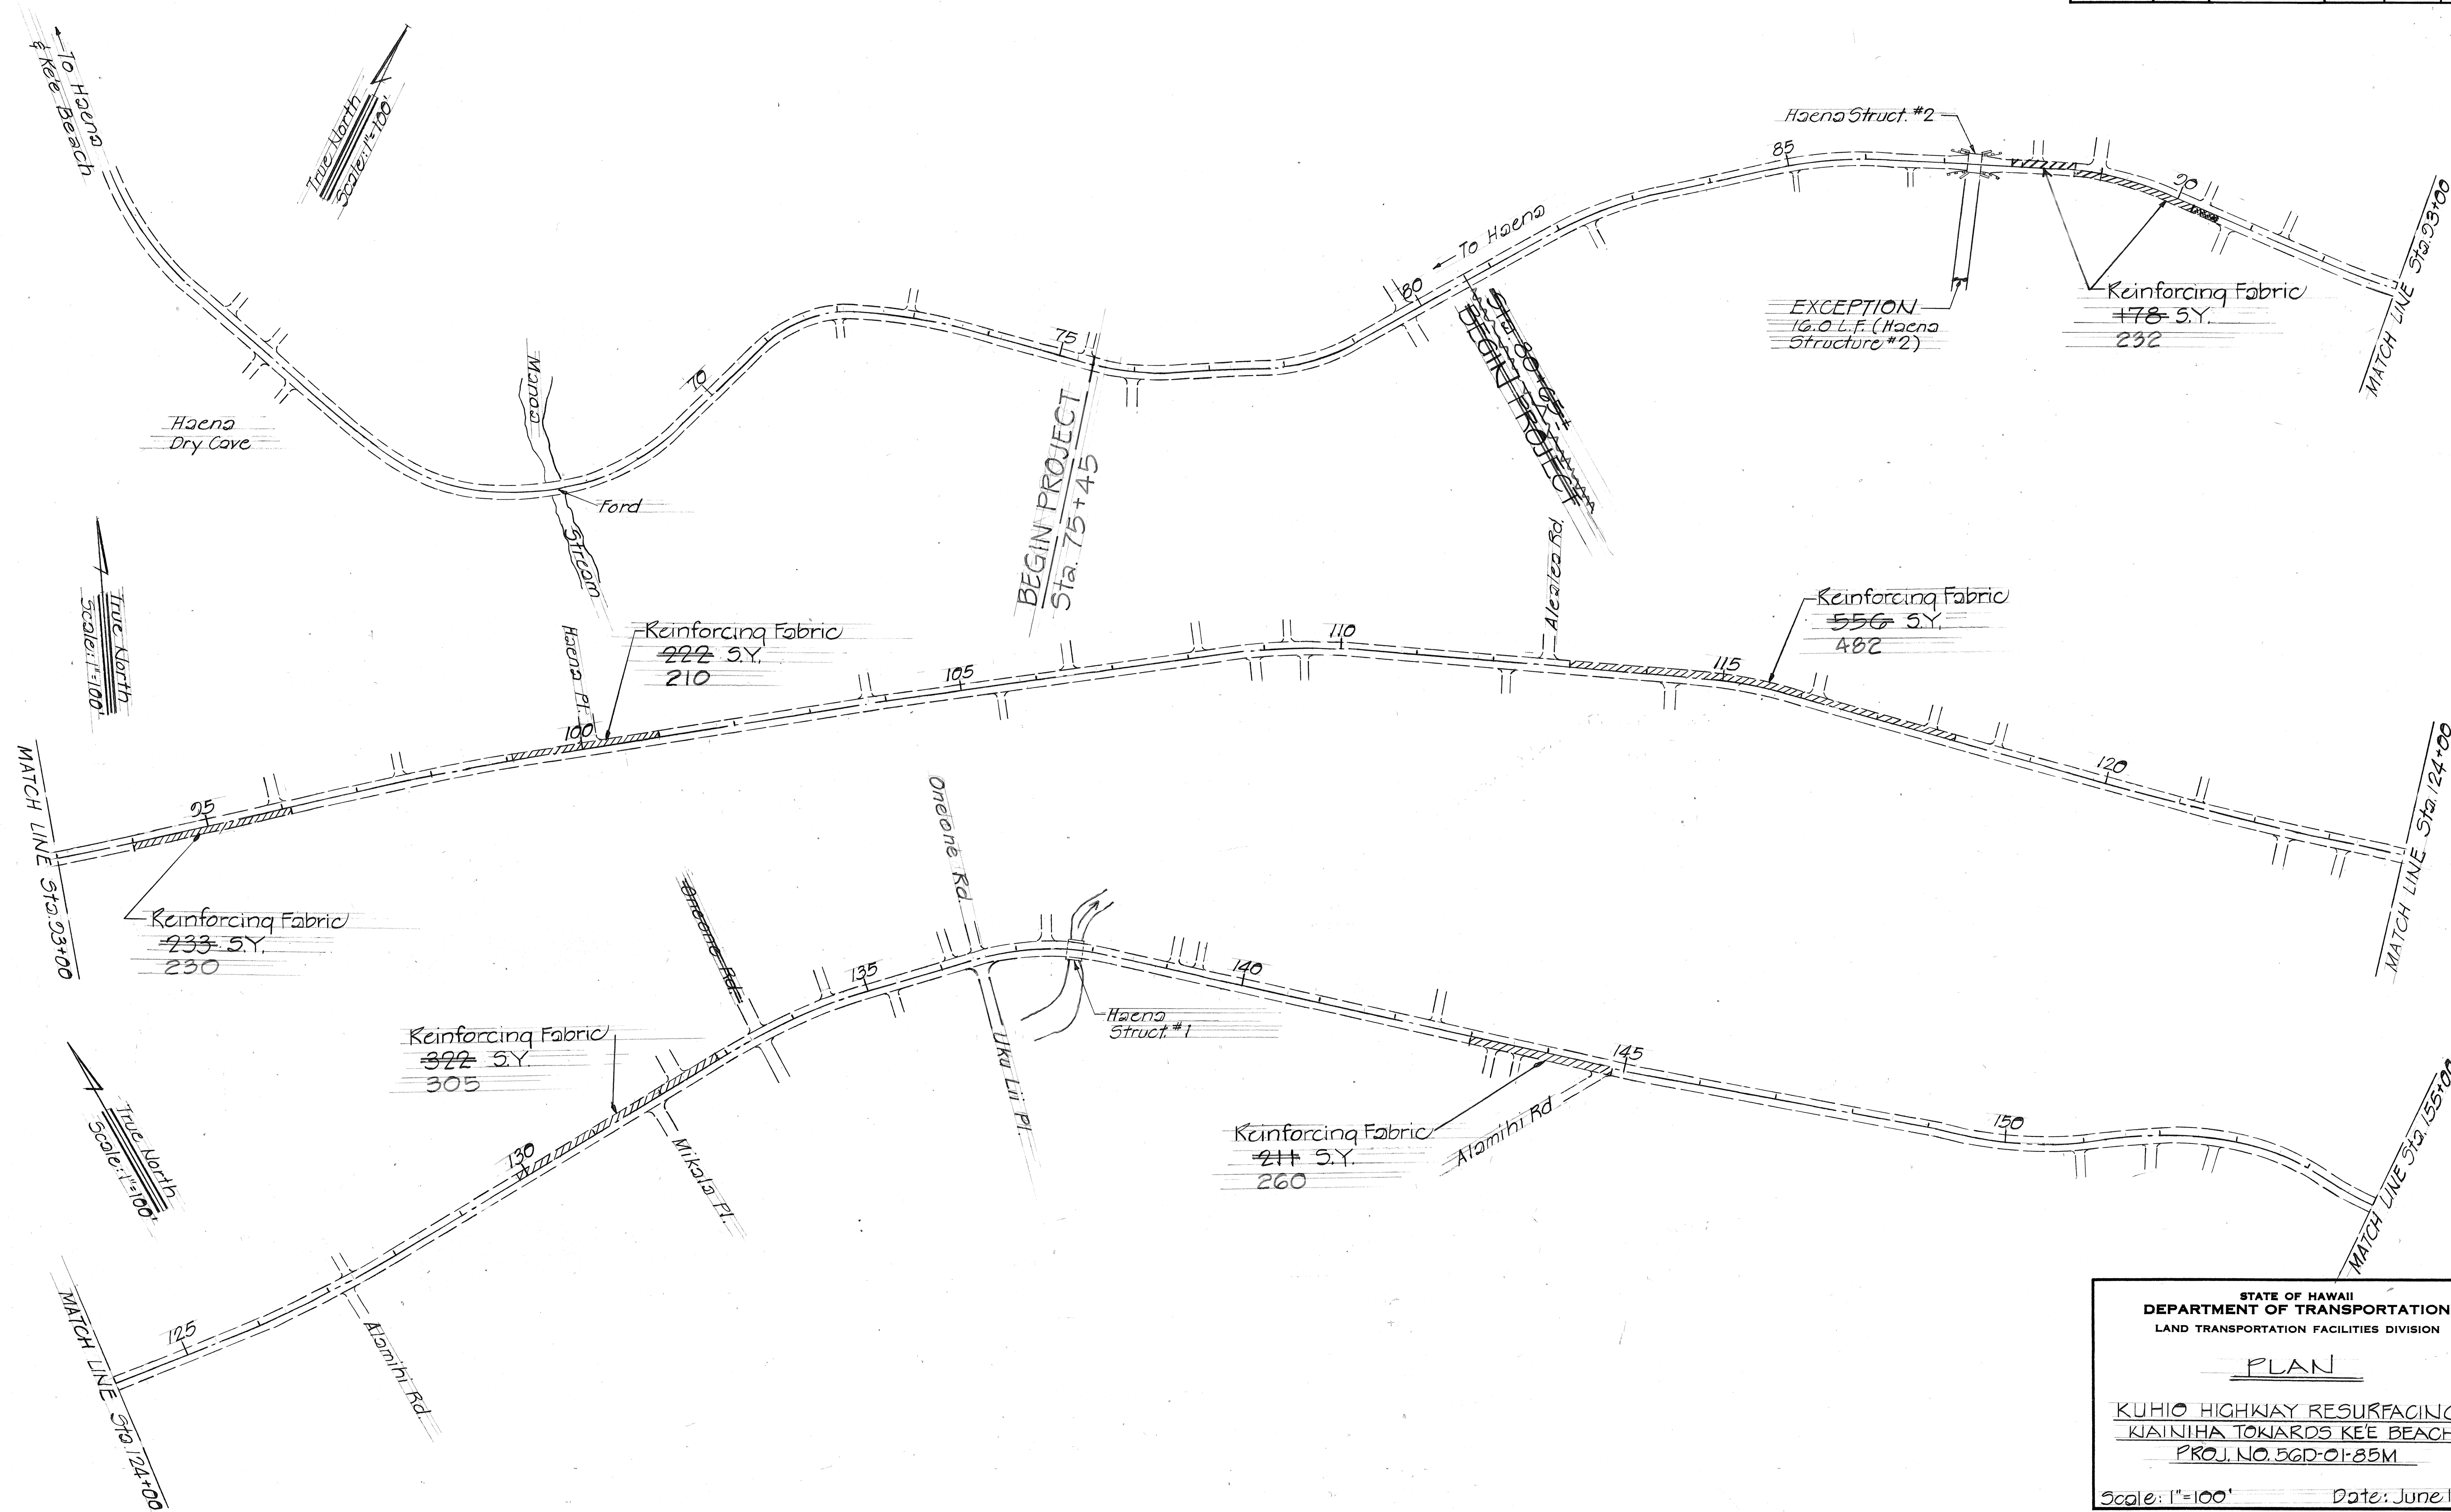

ORIGINAL PLAN	DATE
DESIGNED BY	DATE
NOTED BY	DATE
CHECKED BY	DATE

STATE OF HAWAII
DEPARTMENT OF TRANSPORTATION
LAND TRANSPORTATION FACILITIES DIVISION


PLAN

KUHIO HIGHWAY RESURFACING,
KAIINIHA TOWARDS KEE BEACH
PROJ. NO. 56D-01-85M

Scale: 1"=100' Date: June 1984

SHEET No. 1 OF 2 SHEETS

FED. ROAD DIST. NO.	STATE	PROJ. NO.	FISCAL YEAR	SHEET NO.	TOTAL SHEETS
HAWAII	HAW.	56D-01-85M	1985	4	9

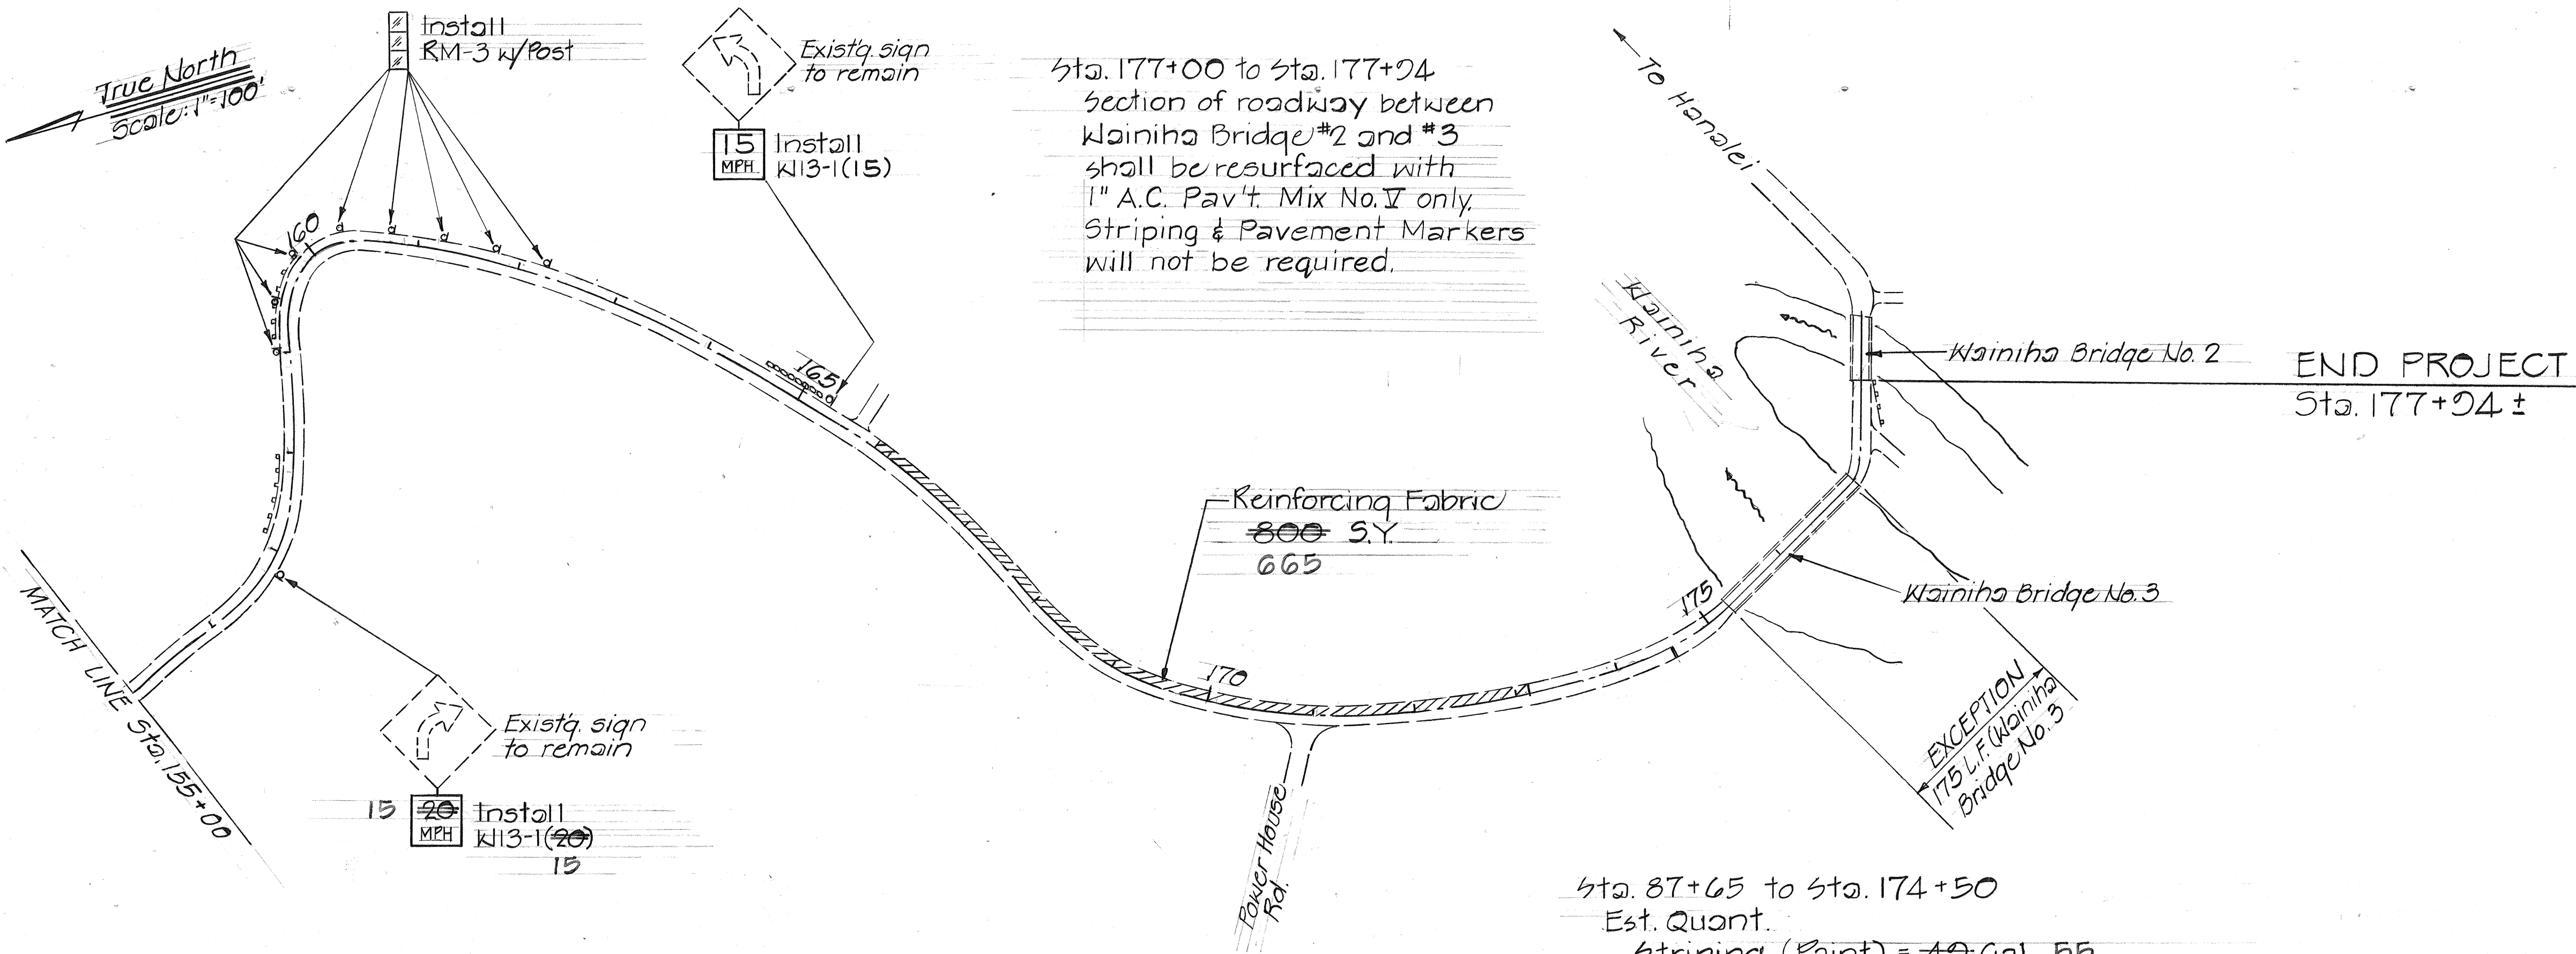


Sta. 87+65 to Sta. 174+50
 Est. Quant.
 Striping (Paint) = ~~40~~ Gal. 55
 Stop Bar (Tape) = ~~30~~ L.F. 29.60
 For Raised Pavement Markers, see Summary below

SUMMARY ~ RAISED PAVEMENT MARKERS & STRIPING						
Station	Striping L.F.	Pavement Markers Ea.			Zone	
	\$	Type D	Type H	Type J		
75+45						
80+65-93+05	1,760	88			No Pass	
93+05-98+05	500	12	13	52	Pass/No Pass	
98+05-99+05		3		12	Pass	
99+05-102+05	300	16			No Pass	
102+05-103+45		4		16	Pass	
103+45-109+05	560	14	15	60	No Pass/Pass	
109+05-114+85	580	30			No Pass	
114+85-117+45	460	11	12	48	Pass/No Pass	
117+45-120+45		3		12	Pass	
120+45-127+05	660	16	17	68	No Pass/Pass	
127+05-137+05	1,000	50			No Pass	
137+05-138+85					Haena Struct. #1	
138+85-144+85	600	15	16	64	Pass/No Pass	
144+85-146+05	120	7			No Pass	
146+05-150+85	480	12	13	52	No Pass/Pass	
150+85-170+70	1985	100			No Pass	
170+70-171+20		2			50' Opening Power House Rd.	
171+20-174+50	330	17			No Pass	
Total	8,815	375	86	384		
	9,335	402	76	332		

Stop Bar locations (one lane bridges)
 Sta. 137+05 ± Rt.
 Sta. 138+85 ± Lt.
 Sta. 174+50 ± Rt.

Note:
 Location of new pavement markings shall be staked out in the field by the contractor for approval by the Engineer prior to installation.

Station	Striping L.F.	Pavement Markers Ea.			Zone
	\$	Type D	Type H	Type J	
127+05-136+35	930	46			No Pass
136+35-136+75		2			Oneone Rd. 40' Opening
136+75-137+05	30	2			No Pass
137+05-138+85					Haena Struct. #1
138+85-139+35	50	3			No Pass
139+35-144+85	550	14	14	56	Pass/No Pass

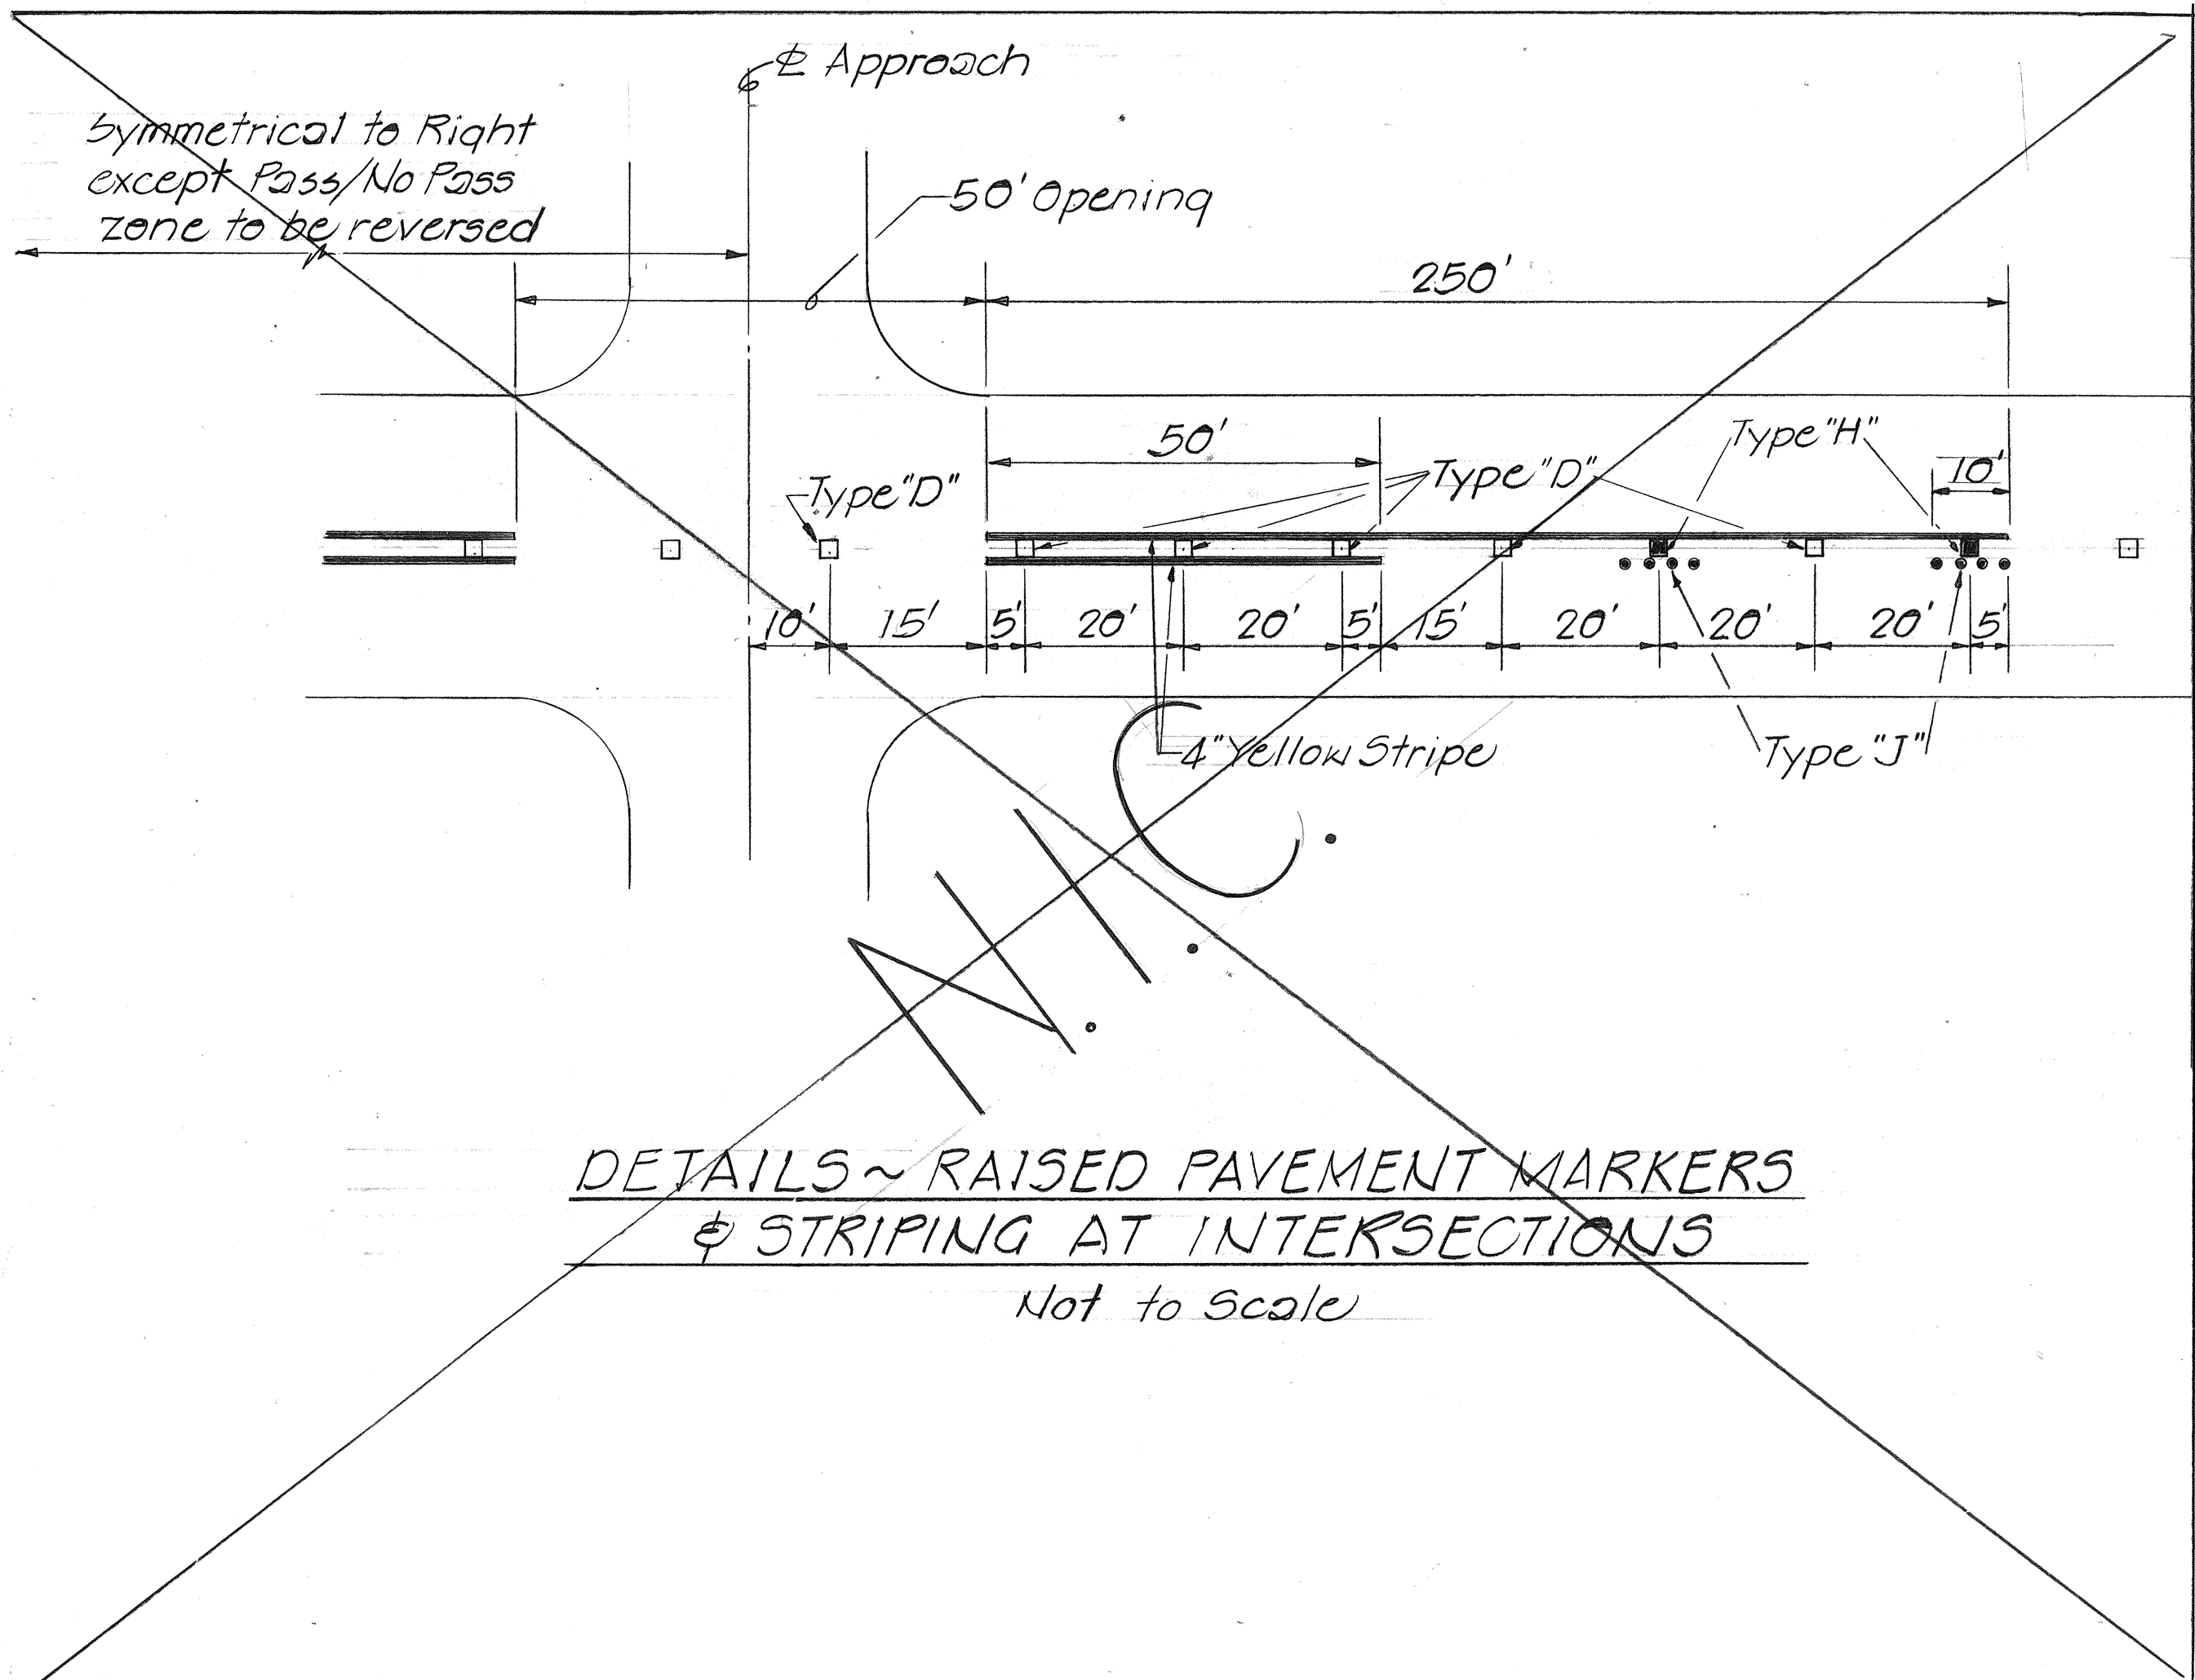

DATE	DESIGNED BY	CHECKED BY
PLANNED BY	NOTED BY	QUANTITIES BY
TRACED BY	DESIGNED BY	CHECKED BY
NOTE BOOK	DESIGNED BY	CHECKED BY
No.	DESIGNED BY	CHECKED BY

STATE OF HAWAII
DEPARTMENT OF TRANSPORTATION
LAND TRANSPORTATION FACILITIES DIVISION

PLAN, PAVEMENT MARKING
SUMMARY & MISC. DETAILS

KUHIO HIGHWAY RESURFACING,
WAINIHA TOWARDS KEE BEACH
PROJ. NO. 56D-01-85M

Scale: As shown Date: June 1984
SHEET NO. 2 OF 2 SHEETS