	INDEX TO DRAWINGS			
SHEET NO.	DESCRIPTION			
	TITLE SHEET			
2	TYPICAL SECTION & GENERAL NOTES			
3 - 4	PLANS			
5 - 9	STANDARD DETAILS			

Aug., 1984 DATE

548-7537 PHONE

KAUAI DISTRICT DESIGNED BY



STATE OF HAWAII

## DEPARTMENT OF TRANSPORTATION

HIGHWAYS DIVISION


"AS-BUILT"

PLANS FOR

## KUHIO HIGHWAY RESURFACING


WAINIHA TOWARDS KE'E BEACH PROJECT NO. 56D-01-85M


DISTRICT OF HANALEI
ISLAND OF KAUAI

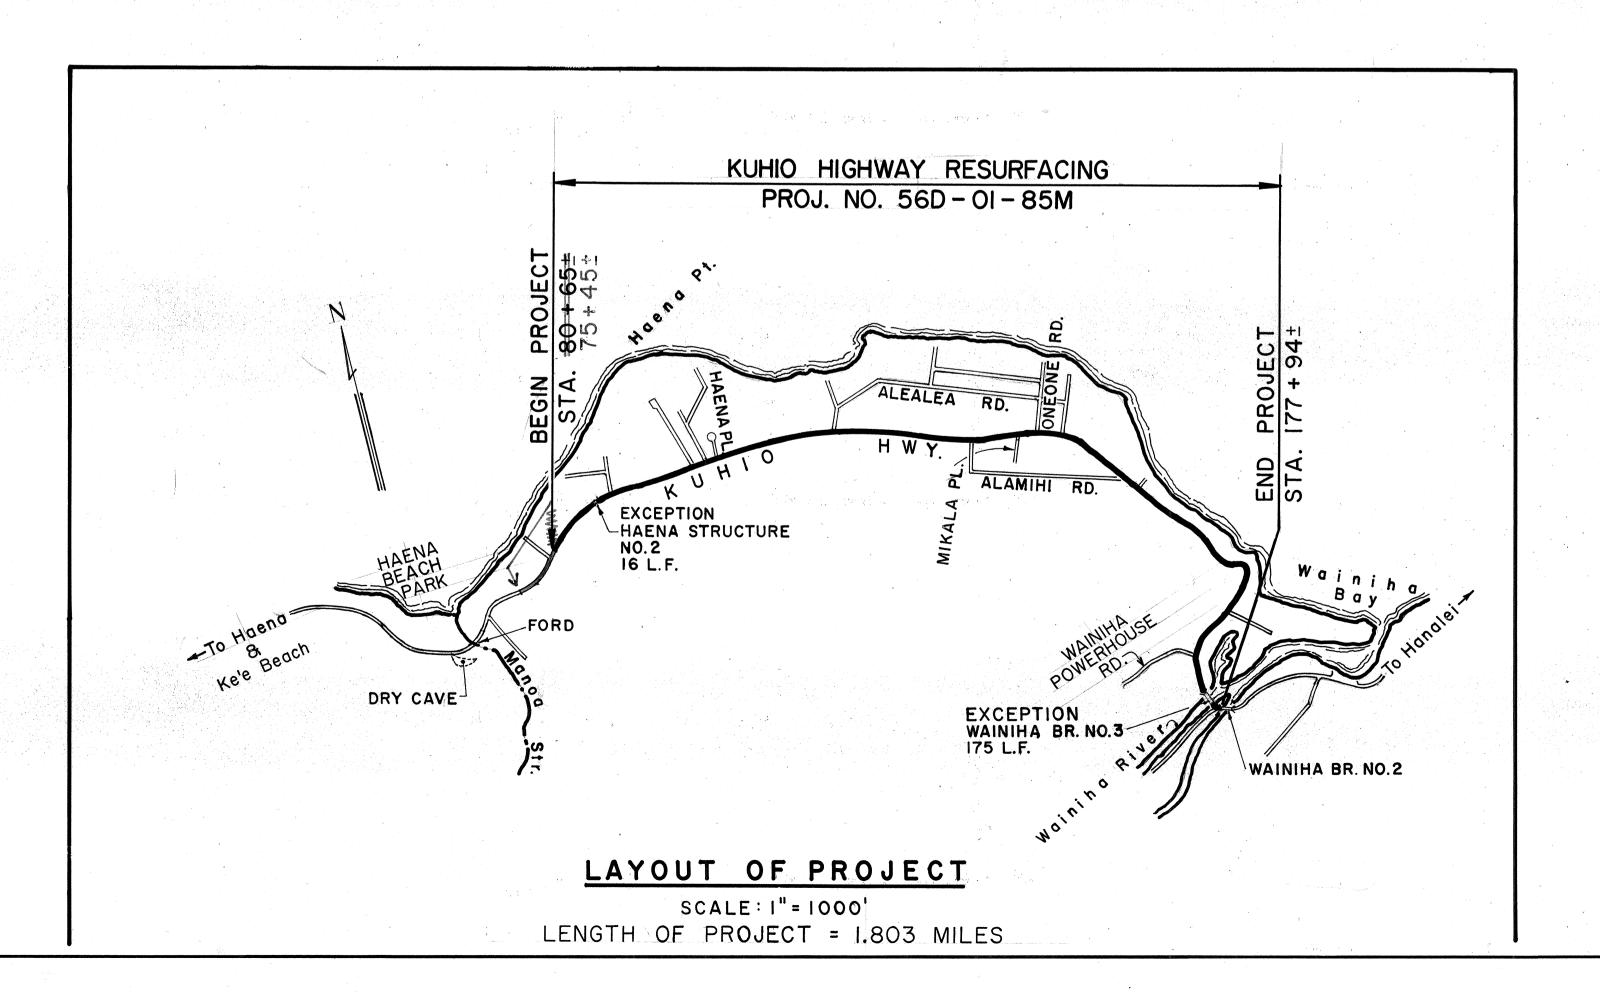

	DIST. NO.	STATE HAW.	PROJ. NO.	YEAR	SHEET NO.	SHEETS
٧	ПАУУАП	пауу.	56D-01-85M	1985	J	, 9



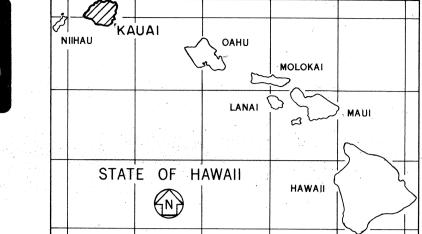

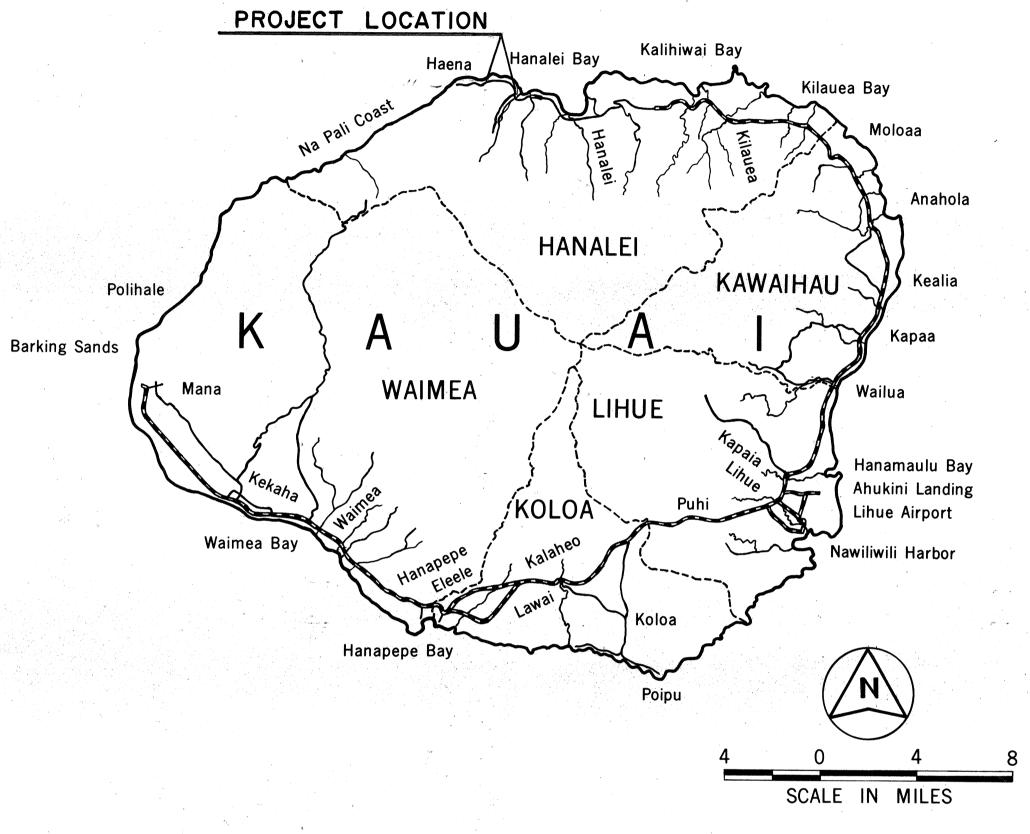

FEDERAL AID PROJECTS PREVIOUSLY CONSTRUCTED

OR UNDER CONSTRUCTION

CHANGES MADE DURING CONSTRUCTION HAVE
BEEN INCORPORATED ON THESE PLANS EXCEPT
CHANGES IN THE ORIGINAL THEORETICAL
QUANTITIES. FOR ACTUAL QUANTITIES, REFER TO
PROJECT LEDGER AND/OR COMPUTATION BOOK.

Jory H Maeda For RESIDENT ENGINEER

ANSPORTATION

C/17/88 DATE

DATE