


FED. ROAD DIST. NO.	STATE	PROJ. NO.	FISCAL YEAR	SHEET NO.	TOTAL SHEETS
HAWAII	HAW.	560A-01-86M	1986	3	7

Sta. 0+00 to Sta. 75+45+
 Install Reinforcing Fabric, Resurface existing traveled lanes and install Centerline Pavement Markers & Striping. For details, see "Typical Section" and "Centerline Striping & Pavement Markers" Sheet No. 2

Est. Quant.:
 Reinforcing Fabric = 2,170 S.Y.
 SS-1 Tack Coat 2902 = 2,590 Gal.
 A.C. Pavement Mix V 2757.01 = 2,290 Tons
 Type "D" Pav't. Markers = 375 Ea.
 4" Dbl. Yellow Stripe (Paint) = 50 Gal.

Pave Existing Ford with 3/4" Pav't. Mix No. I
 Approximate Area = 954 S.F.
 Exception 53 L.F.
 Limahuli Stream Ford

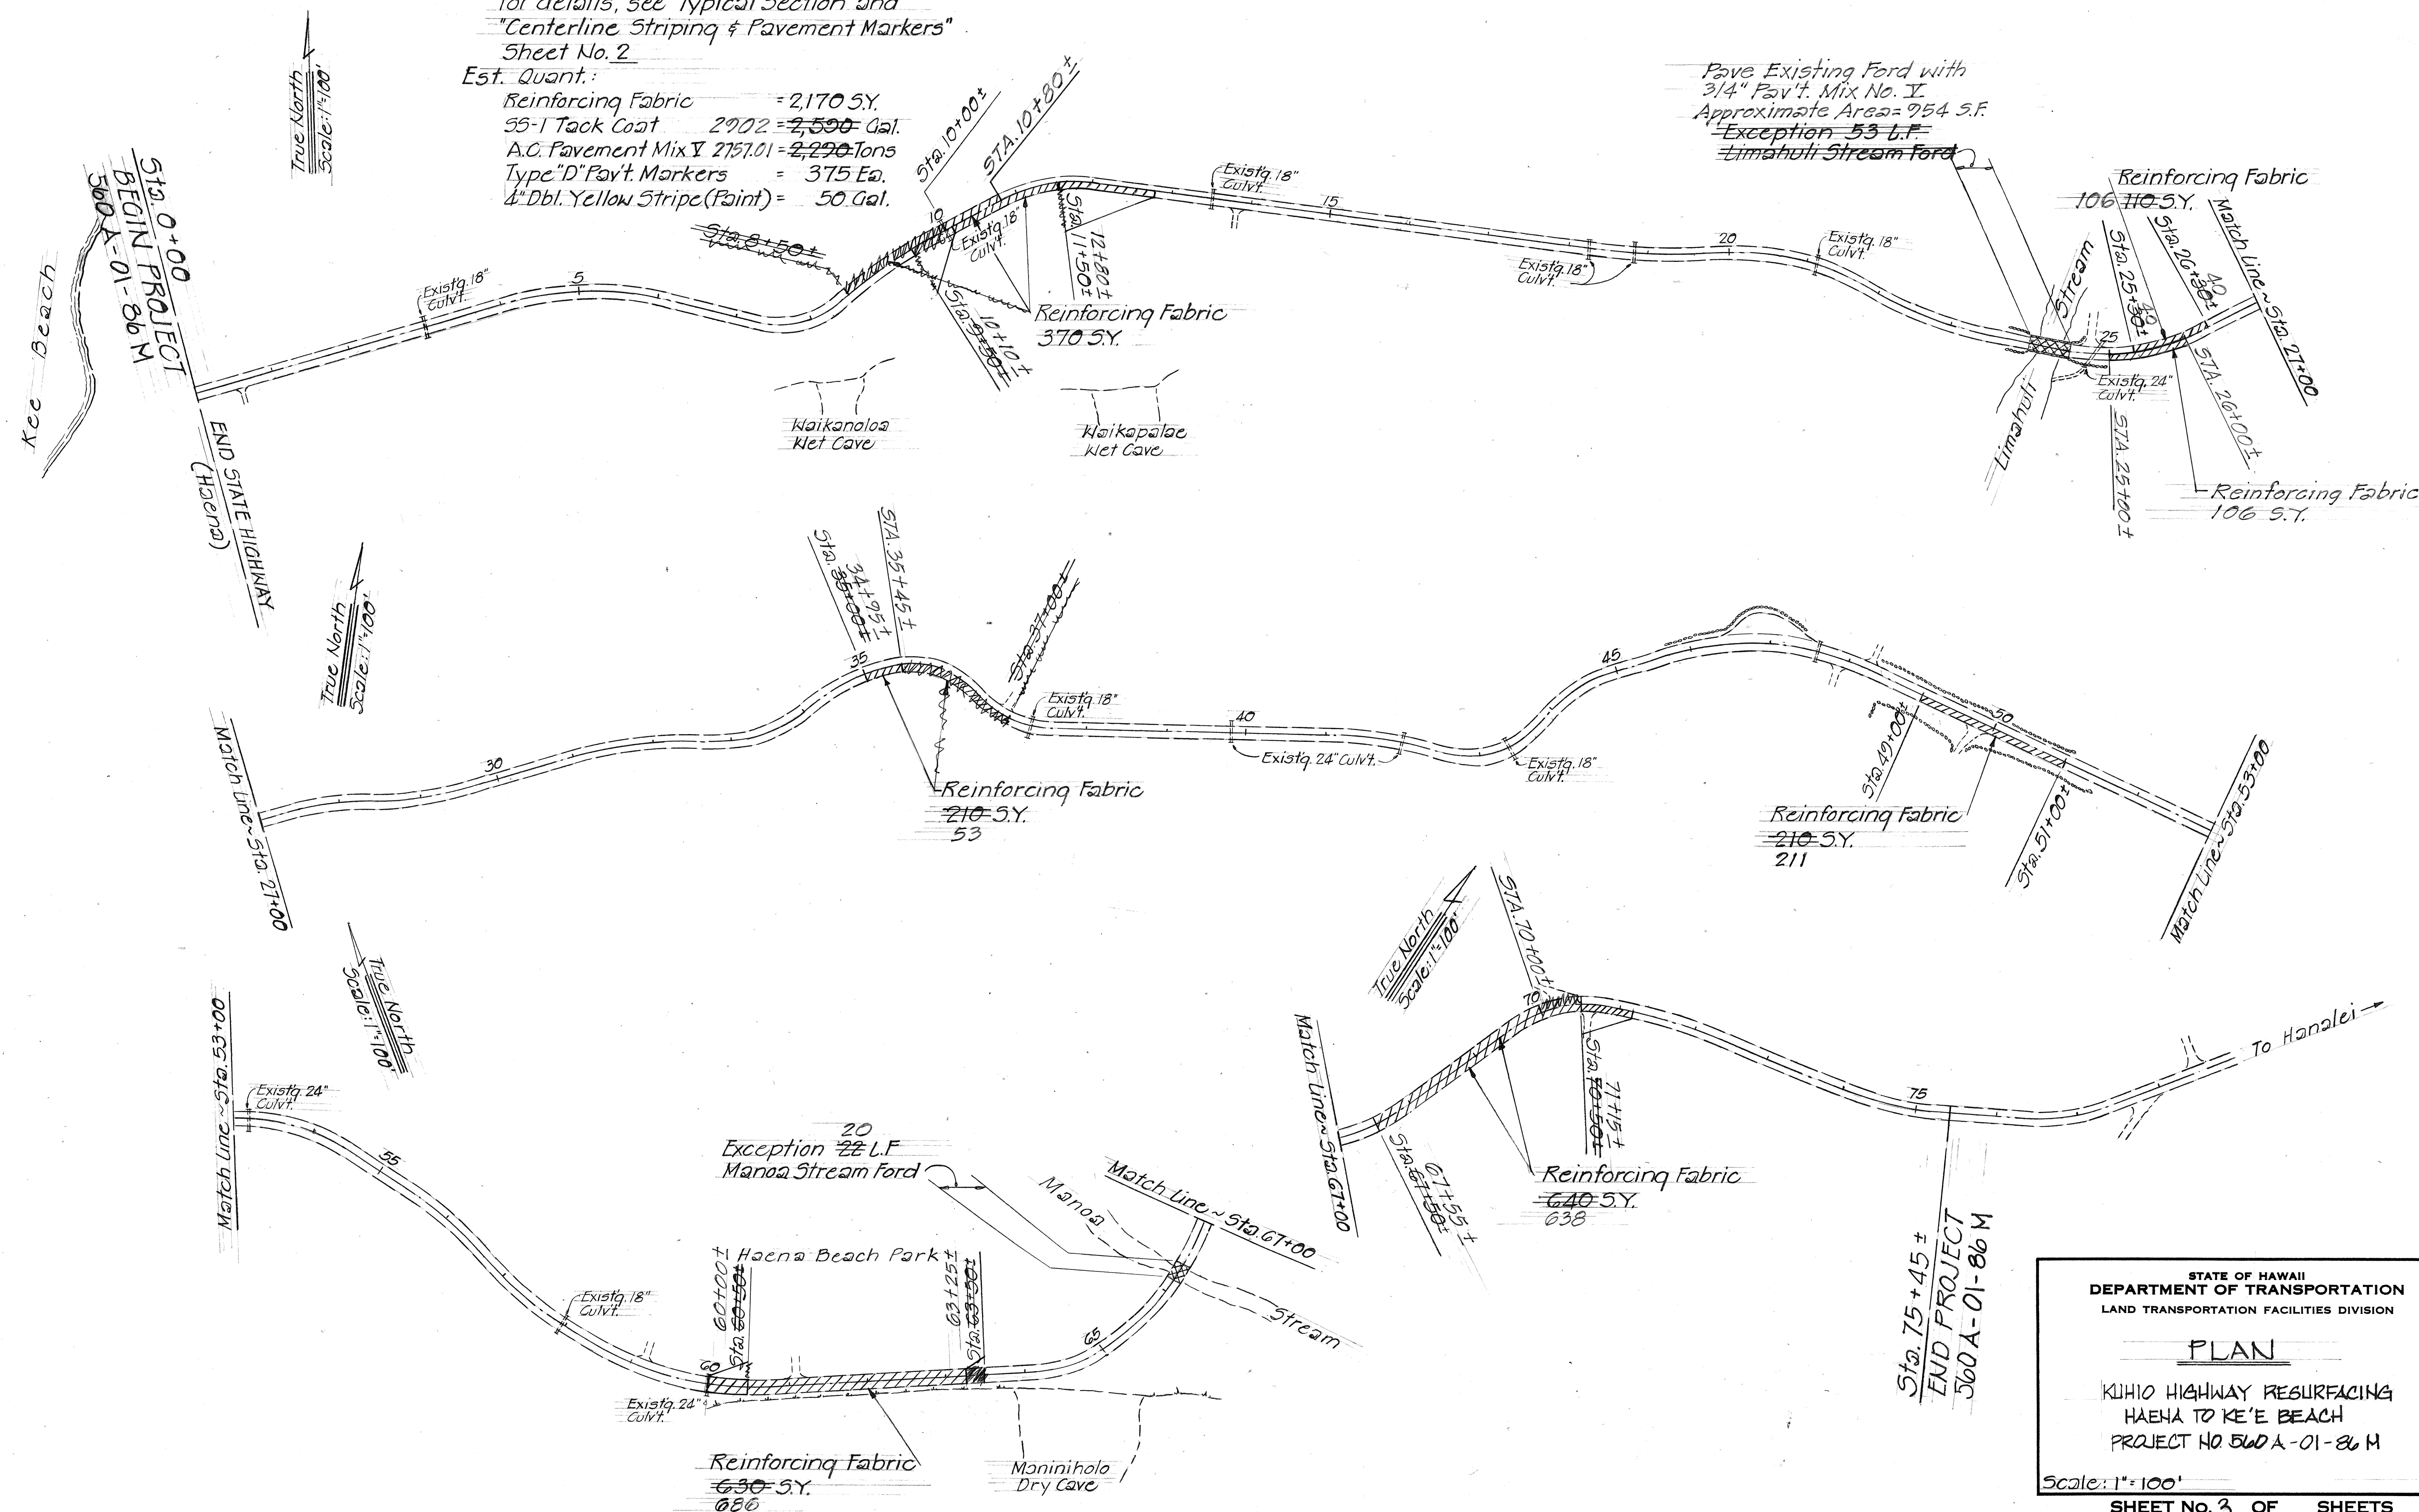

DATE	SURVEY PLOTTED BY
DATE	DRAWN BY
DATE	DESIGNED BY
DATE	QUANTITIES BY
DATE	CHECKED BY

STATE OF HAWAII
 DEPARTMENT OF TRANSPORTATION
 LAND TRANSPORTATION FACILITIES DIVISION

PLAN

KUHIO HIGHWAY RESURFACING
 HAENA TO KE'E BEACH
 PROJECT NO 560A-01-86M

Scale: 1"=100'

SHEET NO. 3 OF SHEETS