	INDEX TO DRAWINGS
SHEET NO.	DESCRIPTION
	TITLE SHEET
2	TYPICAL SECTION, GENERAL NOTES, CENTERLINE STRIPING & RAISED PAVEMENT MARKERS
3	PLANS
4-7	STANDARD DETAILS
1 2	

Sept., 1985 DATE

**548-4125**PHONE

KAUAI DISTRICT DESIGNED BY STATE OF HAWAII

DEPARTMENT OF TRANSPORTATION HIGHWAYS DIVISION

AS BUILT "

PLANS FOR

KUHIO HIGHWAY RESURFACING
HAENA TO KE'E BEACH
PROJECT NO. 560A-01-86M

DISTRICT OF HANALEI
ISLAND OF KAUAI

STATE OF HAWAII


NIIHAU

STATE OF HAWAII

NAME

560A-01-86M

SHEET NO.

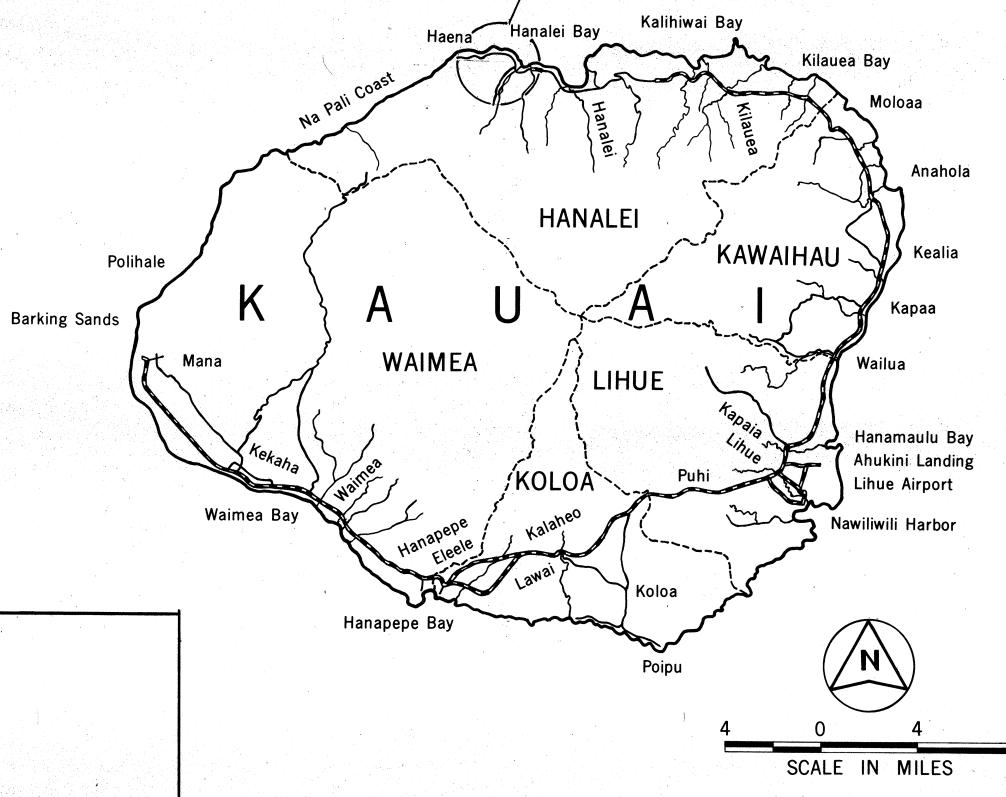

OR UNDER CONSTRUCTION

PROJECT LOCATION

FED. ROAD DIST. NO.

FEDERAL AID PROJECTS PREVIOUSLY CONSTRUCTED

CHANGES MADE DURING CONSTRUCTION HAVE BEEN INCORPORATED ON THESE PLANS EXCEPT CHANGES IN THE ORIGINAL THEORETICAL QUANTITIES, FOR ACTUAL QUANTITIES, REFER TO PROJECT LEDGER AND/OR COMPUTATION BOOK.

for RESIDENT ENGINEER DATE

DEPARTMENT OF TRANSPORTATION
STATE OF HAWAII
APPROVED:

Chenge D. Soon 8/29/85 Fadir. OF TRANSPORTATION DATE

