
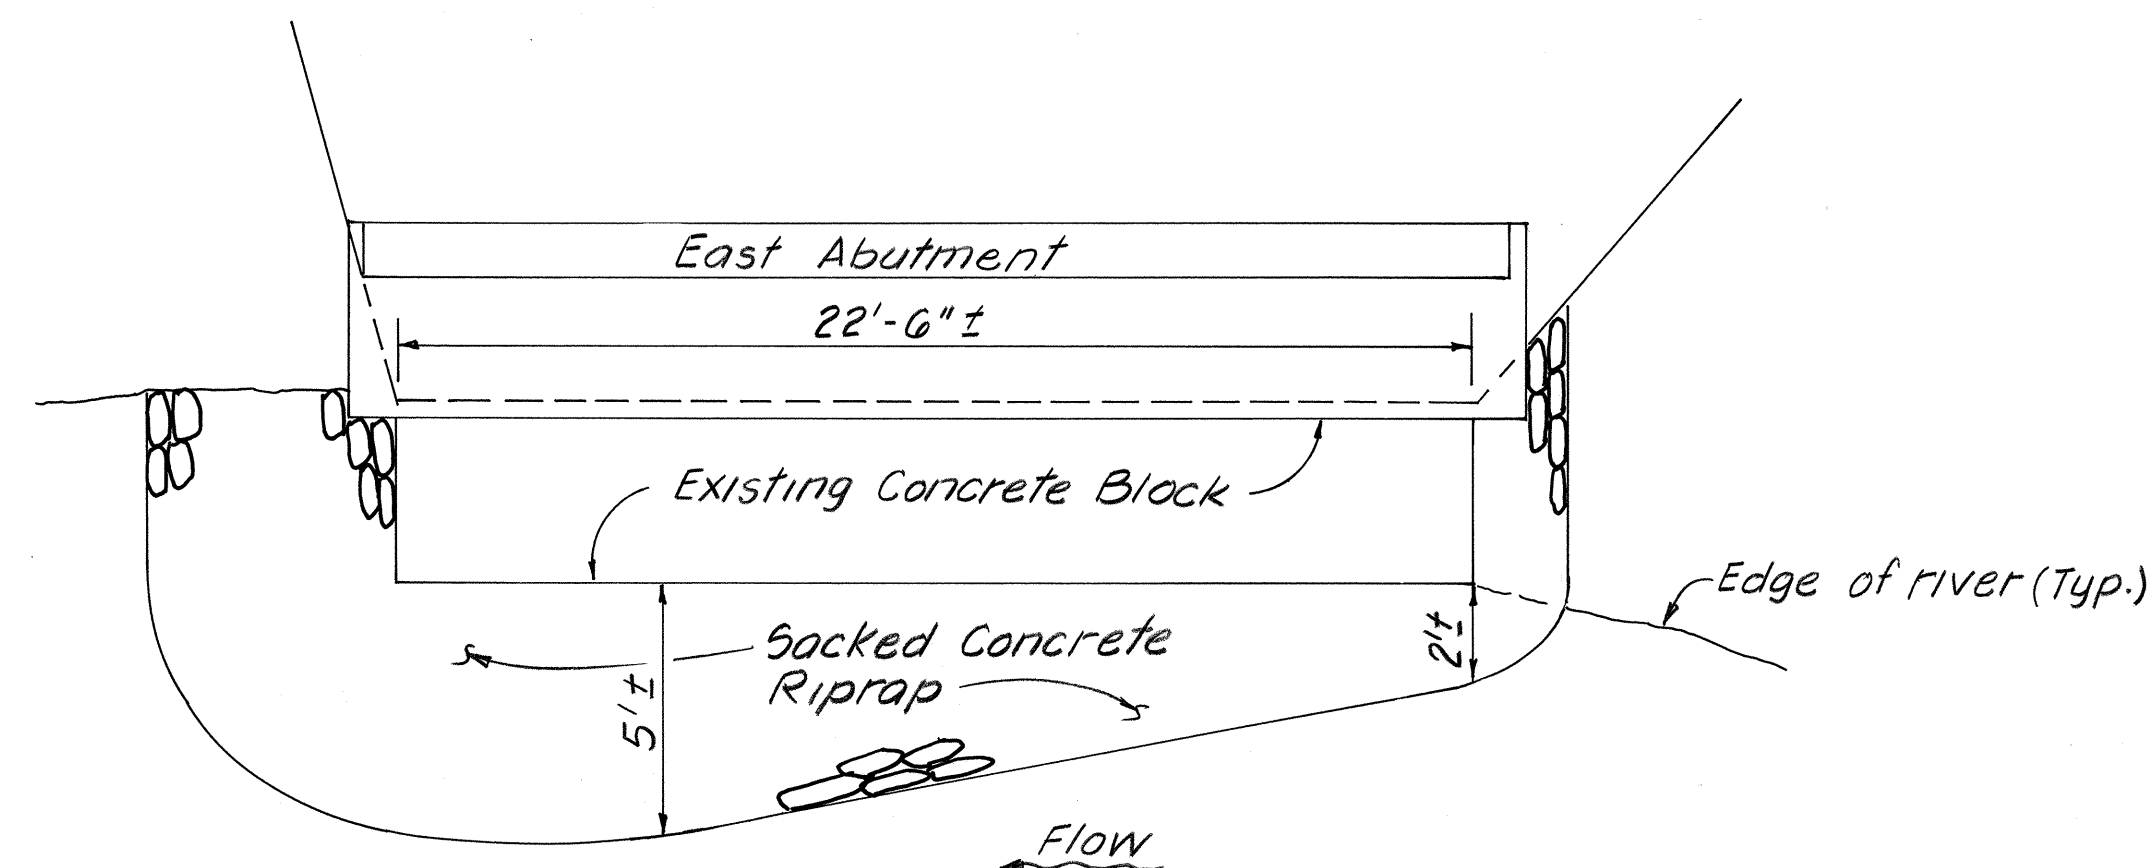
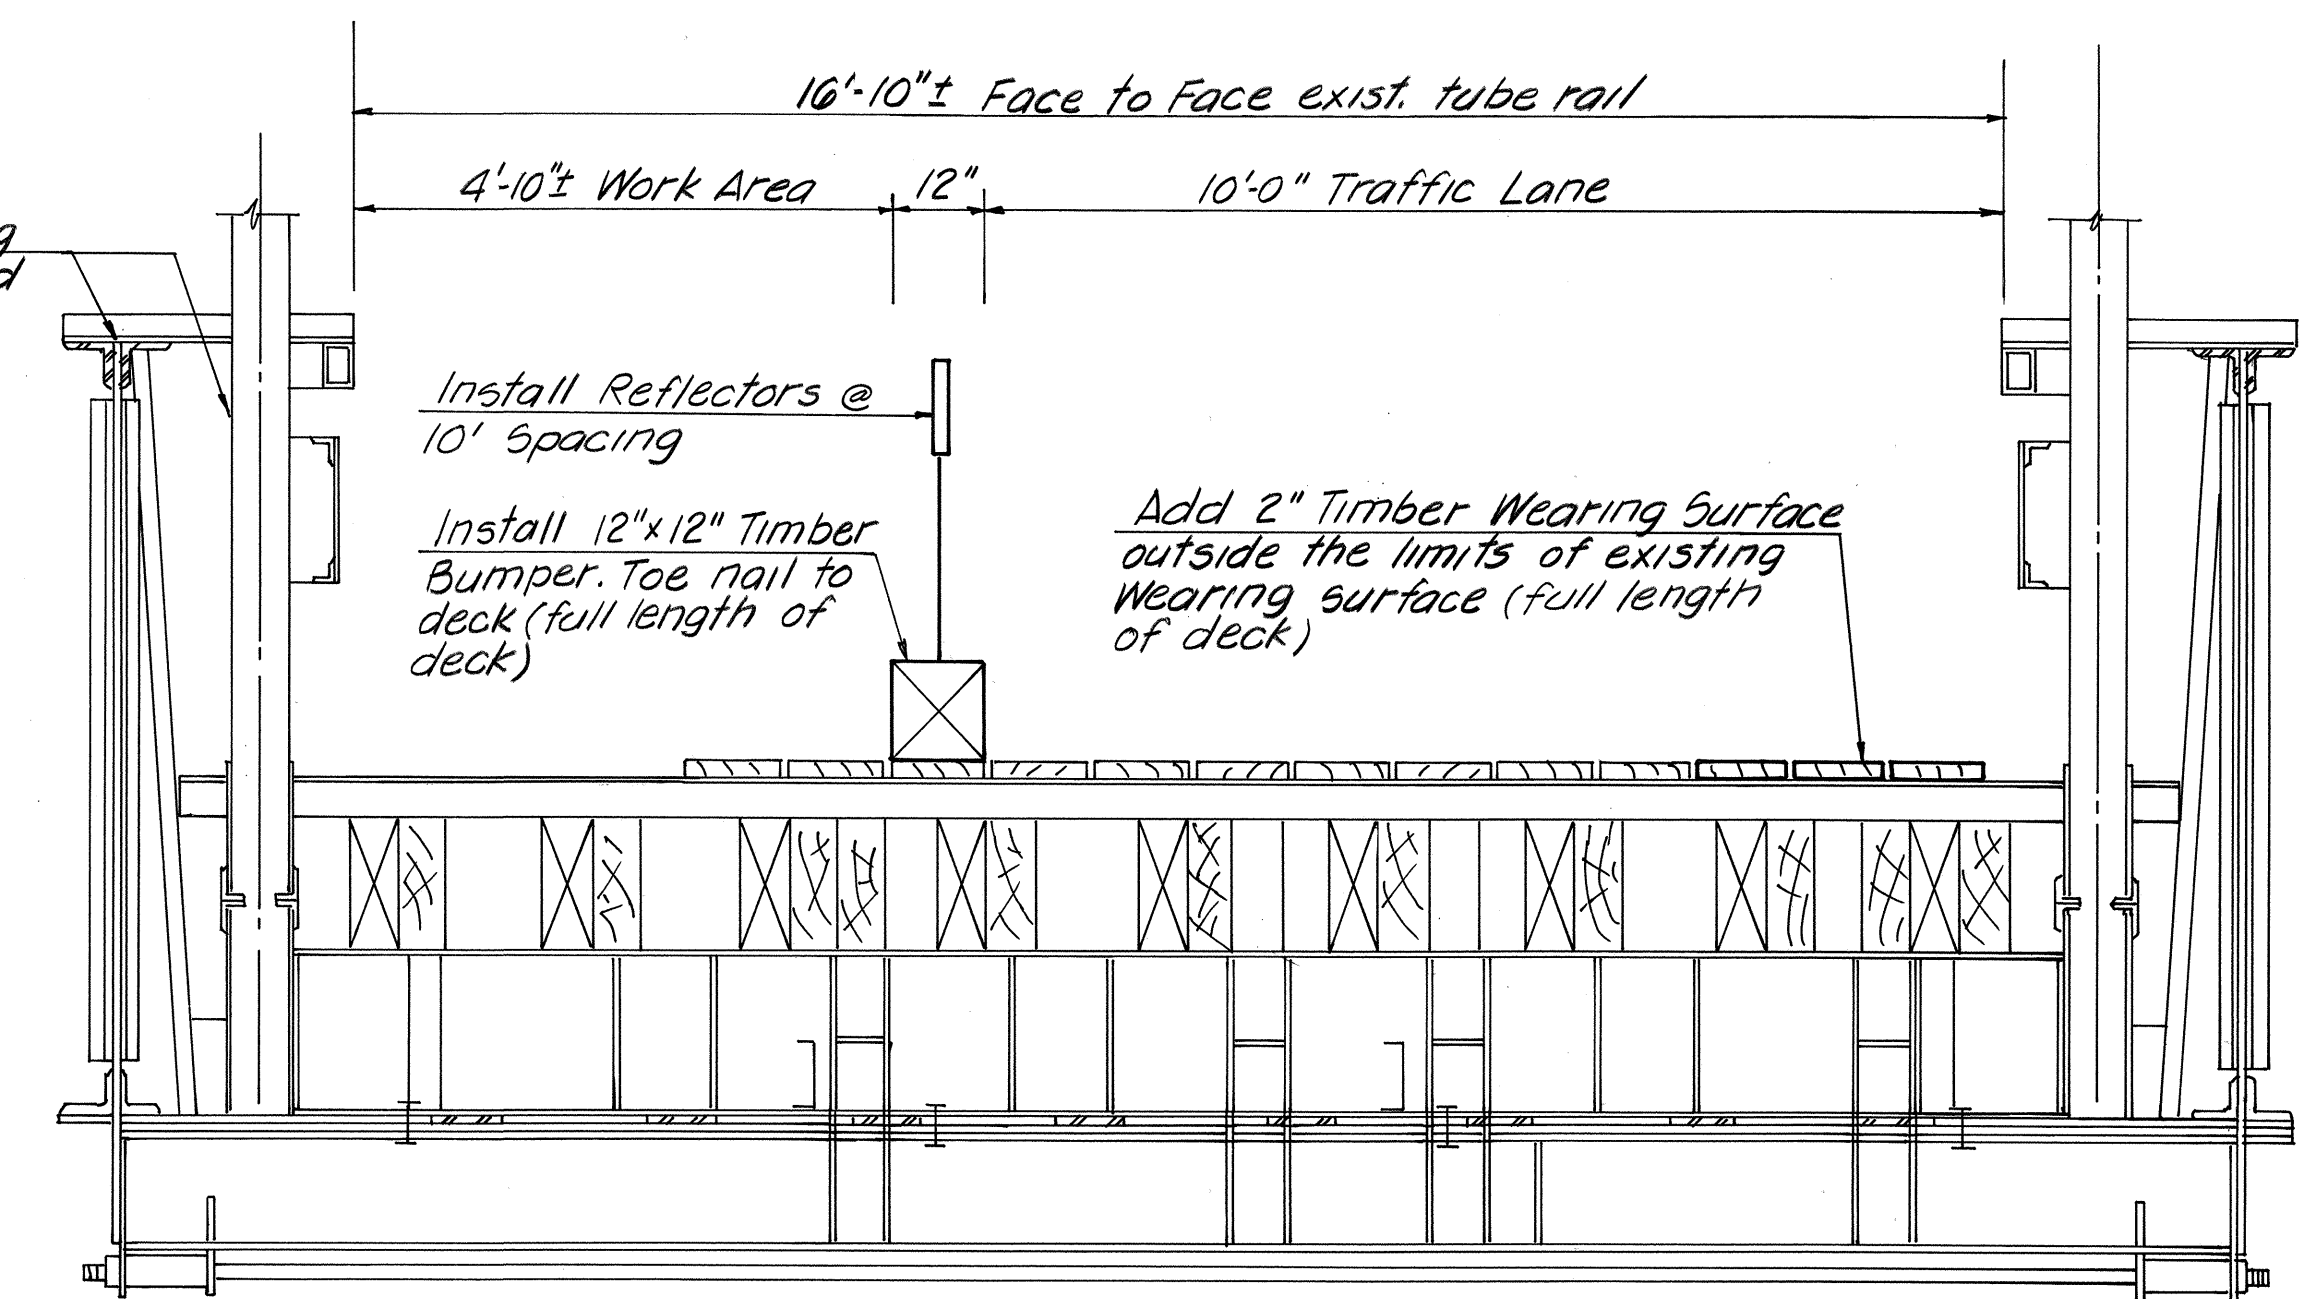


FED. ROAD DIST. NO.	STATE	PROJ. NO.	FISCAL YEAR	SHEET NO.	TOTAL SHEETS
HAWAII	HAW.	56D-01-87M	1988	4	9

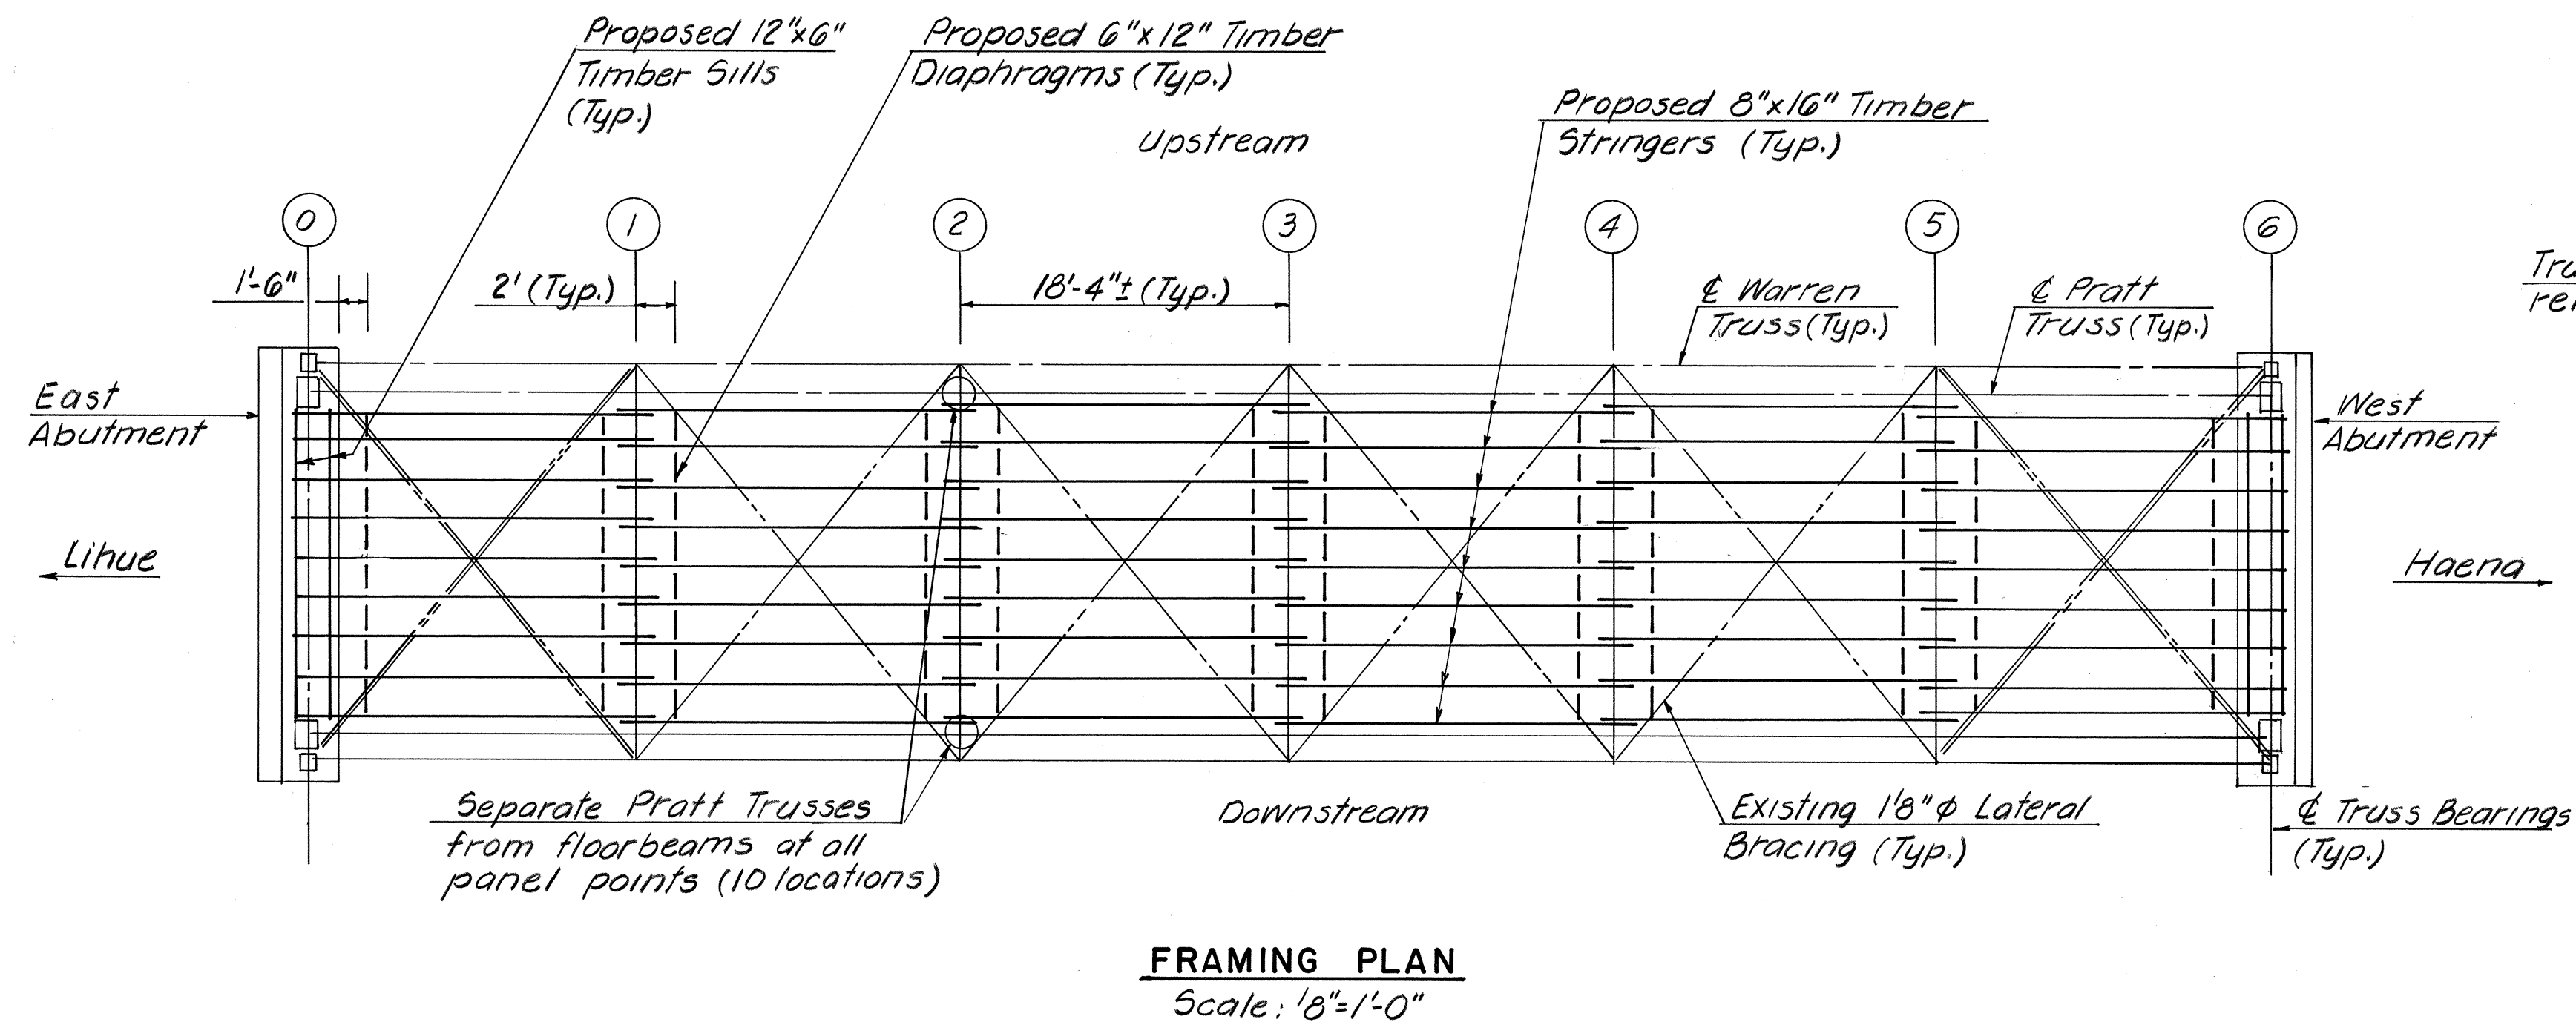

NOTES:

1. Night closure of the bridge will be permitted for the removal and replacement of the deck and stringers.
2. Intermittent closure of the bridge to traffic required during the tightening of the H.S. Bolts (Warren Trusses) and the adjustment of post tensioning rods.
3. See Special Provisions, sections 107 for traffic control requirements.

ORIGINAL PLAN	DATE
DRAWN BY	DESIGNED BY
NOTED BY	CHECKED BY
NO.	

THIS WORK WAS PREPARED BY
ME OR UNDER MY SUPERVISION

Abba G. Lichtenstein
ABBA G. LICHTENSTEIN, P.E.
HAWAII LICENSE NO. 6112

A.G. LICHTENSTEIN & ASSOC. INC.
CONSULTING ENGINEERS
FAIR LAWN, NEW JERSEY
HONOLULU, HAWAII

STATE OF HAWAII
DEPARTMENT OF TRANSPORTATION
HIGHWAYS DIVISION
KUHIO HIGHWAY

REHABILITATION OF THE HANALEI BRIDGE
FRAMING PLAN, TRAFFIC CONTROL
& RIPRAP PROTECTION

PROJECT NO. 56D-01-87M

SCALE: AS SHOWN

DATE: MAY, 1988

SHEET NO. 3 OF 8 SHEETS