
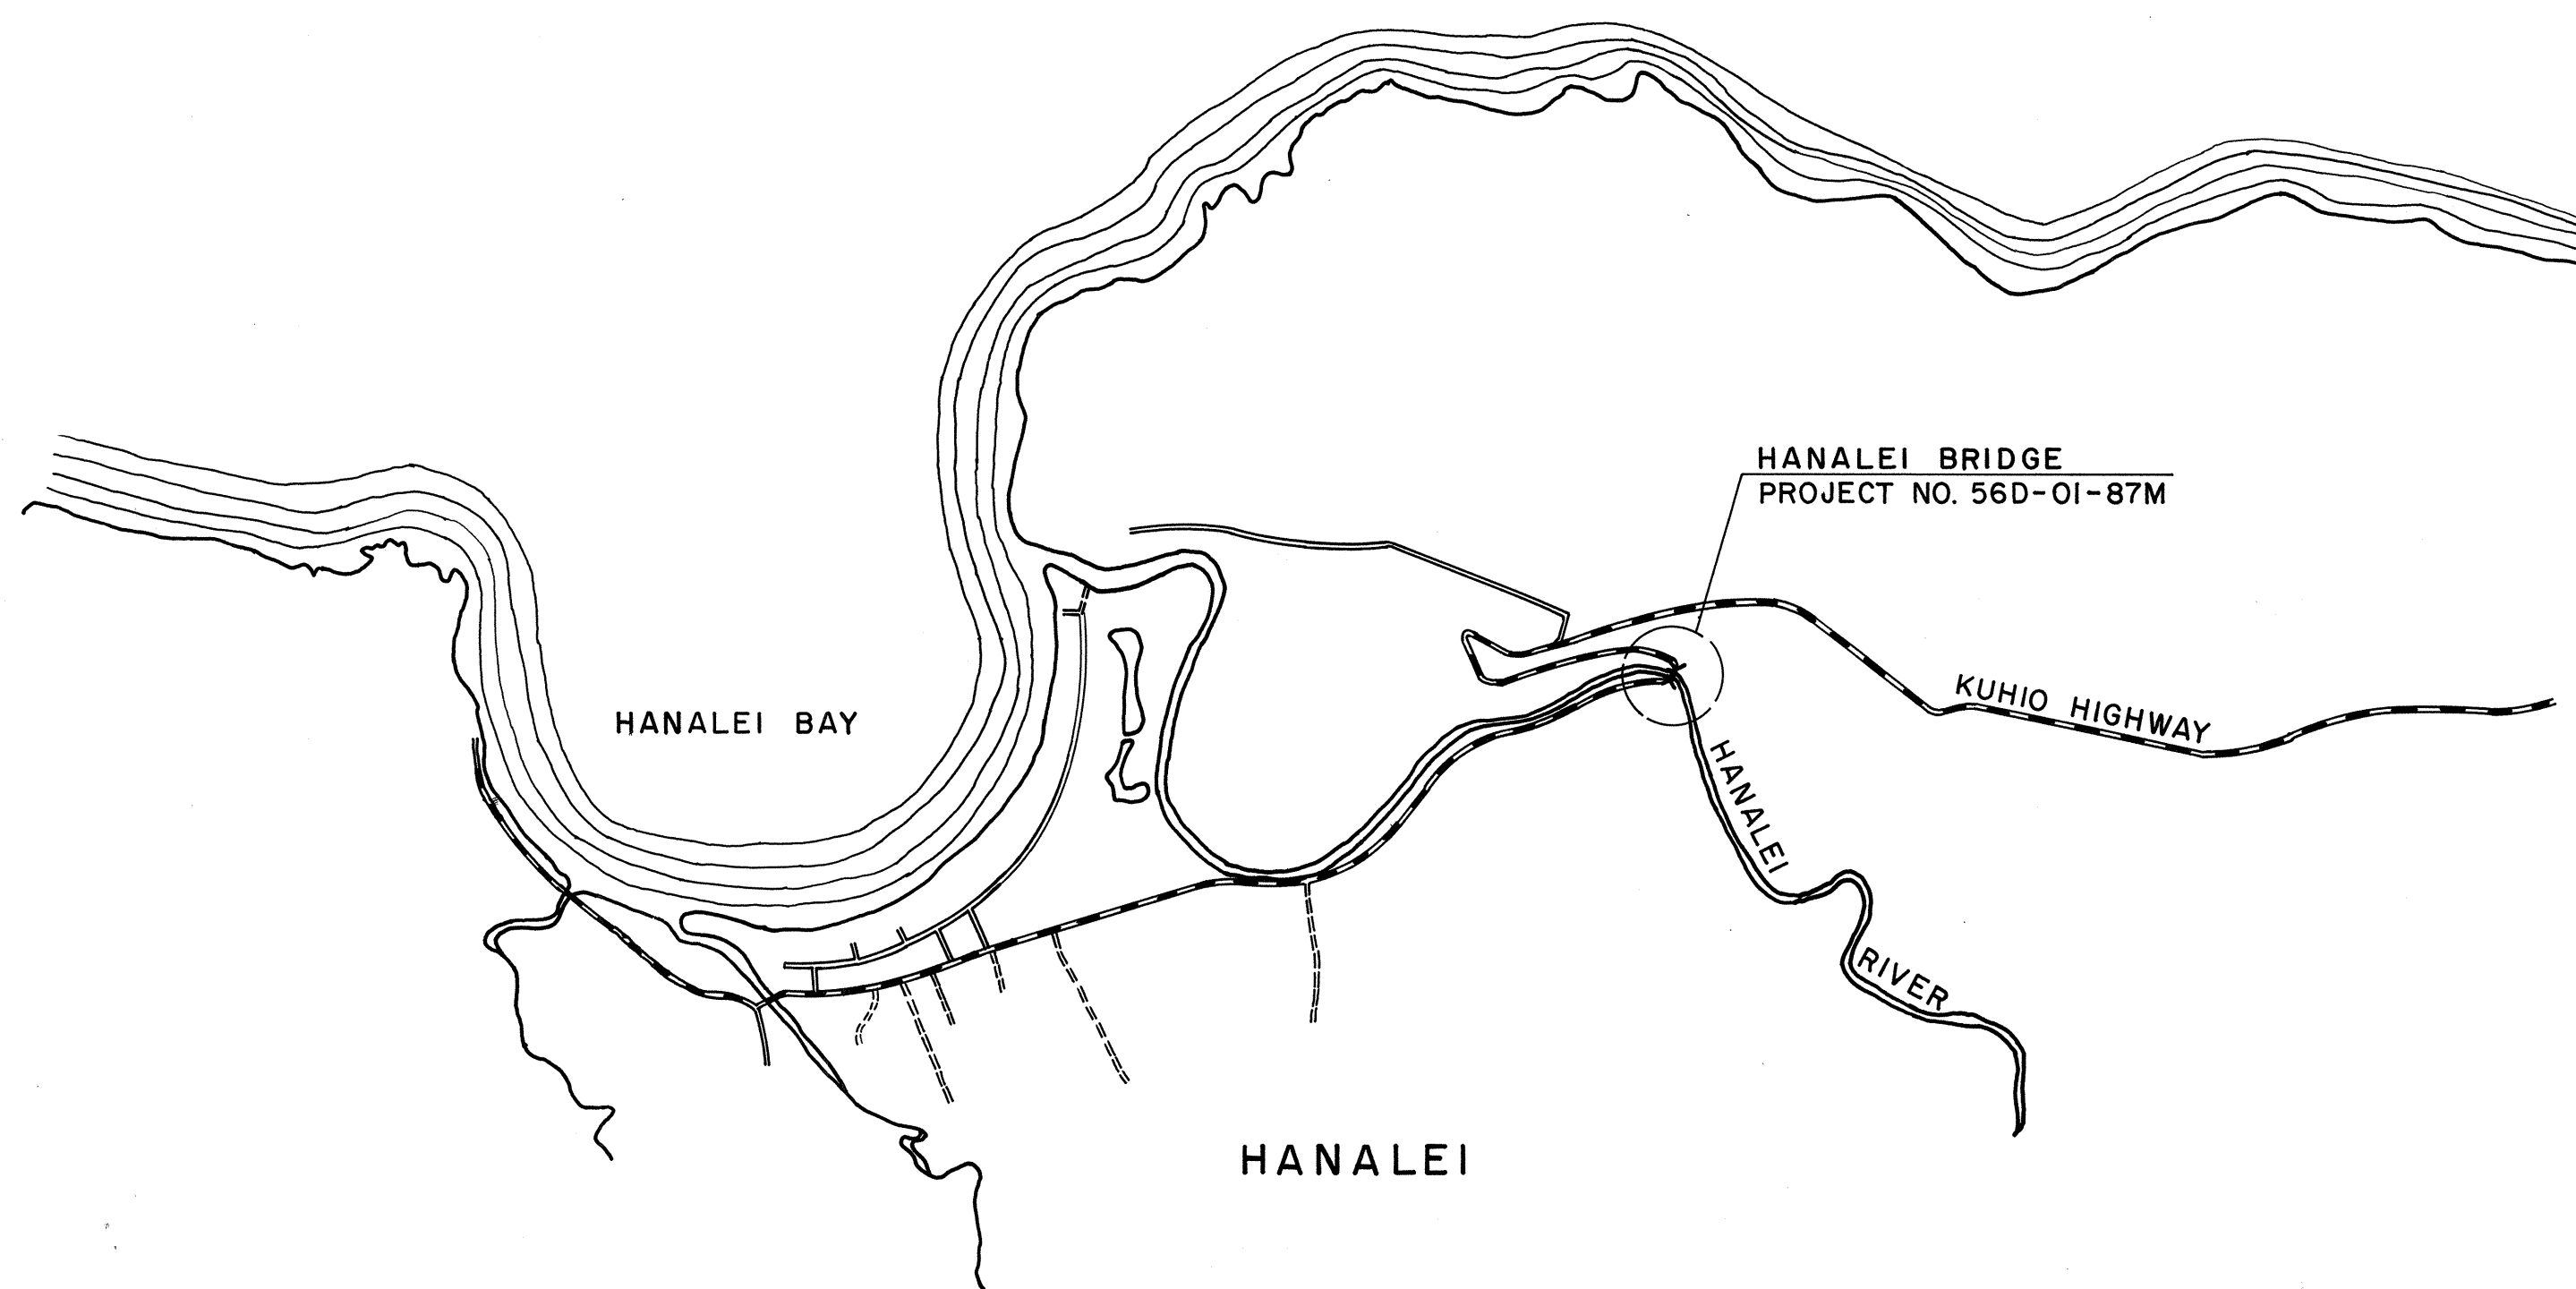


INDEX TO DRAWINGS	
SHEET NO.	DESCRIPTION
1	TITLE SHEET
2	LAYOUT PLAN, NOTES & ESTIMATE
3	TRUSS ELEVATION & SECTION
4	FRAMING PLAN, TRAFFIC CONTROL & RIPRAP PROTECTION
5	STRENGTHENING OF WARREN TRUSSES TOP CHORD
6	STRENGTHENING OF WARREN TRUSSES BOTTOM CHORD
7	ADJUSTMENTS TO PRATT TRUSSES
8	DECK PLAN, SECTION & DETAILS
9	SLOTTED DRAIN PIPE DETAILS

FED. ROAD DIST. NO.	STATE	PROJ. NO.	FISCAL YEAR	SHEET NO.	TOTAL SHEETS
HAWAII	HAW.	56D-01-87M	1988	1	9

STATE OF HAWAII
DEPARTMENT OF TRANSPORTATION
HIGHWAYS DIVISION
HONOLULU, HAWAII
"AS-BUILT"
PLANS FOR
KUHIO HIGHWAY
REHABILITATION OF THE HANAIEI BRIDGE
PROJECT NO. 56D-01-87M
DISTRICT OF HANAIEI
ISLAND OF KAUAI

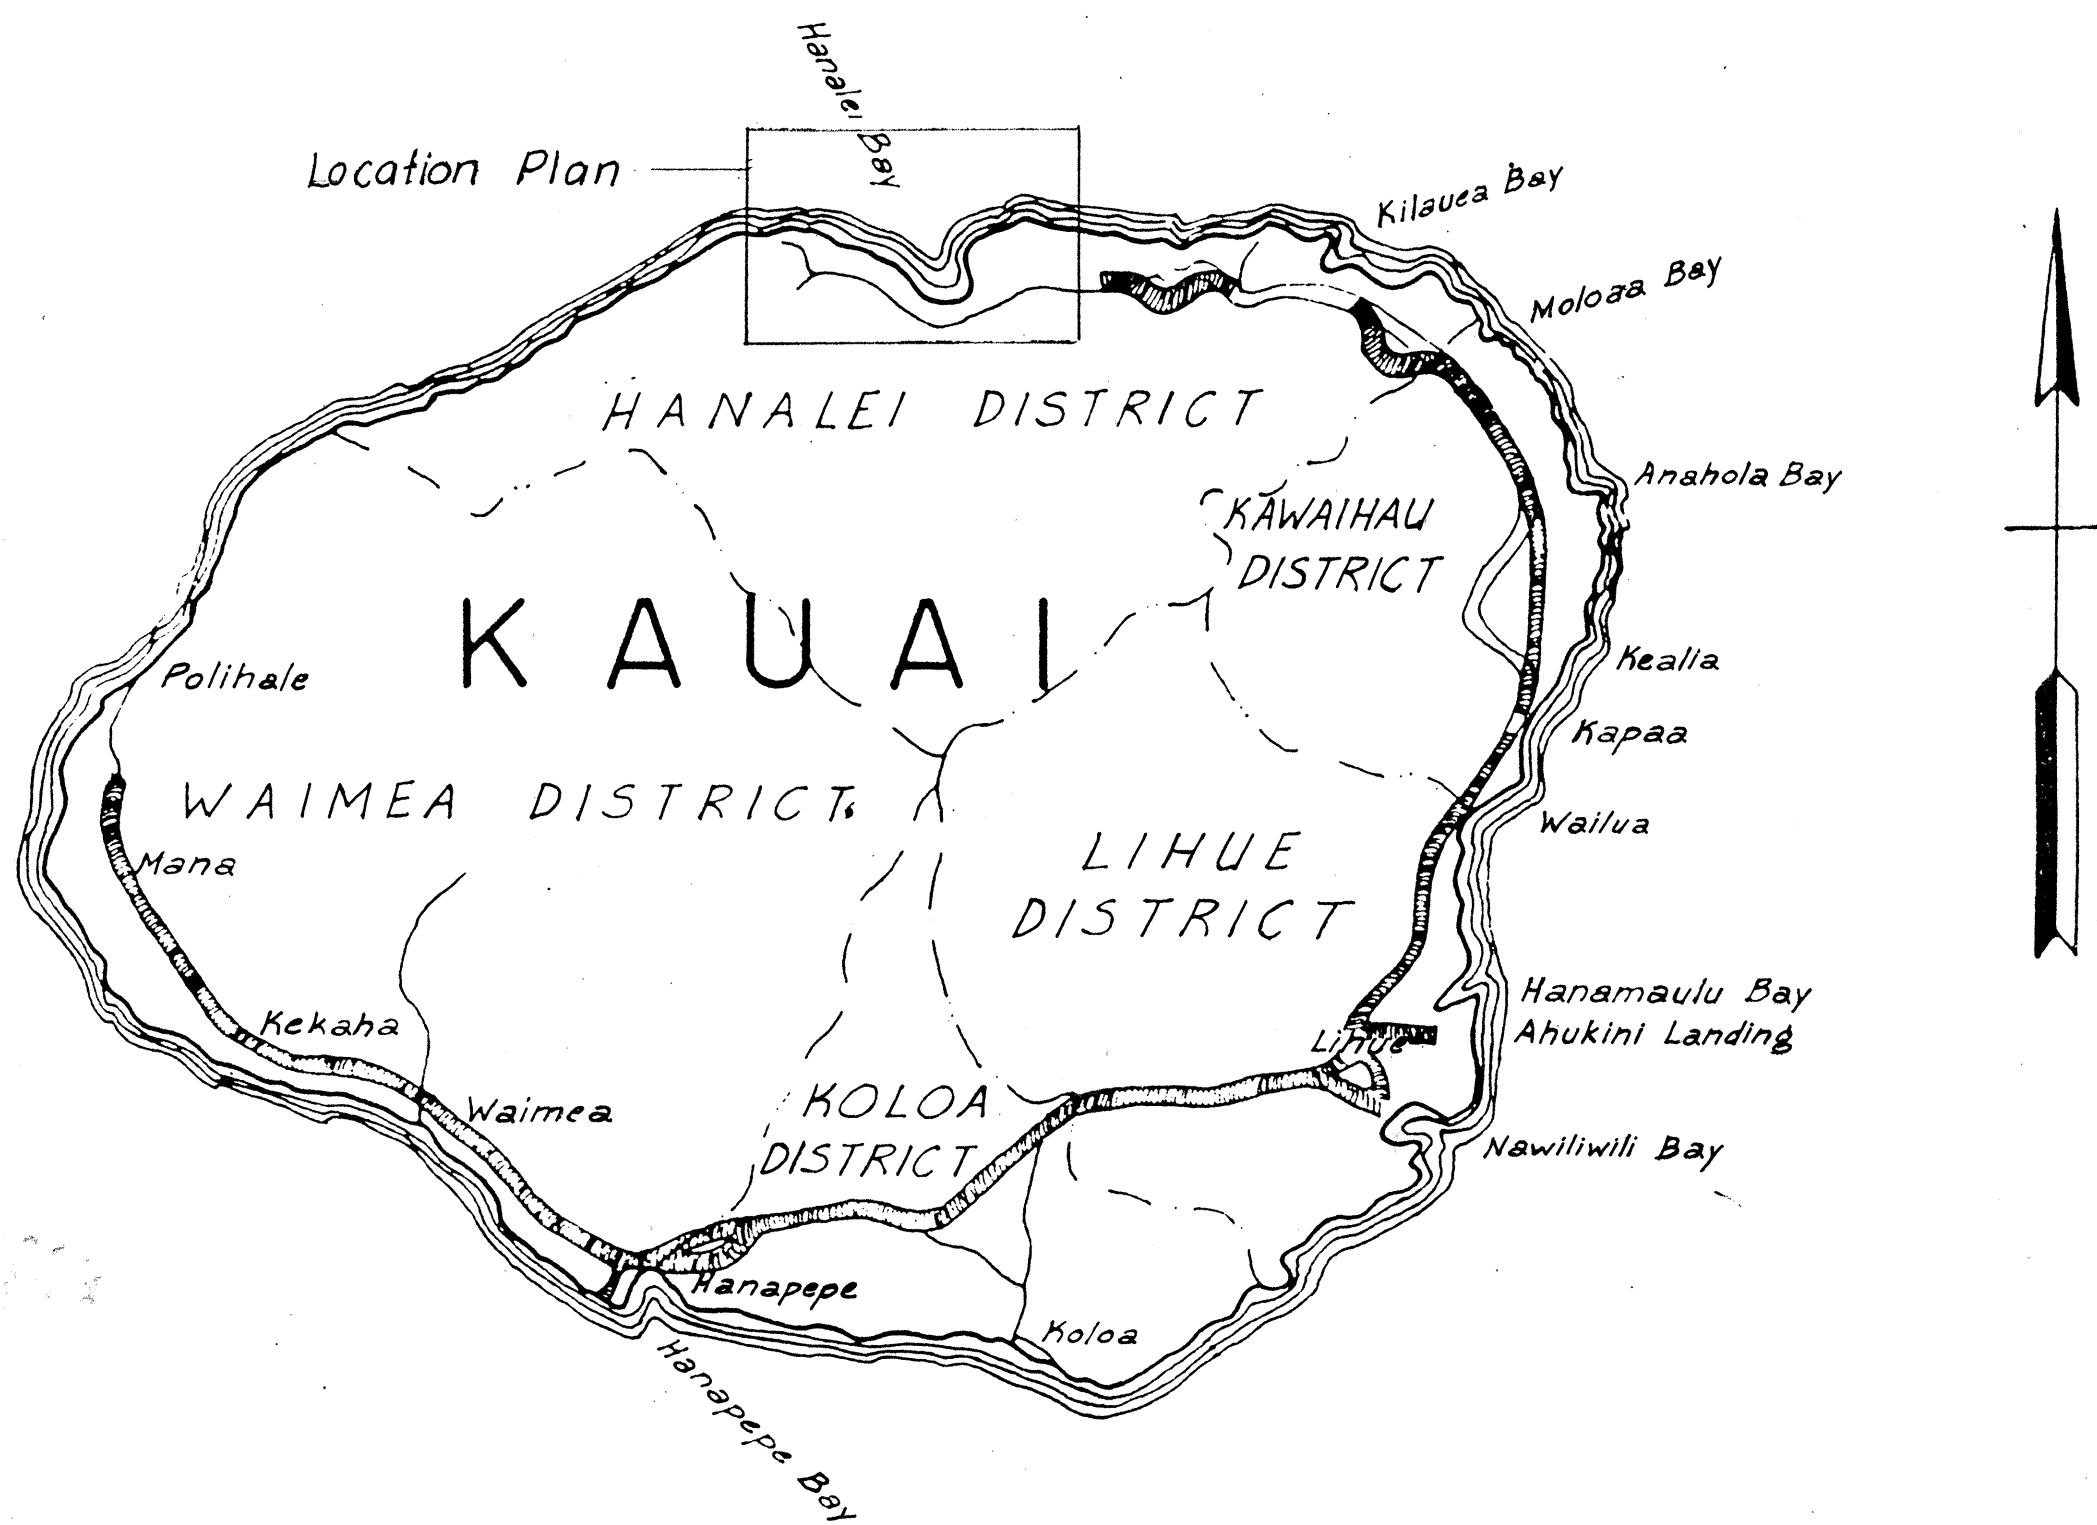

LOCATION PLAN

CHANGES MADE DURING CONSTRUCTION HAVE BEEN INCORPORATED ON THESE PLANS EXCEPT CHANGES IN THE ORIGINAL THEORETICAL QUANTITIES. FOR ACTUAL QUANTITIES, REFER TO PROJECT LEDGER AND/OR COMPUTATION BOOK.

Danyle H. Maeda 5/26/89
RESIDENT ENGINEER DATE

DEPARTMENT OF TRANSPORTATION STATE OF HAWAII	
APPROVED:	
<u>Edmund J. Pratt</u>	5/23/88
DIR. OF TRANSPORTATION	DATE

A.G. LICHTENSTEIN & ASSOC. DESIGNED BY
HERBERT TAO P. S. & E. BY
548-6932 PHONE
MAY 1988 DATE

20-A-5-5