	INDEX TO DRAWINGS
SHEET NO.	DESCRIPTION
l	TITLE SHEET
2	STANDARD PLAN SUMMARY
3	GENERAL & PAVEMENT MARKING
	NOTES, PLAN, SECTIONS, DE-
	TAILS & ESTIMATED QUANTITIES
	·
	ä

JULY,1989 DATE STATE OF HAWAII

DEPARTMENT OF TRANSPORTATION

HIGHWAYS DIVISION HONOLULU, HAWAII


"AS-BUILT"

PLANS FOR

KUHIO HIGHWAY RESURFACING

PRINCEVILLE TO HANALEI TOWN

PROJECT NO. 560A - 01-90M DISTRICT OF HANALEI ISLAND OF KAUAI

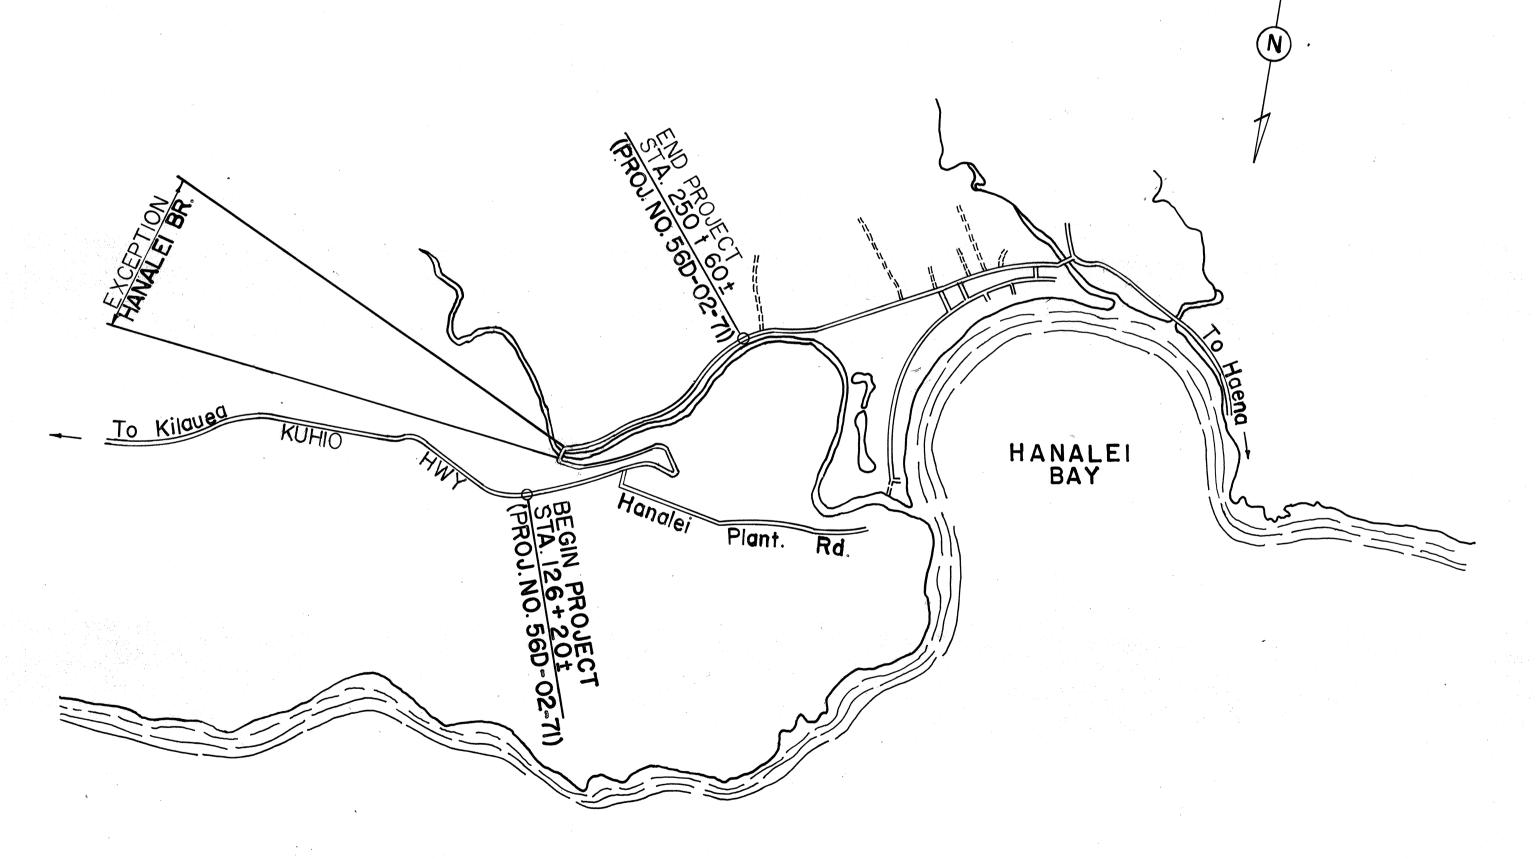


LENGTH OF PROJECT = 2.335 MILES

LAYOUT OF PROJECT


SCALE: | = 2000'

FED. ROAD DIST. NO. STATE PROJ. NO. FISCAL SHEET NO. SHEET NO. SHEET SHEET NO. SHEET N



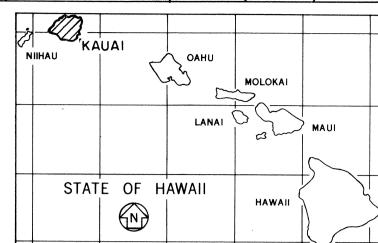

PROJECT LOCATION

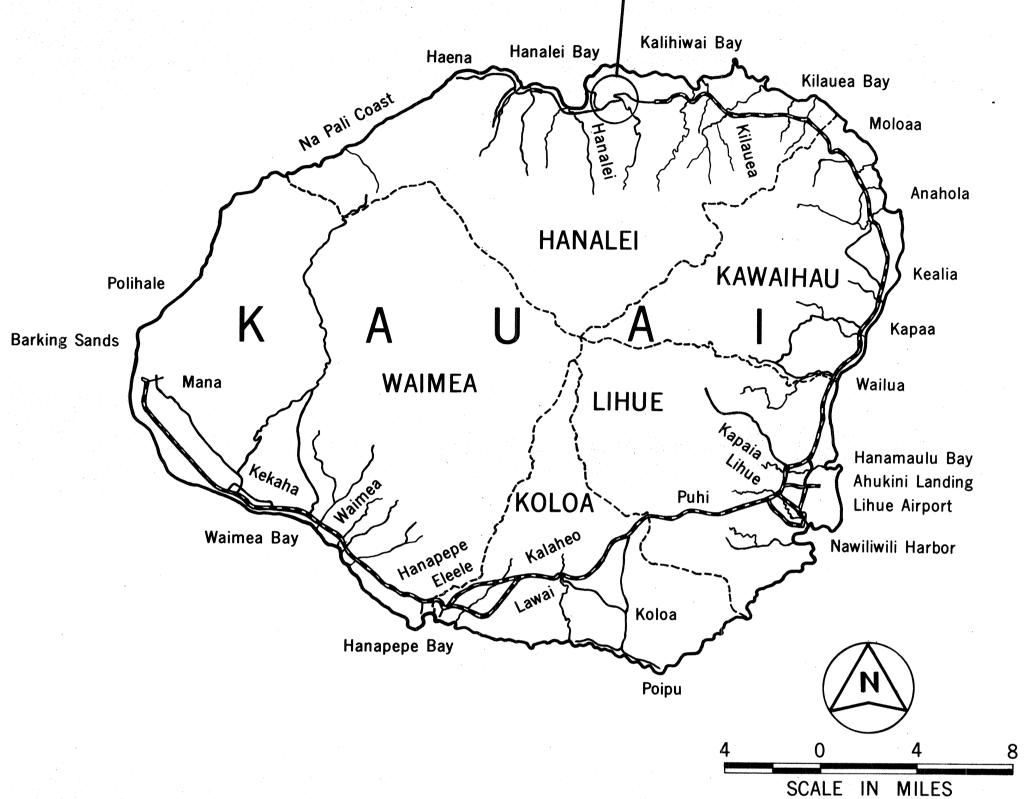

FEDERAL AID PROJECTS PREVIOUSLY CONSTRUCTED
OR UNDER CONSTRUCTION

MILE POST __O__ TO MILE POST _2.50_

CHANGES MADE DURING CONSTRUCTION HAVE BEEN INCORPORATED ON THESE PLANS EXCEPT CHANGES IN THE ORIGINAL THEORETICAL QUANTITIES. FOR ACTUAL QUANTITIES, REFER TO PROJECT LEDGER AND/OR COMPUTATION BOOK.

Danyl 4. Maeda RESIDENT, ENGINEER

6/27/90 DATE

DEPARTMENT OF TRANSPORTATION STATE OF HAWAII
APPROVED:

DIR. OF TRANSPORTATION

TE