	INDEX TO DRAWINGS	
SHEET NO.	DESCRIPTION	
1	TITLE SHEET	
2	STANDARD PLANS SUMMARY	
3 – 6	EXISTING WAINIHA BRIDGE NOS. 3A &	
	3B PLANS - FOR INFORMATION ONLY	
gebyd diadarh foldacoustralas ays glab autoc od and modella browner. Earlin oar all-haft ord		
And the second second and the put door a second contract of the construction of the second deliverage contract on the contract of the second contract of the sec		
per la contraction de la contr		
Makan kalan najakan ili di pama shikukan ata inkan ayas kapa dani pepakan masa, saki an kanan sa ka		
Marconson de Blacoder and a supplied a polyphila deby pilothyland pilothyland a supplied a sold on yes best better		
Addition to Allow the creat of Addition to Agency and the Internal to the Control of the Addition of the Control of t		

STATE OF HAWAII

## DEPARTMENT OF TRANSPORTATION

DIVISION **HIGHWAYS** HONOLULU, HAWAII PLANS FOR

## KUHIO HIGHWAY


CLEAN AND PAINT METAL MEMBERS WAINIHA BRIDGE NO. 3 PROJECT NO. 560A-01-93M

> DISTRICT OF HANALEI ISLAND OF KAUAI

## GENERAL NOTES:


- Project consists of cleaning by water blasting and painting of metal members of Wainiha Bridge Nos. 3A, 3B, and 3C.
- Plan Sheet Nos. 3 to 6 are for information purposes only. All dimensions of existing metal members to be cleaned and painted shall be verified in the field by the Contractor.


ESTIMATED QUANTITIES			
ITEM	PRIME COAT	FINISH COAT	
Cleaning by Water Blasting and Painting of Wainiha Bridge Nos. 3A, 3B and 3C.	120 Gal.	60 Gal.	

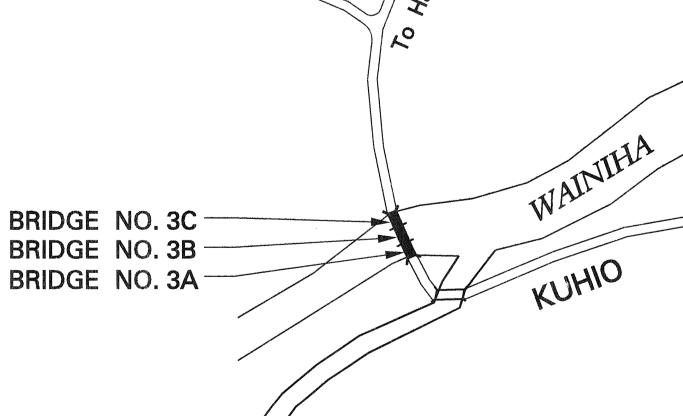

WAINIHA BAYRIVER **HIGHWAY** 

FISCAL SHEET YEAR NO. 560A-01-93M

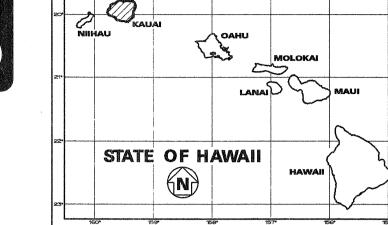

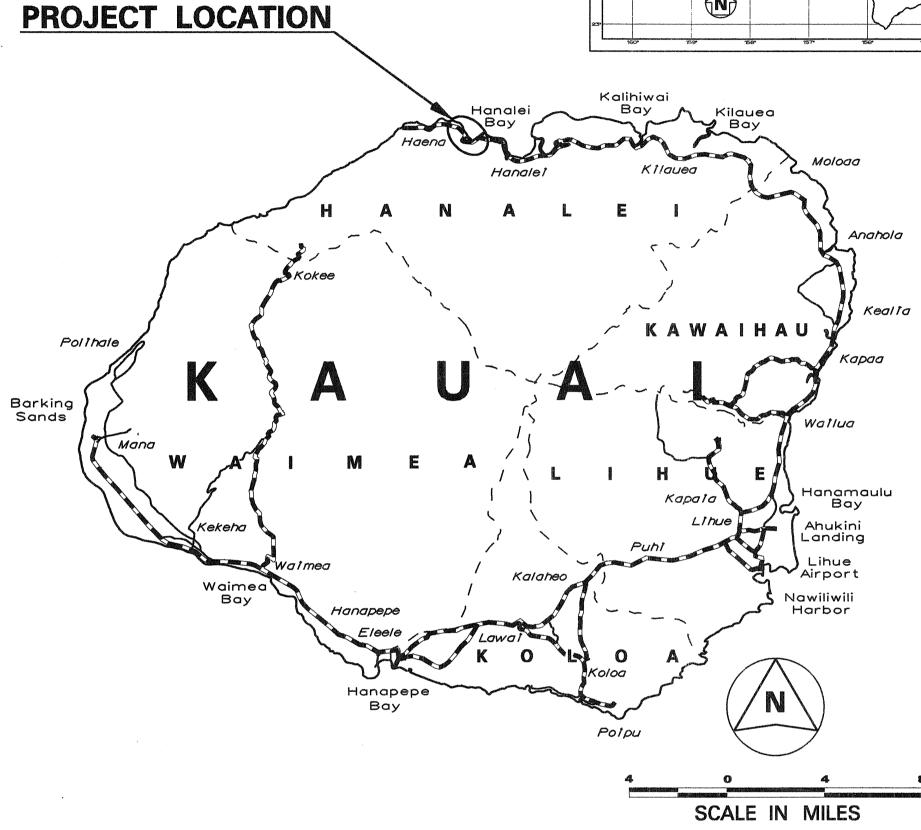

FED. ROAD DIST. NO.

FEDERAL AID PROJECTS PREVIOUSLY CONSTRUCTED OR UNDER CONSTRUCTION

MILE POST 6.73

RESIDENT ENGINEER


NOTE:

ALL CHANGES MADE DURING CONSTRUCTION HAVE BEEN NOTED IN RED ON THESE TRACINGS AND CHECKED BY:

Leaved Outris

7/17/96 DATE



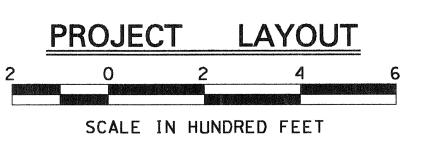

DEPARTMENT OF TRANSPORTATION STATE OF HAWAII APPROVED: A Harans 5/25/93 RDIR. OF TRANSPORTATION DATE