



FED. ROAD DIST. NO.	STATE	PROJ. NO.	FISCAL YEAR	SHEET NO.	TOTAL SHEETS
HAWAII	HAW.	560A-02-96M		14S-1	25

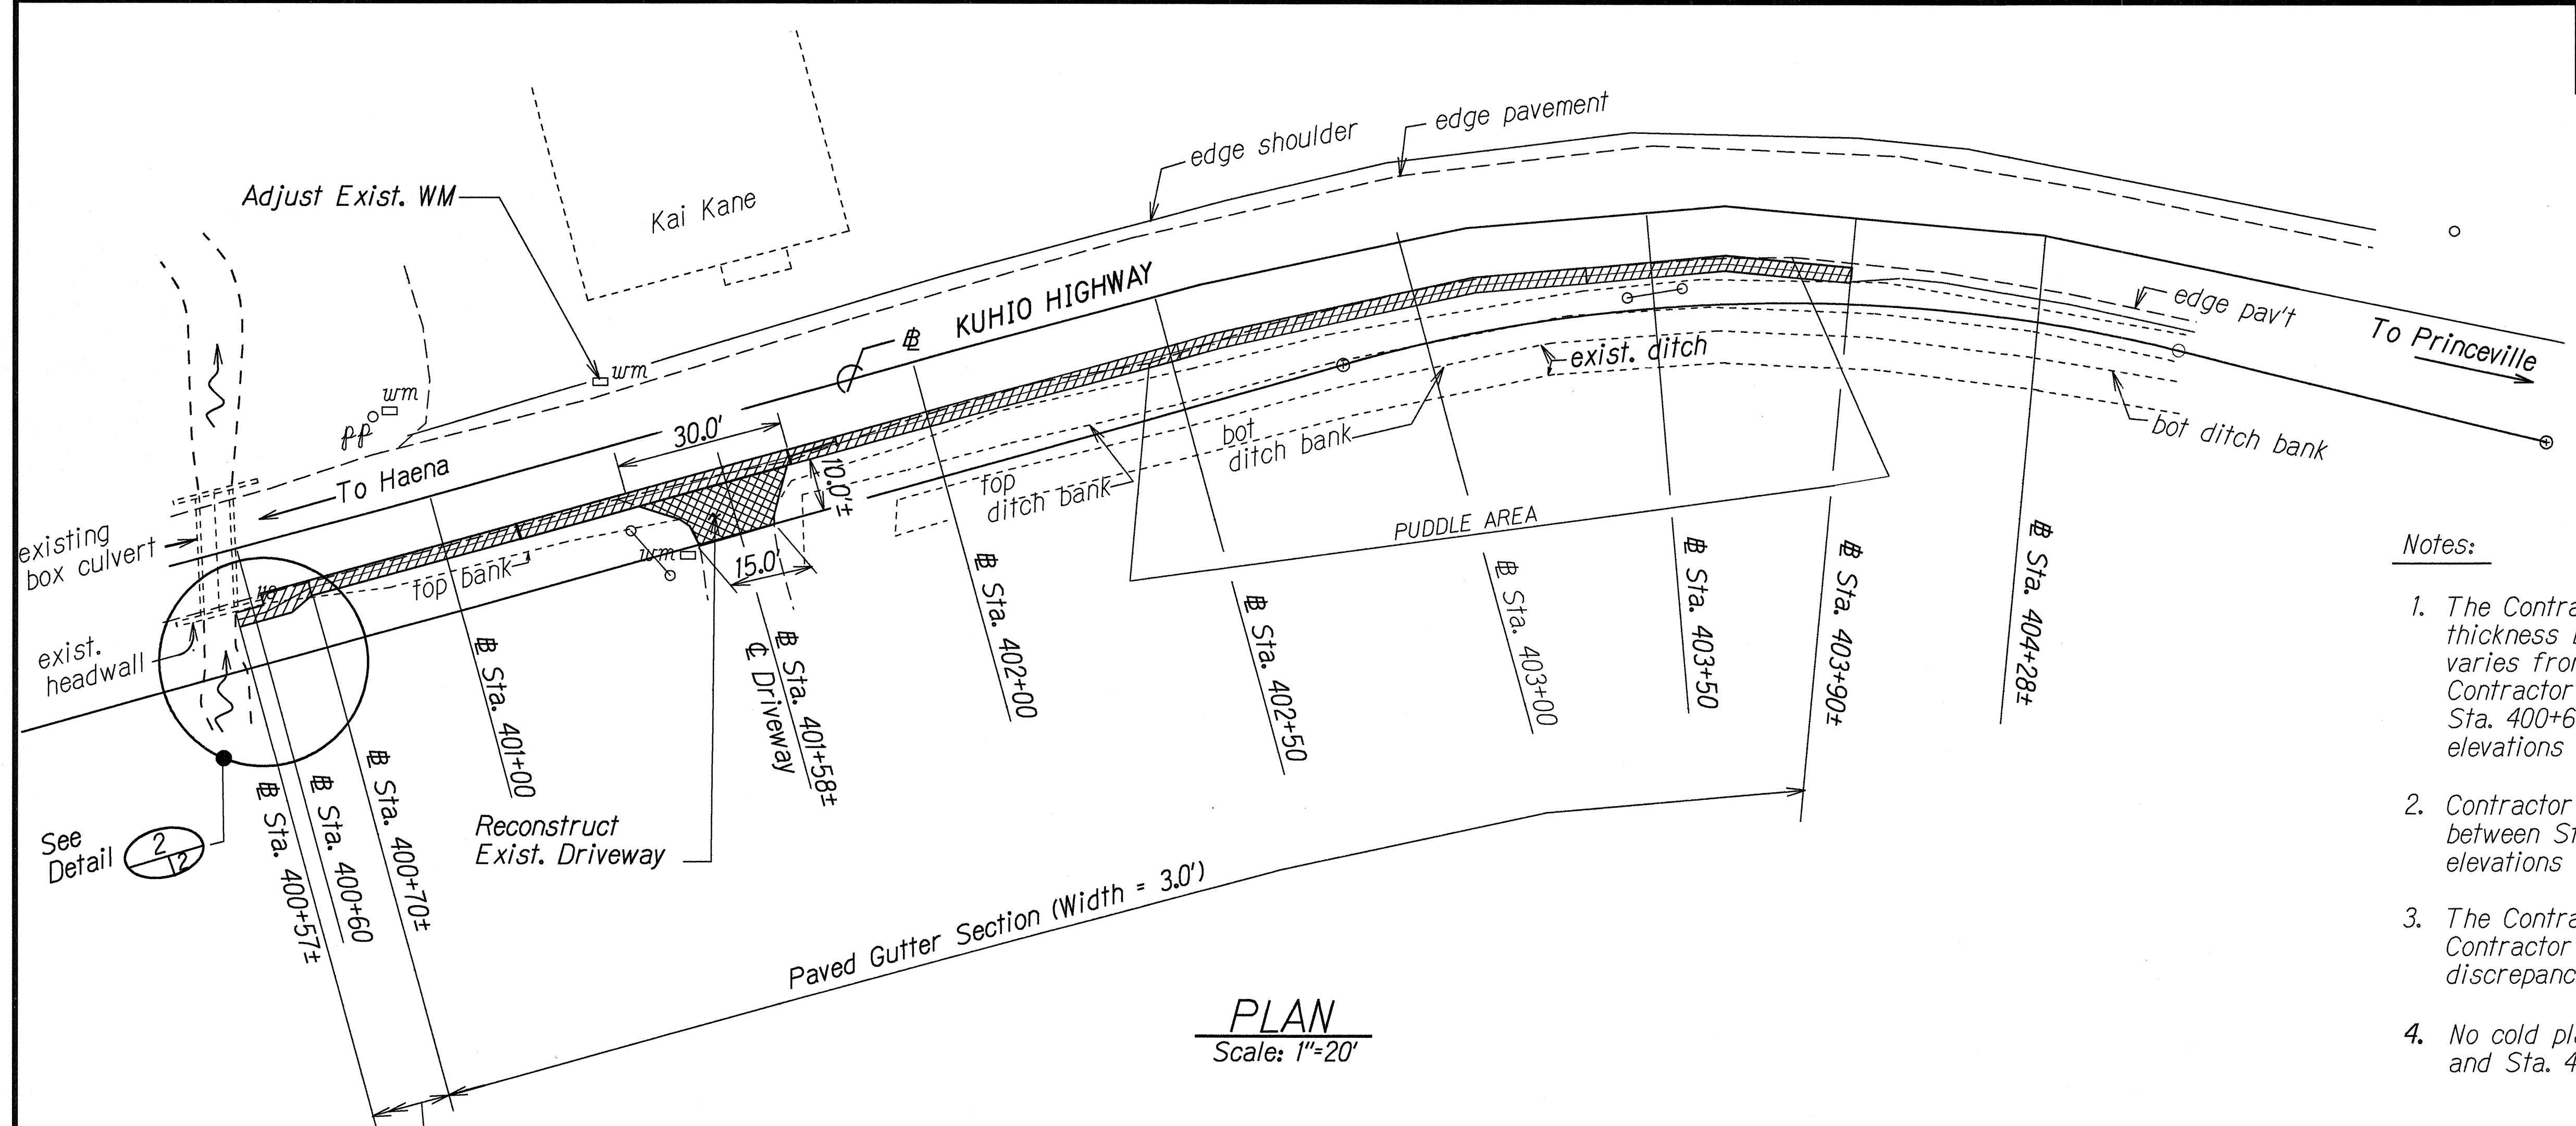

PLAN
Scale: 1"=20'

- Notes:
1. The Contractor is cautioned that the AC resurfacing thickness between Sta. 400+60 and Sta. 403+90± varies from 2" at Sta. 400+60 to 4 1/4" at Sta. 403+90±. Contractor shall control finished grade between Sta. 400+60 and Sta. 403+90 by using finished grade elevations shown on the profile.
 2. Contractor shall control concrete gutter slope between Sta. 400+60 and Sta. 403+90 by using gutter elevations shown on the profile.
 3. The Contractor shall verify all elevations in the field. Contractor shall notify the Engineer of any discrepancies in elevations and/or stationing.
 4. No cold planing required between Sta. 400+60 and Sta. 403+90±.

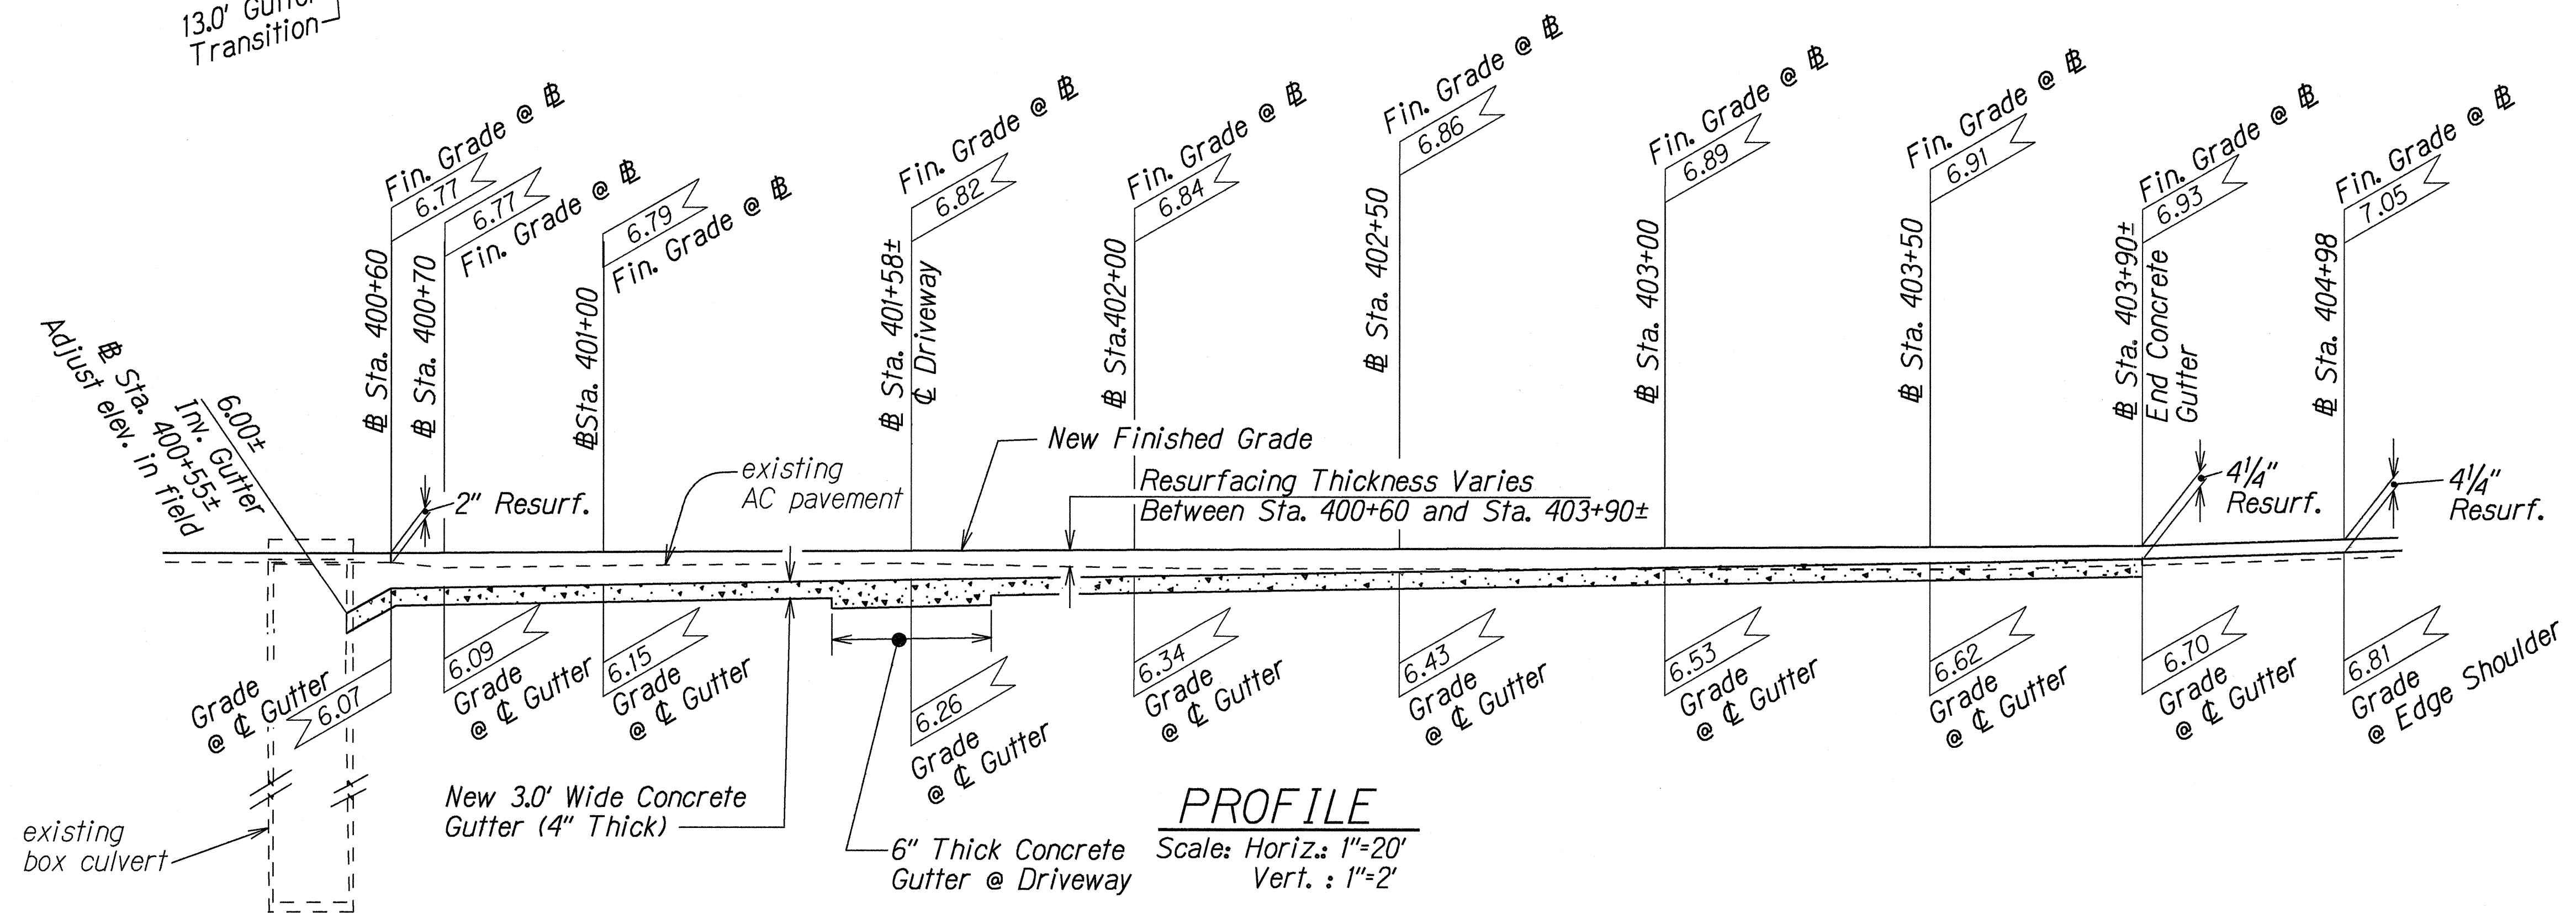

PROFILE
Scale: Horiz.: 1"=20'
Vert. : 1"=2'

Estimated Quantities

Roadway Excavation	25 C.Y.
Aggregate Base	15 C.Y.
Concrete Gutter	335 L.F.
Adjust Ex. Water Meter	1 Ea.

NOTE: THIS TRACING PREPARED DURING "AS-BUILT" POSTING

STATE OF HAWAII
DEPARTMENT OF TRANSPORTATION
HIGHWAYS DIVISION


ROADWAY PLAN
CONCRETE GUTTER
CONSTRUCTION
KUHIO HIGHWAY RESURFACING
Hanalei Town to Princeville
Project No. 560A-02-96M
Scale: As Shown Date: Sept., 1996

SHEET No. 1 OF 2 SHEETS

ORIGINAL PLAN	DATE
DESIGNED BY	
CHECKED BY	
NOTE BOOK	
NO.	


"AS-BUILT"

FED. ROAD DIST. NO.	STATE	PROJ. NO.	FISCAL YEAR	SHEET NO.	TOTAL SHEETS
HAWAII	HAW.	560A-02-96M		14S-2	25

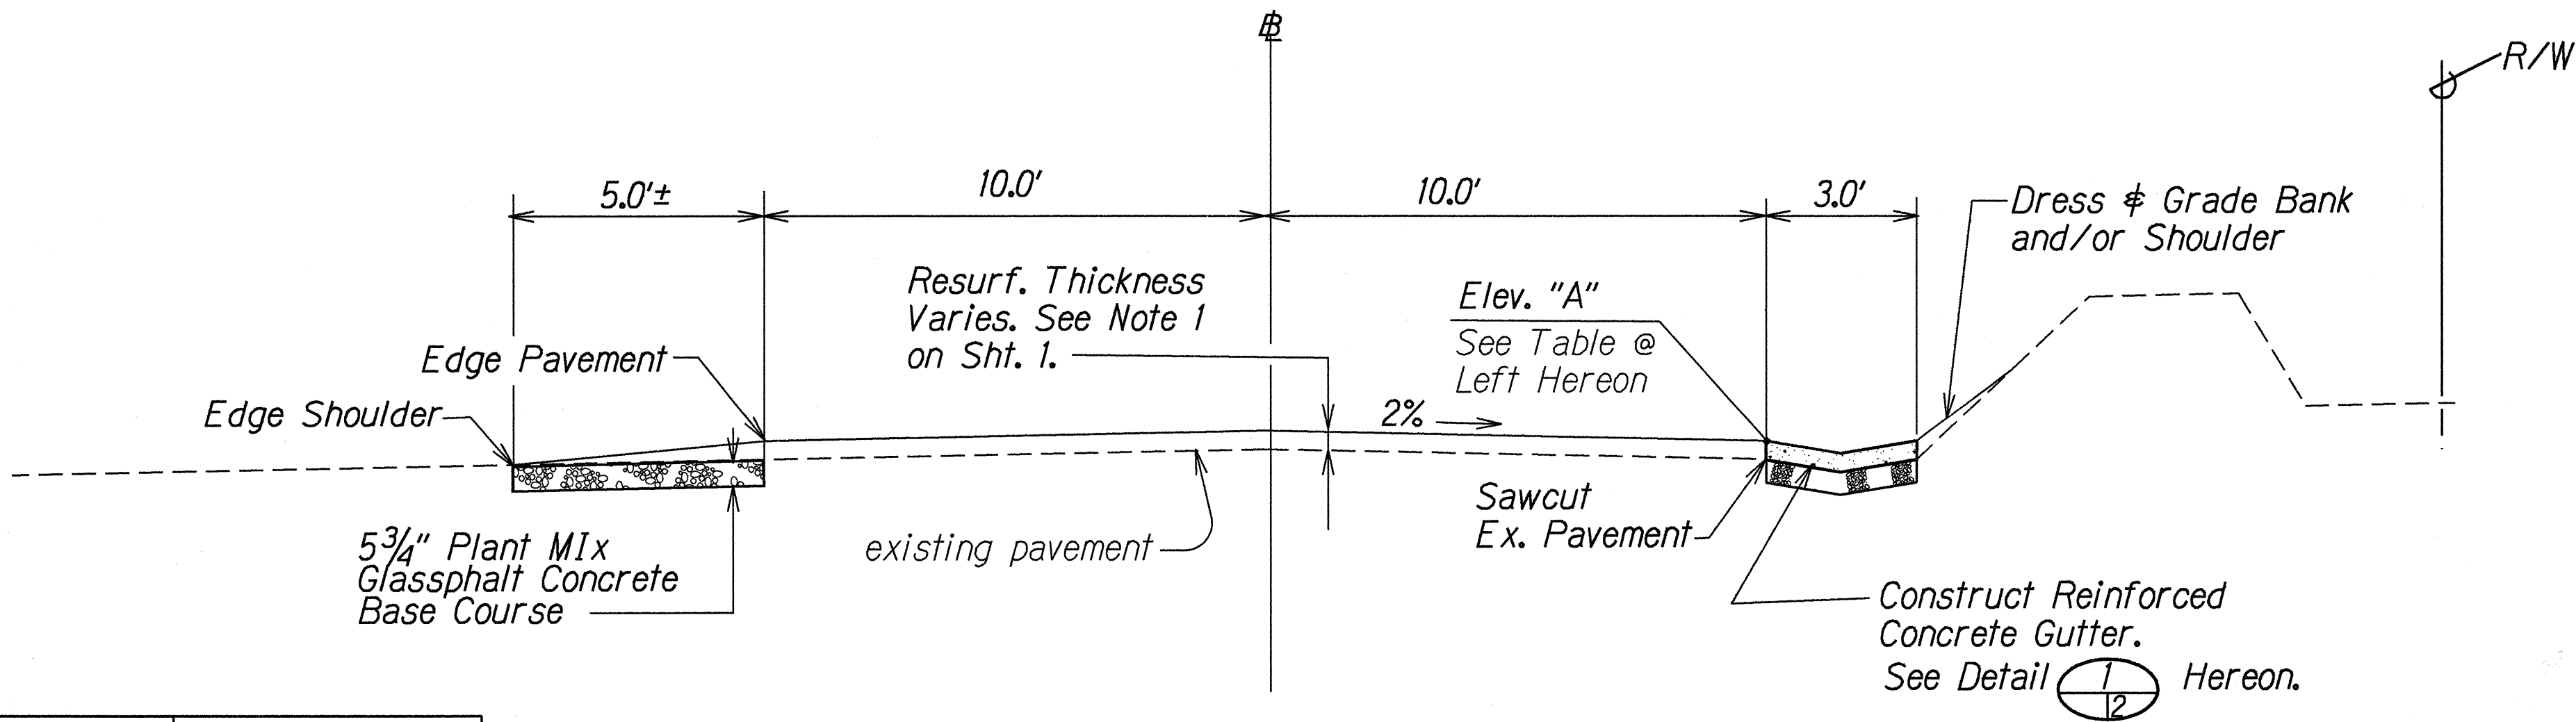


# Sta.	Elev. "A" (@ Edge Gutter)
400+60	6.57
400+70	6.57
401+00	6.59
401+58± @ Driveway	6.62
402+00	6.64
402+50	6.66
403+00	6.69
403+50	6.71
403+98± End Gutter	6.73


TYPICAL SECTION
Sta. 400+60 to Sta. 403+90±
(With Exception @ Driveway)
Scale: 3/8" = 1'-0"

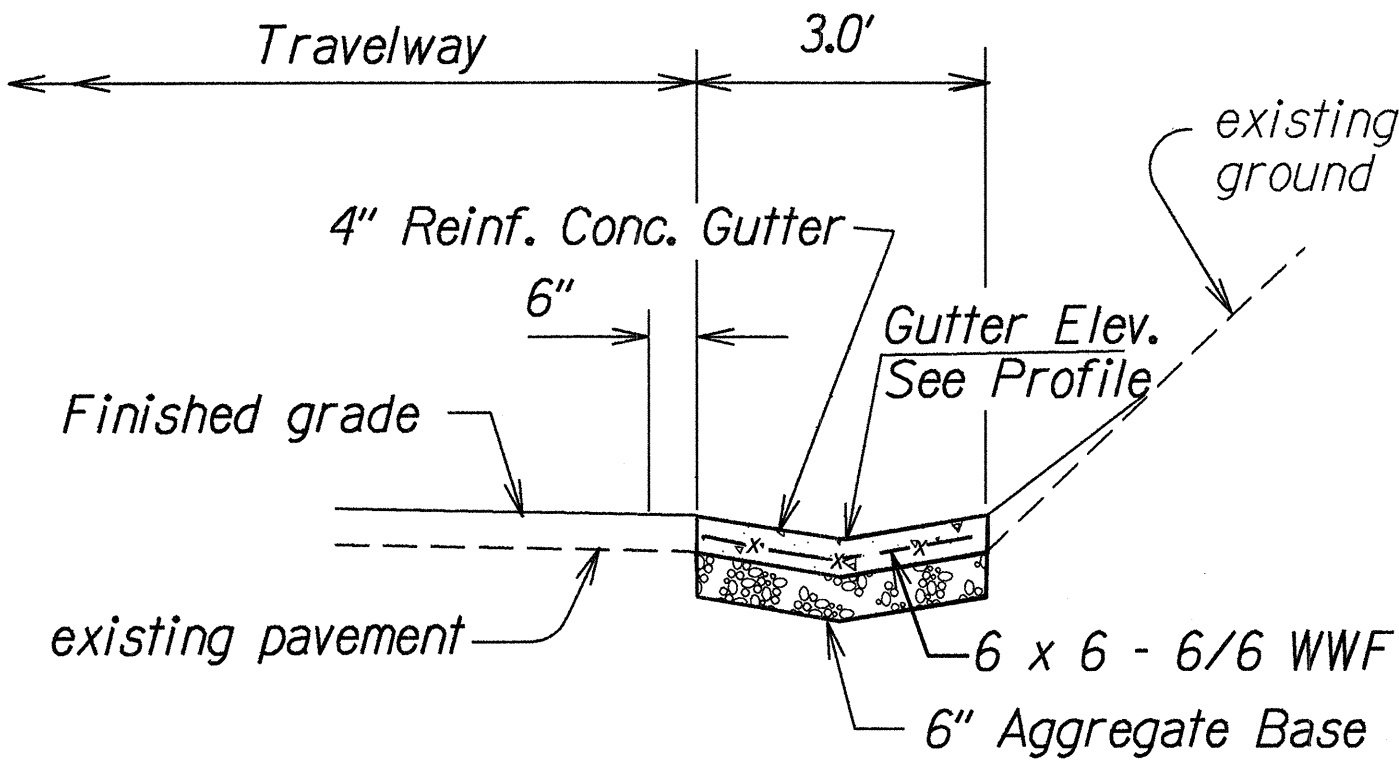

DETAIL 1
Scale: 1/2" = 1'-0"

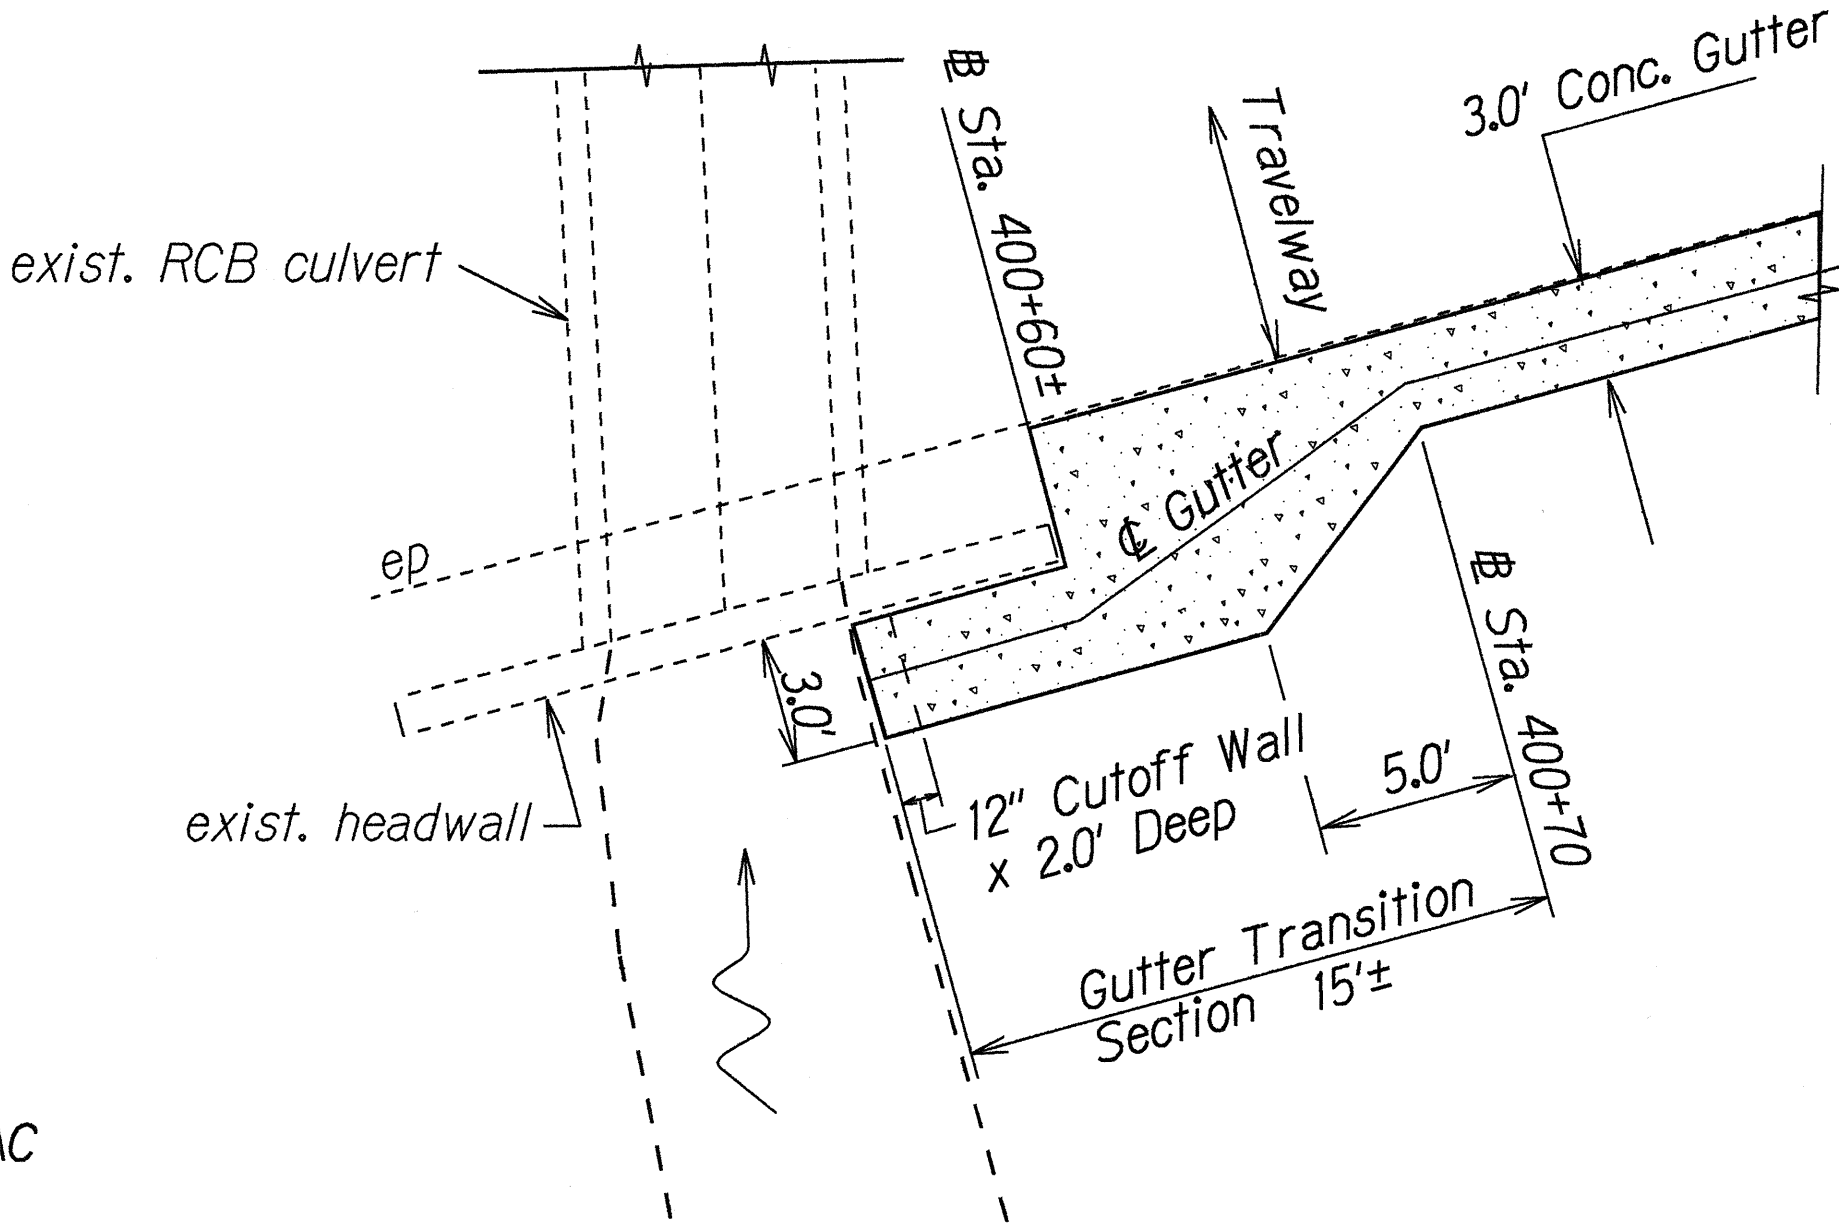

DETAIL 2
Scale: 1" = 5'

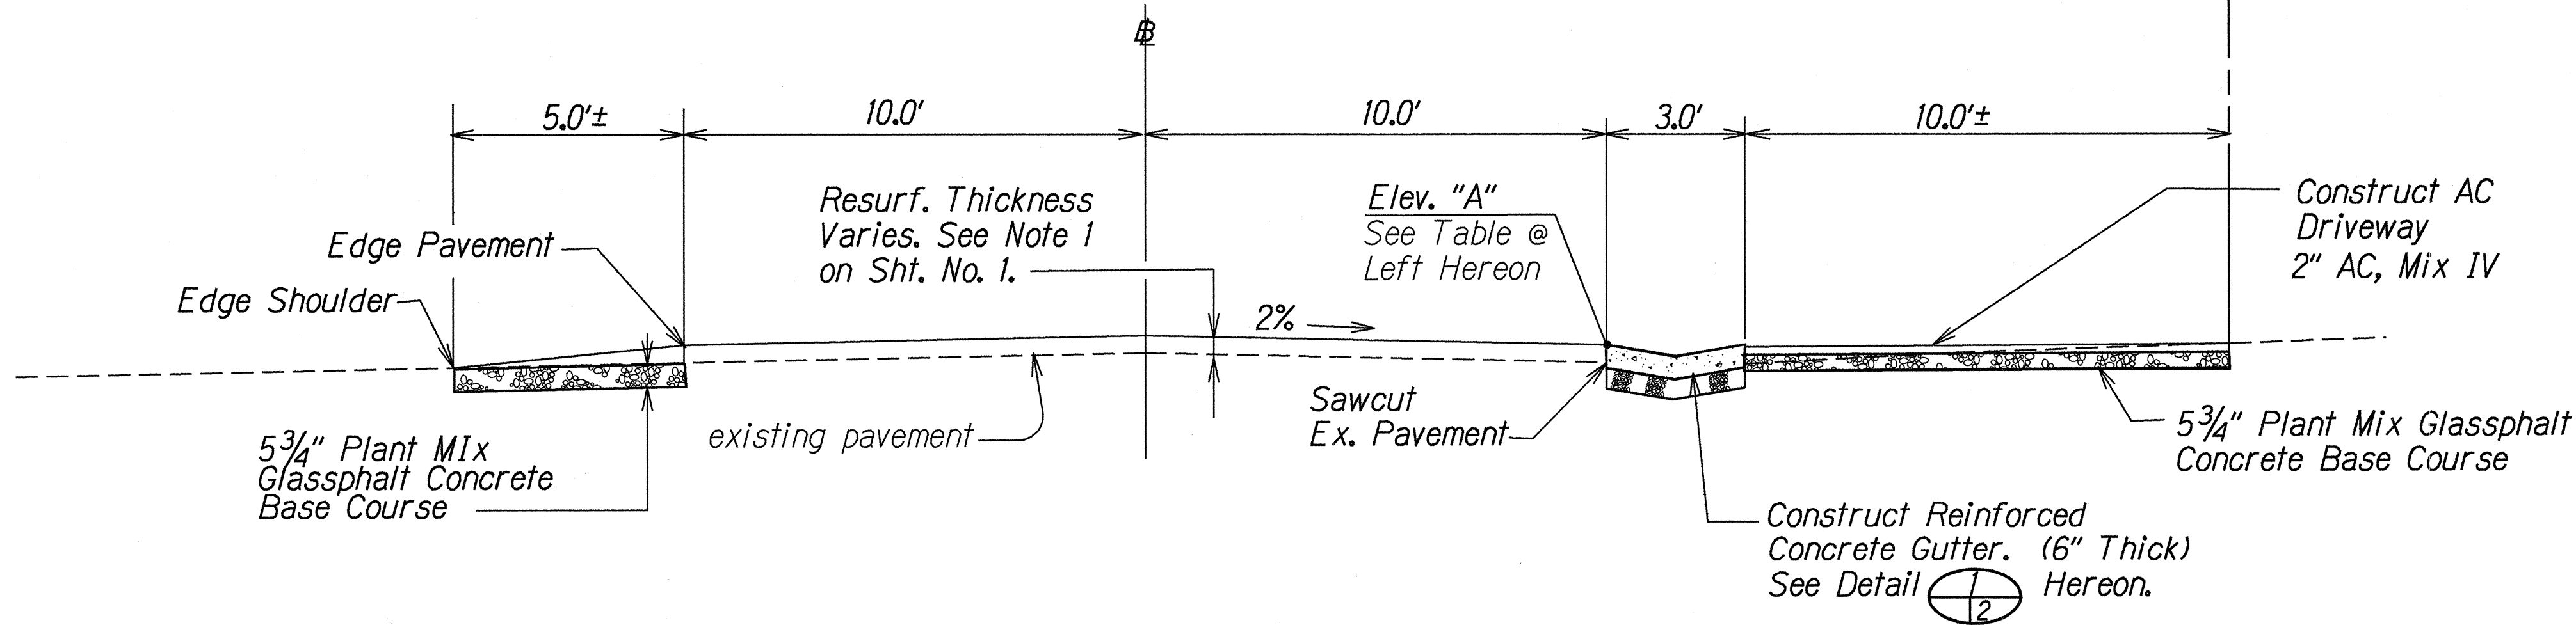

TYPICAL SECTION @ DRIVEWAY
Scale: 3/8" = 1'-0"

NOTE: THIS TRACING PREPARED DURING "AS-BUILT" POSTING

STATE OF HAWAII
DEPARTMENT OF TRANSPORTATION
HIGHWAYS DIVISION

ROADWAY PLAN
CONCRETE GUTTER
CONSTRUCTION
KUHIO HIGHWAY RESURFACING
Hanalei Town to Princeville
Project No. 560A-02-96M
Scale: As Shown Date: Sept., 1996

SURVEY PLOTTED BY	DATE
DRAWN BY	
TRACED BY	
CHECKED BY	
NOTED BY	
ORIGINAL PLAN	
NO. 1	