


FED. ROAD DIST. NO.	STATE	PROJ. NO.	FISCAL YEAR	SHEET NO.	TOTAL SHEETS
HAWAII	HAW.	560A-02-96M	1996	16	25

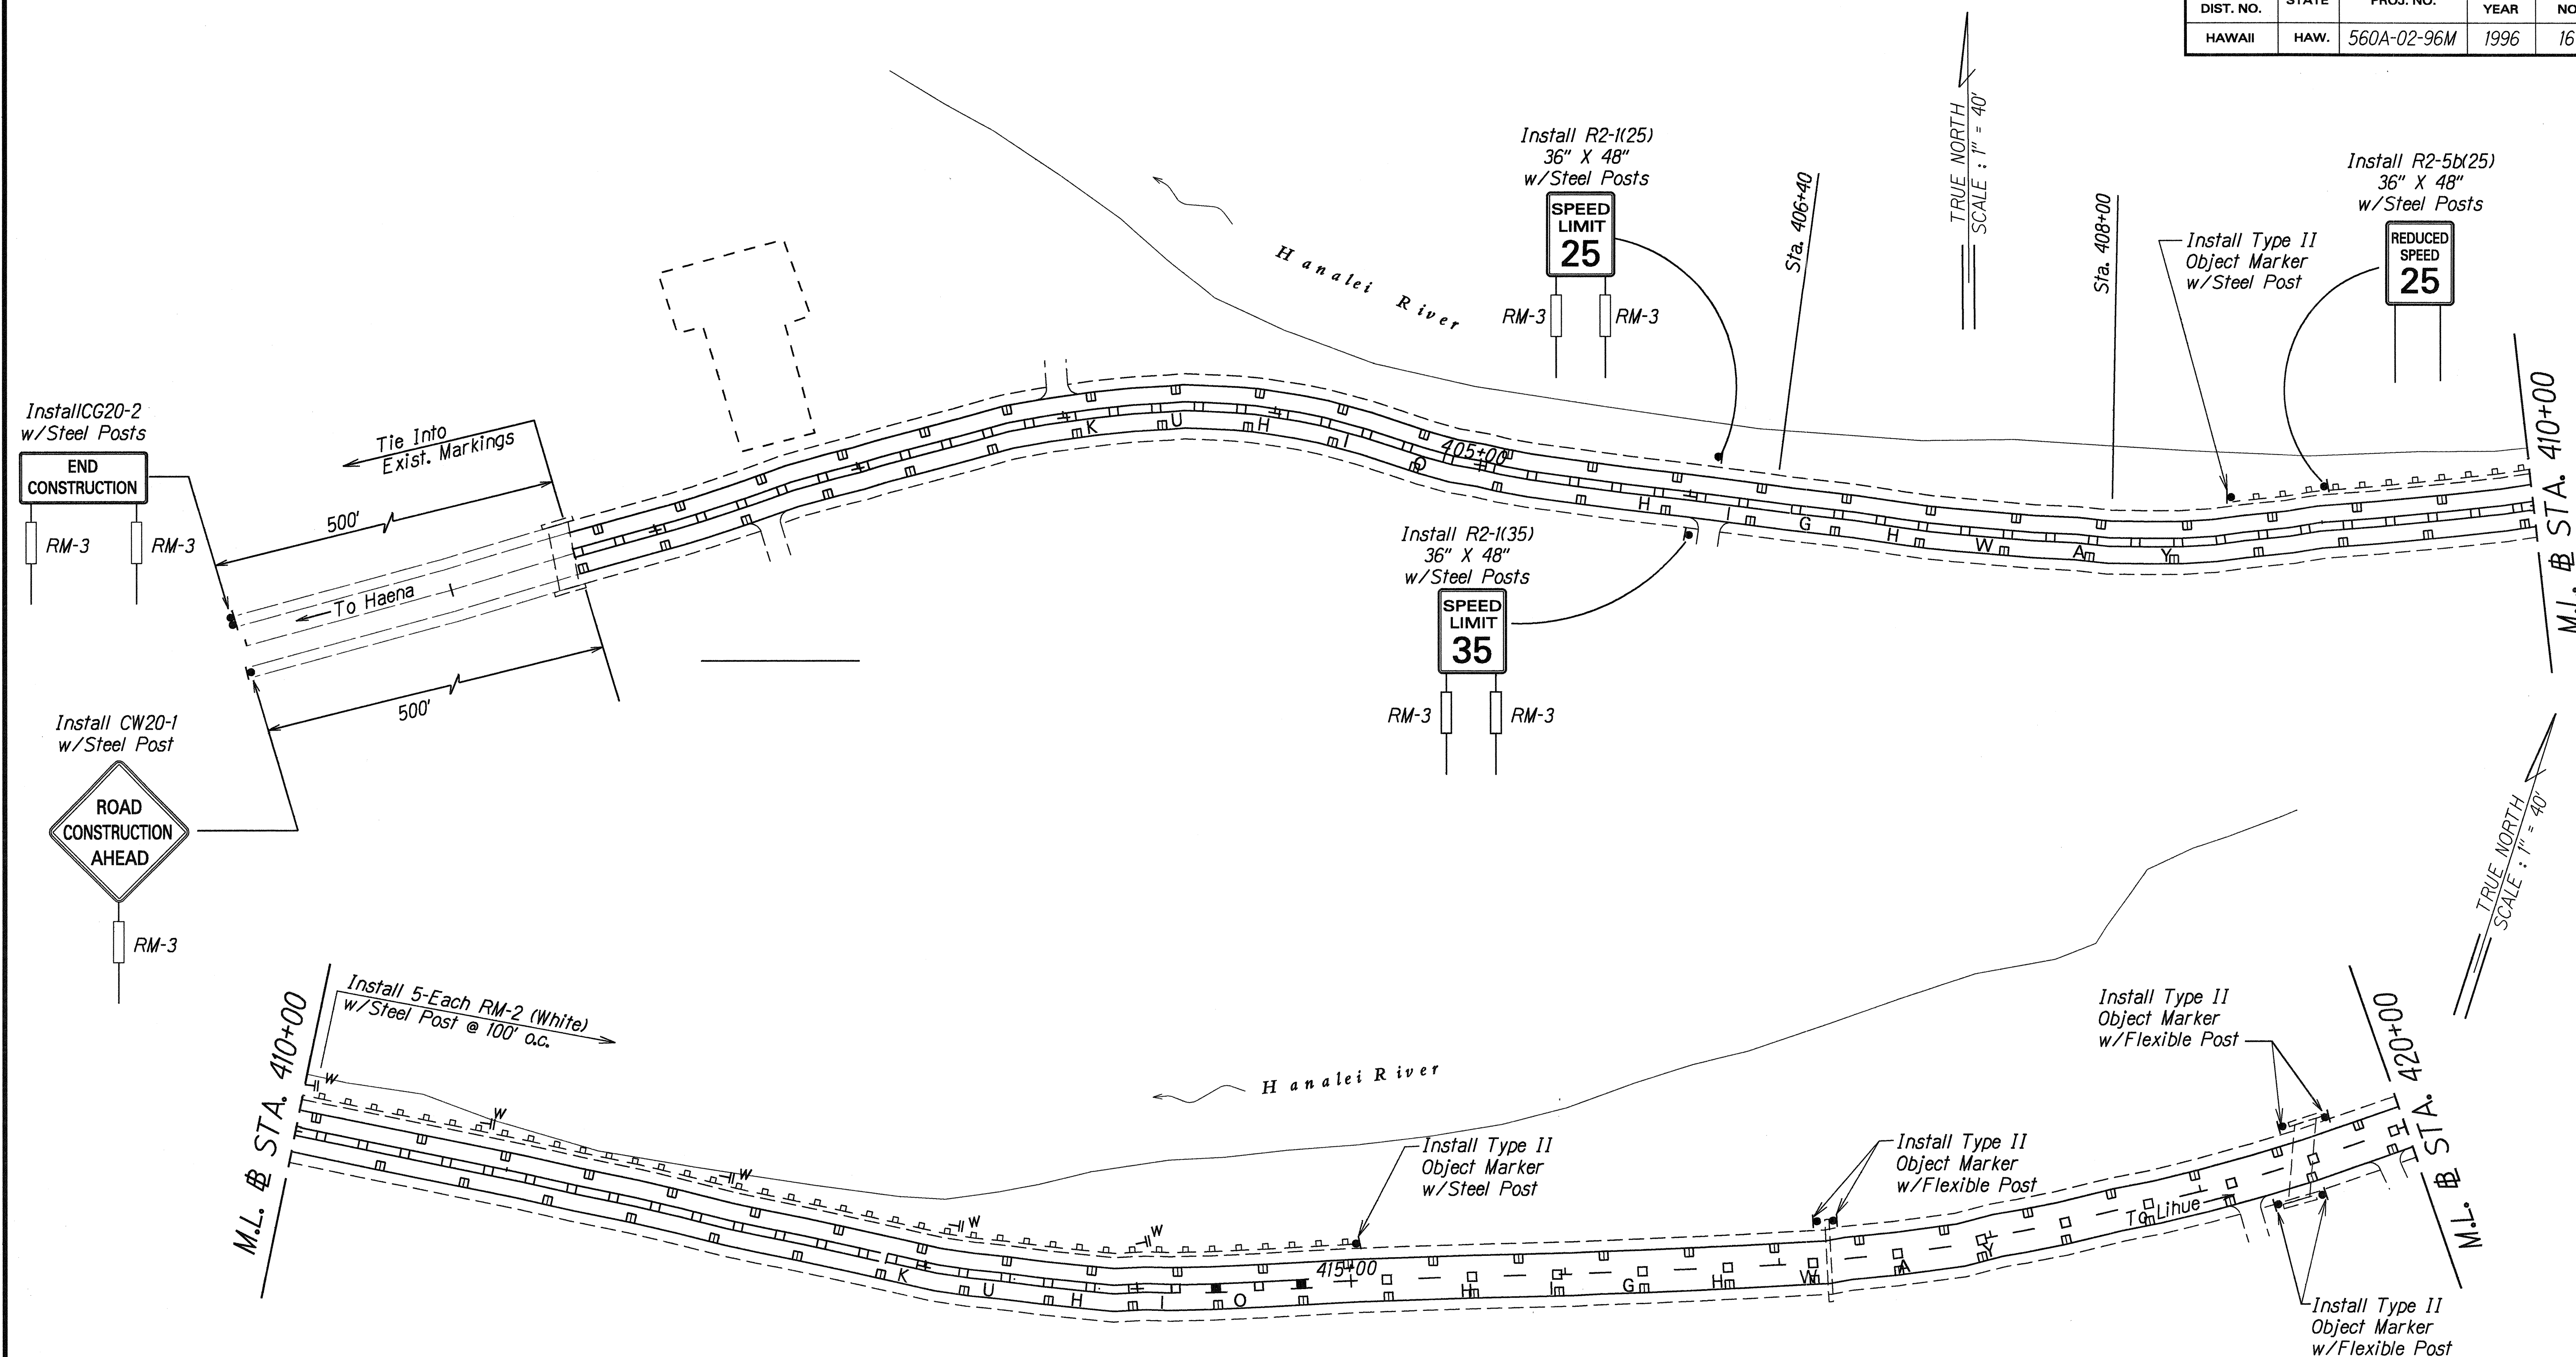

ORIGINAL PLAN	SURVEY PLOTTED BY	DATE
NOTE BOOK	DRAWN BY	
KE-2, Gary	CHECKED BY	
N. K. H. P. I.		

STATE OF HAWAII
DEPARTMENT OF TRANSPORTATION
HIGHWAYS DIVISION


PAVEMENT MARKING AND
TRAFFIC SIGN PLAN

KUHIO HIGHWAY RESURFACING
Hanalei Town To Princeville
Project No. 560A-02-96M

Scale: 1" = 40' Date: April, 1996

SHEET No. 1 OF 7 SHEETS

FED. ROAD DIST. NO.	STATE	PROJ. NO.	FISCAL YEAR	SHEET NO.	TOTAL SHEETS
HAWAII	HAW.	560A-02-96M	1996	17	250

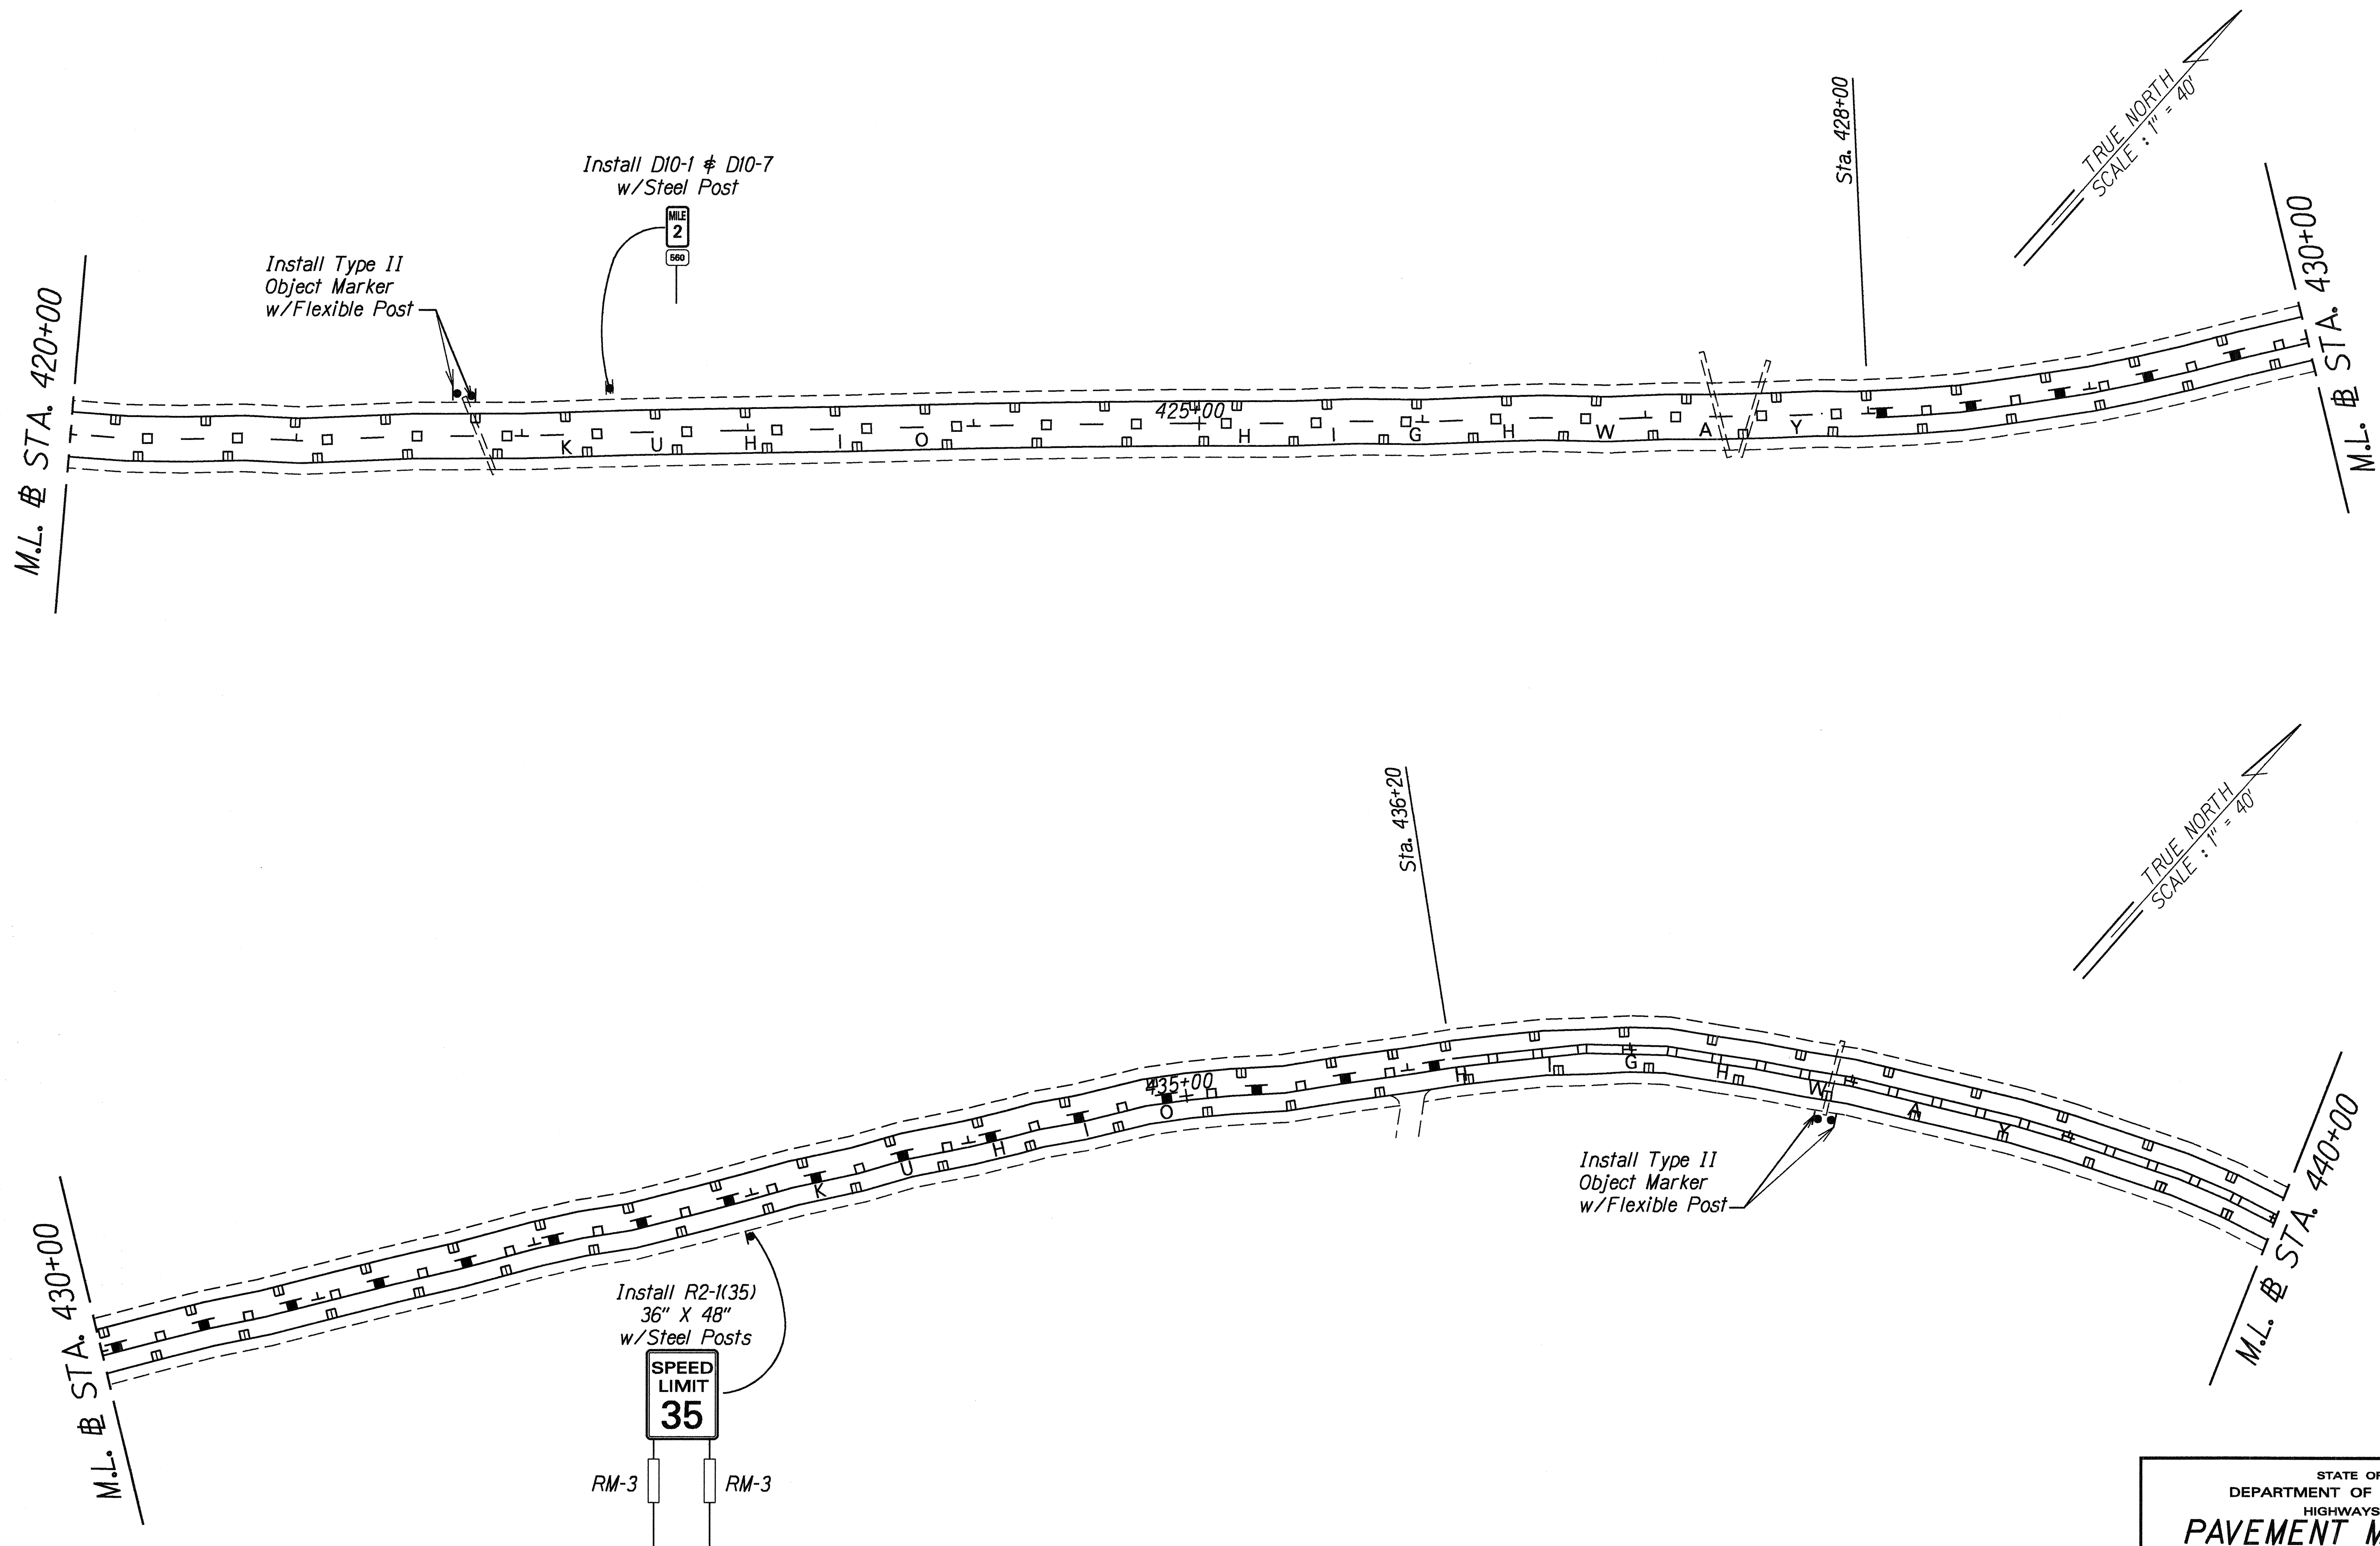


ORIGINAL PLAN	SURVEY PLOTTED BY	DATE
PLAN	DRAWN BY	
NOTE BOOK	TRACED BY	
KE-2, Gary	CHECKED BY	
N. K. H. P. 02		

STATE OF HAWAII
DEPARTMENT OF TRANSPORTATION
HIGHWAYS DIVISION

PAVEMENT MARKING AND
TRAFFIC SIGN PLAN
KUHIO HIGHWAY RESURFACING
Hanalei Town To Princeville
Project No. 560A-02-96M
Scale: 1" = 40' Date: April, 1996
SHEET No. 2 OF 7 SHEETS

FED. ROAD DIST. NO.	STATE	PROJ. NO.	FISCAL YEAR	SHEET NO.	TOTAL SHEETS
HAWAII	HAW.	560A-02-96M	1996	19	25

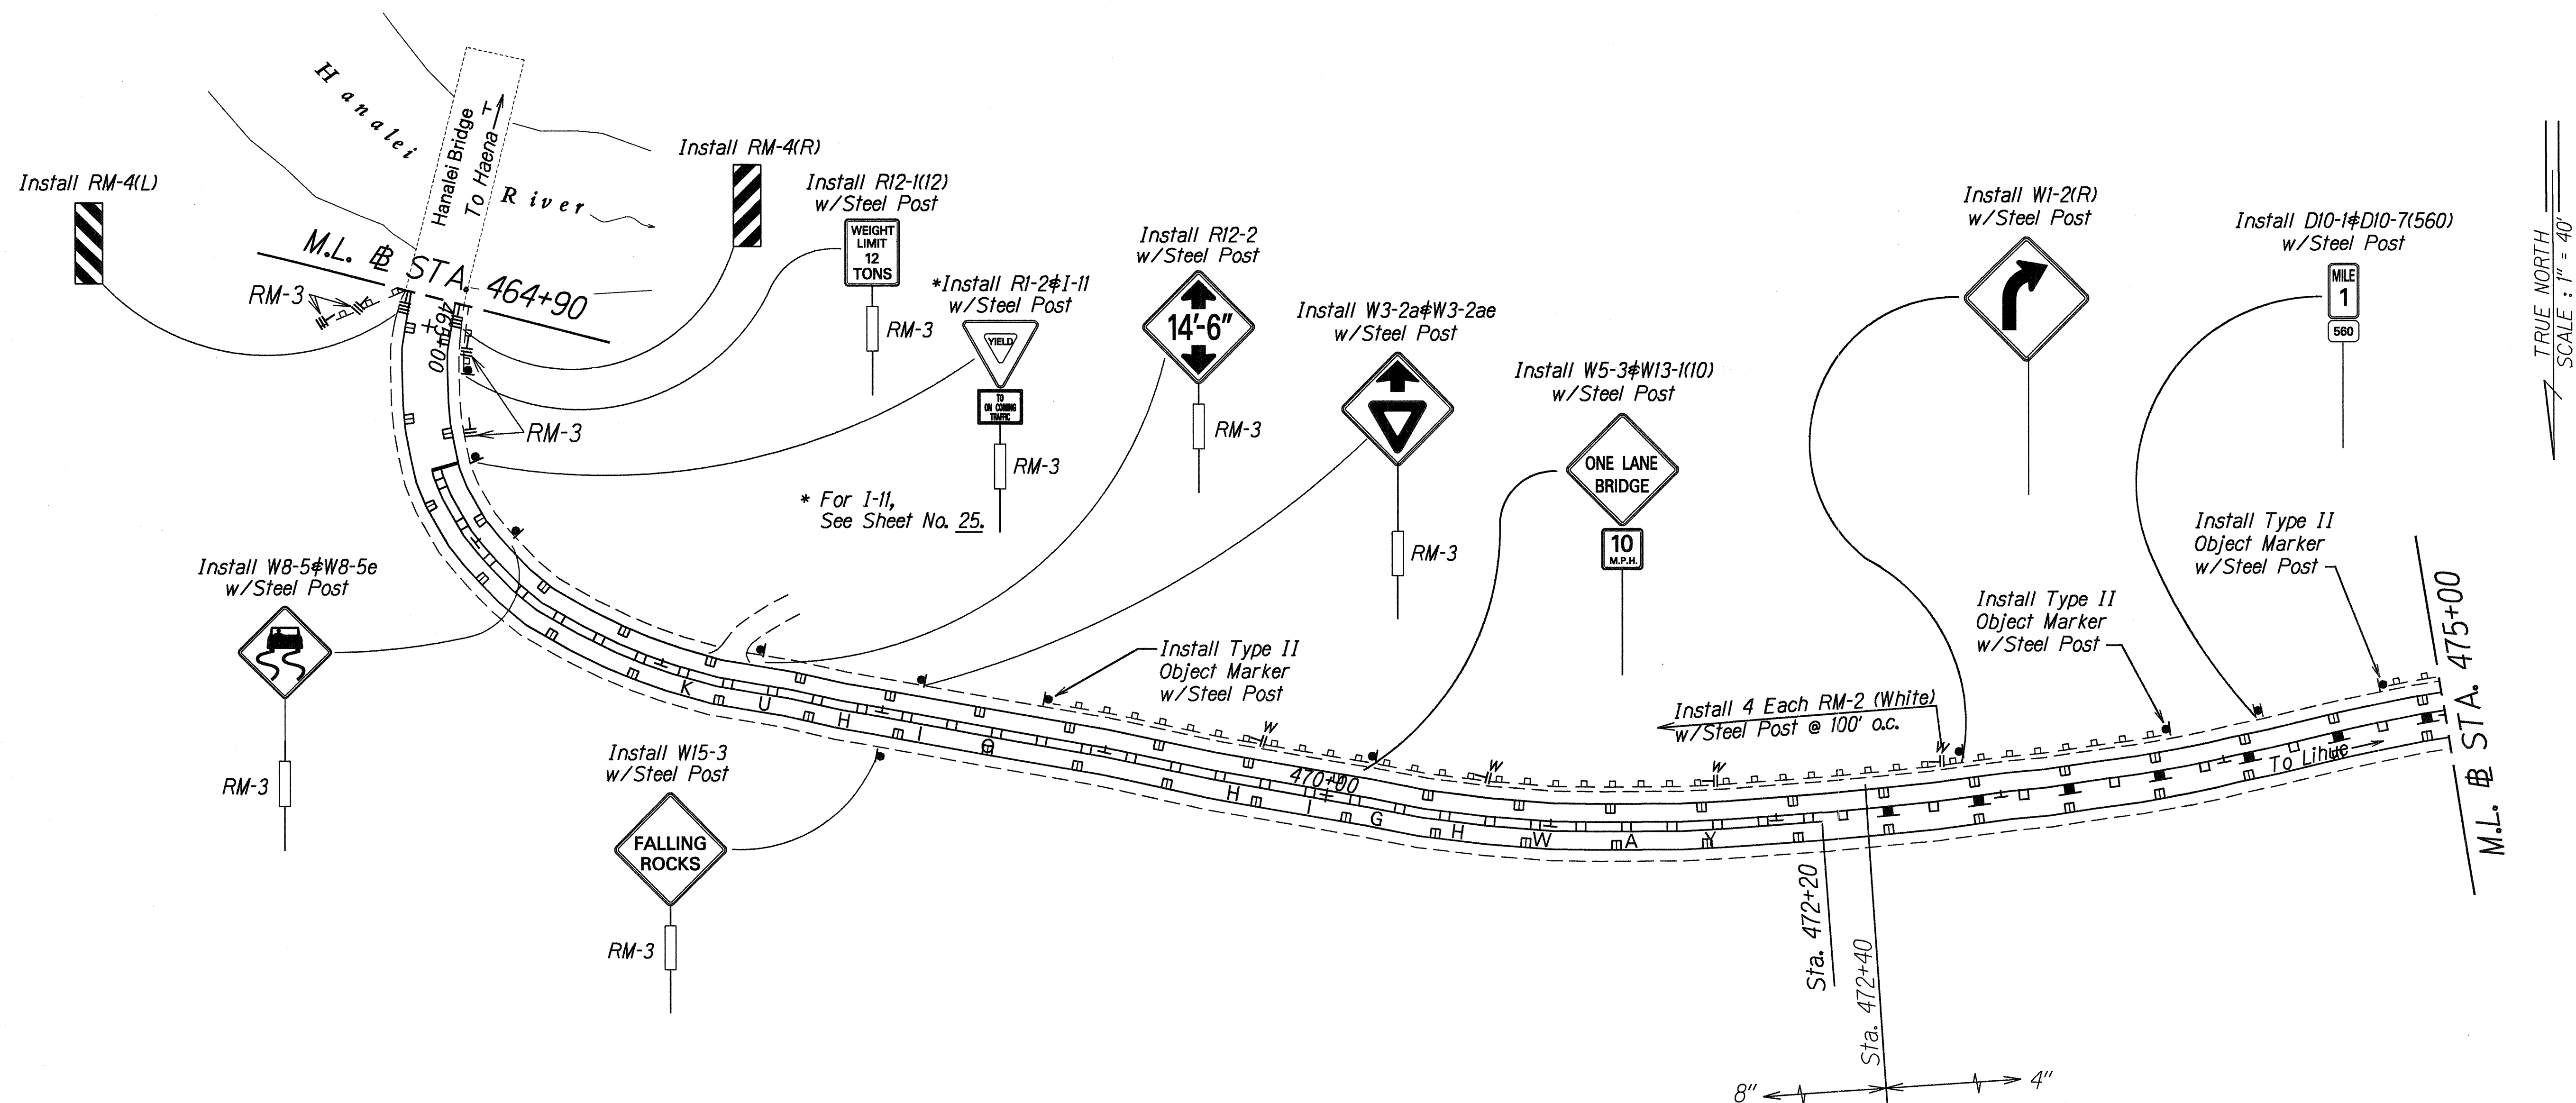

ORIGINAL PLAN	SURVEY PLOTTED BY	DATE
NOTE BOOK	DRAWN BY	
KE-2, Gary	DESIGNED BY	
NS/KUNIKIDA	CHECKED BY	

STATE OF HAWAII
DEPARTMENT OF TRANSPORTATION
HIGHWAYS DIVISION


PAVEMENT MARKING AND
TRAFFIC SIGN PLAN

KUHIO HIGHWAY RESURFACING
Hanalei Town To Princeville
Project No. 560A-02-96M

Scale: 1" = 40' Date: April, 1996

SHEET No. 4 OF 7 SHEETS

FED. ROAD DIST. NO.	STATE	PROJ. NO.	FISCAL YEAR	SHEET NO.	TOTAL SHEETS
HAWAII	HAW.	560A-02-96M	1996	20	25

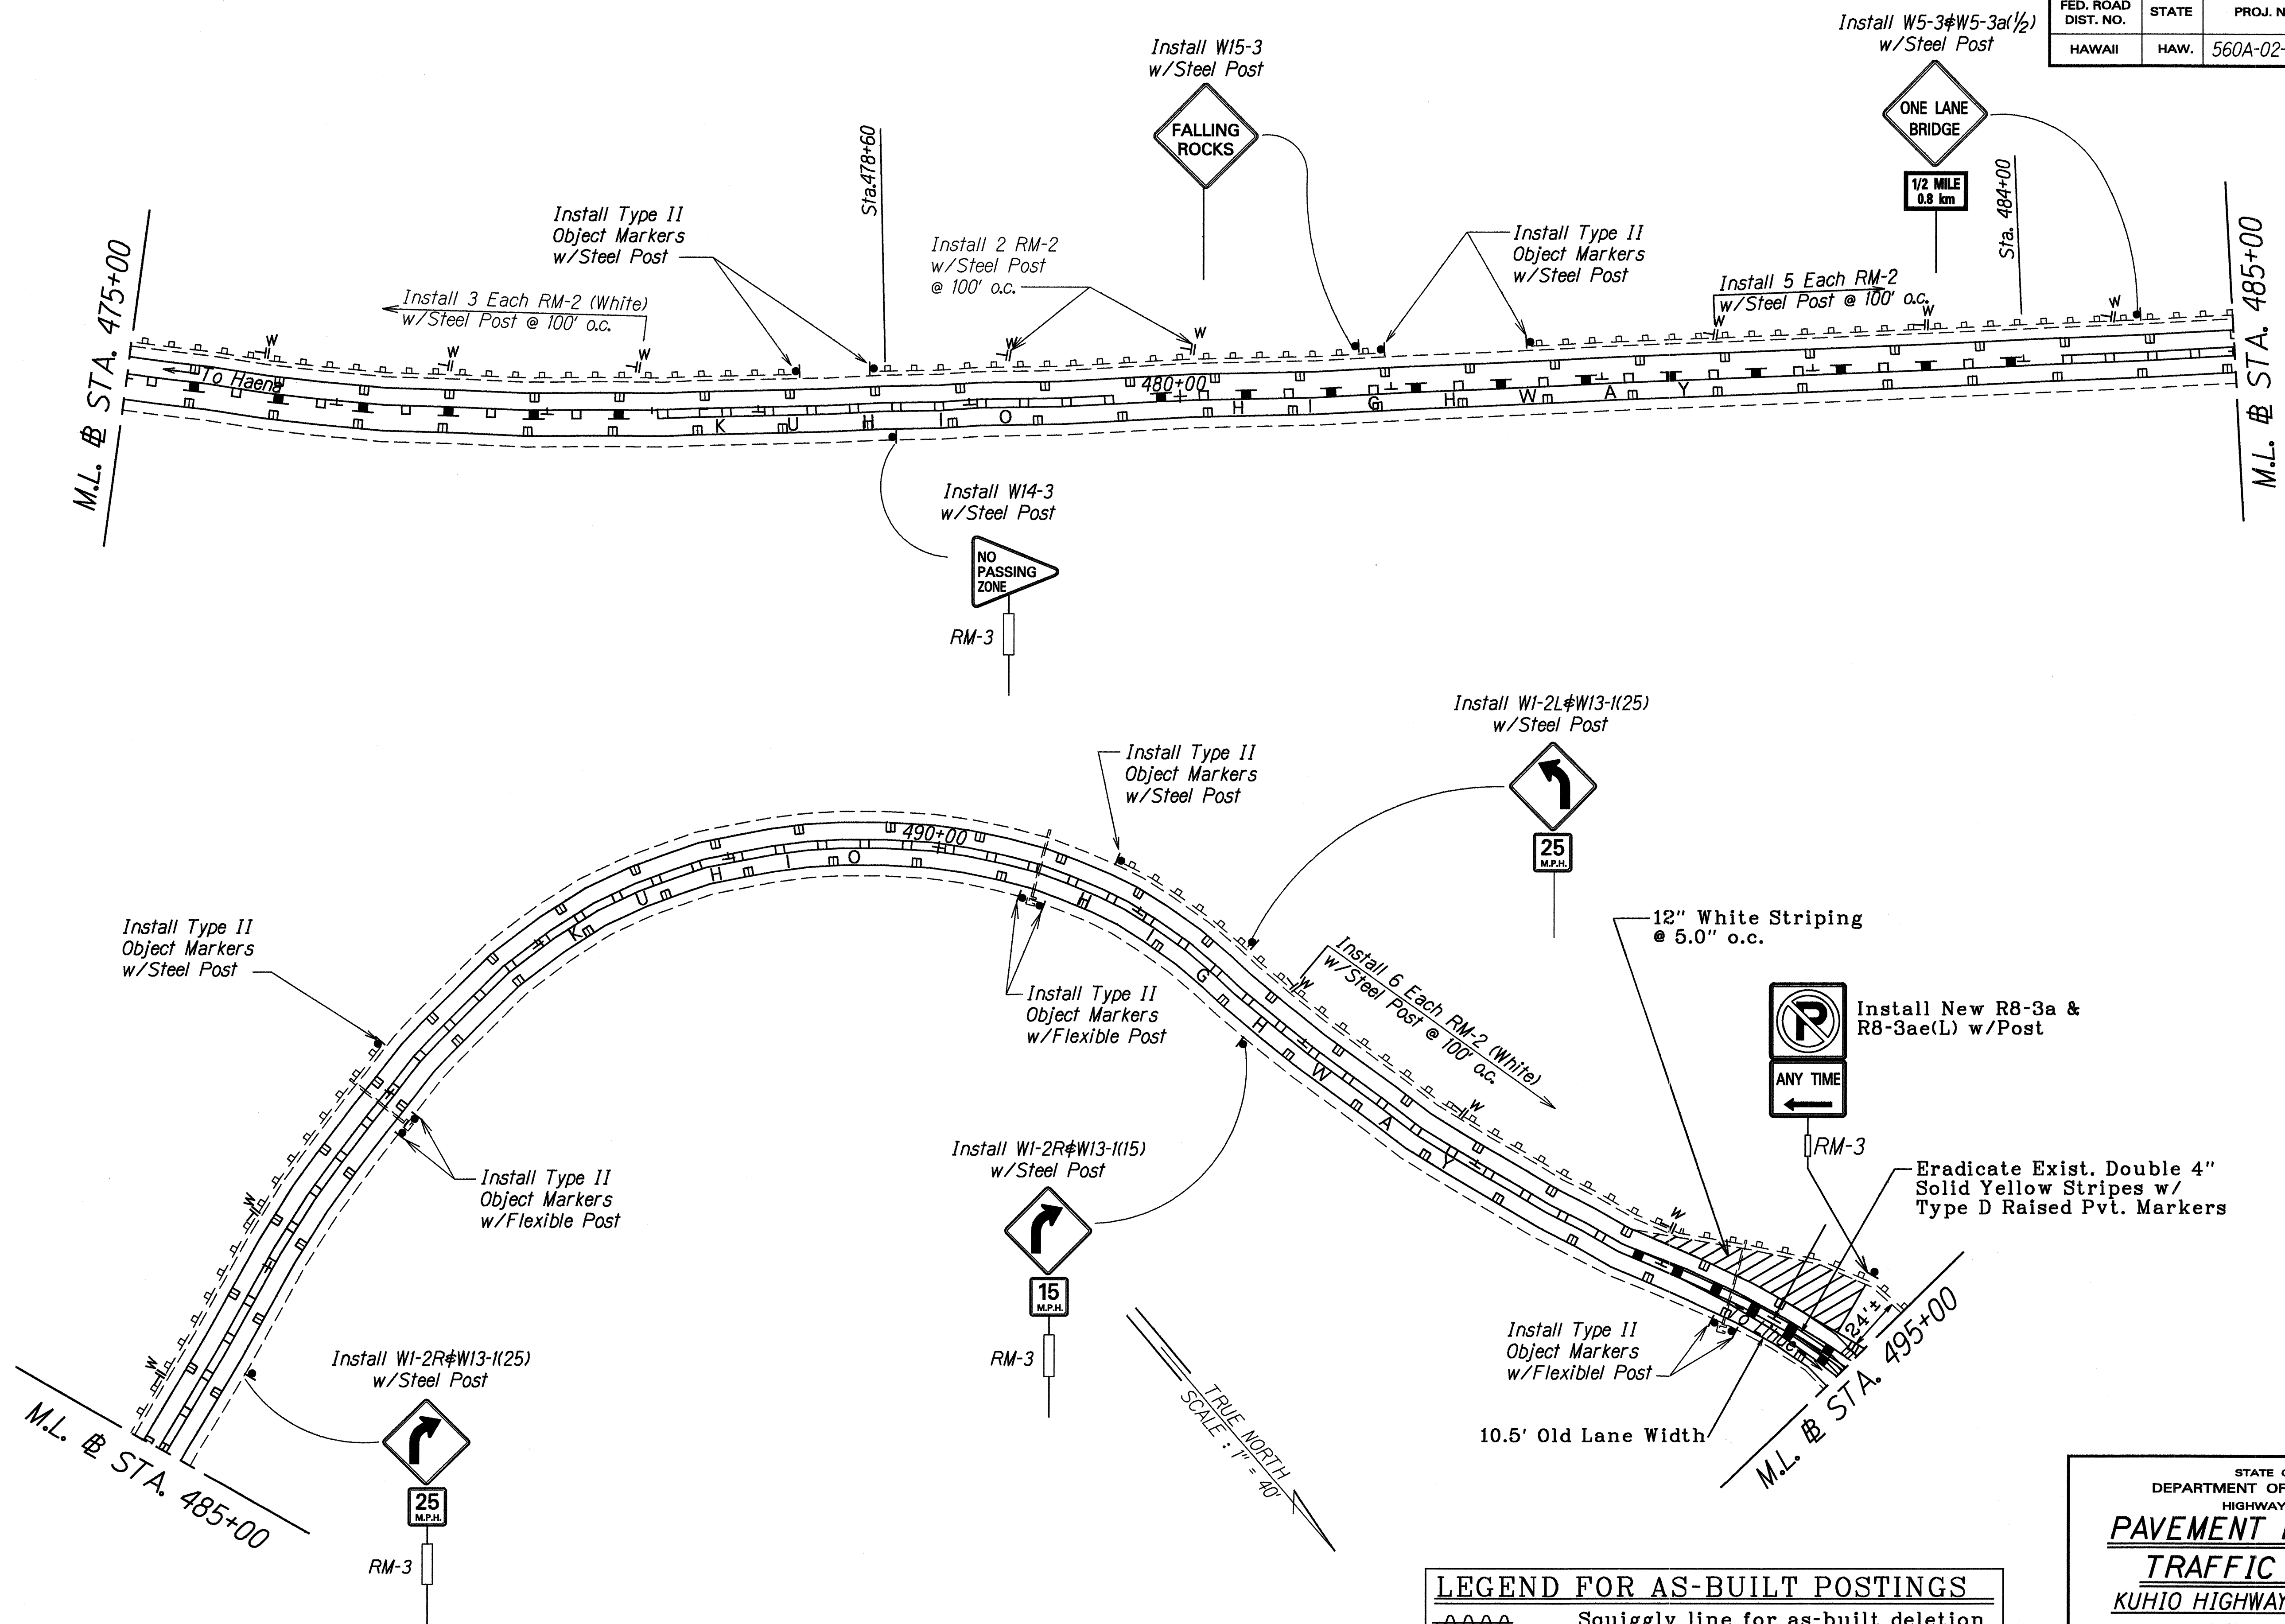


ORIGINAL PLAN	SURVEY PLOTTED BY	DATE
KE2, Gary	DATE	
NOTES	DESIGNED BY	
QUANTITIES BY		
CHECKED BY		

LEGEND FOR AS-BUILT POSTINGS	
	Squiggly line for as-built deletion
	Double line for as-built deletion
Roadway	Text for as-built posting

STATE OF HAWAII
DEPARTMENT OF TRANSPORTATION
HIGHWAYS DIVISION
**PAVEMENT MARKING AND
TRAFFIC SIGN PLAN**
KUHIO HIGHWAY RESURFACING
Hanalei Town To Princeville
Project No. 560A-02-96M
Scale: 1" = 40' Date: April, 1996
SHEET No. 5 OF 7 SHEETS

AS-BUILT 20

FED. ROAD DIST. NO.	STATE	PROJ. NO.	FISCAL YEAR	SHEET NO.	TOTAL SHEETS
HAWAII	HAW.	560A-02-96M	1996	21	25

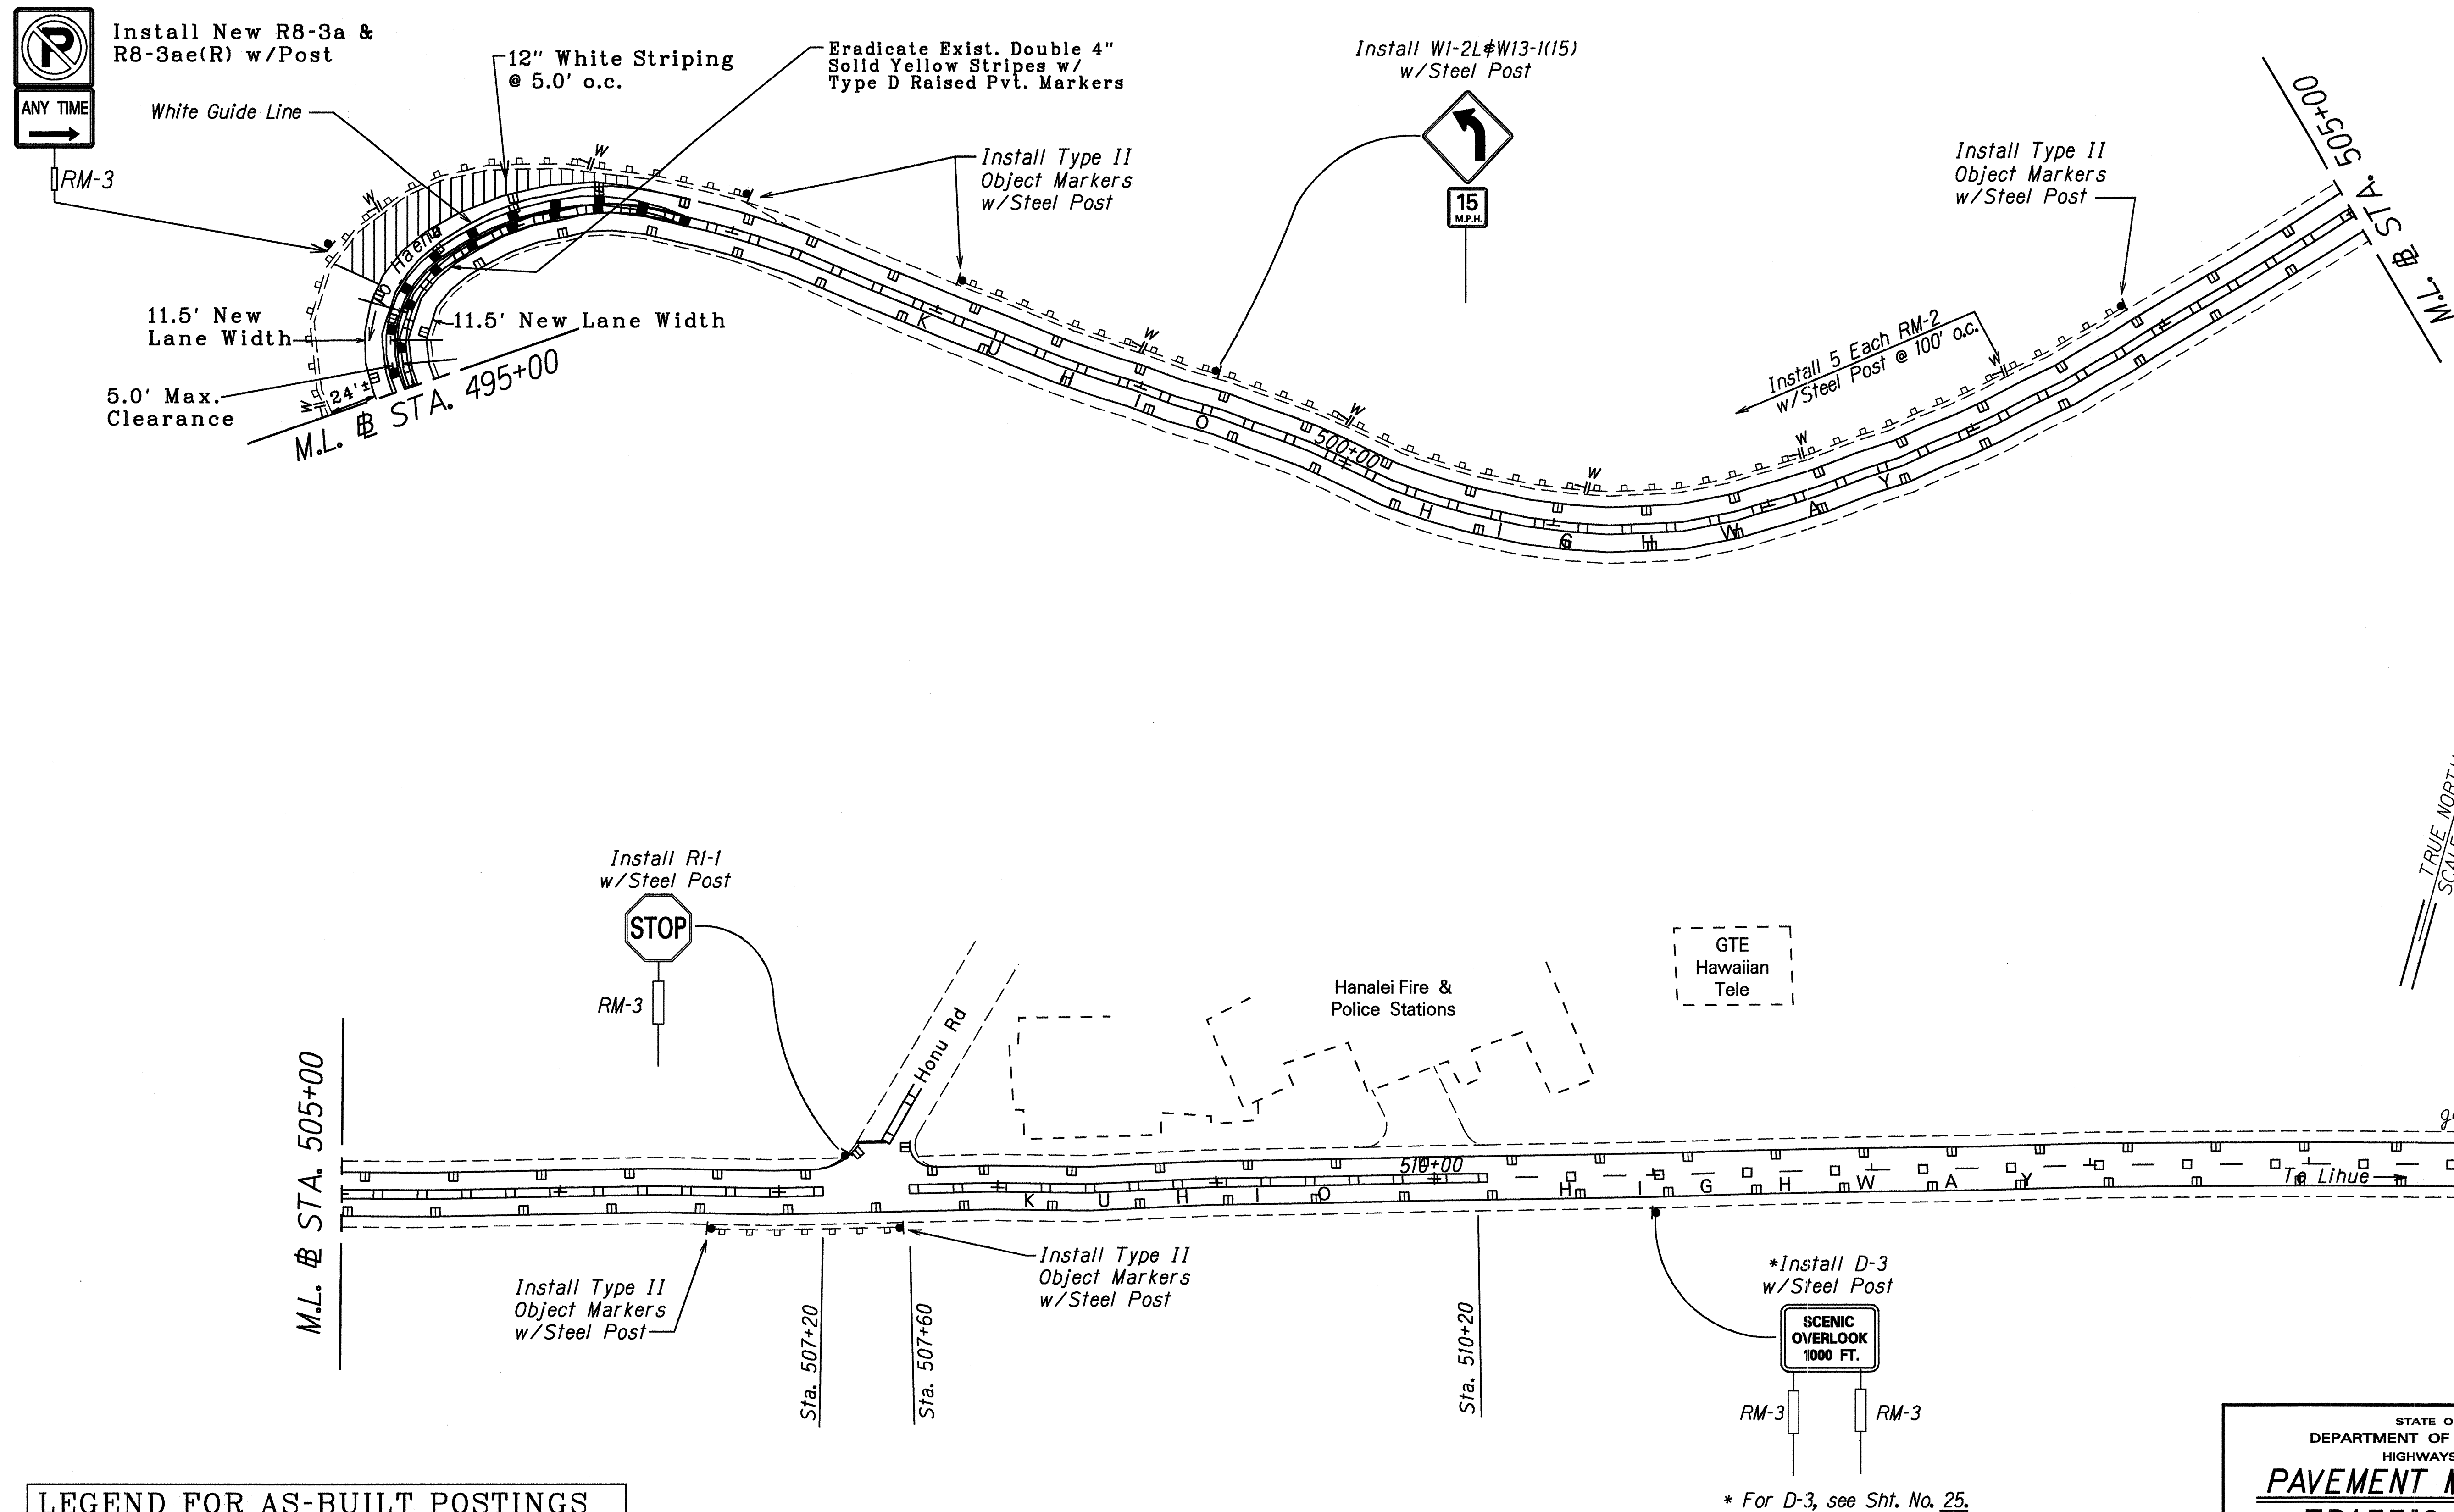

LEGEND FOR AS-BUILT POSTINGS	
	Squiggly line for as-built deletion
	Double line for as-built deletion
Roadway	Text for as-built posting

STATE OF HAWAII
DEPARTMENT OF TRANSPORTATION
HIGHWAYS DIVISION

**PAVEMENT MARKING AND
TRAFFIC SIGN PLAN**

KUHIO HIGHWAY RESURFACING


Hanalei Town To Princeville

Project No. 560A-02-96M

Scale: 1" = 40' Date: April, 1996

SHEET No. 6 OF 7 SHEETS

FED. ROAD DIST. NO.	STATE	PROJ. NO.	FISCAL YEAR	SHEET NO.	TOTAL SHEETS
HAWAII	HAW.	560A-02-96M	1996	22	25

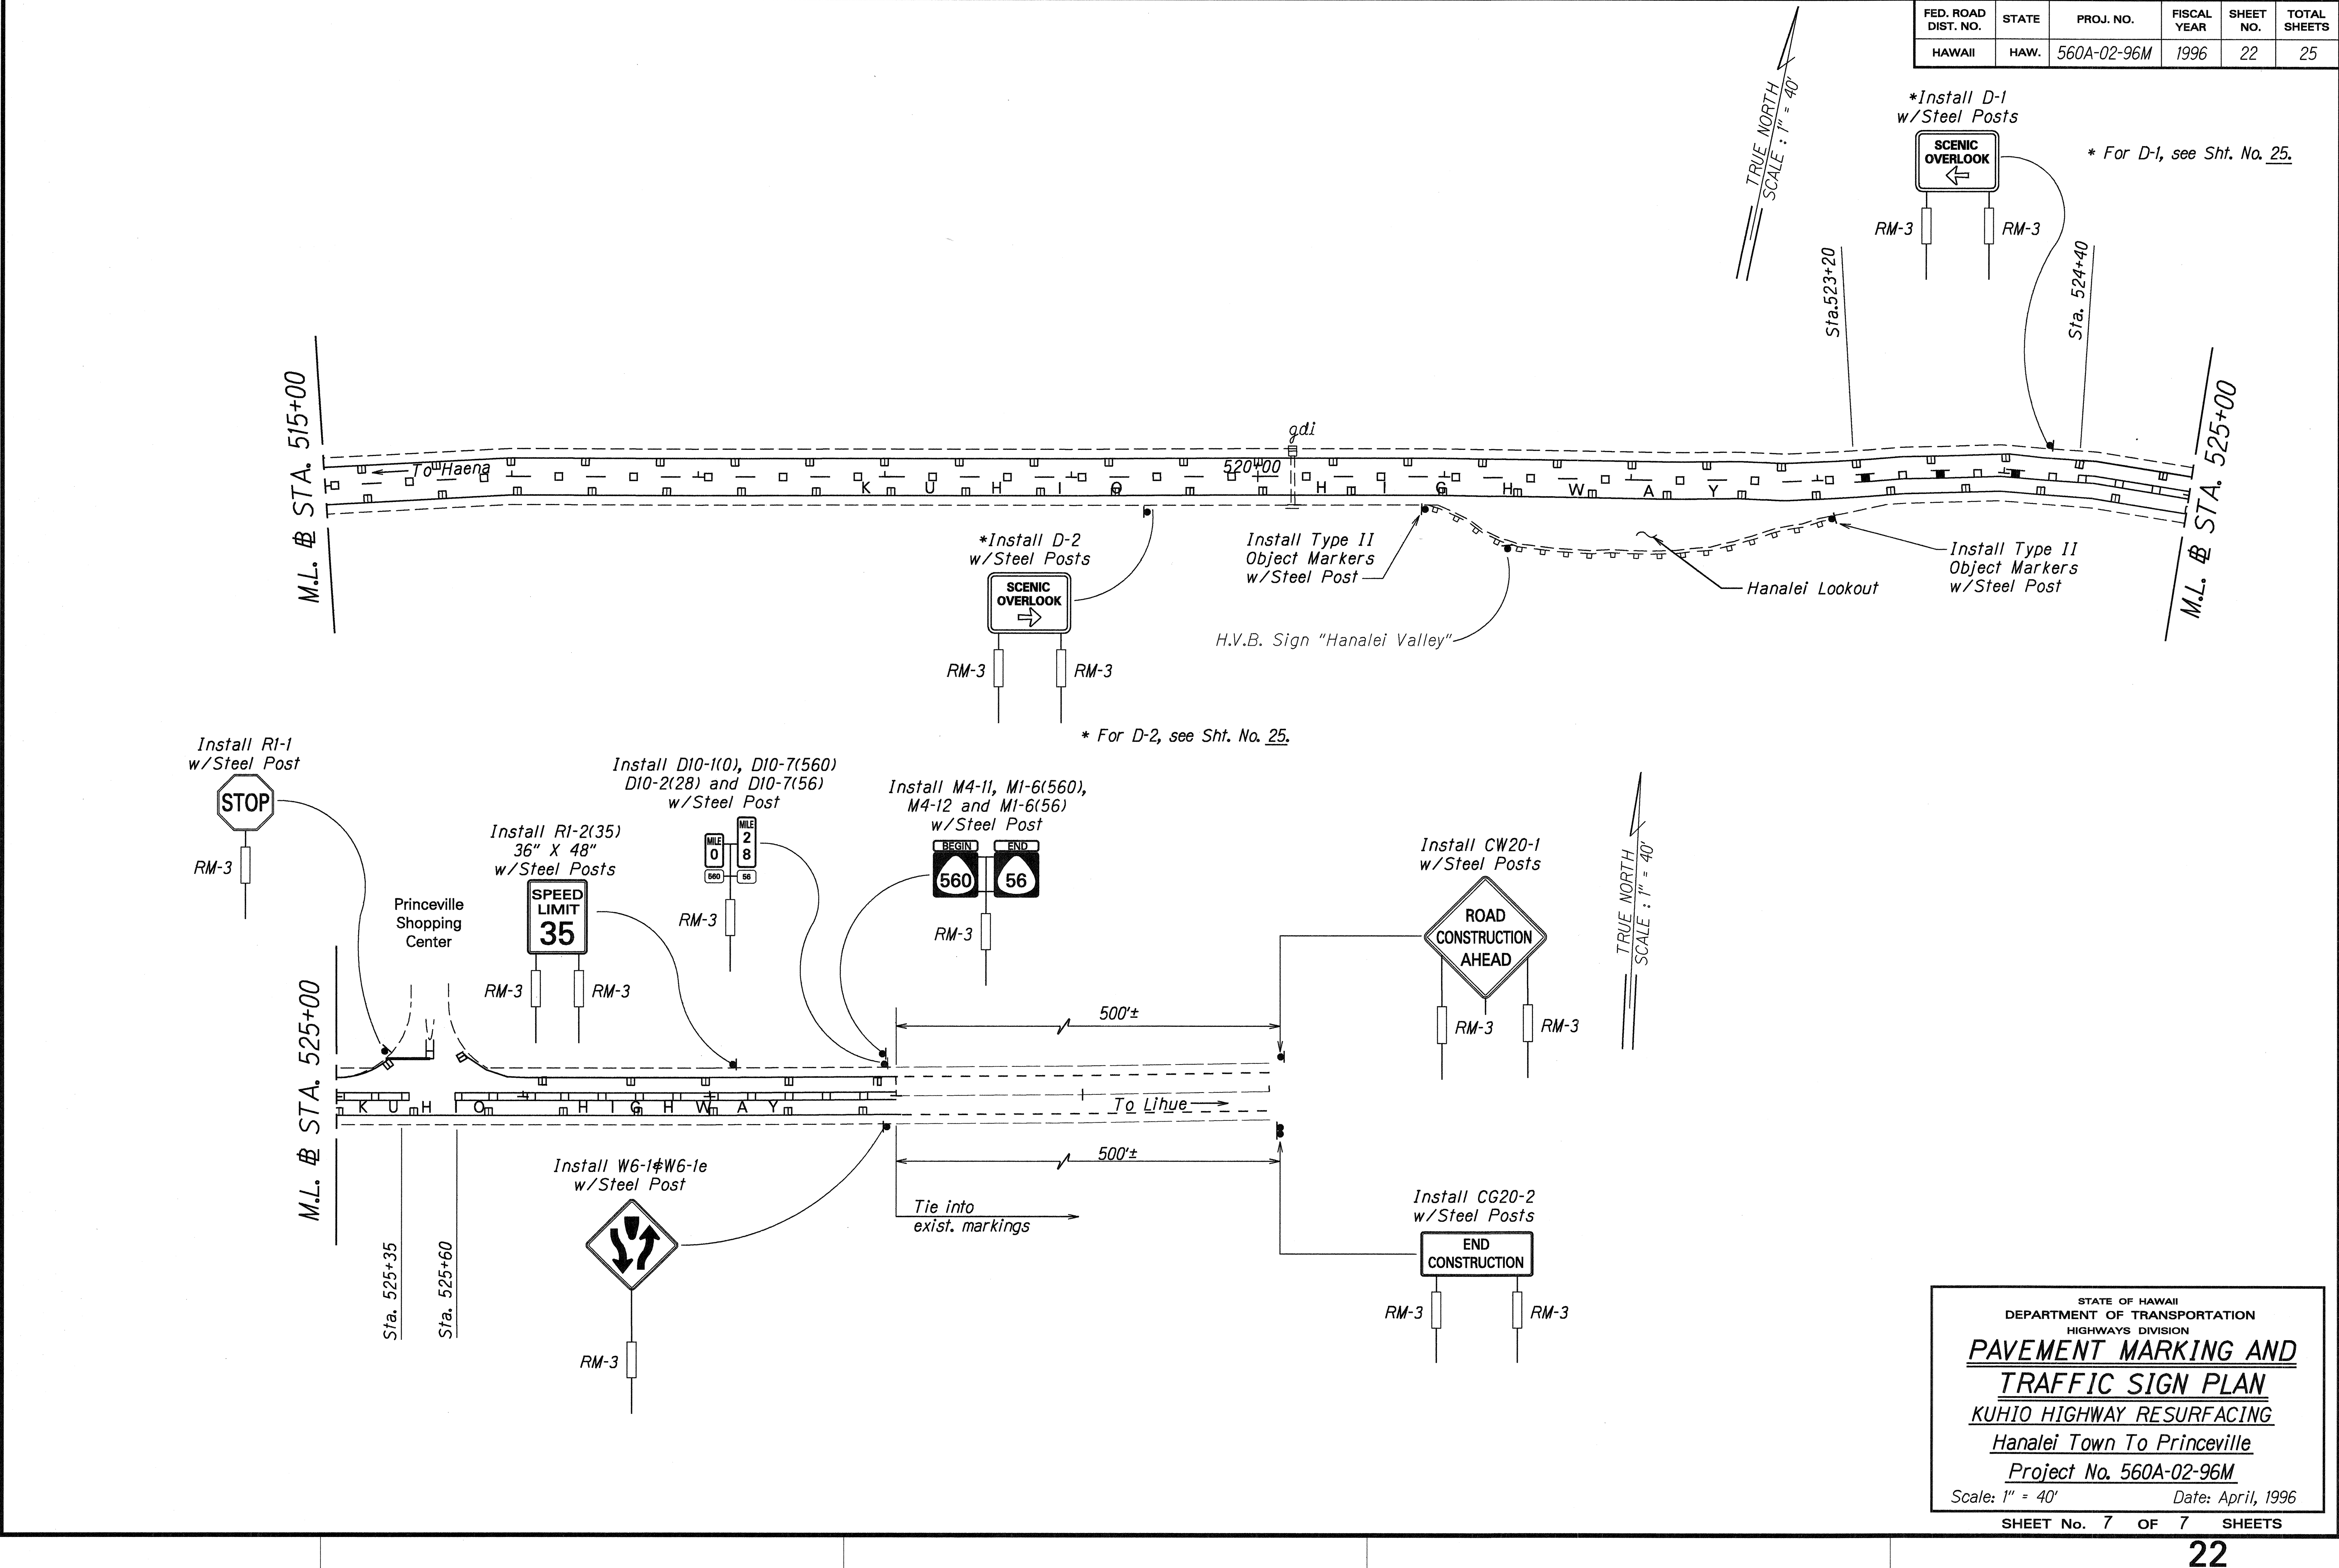

ORIGINAL PLAN	SURVEY PLOTTED BY	DATE
NOTE BOOK	DRAWN BY	
DESIGNED BY	KE-2 Gary	
CHECKED BY	Ngahitipati	

STATE OF HAWAII
DEPARTMENT OF TRANSPORTATION
HIGHWAYS DIVISION

PAVEMENT MARKING AND
TRAFFIC SIGN PLAN

KUHIO HIGHWAY RESURFACING
Hanalei Town To Princeville
Project No. 560A-02-96M

Scale: 1" = 40' Date: April, 1996

SHEET No. 7 OF 7 SHEETS