



FED. ROAD DIST. NO.	STATE	FED. AID PROJ. NO.	FISCAL YEAR	SHEET NO.	TOTAL SHEETS
HAWAII	HAW.	560A-02-96M	1996	7	25

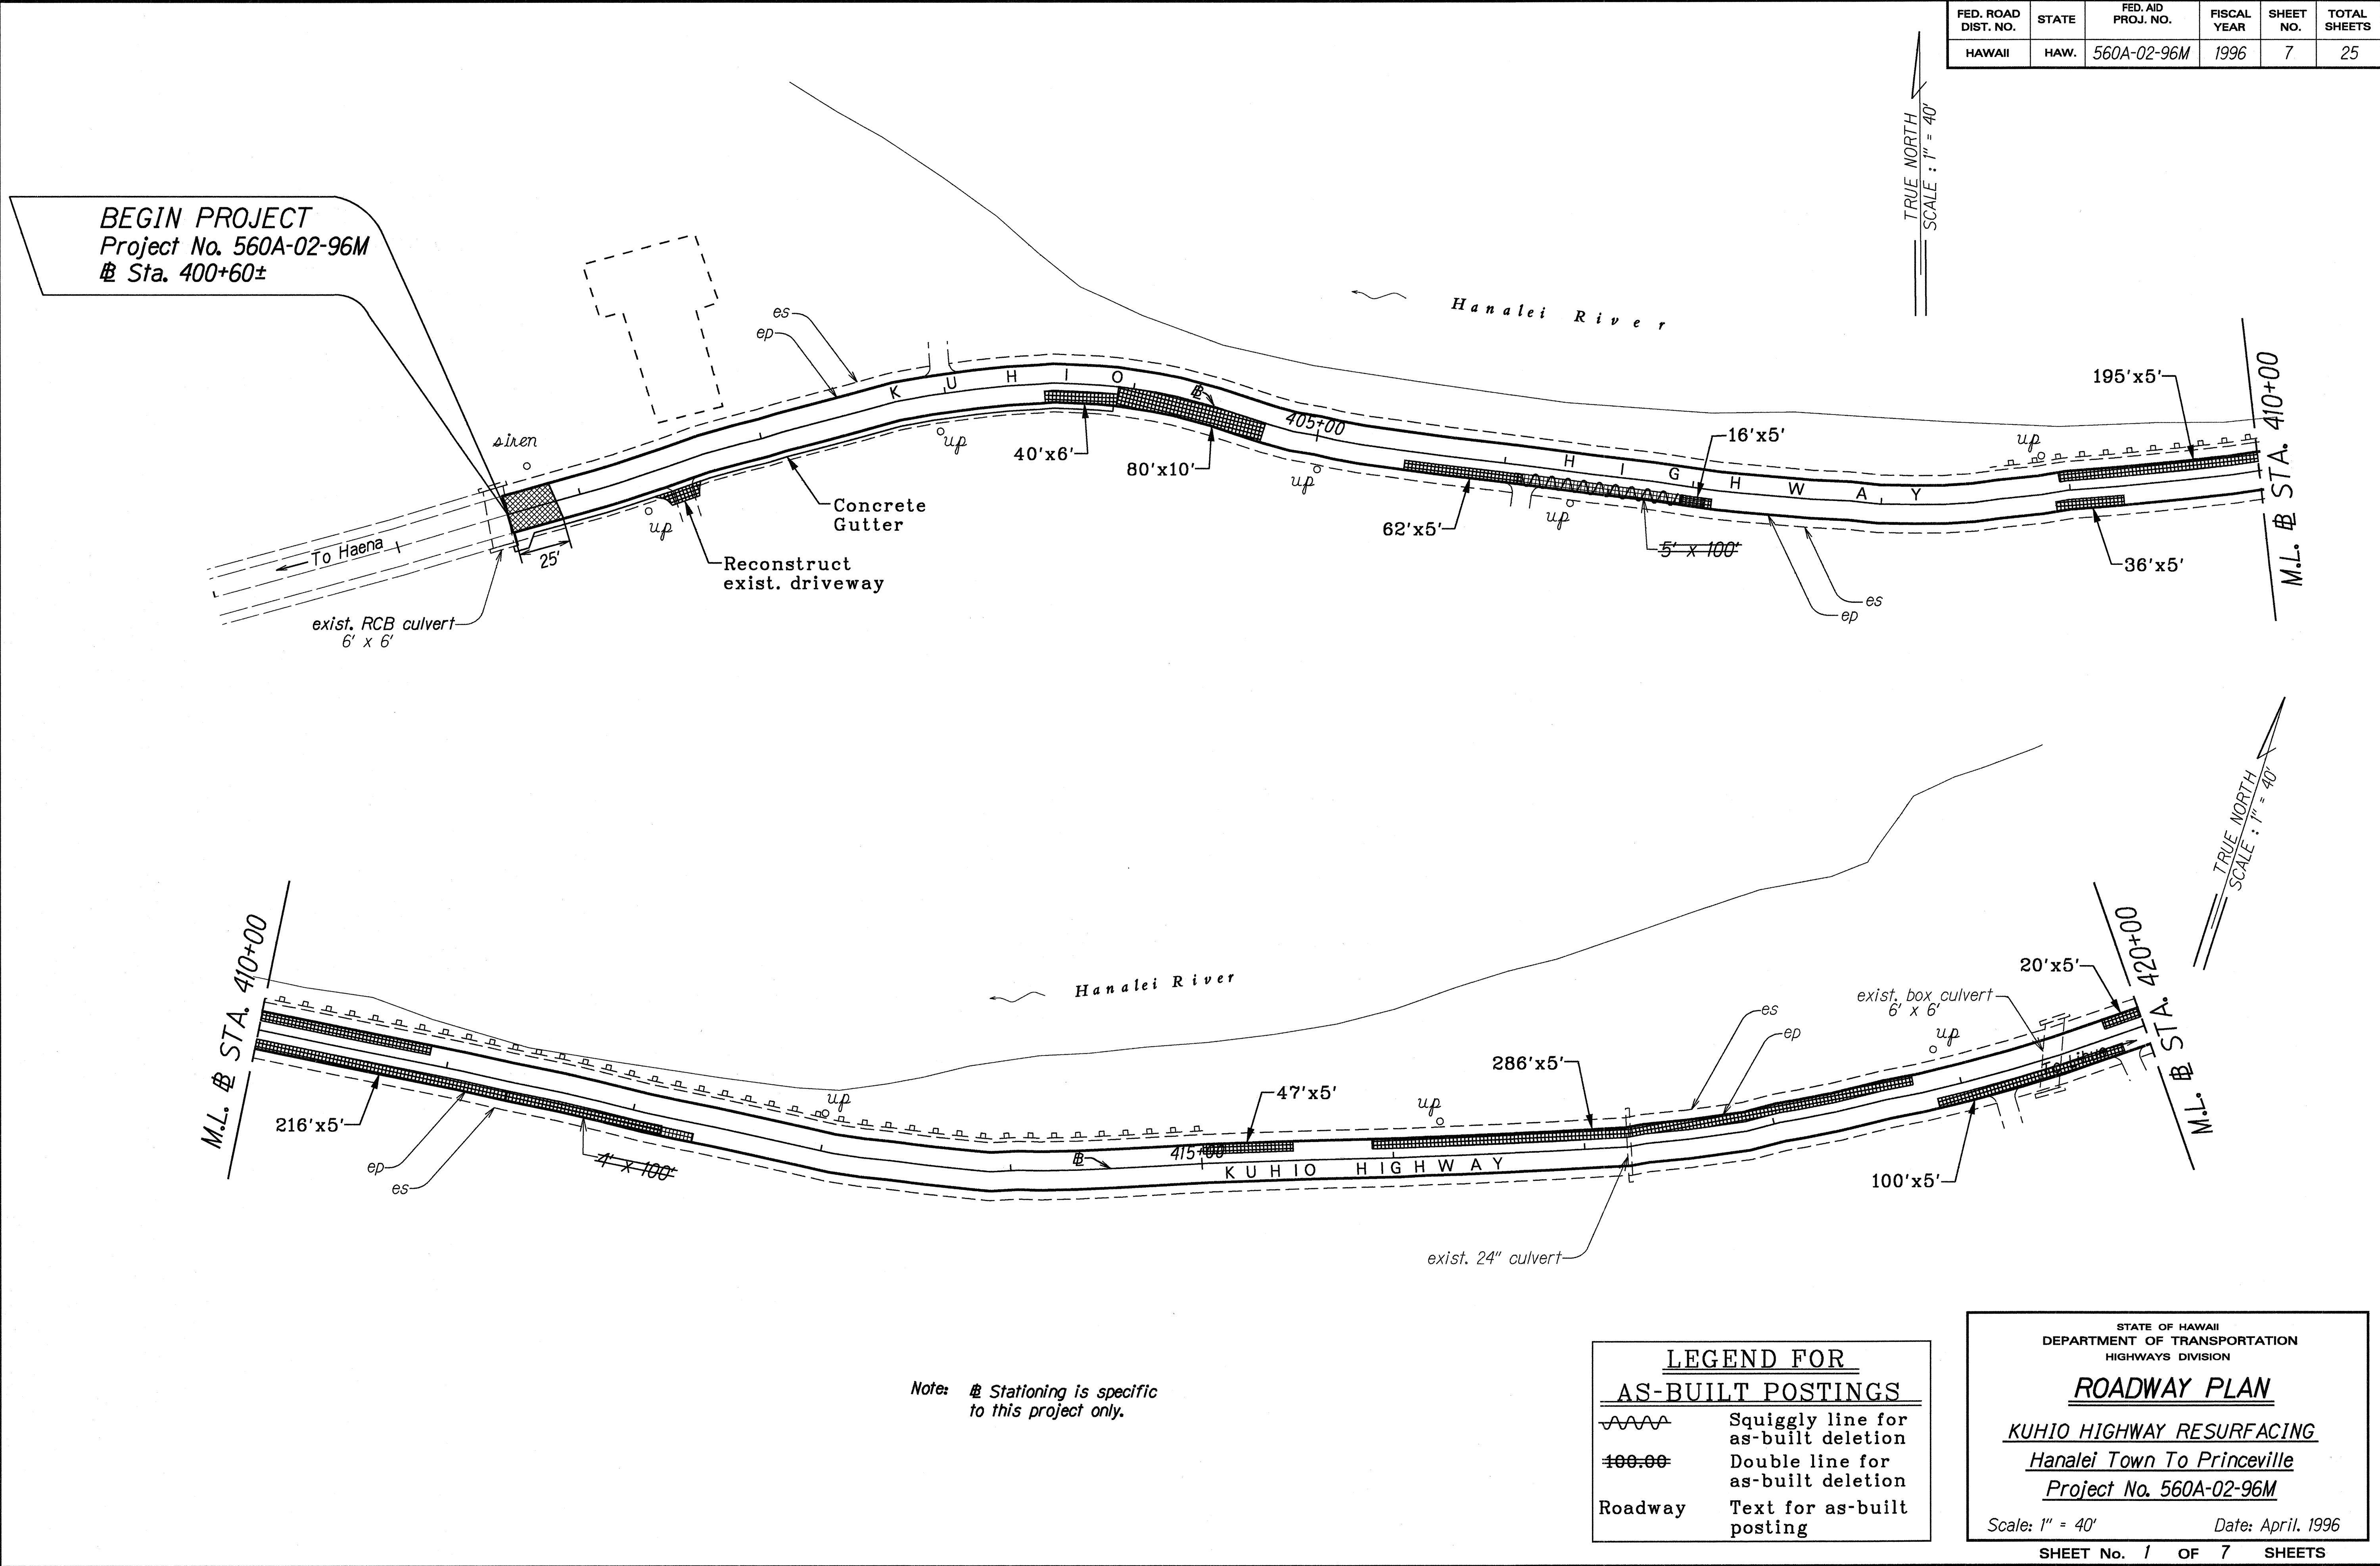

ORIGINAL PLAN	SURVEY PLOTTED BY	DATE
NOTE BOOK	DRAWN BY	
KE-2, Gen	DESIGNED BY	
Na, Kauhail	CHECKED BY	

FED. ROAD DIST. NO.	STATE	PROJ. NO.	FISCAL YEAR	SHEET NO.	TOTAL SHEETS
HAWAII	HAW.	560A-02-96M	1996	8	25

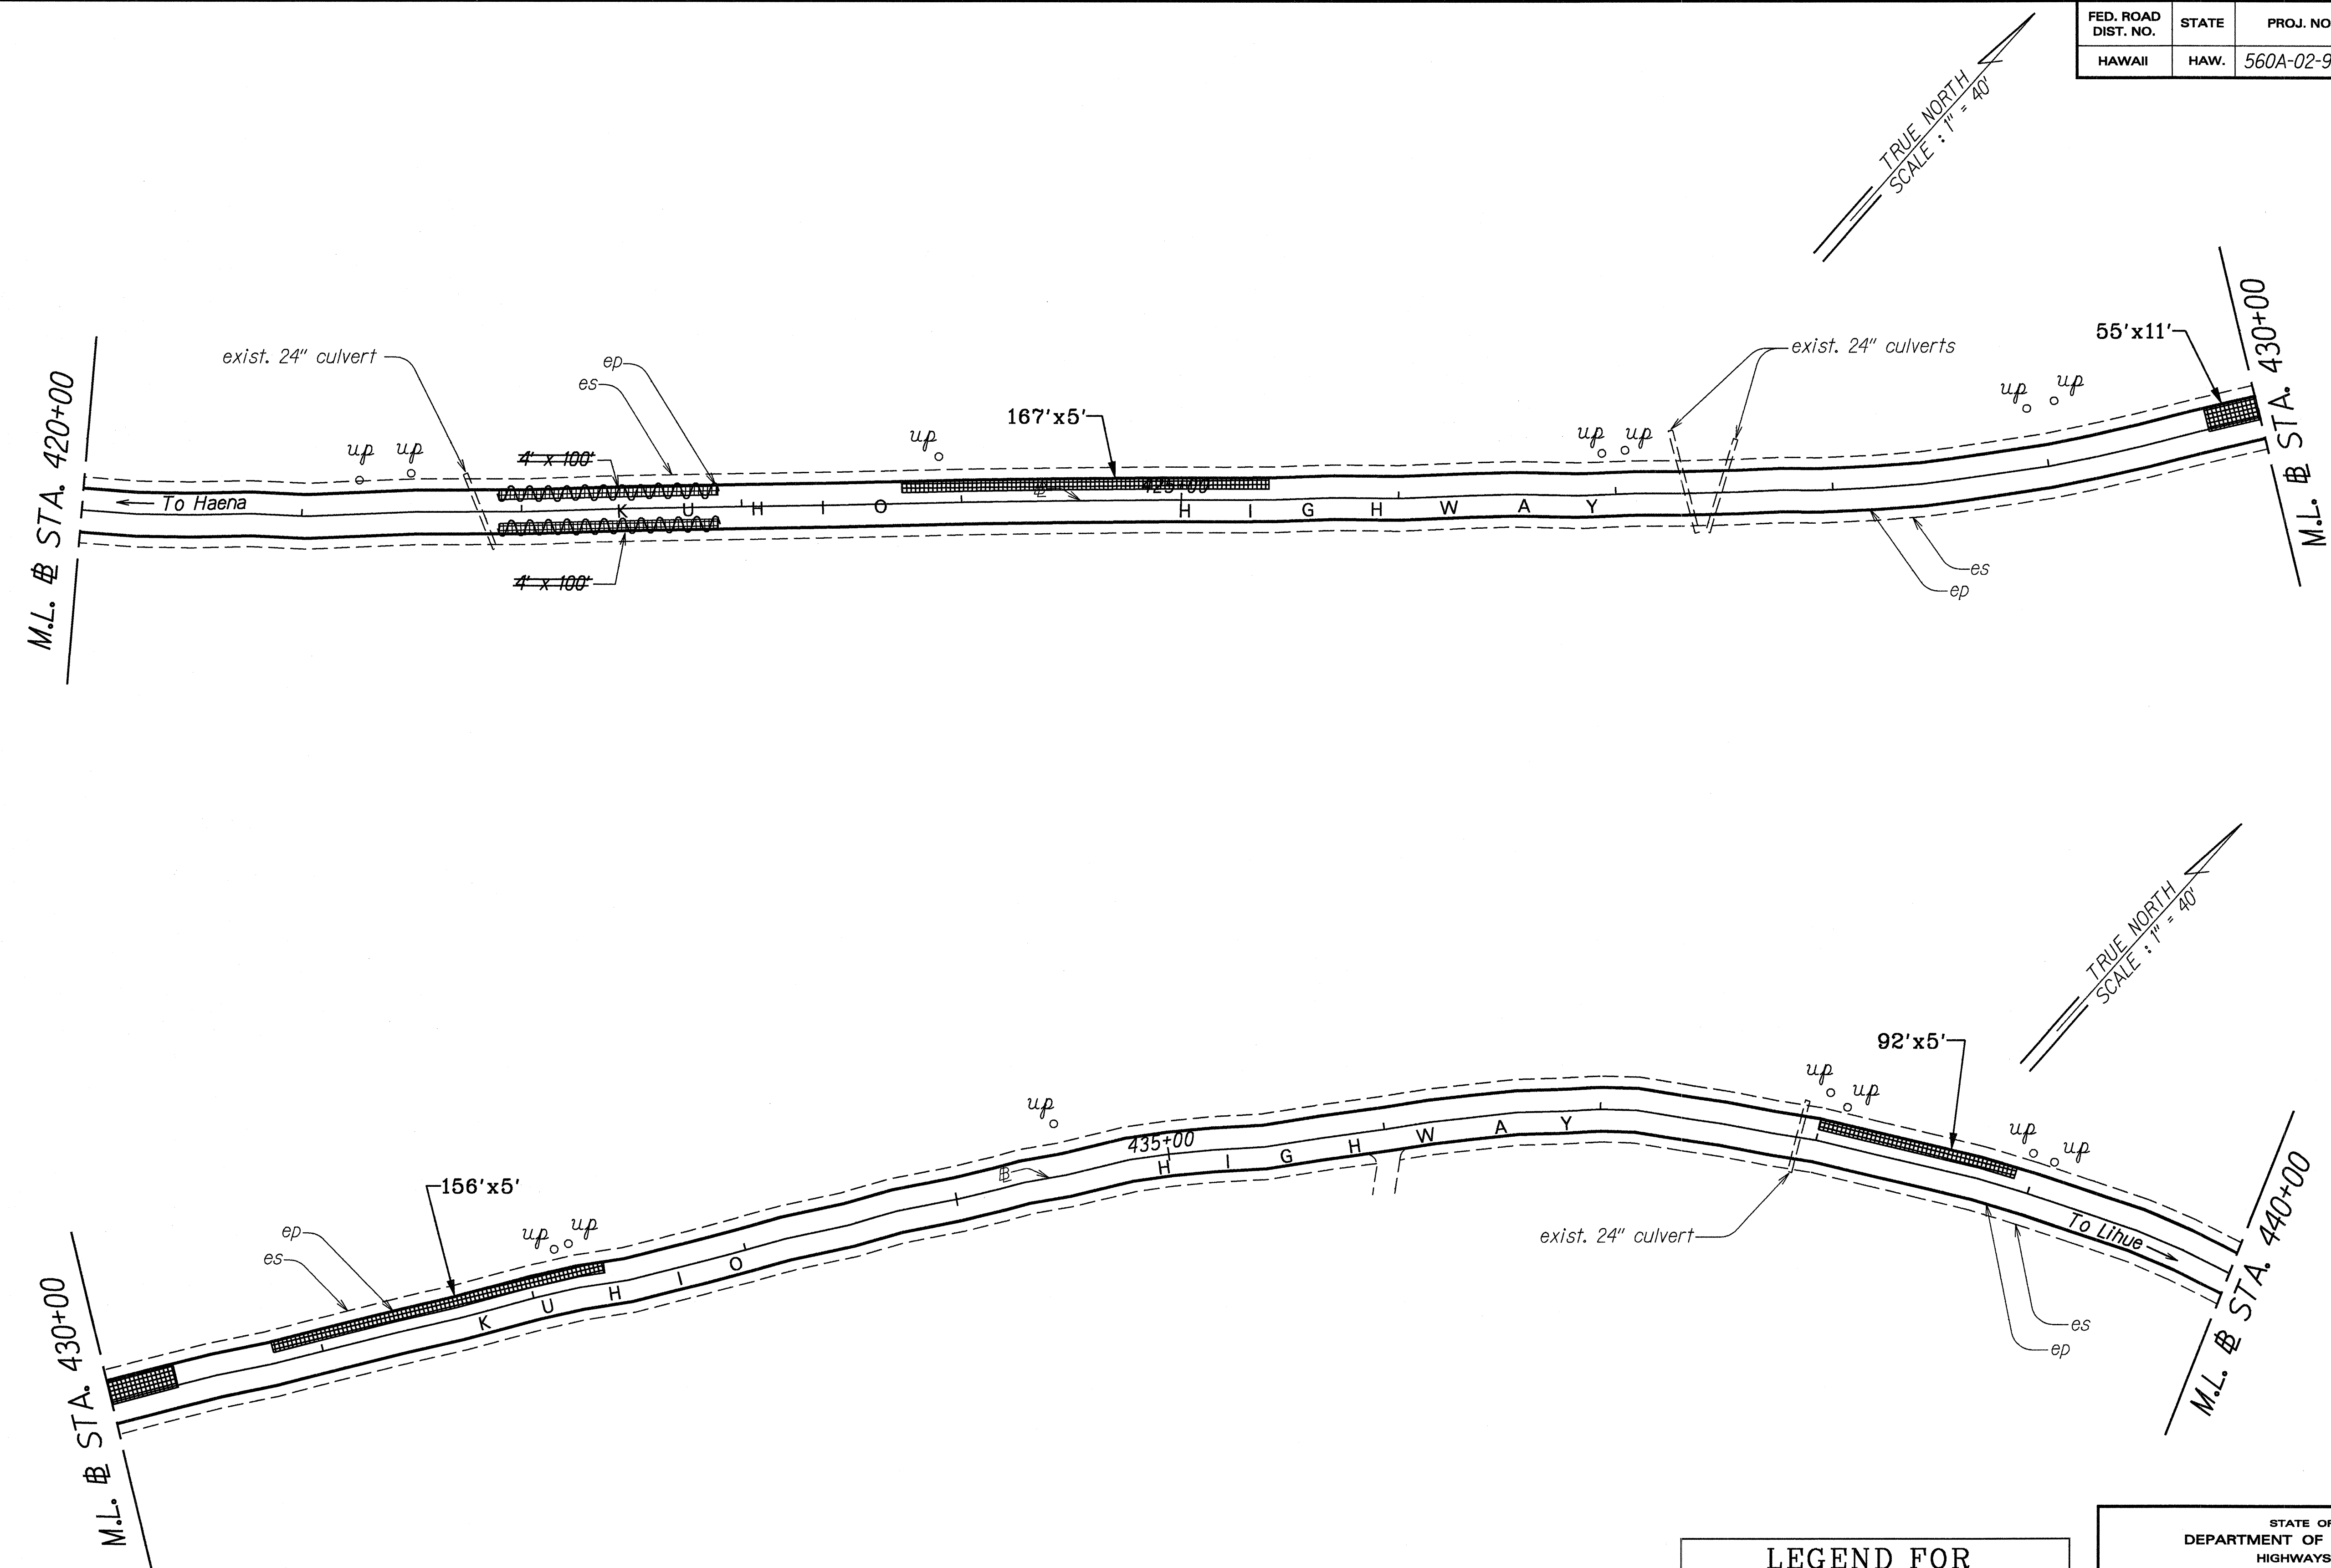

ORIGINAL PLAN	SURVEY PLOTTED BY	DATE
NOTE BOOK	DRAWN BY	
ME-2, Gary	DESIGNED BY	
Naohiko	CHECKED BY	

LEGEND FOR AS-BUILT POSTINGS	
	Squiggly line for as-built deletion
	Double line for as-built deletion
Roadway	Text for as-built posting

STATE OF HAWAII
DEPARTMENT OF TRANSPORTATION
HIGHWAYS DIVISION

ROADWAY PLAN


KUHIO HIGHWAY RESURFACING
Hanalei Town To Princeville
Project No. 560A-02-96M

Scale: 1" = 40' Date: April, 1996

SHEET No. 2 OF 7 SHEETS

"AS-BUILT"

FED. ROAD DIST. NO.	STATE	PROJ. NO.	FISCAL YEAR	SHEET NO.	TOTAL SHEETS
HAWAII	HAW.	560A-02-96M	1996	9	25

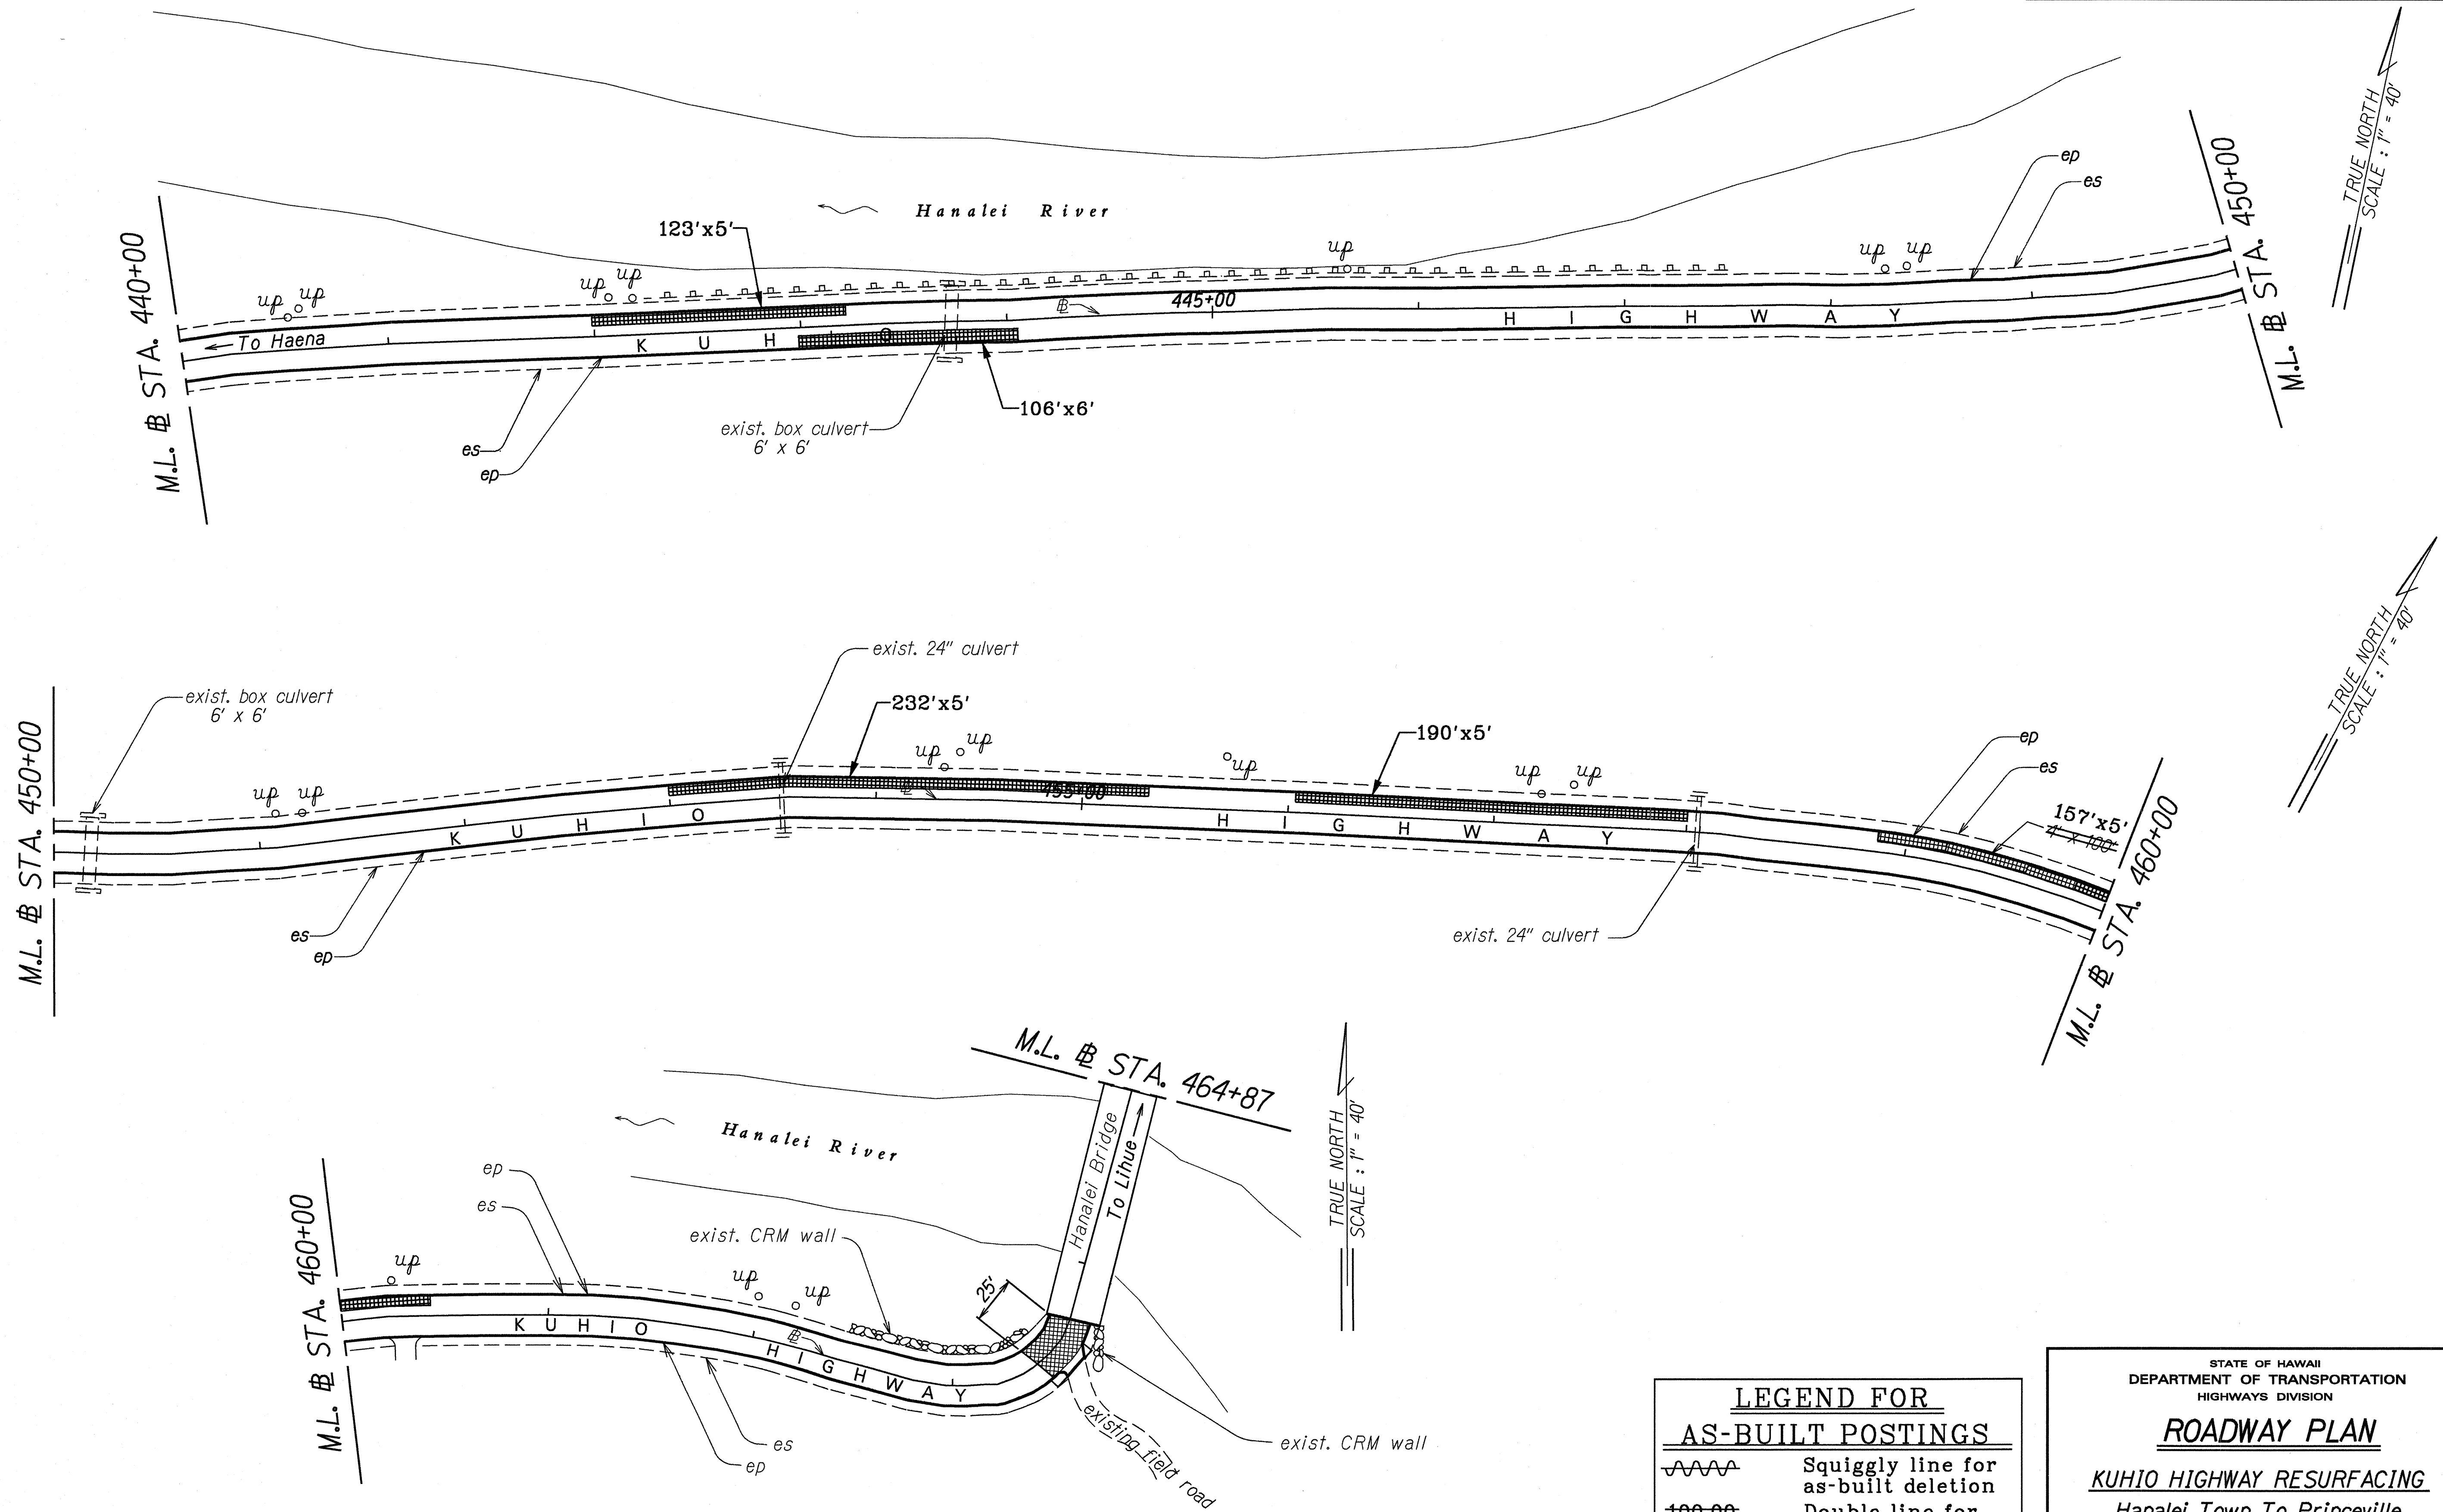

LEGEND FOR AS-BUILT POSTINGS

Squiggly line for as-built deletion

Double line for as-built deletion

Roadway Text for as-built posting

STATE OF HAWAII
DEPARTMENT OF TRANSPORTATION
HIGHWAYS DIVISION

ROADWAY PLAN

KUHIO HIGHWAY RESURFACING
Hanalei Town To Princeville
Project No. 560A-02-96M


Scale: 1" = 40' Date: April, 1996

SHEET No. 3 OF 7 SHEETS

ORIGINAL PLAN	DATE
SURVEY PLOTTED BY	
DRAWN BY	
DESIGNED BY	
QUANTITIES BY	
CHECKED BY	

"AS-BUILT"

FED. ROAD DIST. NO.	STATE	PROJ. NO.	FISCAL YEAR	SHEET NO.	TOTAL SHEETS
HAWAII	HAW.	560A-02-96M	1996	10	25

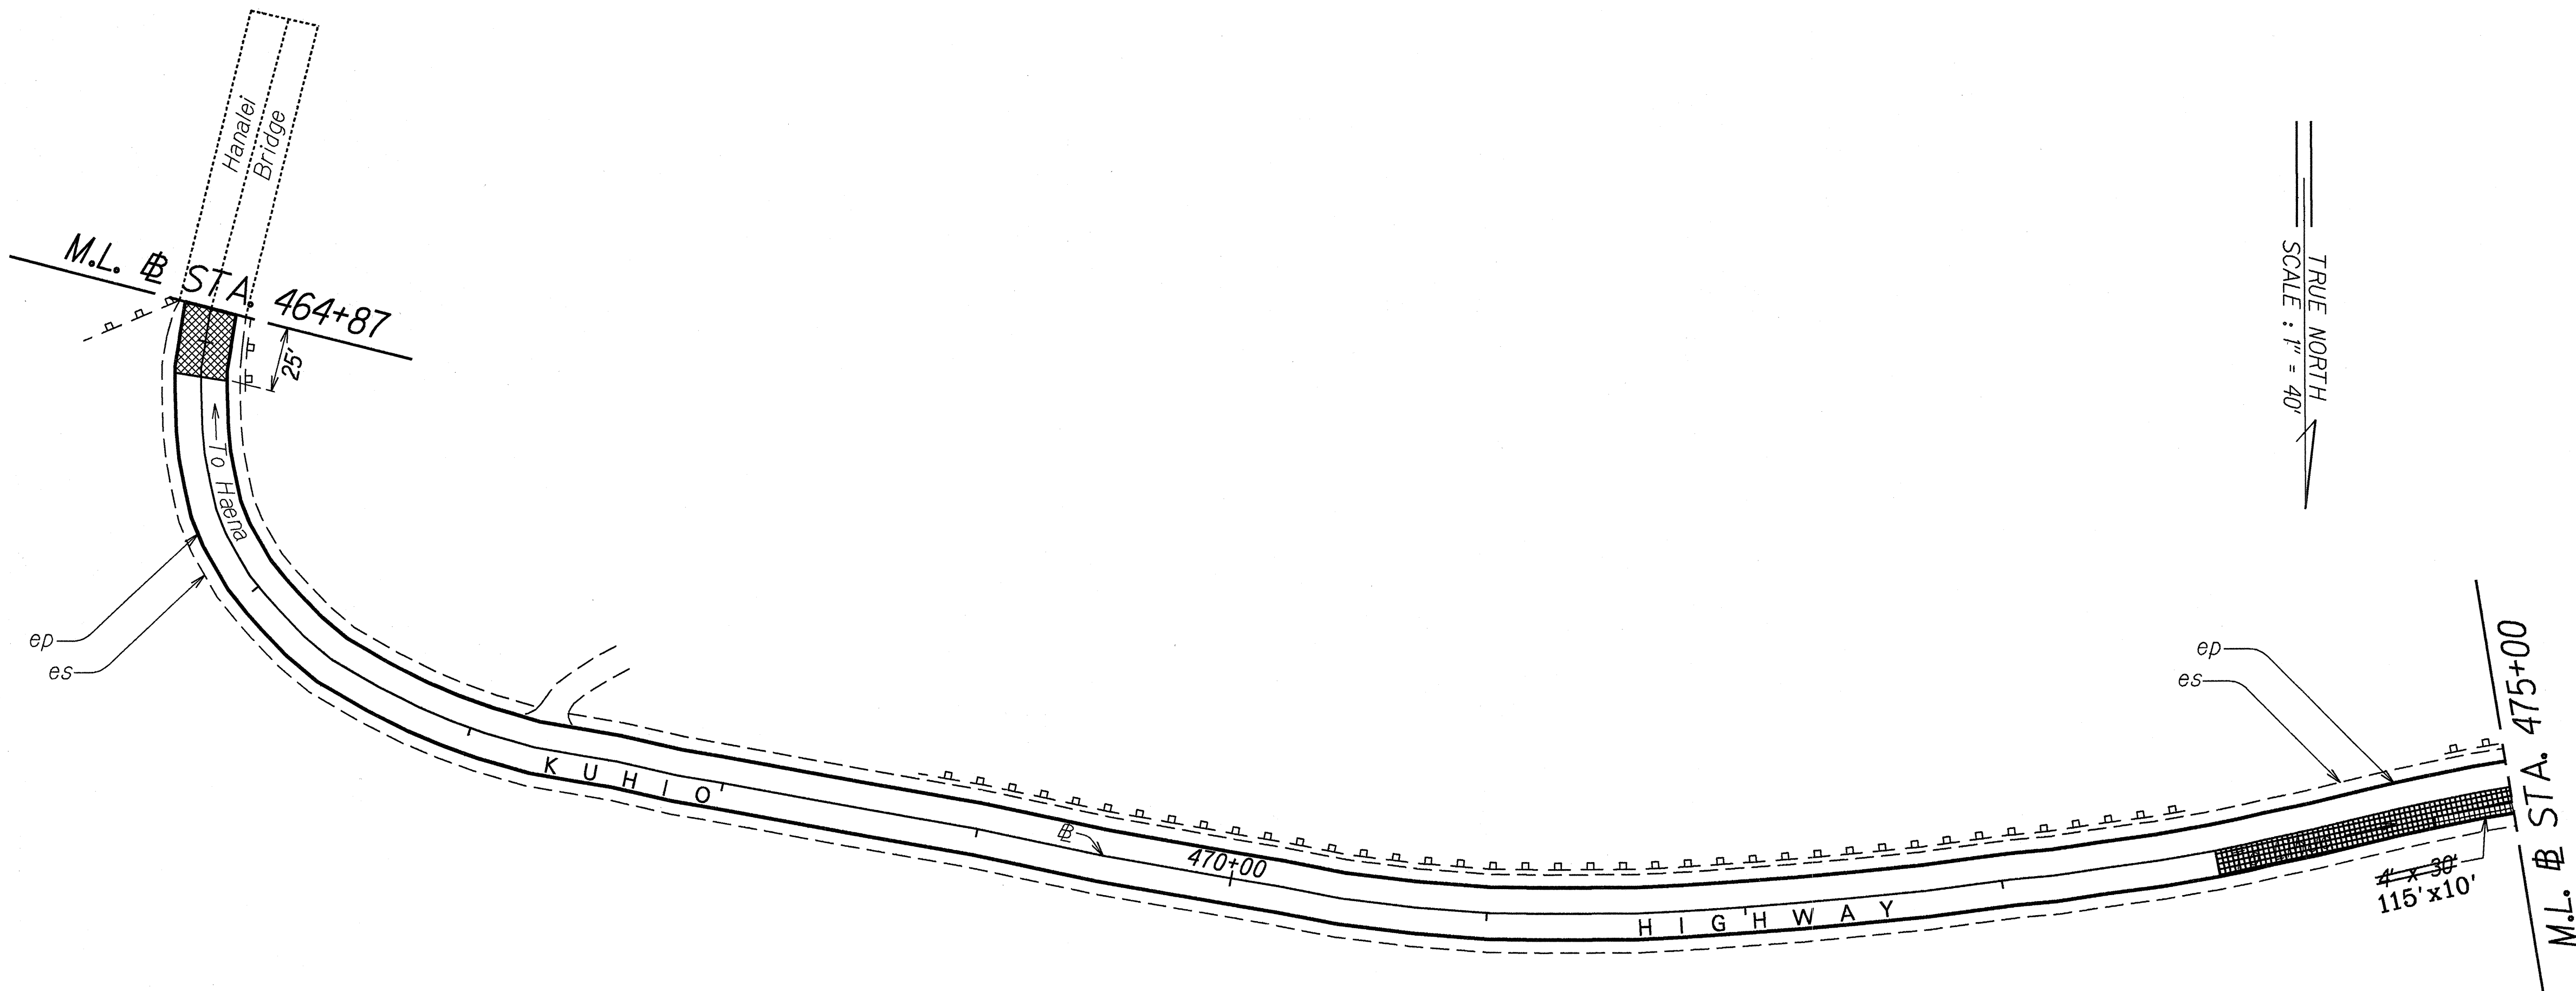

ORIGINAL PLAN	SURVEY PLOTTED BY	DATE
NOTE BOOK	DRAWN BY HWK	X
ME-2, Gary	CHECKED BY HWK	
N. Chulupoff	CHECKED BY	

LEGEND FOR AS-BUILT POSTINGS	
	Squiggly line for as-built deletion
	Double line for as-built deletion
Roadway	Text for as-built posting



STATE OF HAWAII
DEPARTMENT OF TRANSPORTATION
HIGHWAYS DIVISION

ROADWAY PLAN
KUHI O HIGHWAY RESURFACING
Hanalei Town To Princeville
Project No. 560A-02-96M

Scale: 1" = 40'
Date: April, 1996

SHEET No. 4 OF 7 SHEETS

FED. ROAD DIST. NO.	STATE	PROJ. NO.	FISCAL YEAR	SHEET NO.	TOTAL SHEETS
HAWAII	HAW.	560A-02-96M	1996	11	25

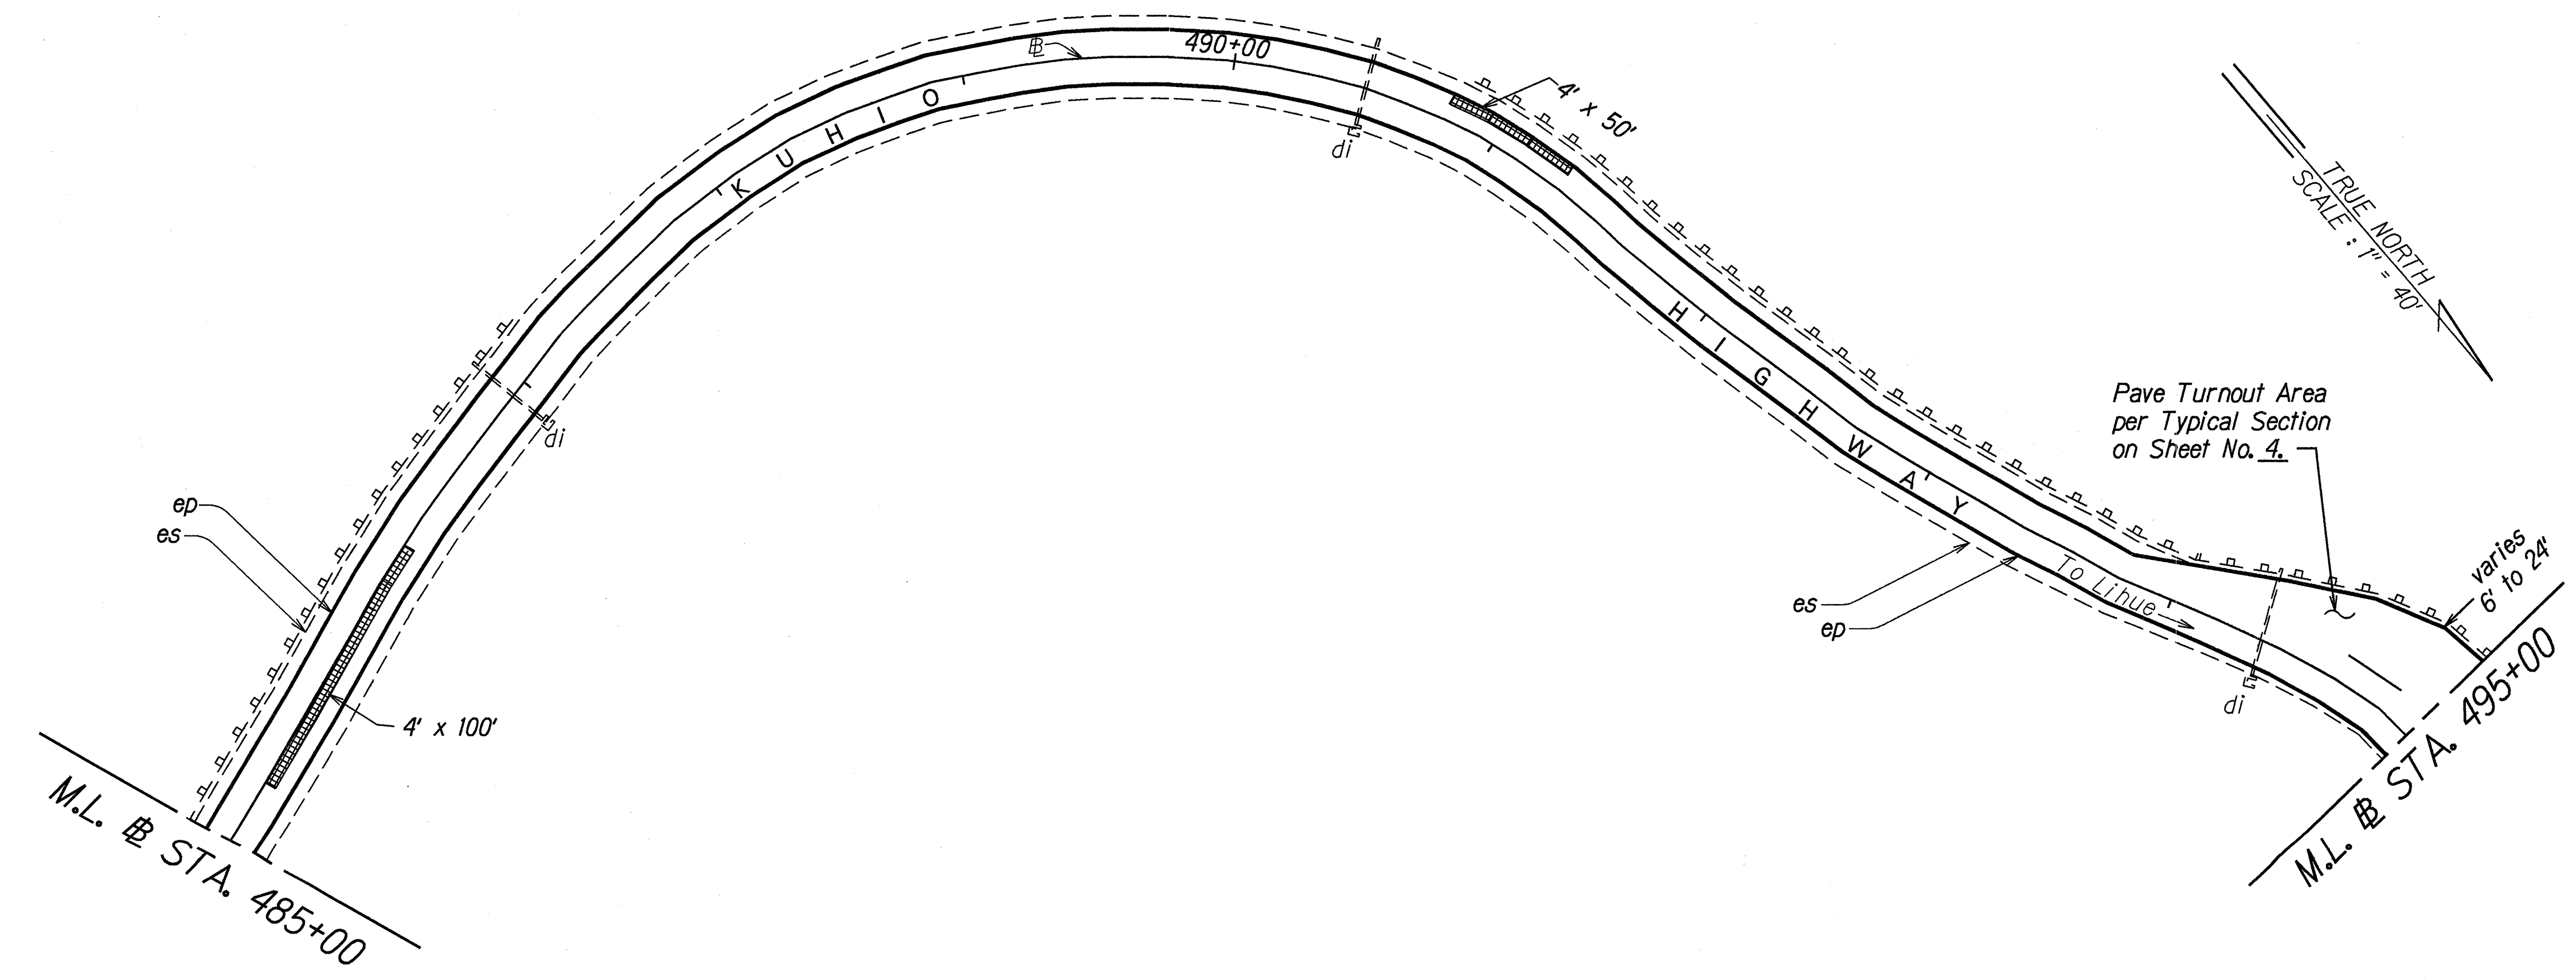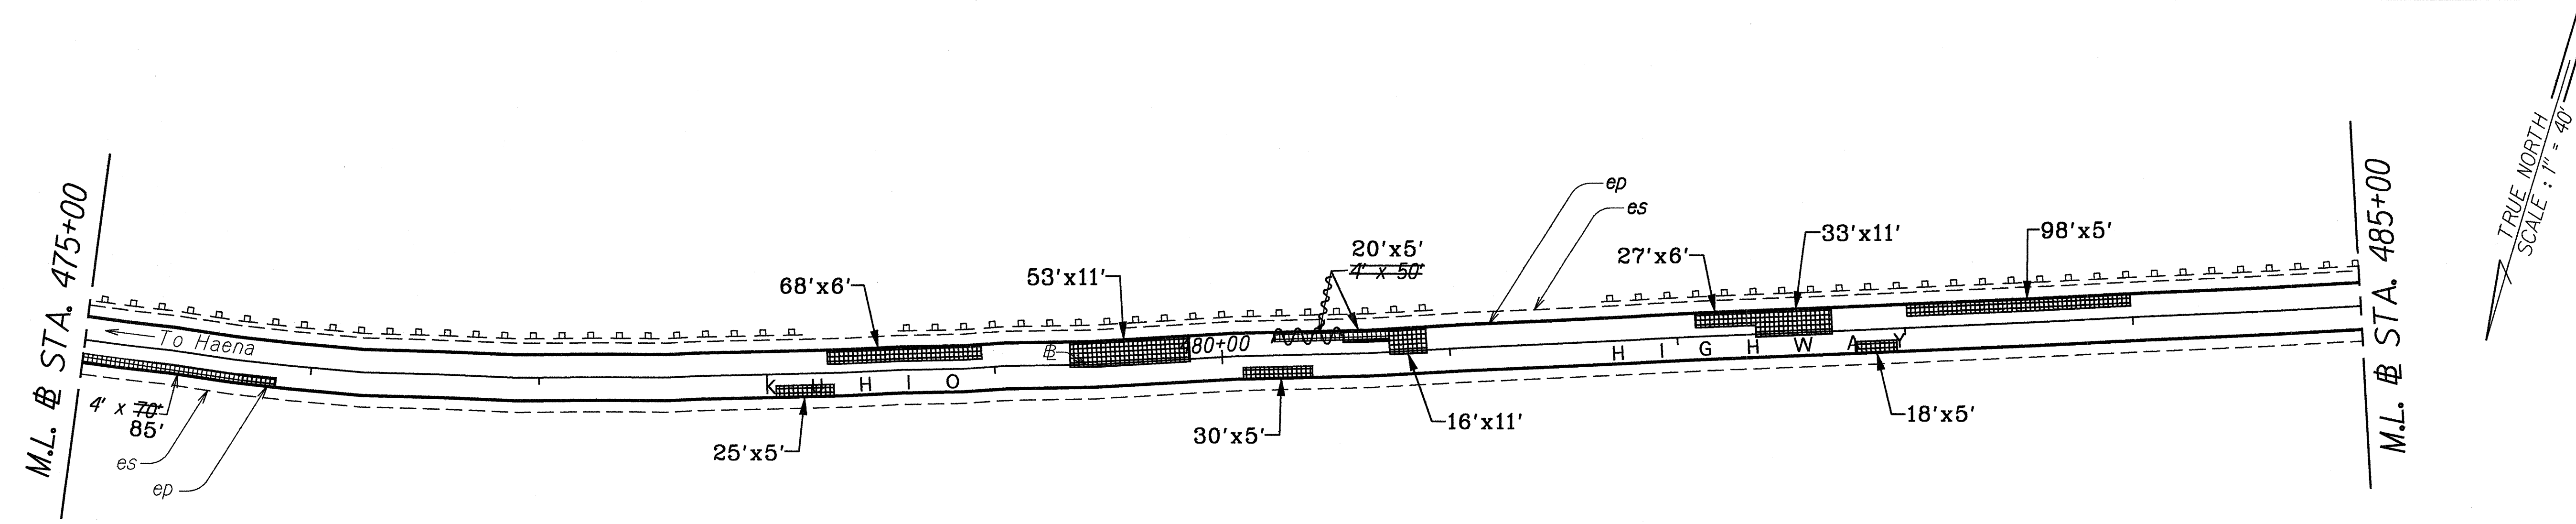

LEGEND FOR AS-BUILT POSTINGS	
	Squiggly line for as-built deletion
	Double line for as-built deletion
Roadway	Text for as-built posting

STATE OF HAWAII
DEPARTMENT OF TRANSPORTATION
HIGHWAYS DIVISION

ROADWAY PLAN

KUHIO HIGHWAY RESURFACING
Hanalei Town To Princeville
Project No. 560A-02-96M

Scale: 1" = 40' Date: April, 1996

SHEET No. 5 OF 7 SHEETS

ORIGINAL PLAN	SURVEY PLOTTED BY	DATE
NOTE BOOK	DRAWN BY	
KE-2, Gary	DESIGNED BY	
N. duhuapob	CHECKED BY	

"AS-BUILT"

FED. ROAD DIST. NO.	STATE	PROJ. NO.	FISCAL YEAR	SHEET NO.	TOTAL SHEETS
HAWAII	HAW.	560A-02-96M	1996	13	25


Sta.520+20± o/s 13.67' Lt.

Demolish existing GDI
Construct: Type 61614B GDI
Install: 24" RCP, Cl. III, Concrete Collar
(For Details, See Plan Sht No. 14)


Estimated Quantities:

24" RCP, Cl. III = 2 L.F.
Type 61614B GDI = 1 Ea.
(2.00 ft to 2.99 ft)

TRUE NORTH
SCALE: 1" = 40'

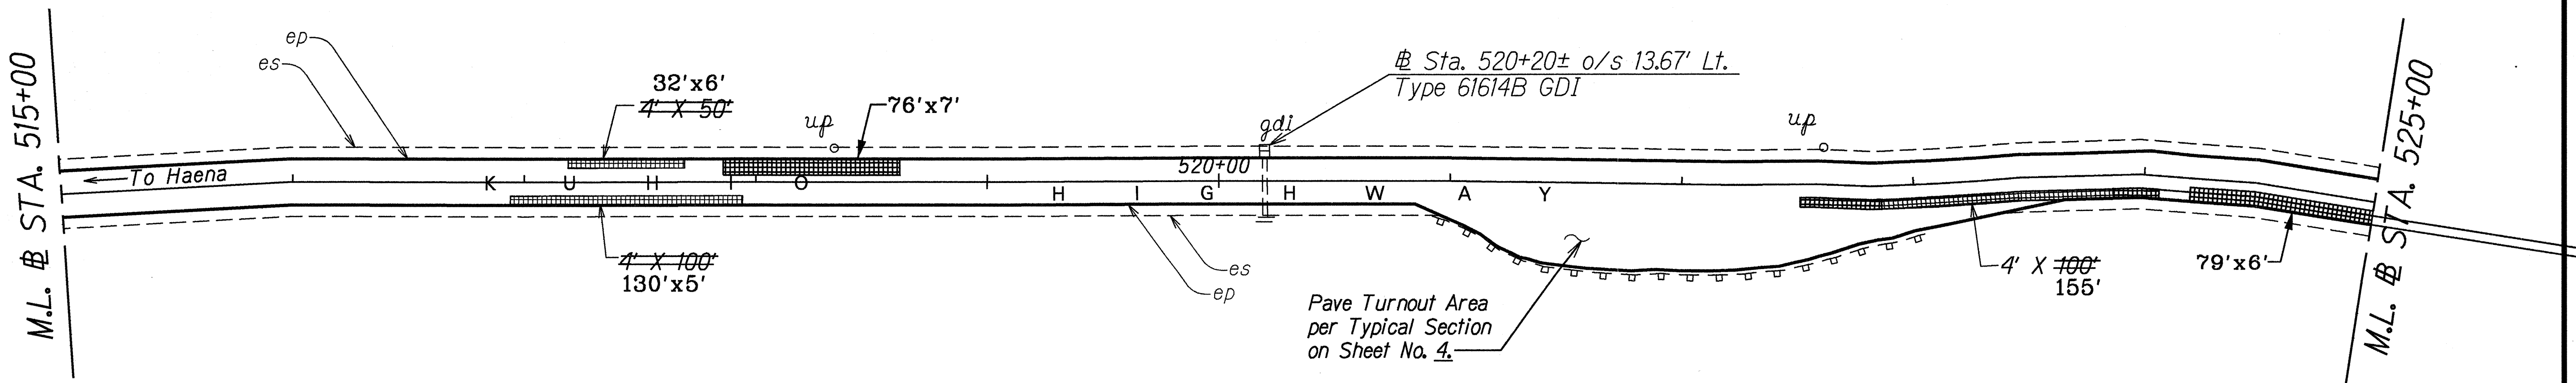

END PROJECT
Project No. 560A-02-96M
Sta.528+00±

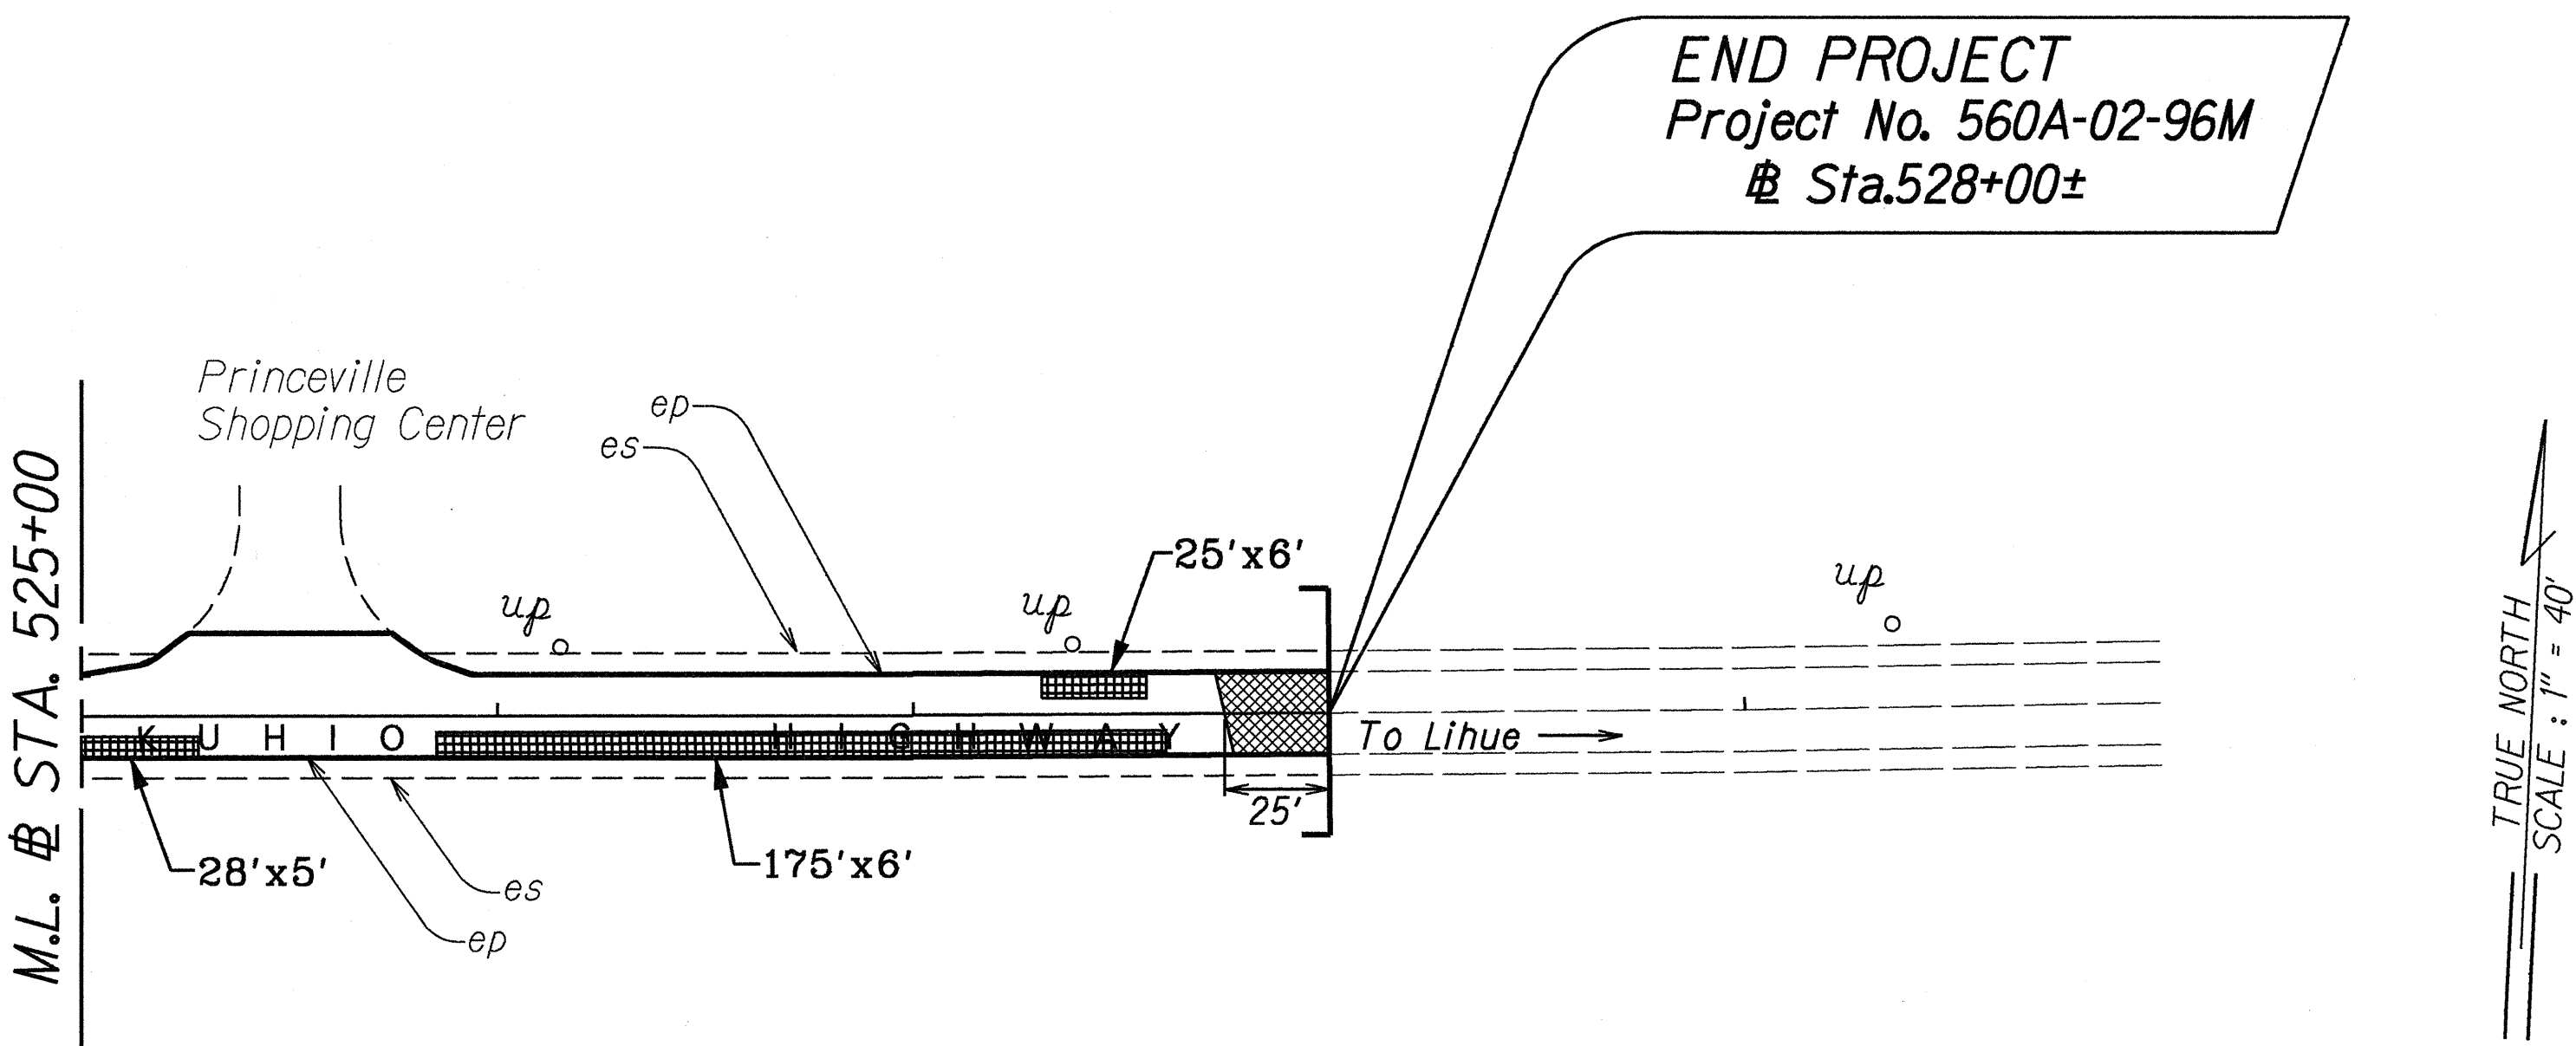

LEGEND FOR AS-BUILT POSTINGS	
	Squiggly line for as-built deletion
	Double line for as-built deletion
Roadway	Text for as-built posting

STATE OF HAWAII
DEPARTMENT OF TRANSPORTATION
HIGHWAYS DIVISION
ROADWAY PLAN
KUHIO HIGHWAY RESURFACING
Hanalei Town To Princeville
Project No. 560A-02-96M
Scale: 1" = 40' Date: April, 1996
SHEET No. 7 OF 7 SHEETS

ORIGINAL PLAN	SURVEY PLOTTED BY	DATE
NOTE BOOK	DRAWN BY	
KE-2, Gary	DESIGNED BY	
NA, Nuhou	CHECKED BY	

"AS-BUILT"