








FED. ROAD DIST. NO.	STATE	PROJ. NO.	FISCAL YEAR	SHEET NO.	TOTAL SHEETS
HAWAII	HAW.	560A-02-96M	1996	23	25

TRAFFIC SIGN SUMMARY					
SIGN NO.	MESSAGE	QUANTITY			
		10 SQ. FT. OR LESS		GREATER THAN 10 SQ. FT.	
		W/POST	W/O POST	W/POSTS	W/O POST
R1-1	STOP	3			
R1-2	YIELD	2			
R2-1(25)	SPEED LIMIT 25			1	
R2-1(35)	SPEED LIMIT 35			4	
R2-5b(25)	REDUCED SPEED 25			1	
R4-1	DO NOT PASS	1			
R12-1	WEIGHT LIMIT 12 TONS	2			
W1-2(L)		3			
W1-2(R)		3			
W3-2a		2			
W5-3	ONE LANE BRIDGE	4			
W5-3A(1/2)	1/2 MILE 0.8 km		2		
W6-1		1			
W8-5		2			
W12-2	14'-6" (Height limit)	2			
W13-1(10)	10 MPH ADVISORY SPEED LIMIT		2		
W13-1(15)	15 MPH ADVISORY SPEED LIMIT		2		
W13-1(25)	25 MPH ADVISORY SPEED LIMIT		2		
W14-3	NO PASSING ZONE	2			
W15-3	FALLING ROCKS	2			
I-11	TO ON COMING TRAFFIC		2		
	TOTAL	29	10	6	0


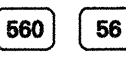



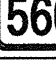
NOTE: Bold letters denotes new signs to be installed on this project.

CONSTRUCTION SIGN SUMMARY			
SIGN NO.	MESSAGE	W/POSTS	W/O POST
CG20-2	END CONSTRUCTION	2	
CW20-1d	ROAD CONSTRUCTION AHEAD	2	
TOTAL		4	0

ROUTE MARKER SUMMARY					
SIGN ASSEMBLY	SIGN NO. AND MESSAGE	TYPE A ASSEMBLY		TYPE B ASSEMBLY	
		W/POST	W/O POST	W/POST	W/O POST
B	M4-11   M4-12 M1-6(560)   M1-6(56)			1	
A	M1-6(56) 	2			
	TOTAL	2	0	1	0

REFLECTOR MARKER SUMMARY					
TYPE	QUANTITY				
	W/O POST		W/STEEL POST		W/FLEXIBLE POST TYPE B
	YELLOW	WHITE	YELLOW	WHITE	
RM-1				4	
RM-2				33	
RM-3	44				
RM-4(L)			2		
RM-4(R)			2		
TYPE II OBJECT MARKER*	*50		17		32

* All objects (utility poles or trees) that are within the State highway right-of-way and within 30 feet of the roadway edge of pavement shall be marked as directed by the Engineer.

MILEPOST MARKER SUMMARY			
SIGN ASSEMBLY	SIGN NO. AND MESSAGE	QUANTITY	
		BI-DIRECTIONAL W/POST	W/O POST
	D10-1  D10-7 	1	
	D10-1  D10-7 	1	
	D10-1  D10-7 	1	
	TOTAL	3	0

ORIGINAL PLAN	SURVEY PLOTTED BY	DATE
DATE	DRAWN BY	DATE
DATE	TRACED BY	DATE
DATE	DESIGNED BY	DATE
DATE	CHECKED BY	DATE
DATE	CHECKED BY	DATE

DESTINATION SIGN SUMMARY					
SIGN NO.	LOCATION	MESSAGE	SIZE	OVERLAY AREA (SQ. FT.)	NEW PANEL AREA (SQ. FT.)
					W/O POSTS W/POSTS
D-1	Sta. 524 + 25	➔ SCENIC OVERLOOK	4' - 6" X 3' - 6"		15.75 SQ. FT.
D-2	Sta. 519 + 40	➔ SCENIC OVERLOOK	4' - 6" X 3' - 6"		15.75 SQ. FT.
D-3	Sta. 511 + 00	SCENIC OVERLOOK 1000 FT.	4' - 6" X 3' - 0"		13.5 SQ. FT.
			TOTAL		45 SQ. FT.

STATE OF HAWAII
DEPARTMENT OF TRANSPORTATION
HIGHWAYS DIVISION

TRAFFIC SUMMARIES

KUHIO HIGHWAY RESURFACING
Hanalei Town To Princeville
Project No. 560A-02-96M

Date: April, 1996

SHEET No. 1 OF 1 SHEETS