


FED. ROAD DIST. NO.	STATE	PROJ. NO.	FISCAL YEAR	SHEET NO.	TOTAL SHEETS
HAWAII	HAW.	560A-01-96M	1996	7	32

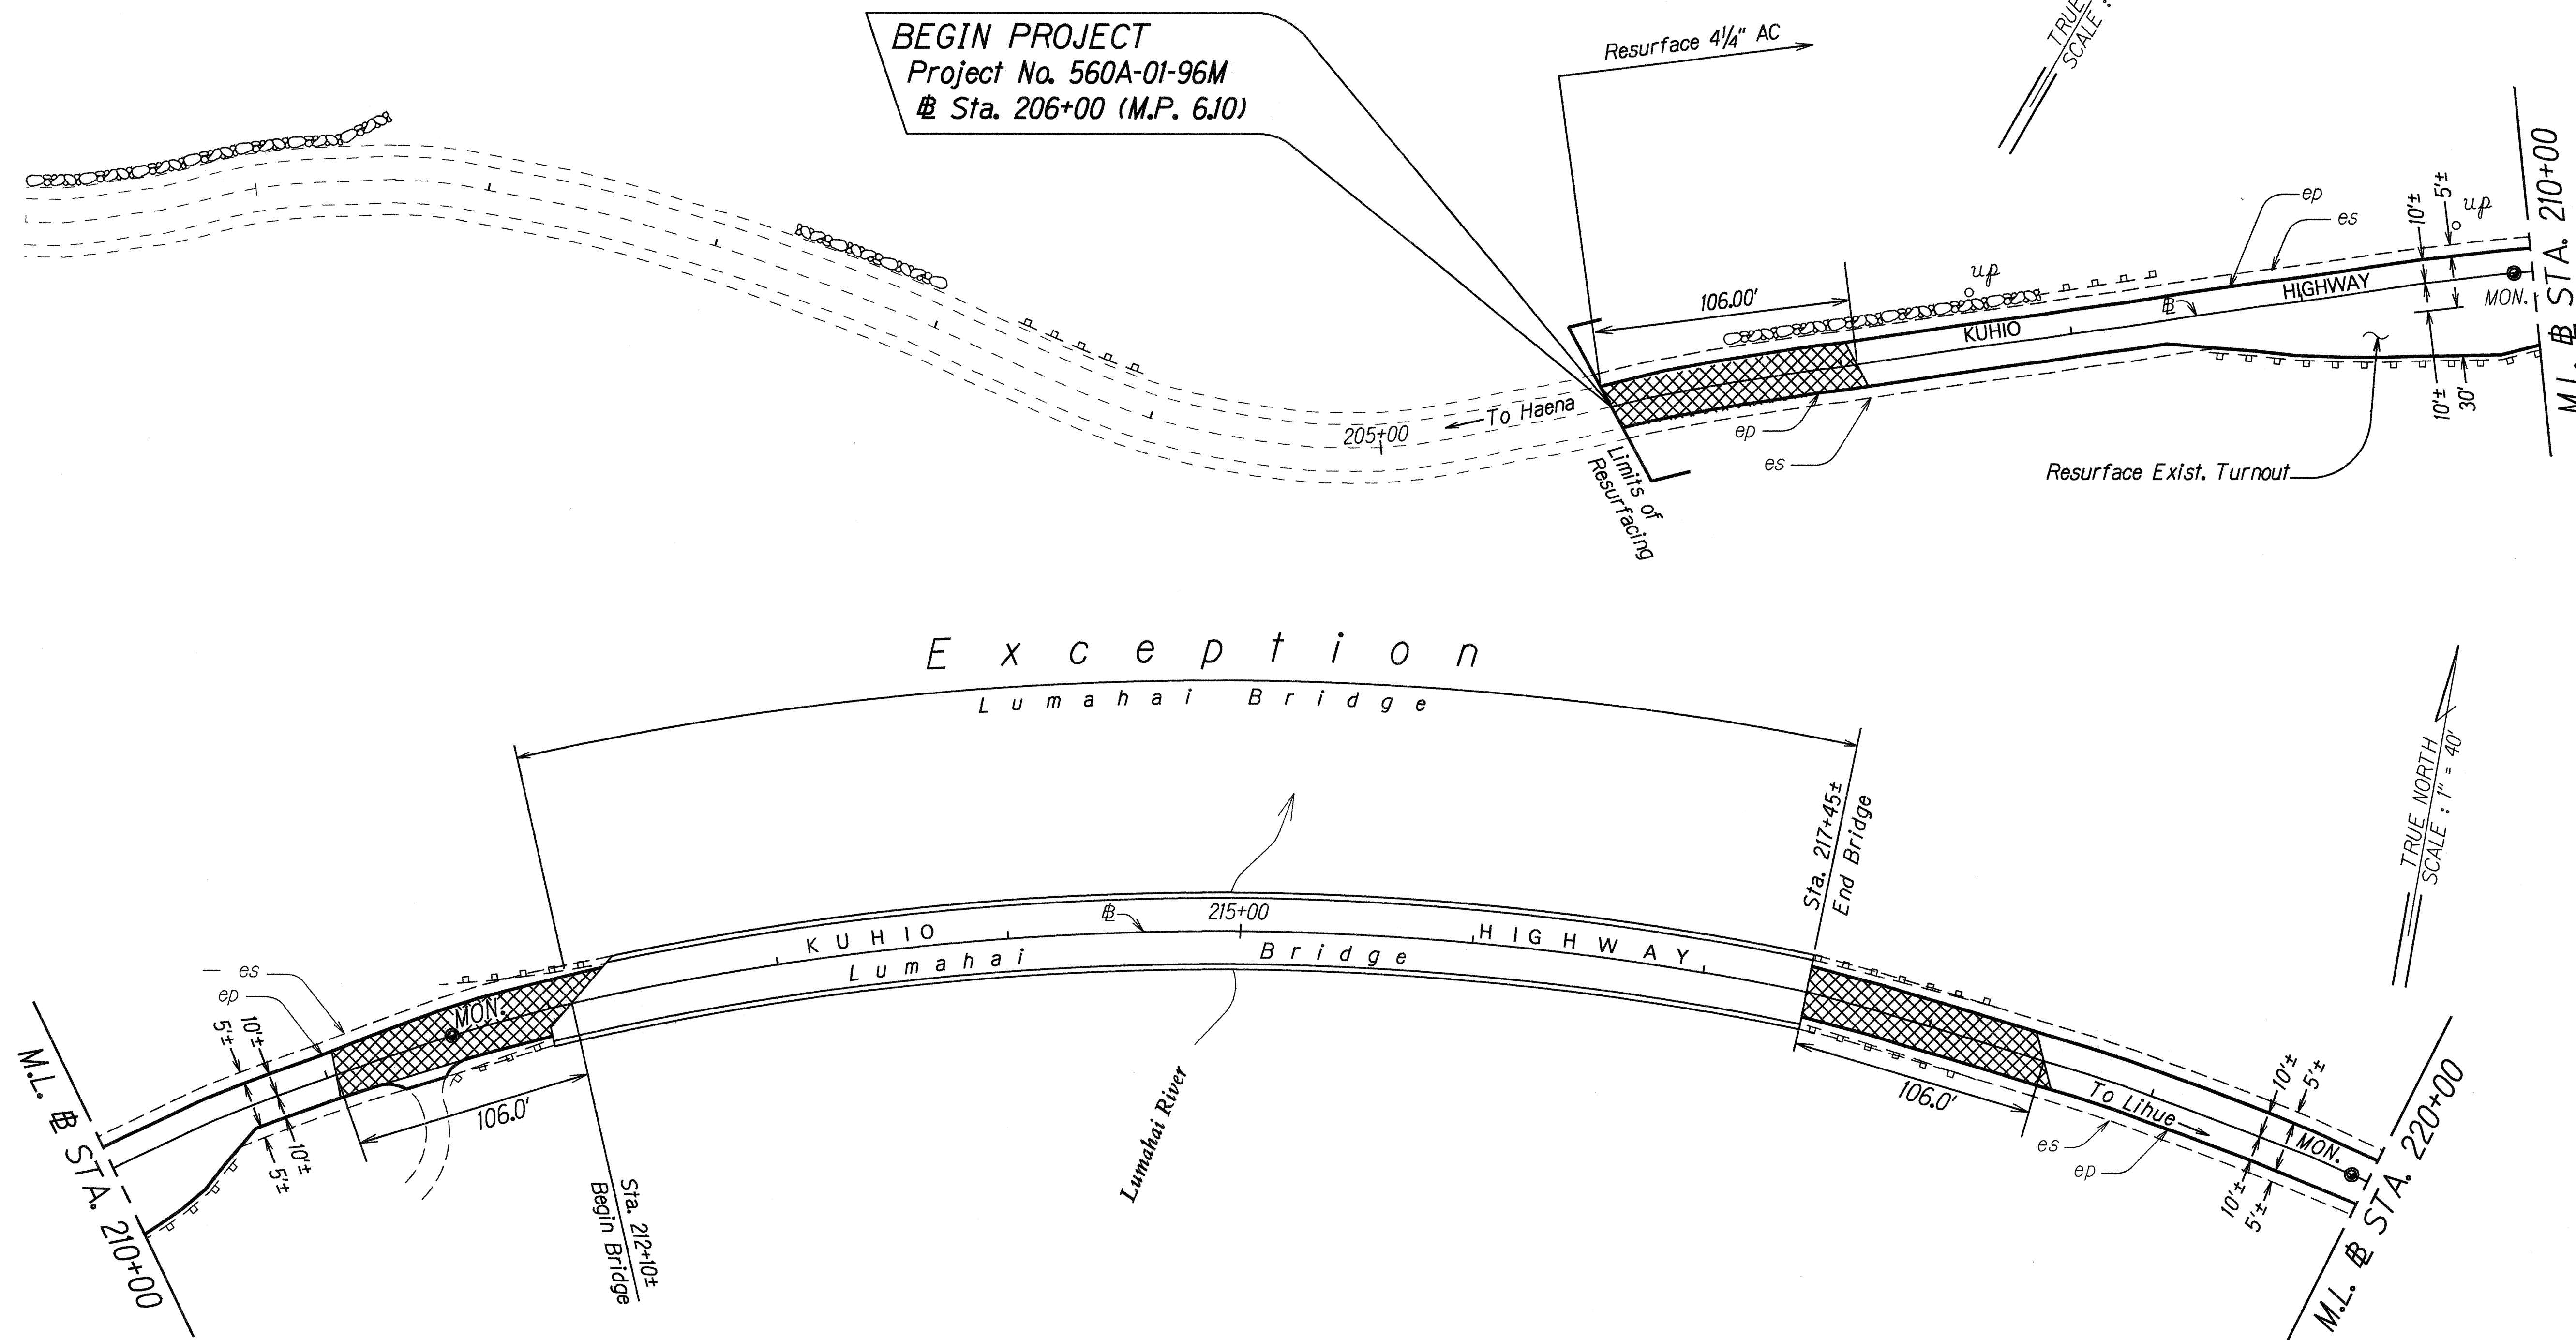

DATE	5/11/96
SURVEY PLOTTED BY	
DRAWN BY	
DESIGNED BY	WPK
CHECKED BY	
APPROVED BY	
ORIGINAL PLAN	
NOTES	
REVISIONS	
NO. 001/001	

STATE OF HAWAII
DEPARTMENT OF TRANSPORTATION
HIGHWAYS DIVISION



ROADWAY PLAN

KUHIO HIGHWAY RESURFACING
Lumamahai To Hanalei Town
Project No. 560A-01-96M

Scale: 1"=40' Date: May, 1996

SHEET No. 1 OF 11 SHEETS

FED. ROAD DIST. NO.	STATE	PROJ. NO.	FISCAL YEAR	SHEET NO.	TOTAL SHEETS
HAWAII	HAW.	560A-01-96M	1996	8	32

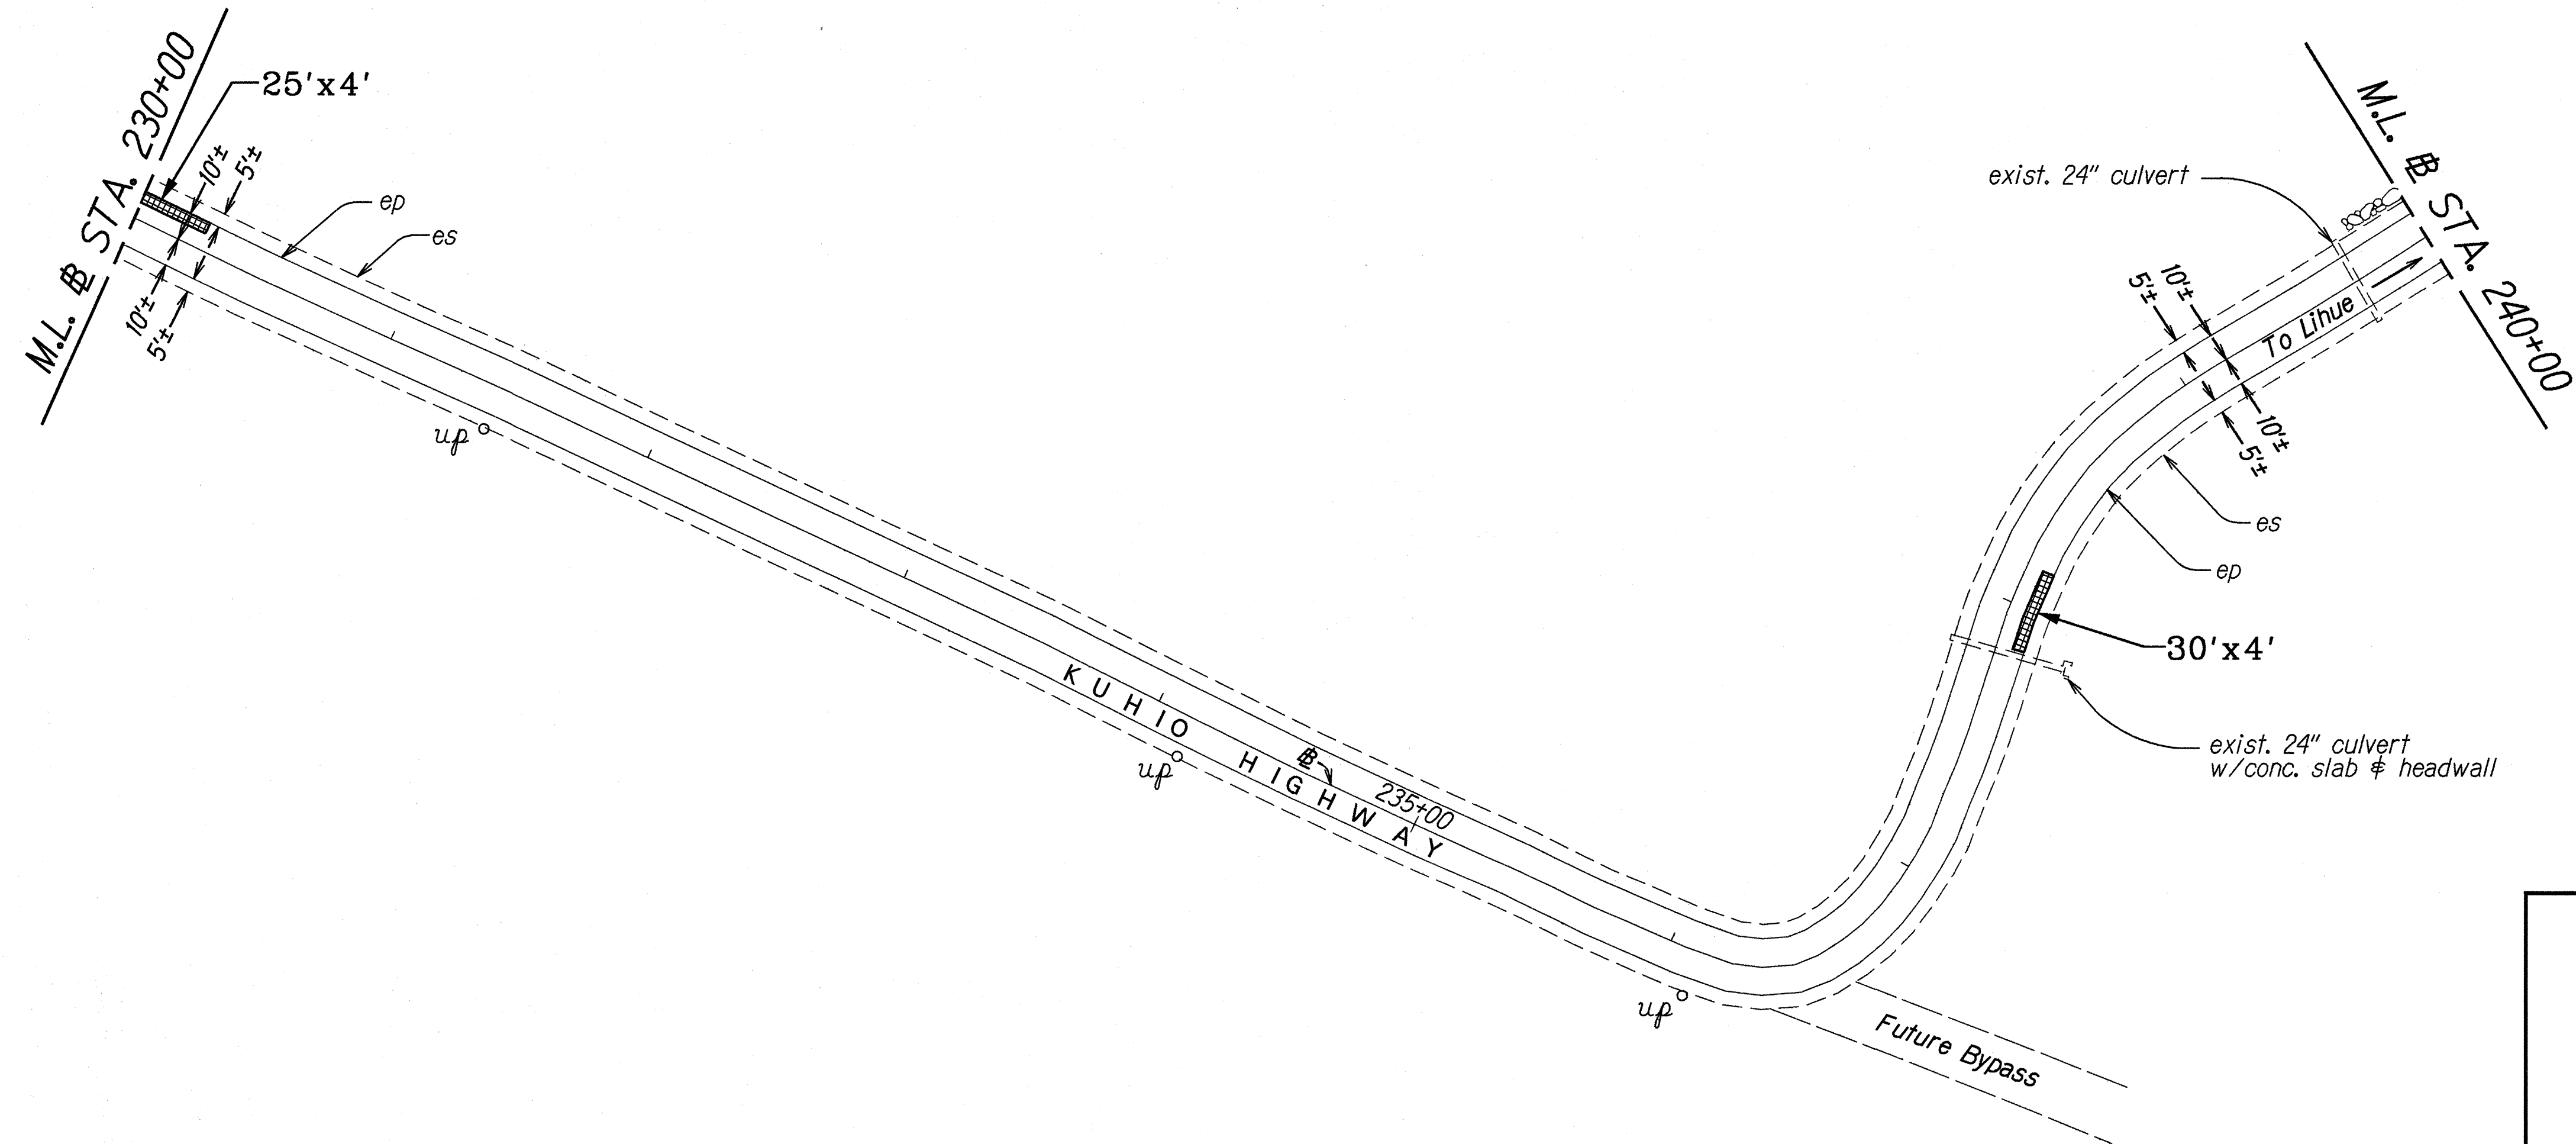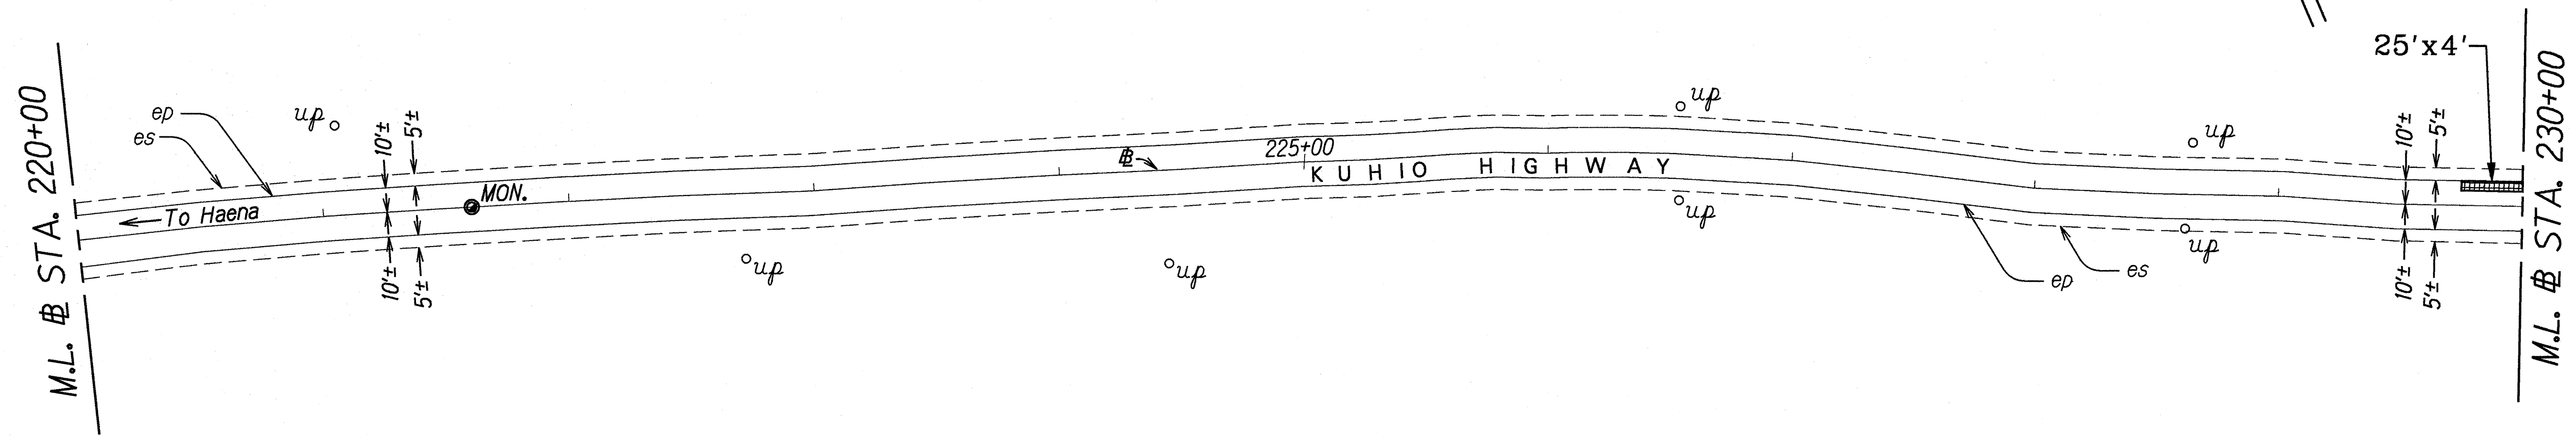

ORIGINAL PLAN	SURVEY PLOTTED BY	DATE
NOTED BY	DRAWN BY	6/20/97
Re-2, Gary N. Okunaka	HWY-K	
CHECKED BY	QUANTITIES BY	

STATE OF HAWAII
DEPARTMENT OF TRANSPORTATION
HIGHWAYS DIVISION

ROADWAY PLAN



KUHIO HIGHWAY RESURFACING
Lumahai To Hanalei Town
Project No. 560A-01-96M

Scale: 1" = 40' Date: May, 1996

SHEET No. 2 OF 11 SHEETS

"AS-BUILT"

FED. ROAD DIST. NO.	STATE	PROJ. NO.	FISCAL YEAR	SHEET NO.	TOTAL SHEETS
HAWAII	HAW.	560A-01-96M	1996	9	32

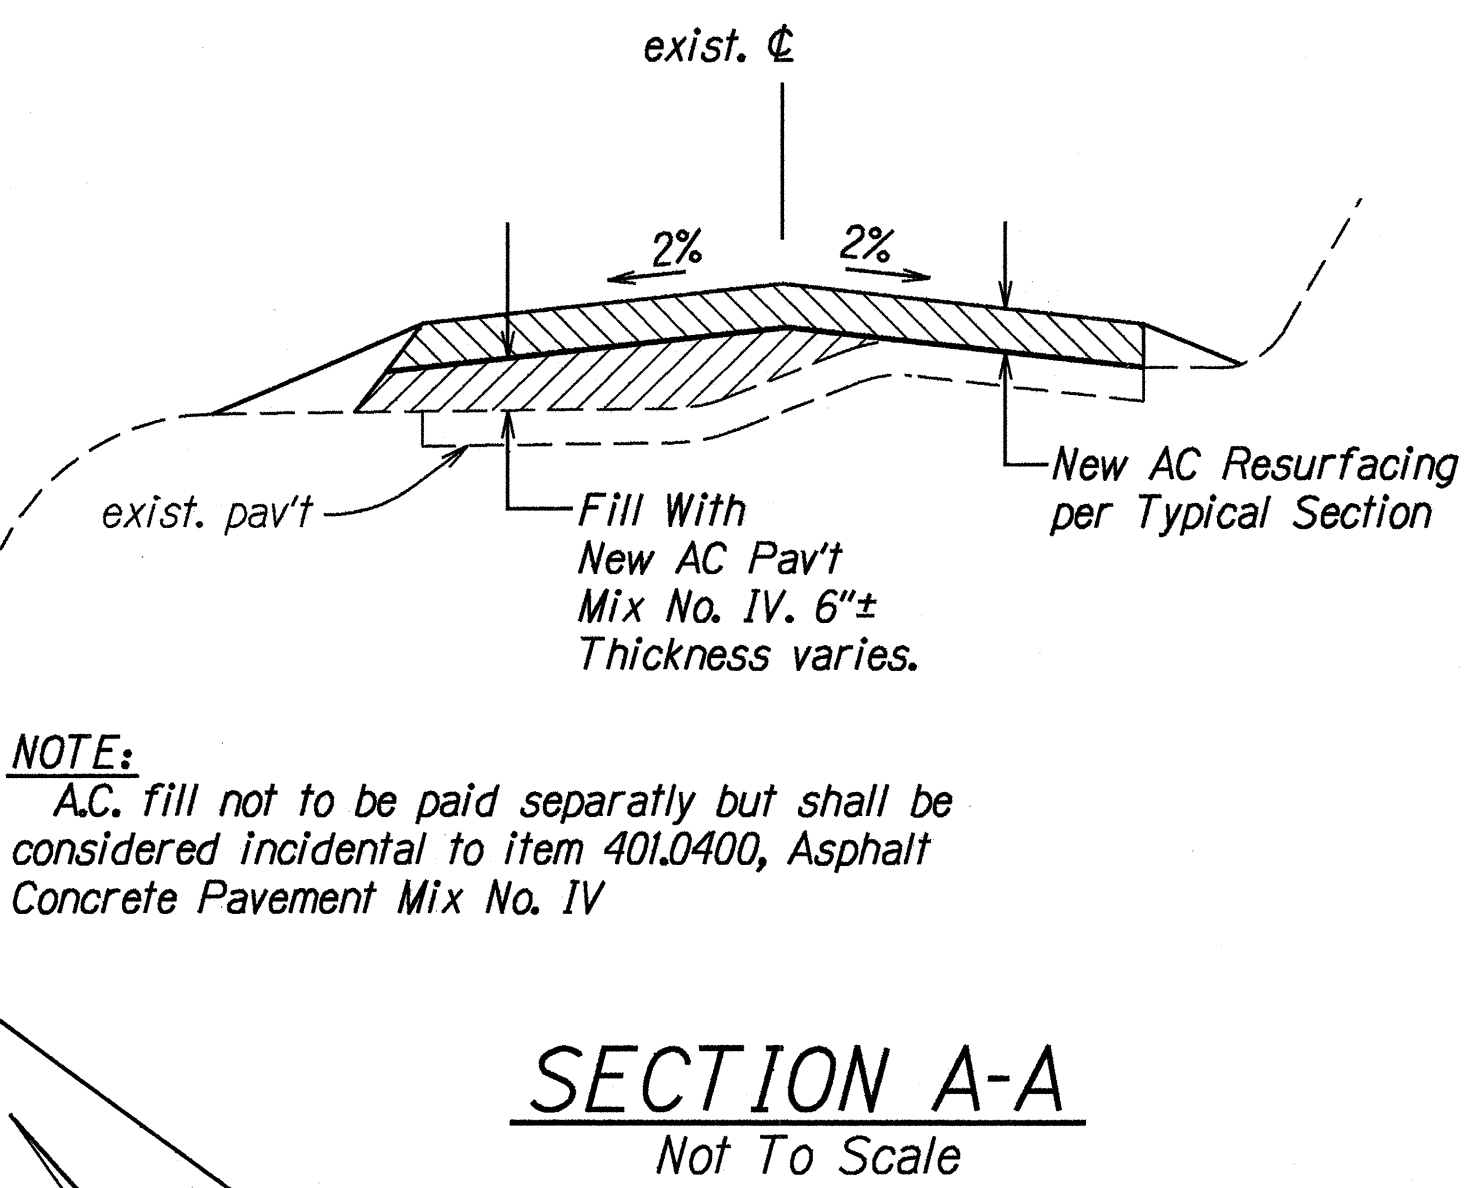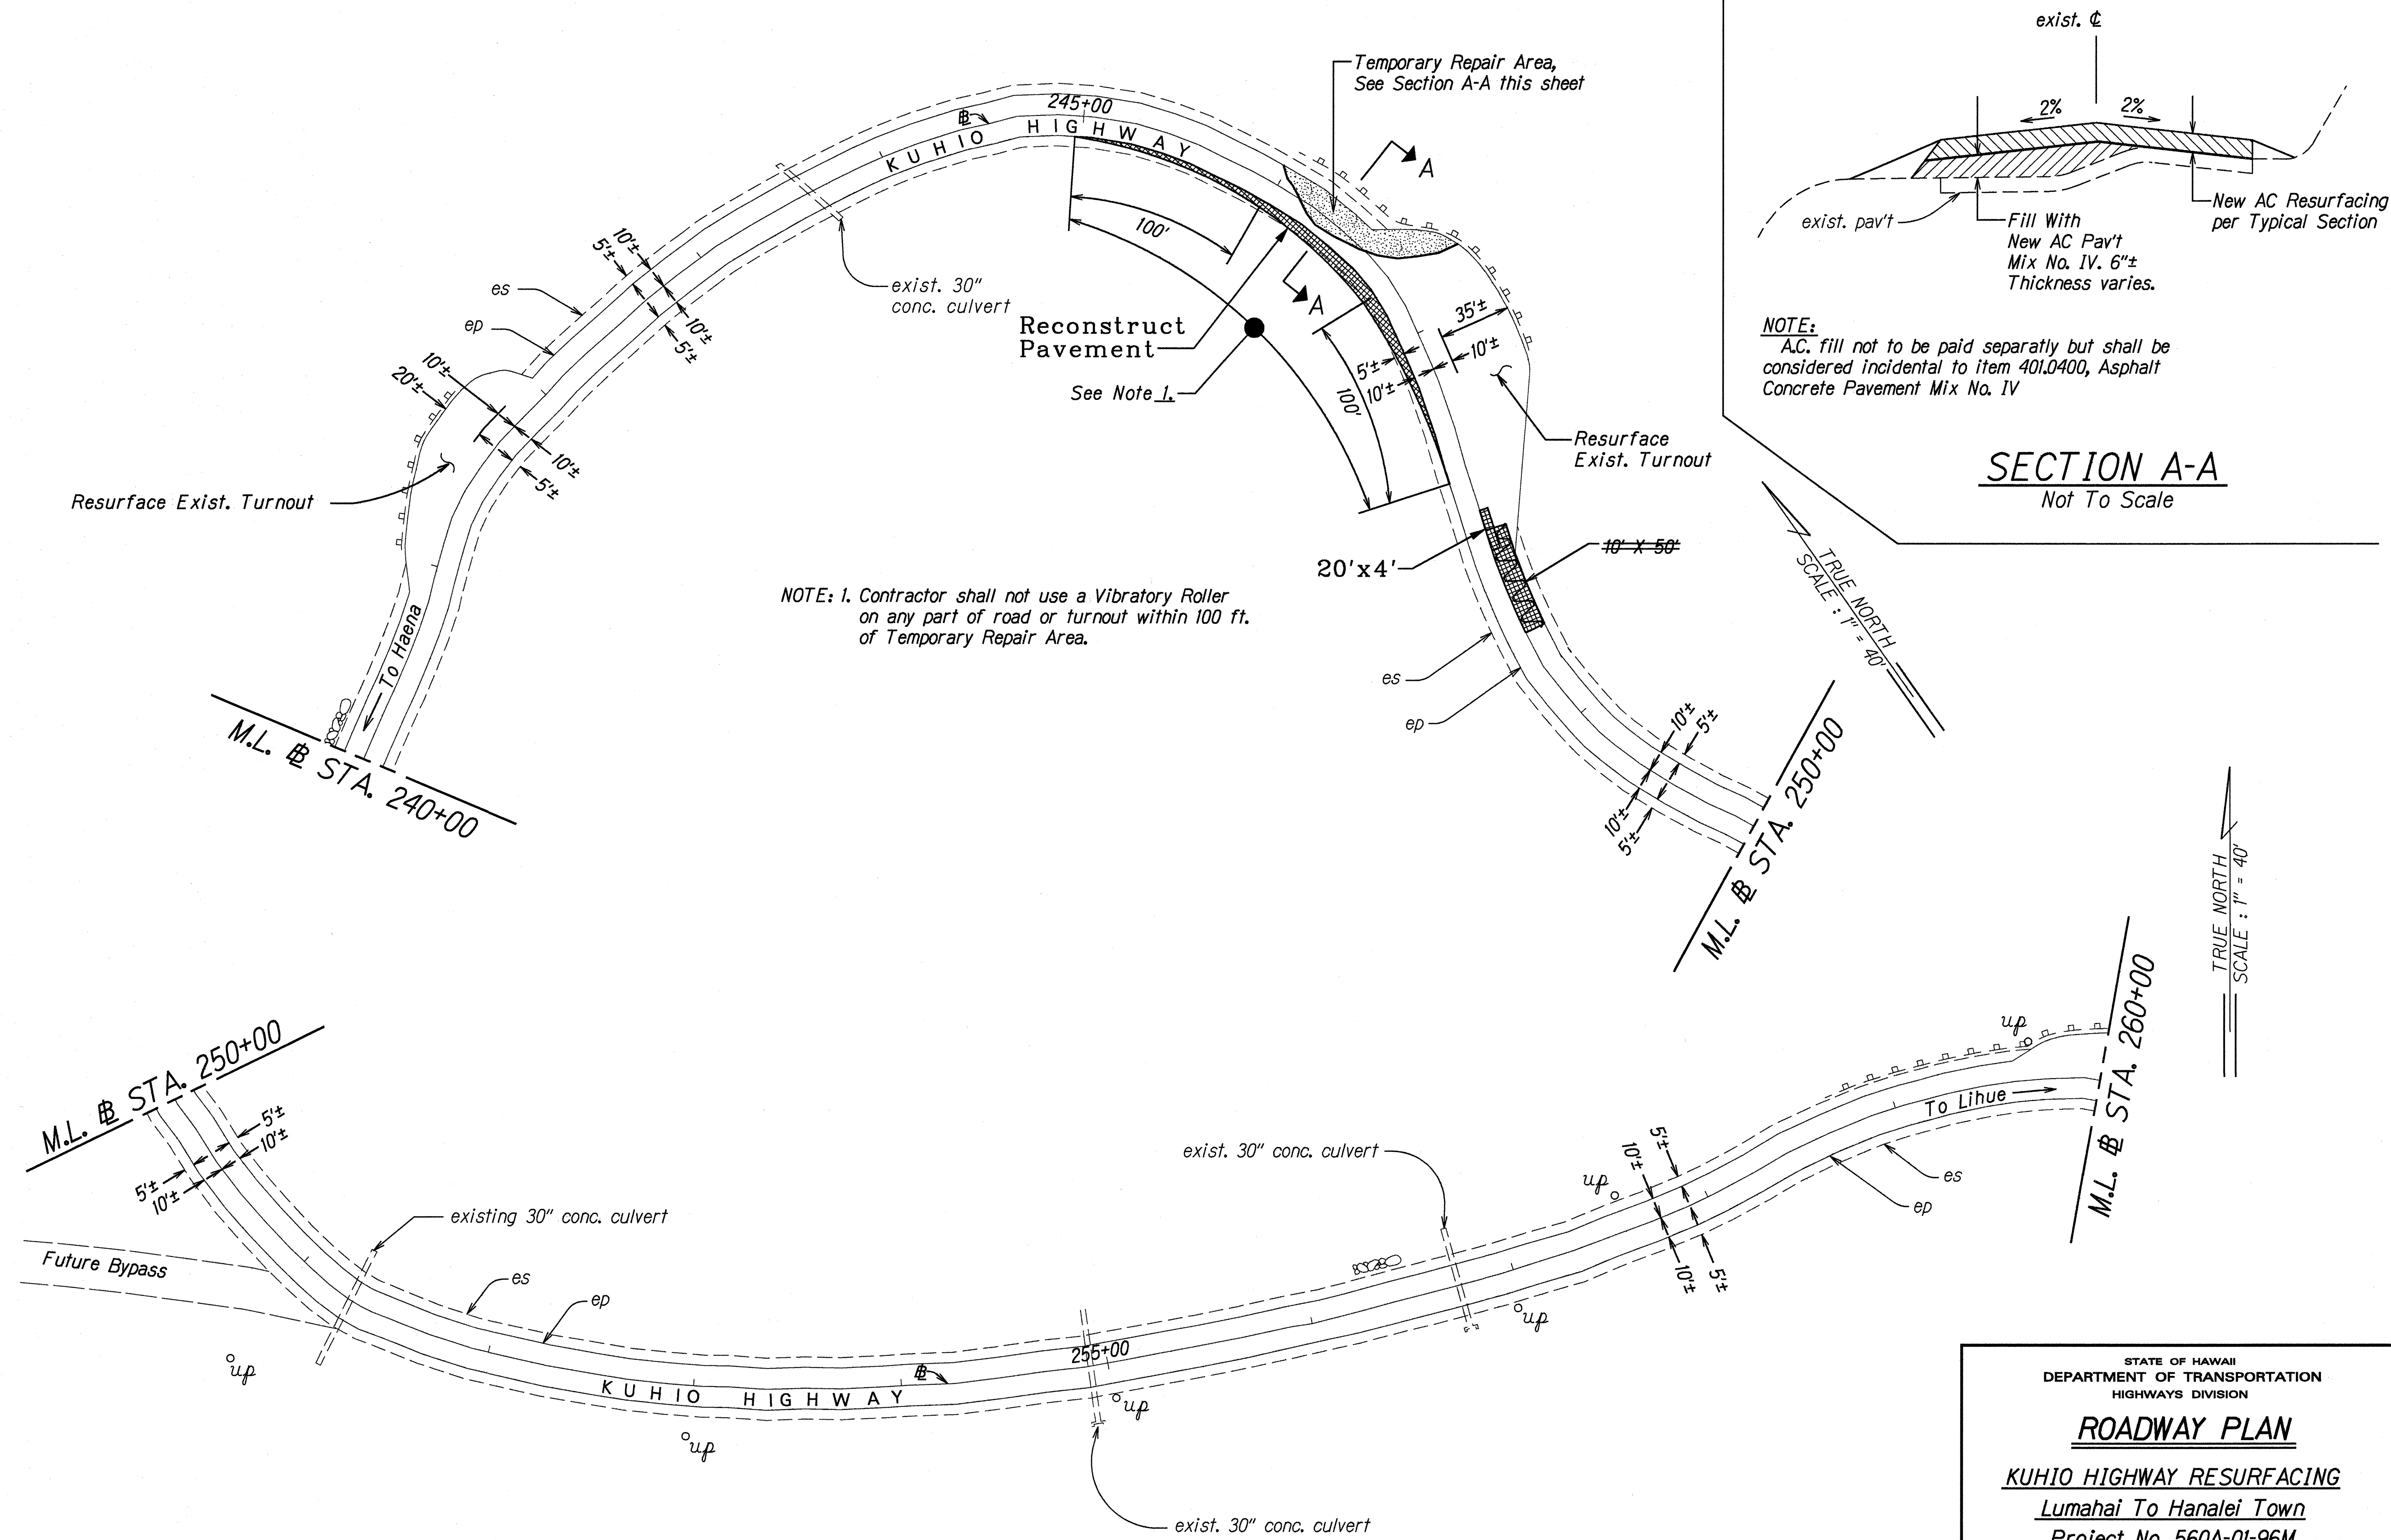

NOTE:
AC fill not to be paid separately but shall be considered incidental to item 401.0400, Asphalt Concrete Pavement Mix No. IV

NOTE: 1. Contractor shall not use a Vibratory Roller on any part of road or turnout within 100 ft. of Temporary Repair Area.

dd/lyne	ORIGINAL PLAN	SURVEY PLOTTED BY	DATE
		DRAWN BY G.M. MH	6/20/97
		TRACED BY LHW-K	
		DESIGNED BY LHW-K	
		CHECKED BY N. Chulheda	

STATE OF HAWAII
DEPARTMENT OF TRANSPORTATION
HIGHWAYS DIVISION


ROADWAY PLAN
KUHIO HIGHWAY RESURFACING
Lumahai To Hanalei Town
Project No. 560A-01-96M

Scale: 1" = 40'
Date: May, 1996

SHEET No. 3 OF 11 SHEETS

"AS-BUILT"

FED. ROAD DIST. NO.	STATE	PROJ. NO.	FISCAL YEAR	SHEET NO.	TOTAL SHEETS
HAWAII	HAW.	560A-01-96M	1996	10	32

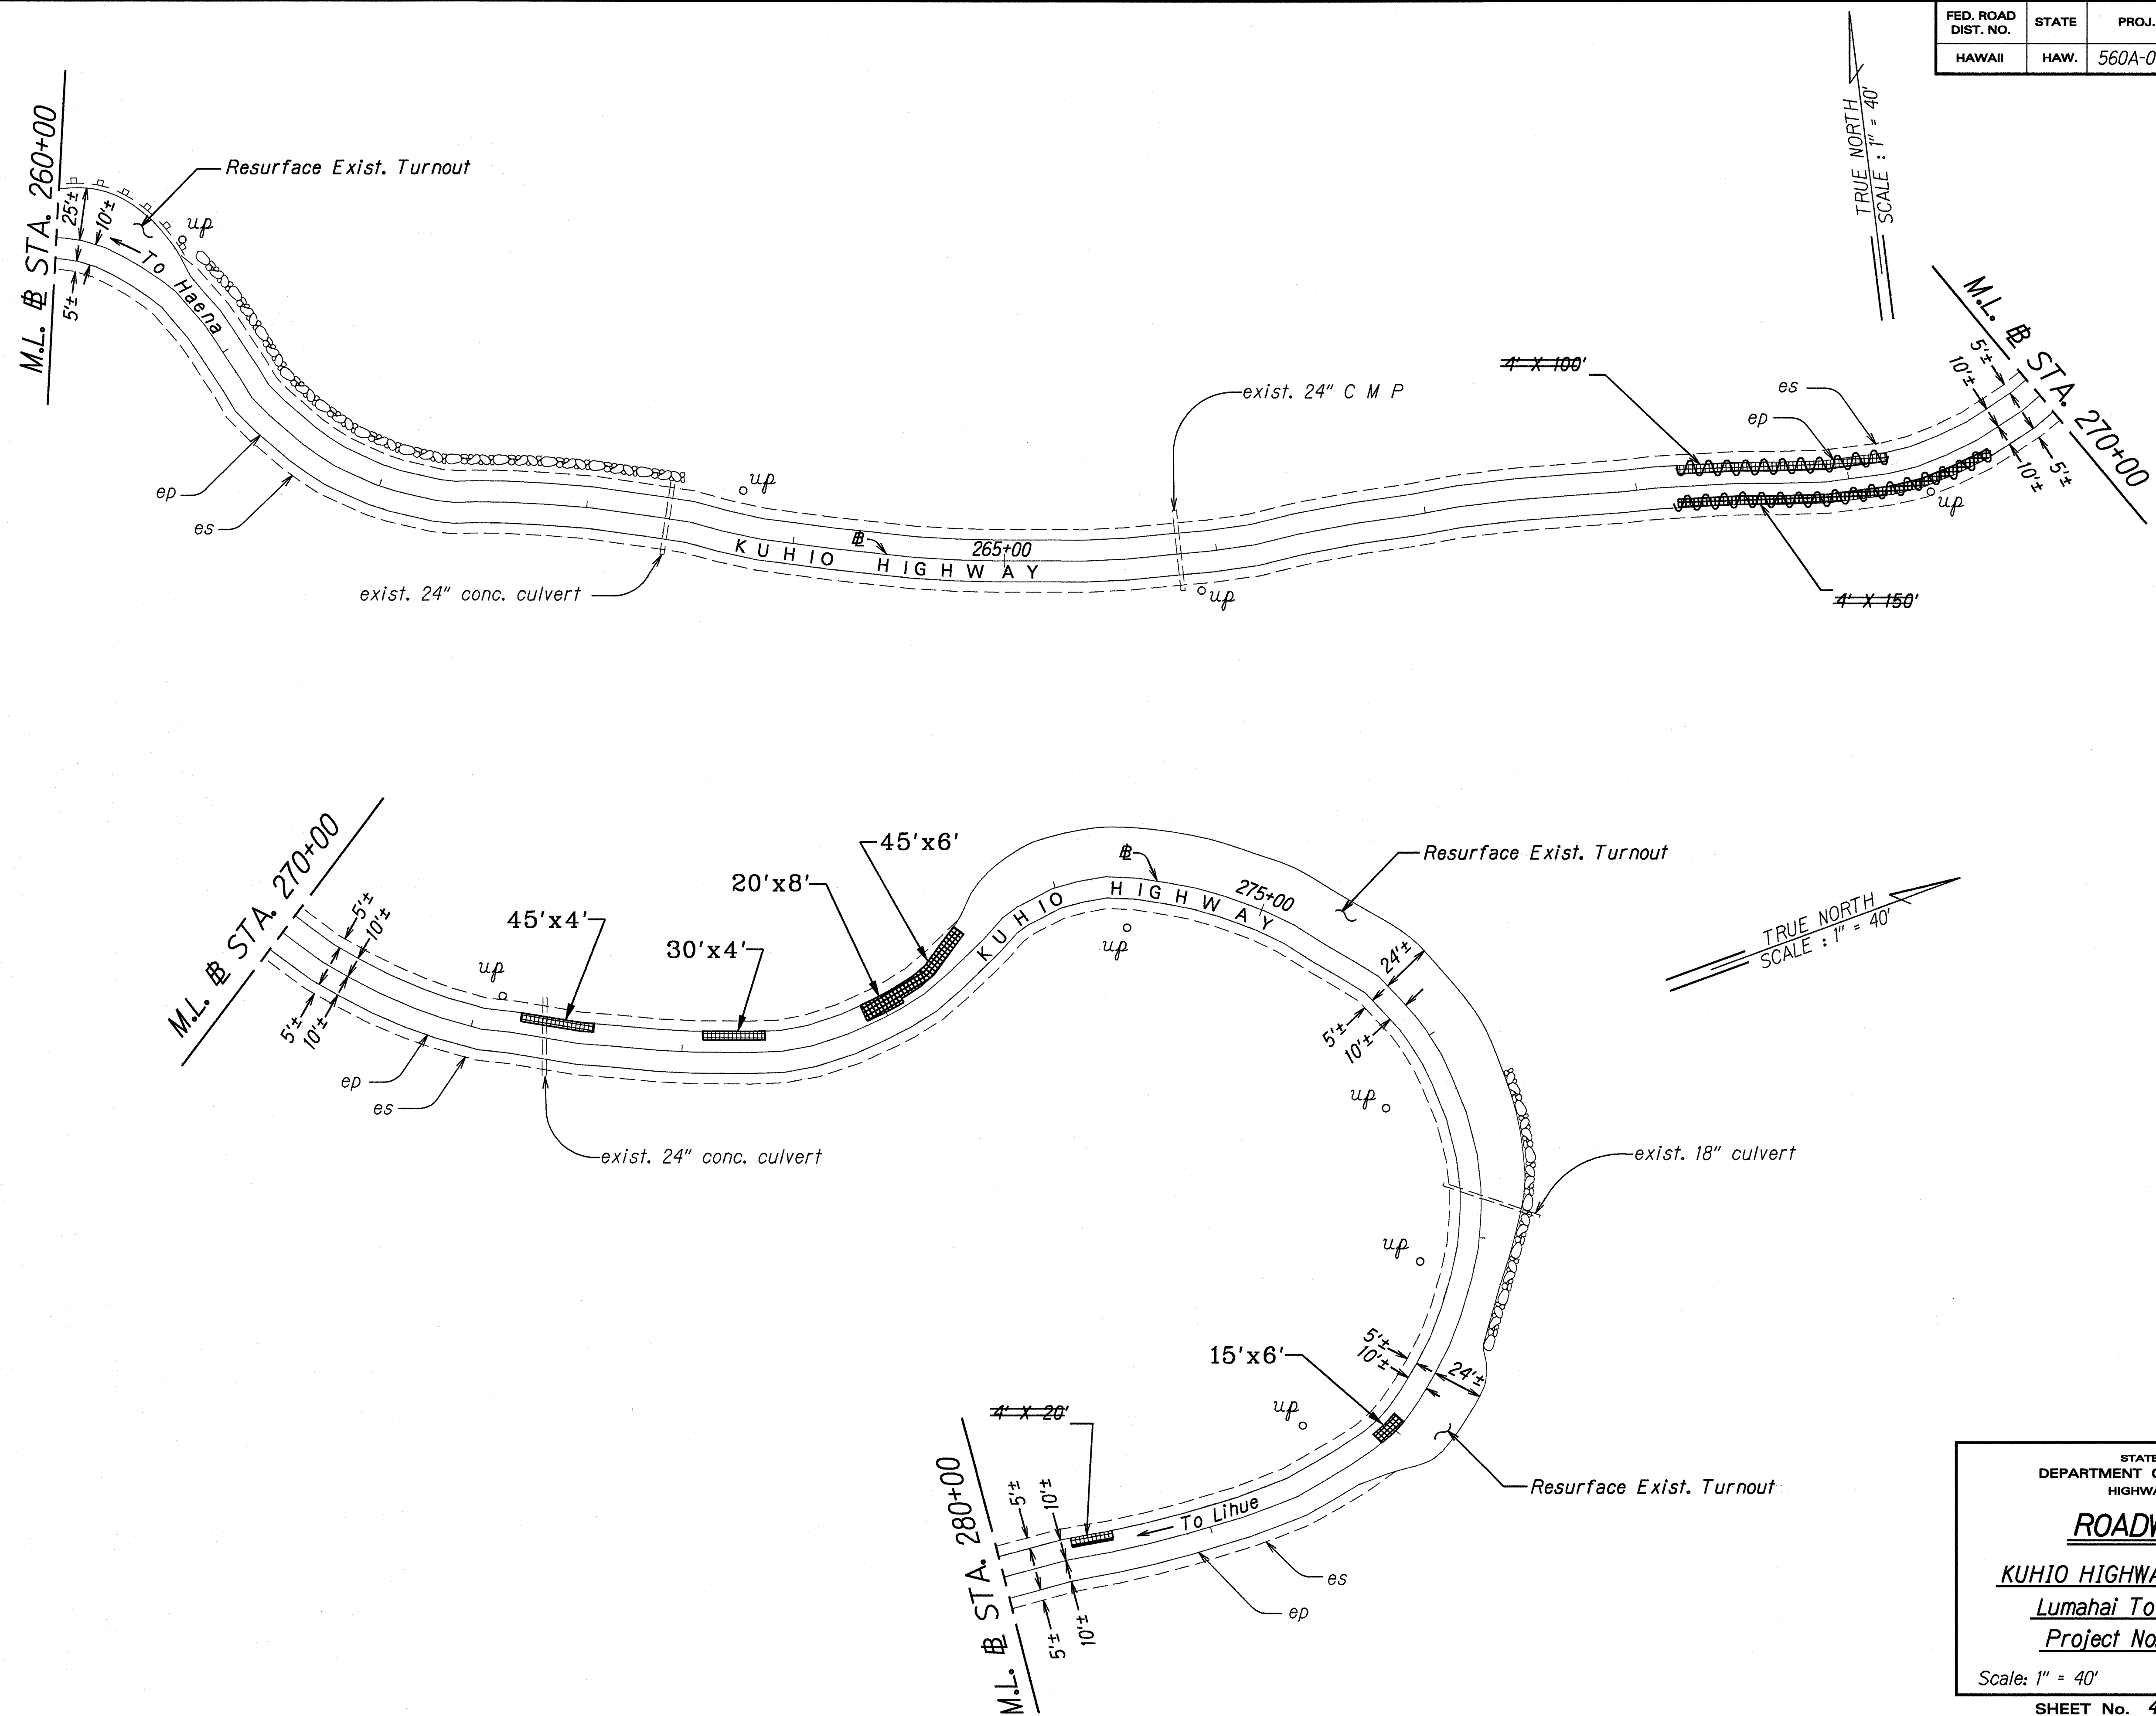

443/1/96	SURVEY PLOTTED BY	DATE	6/30/97
ORIGINAL PLAN	DESIGNED BY	TRACED BY	
NOTE BOOK	DESIGNED BY	QUANTITIES BY	
162, 687	QUANTITIES BY	CHECKED BY	
162, 687	CHECKED BY		

STATE OF HAWAII
DEPARTMENT OF TRANSPORTATION
HIGHWAYS DIVISION

ROADWAY PLAN



KUHIO HIGHWAY RESURFACING
Lumahai To Hanalei Town
Project No. 560A-01-96M

Scale: 1" = 40' Date: May, 1996

SHEET No. 4 OF 11 SHEETS

"AS-BUILT"

FED. ROAD DIST. NO.	STATE	PROJ. NO.	FISCAL YEAR	SHEET NO.	TOTAL SHEETS
HAWAII	HAW.	560A-01-96M	1996	11	32

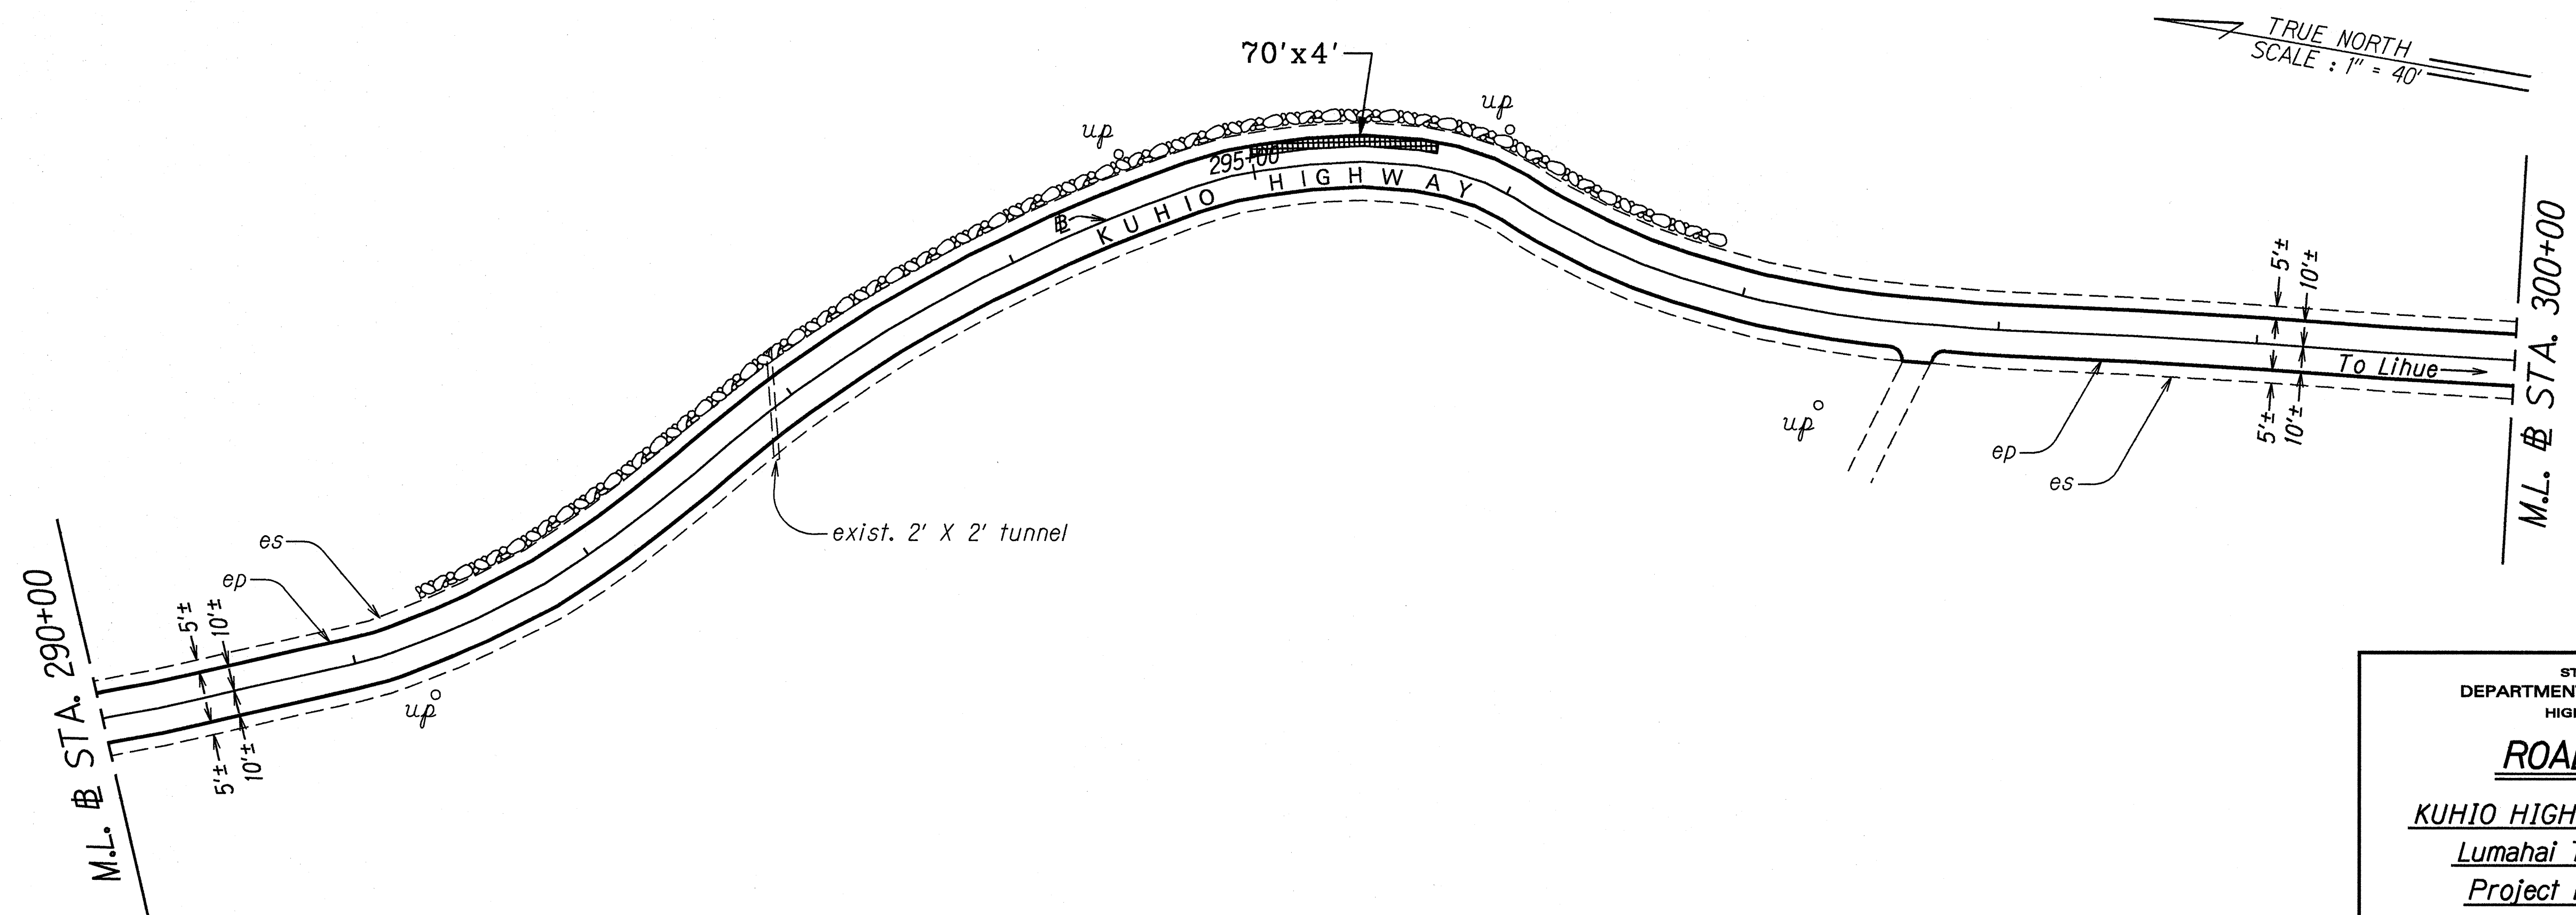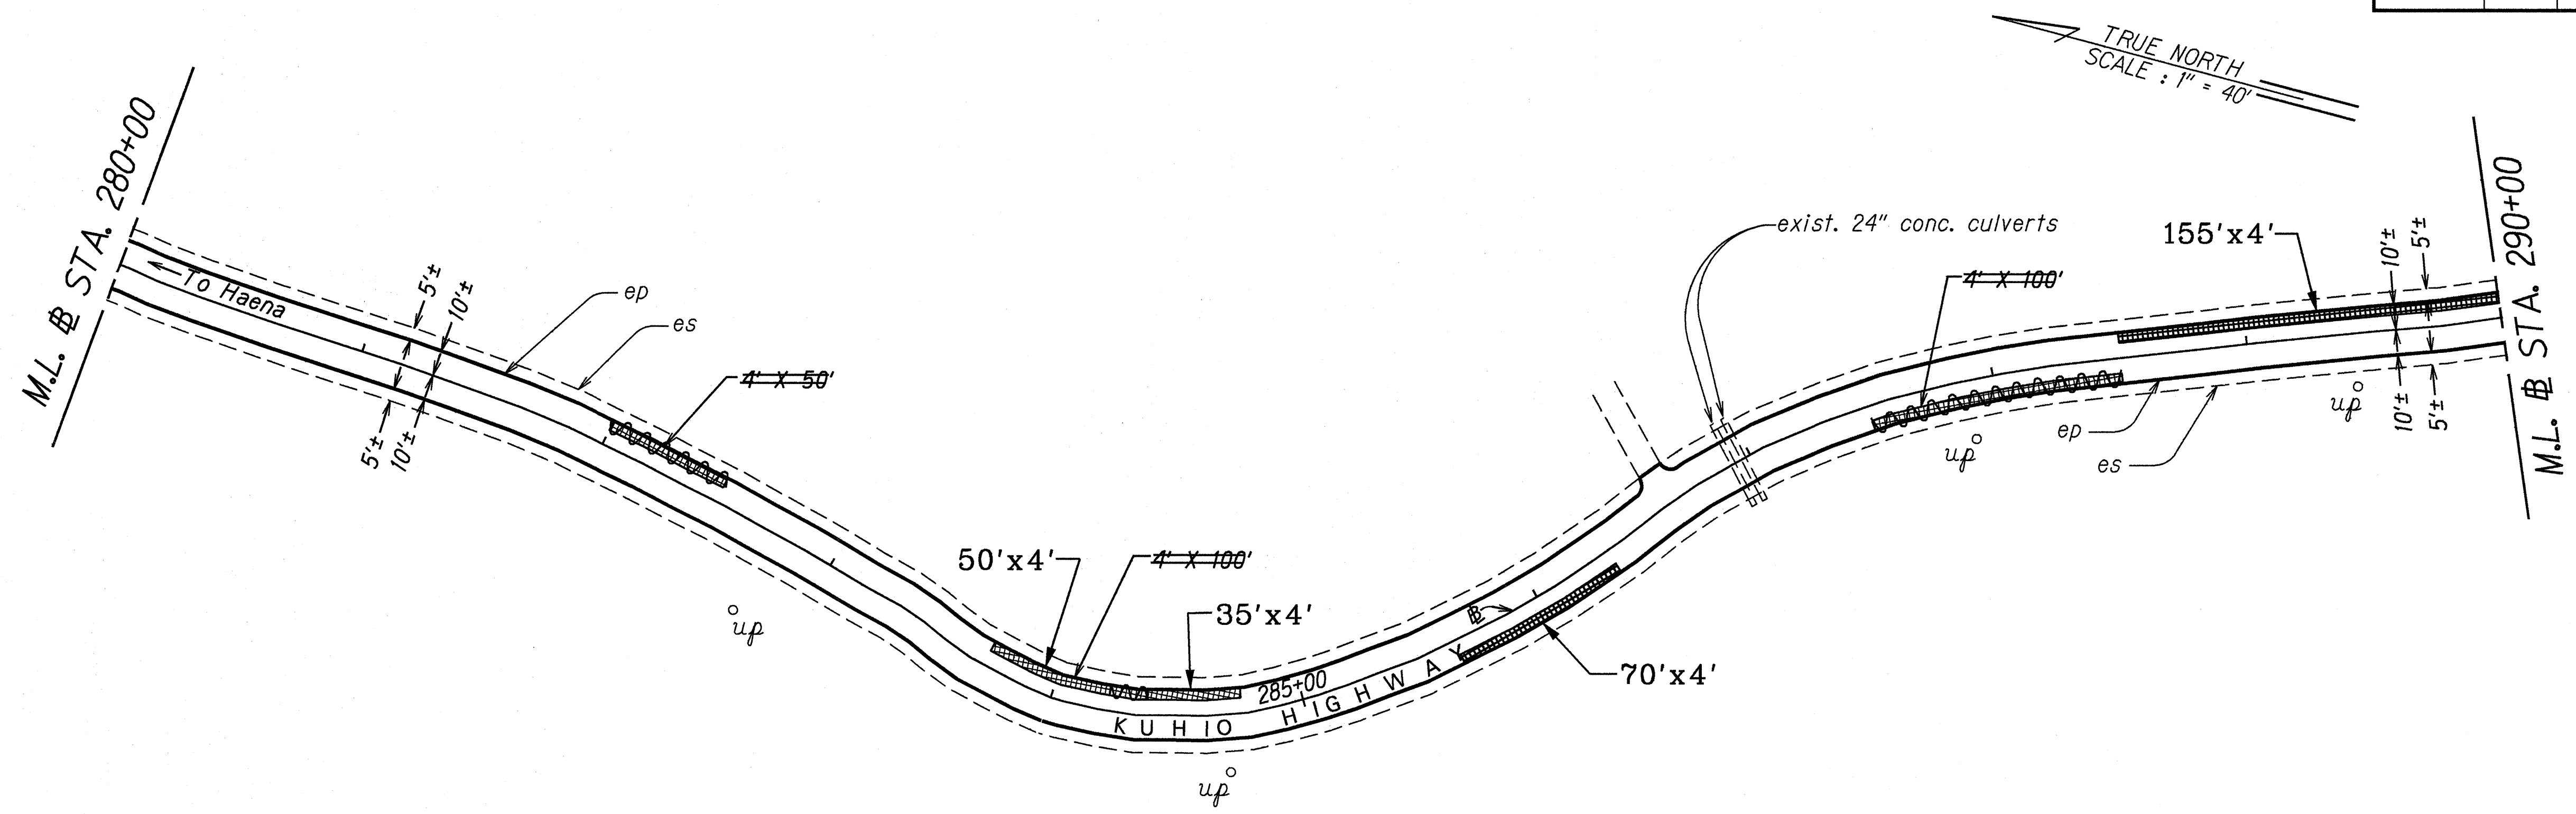

ORIGINAL PLAN	SURVEY PLOTTED BY	DATE
NOTED BOOK	DRAWN BY	7/3/97
DESIGNED BY	TRACED BY	
CHECKED BY	DESIGNED BY	
	CHECKED BY	

STATE OF HAWAII
DEPARTMENT OF TRANSPORTATION
HIGHWAYS DIVISION

ROADWAY PLAN


KUHIO HIGHWAY RESURFACING
Lumahai To Hanalei Town
Project No. 560A-01-96M

Scale: 1"=40' Date: May, 1996

SHEET No. 5 OF 11 SHEETS

"AS-BUILT"

FED. ROAD DIST. NO.	STATE	PROJ. NO.	FISCAL YEAR	SHEET NO.	TOTAL SHEETS
HAWAII	HAW.	560A-01-96M	1996	12	32

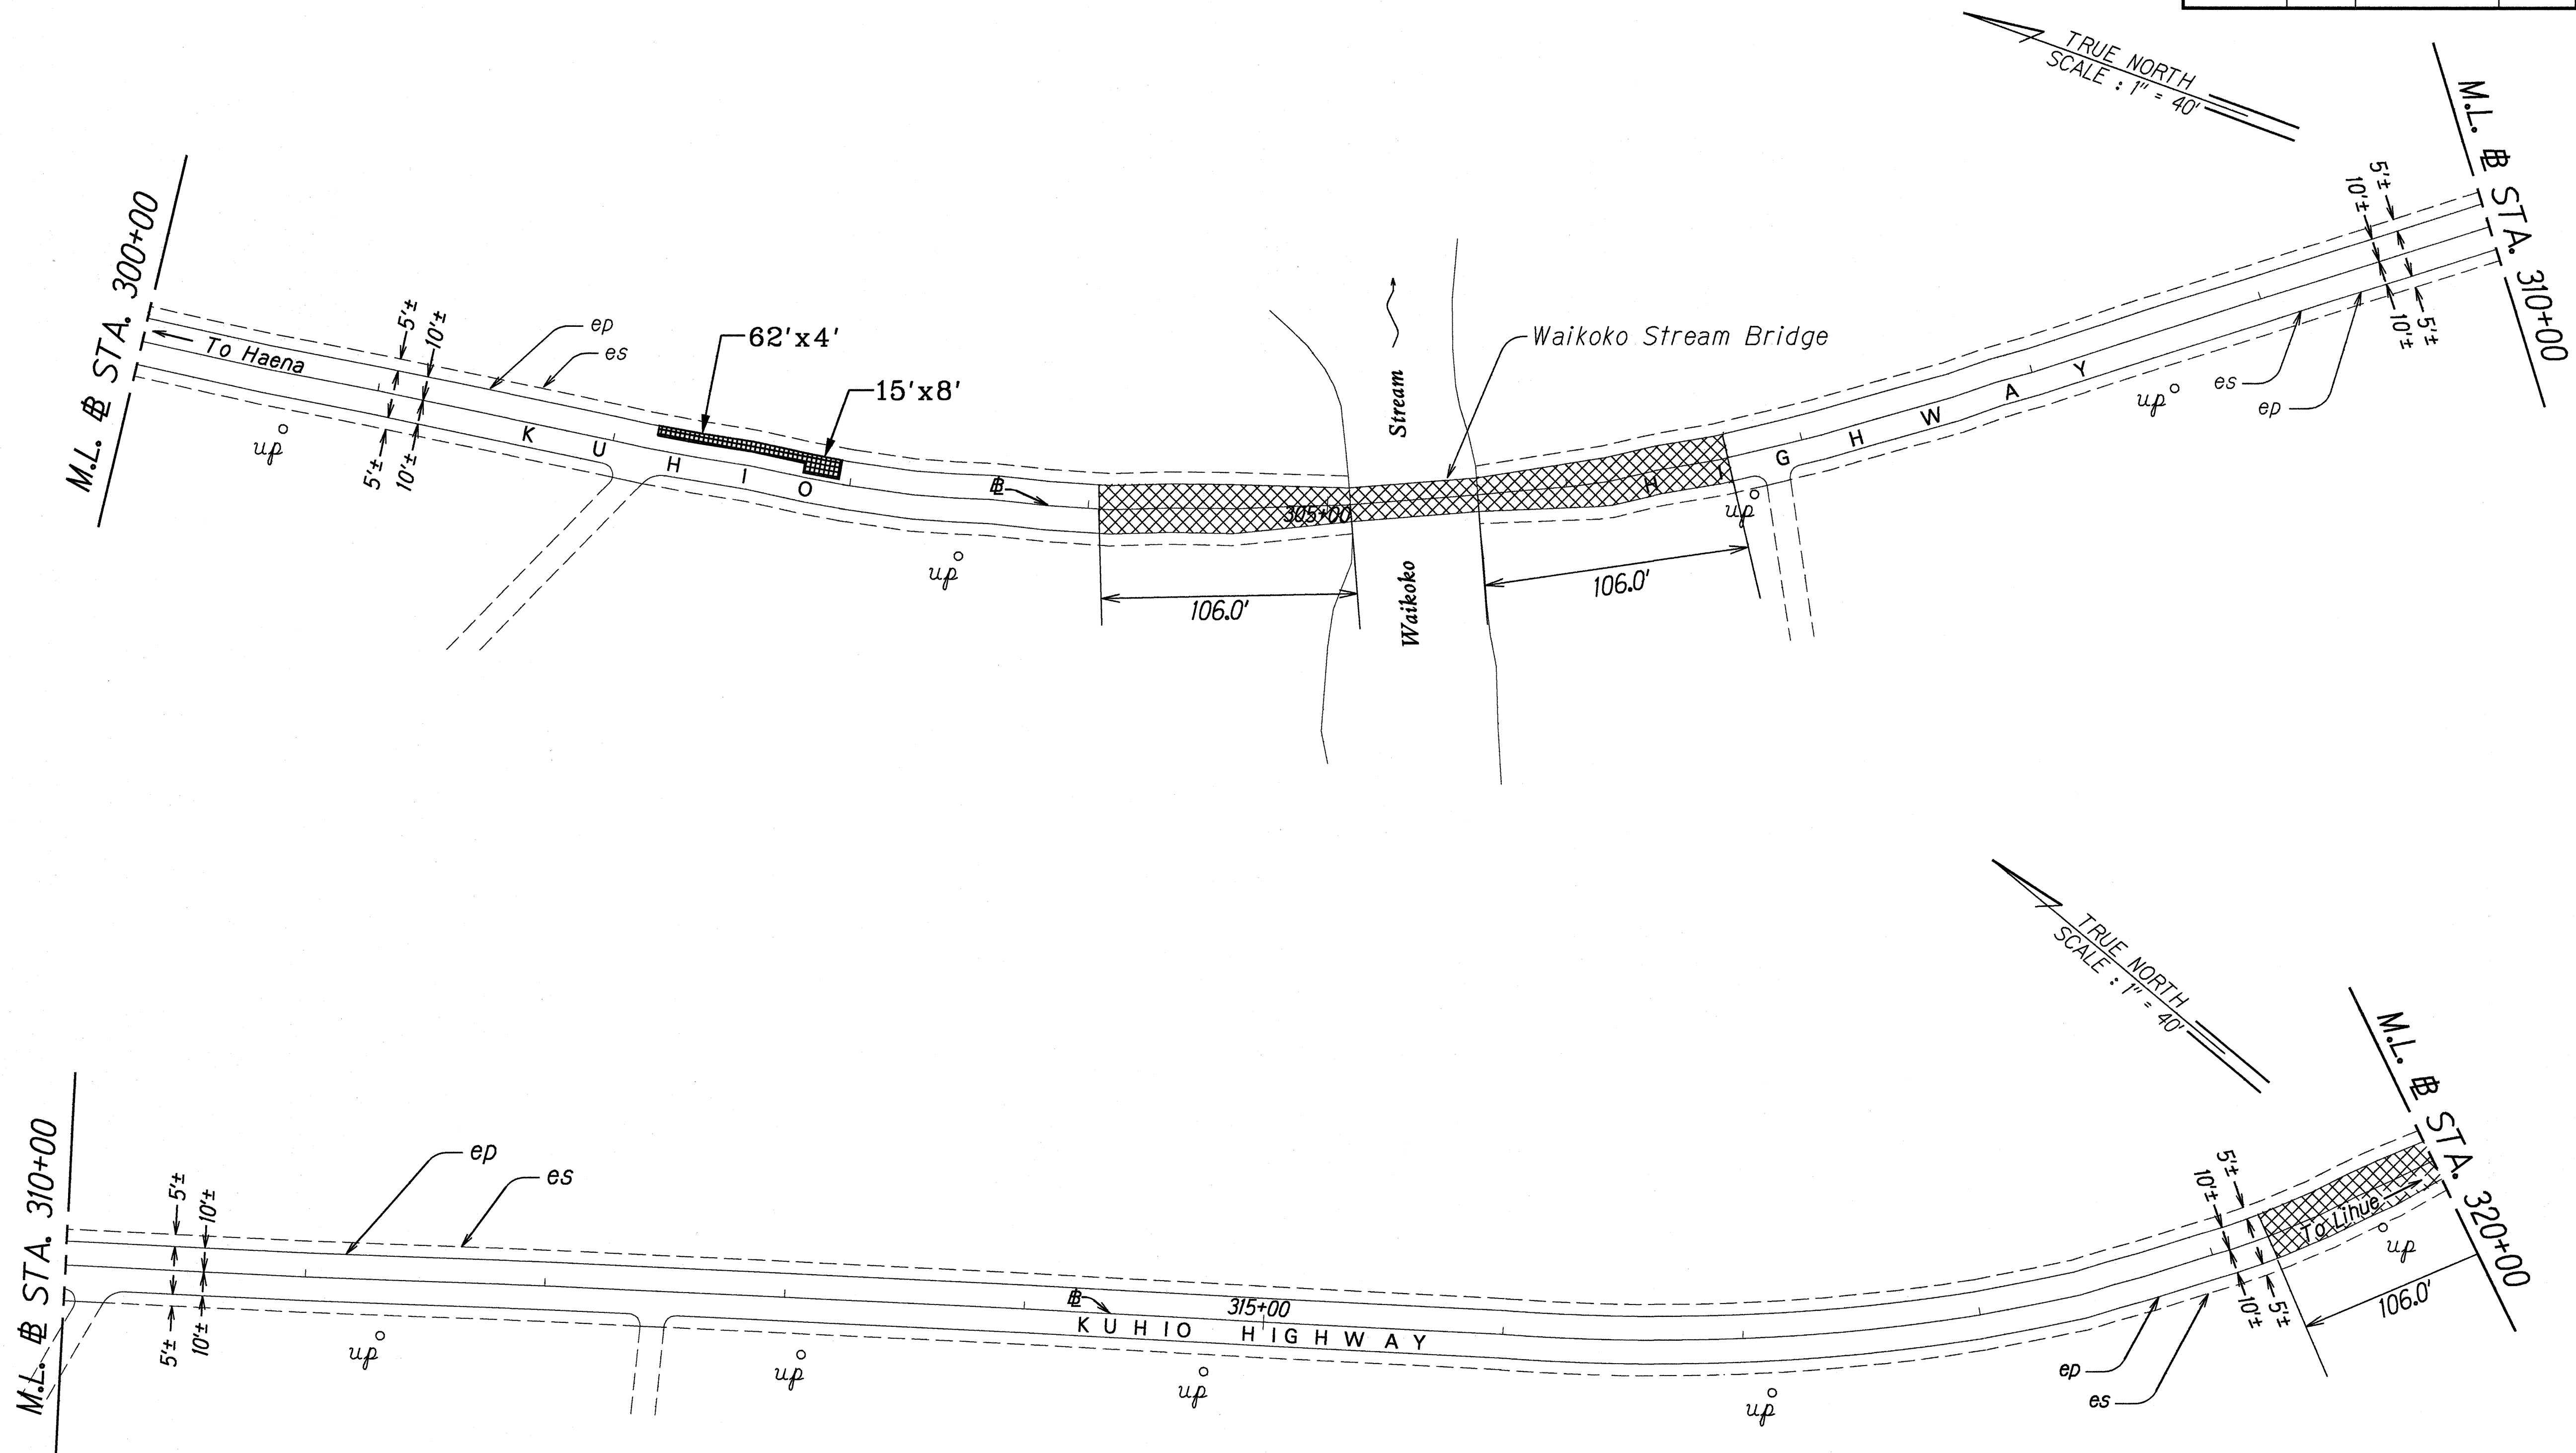

dd3/lyme	ORIGINAL PLAN	DATE: 7/3/97
	SURVEY PLATTED BY	
	DRAWN BY	
	DESIGNED BY	
	CHECKED BY	
	APPROVED BY	

STATE OF HAWAII
DEPARTMENT OF TRANSPORTATION
HIGHWAYS DIVISION

ROADWAY PLAN


KUHIO HIGHWAY RESURFACING
Lumalai To Hanalei Town
Project No. 560A-01-96M

Scale: 1" = 40' Date: May, 1996

SHEET No. 6 OF 11 SHEETS

"AS-BUILT"

FED. ROAD DIST. NO.	STATE	PROJ. NO.	FISCAL YEAR	SHEET NO.	TOTAL SHEETS
HAWAII	HAW.	560A-01-96M	1996	13	32

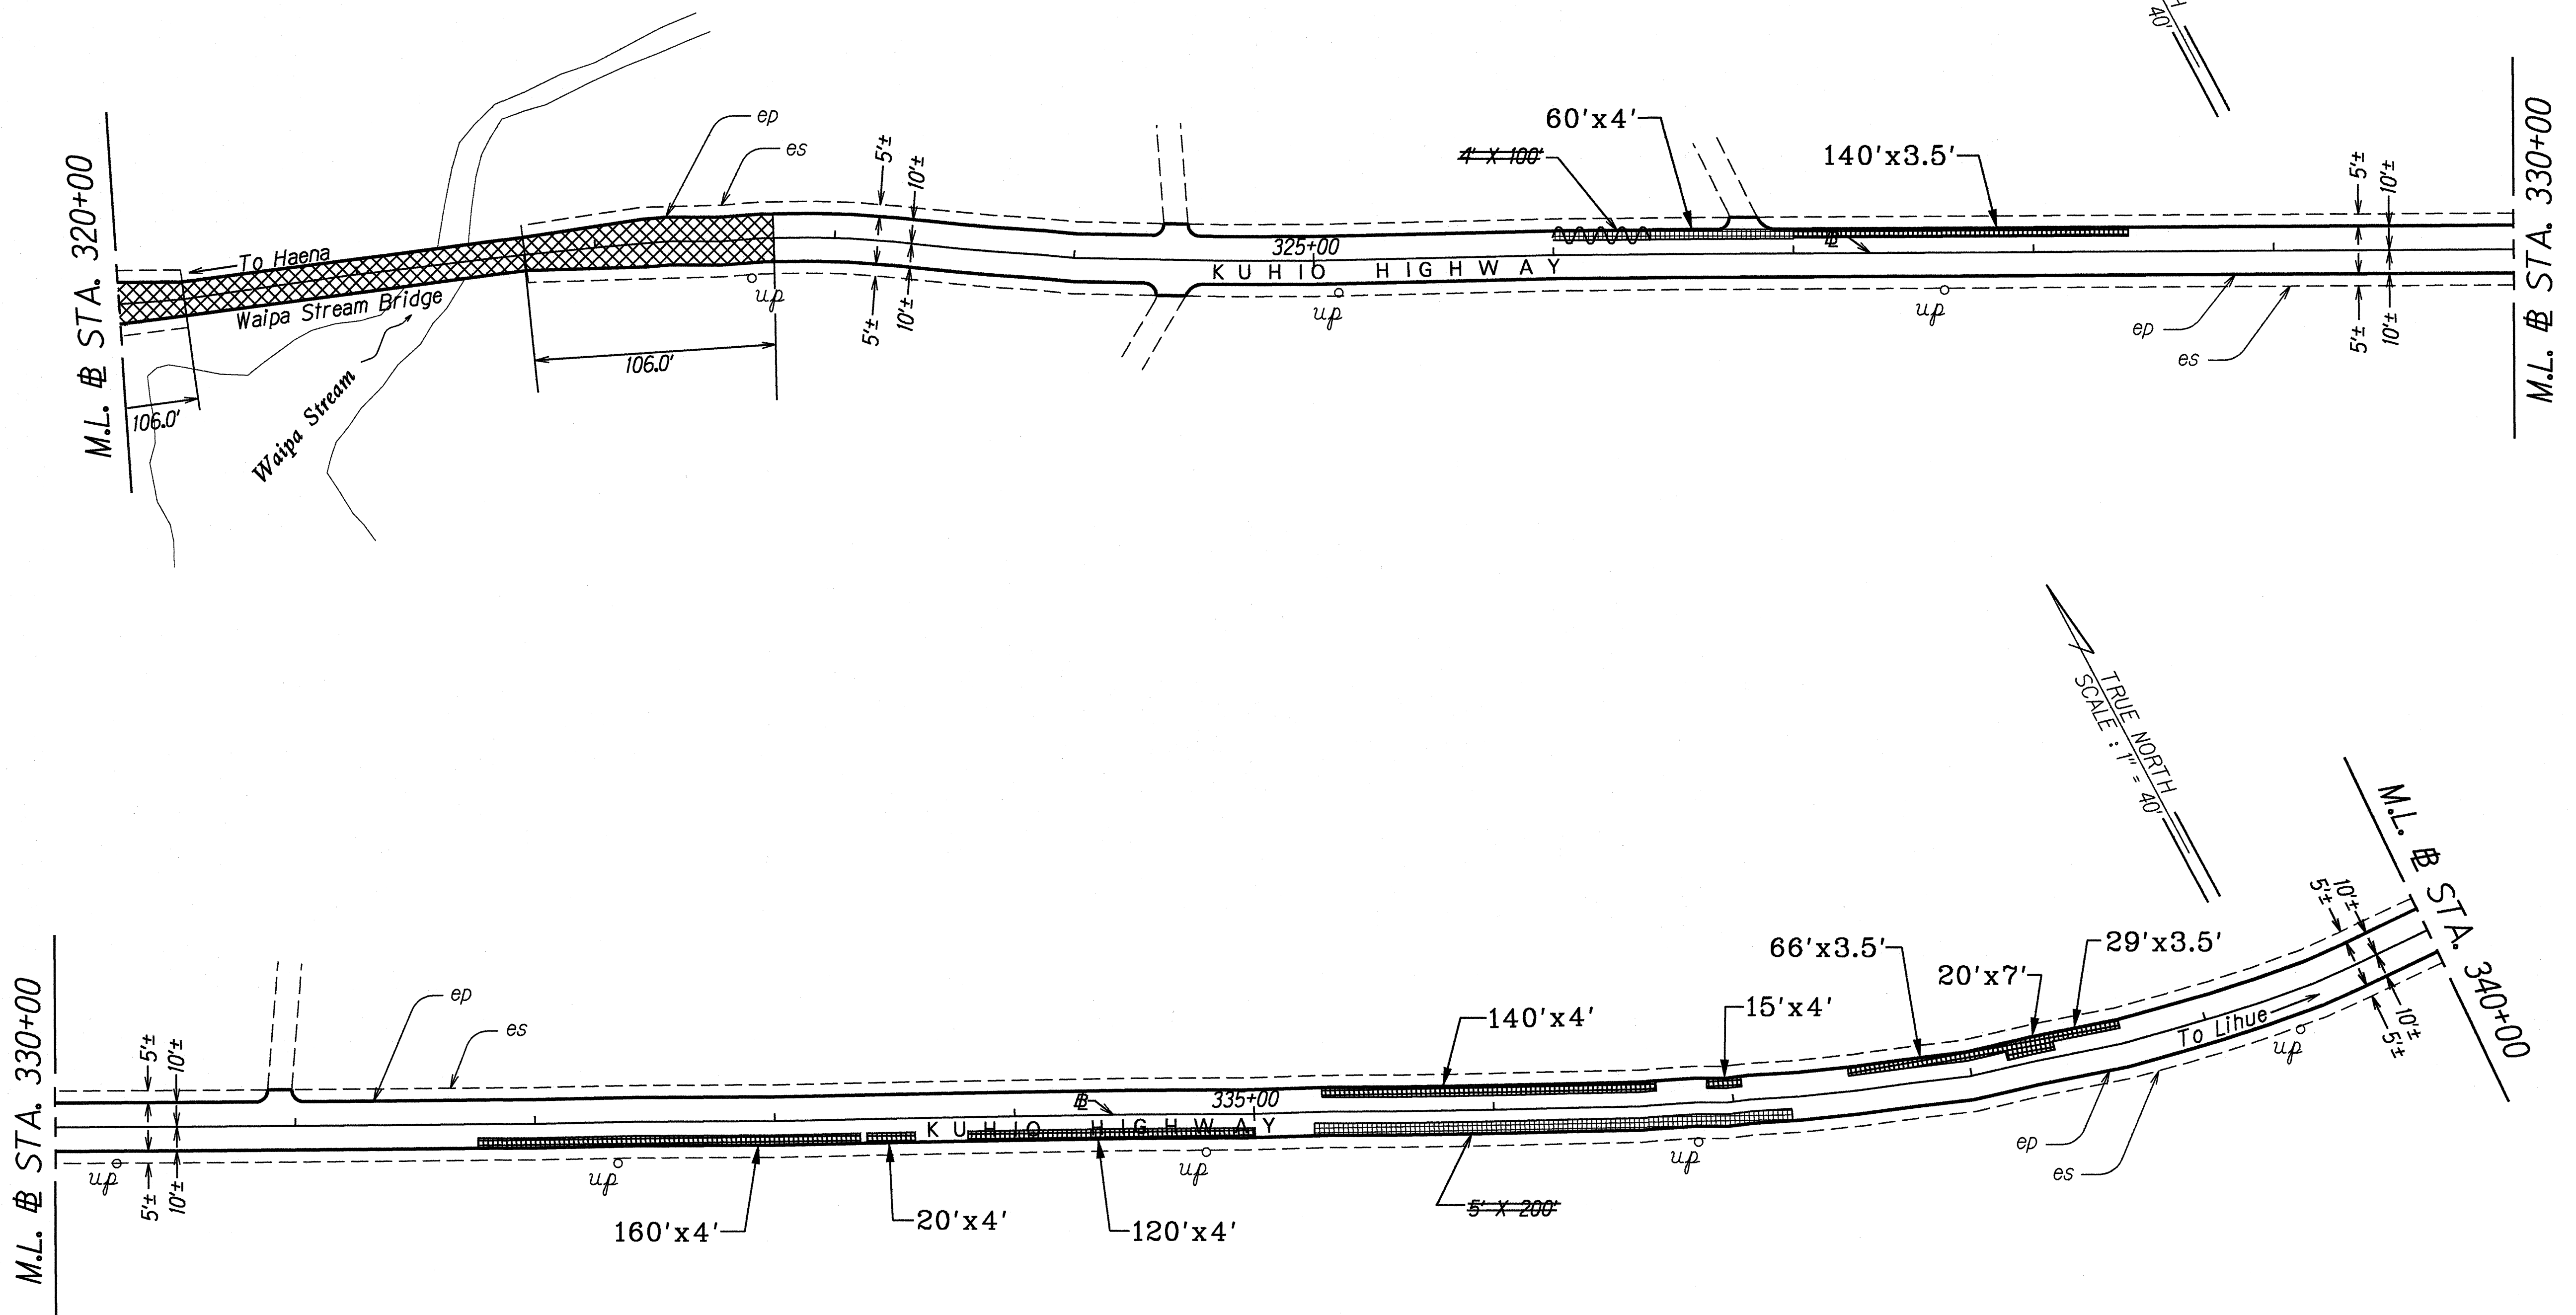

ORIGINAL PLAN	SURVEY PLOTTED BY	DATE
NOTED BY	DRAWN BY	7/3/97
QUANTITIES BY	TRACED BY	
CHECKED BY	NOTED BY	

STATE OF HAWAII
DEPARTMENT OF TRANSPORTATION
HIGHWAYS DIVISION

ROADWAY PLAN


KUHIO HIGHWAY RESURFACING
Lumahai To Hanalei Town
Project No. 560A-01-96M

Scale: 1" = 40' Date: May, 1996

SHEET No. 7 OF 11 SHEETS

"AS-BUILT"

FED. ROAD DIST. NO.	STATE	PROJ. NO.	FISCAL YEAR	SHEET NO.	TOTAL SHEETS
HAWAII	HAW.	560A-01-96M	1996	14	32

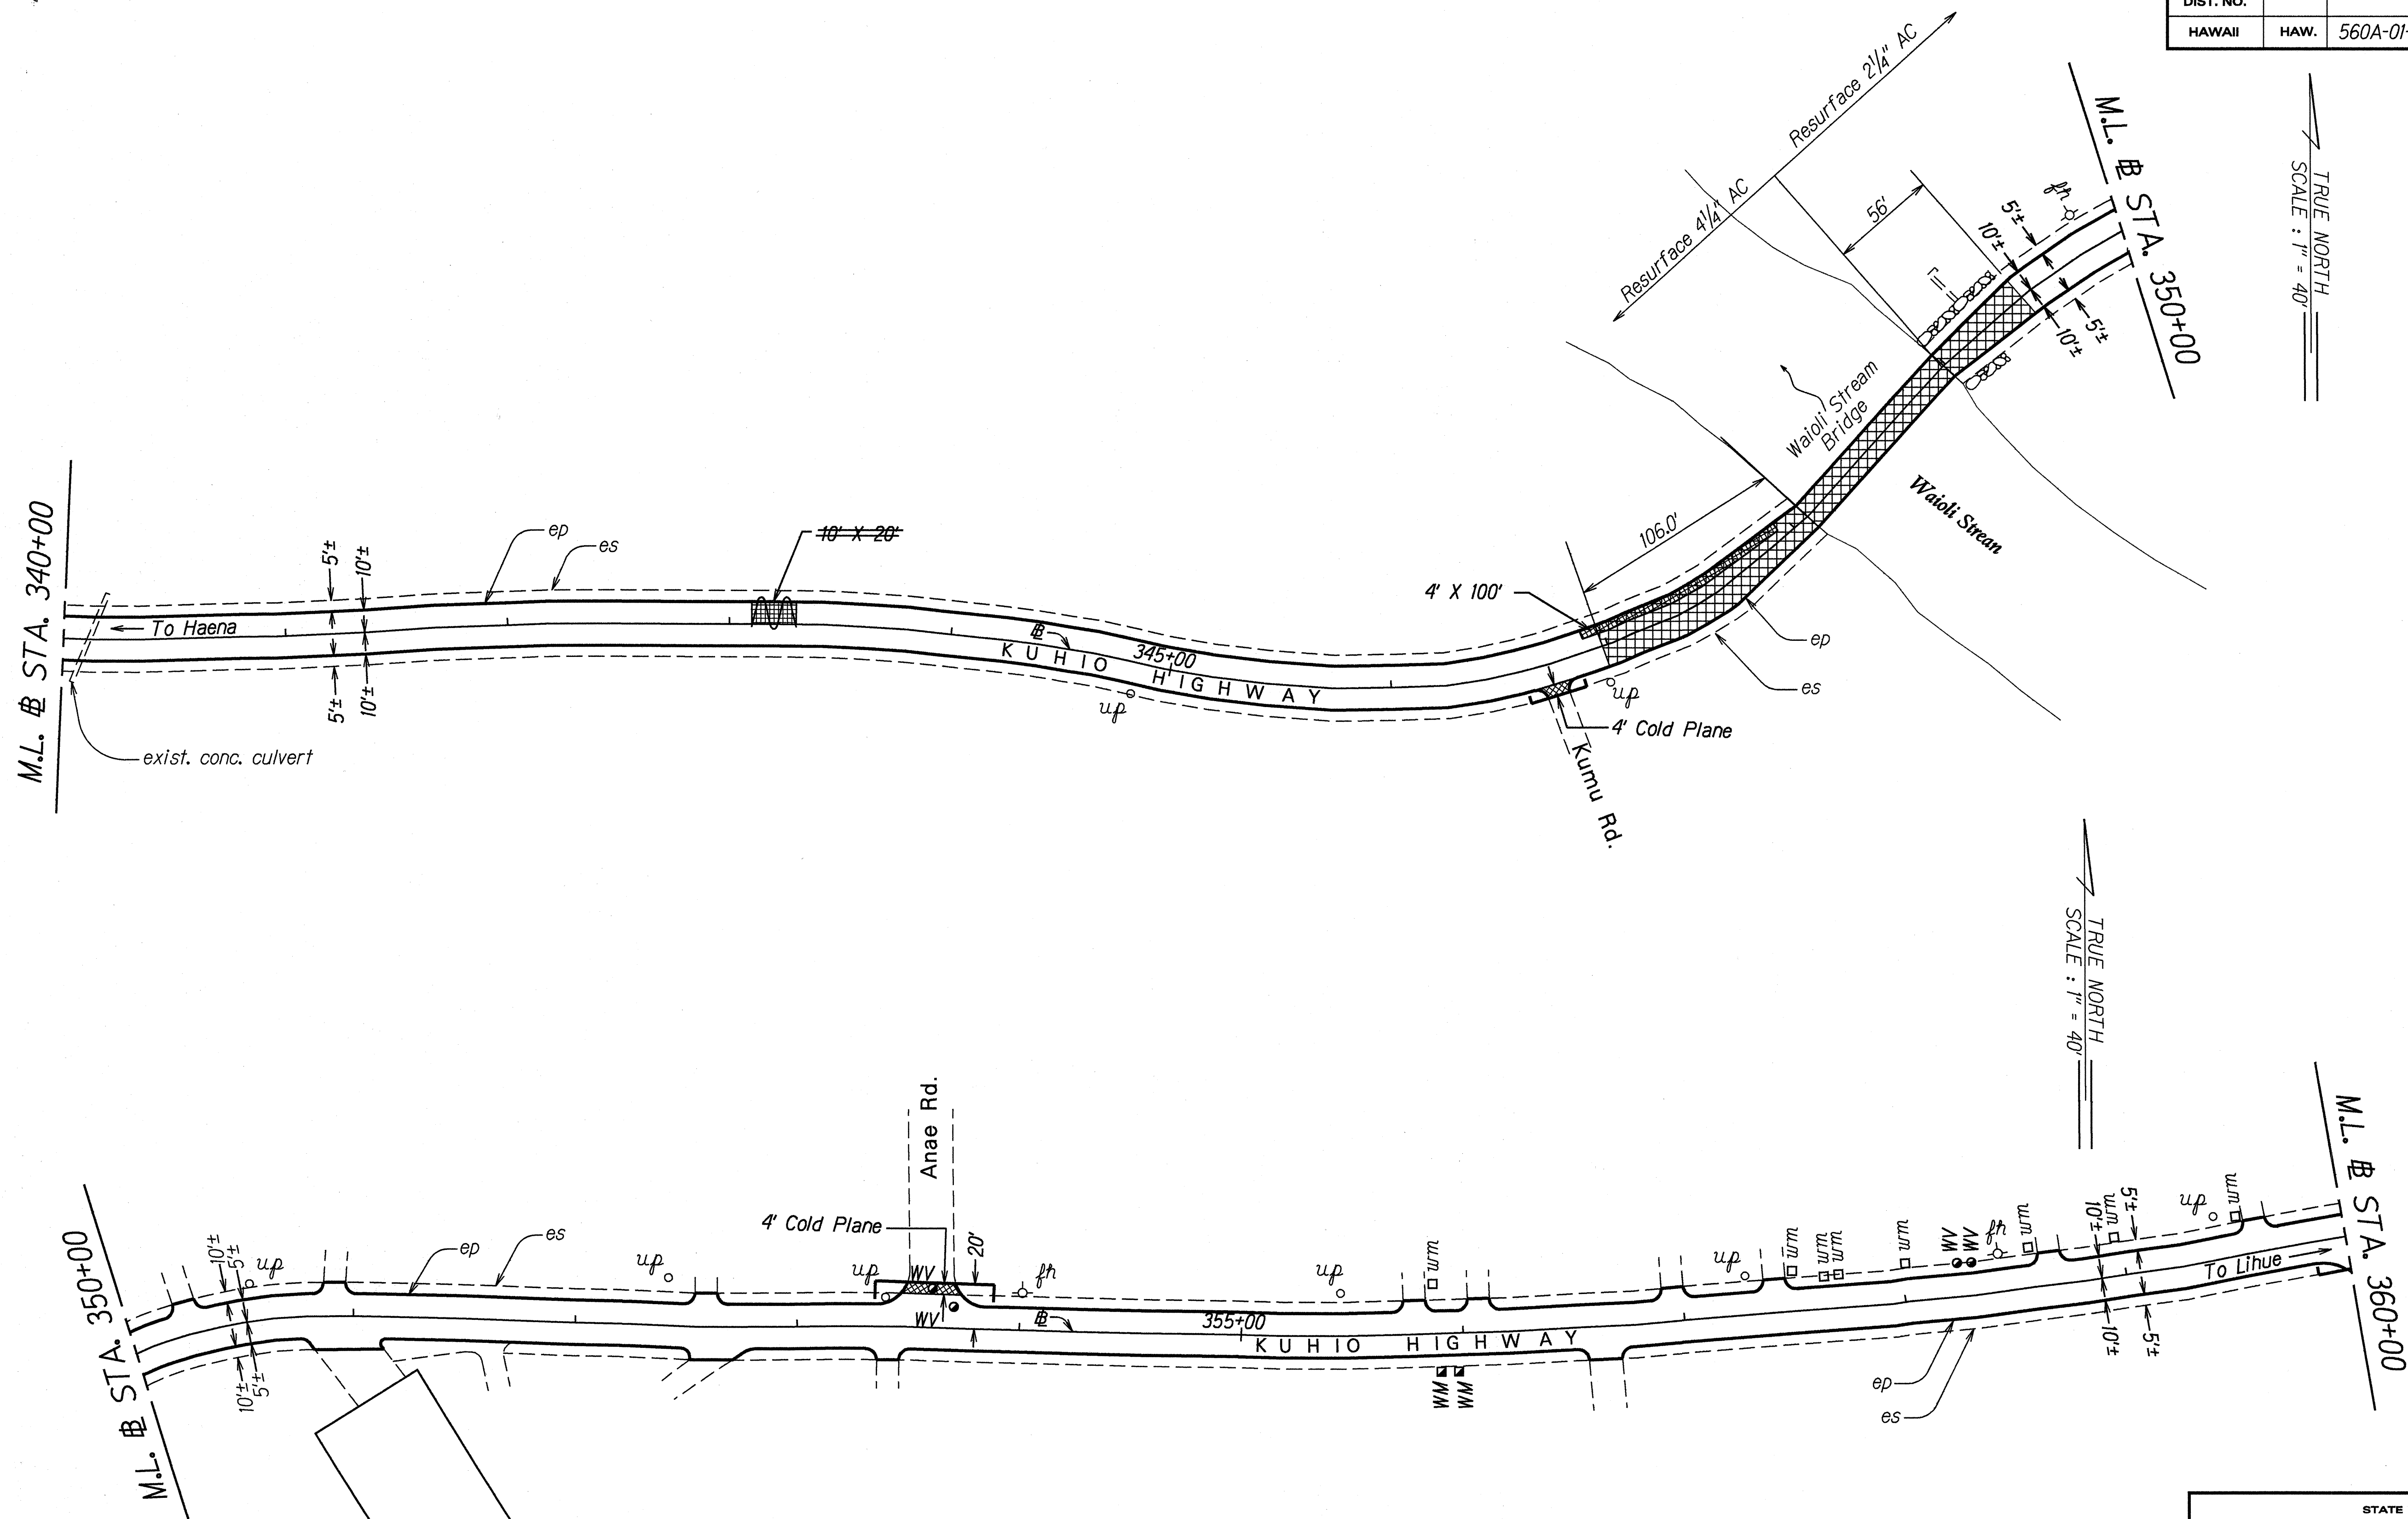

ORIGINAL PLAN	SURVEY PLOTTED BY	DATE
NOTED BOOK	DRAWN BY	7/3/91
NOTED BOOK	TRACED BY	
NOTED BOOK	CHECKED BY	
NOTED BOOK	CHECKED BY	

STATE OF HAWAII
DEPARTMENT OF TRANSPORTATION
HIGHWAYS DIVISION

ROADWAY PLAN


KUHIO HIGHWAY RESURFACING
Lumahai To Hanalei Town
Project No. 560A-01-96M

Scale: 1" = 40' Date: May, 1996

SHEET No. 8 OF 11 SHEETS

"AS-BUILT"

FED. ROAD DIST. NO.	STATE	PROJ. NO.	FISCAL YEAR	SHEET NO.	TOTAL SHEETS
HAWAII	HAW.	560A-01-96M	1996	15	32

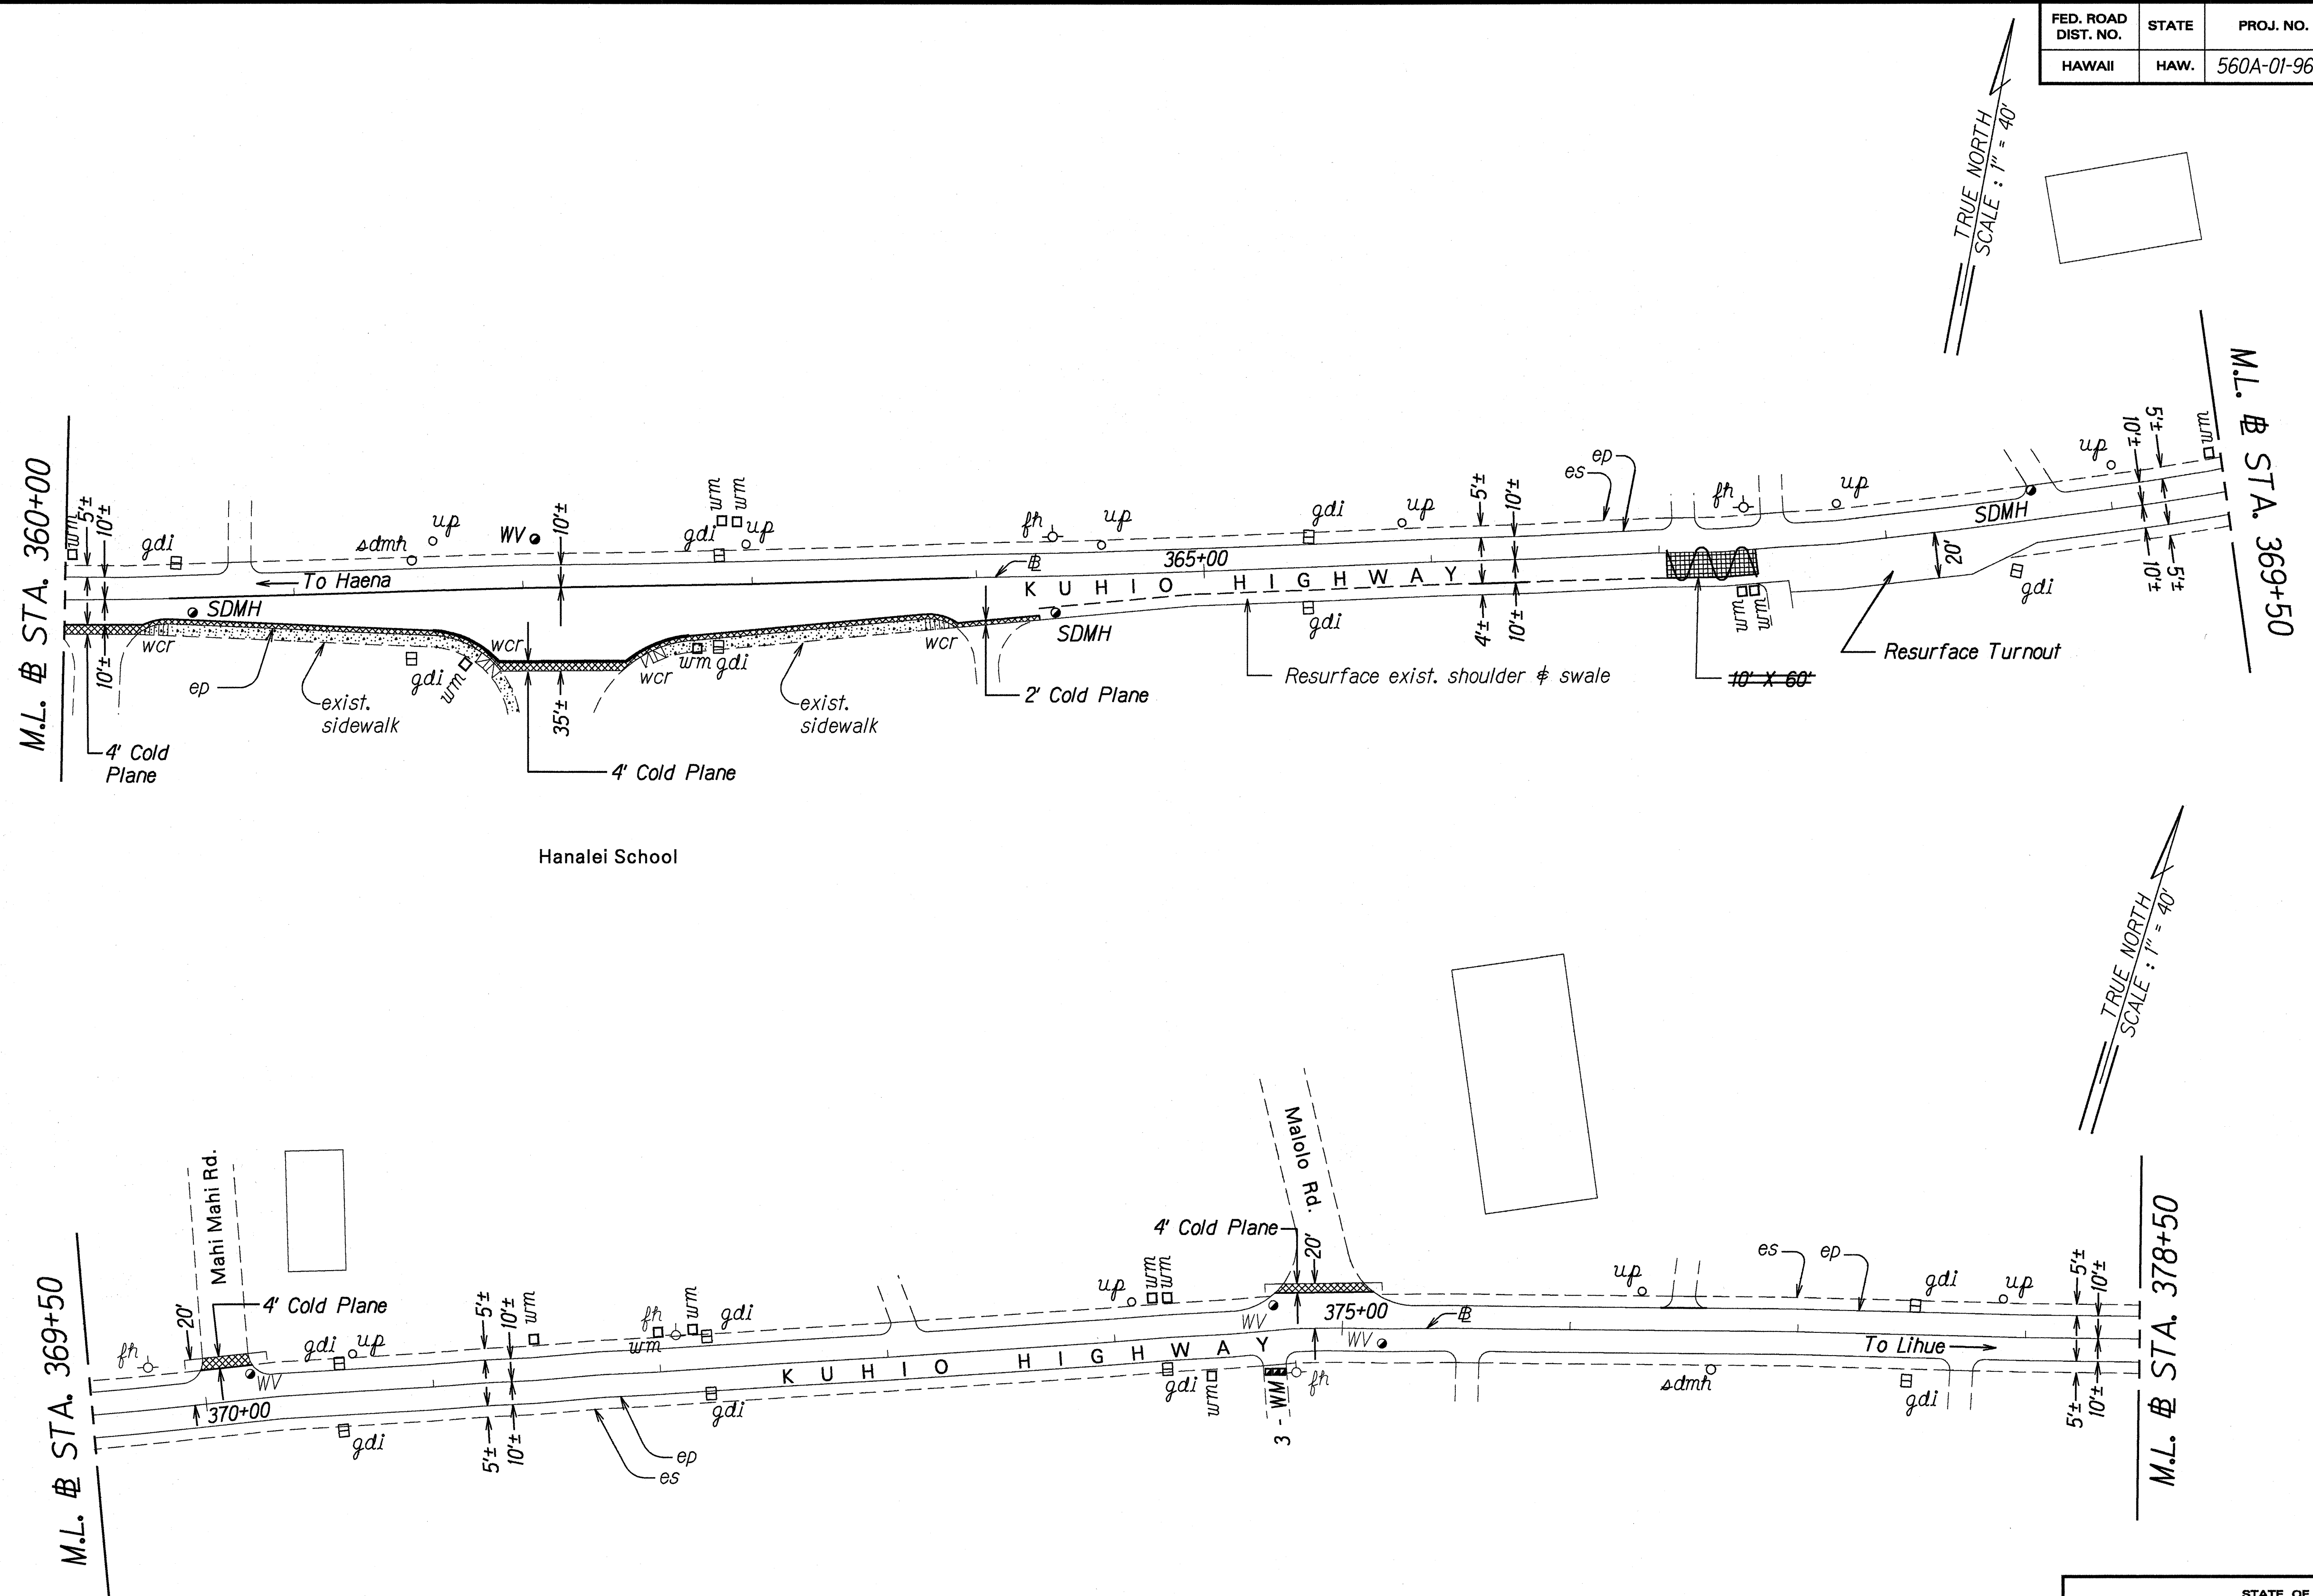

ORIGINAL PLAN	SURVEY PLATTED BY	DATE
NOTED BOOK	DRAWN BY	7/3/97
Re-2, Gary	CHECKED BY	
N. Chulupog		

STATE OF HAWAII
DEPARTMENT OF TRANSPORTATION
HIGHWAYS DIVISION

ROADWAY PLAN

KUHIO HIGHWAY RESURFACING

Lumahai To Hanalei Town



Project No. 560A-01-96M

Scale: 1" = 40'
Date: May, 1996

SHEET No. 9 OF 11 SHEETS

"AS-BUILT"

FED. ROAD DIST. NO.	STATE	PROJ. NO.	FISCAL YEAR	SHEET NO.	TOTAL SHEETS
HAWAII	HAW.	560A-01-96M	1996	16	32

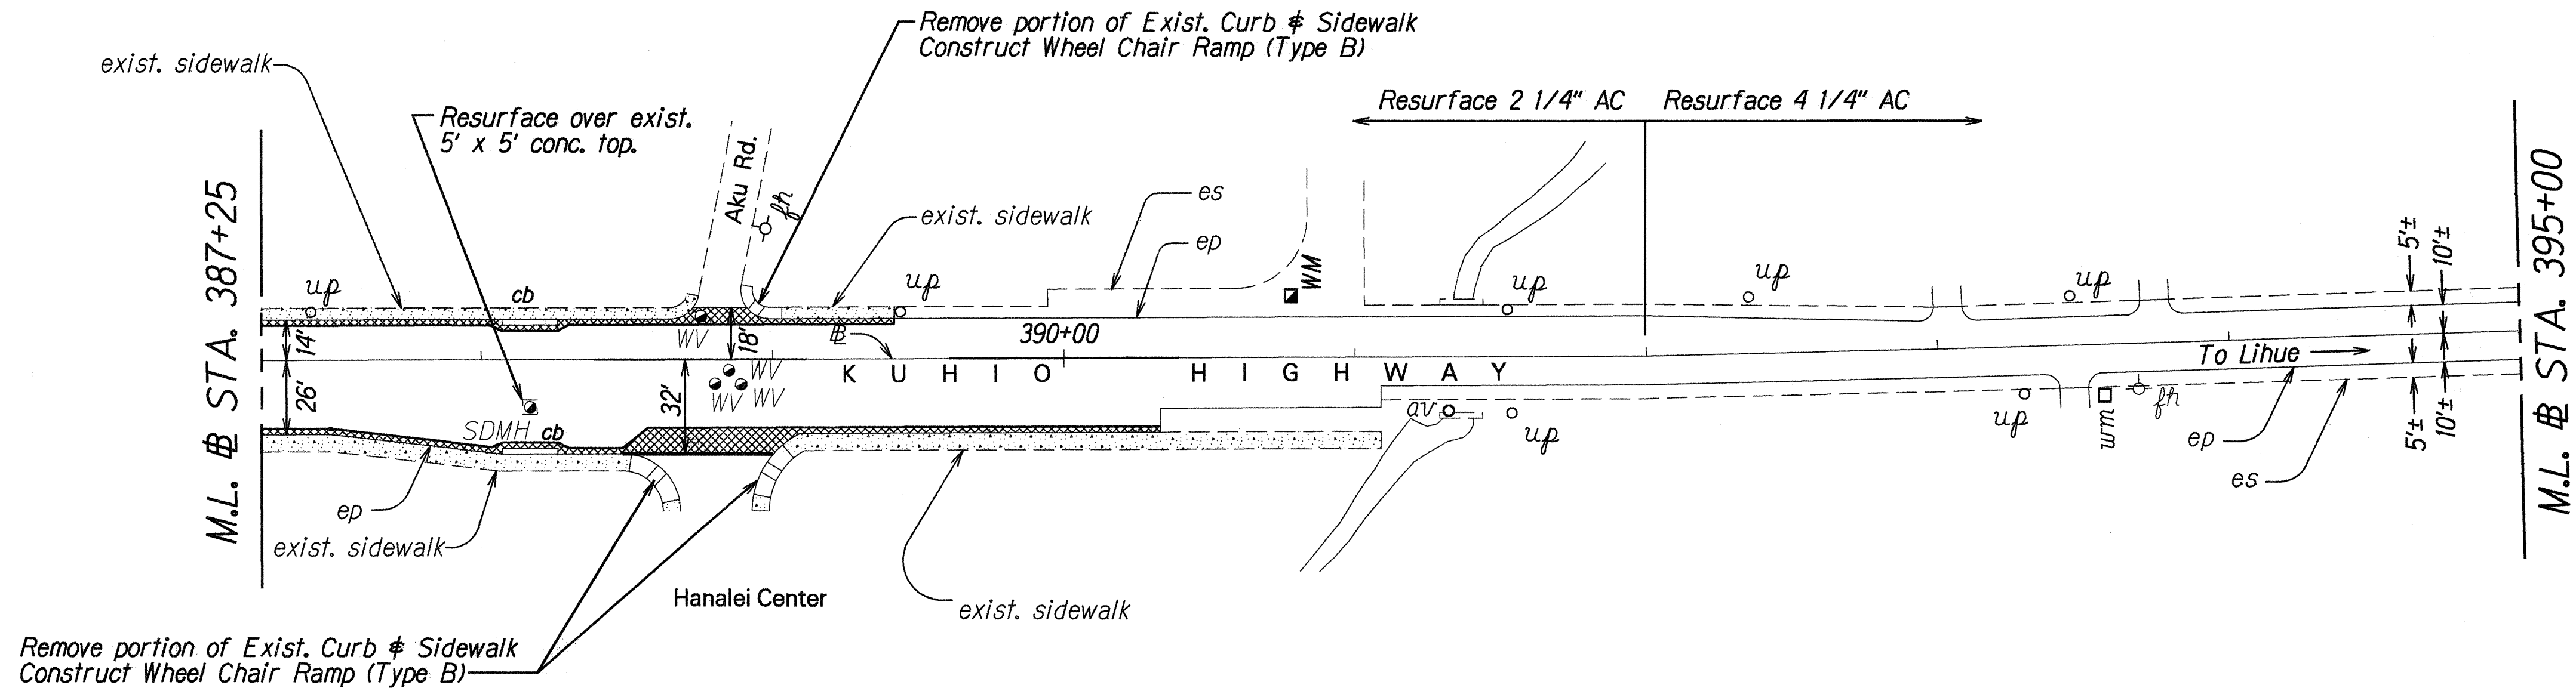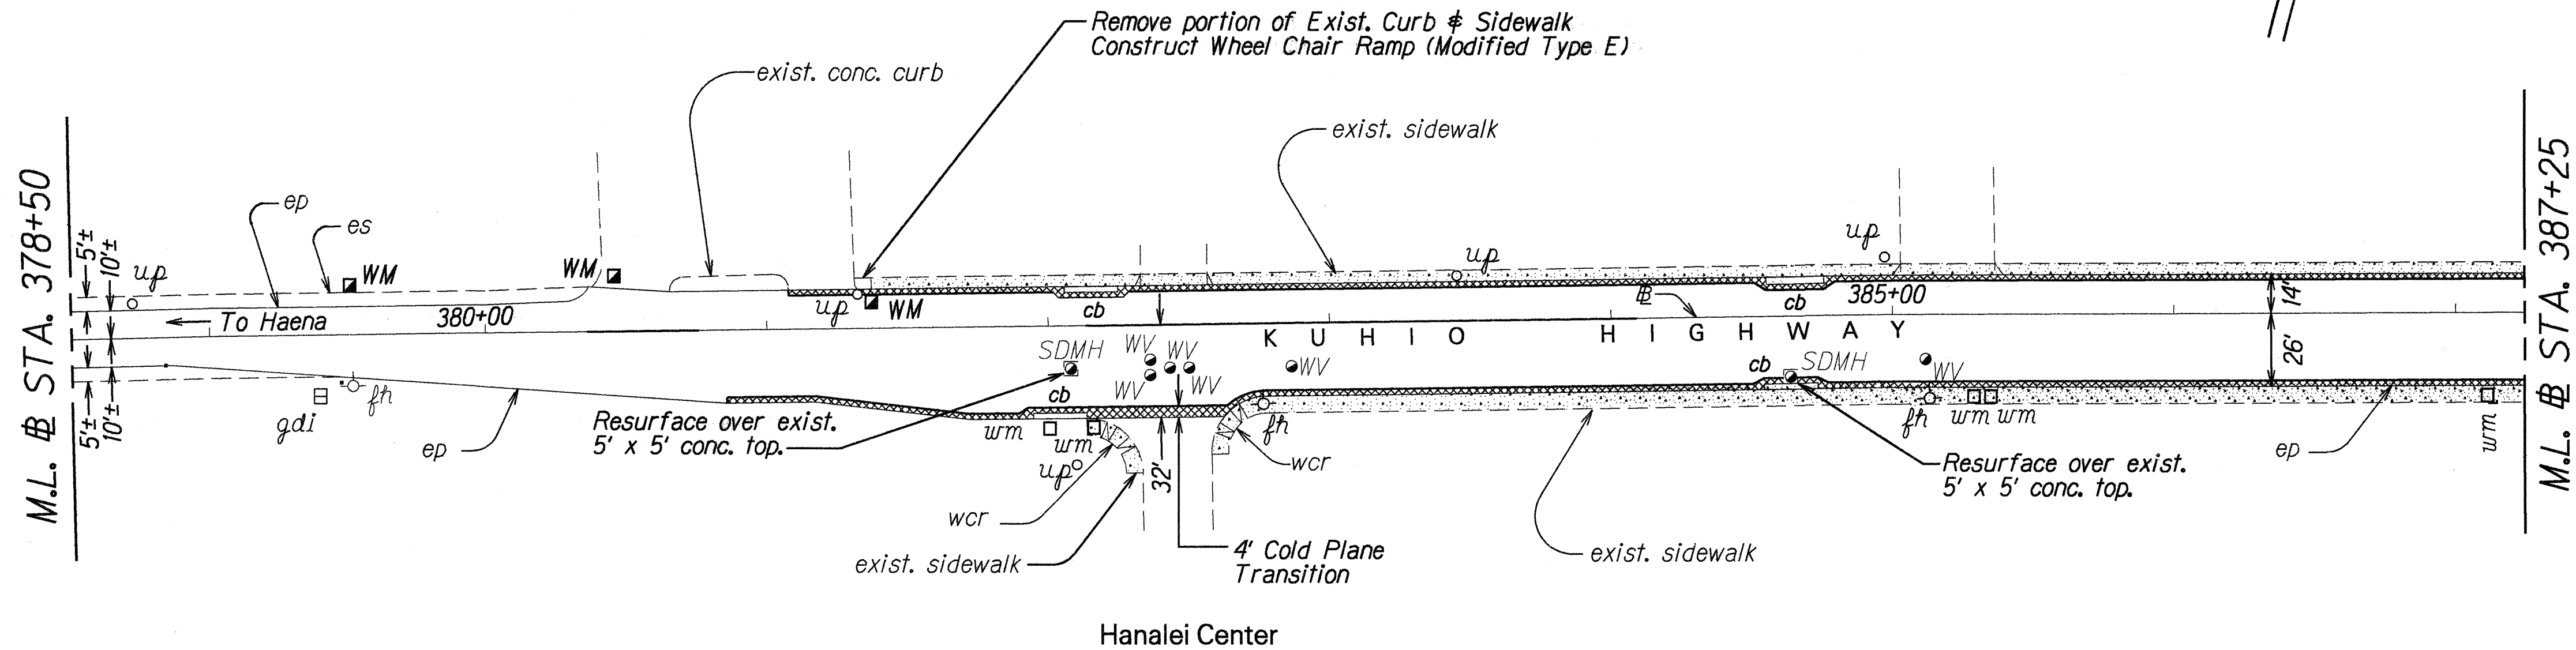

ORIGINAL PLAN	SURVEY PLOTTED BY	DATE
NOTED BOOK	DRAWN BY	5/11/96
DESIGNED BY	TRACED BY	
CHECKED BY	DESIGNED BY	
	CHECKED BY	

STATE OF HAWAII
DEPARTMENT OF TRANSPORTATION
HIGHWAYS DIVISION


ROADWAY PLAN

KUHIO HIGHWAY RESURFACING
Lumahai to Hanalei Town
Project No. 560A-01-96M

Scale: 1" = 40' Date: May, 1996

SHEET No. 10 OF 11 SHEETS

FED. ROAD DIST. NO.	STATE	PROJ. NO.	FISCAL YEAR	SHEET NO.	TOTAL SHEETS
HAWAII	HAW.	560A-01-96M	1996	17	32

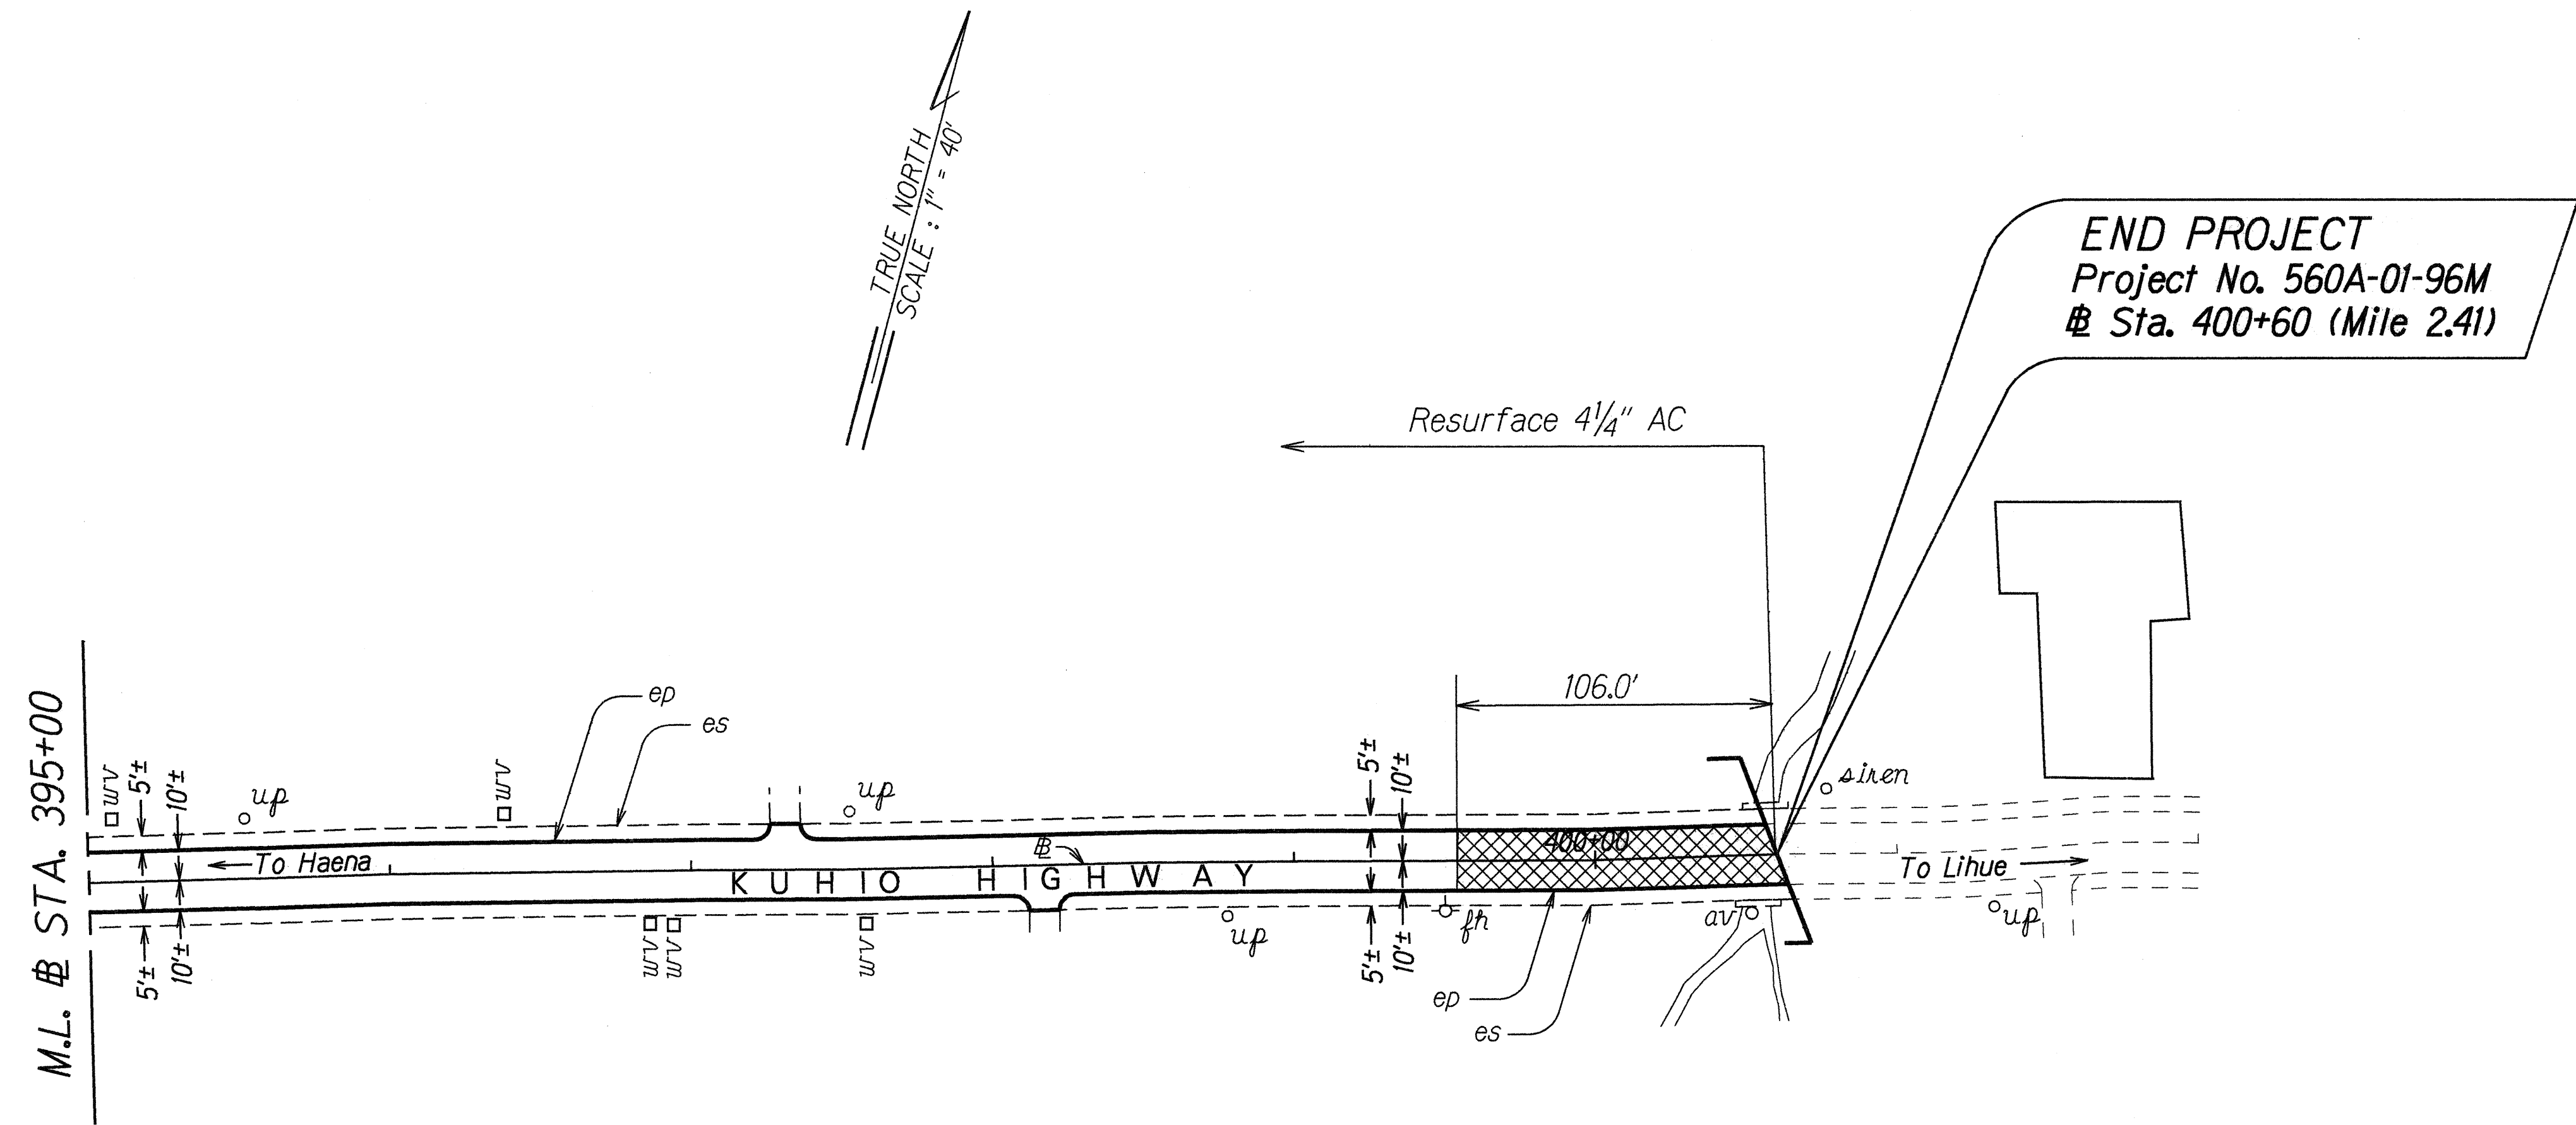

dd3/lyne

ORIGINAL PLAN	SURVEY PLOTTED BY	DATE
NOTED	DRAWN BY	5/11/96
DESIGNED BY	HW-K	
CHECKED BY	te-2 Gary	
	checked by	

STATE OF HAWAII
DEPARTMENT OF TRANSPORTATION
HIGHWAYS DIVISION

ROADWAY PLAN

KUHIO HIGHWAY RESURFACING
Lumalai to Hanalei Town
Project No. 560A-01-96M

Scale: 1" = 40' Date: May, 1996

SHEET No. 11 OF 11 SHEETS