

STATE OF HAWAII

DEPARTMENT OF TRANSPORTATION

HIGHWAYS DIVISION HONOLULU, HAWAII "AS-BUILT"


PLANS FOR

KUHIO HIGHWAY RESURFACING

LUMAHAI TO HANALEI TOWN PROJECT NO. 560A-01-96M

> DISTRICT OF HANALEI **ISLAND OF KAUAI**


> > LAYOUT PLAN

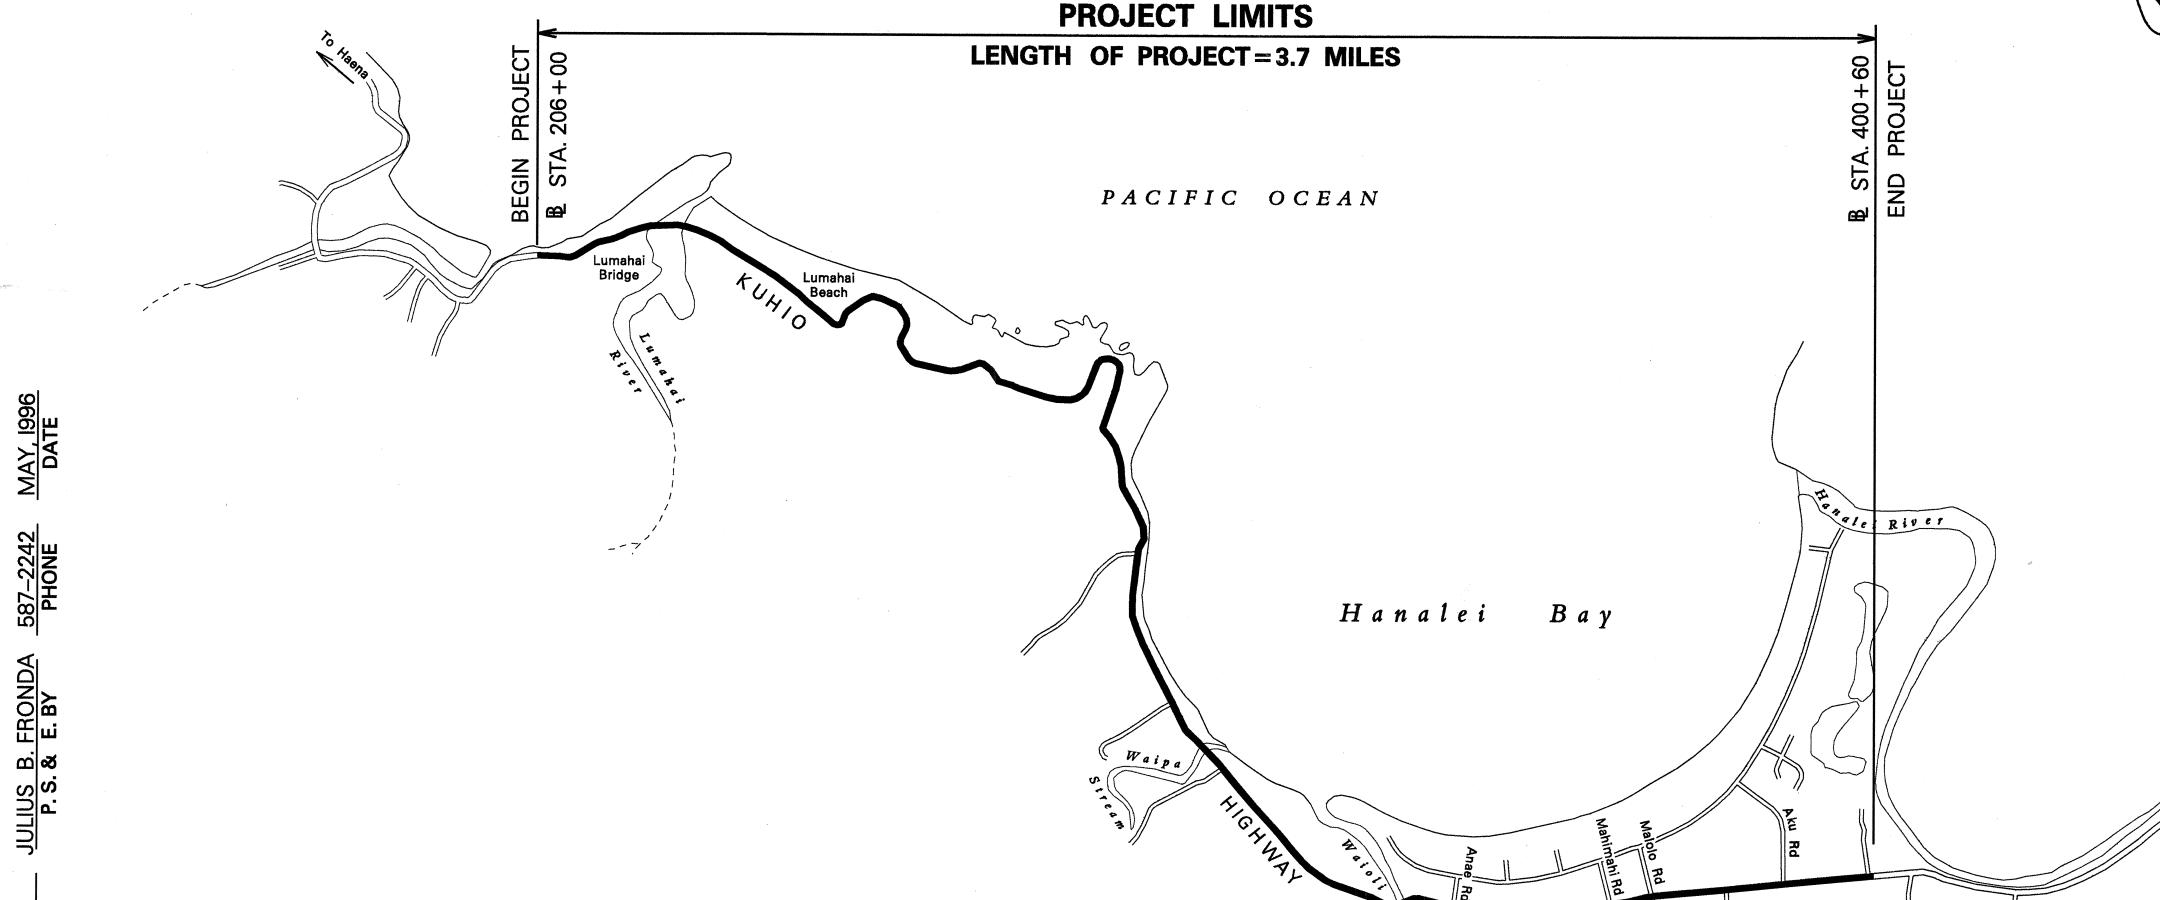


SCALE IN THOUSAND FEET

FED. ROAD DIST. NO. FISCAL SHEET NO. PROJ. NO. SHEETS 560A-01-96M



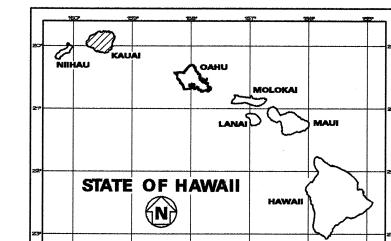


LOCATION OF PROJECT

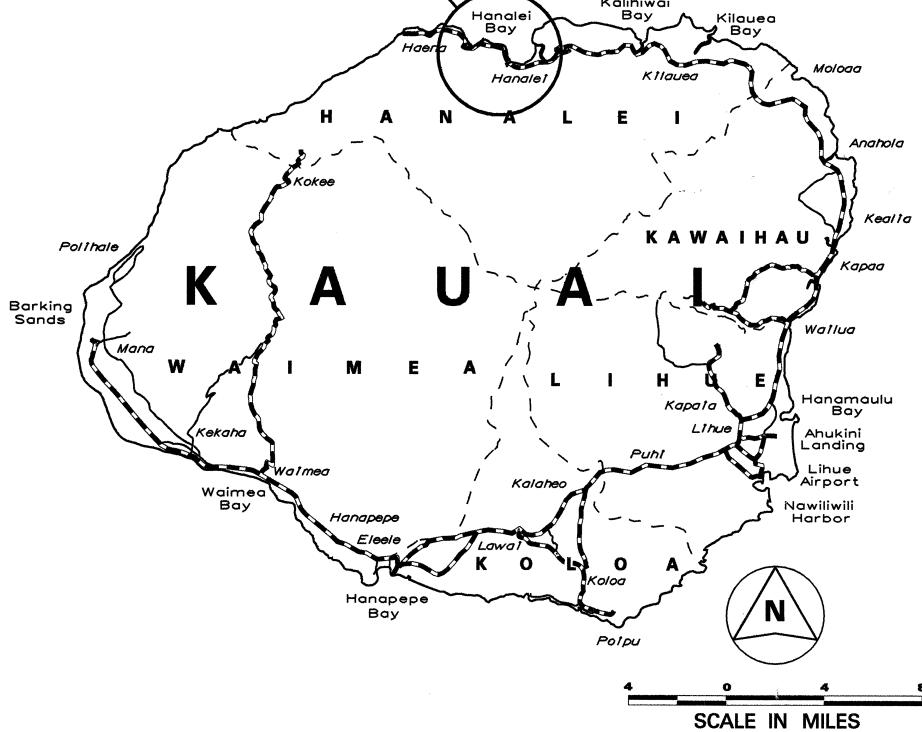

FEDERAL AID PROJECTS PREVIOUSLY CONSTRUCTED OR UNDER CONSTRUCTION

MILE POST <u>2.4</u> TO MILE POST <u>6.1</u>

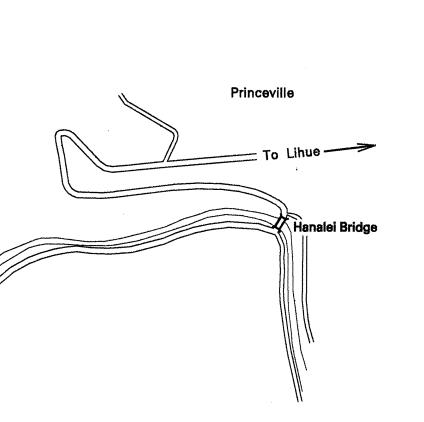

DEPARTMENT OF TRANSPORTATION STATE OF HAWAII

APPROVED:

DIR. OF TRANSPORTATION

BEEN NOTED ON THESE PLANS AND CHECKED BY: RESIDENT ENGINEER

CHANGES MADE DURING CONSTRUCTION HAVE