


| INDEX TO DRAWINGS |                                |
|-------------------|--------------------------------|
| SHEET             | DESCRIPTION                    |
| 1                 | TITLE SHEET                    |
| 2                 | BORING LOCATION PLAN & PROFILE |

STATE OF HAWAII  
DEPARTMENT OF TRANSPORTATION  
HIGHWAYS DIVISION  
"AS BUILT"  
PLANS FOR

KAUAI BELT ROAD  
SUBSTRATA INVESTIGATION


FEDERAL AID SECONDARY PROJ. NO. S-0560(I) UNIT I  
(KAUAI BELT ROAD, LUMAHAI BRIDGE AND APPROACHES)

DISTRICT OF HANAIEI  
ISLAND OF KAUAI

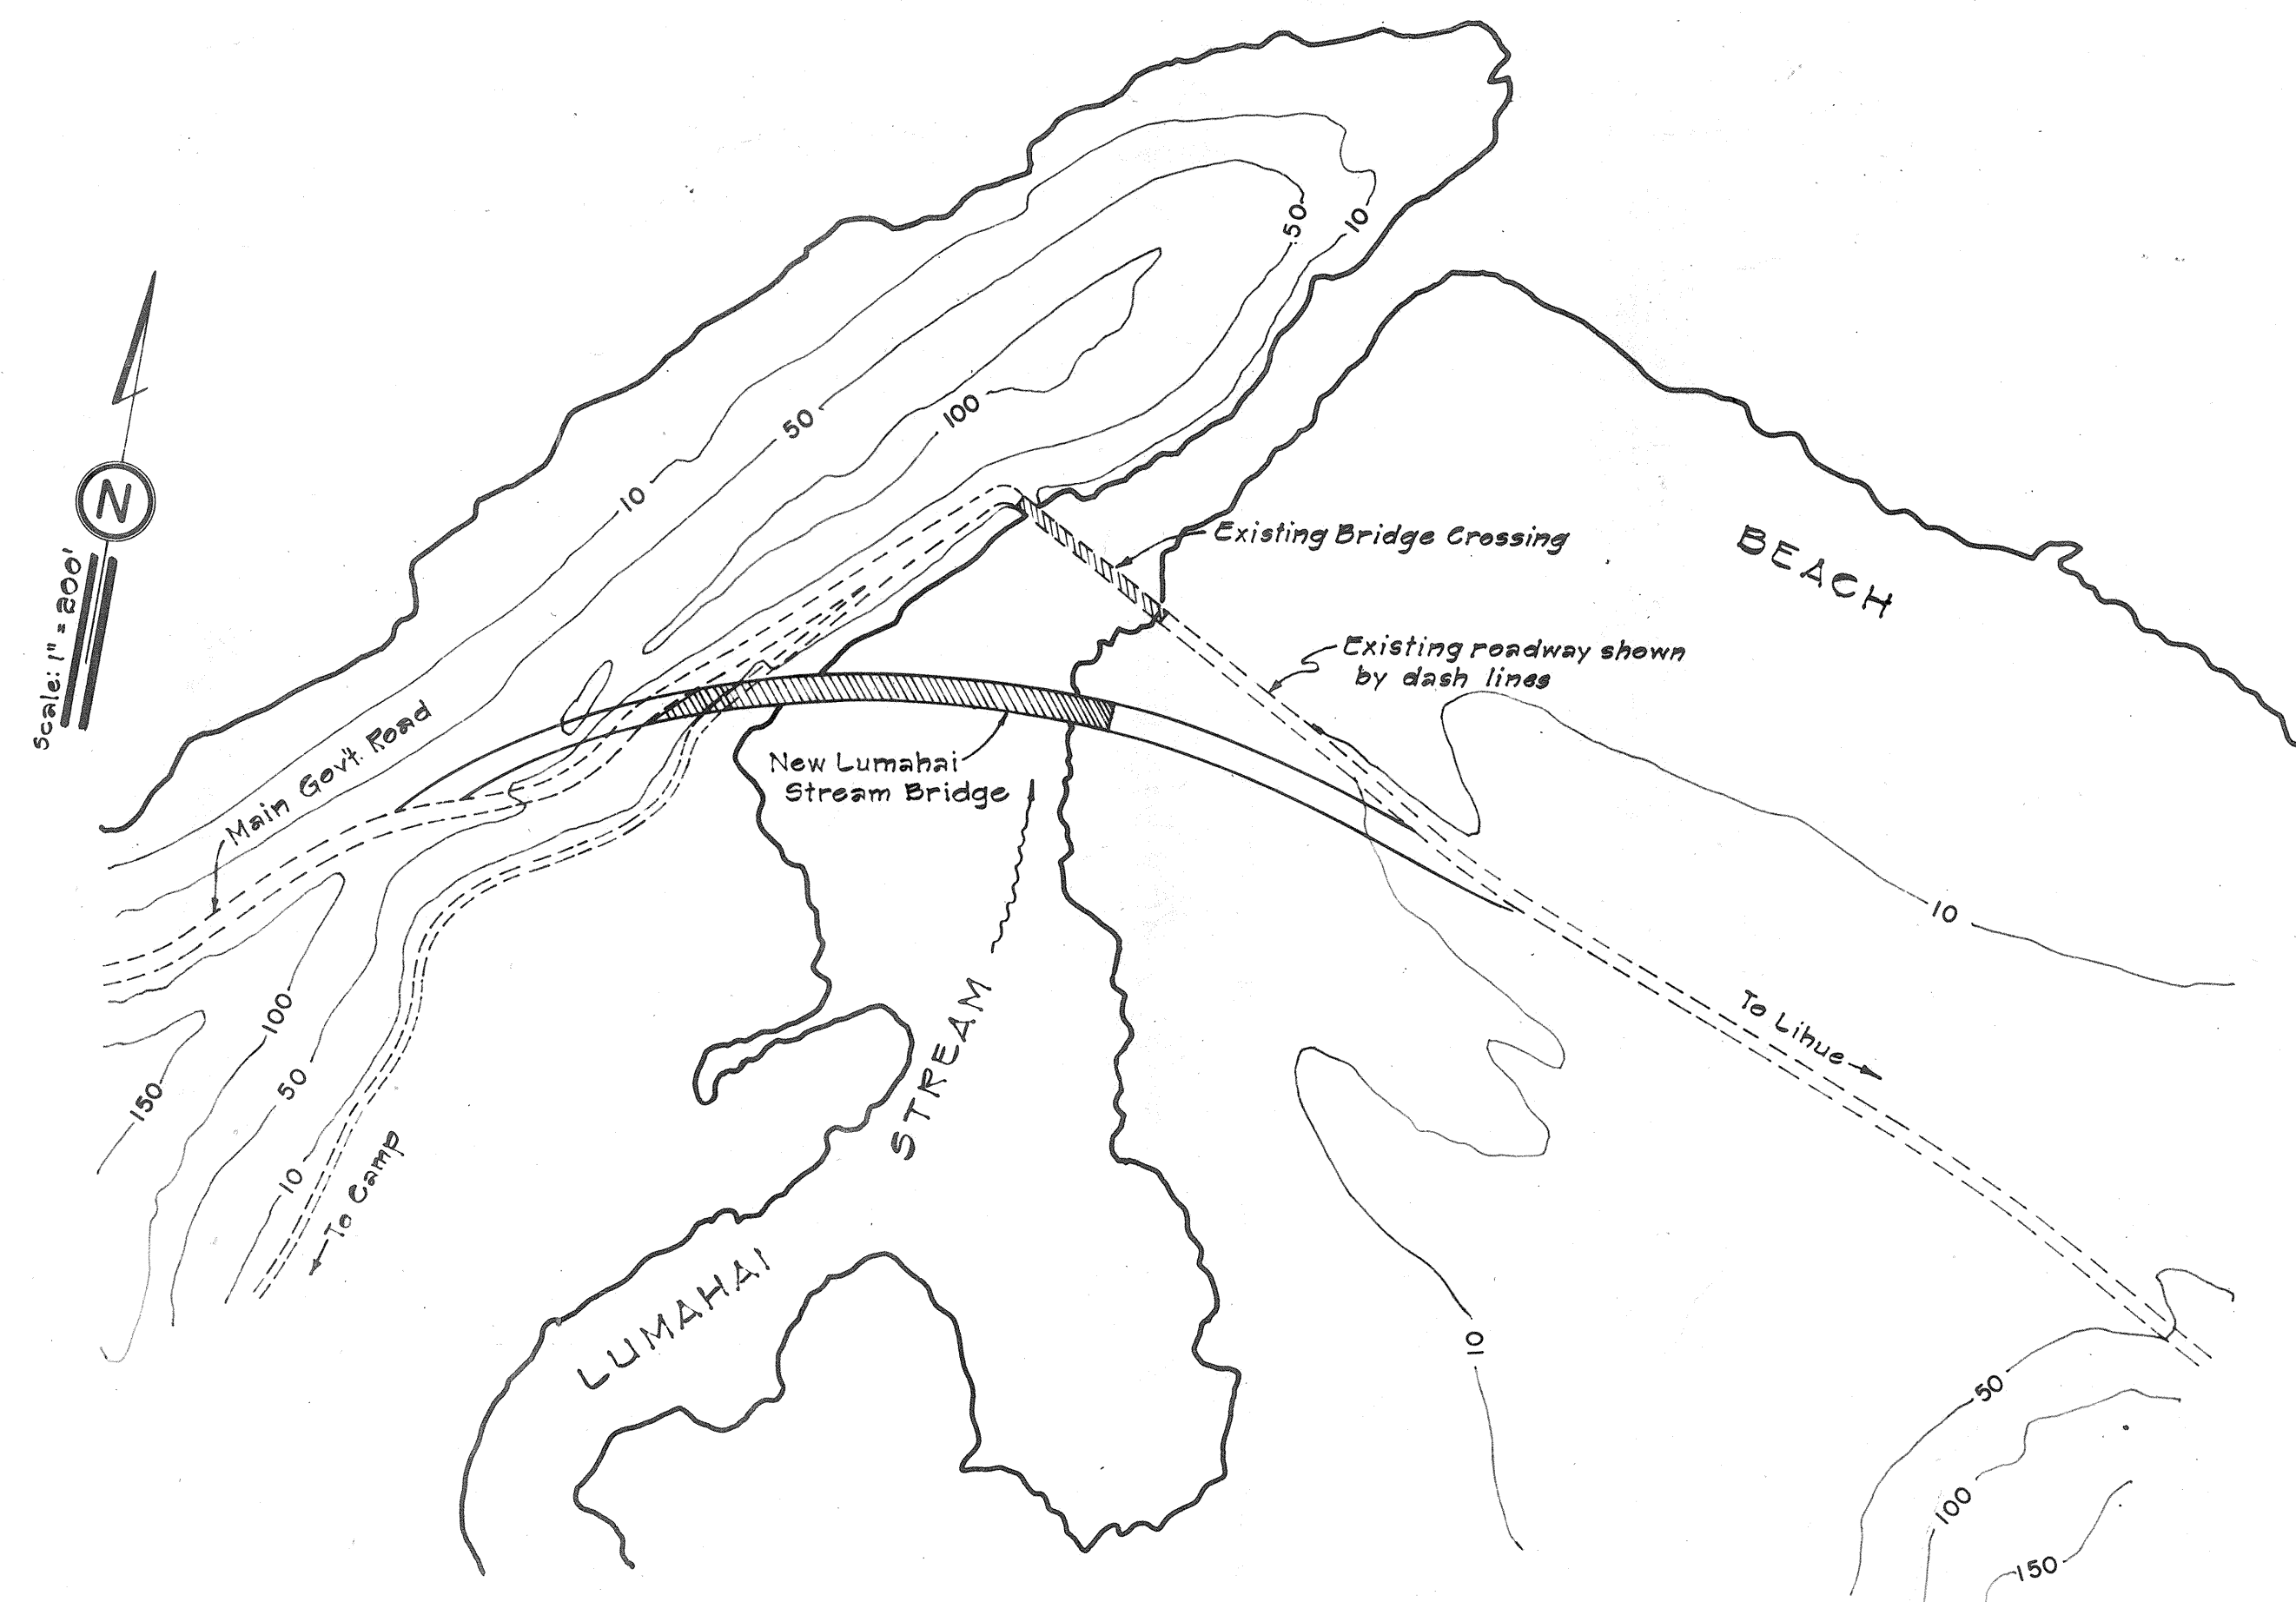

LAYOUT PLAN

LOCATION OF PROJECT  
S-0560(I) UNIT I

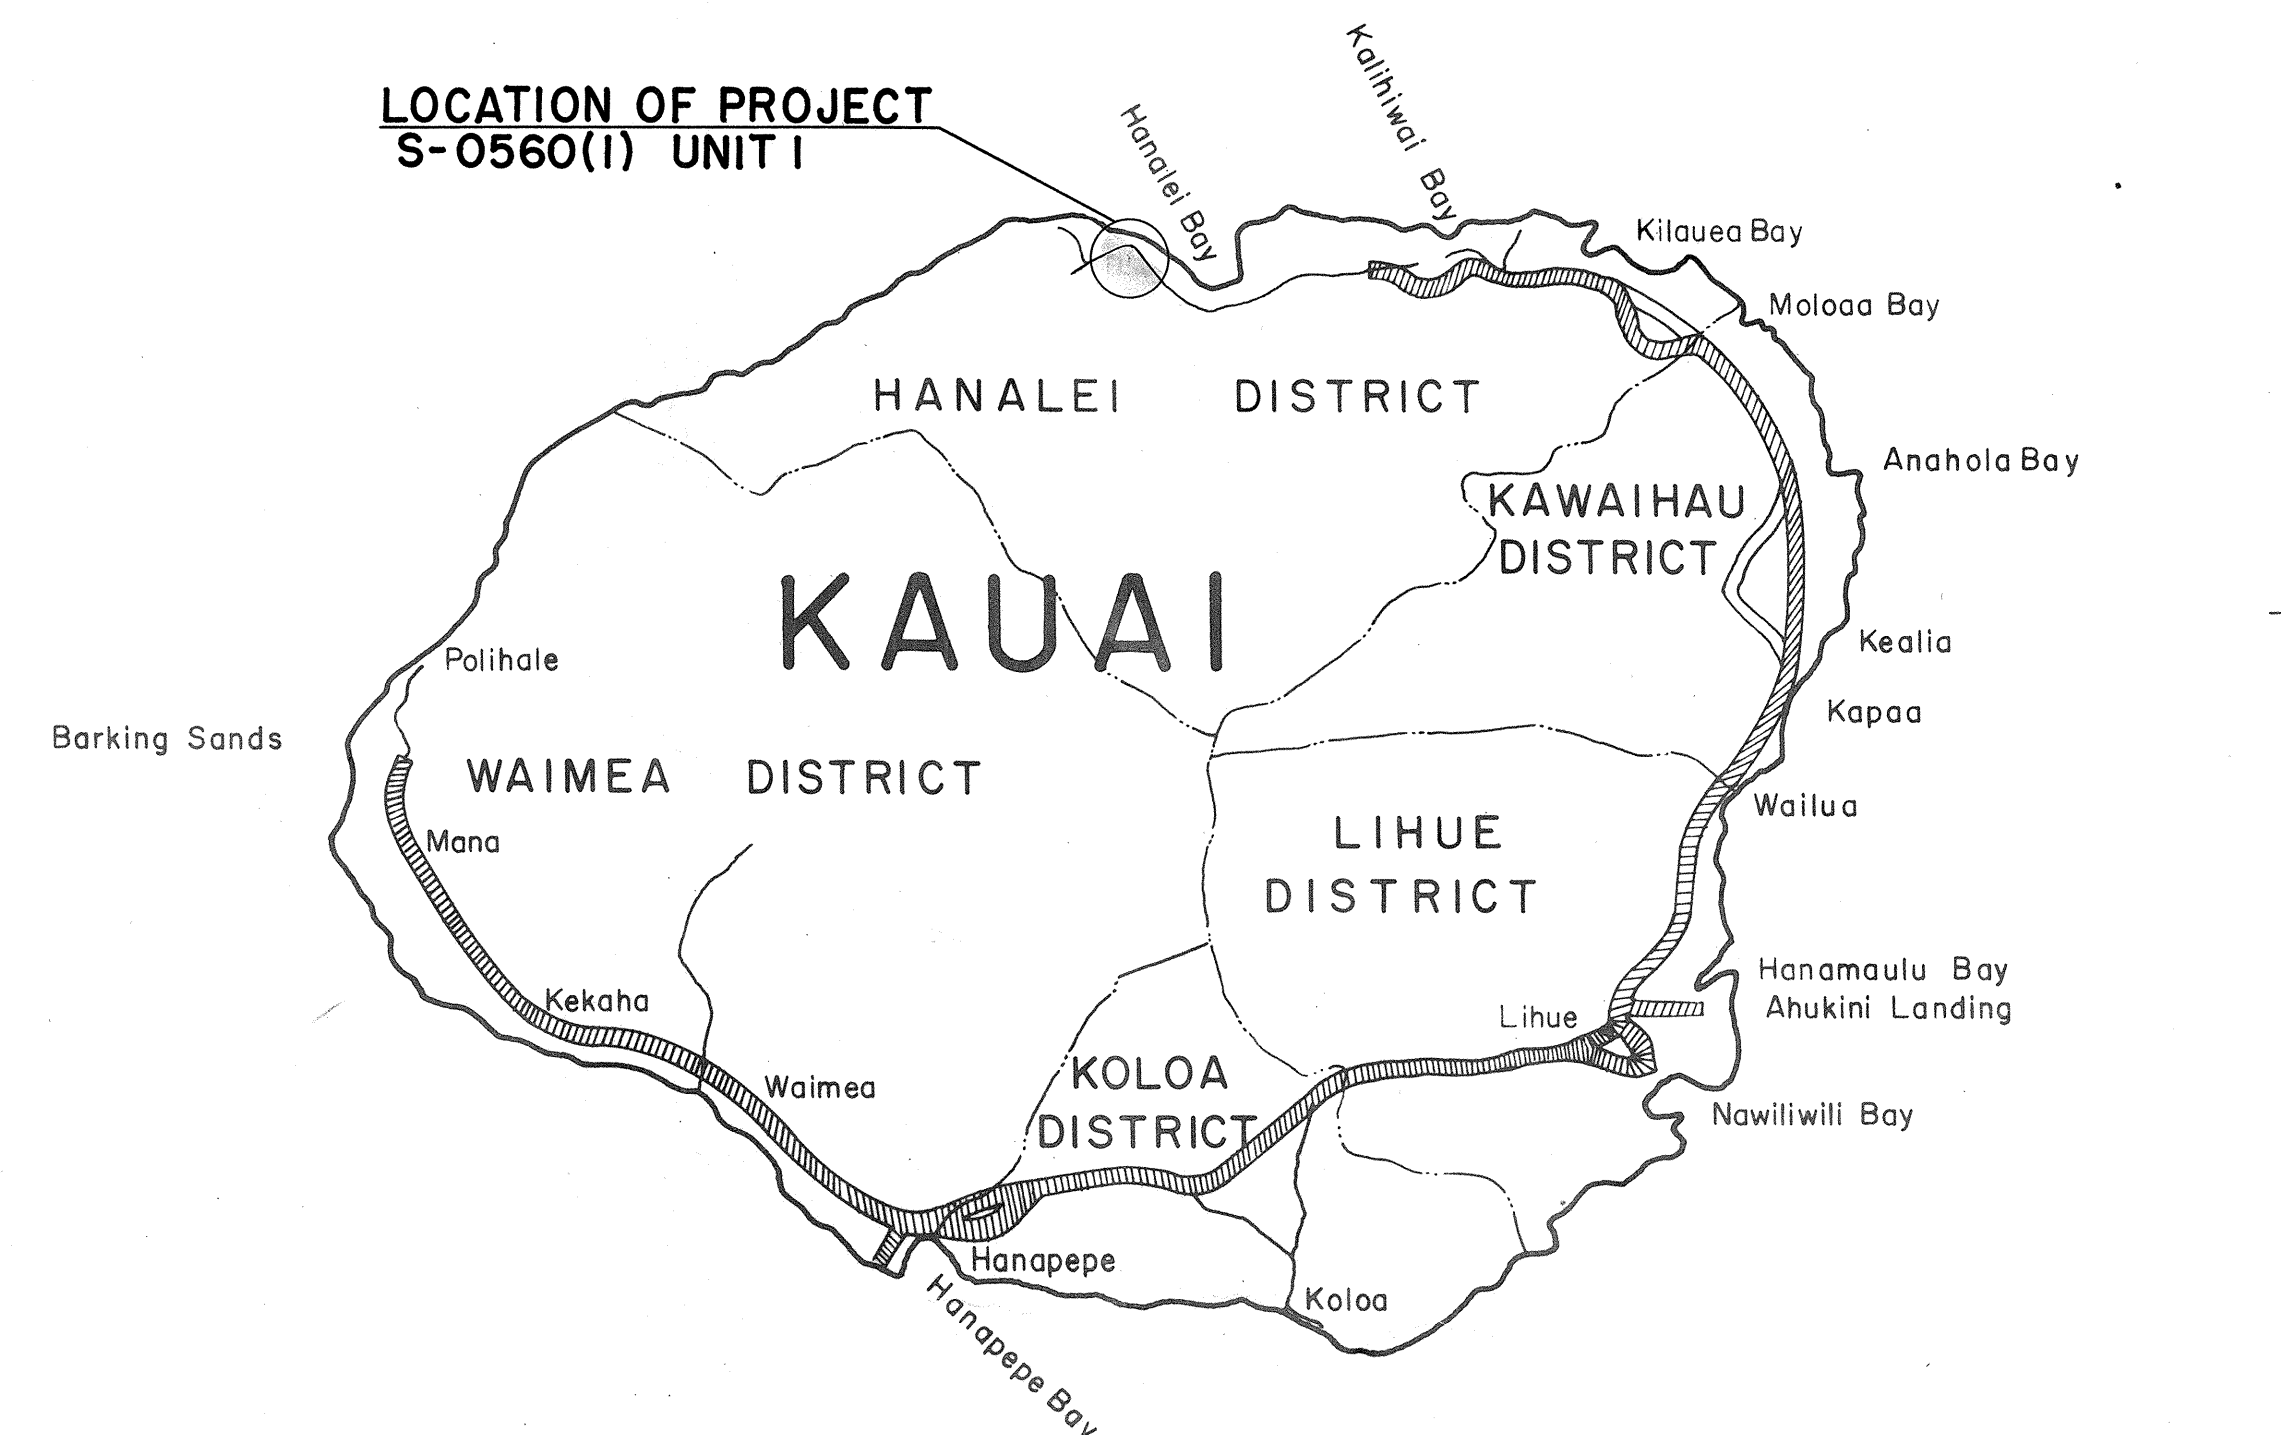

FEDERAL AID PROJECTS PREVIOUSLY CONSTRUCTED OR UNDER CONSTRUCTION

NOTE :

ALL CHANGES MADE DURING CONSTRUCTION  
HAVE BEEN NOTED ON THESE TRACINGS IN  
RED AND CHECKED BY :

*Atsushi Hiromaka*  
PROJECT ENGINEER

3/14/68  
DATE

APPROVED:

DATE: 23 Dec 65

*Louis H. H. H.*  
DIRECTOR OF TRANSPORTATION

APPROVED:

*John B. Dalhouse*  
DIVISION ENGINEER  
DATE