



PLAN	DATE	BY	DATE
SURVEYED			
PLOTTED			
CHECKED			
NO.			

PROFILE	DATE	BY	DATE
SURVEYED			
PLOTTED			
CHECKED			
NO.			

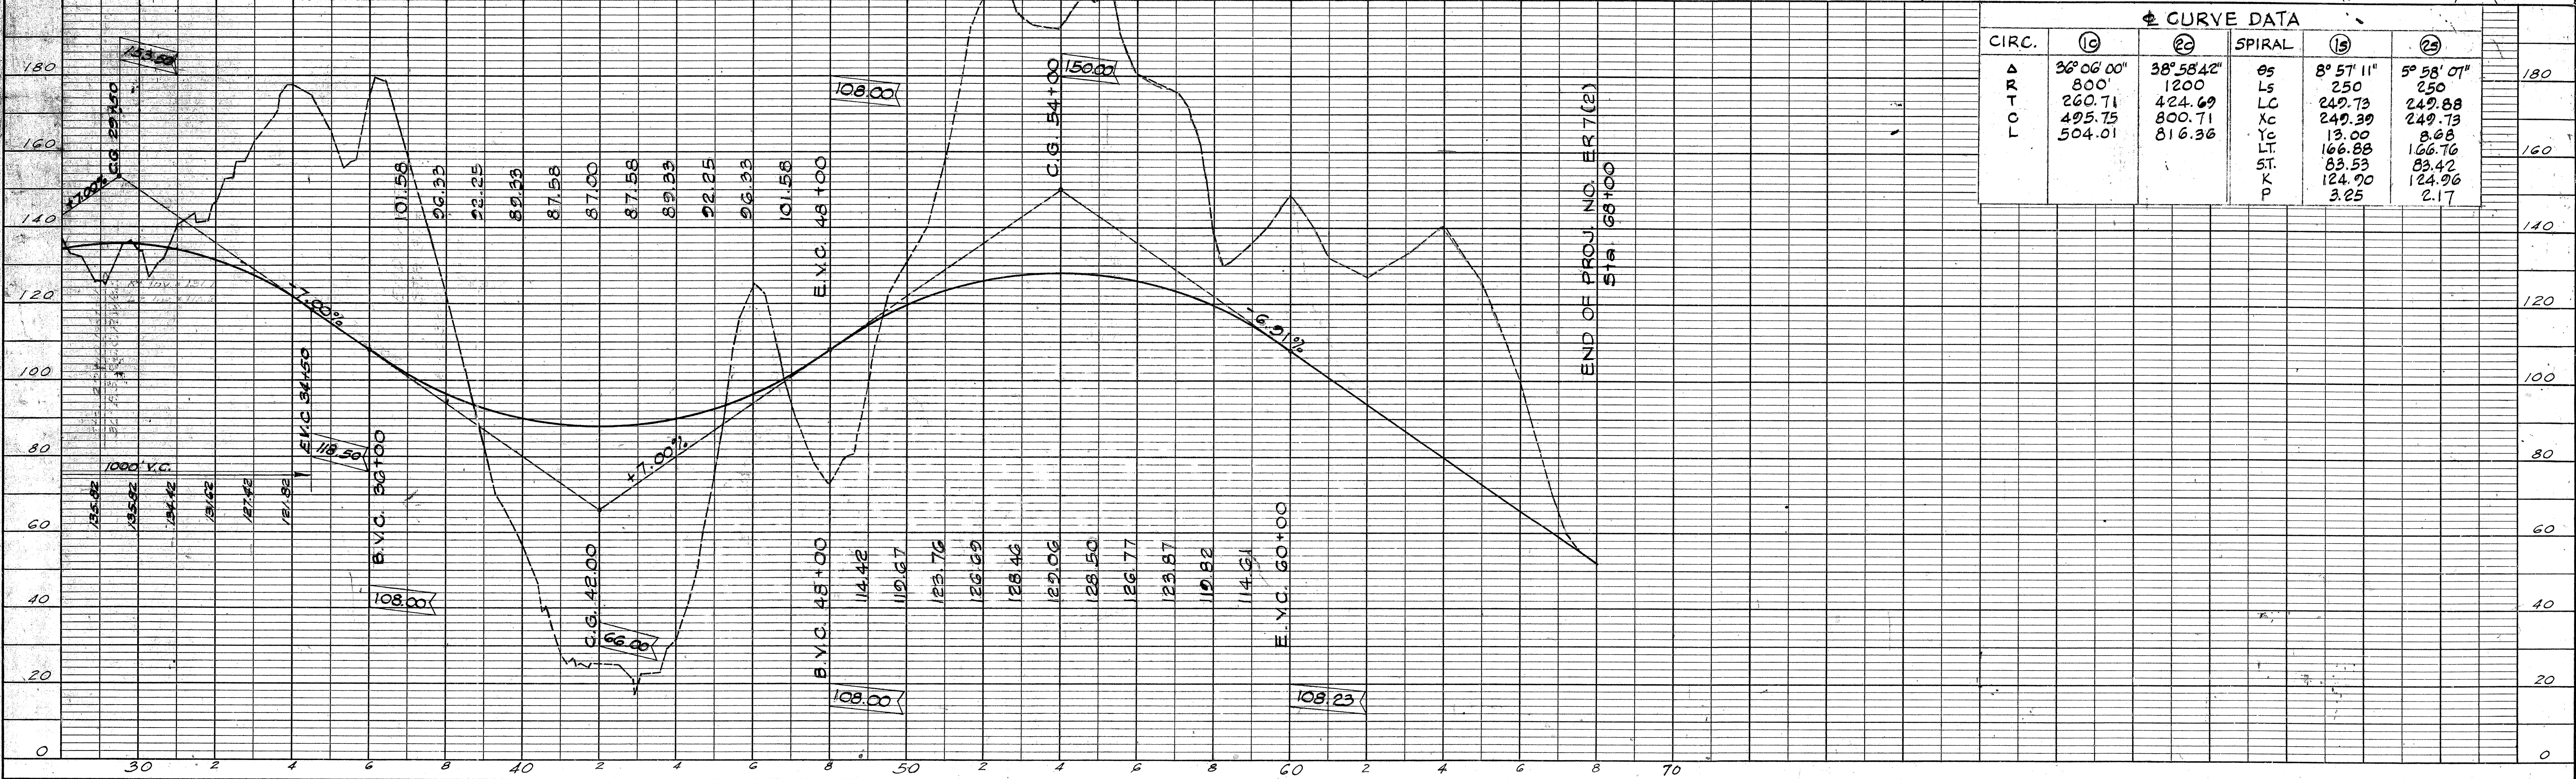

CURVE DATA				
CIRC.	19	29	SPIRAL	19
Δ	36° 06' 00"	38° 58' 42"	05	8° 57' 11"
L_s	800'	1200'	LC	250'
L_c	260.71	424.69	LC	249.73
L_t	495.75	800.71	XC	249.39
L_p	504.01	816.36	YC	13.00
			LT	166.88
			ST	83.53
			K	124.70
			P	3.25
				2.17

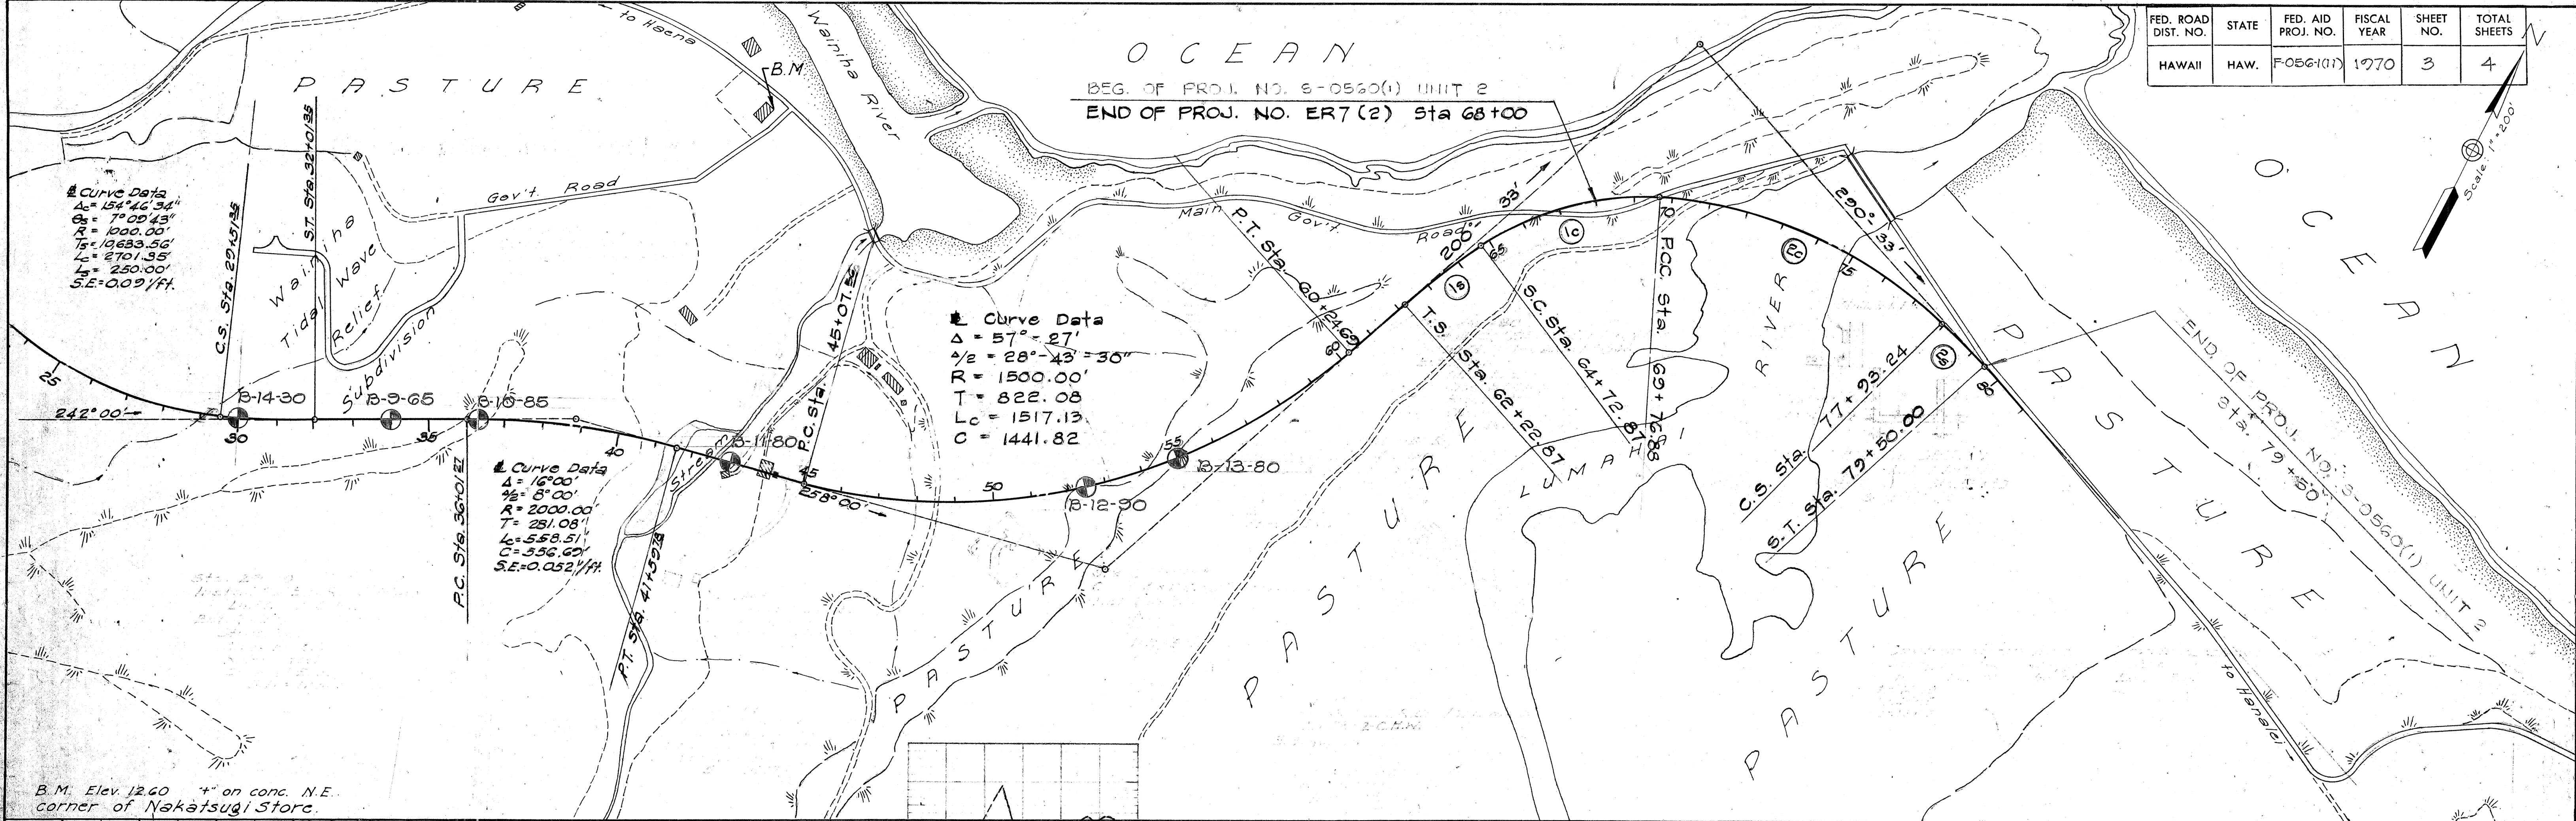