

FED. ROAD DIST. NO.	STATE	PROJ. NO.	FISCAL YEAR	SHEET NO.	TOTAL SHEETS
HAWAII	HAW.	560A-02-12	2012	8	36


TRUE NORTH
SCALE: 1" = 20'

NAIL W/ SHINER
ELEV.=121.54
N 3333.98
W 20588.53

BEGIN PROJECT
Project No. 560A-02-12
Sta. 0+00 KUHIO HWY

SPIKE
ELEV.=135.88
N 3101.94
W 20467.76

Sta. 4+15.95 KUHIO HWY
Project No. 560A-02-12
END PROJECT

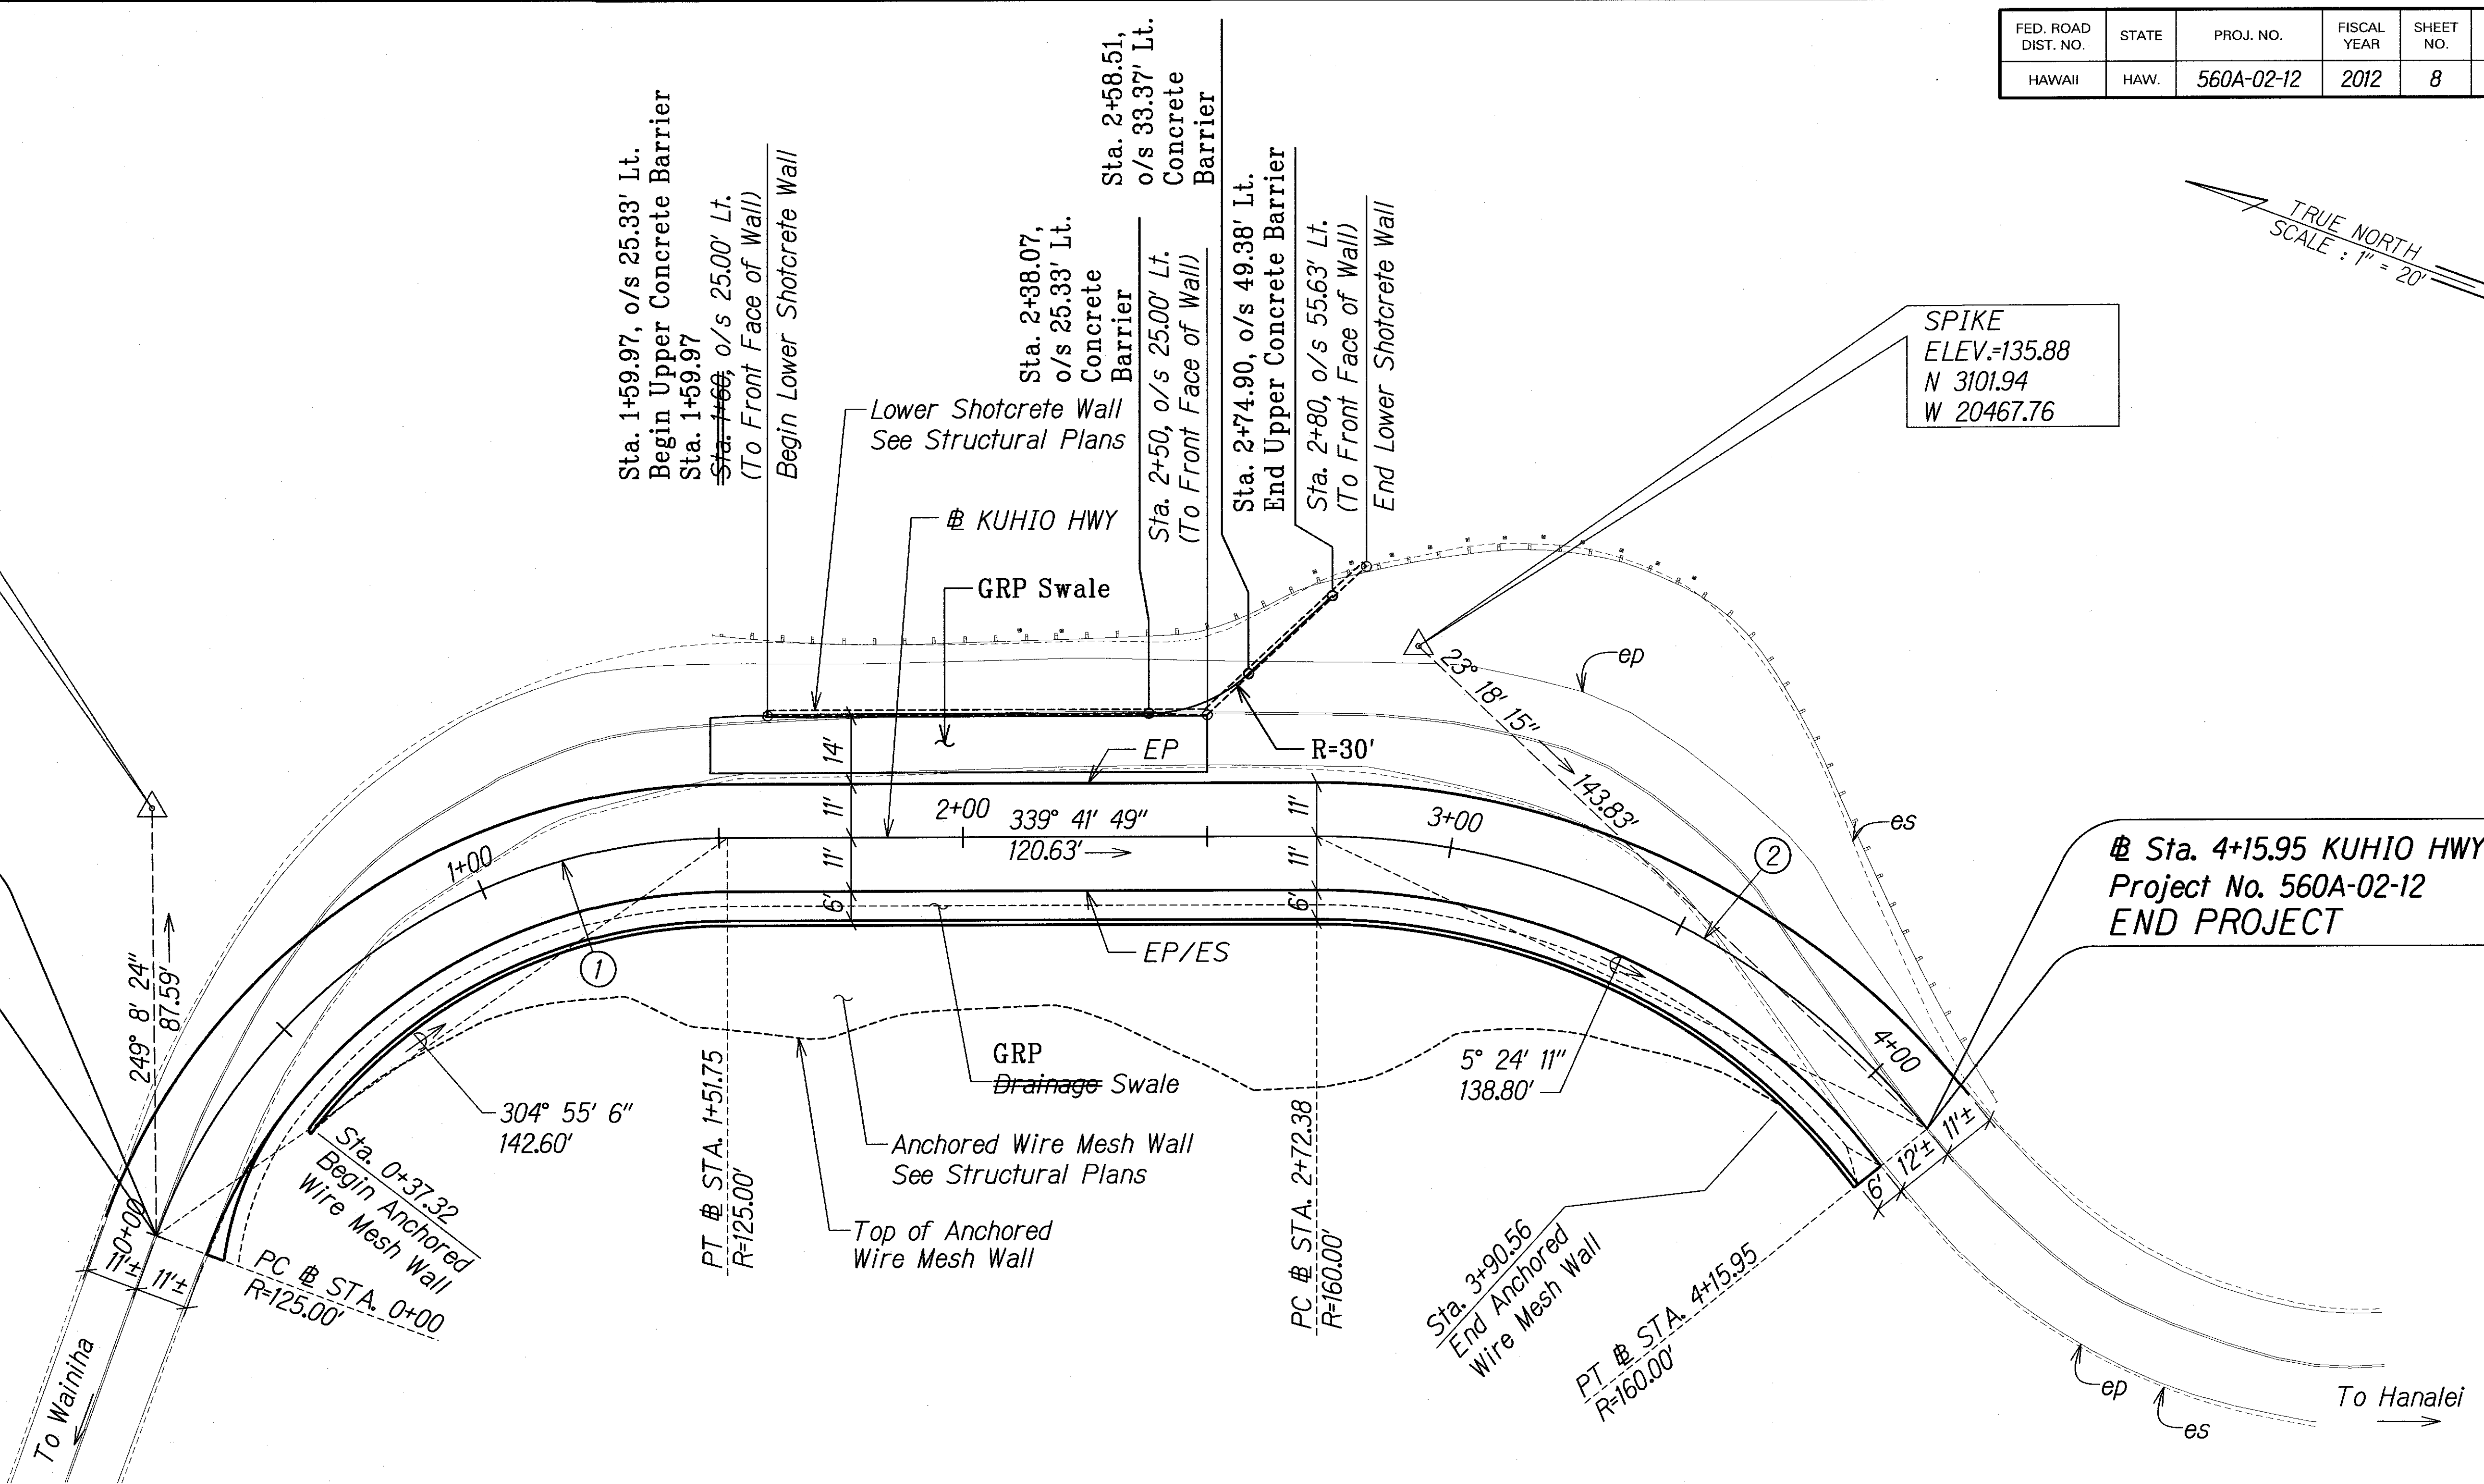

CURVE DATA		
	①	②
Δ	69° 33' 28"	51° 24' 44"
Δ/2	34° 46' 43"	25° 42' 22"
R	125.00	160.00
T	86.81	77.02
C	142.60	138.80
L _C	151.75	143.57

LEGEND FOR AS-BUILT POSTINGS

~~~~~ Squiggly line for as-built deletion

== Double line for as-built deletion

Roadway Text for as-built posting

PAMELA K. UYEDA  
LICENSED PROFESSIONAL ENGINEER  
No. 10352-C  
HAWAII, U.S.A.

THIS WORK WAS PREPARED BY ME OR UNDER MY SUPERVISION.

*[Signature]* 04/30/12  
SIGNATURE EXPIRATION DATE OF THE LICENSE

STATE OF HAWAII  
DEPARTMENT OF TRANSPORTATION  
HIGHWAYS DIVISION

**ALIGNMENT PLAN**

KUHIO HIGHWAY EMERGENCY SLOPE REPAIRS  
Vicinity of Lumahai  
Project No. 560A-02-12  
Scale: As Shown Date: Oct. 17, 2011

|                   |      |
|-------------------|------|
| ORIGINAL PLAN     | DATE |
| SURVEY PLOTTED BY |      |
| DRAWN BY          |      |
| TRACED BY         |      |
| DESIGNED BY       |      |
| NOTED BY          |      |
| CHECKED BY        |      |
| DATE              |      |