


FED. ROAD DIST. NO.	STATE	PROJ. NO.	FISCAL YEAR	SHEET NO.	TOTAL SHEETS
HAWAII	HAW.	560A-02-12	2012	18	36

FINAL

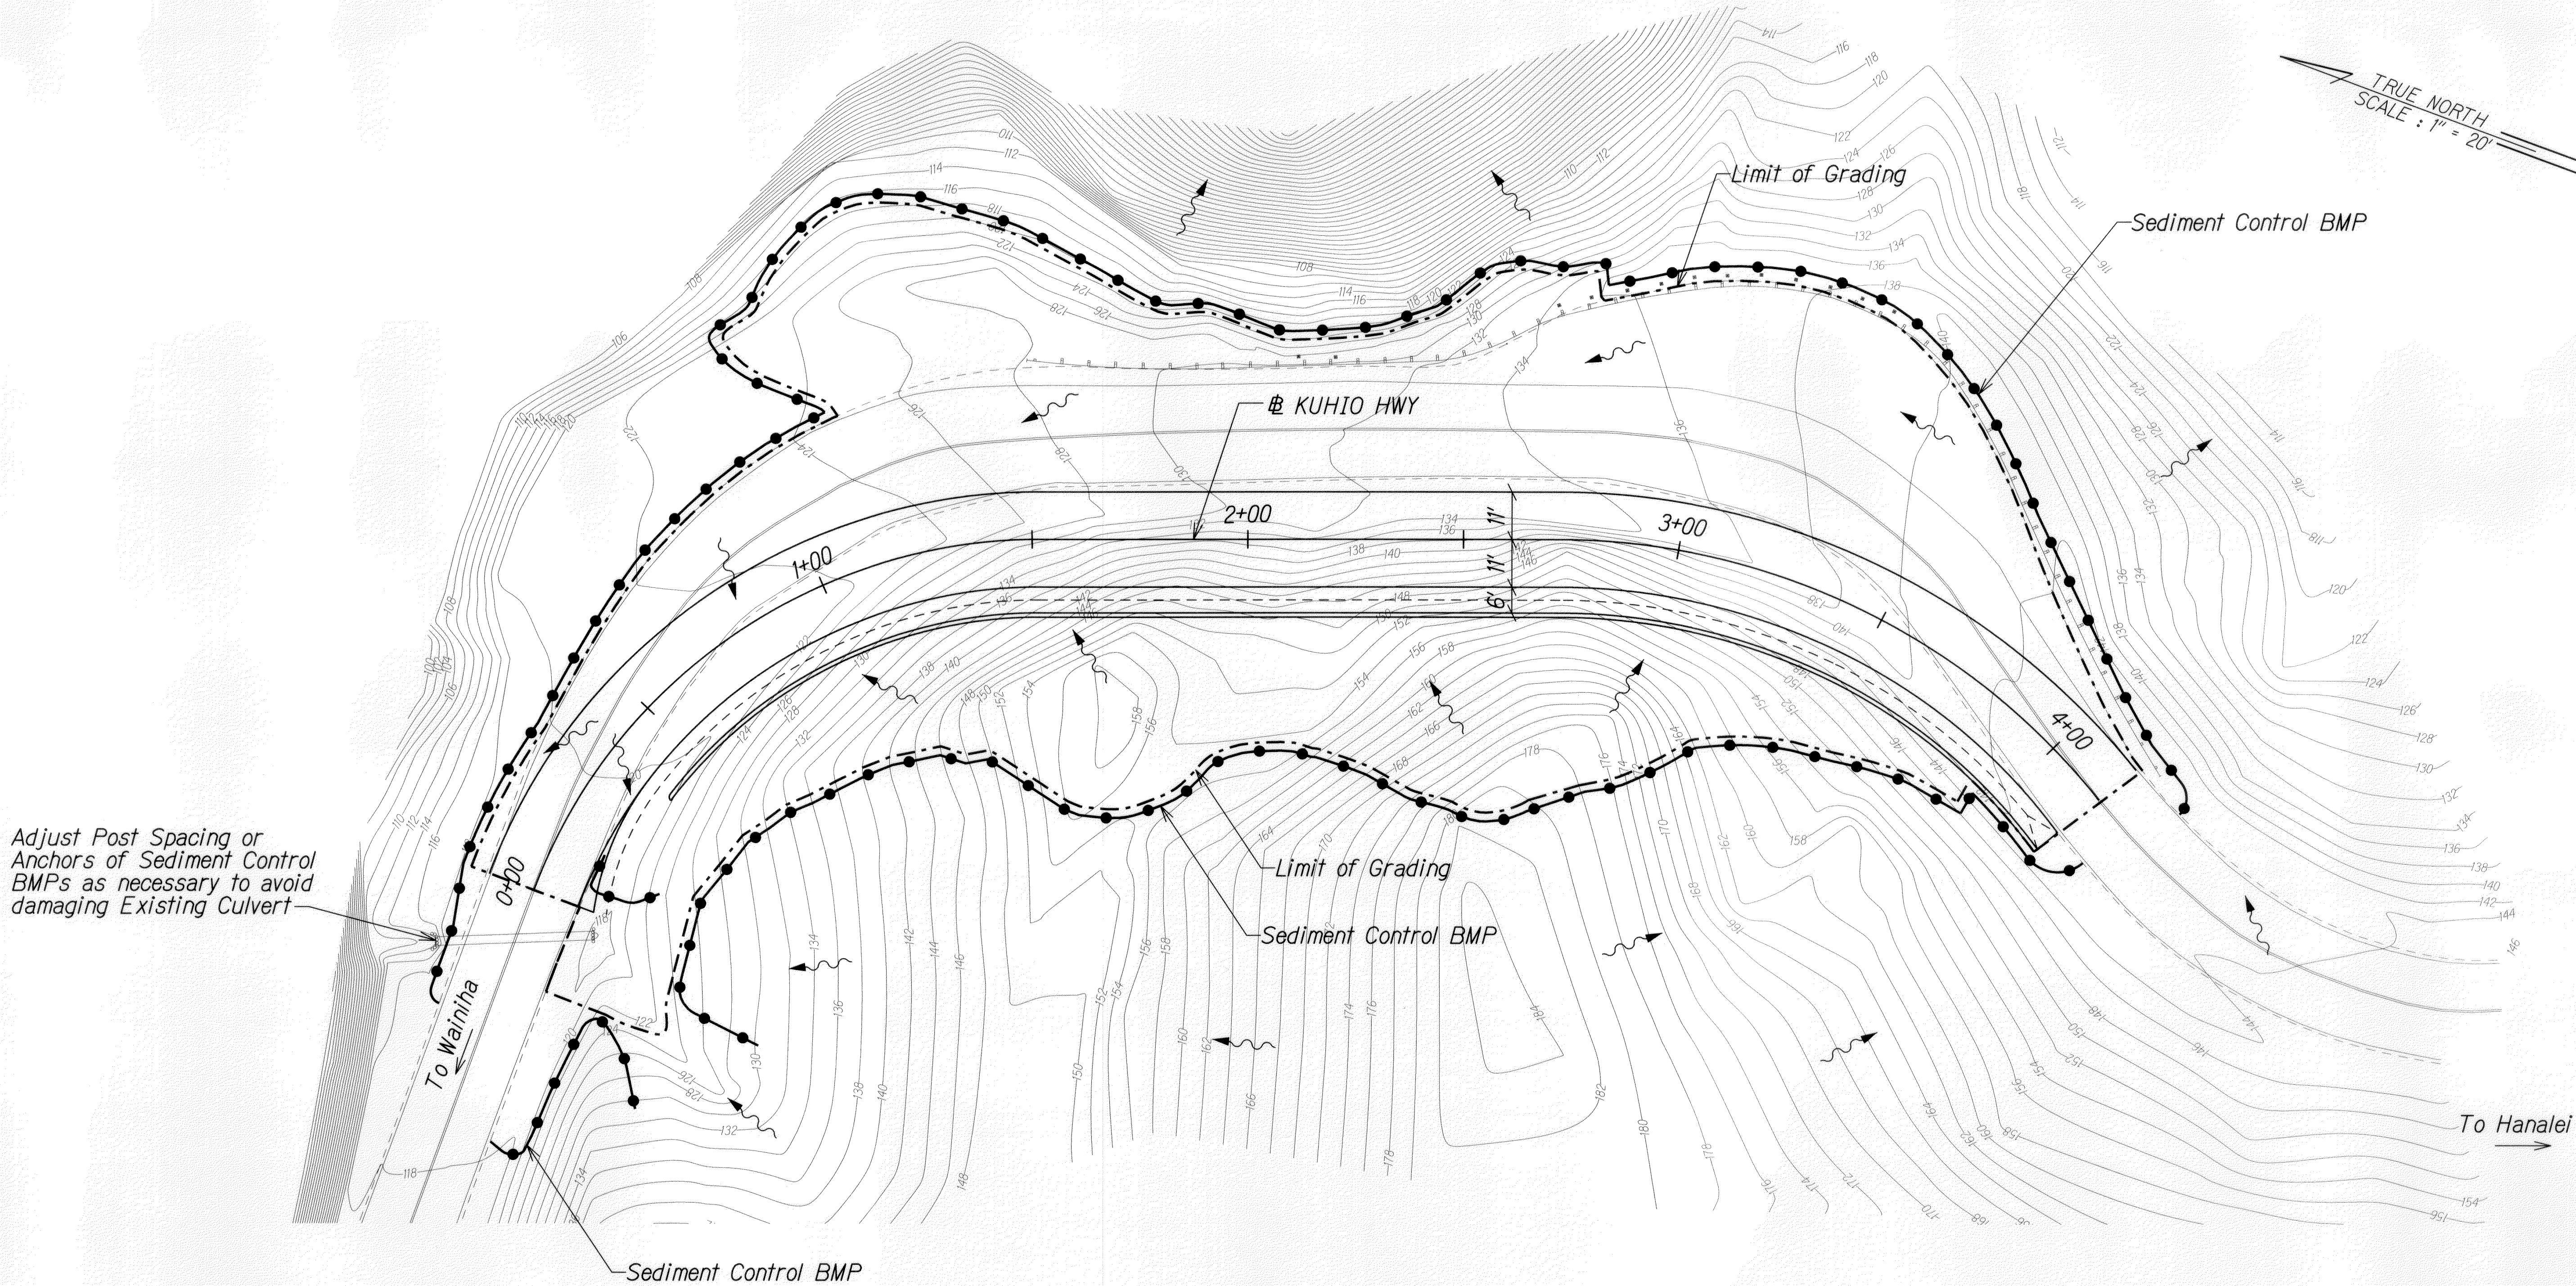

Adjust Post Spacing or Anchors of Sediment Control BMPs as necessary to avoid damaging Existing Culvert

Sediment Control BMP

- LEGEND:**
- Limit of Grading
 - Sediment Control BMP
 - ~ Flow Arrows
 - Existing Contours

ORIGINAL PLAN	DATE
NOTED BY	
DESIGNED BY	
CHECKED BY	

THIS WORK WAS PREPARED BY ME OR UNDER MY SUPERVISION.

[Signature] 04/30/12

SIGNATURE EXPIRATION DATE OF THE LICENSE

STATE OF HAWAII
DEPARTMENT OF TRANSPORTATION
HIGHWAYS DIVISION

EROSION CONTROL PLAN

KUHIO HIGHWAY EMERGENCY SLOPE REPAIRS
Vicinity of Lumahai

Project No. 560A-02-12
Scale: As Shown Date: Oct. 17, 2011

SHEET No. C6J OF 18 SHEETS