



FED. ROAD DIST. NO.	STATE	PROJ. NO.	FISCAL YEAR	SHEET NO.	TOTAL SHEETS
HAWAII	HAW.	560A-02-12	2012	36	36

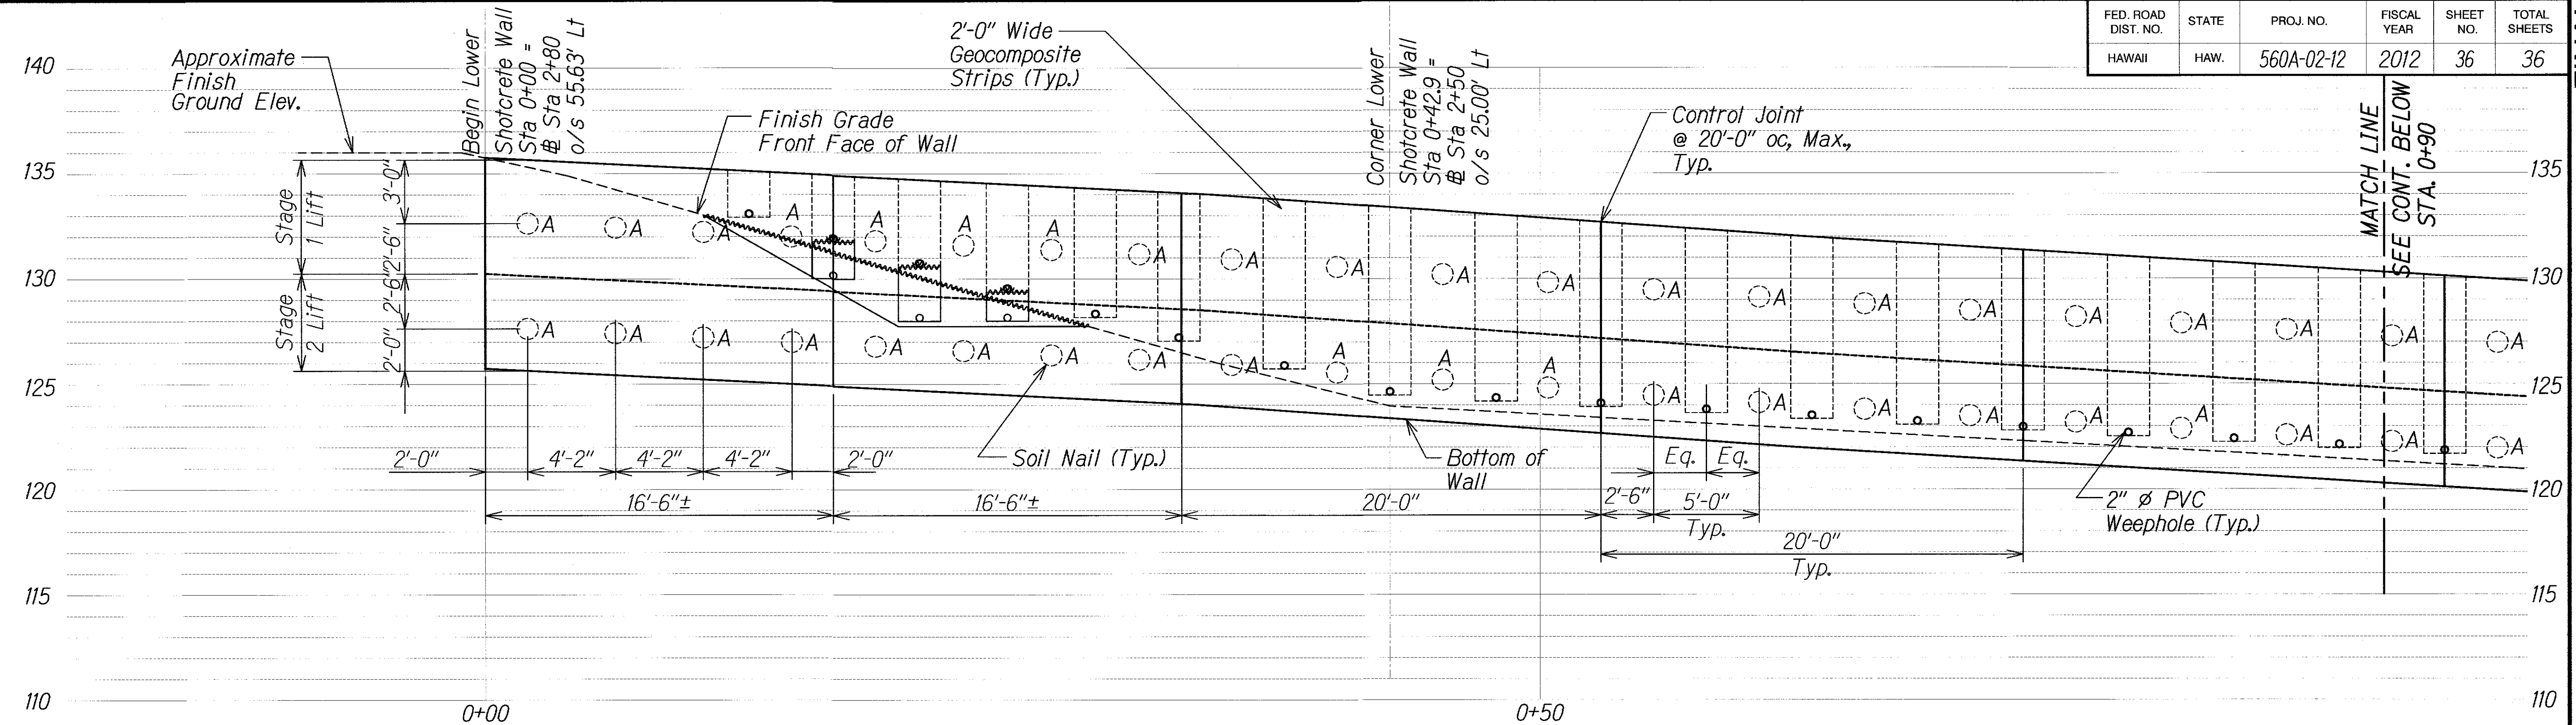

LOWER SHOTCRETE WALL ELEVATION

Scale: 1/4" = 1'-0"

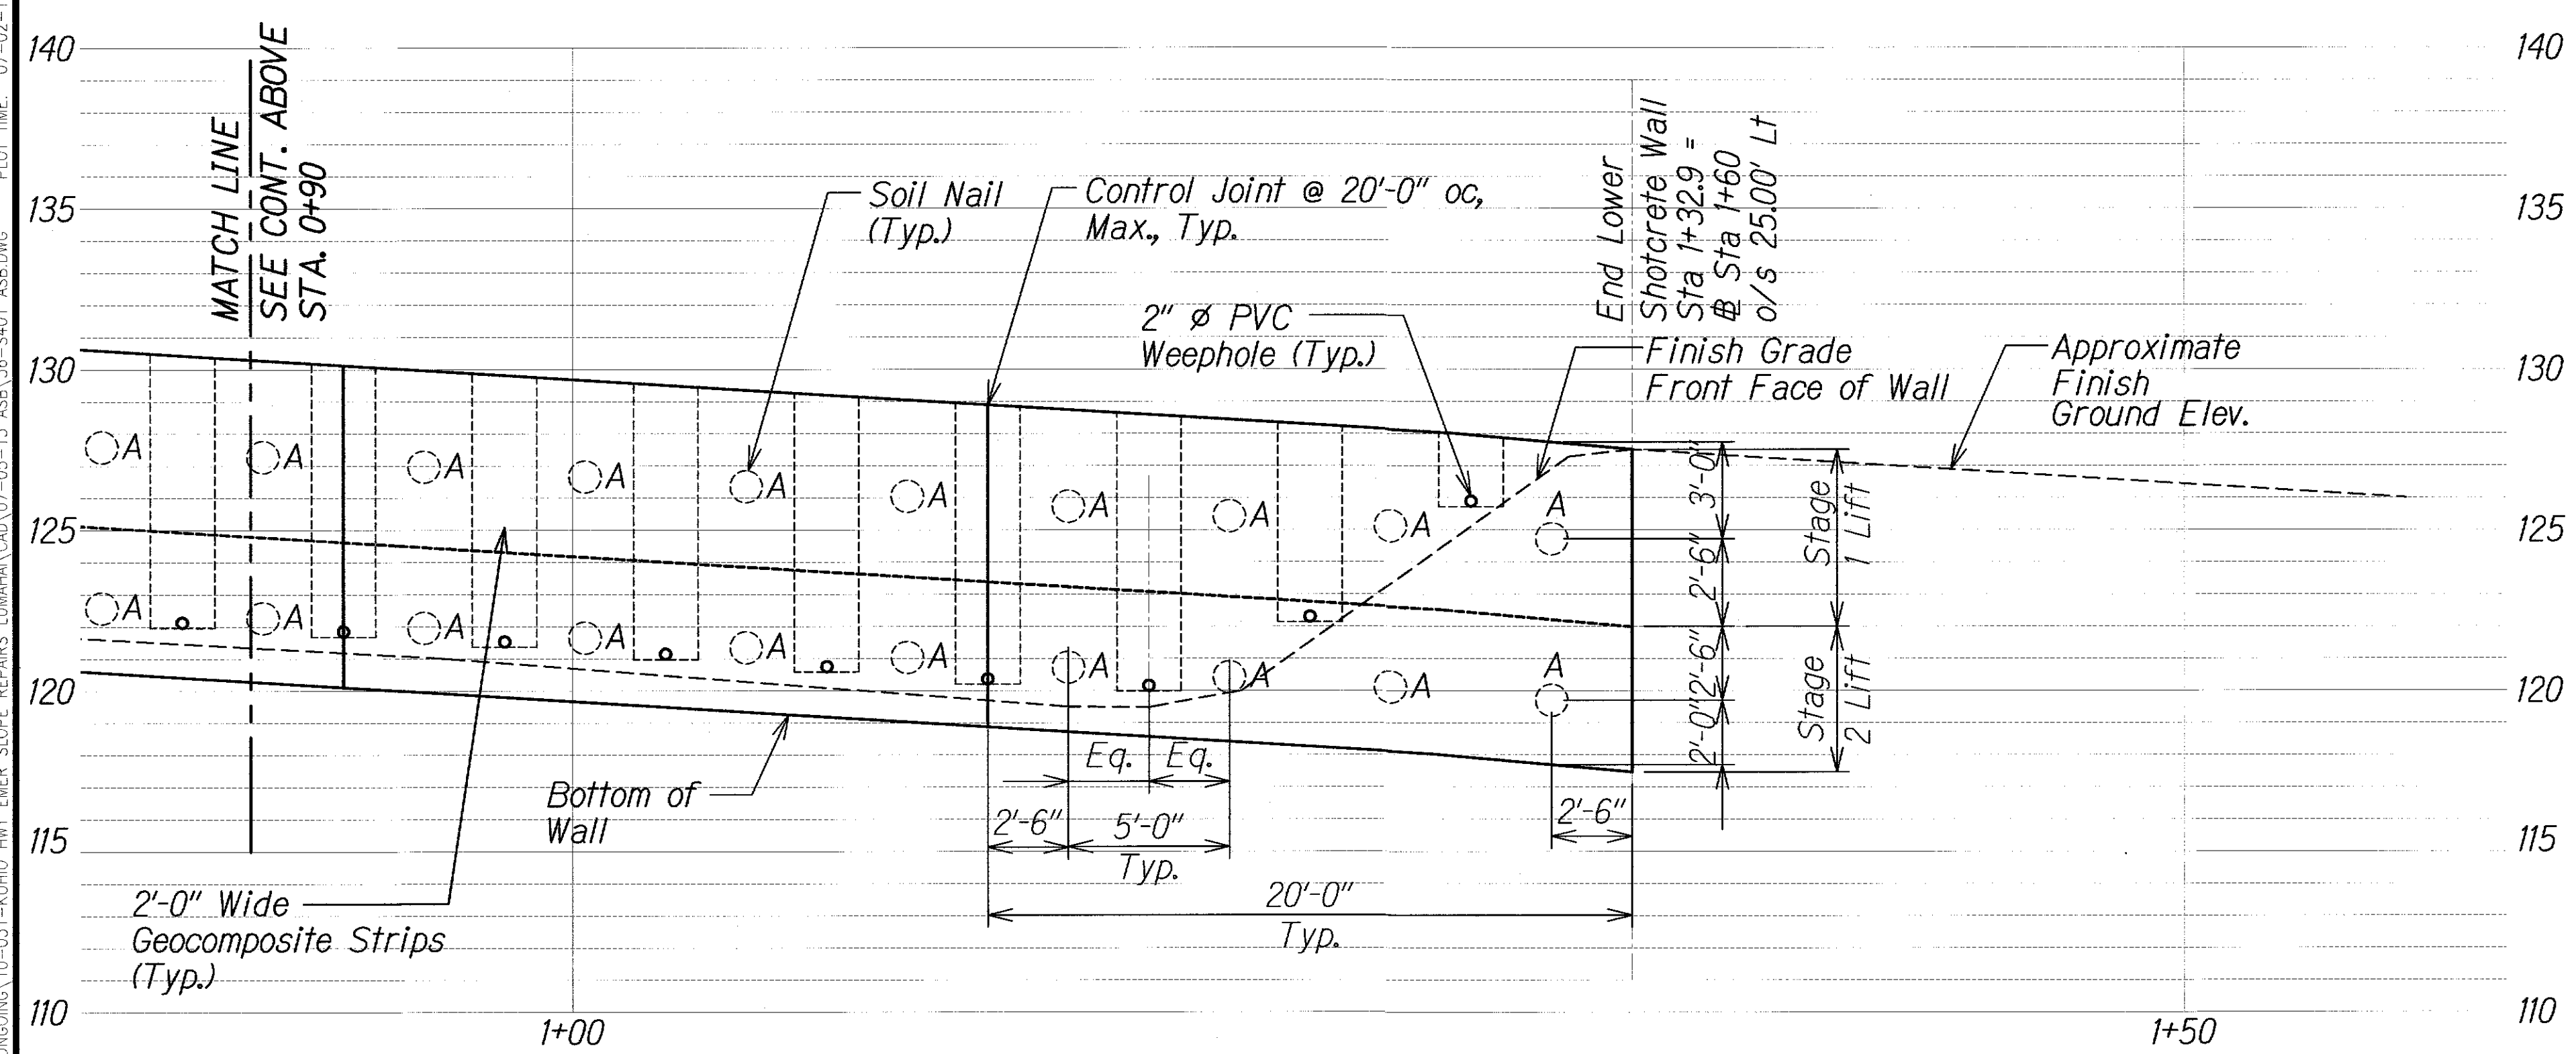


LOWER SHOTCRETE WALL ELEVATION

Scale: 1/4" = 1'-0"

NOTE:
See Civil Sht. C4.1 for Finish Grade.

LEGEND FOR AS-BUILT POSTINGS	
	Squiggly line for as-built deletion
	Double line for as-built deletion
	Text for as-built posting

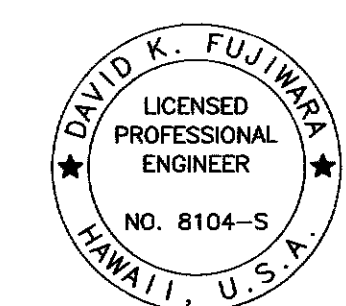


THIS WORK WAS PREPARED BY ME OR UNDER MY SUPERVISION.
David K. Fujiwara
SIGNATURE APRIL 30, 2014 U.C. EXP. DATE


STATE OF HAWAII
DEPARTMENT OF TRANSPORTATION
HIGHWAYS DIVISION
LOWER SHOTCRETE WALL ELEVATIONS
WALL STA. 0+00 TO 1+32.9
KUHIU HIGHWAY EMERGENCY SLOPE REPAIRS
Vicinity of Lumahai
Project No. 560A-02-12
Scale: As Shown Date: Oct. 17, 2011
SHEET No. 341 OF 1 SHEETS

"AS-BUILT"

FED. ROAD DIST. NO.	STATE	PROJ. NO.	FISCAL YEAR	SHEET NO.	TOTAL SHEETS
HAWAII	HAW.	560A-02-12	2012	36 S-1	36

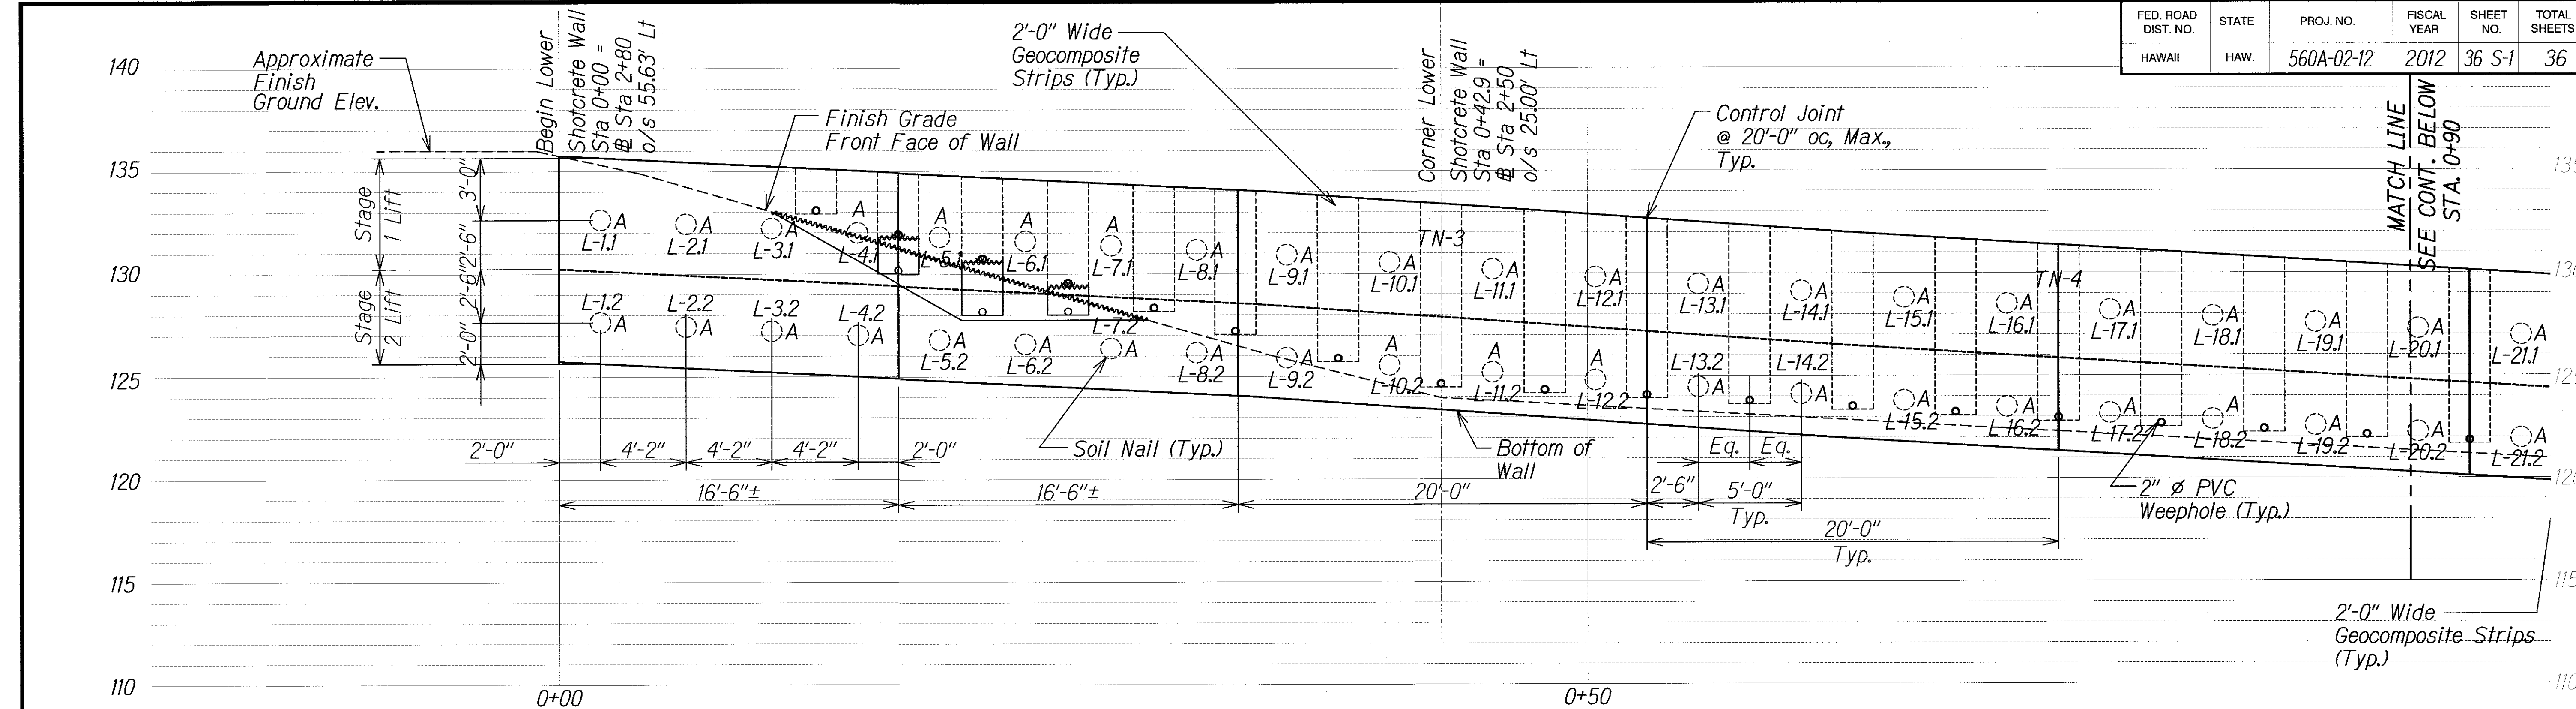

**LOWER SHOTCRETE WALL
SOIL NAIL IDENTIFICATION PLAN**
Scale: 1/4" = 1'-0"

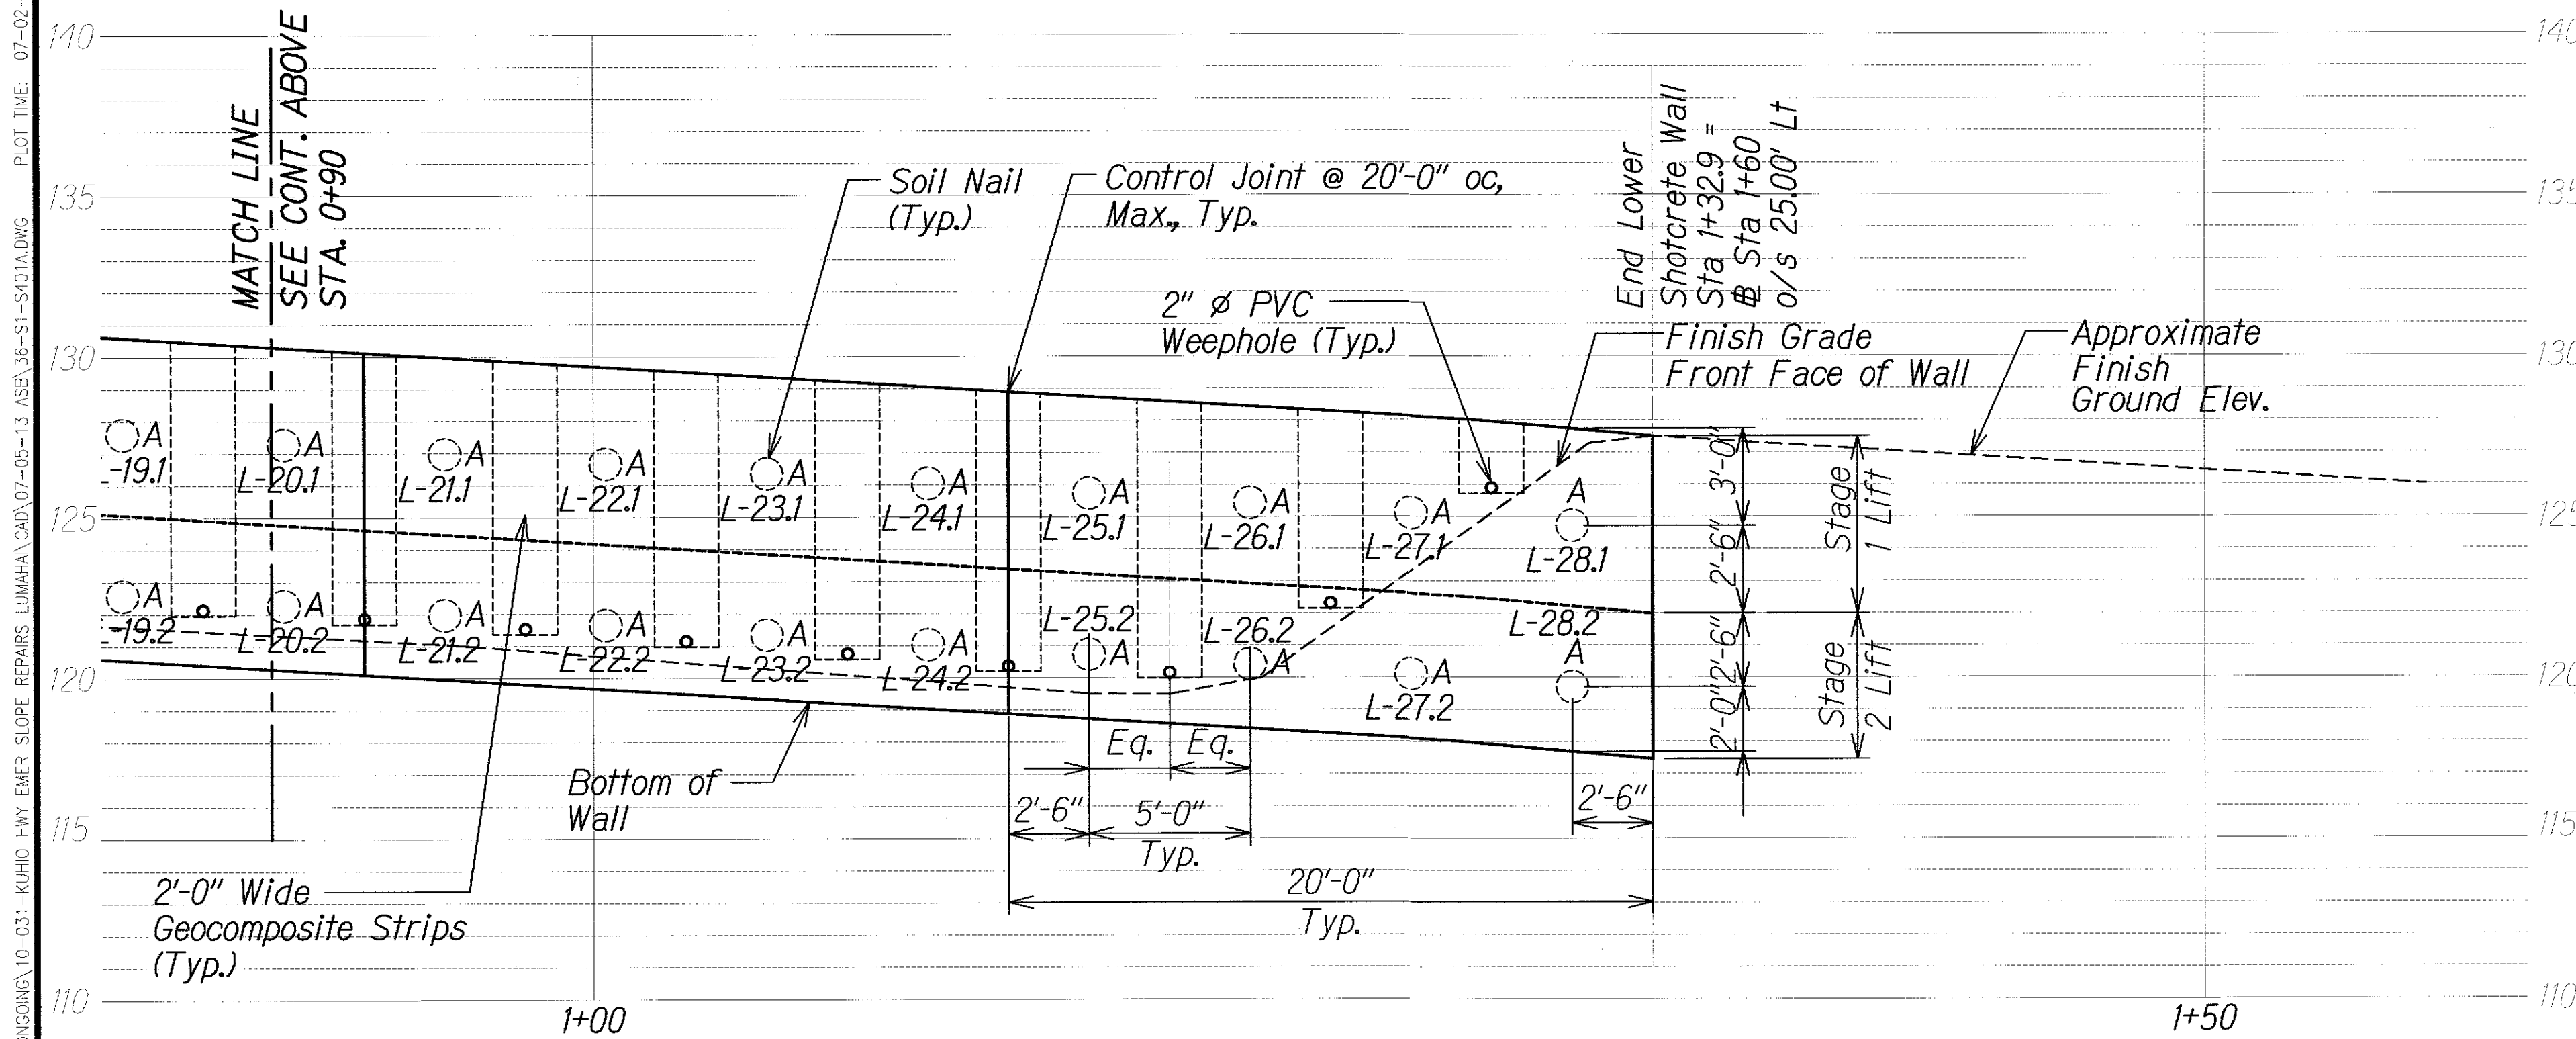

**LOWER SHOTCRETE WALL
SOIL NAIL IDENTIFICATION PLAN**
Scale: 1/4" = 1'-0"

- NOTES:**
1. See Civil Sht. C4.1 for Finish Grade.
 2. Sacrificial test nails (TN) shall be installed and tested prior to production nail installation.

LEGEND FOR AS-BUILT POSTINGS	
	Squiggly line for as-built deletion
	Double line for as-built deletion
	Text for as-built posting

ORIGINAL PLAN	DATE
DRAWN BY	
DESIGNED BY	
CHECKED BY	
NOTED BY	
NO.	

DRAWING NAME: 2A00 CONCRETE/10-031-KUHIO HWY EMER SLOPE REPAIRS LUMAHAI CAD/07-05-13 ASE/36-S1-5401A.DWG PLOT TIME: 07-02-13, 12:42 PM

THIS WORK WAS PREPARED BY ME
OR UNDER MY SUPERVISION.

David K. Fujiwara
SIGNATURE

APRIL 30, 2014
U.C. EXP. DATE

STATE OF HAWAII
DEPARTMENT OF TRANSPORTATION
HIGHWAYS DIVISION

**LOWER SHOTCRETE WALL
SOIL NAIL IDENTIFICATION PLAN**

KUHIO HIGHWAY EMERGENCY SLOPE REPAIRS
Vicinity of Lumahai
Project No. 560A-02-12

Scale: As Shown Date: Oct. 17, 2011

SHEET No. 541A OF 1 SHEETS