


FED. ROAD DIST. NO.	STATE	PROJ. NO.	FISCAL YEAR	SHEET NO.	TOTAL SHEETS
HAWAII	HAW.	560A-02-12	2012	C.O. 9	36

LEGEND FOR AS-BUILT POSTINGS	
	Squiggly line for as-built deletion
	Double line for as-built deletion
Roadway	Text for as-built posting

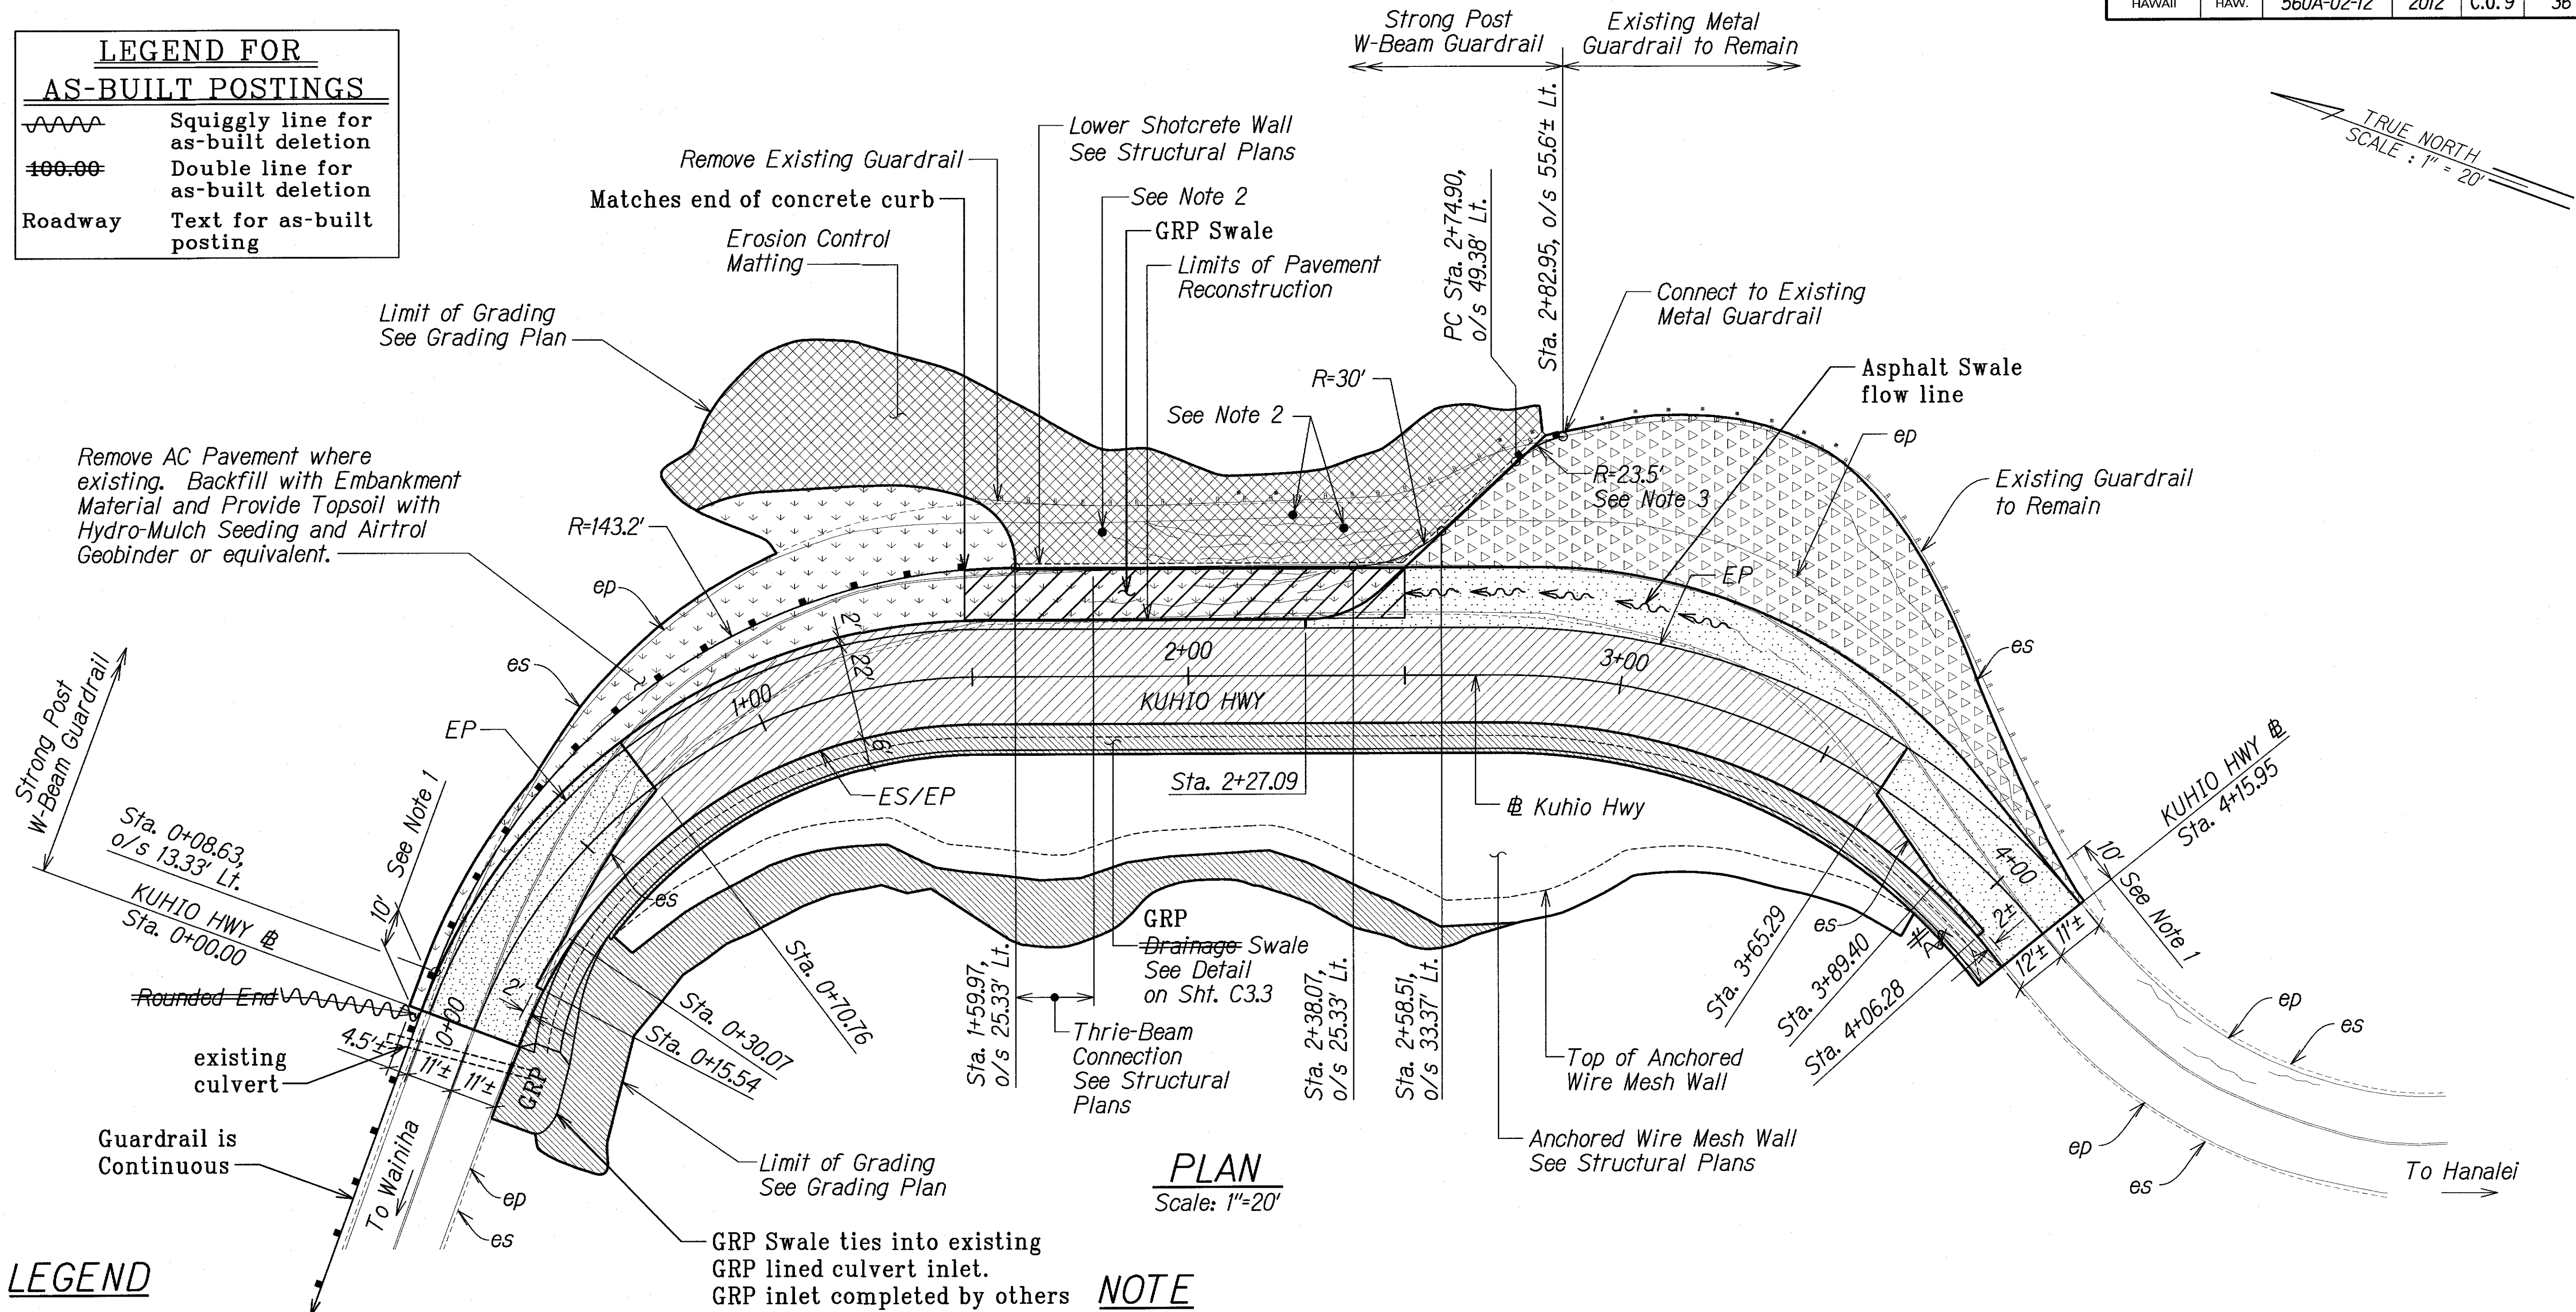

LEGEND

	Pavement Reconstruction 4" HMA Pavement, Mix No. IV 12" Aggregate Base Course		Erosion Control Matting Hydro-Mulch Seeding with Airtrol Geobinder or equivalent
	Seal Cracks 1 1/2" min. HMA Overlay, Mix No. IV		Turf Reinfort Matting (TRM) Hydro-Mulch Seeding with Airtrol Geobinder or equivalent
	Remove AC Pavement where existing. Backfill with Embankment Material and Provide Topsoil with Hydro-Mulch Seeding and Airtrol Geobinder or equivalent.		Sand Seal

PLAN
Scale: 1"=20'

NOTE

1. Cold Plane Existing AC Pavement to provide 1 1/2" Surface Course. See Smooth Riding Connection Detail on Sheet C3.3.
2. ~~The Contractor shall keep the existing inclinometer casings intact. If it is anticipated that damage during construction is unavoidable, the Contractor shall notify the Engineer prior to cutting or removing the casing.~~
3. Provide Shop-Bent Radius.

Cut inclinometer casing and grout solid to lower grade.

	STATE OF HAWAII DEPARTMENT OF TRANSPORTATION HIGHWAYS DIVISION	
	ROADWAY PLAN	
	KUHIO HIGHWAY EMERGENCY SLOPE REPAIRS Vicinity of Lumahai	
	Project No. 560A-02-12 Scale: As Shown Date: Oct. 17, 2011	
	SHEET No. C3J OF 18 SHEETS	

"AS-BUILT"

C.O. 9