


FED. ROAD DIST. NO.	STATE	PROJ. NO.	FISCAL YEAR	SHEET NO.	TOTAL SHEETS
HAWAII	HAW.	560A-02-12	2012	10	36

FINAL

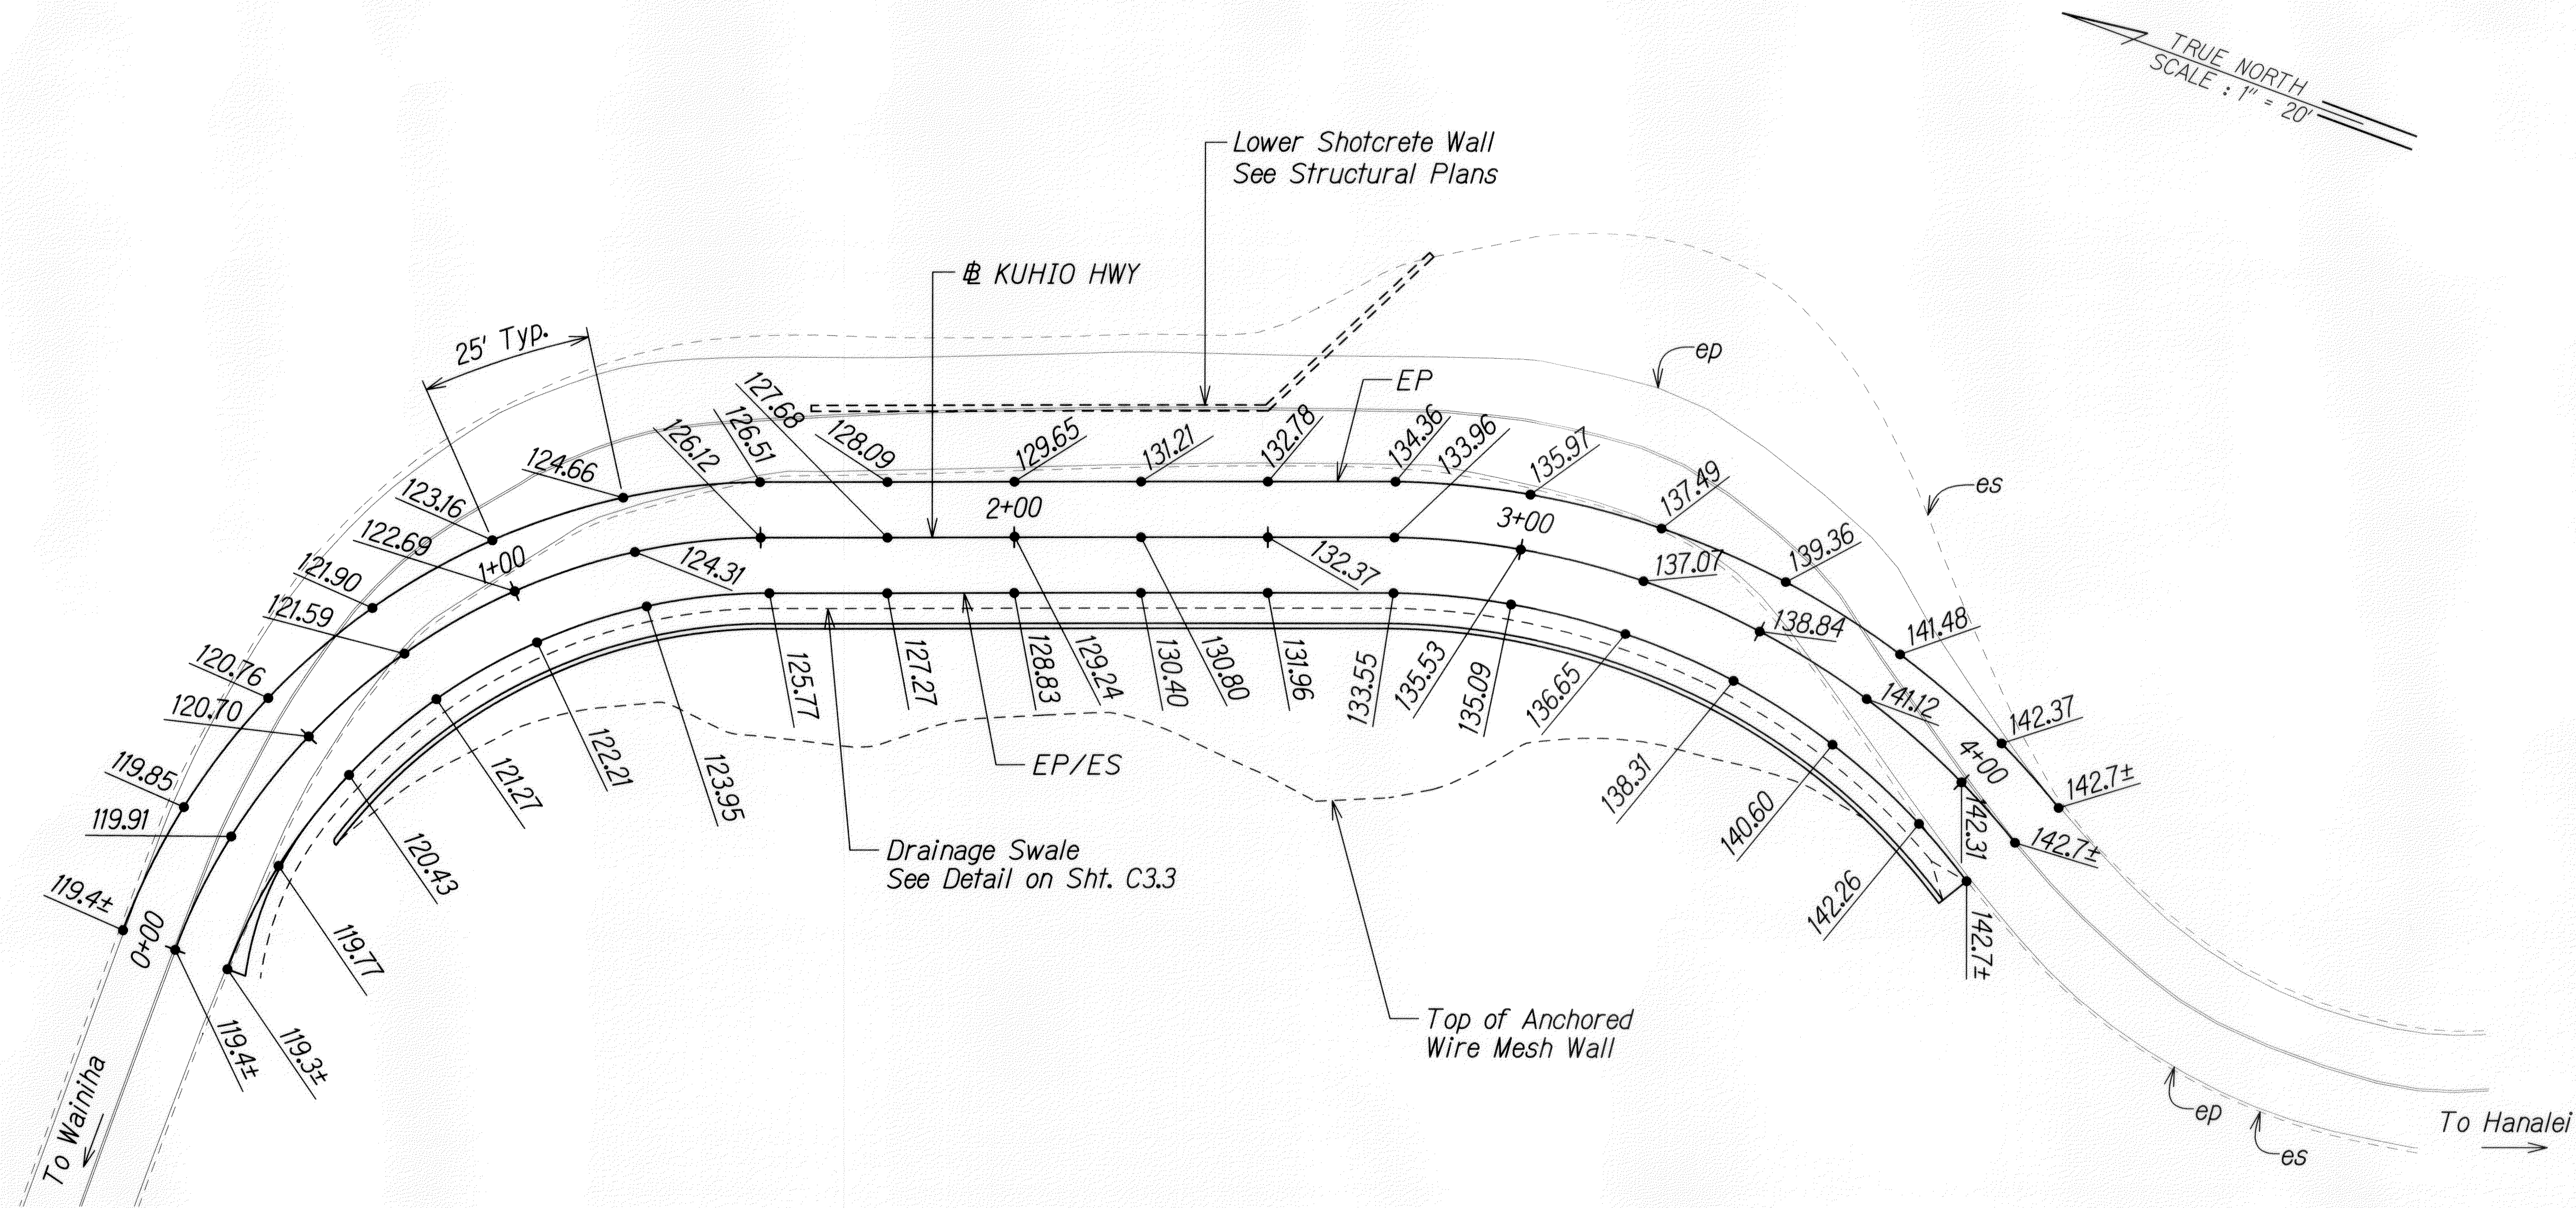

ORIGINAL PLAN	DATE
DESIGNED BY	
NOTED BY	
CHECKED BY	
IN CHARGE	

THIS WORK WAS PREPARED BY ME OR UNDER MY SUPERVISION.

*[Signature]* 04/30/12

SIGNATURE EXPIRATION DATE OF THE LICENSE

STATE OF HAWAII  
DEPARTMENT OF TRANSPORTATION  
HIGHWAYS DIVISION

**SPOT ELEVATION PLAN**

**KUHIO HIGHWAY EMERGENCY SLOPE REPAIRS**

*Vicinity of Lumahai*

Project No. 560A-02-12

Scale: As Shown Date: Oct. 17, 2011

SHEET No. C3.2 OF 18 SHEETS